


REFER TO STD. DRAWING G-1 & G-1D FOR ALL COMMON GUARDRAIL DETAILS NOT SHOWN HERE

SEE CONNECTION PLATE DETAIL (4) 7/8" X 12" HEX BOLTS w/ (1) HEX NUT. & (1) WASHER EACH

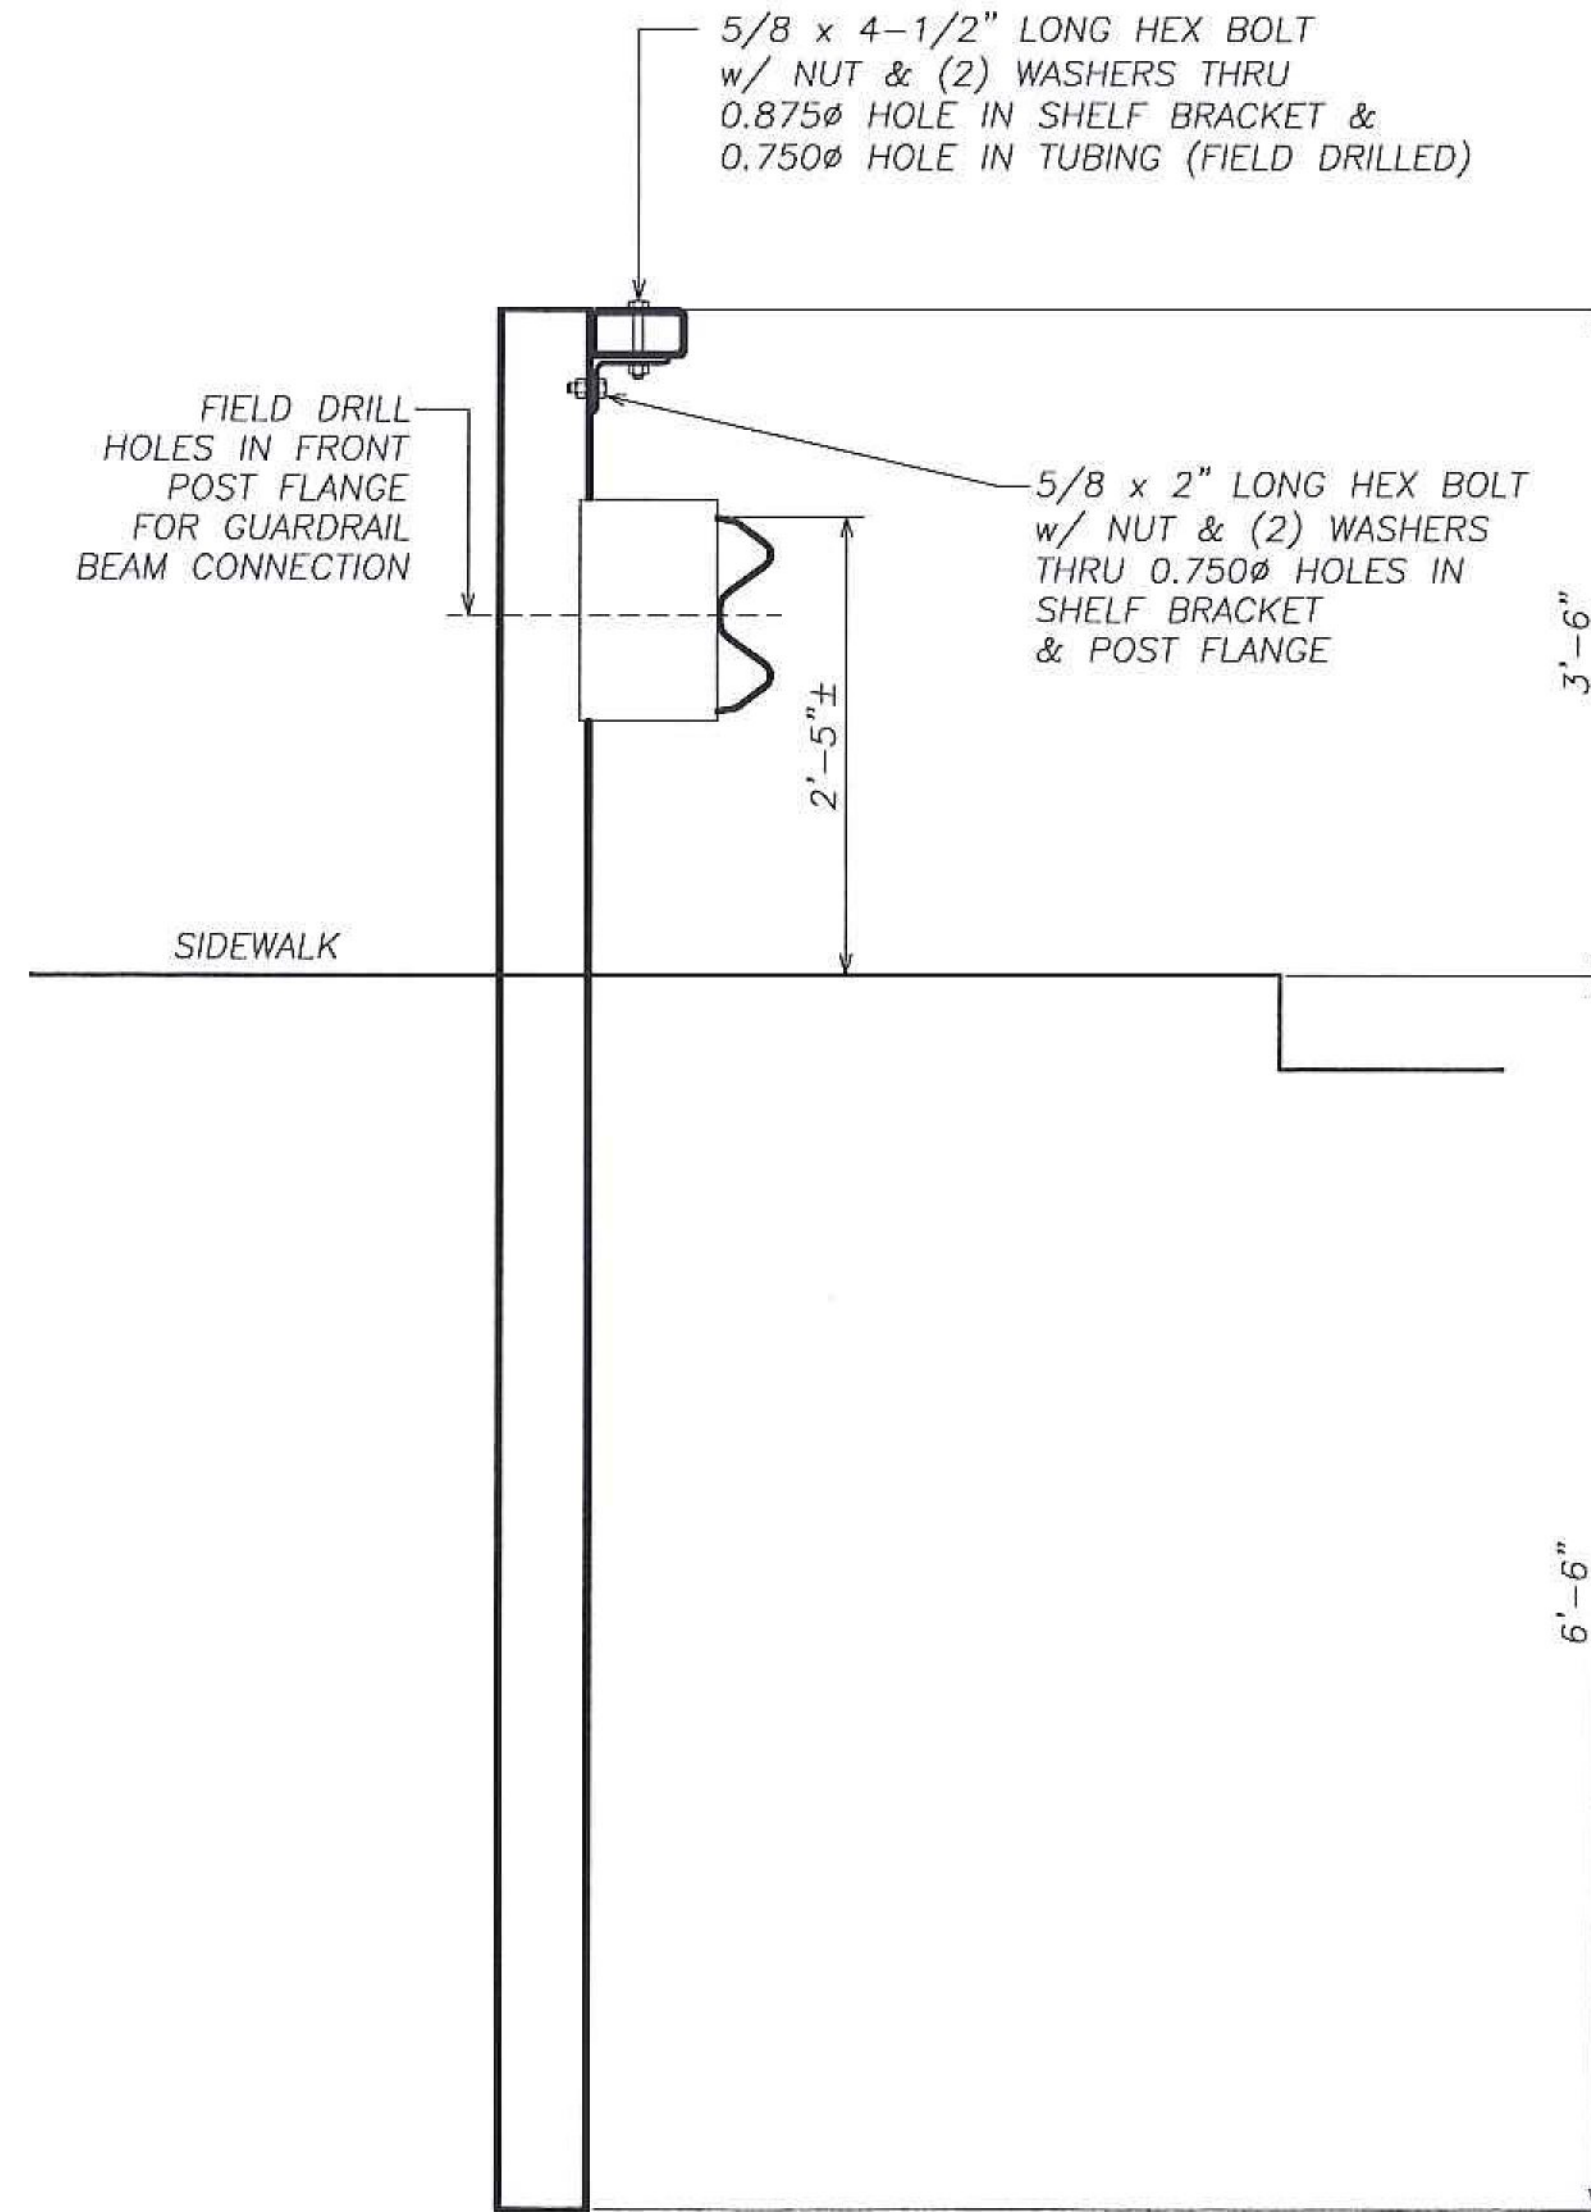

SECTION B
TYPICAL AT WINGWALLS 2 & 4

RAILING ELEVATION @ WINGWALL 4
LOOKING AT FACE OF RAIL FROM CENTERLINE OF ROAD

Approved

BY: Carolyn Carlson
 DATE: 05/26/2018
 RESUBMIT: NO
 RECEIVED: May 25, 2018
 CKD BY: Carolyn Carlson

**STATE OF VERMONT
AGENCY OF TRANSPORTATION**

HIGHWAY SAFETY CORP GLASTONBURY, CT 860-633-9445		CERTIFIED FABRICATOR
GENERAL CONTRACTOR		JOB NO. 2234
SUB CONTRACTOR LAFAYETTE		SHEET NO. 4 of 5
DRAWN PAR	CHECKED	DATE 03-26-18 SCALE NONE SIZE D