


Benchmark  
Chls. Square  
So. end conc  
retaining wall  
Elev = 210.408

CURVE DATA  
 $\Delta = 11^{\circ}32'24.3''$  Lt.  
 R = 400.000  
 T = 40.419  
 L = 80.565  
 E = 2.037  
 BANK = 0.066

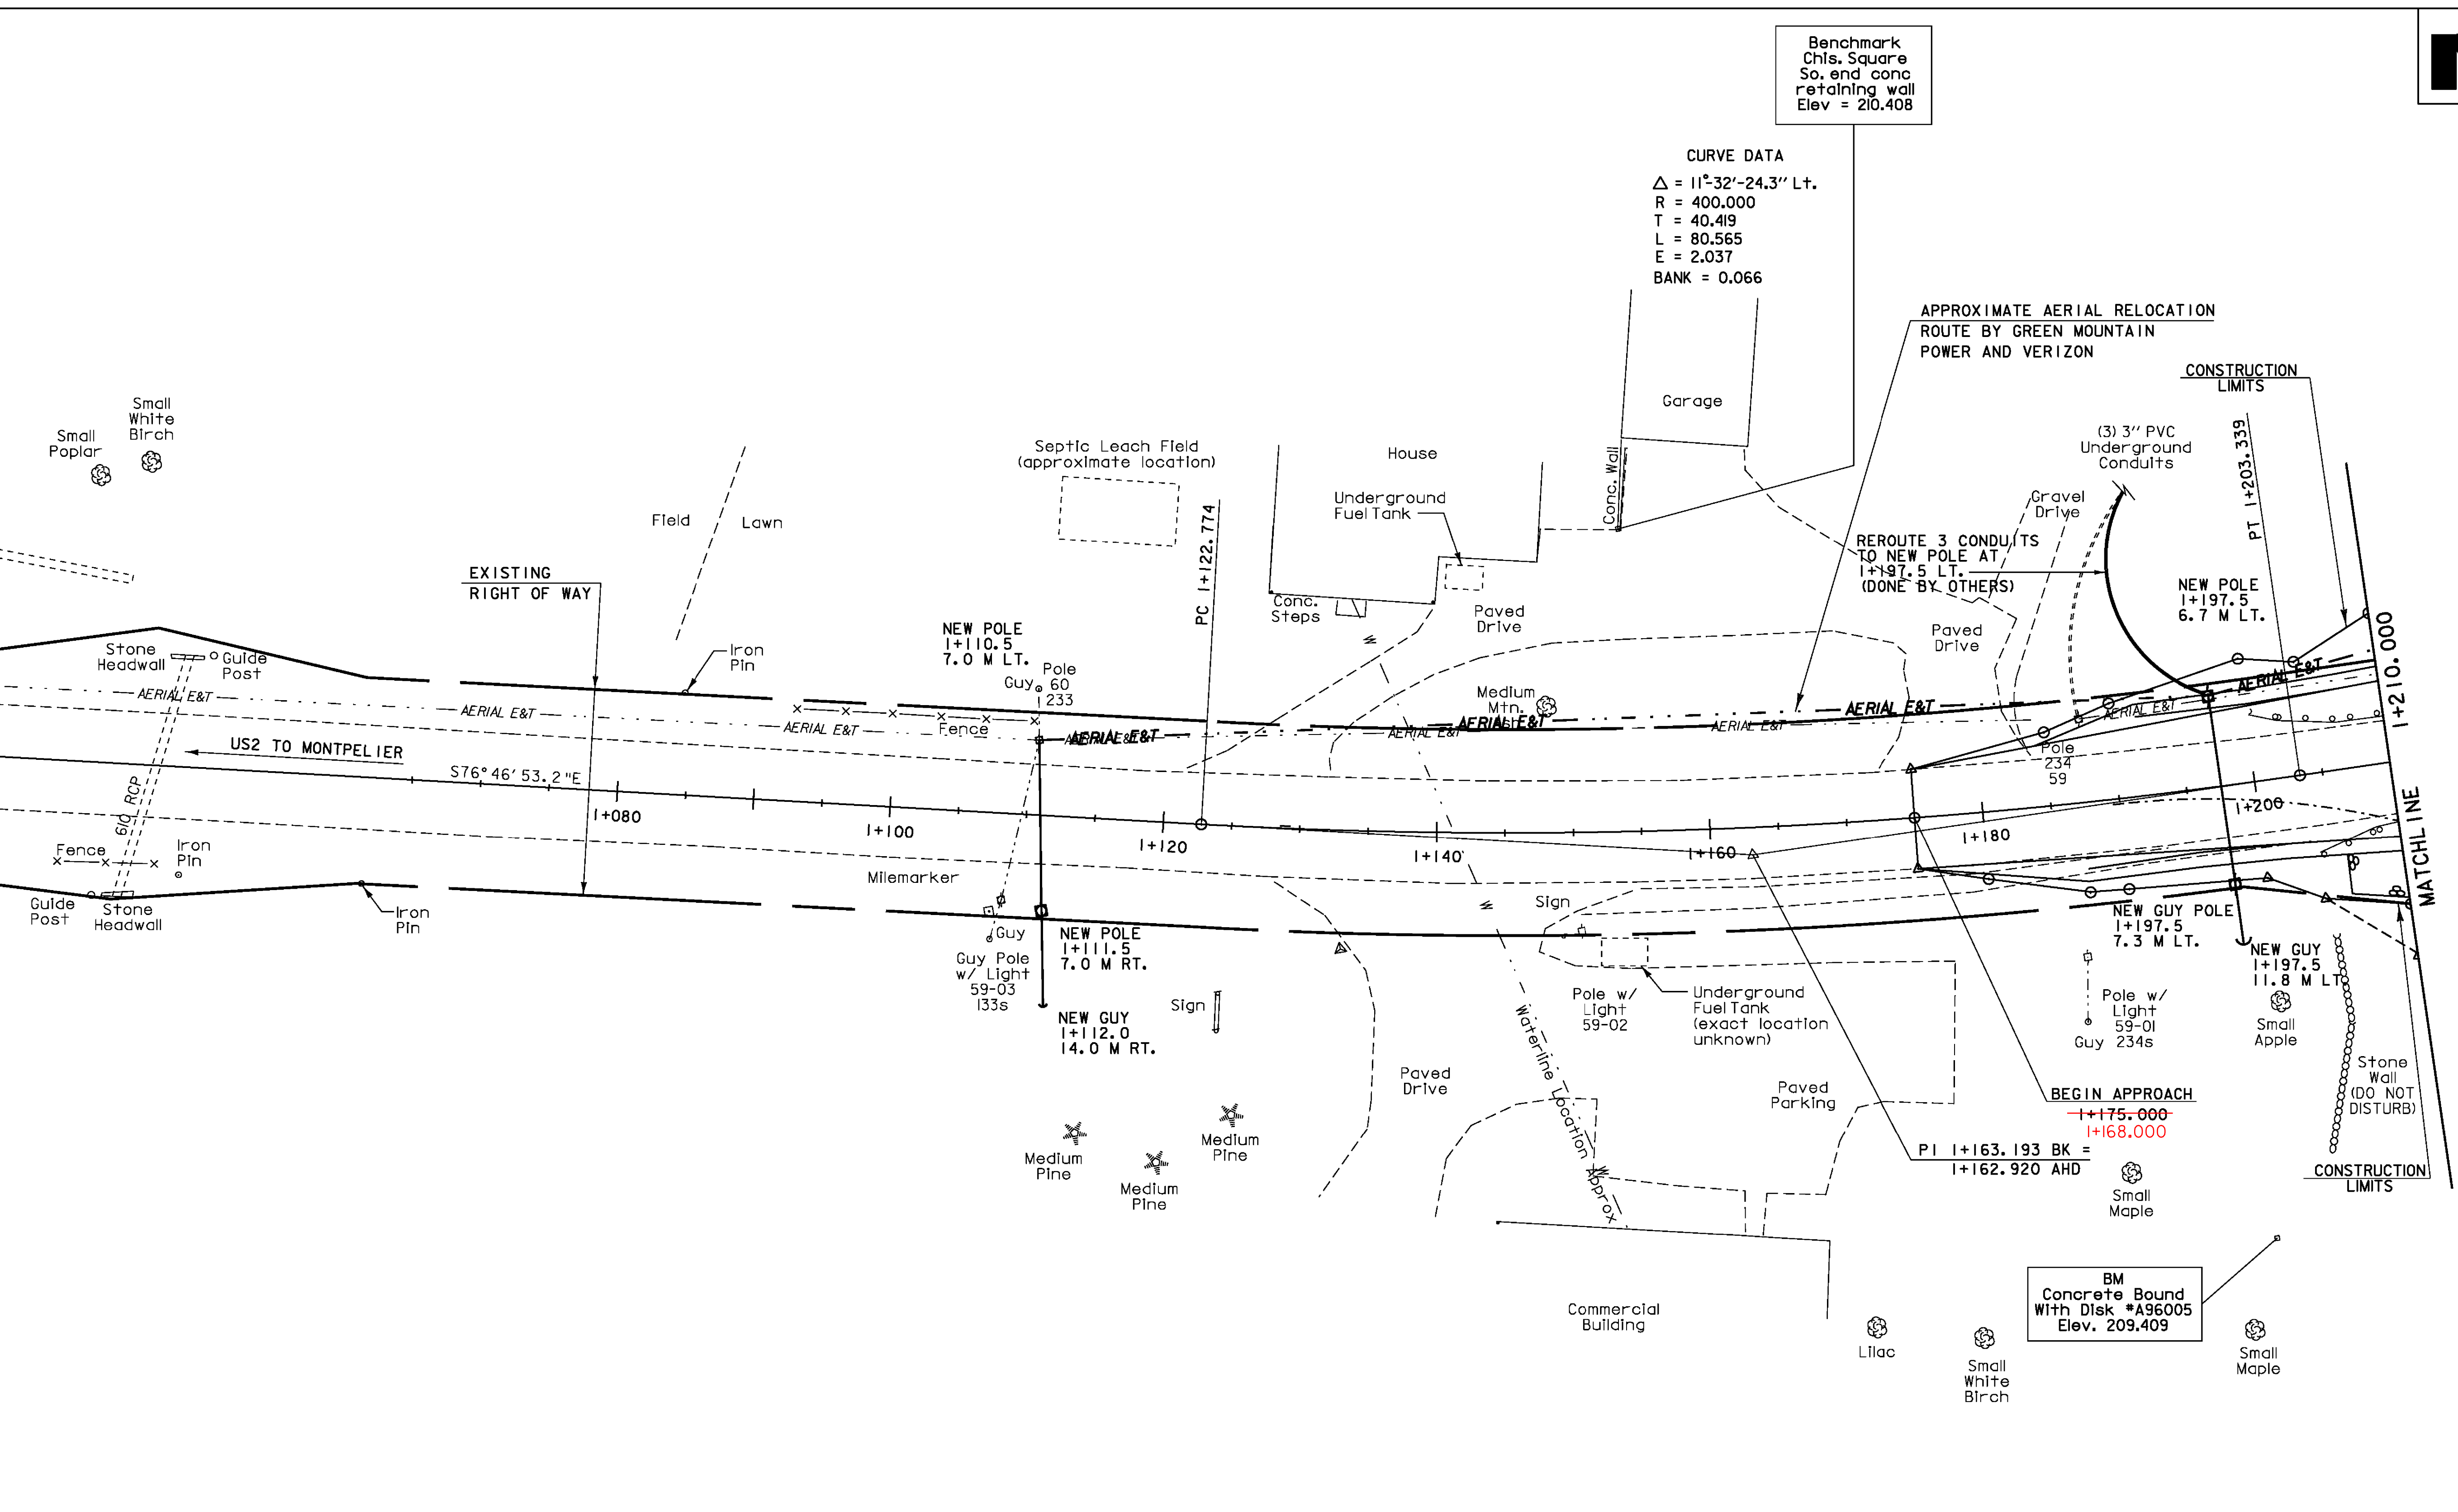


COLD PLANING, BITUMINOUS PAVEMENT  
 1+168 Lt. to 1+195

REMOVAL AND DISPOSAL OF EXISTING GUARDRAIL  
 1+200.4 Lt. - 1+210 Lt.  
 1+204.1 Rt. - 1+210 Rt.

BOX BEAM GUARDRAIL  
 1+188.43 Rt. to 1+210.00 Rt.  
 1+191.82 Lt. to 1+210.00 Lt.

SLOPE STABILIZATION W/ STONE FILL, TYPE II  
 1+206 Rt. to 1+210 Rt.

**DATUM**  
 VERTICAL NAVD 88  
 HORIZONTAL NAD 83 (96)

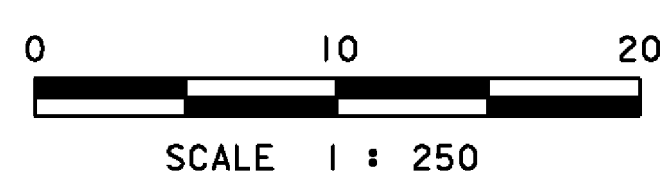

PROJECT: <b>EAST MONTPELIER</b>	PROJECT NO. : <b>BRF 028-3(36)</b>
DESIGN FILE NAME: /98b254/str/sb254bdr.dgn	PLOT DATE: 03-FEB-2009
IPARM FILE NAME: sb254ld.l	DRAWN BY: R. PELLETT
DESIGNED BY: J. LACROIX	CHECKED BY: J. LACROIX
SQUAD LEADER: K. HIGGINS	SHEET: 9 OF 68
LAYOUT SHEET #1	