

**COLD PLANING**  
I+380 to I+400  
I+418


**REMOVAL AND DISPOSAL OF EXISTING GUARDRAIL**  
I+340 Rt. - I+368 Rt.  
I+340 Lt. - I+383 Lt.

**BOX BEAM GUARDRAIL**  
I+340.00 Lt. to I+384.82 Lt.  
I+340.00 Rt. to I+366.41 Rt.  
I+373.2 RT

**CONSTRUCT GRAVEL DRIVE W/ 1500 PAVED APRON**  
I+390.0 Lt. - GRAVEL  
I+423.0 Rt. - GRAVEL (GRAVEL DRIVE SHALL BE CONSTRUCTED PRIOR TO TEMPORARY DETOUR)

**REMOVE DRIVE**  
I+374 Rt.

**DATUM**  
VERTICAL NAVD 88  
HORIZONTAL NAD 83 (96)

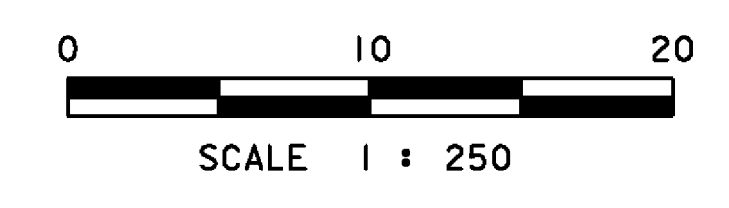

PROJECT: <b>EAST MONTPELIER</b>	PROJECT NO. : <b>BRF 028-3(36)</b>
DESIGN FILE NAME: /98b254/str/sb254bdr.dgn	PLOT DATE: 03-FEB-2009
IPARM FILE NAME: sb254la3.1	DRAWN BY: R. PELLETT
DESIGNED BY: J. LACROIX	CHECKED BY: J. LACROIX
SQUAD LEADER: K. HIGGINS	SHEET: 11 OF 68
LAYOUT SHEET *3	