


PROFILE US 2

THE GRADES SHOWN TO THE NEAREST HUNDREDTH ARE THE ORIGINAL GROUND ELEVATIONS ALONG THE PROPOSED ALIGNMENT. THE GRADES SHOWN TO THE NEAREST THOUSANDTH ARE THE FINISH GRADES ALONG THE PROPOSED ALIGNMENT.

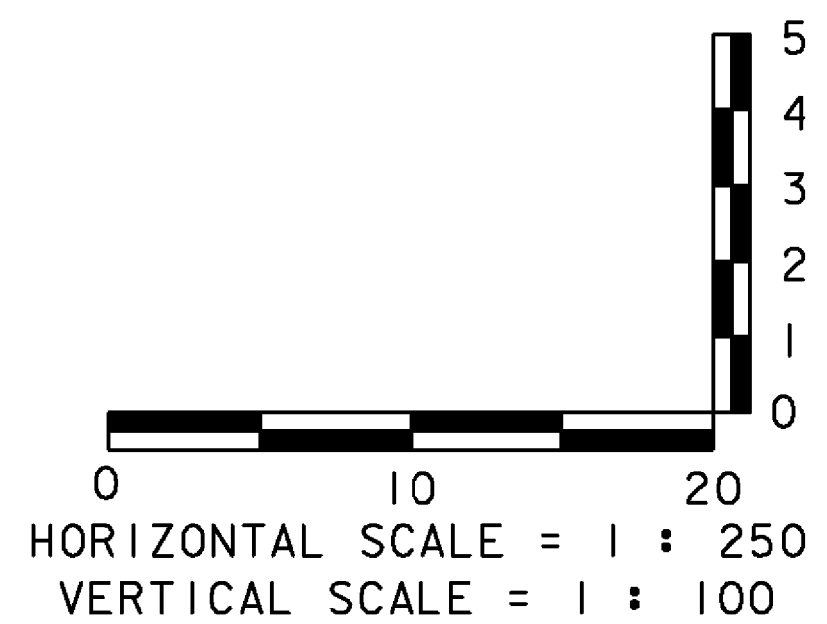

PROJECT: EAST MONTPELIER	PROJECT NO. : BRF 028-3(36)
DESIGN FILE NAME: /98b254/str/sb254xs.dgn	PLOT DATE: 03-FEB-2009
IPARM FILE NAME: sb254pro3.i	DRAWN BY: R. PELLETT
DESIGNED BY: J. LACROIX	CHECKED BY: J. LACROIX
SQUAD LEADER: K. HIGGINS	SHEET: 14 OF 68
PROFILE SHEET *3	