


DURABLE 100 mm WHITE LINE, THERMOPLASTIC  
 1+175.0 Lt. to 1+210.0 Lt.  
 1+175.0 Rt. to 1+210.0 Rt.

DURABLE 100 mm YELLOW LINE, THERMOPLASTIC  
 1+175.0 to 1+210.0 CL- (DBL).

NOTE:  
 ADJUST NEW EDGE LINE TO MATCH  
 EXISTING EDGE LINE @ BEGIN  
 APPROACH

**DATUM**  
 VERTICAL NAVD 88  
 HORIZONTAL NAD 83 (96)

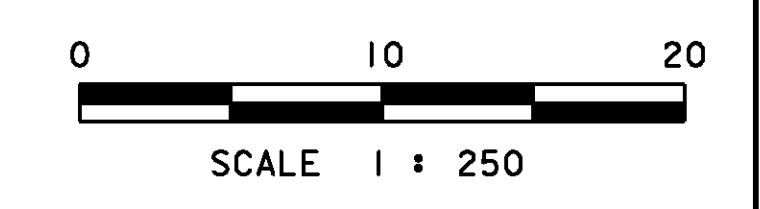

PROJECT: <b>EAST MONTEPELIER</b>	PROJECT NO.: <b>BRF 028-3(36)</b>
DESIGN FILE NAME: /98b254/str/sb254bdr.dgn	PLOT DATE: 03-FEB-2009
IPARM FILE NAME: sb254pml.i	DRAWN BY: R. PELLETT
DESIGNED BY: J. LACROIX	CHECKED BY: J. LACROIX
SQUAD LEADER: K. HIGGINS	SHEET: 16 OF 68
SIGNS & PAVEMENT MARKINGS SHEET #1	