

DURABLE 100 mm WHITE LINE, THERMOPLASTIC


1+340.0 Lt. TO 1+400.0 Lt.  
1+340.0 Rt. TO 1+400.0 Rt.

DURABLE 100 mm YELLOW LINE, THERMOPLASTIC

1+340.0 TO 1+400.0 CL- (DBL)

NOTE:  
ADJUST NEW EDGE LINE TO MATCH  
EXISTING EDGE LINE @ END  
APPROACH

DATUM  
VERTICAL NAVD 88  
HORIZONTAL NAD 83 (96)

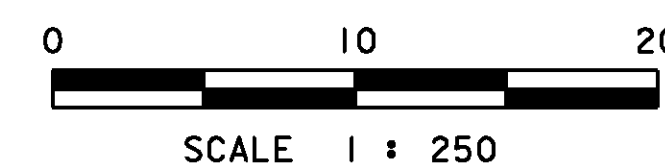

PROJECT: <b>EAST MONTEPELIER</b>	PROJECT NO.: <b>BRF 028-3(36)</b>
DESIGN FILE NAME: /98b254/str/sb254bdr.dgn	PLOT DATE: 03-FEB-2009
IPARM FILE NAME: sb254pm3.i	DRAWN BY: R. PELLETT
DESIGNED BY: J. LACROIX	CHECKED BY: J. LACROIX
SQUAD LEADER: K. HIGGINS	SHEET: 18 OF 68
SIGNS & PAVEMENT MARKINGS SHEET *3	