

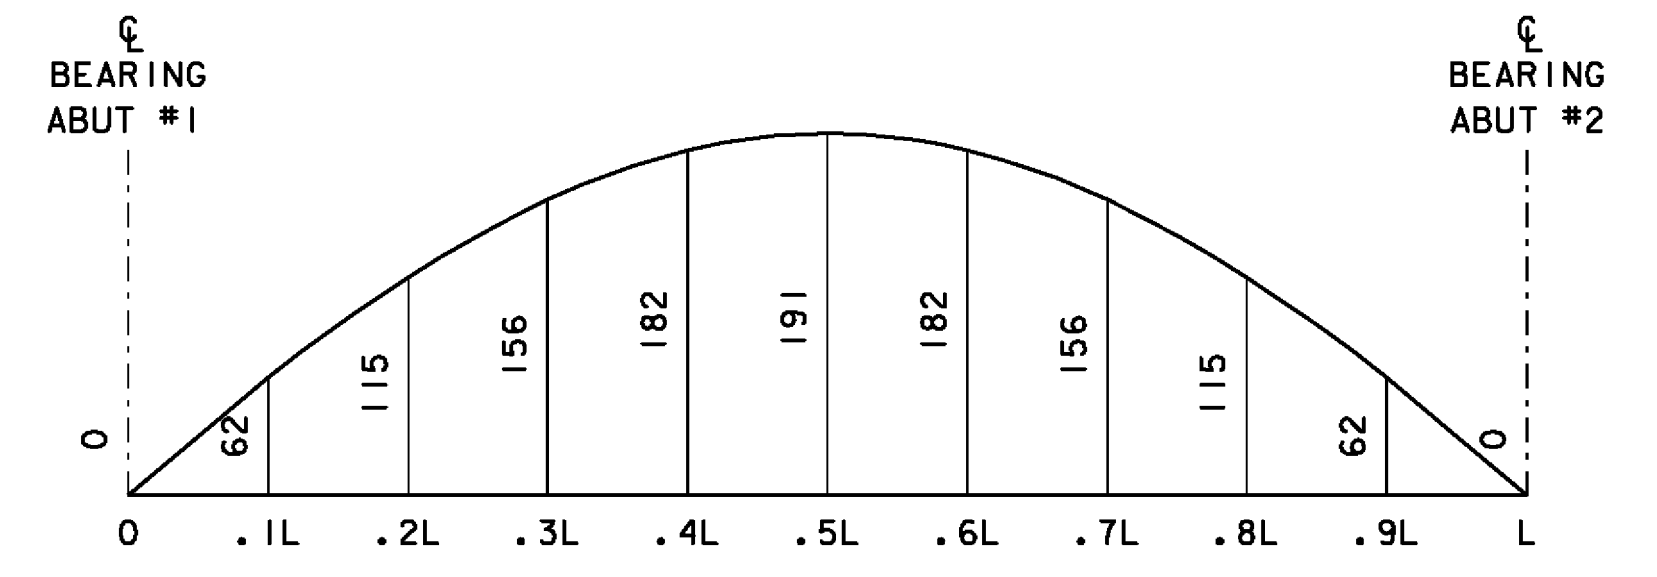


HORIZ. SCALE = 1:100
VERT. SCALE = 1:20

* DENOTES CHARPY V - NOTCH TEST REQUIRED

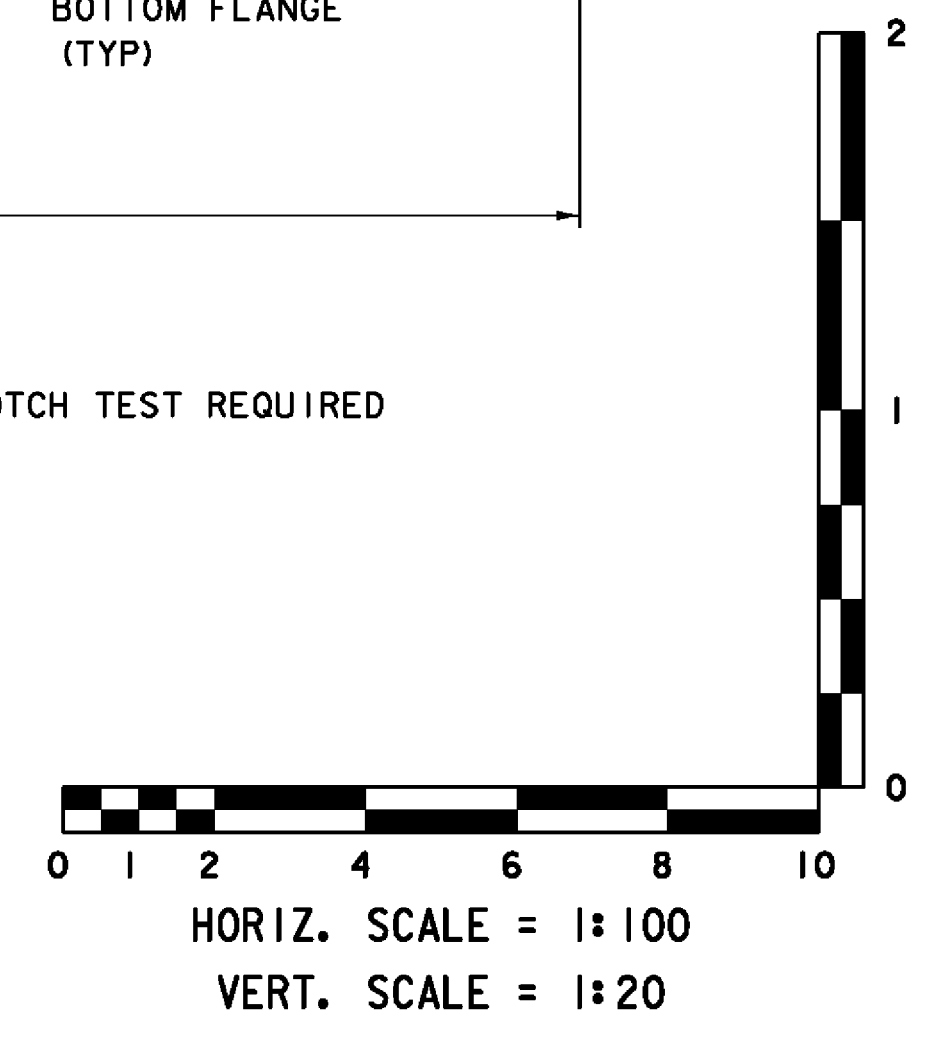


CAMBER DIAGRAM
HORIZ. SCALE = 1:200
VERT. SCALE = 1:40

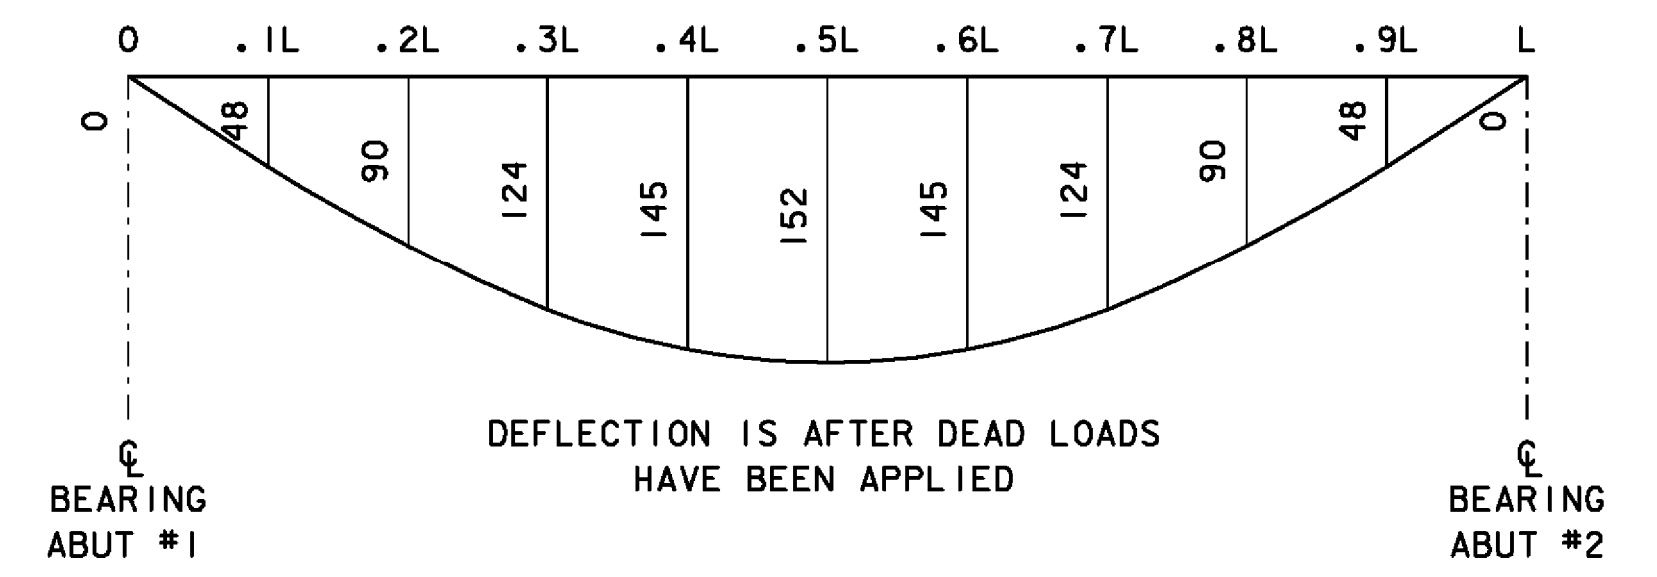


DEAD LOAD DEFLECTION DIAGRAM
HORIZ. SCALE = 1:200
VERT. SCALE = 1:40

NOTE: DEAD LOAD DEFLECTION INCLUDES THE GIRDER SELF-WEIGHT.
SEE SHEET INSTRUMENTATION #4 FOR SIZE AND LOCATION OF HOLES
SEE SHEET INSTRUMENTATION #2 FOR LOCATION OF MOUNTING BLOCKS.

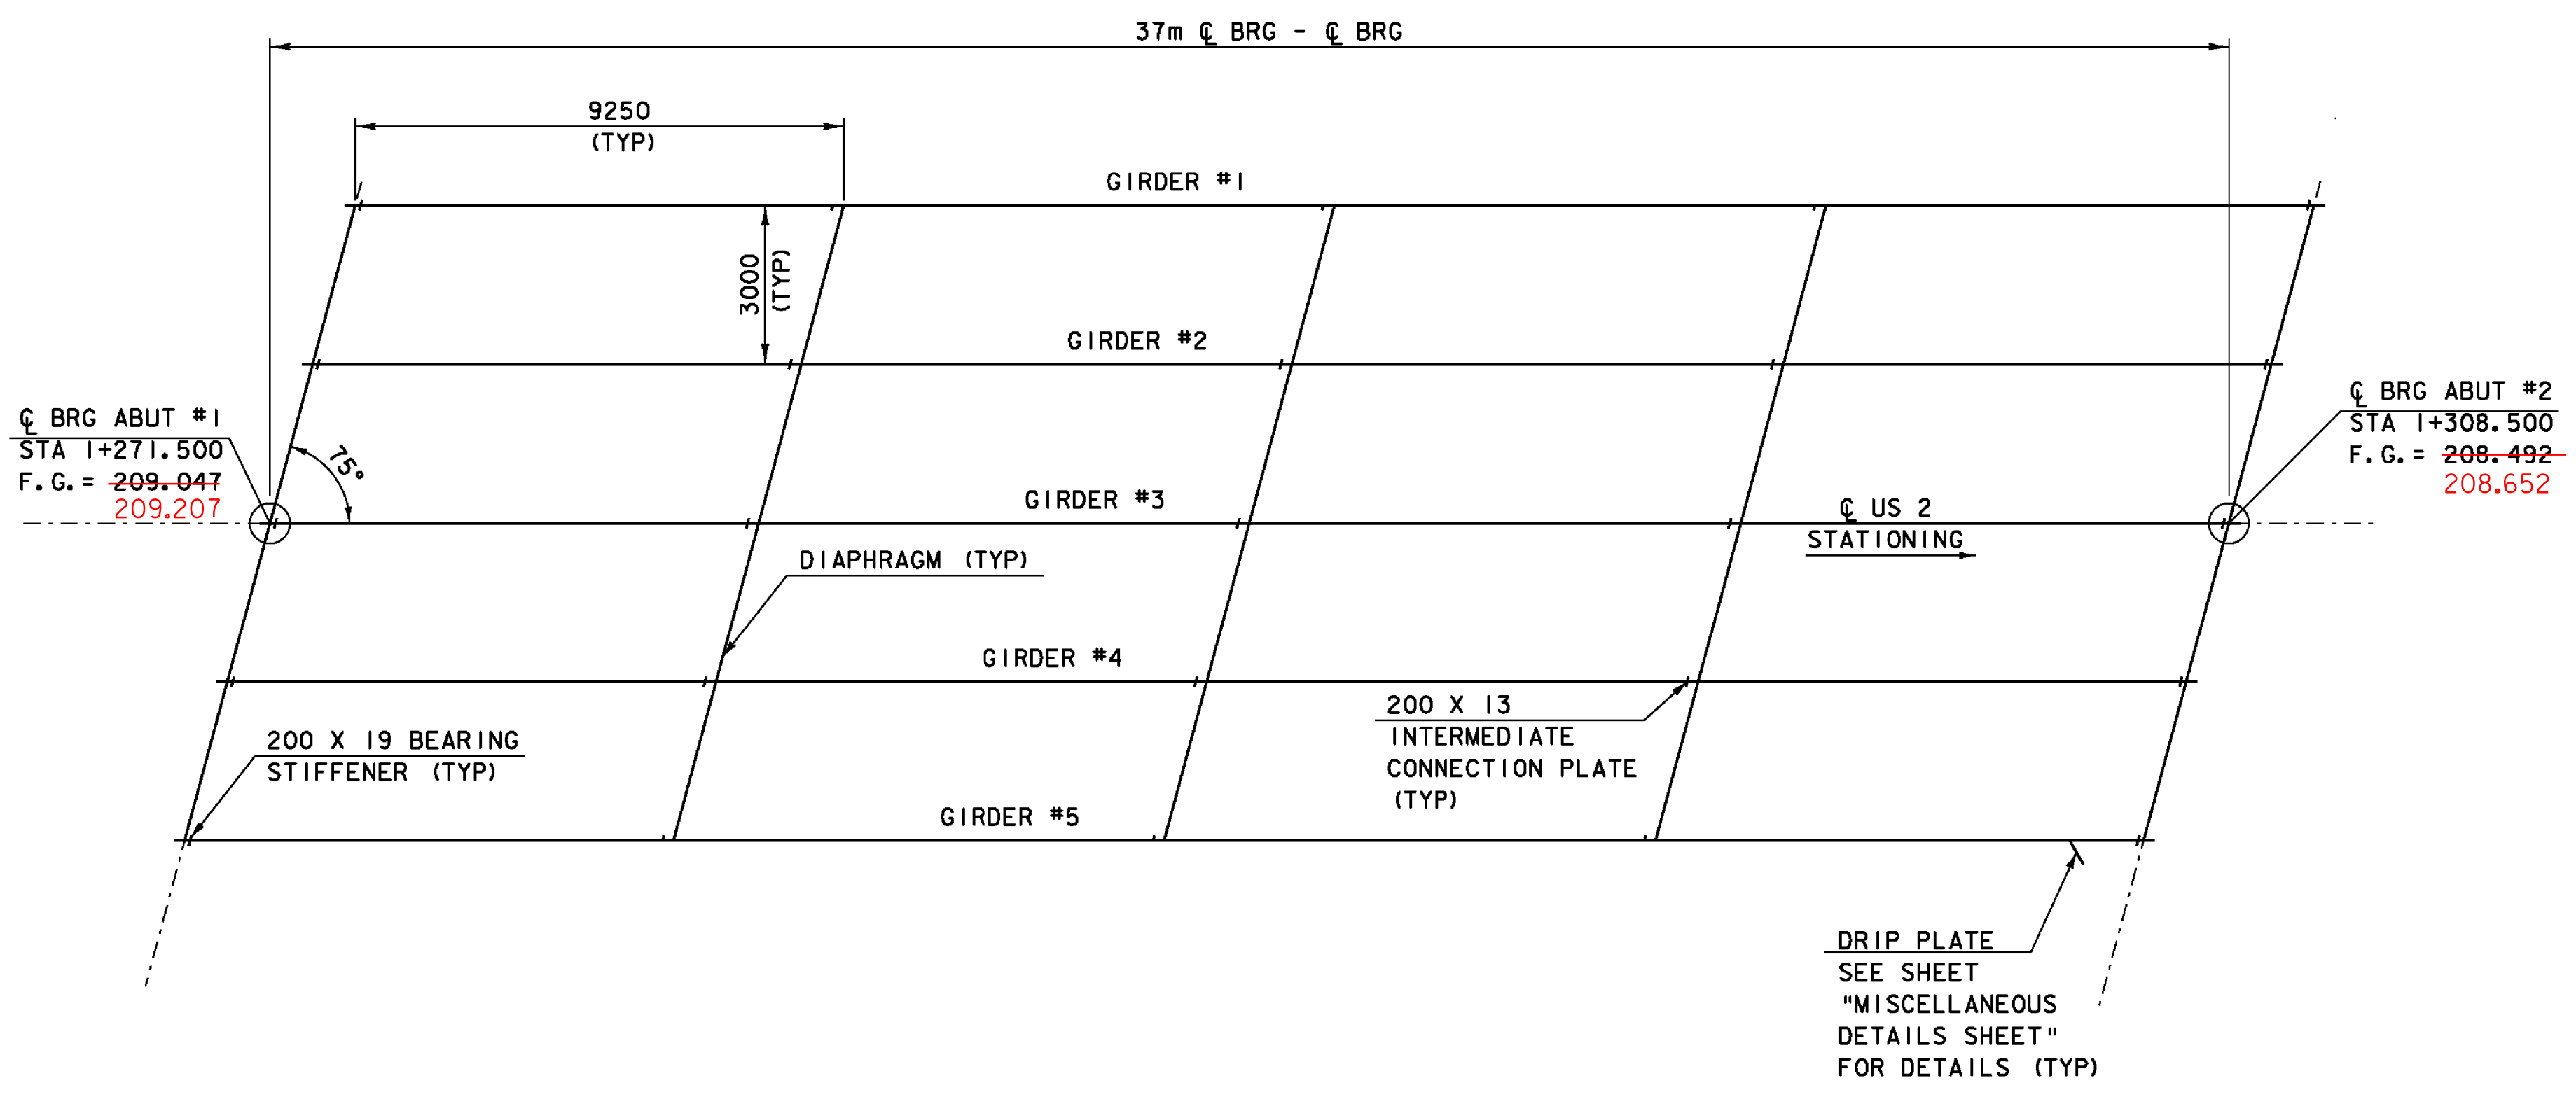

FRAMING PLAN

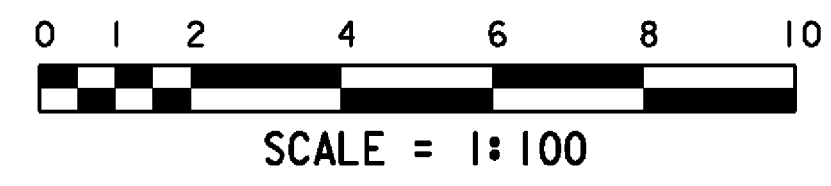

SEE SHEETS 34a and 34b FOR ADDITIONAL FRAMING DETAILS

PROJECT: EAST MONTPELIER	PROJECT NO. : BRF 028-3(36)
DESIGN FILE NAME: /98b254/str/sb254sup.dgn	PLOT DATE: 03-FEB-2009
IPARM FILE NAME: sb254frm.1	DRAWN BY: R. PELLETT
DESIGNED BY: J. LACROIX	CHECKED BY: J. LACROIX
SQUAD LEADER: K. HIGGINS	SHEET: 33 OF 68
FRAMING PLAN	