



APPROACH SLAB #1 PLAN
 0 1 2 3 4 5
 SCALE = 1:50

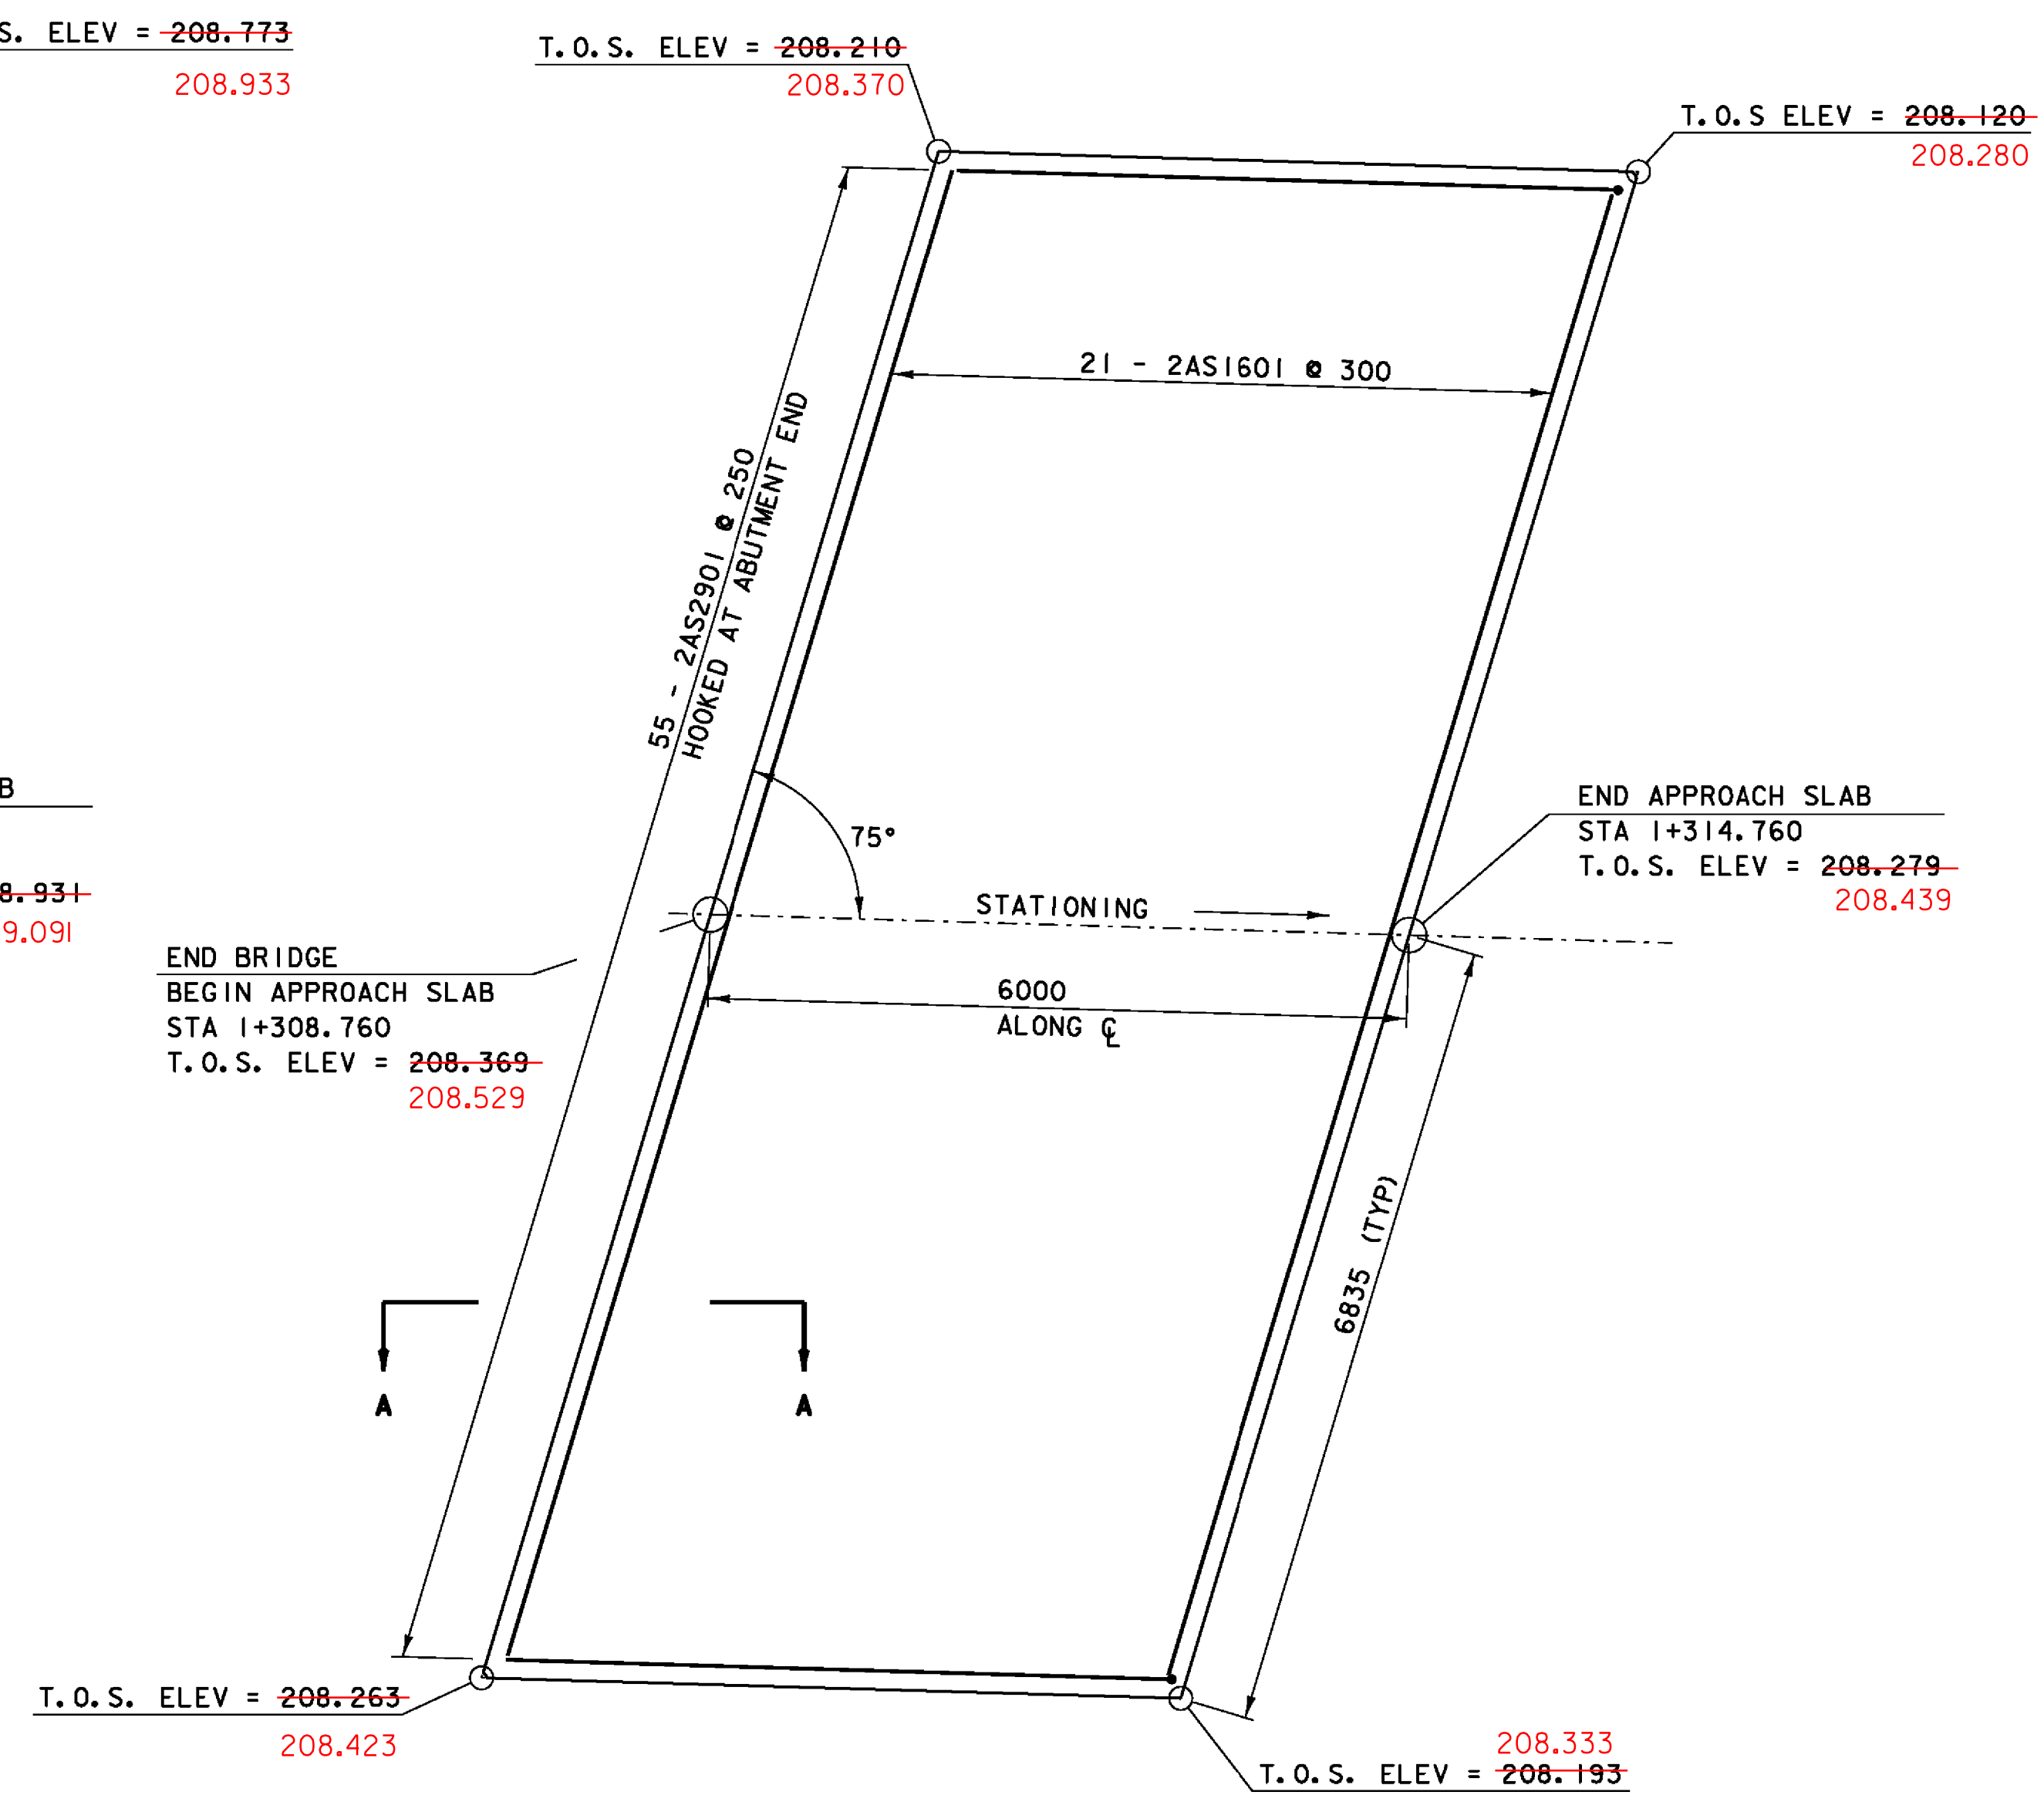

APPROACH SLAB #2 PLAN
 0 1 2 3 4 5
 SCALE = 1:50

SEE "CORNER DETAIL" ON DECK DETAIL SHEET FOR ACUTE ANGLE

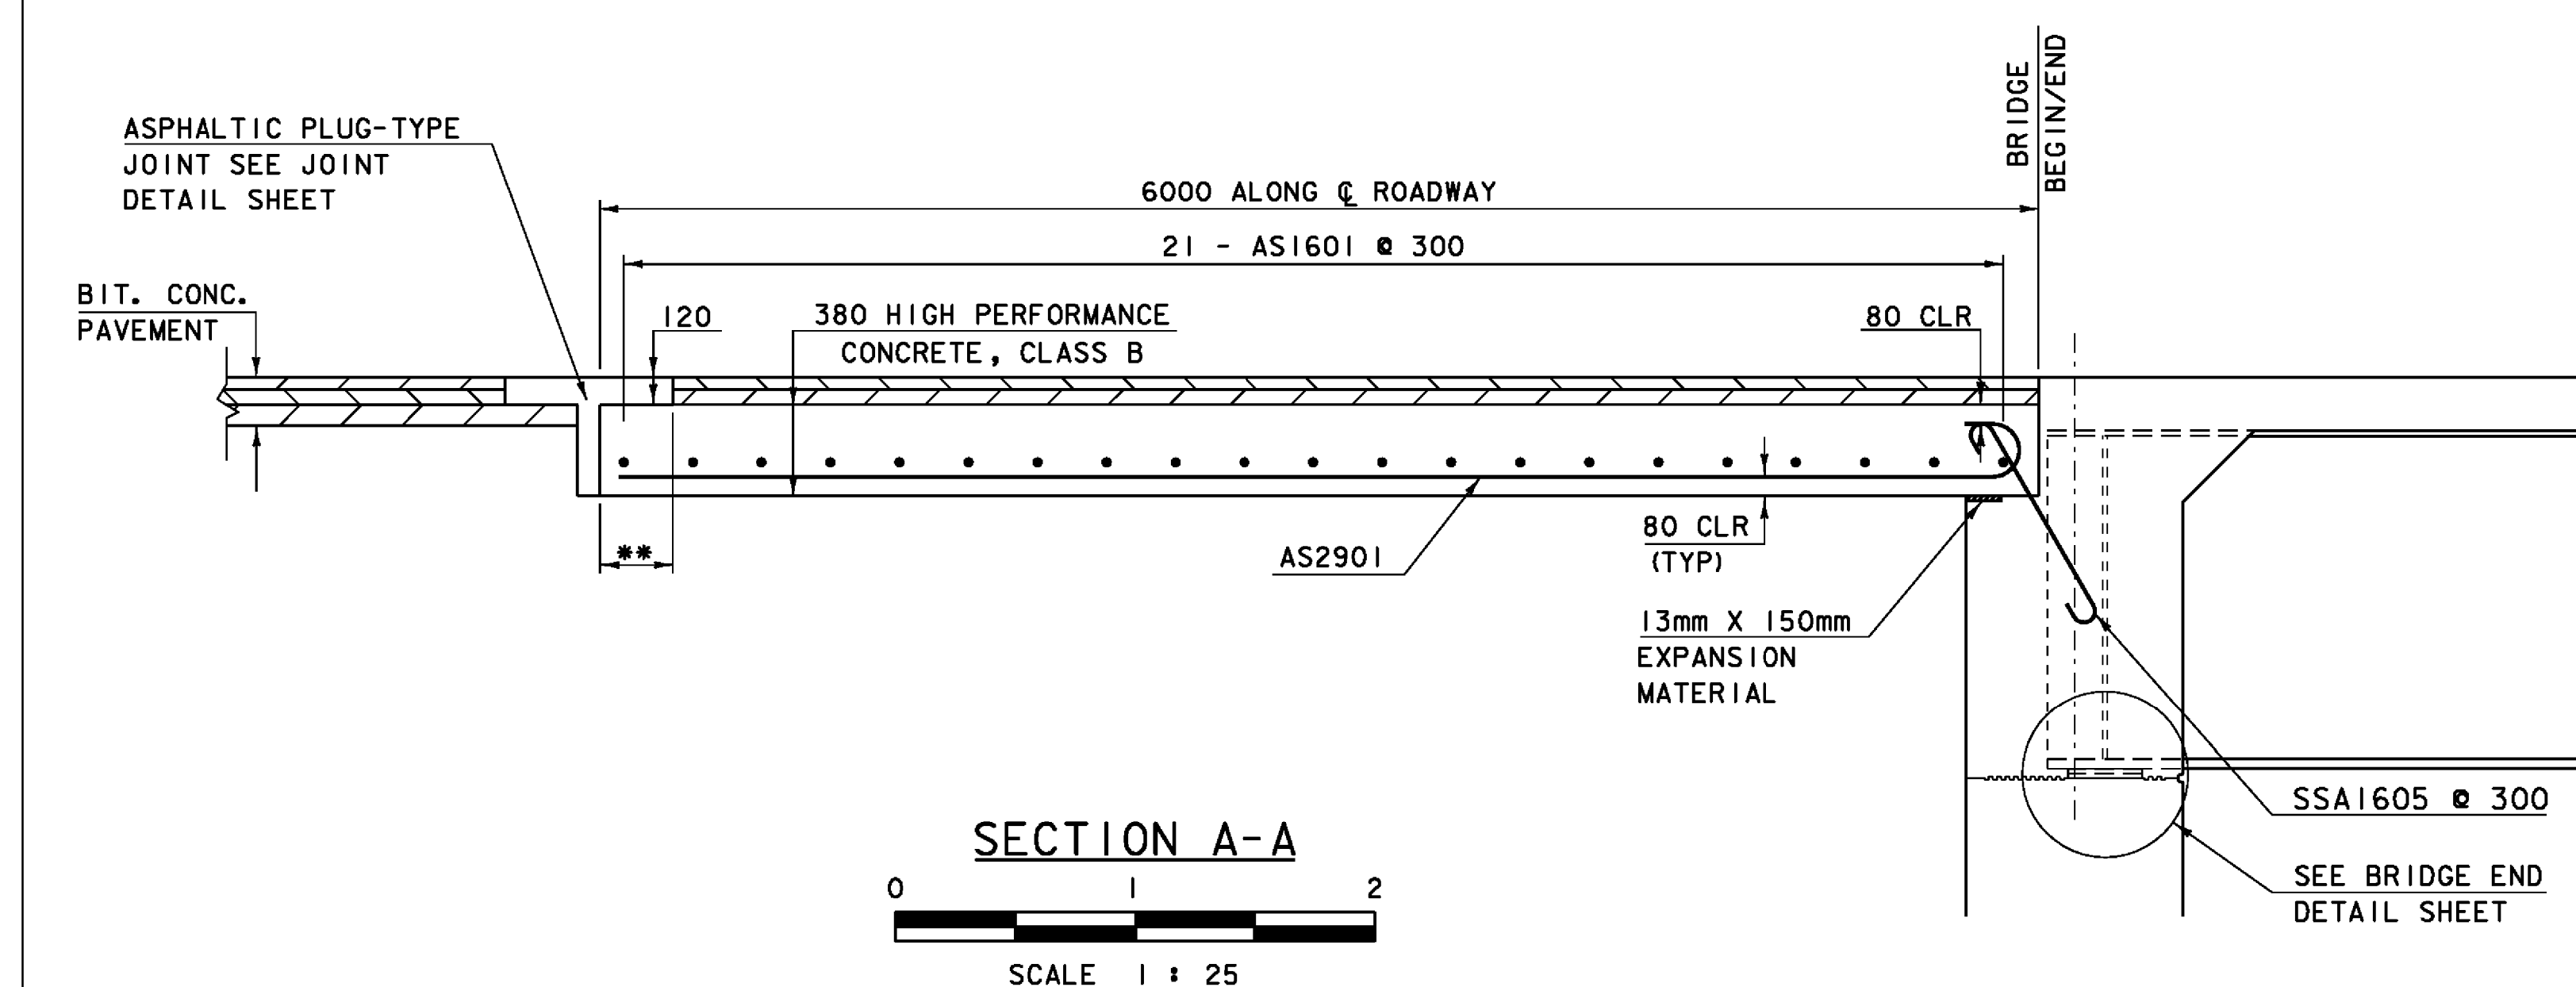

SECTION A-A
 0 1 2
 SCALE 1:25

** DISTANCES PER JOINT MANUFACTURER'S RECOMMENDATIONS. DESIGN BASED ON TEMPERATURE RANGE FROM -15°F TO 105°F, WITH 40 EXPANSION.

NOTE:
 NF = NEAR FACE
 FF = FAR FACE
 EF = EACH FACE
 ▲ = CUT TO FIT IN FIELD
 80 CLEAR, UNLESS OTHERWISE SPECIFIED ON THE PLANS.
 660 BAR LAP UNLESS OTHERWISE SPECIFIED ON THE PLANS.

PROJECT: EAST MONTPELIER	PROJECT NO. : BRF 028-3(36)
DESIGN FILE NAME: /98b254/str/sb254sup.dgn	PLOT DATE: 03-FEB-2009
IPARM FILE NAME: sb254asd.i	DRAWN BY: R. PELLETT
DESIGNED BY: J. LACROIX	CHECKED BY: J. LACROIX
SQUAD LEADER: K. HIGGINS	SHEET: 36 OF 68
APPROACH SLAB DETAILS	