




WINGWALL #2

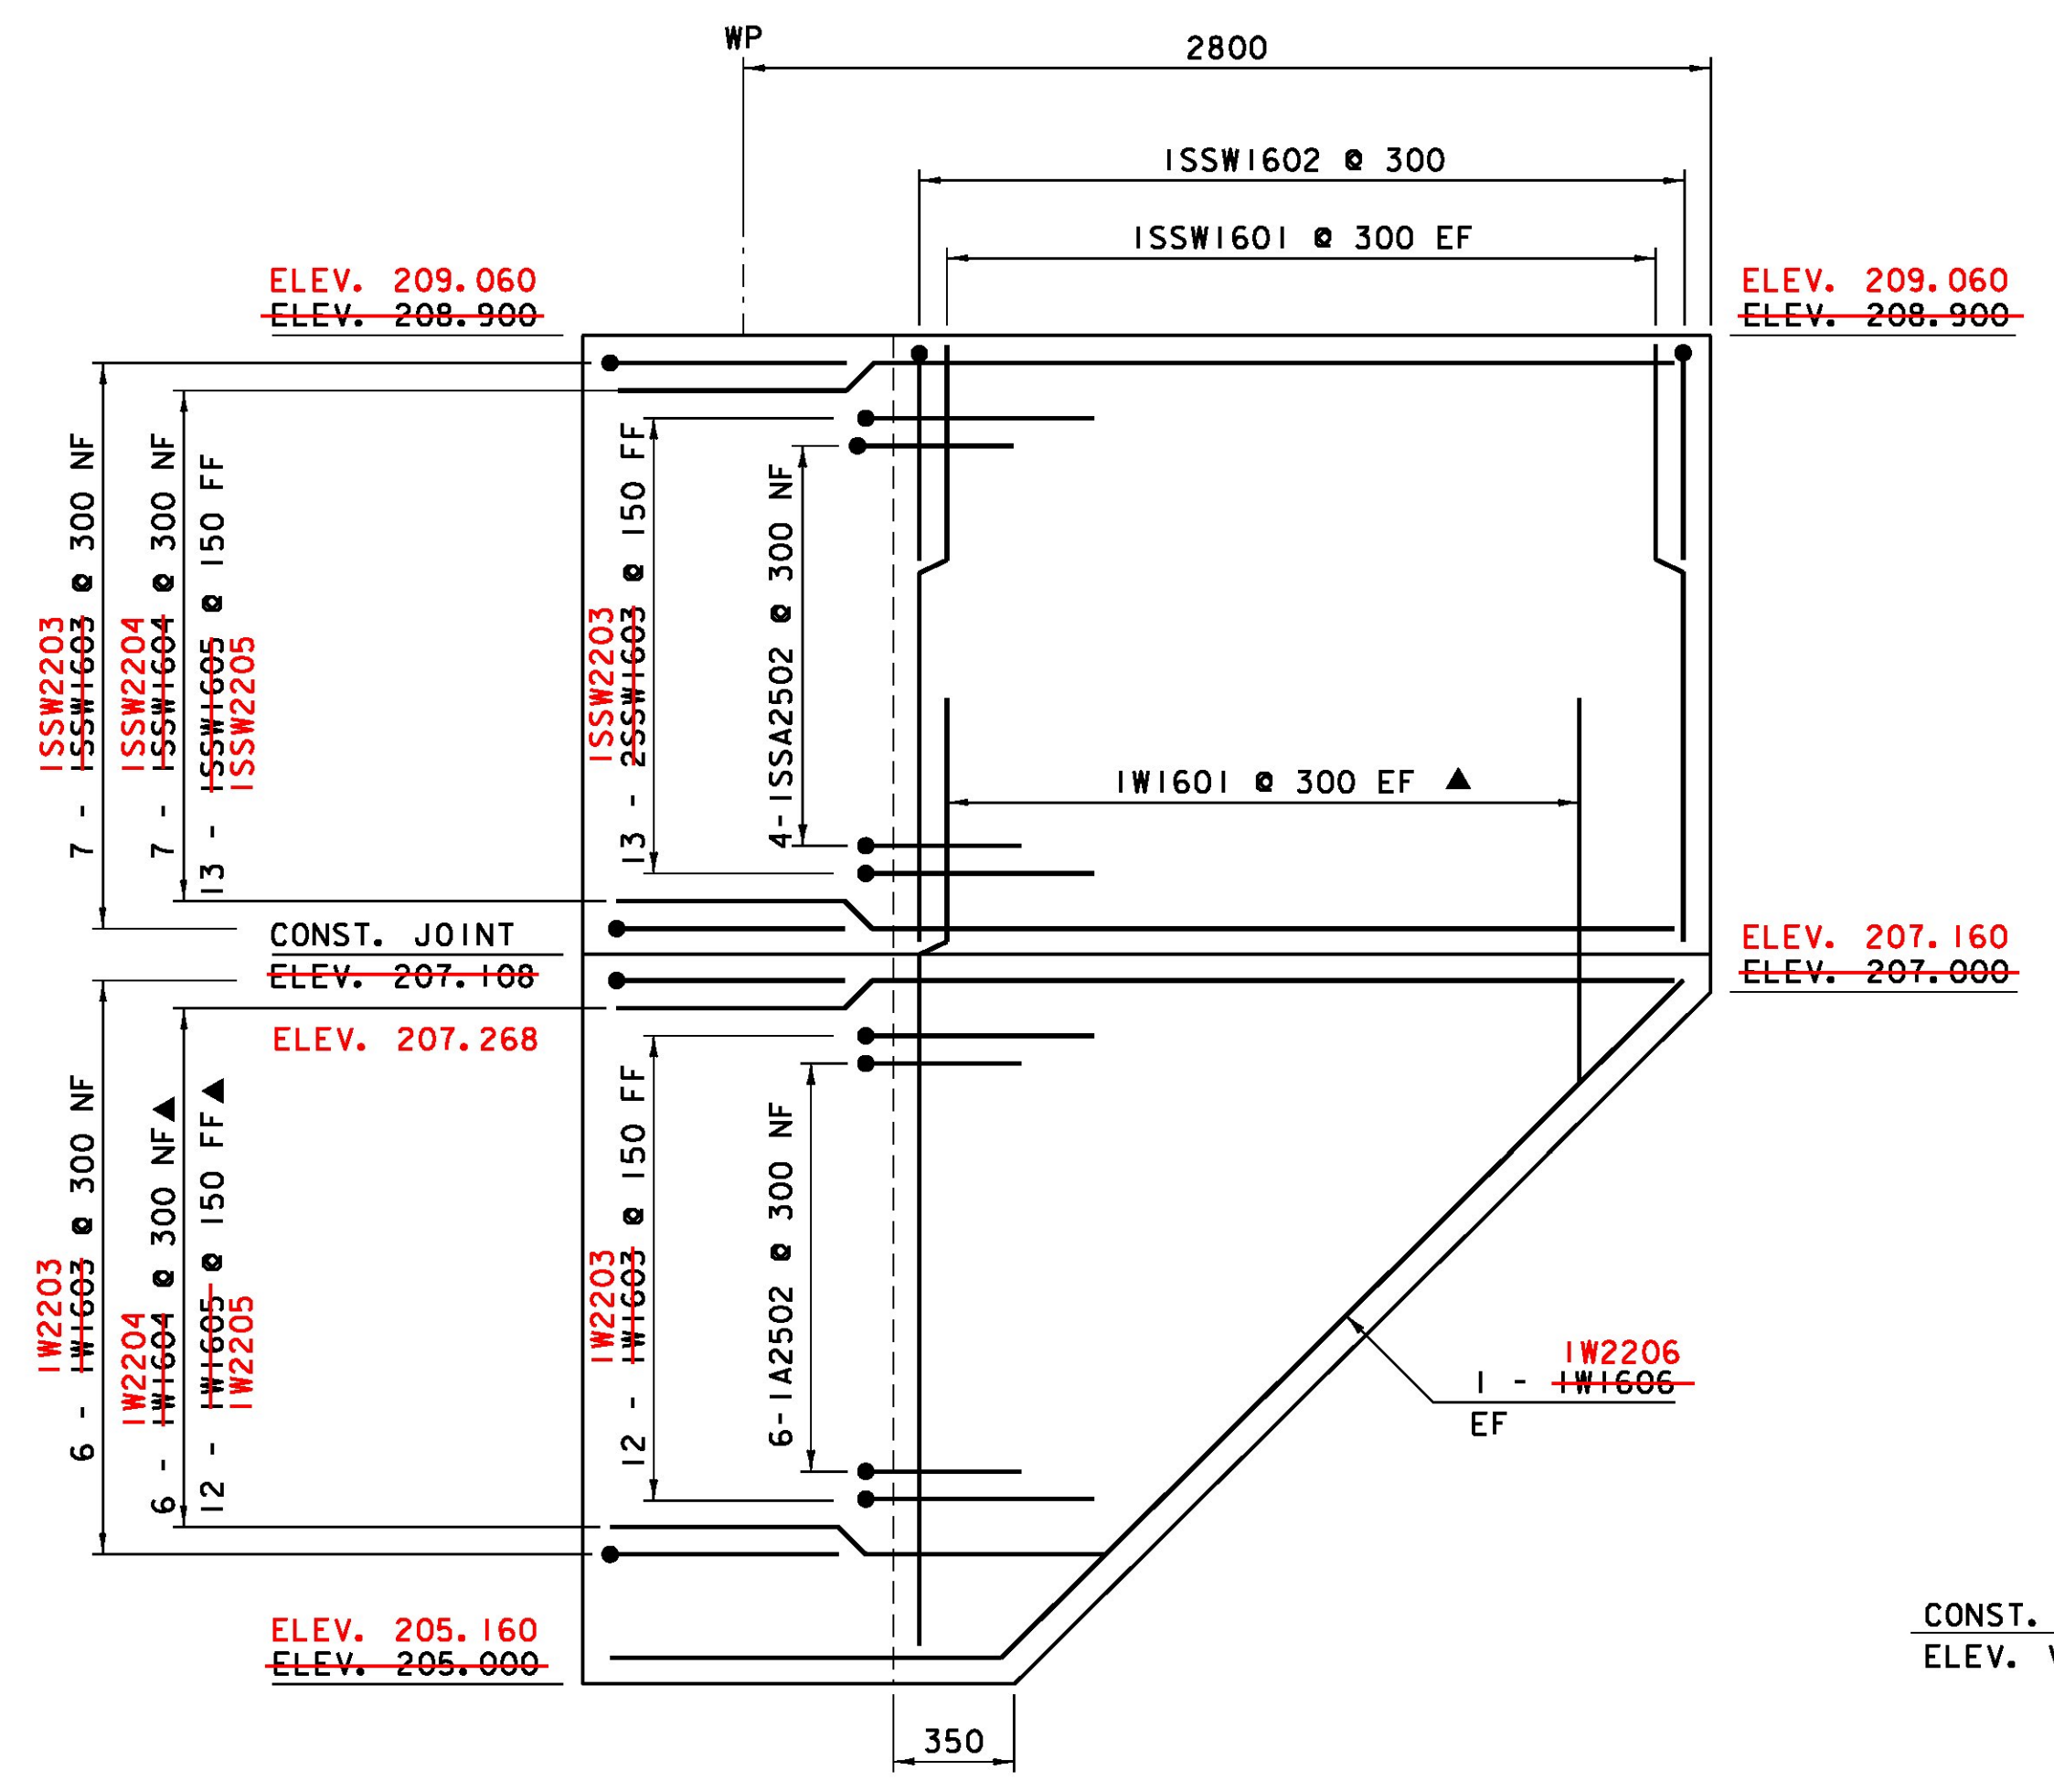


WINGWALL #1

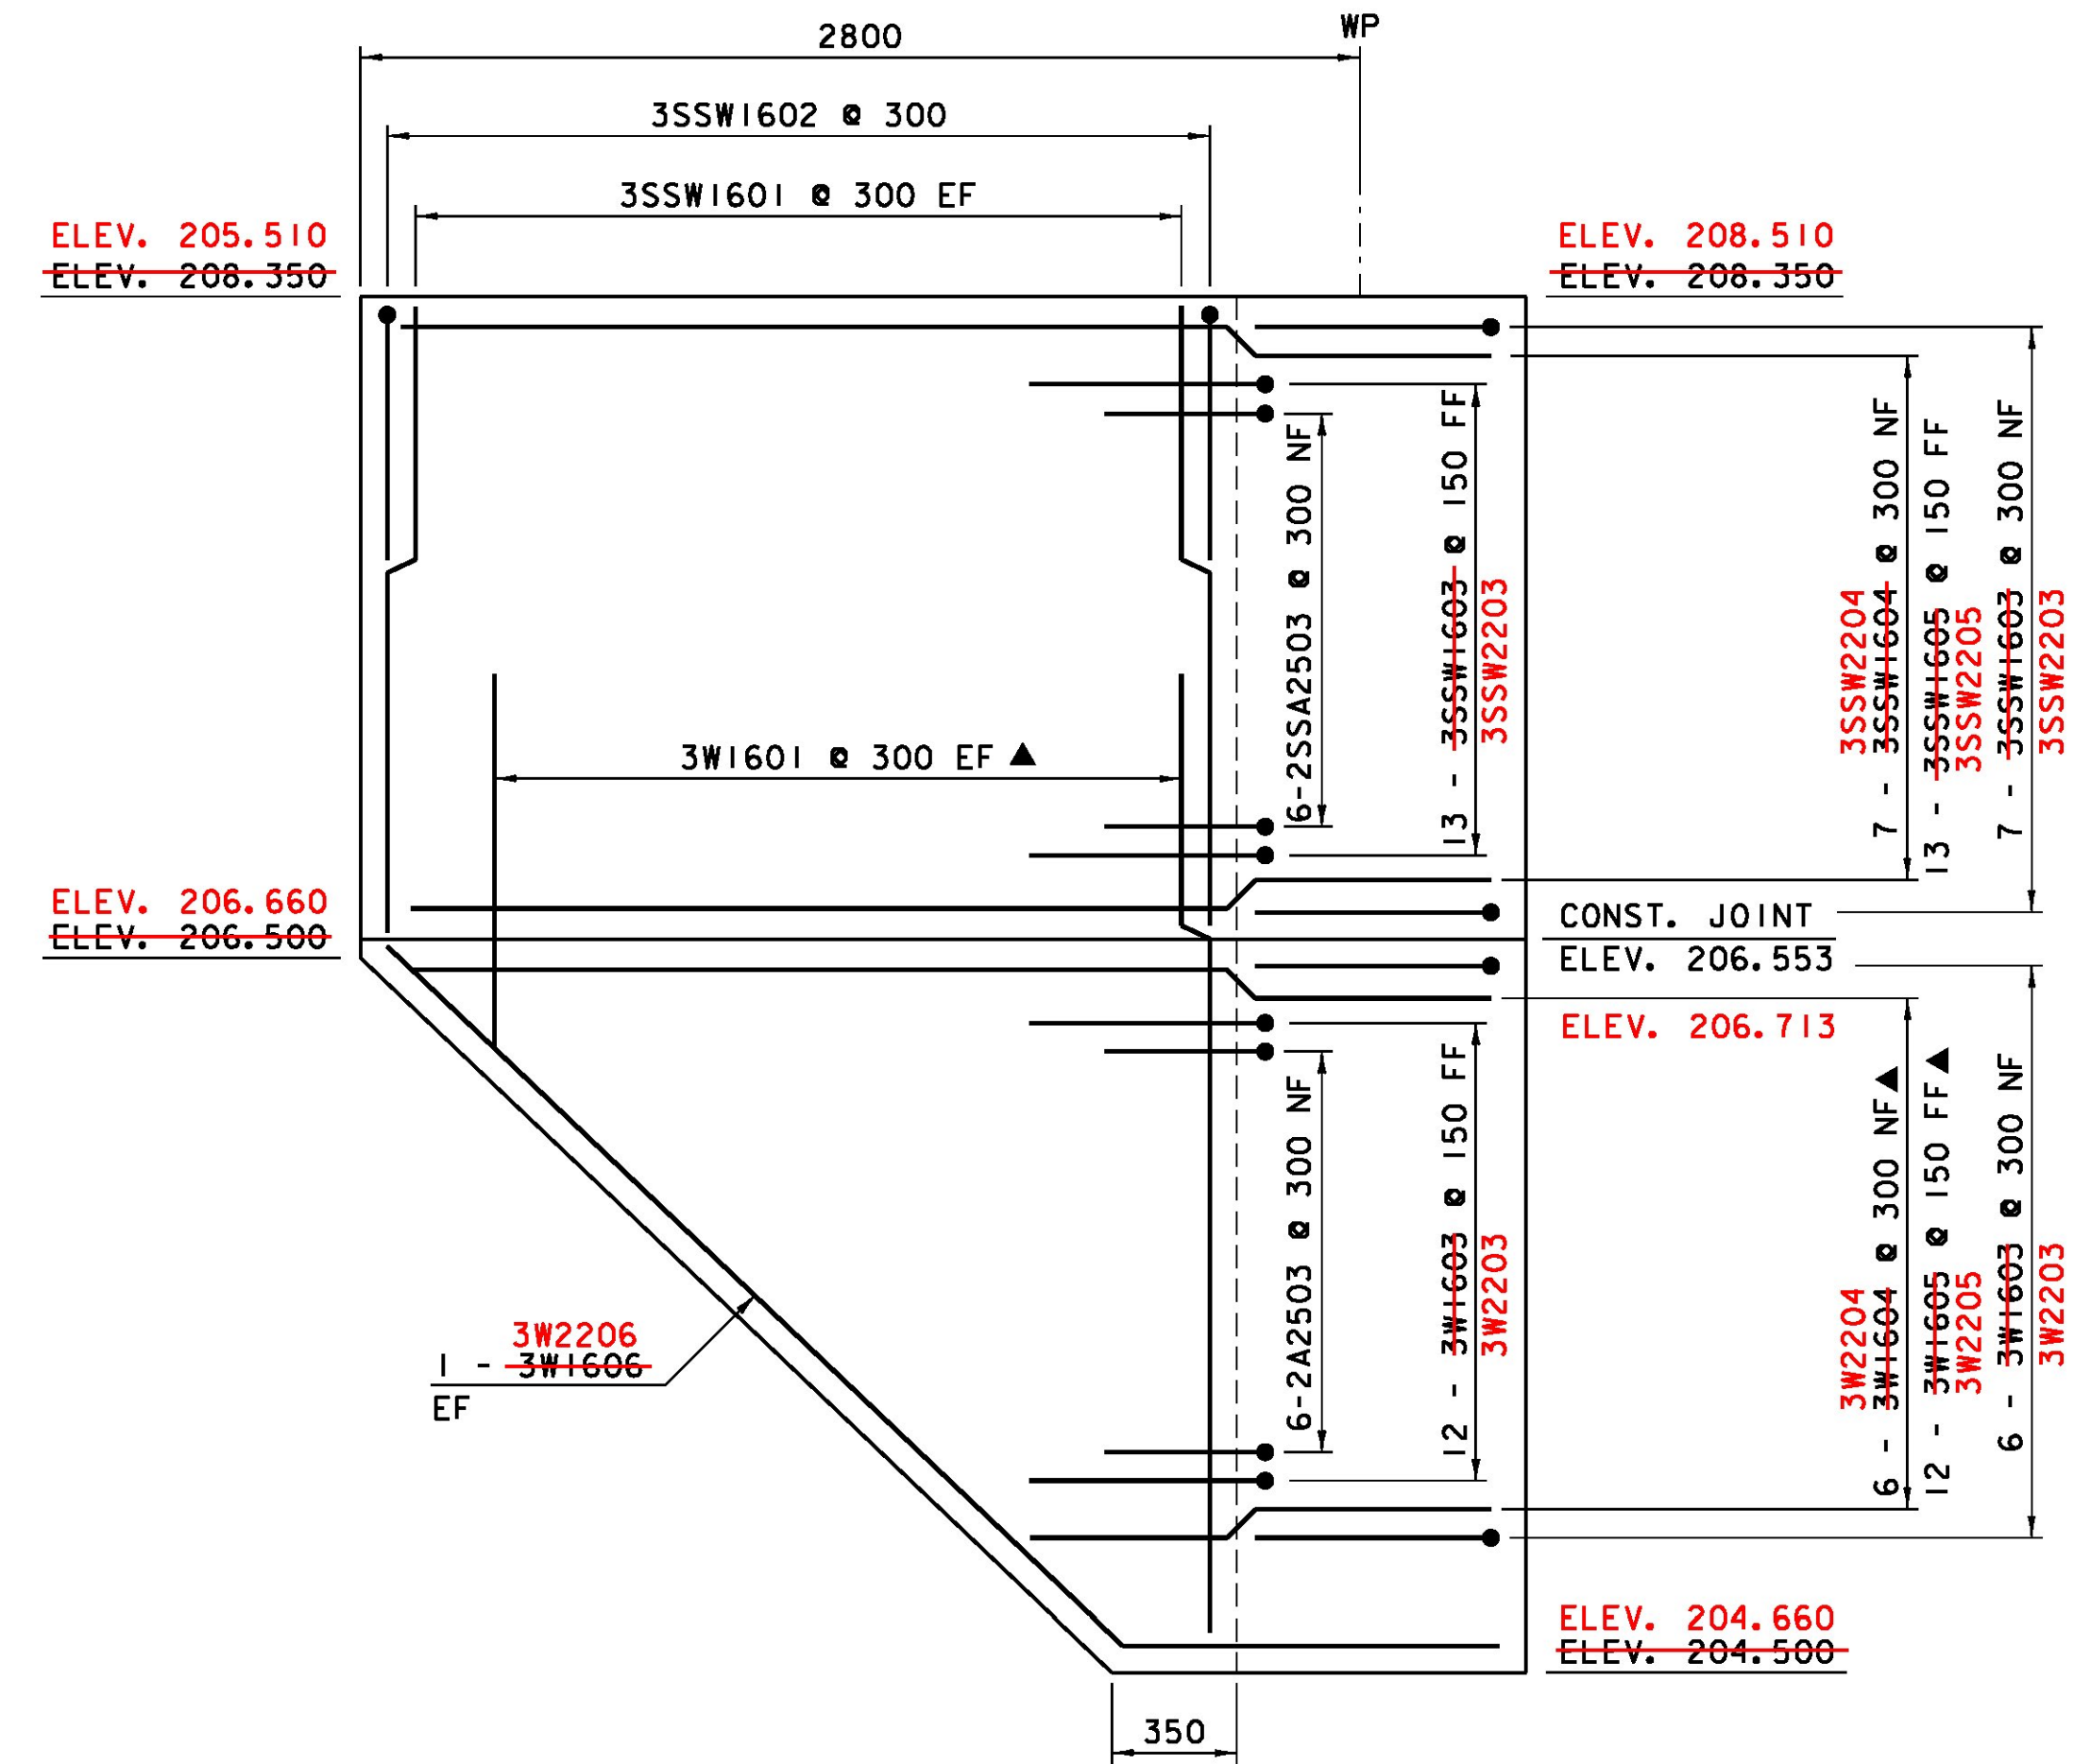

WINGWALL #3

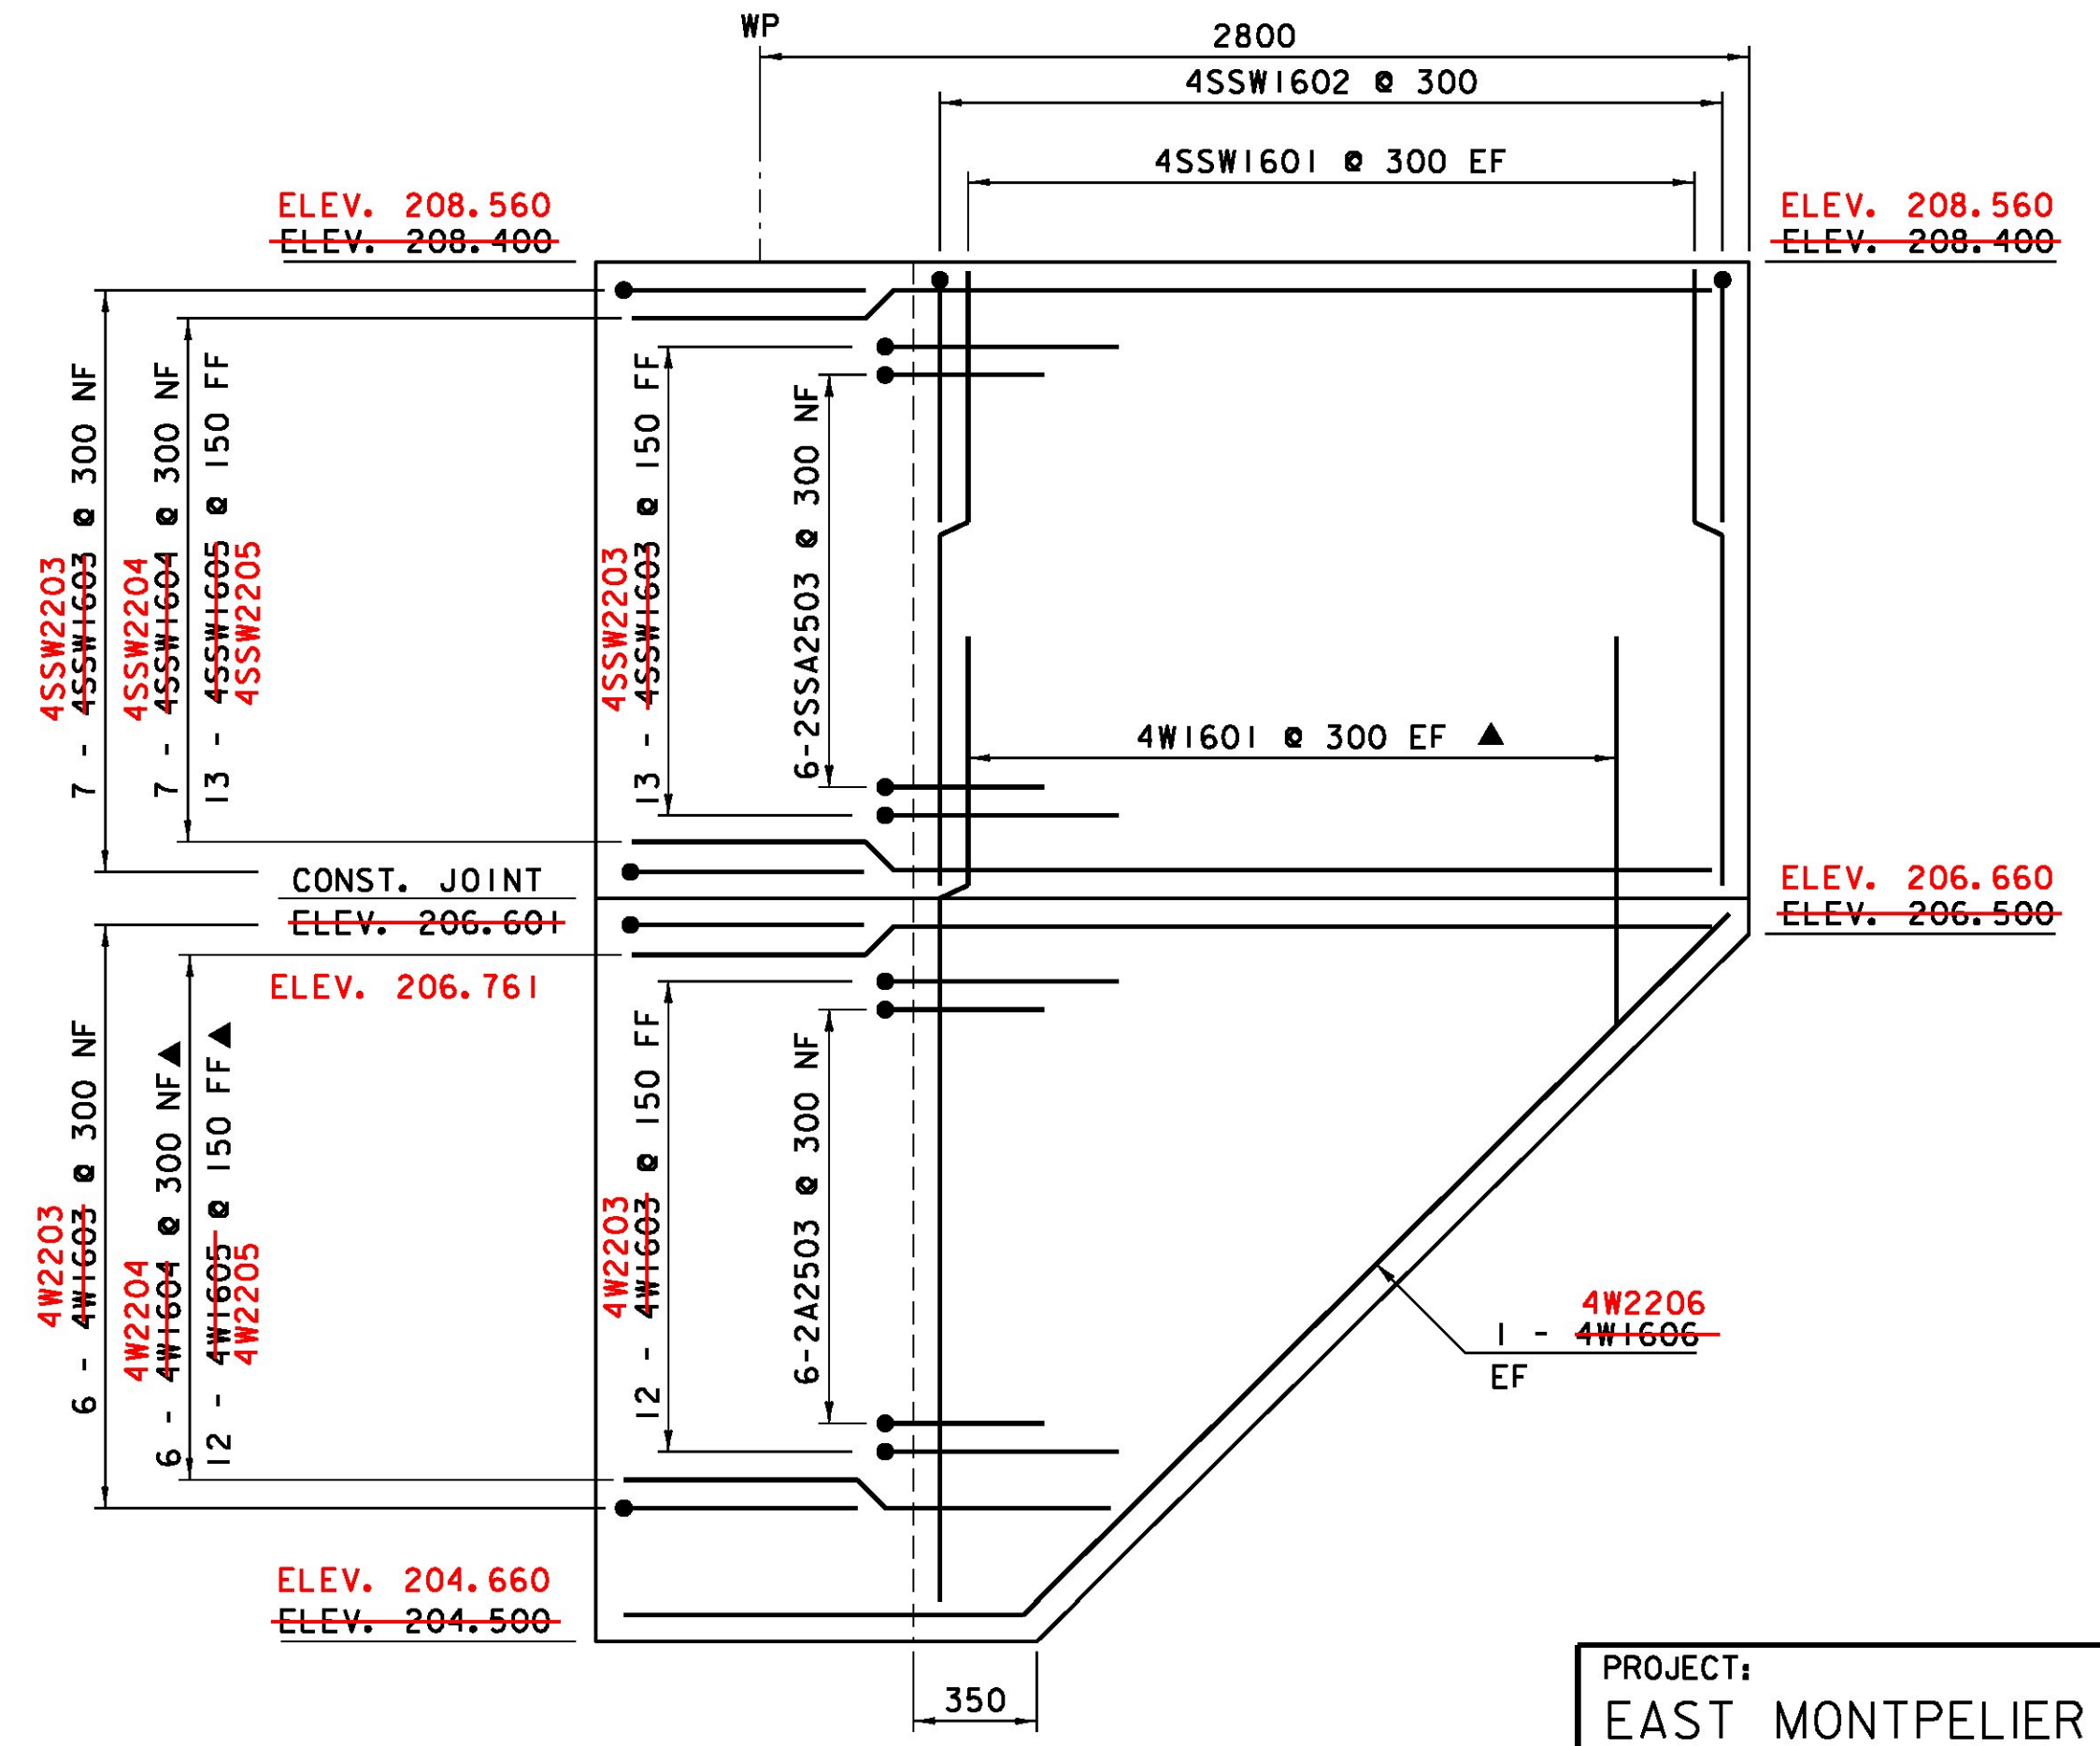


WINGWALL #4

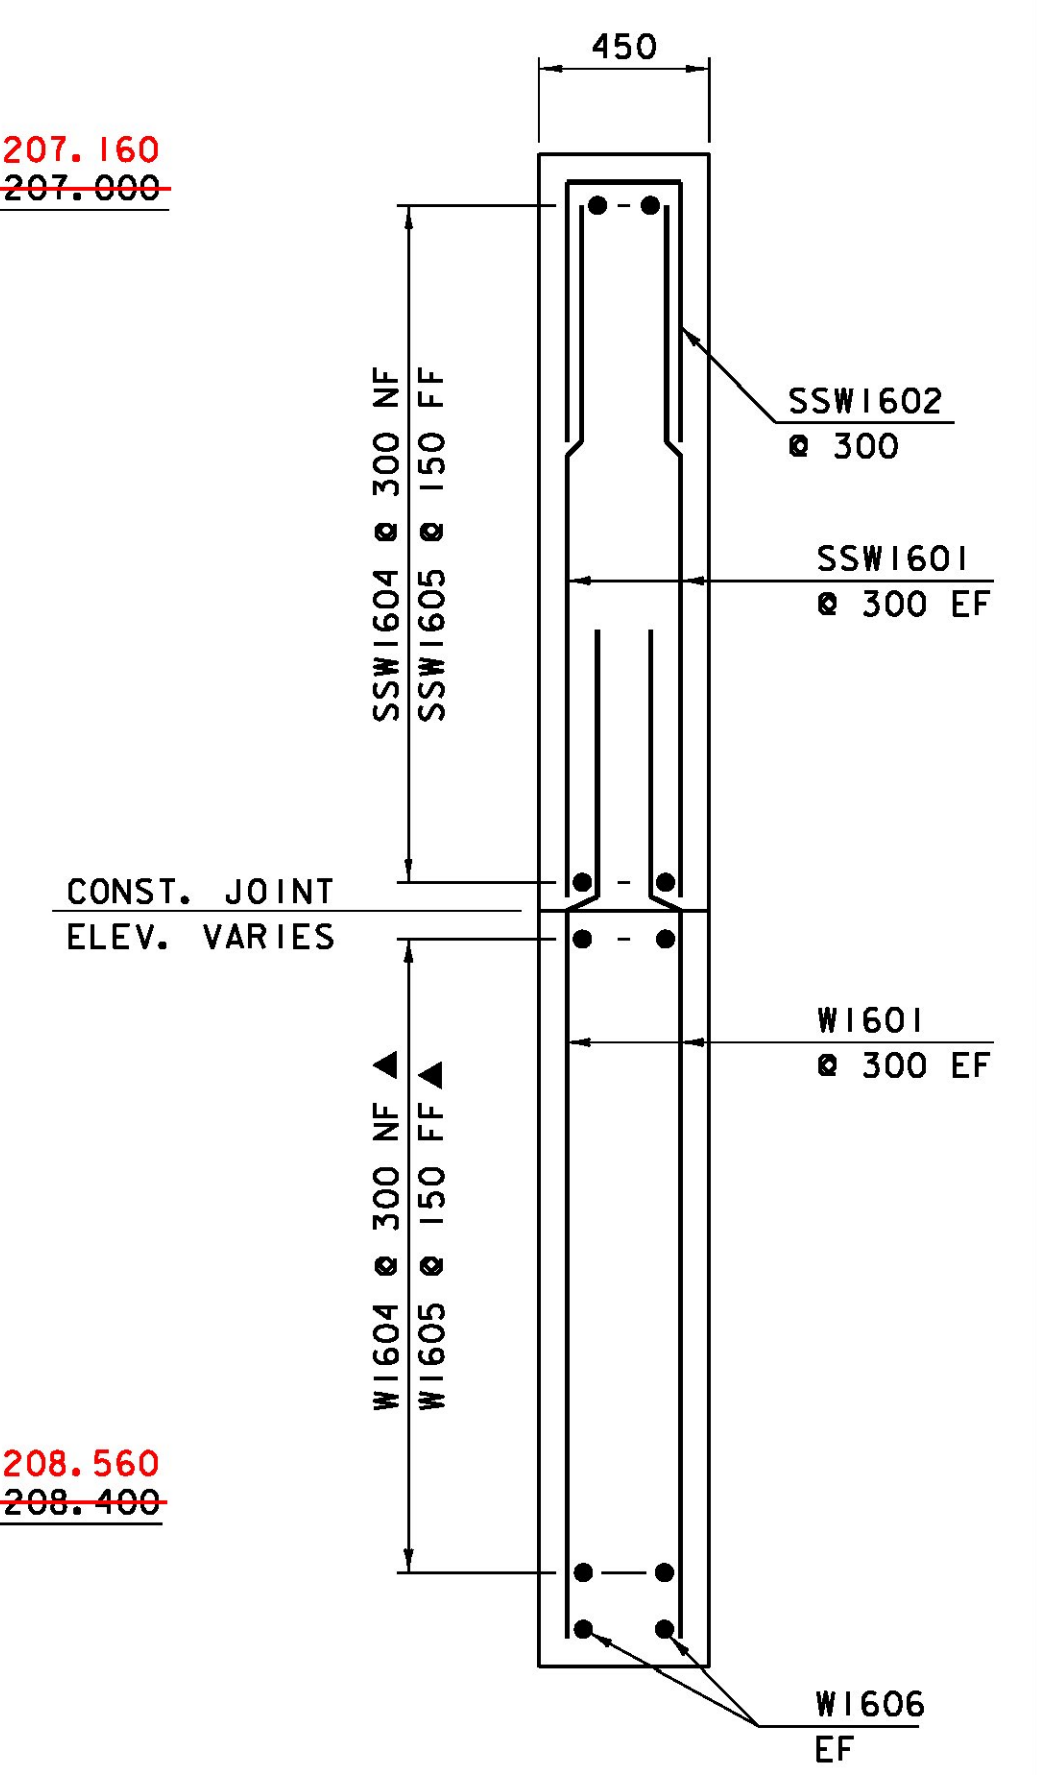

WINGWALL TYPICAL SECTION

NOTE:
 NF = NEAR FACE
 FF = FAR FACE
 EF = EACH FACE
 ▲ = CUT TO FIT IN FIELD
 80 CLEAR, UNLESS OTHERWISE SPECIFIED ON THE PLANS.
 660 BAR LAP UNLESS OTHERWISE SPECIFIED ON THE PLANS.

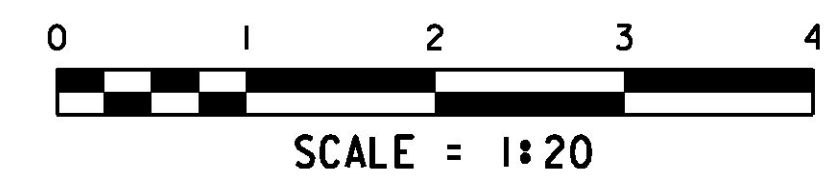

PROJECT: EAST MONTPELIER	PROJECT NO. 1: BRF 028-3(36)
DESIGN FILE NAME: /98b254/str/sb254sub.dgn	PLOT DATE: 10-JUL-2009 01
IPARM FILE NAME: sb254ww.i	DRAWN BY: R. PELLET
DESIGNED BY: J. LACROIX	CHECKED BY: J. LACROIX
SQUAD LEADER: K. HIGGINS	SHEET: \$S*\$ OF \$T*\$
WINGWALLS	