



ABUTMENT #1 PLAN
SCALE = 1:40

SEE "CORNER DETAIL" ON DECK DETAILS SHEET FOR ACUTE ANGLE

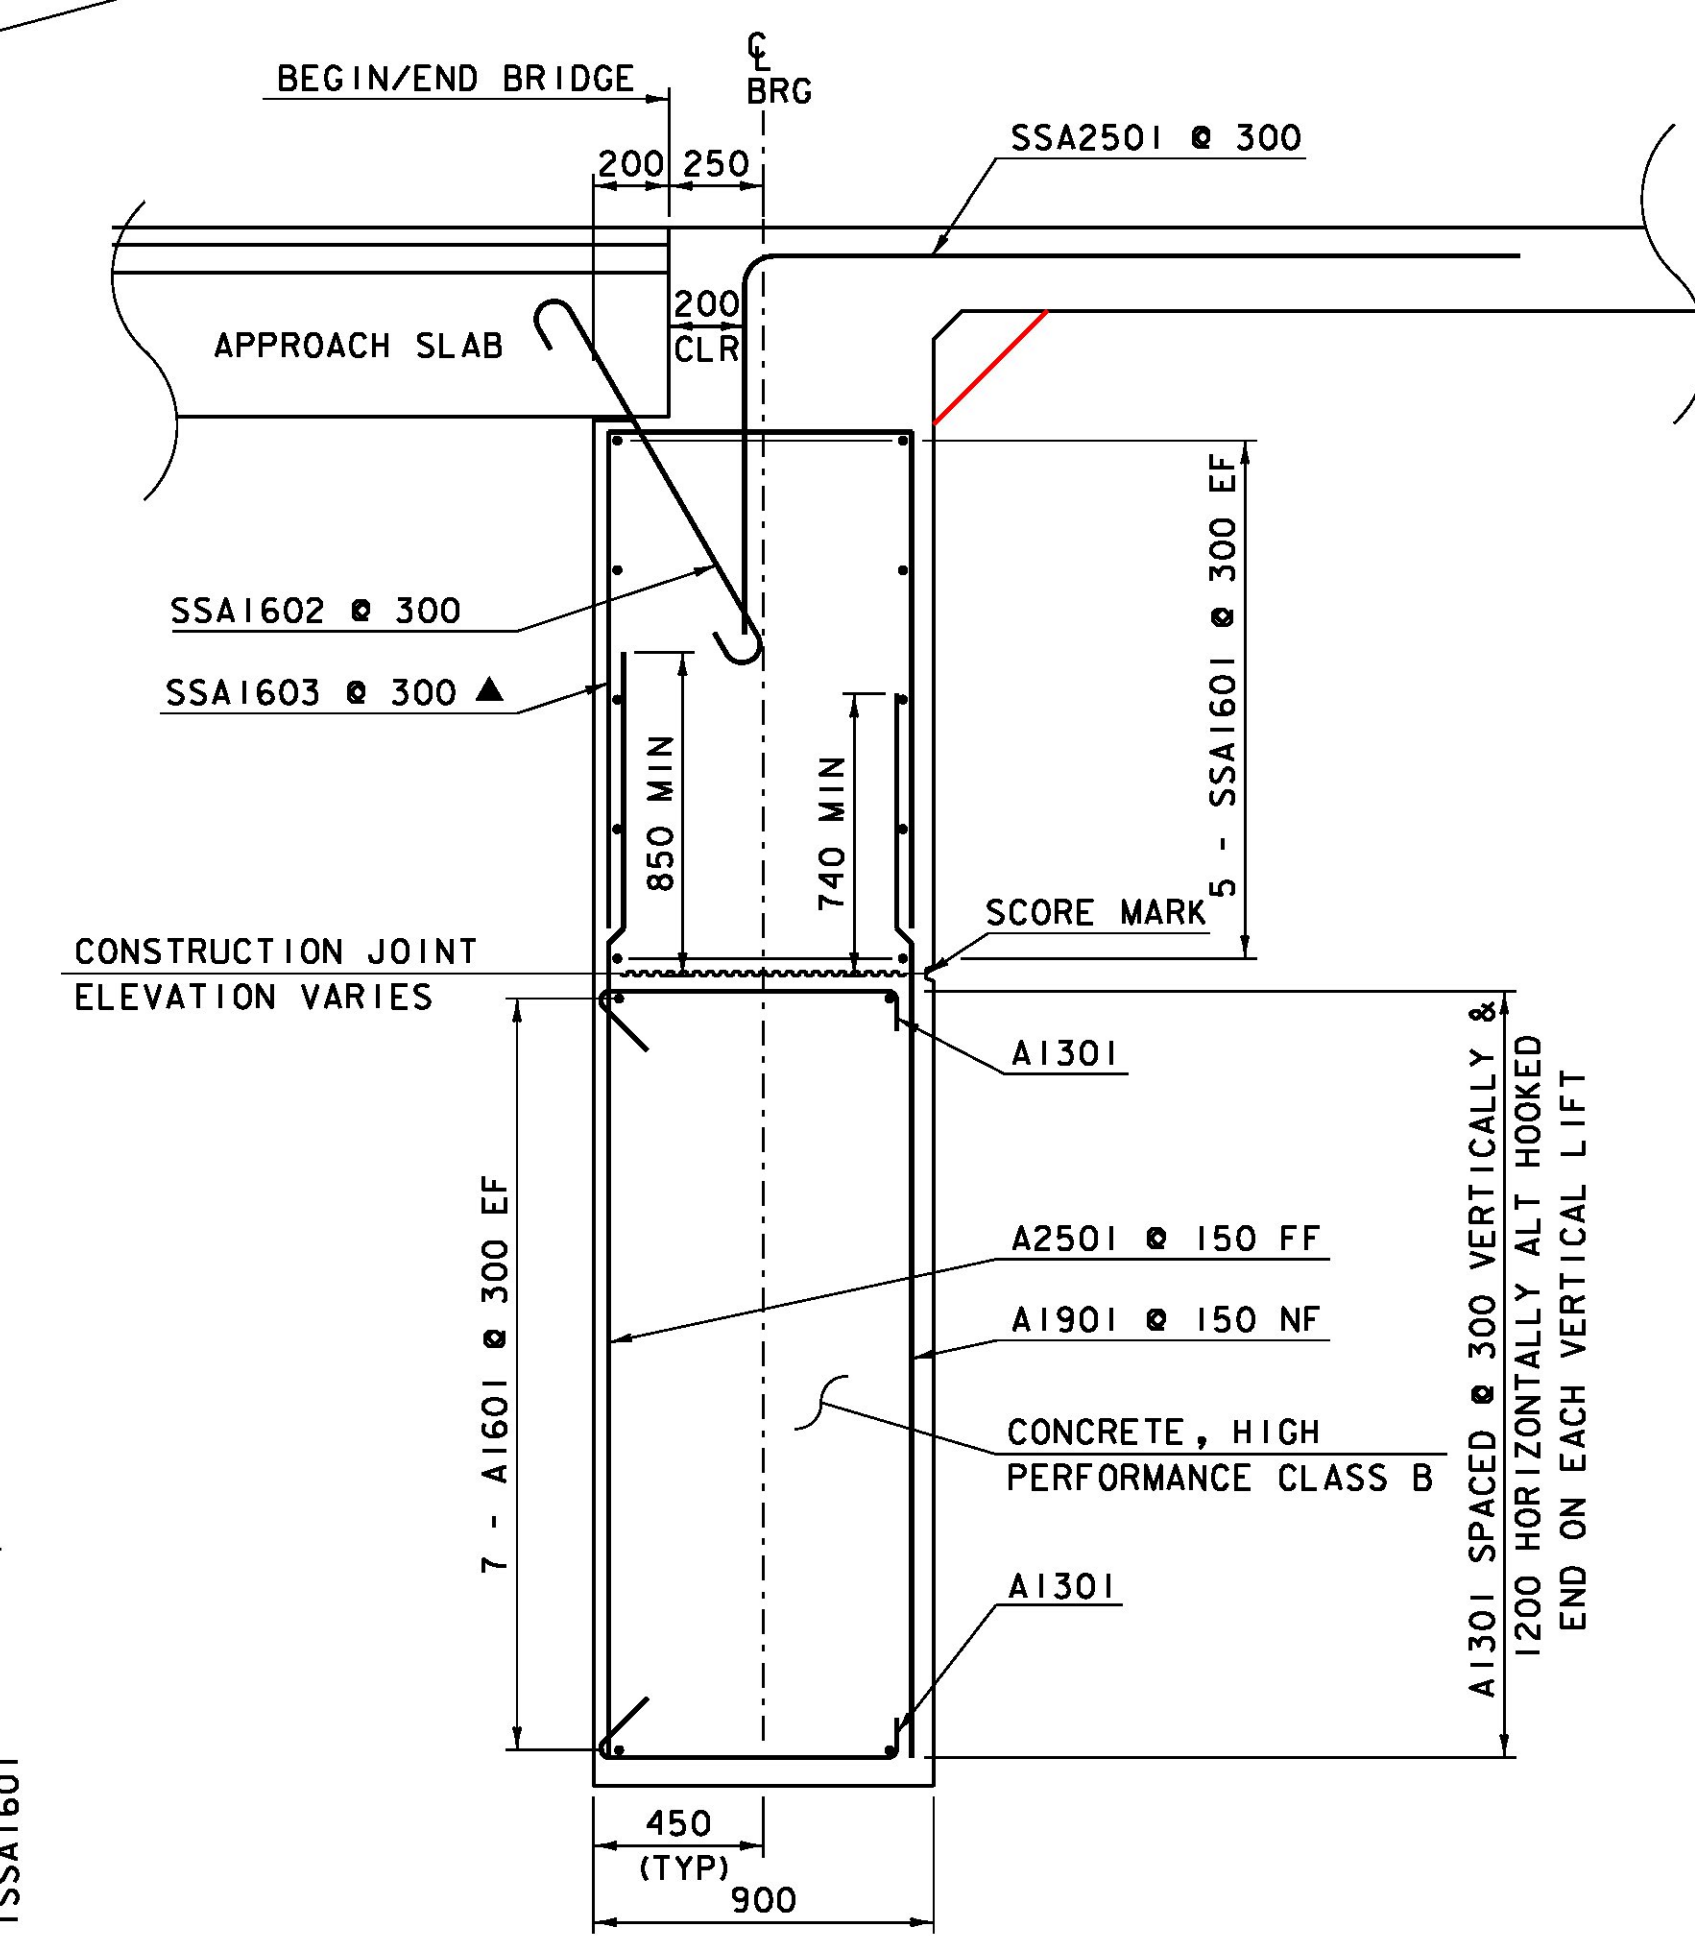

SECTION "A-A"


BRIDGE END DETAIL AND ABUTMENT TYPICAL SECTION
SCALE = 1:10

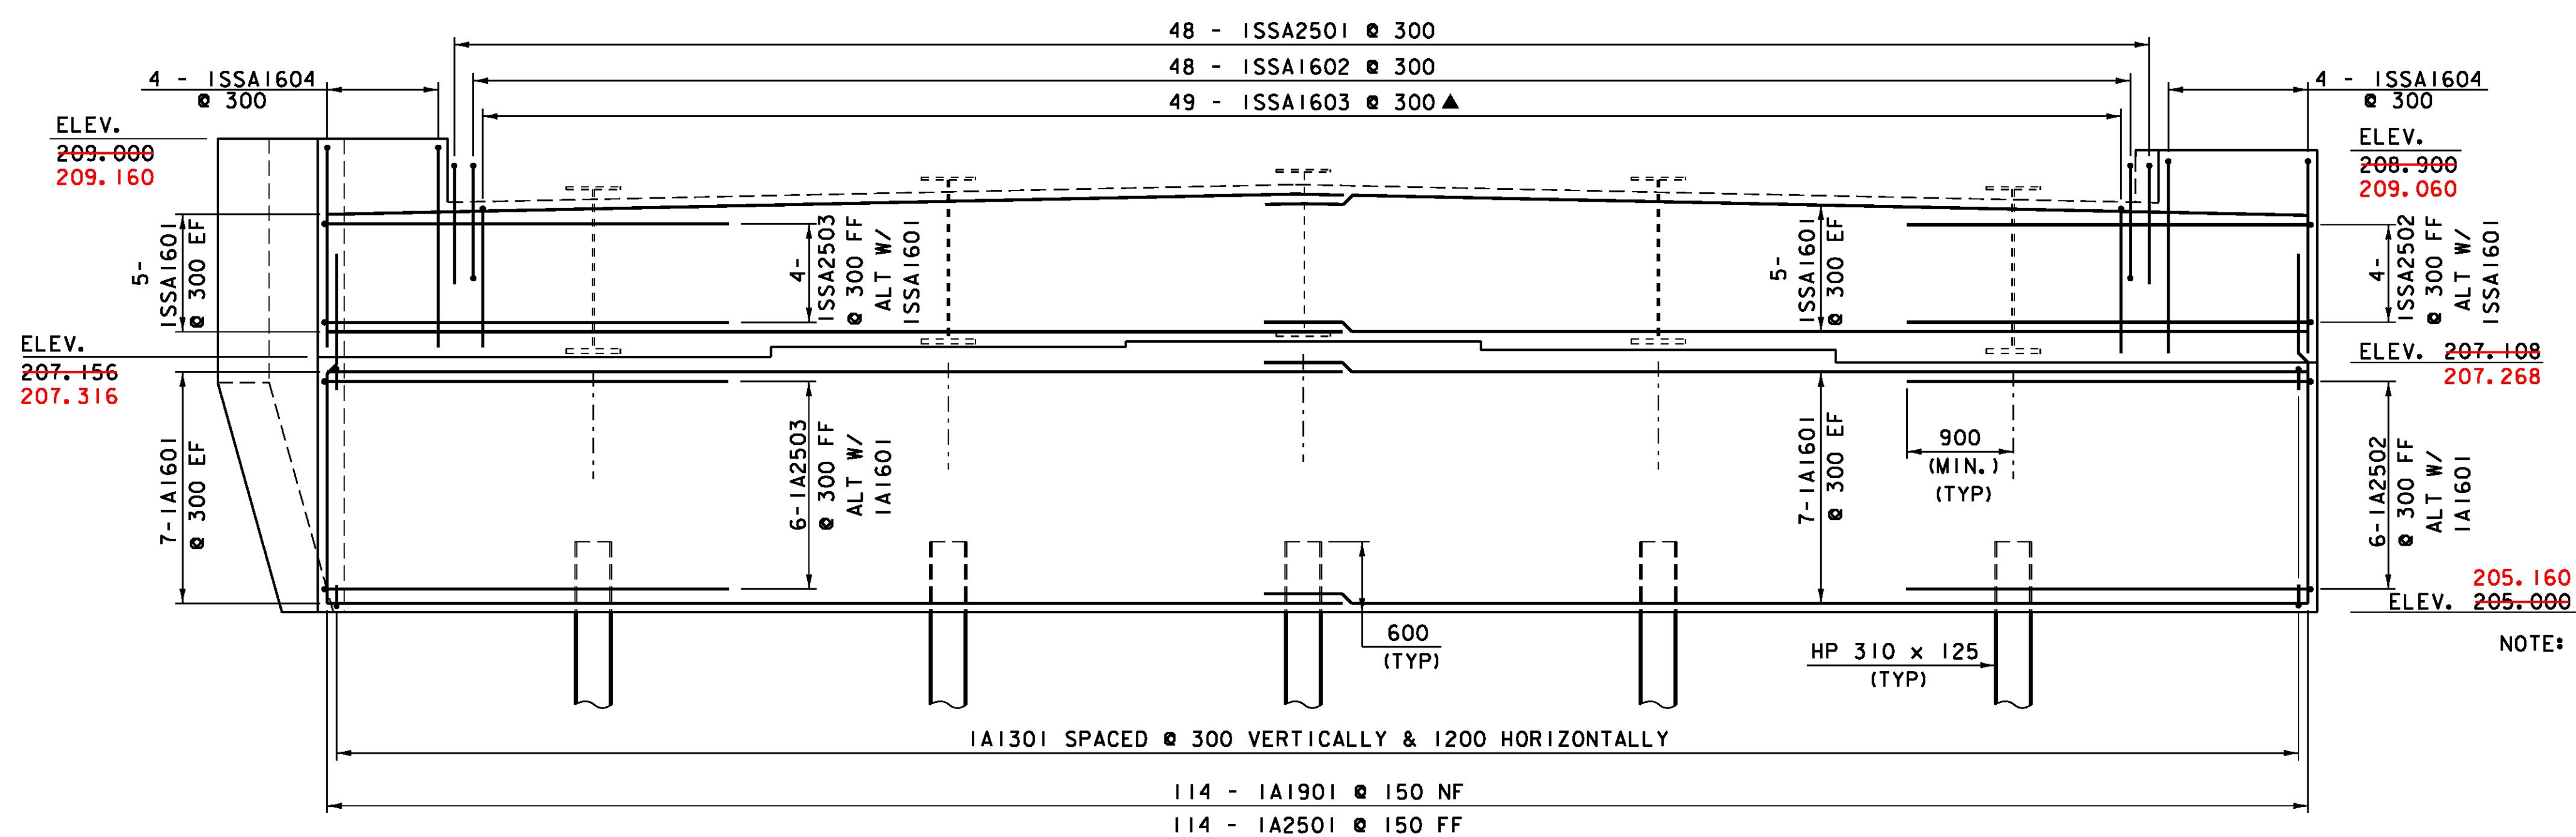

ABUTMENT #1 ELEVATION
SCALE = 1:40

NOTE: BRIDGE SEATS REQUIRE A MINIMUM 500X500 LEVEL SURFACE CENTERED ABOUT THE C OF THE BEARING STIFFENER AND C OF EACH GIRDER. ALTERNATE FORMING CONFIGURATIONS MAY BE APPROVED BY THE RESIDENT ENGINEER.

NOTE:
NF = NEAR FACE
FF = FAR FACE
EF = EACH FACE
▲ = CUT TO FIT IN FIELD
80 CLEAR, UNLESS OTHERWISE SPECIFIED ON THE PLANS.
660 BAR LAP UNLESS OTHERWISE SPECIFIED ON THE PLANS.

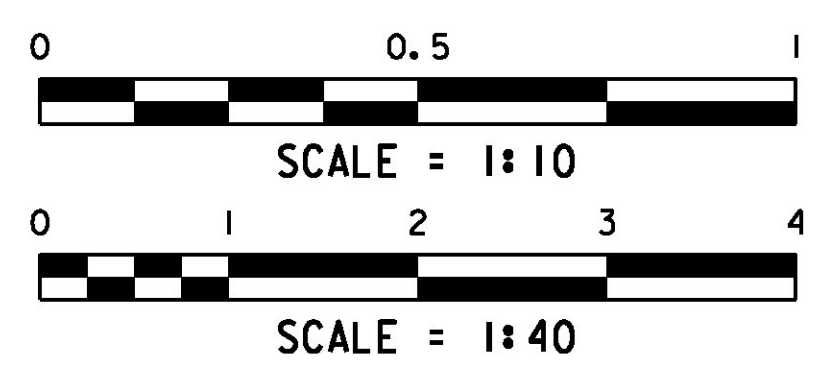

PROJECT: EAST MONTPELIER	PROJECT NO. 1: BRF 028-3(36)
DESIGN FILE NAME: /98b254/str/sb254sub.dgn	PLOT DATE: 10-JUL-2009 01
IPARM FILE NAME: sb254abi.i	DRAWN BY: R. PELLETT
DESIGNED BY: J. LACROIX	CHECKED BY: J. LACROIX
SQUAD LEADER: K. HIGGINS	SHEET: *S* OF *T*#
ABUTMENT #1	