

TO ROW SHEET 19 OF 20  
MATCHLINE I+340.000


END ROW PROJECT  
BRF 028-3 (36) SC I+448.31 CL

FOR EROSION CONTROL DETAILS  
SEE ROW SHEET 14 & 15 OF 20

LINES SHOWN ON THIS PLAN AS EXISTING  
PROPERTY LINES P/L ARE BELIEVED TO  
BE ACCURATE BUT SHOULD NOT BE RELIED  
UPON FOR PURPOSES UNRELATED TO THE  
STATE OF VERMONT'S ACQUISITION OF LAND  
AND RIGHTS FOR THIS PROJECT.

**FOR R.O.W.  
USE ONLY**

- COLD PLANING  
I+380 to I+400
- REMOVAL AND DISPOSAL  
OF EXISTING GUARDRAIL  
I+340 Rt. - I+368 Rt.  
I+340 Lt. - I+383 Lt.
- BOX BEAM GUARDRAIL  
I+340.00 Lt. to I+384.82 Lt.  
I+340.00 Rt. to I+366.41 Rt.
- CONSTRUCT GRAVEL DRIVE W/ 1500 PAVED APRON  
I+390.0 Lt. - GRAVEL  
I+423.0 Rt. - GRAVEL (GRAVEL DRIVE SHALL  
BE CONSTRUCTED PRIOR TO  
TEMPORARY DETOUR)
- REMOVE DRIVE  
I+374 Rt.

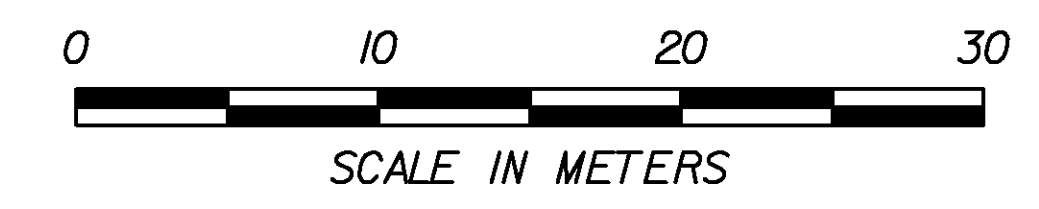

**PLAN SHEET**

PROJECT NAME:	EAST MONTPELIER
PROJECT NUMBER:	BRF 028-3 (36)
FILE NAME: /str5/98b254/sb254bdr.dgn	PLOT DATE: 03-FEB-2009
PROJECT LEADER: K. HIGGINS	DRAWN BY: R. PELLETT
DESIGNED BY: J. LACROIX	CHECKED BY: J. LACROIX
R.O.W. SHEET 20 OF 20 SHEETS	SHEET 55 OF 68