

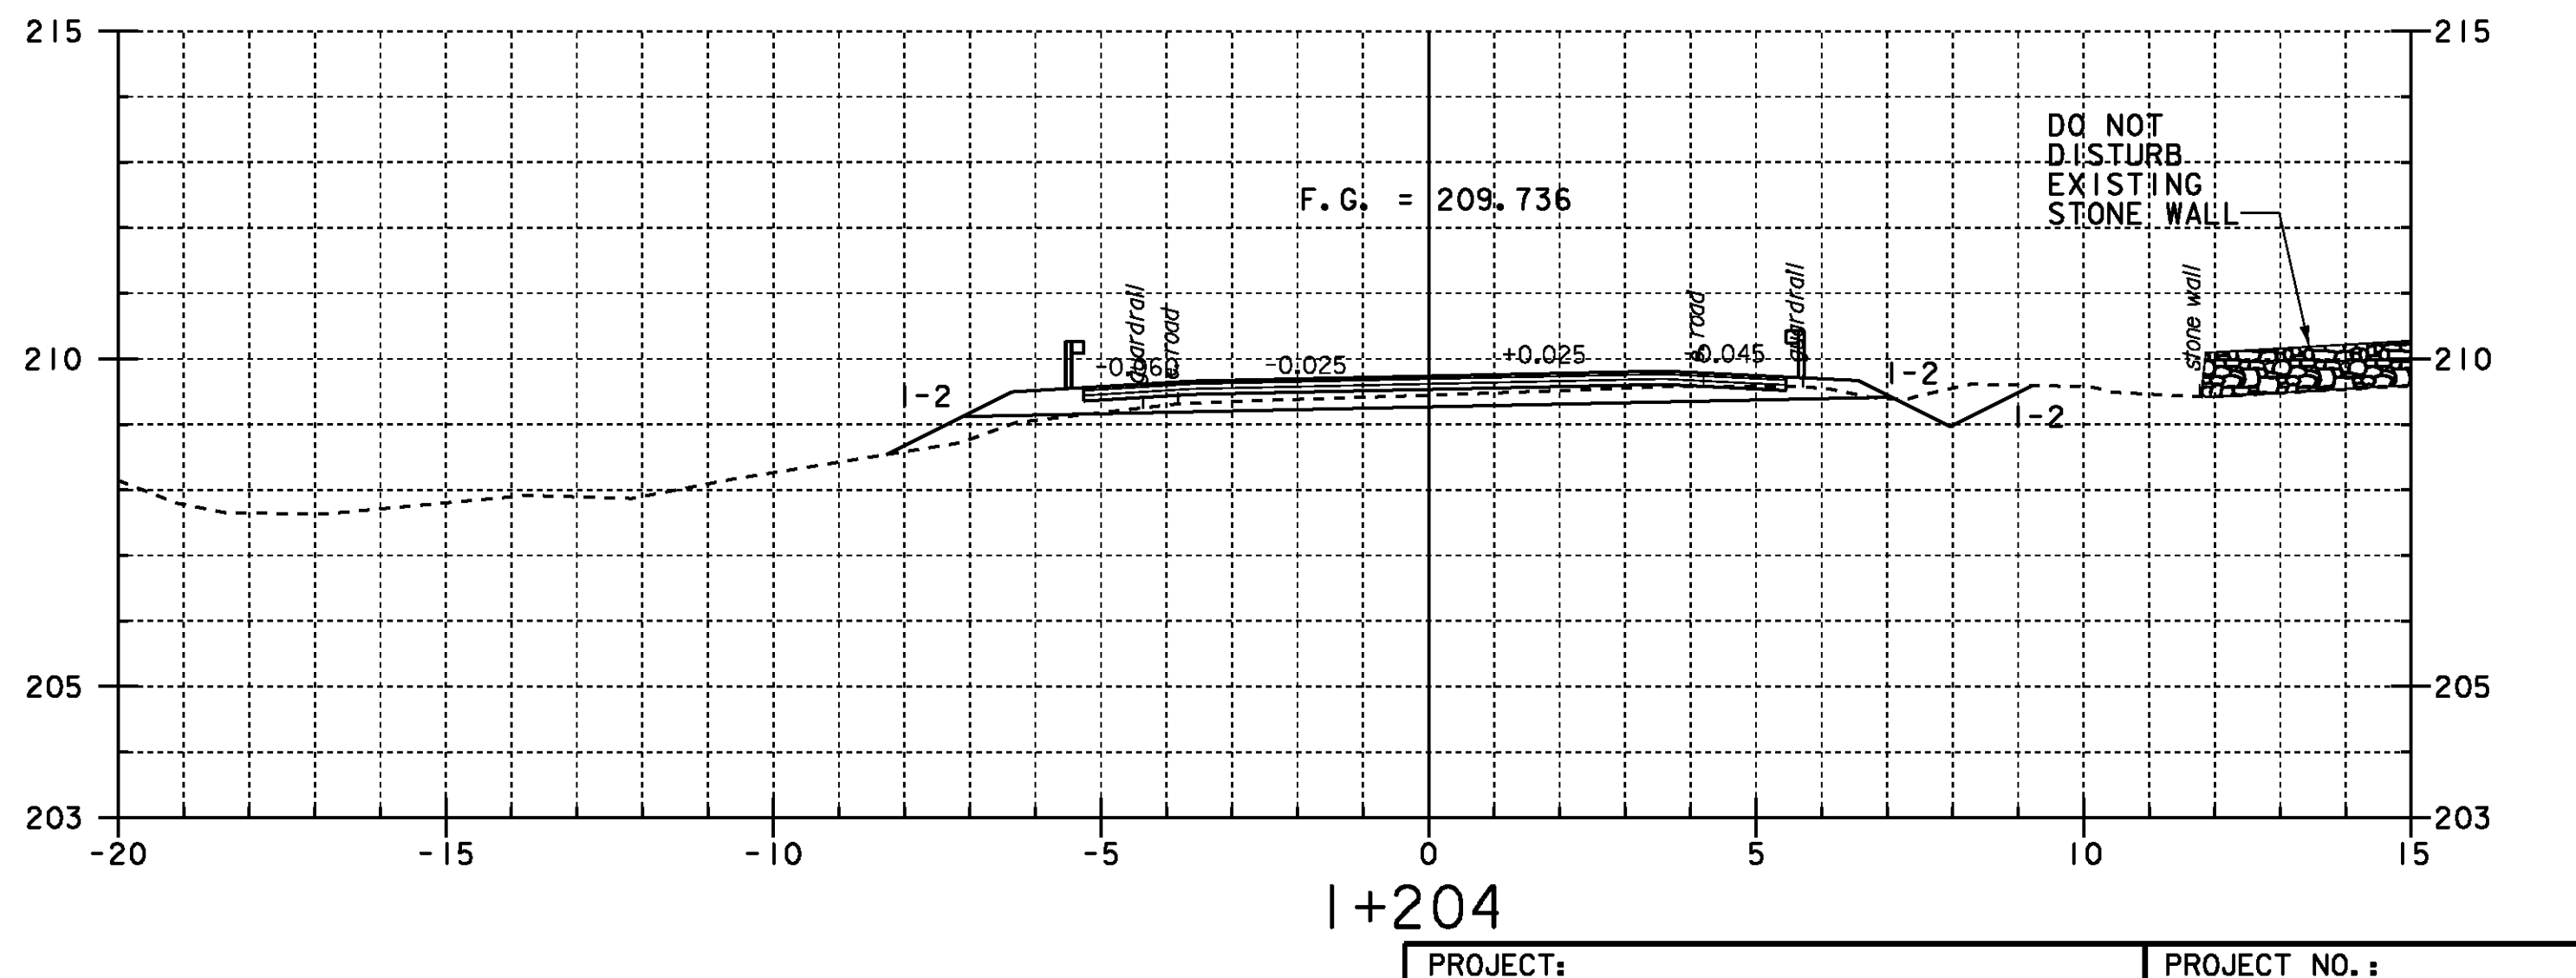


I+206.0 Rt.  
Begin Slope Stabilization with  
Stone Fill, Type II with  
300 Grubbing Material.

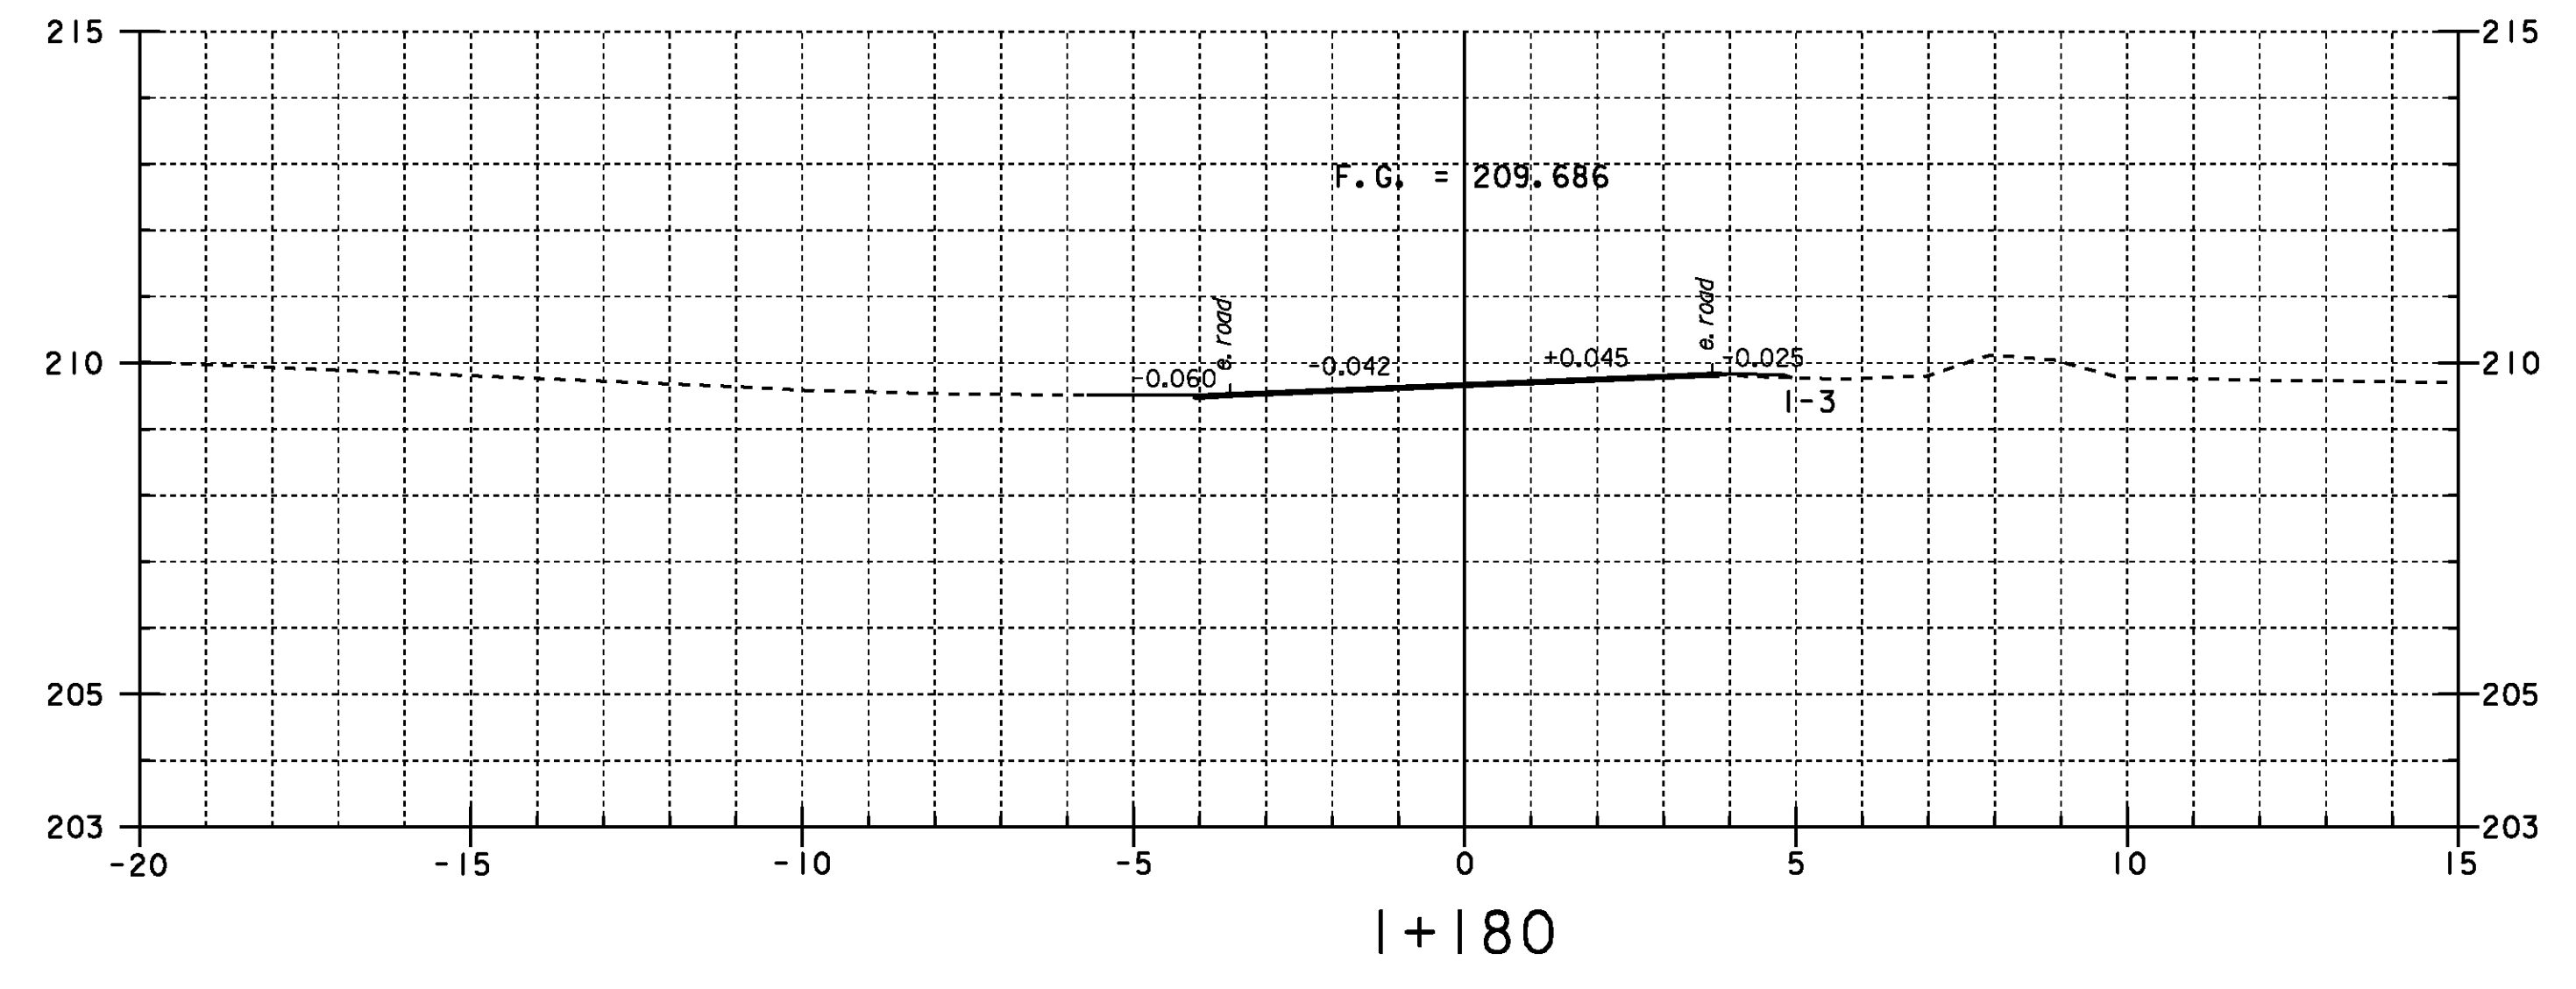

I+175  
BEGIN  
APPROACH

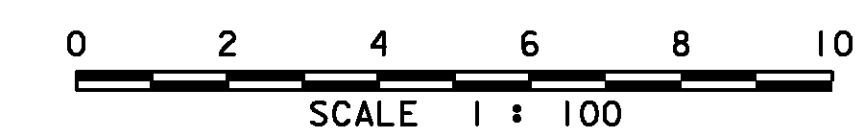

PROJECT: <b>EAST MONTPELIER</b>	PROJECT NO.: <b>BRF 028-3(36)</b>
DESIGN FILE NAME: /98b254/str/sb254xs.dgn	PLOT DATE: 03-FEB-2009
IPARM FILE NAME: sb254x3.1	DRAWN BY: R. PELLETT
DESIGNED BY: J. LACROIX	CHECKED BY: J. LACROIX
SQUAD LEADER: K. HIGGINS	SHEET: 57 OF 68
MAINLINE CROSS SECTIONS #1	