



I+313.5 Lt.
End Stone Fill, type IV
Begin Slope Stabilization
with Stone Fill, type II
See Layout

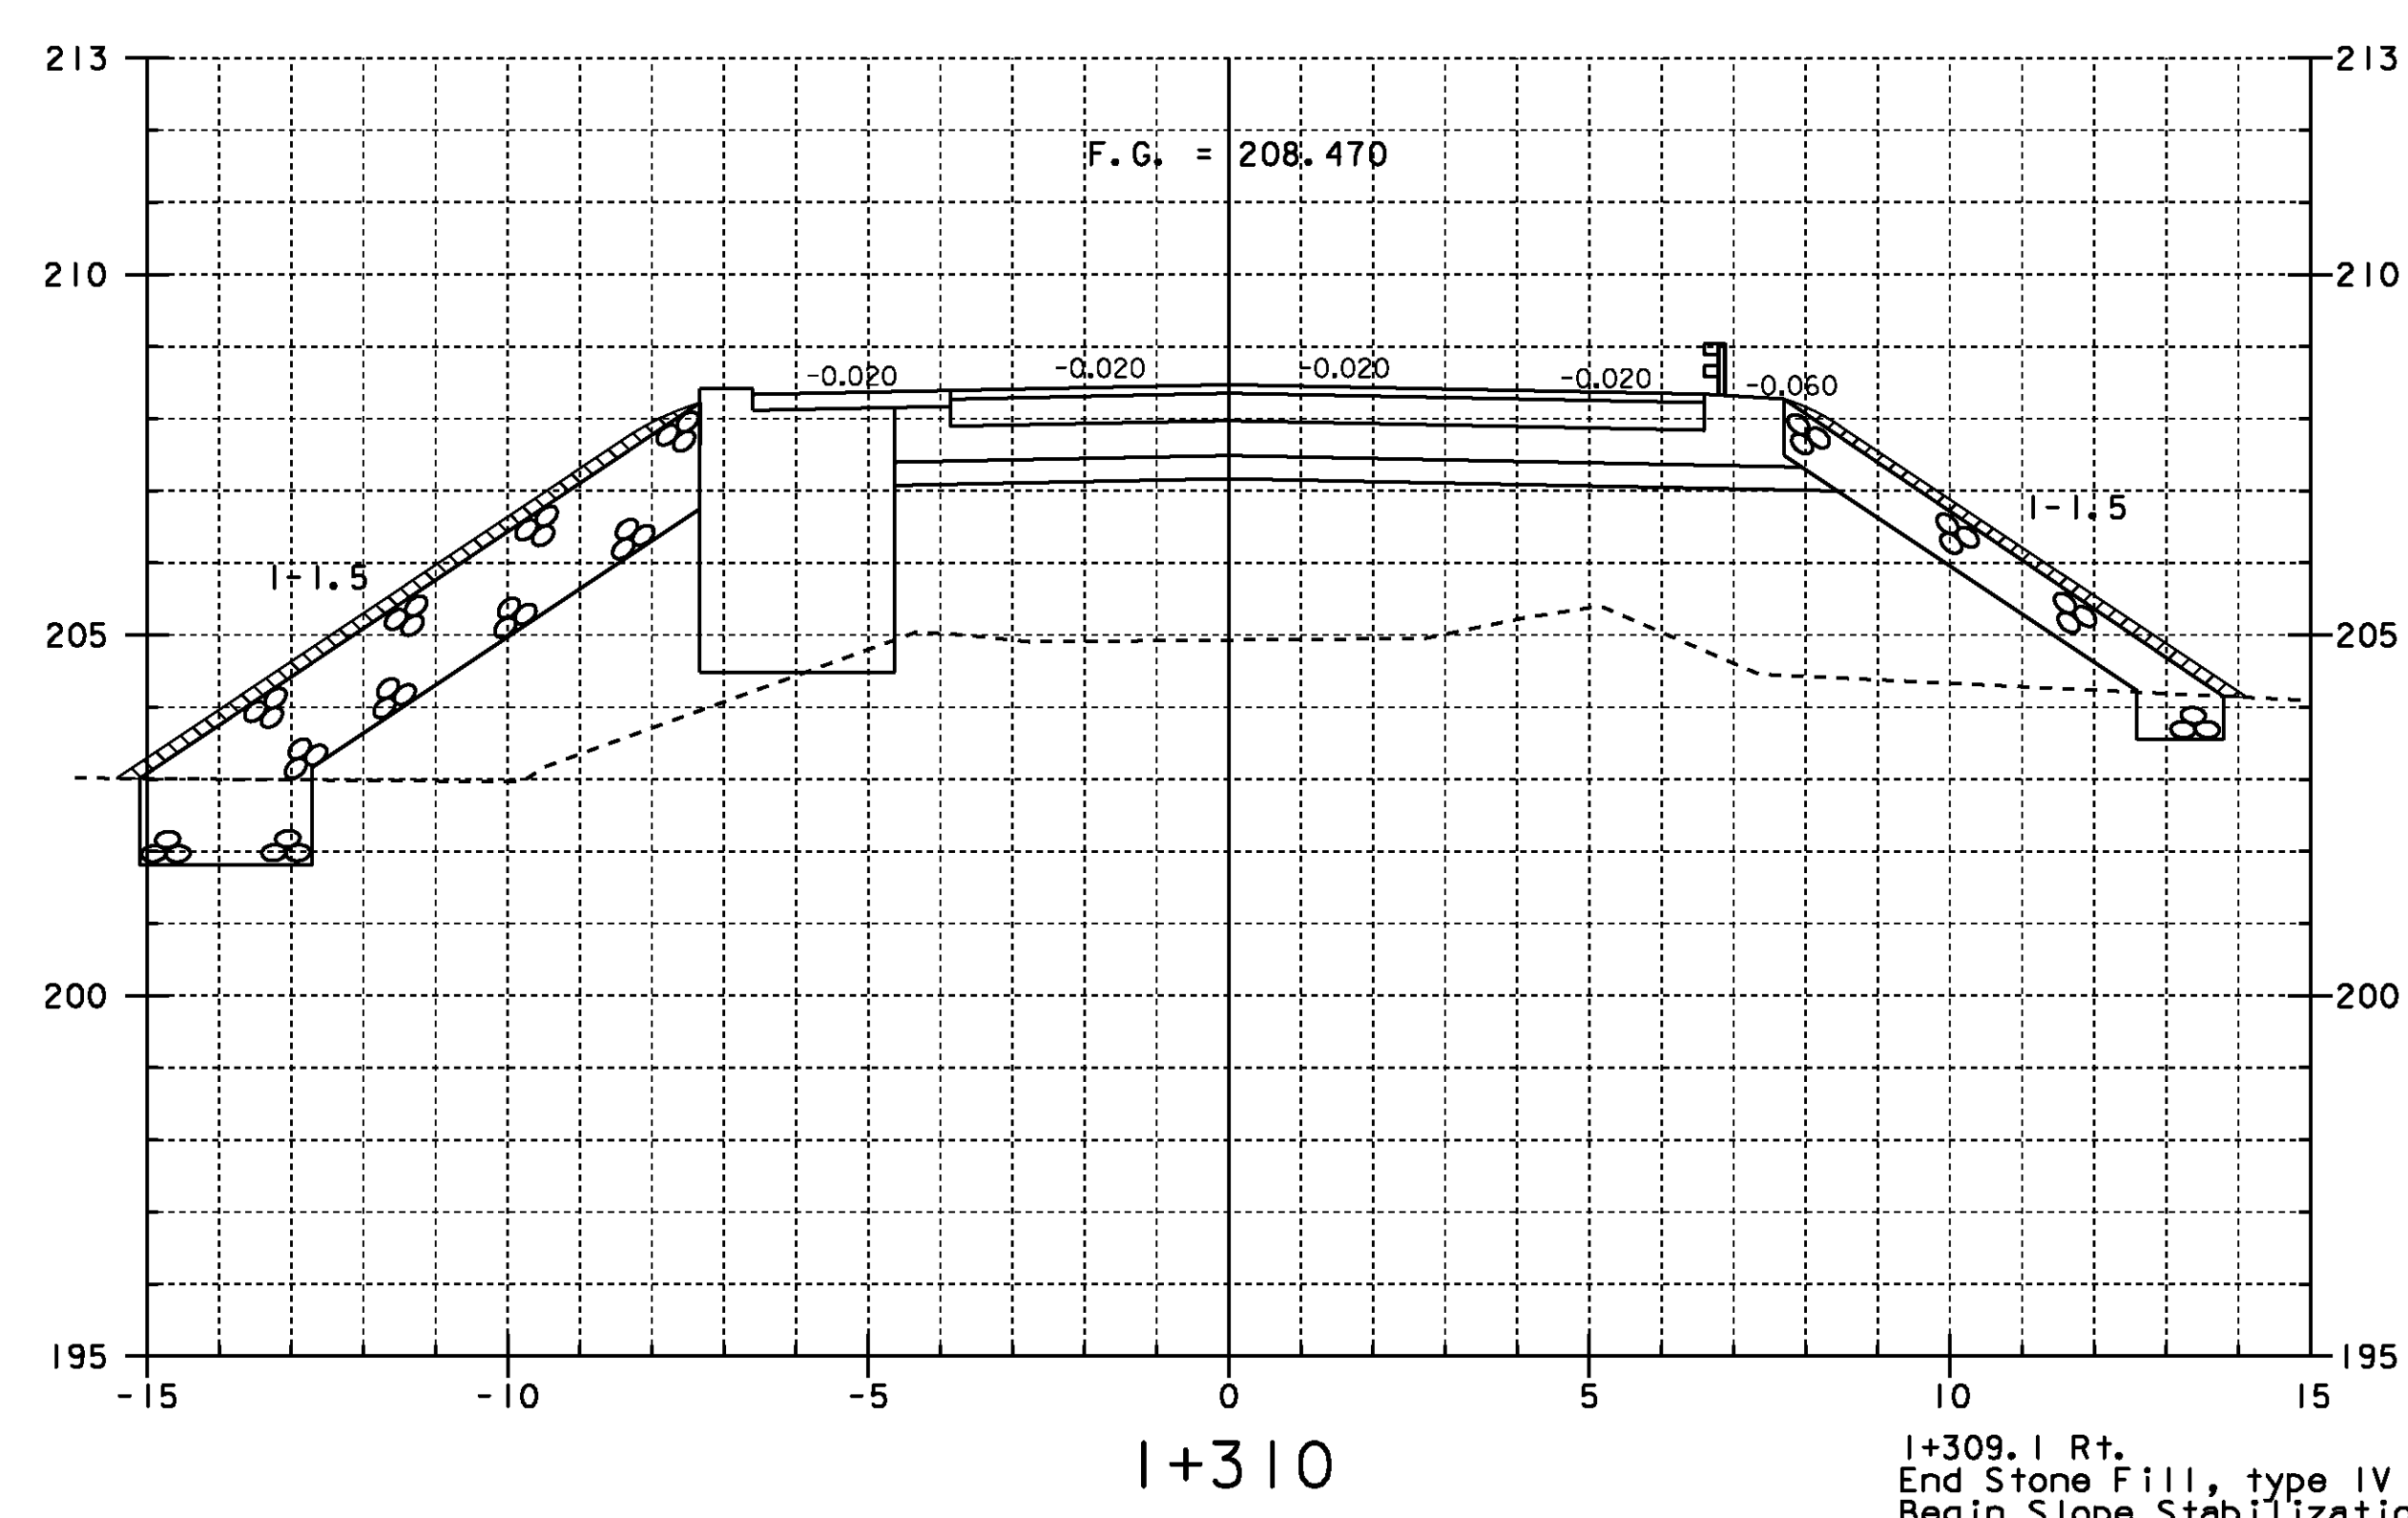

I+309.1 Rt.
End Stone Fill, type IV
Begin Slope Stabilization
with Stone Fill, type II
See Layout

I+308.760
End Bridge

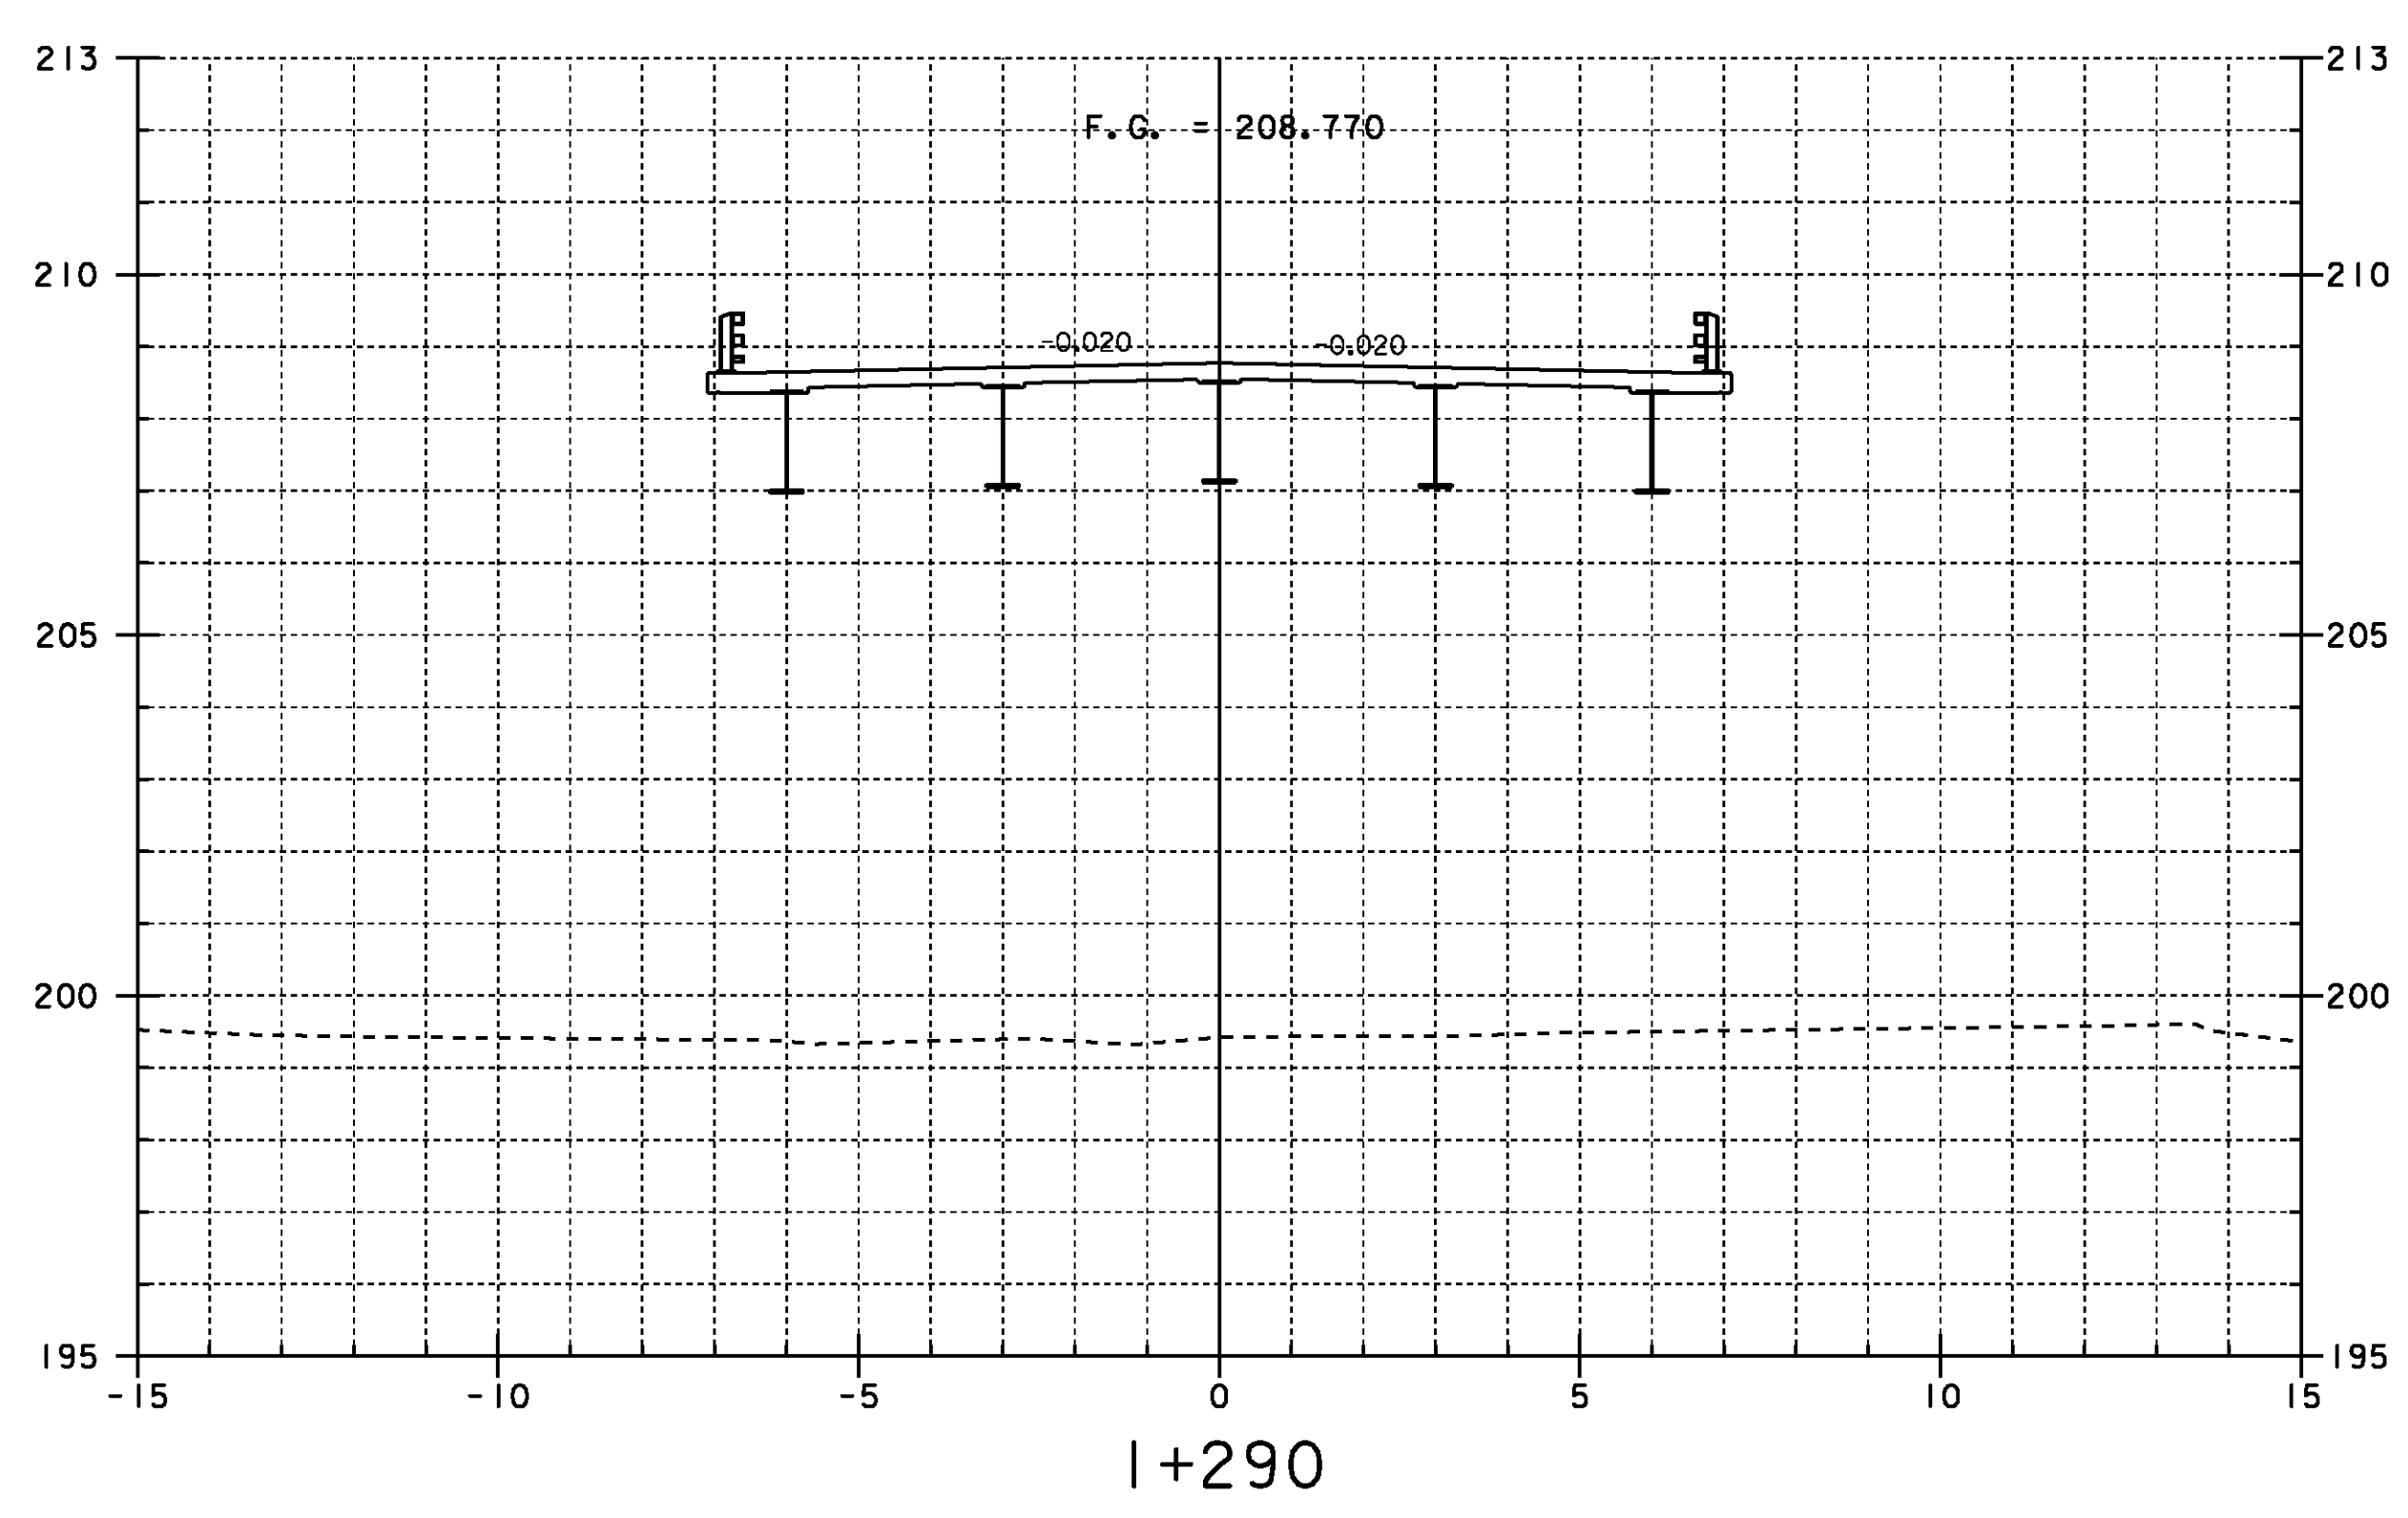

PROJECT: EAST MONTPELIER	PROJECT NO.: BRF 028-3(36)
DESIGN FILE NAME: /98b254/str/sb254xs.dgn	PLOT DATE: 03-FEB-2009
IPARM FILE NAME: sb254x5.1	DRAWN BY: R. PELLETT
DESIGNED BY: J. LACROIX	CHECKED BY: J. LACROIX
SQUAD LEADER: K. HIGGINS	SHEET: 59 OF 68
MAINLINE CROSS SECTIONS #3	