


F.G. = 208.236  
F.G. = 208.008

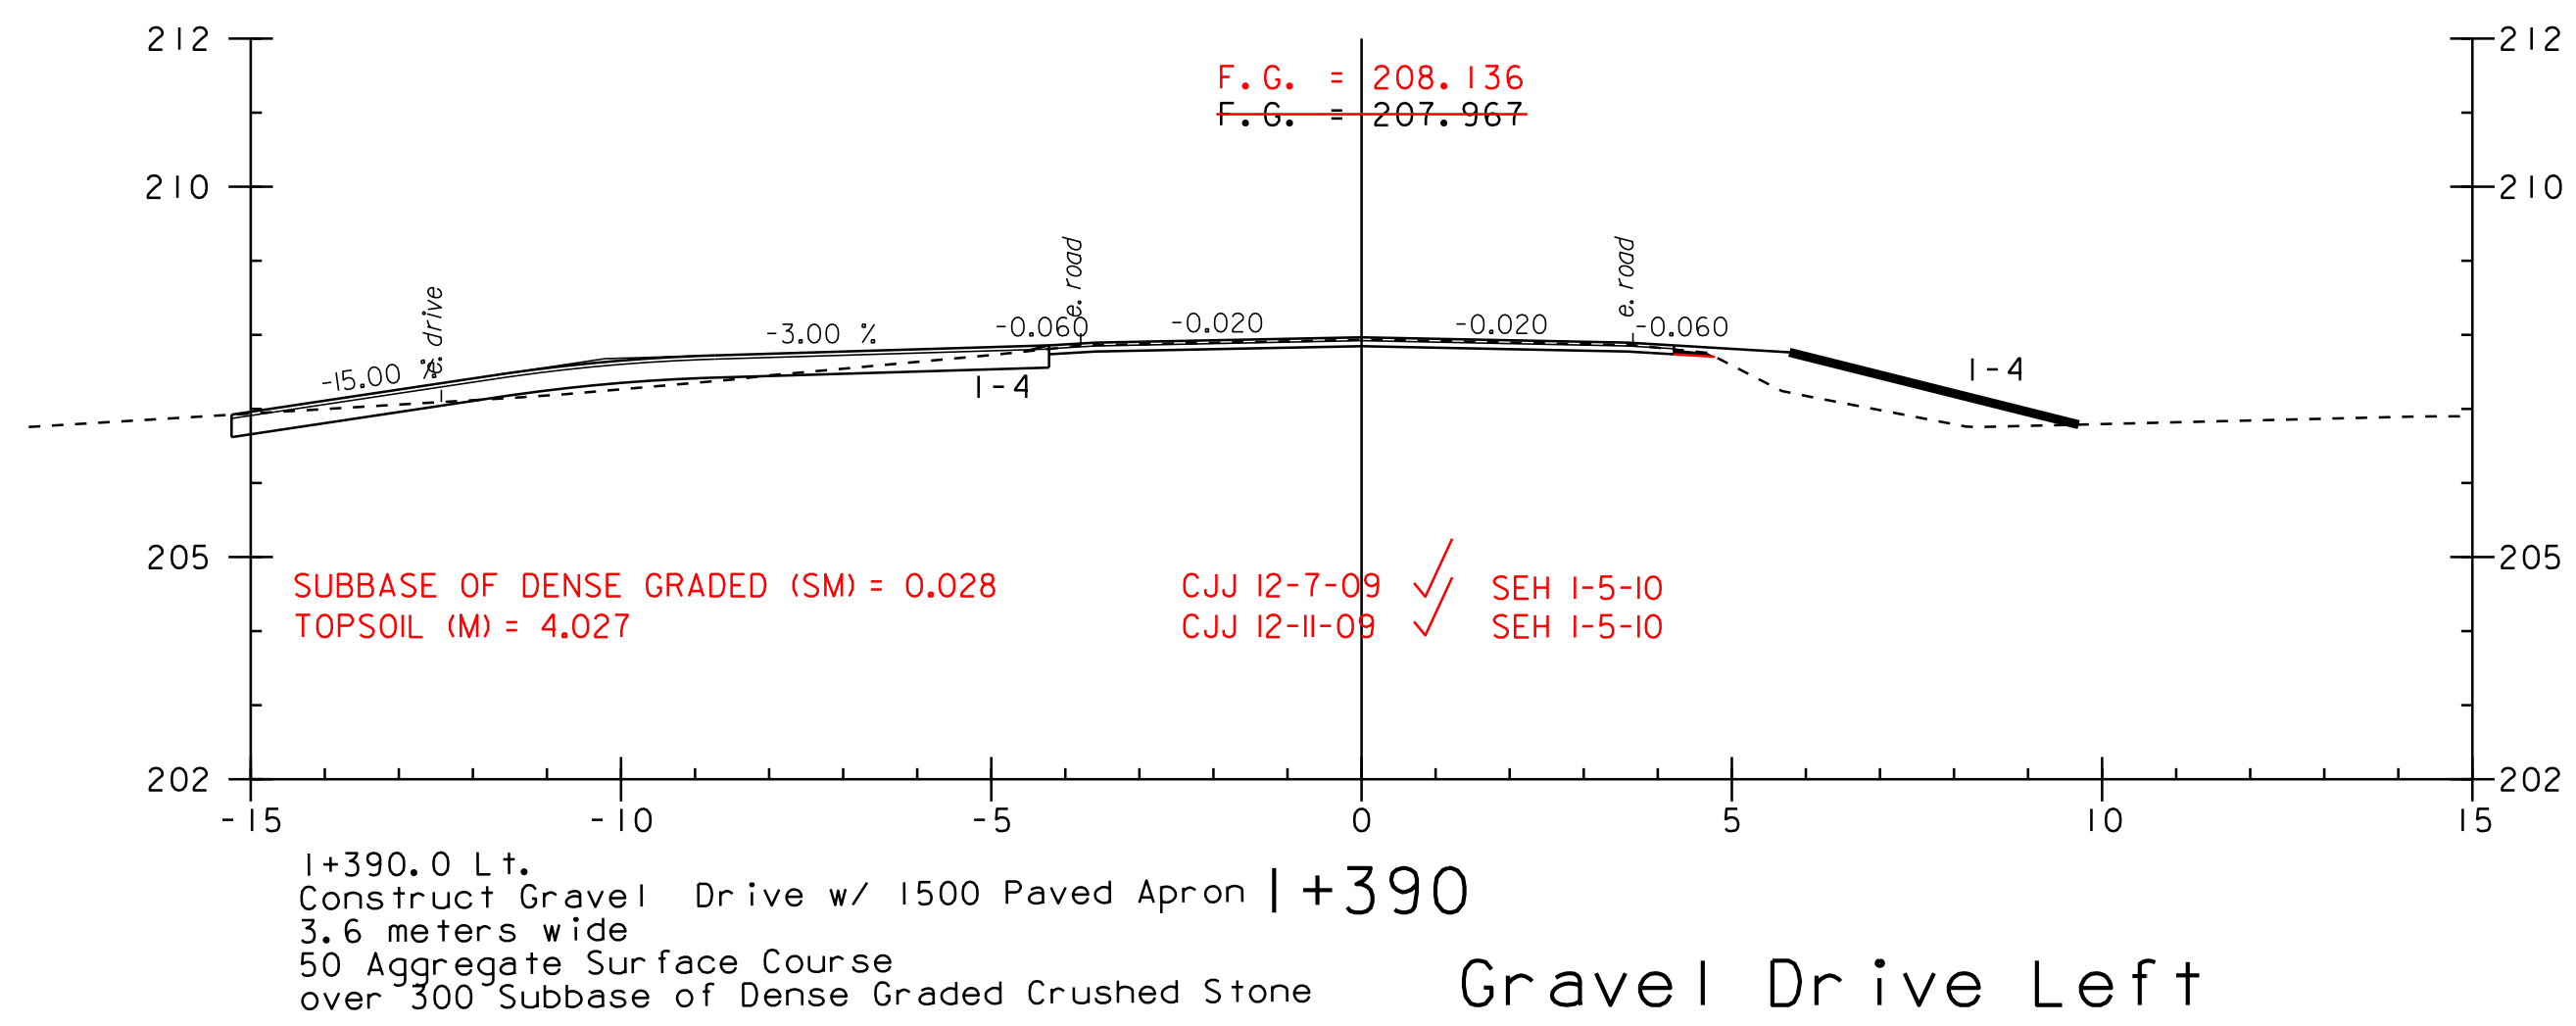


F.G. = 208.136  
F.G. = 207.967


SUBBASE OF DENSE GRADED (SM) = 0.028  
TOPSOIL (M) = 4.027

CJJ 12-7-09 ✓ SEH 1-5-10  
CJJ 12-11-09 ✓ SEH 1-5-10

1+390.0 Lt.  
Construct Gravel Drive w/ 1500 Paved Apron  
3.6 meters wide  
50 Aggregate Surface Course  
over 300 Subbase of Dense Graded Crushed Stone

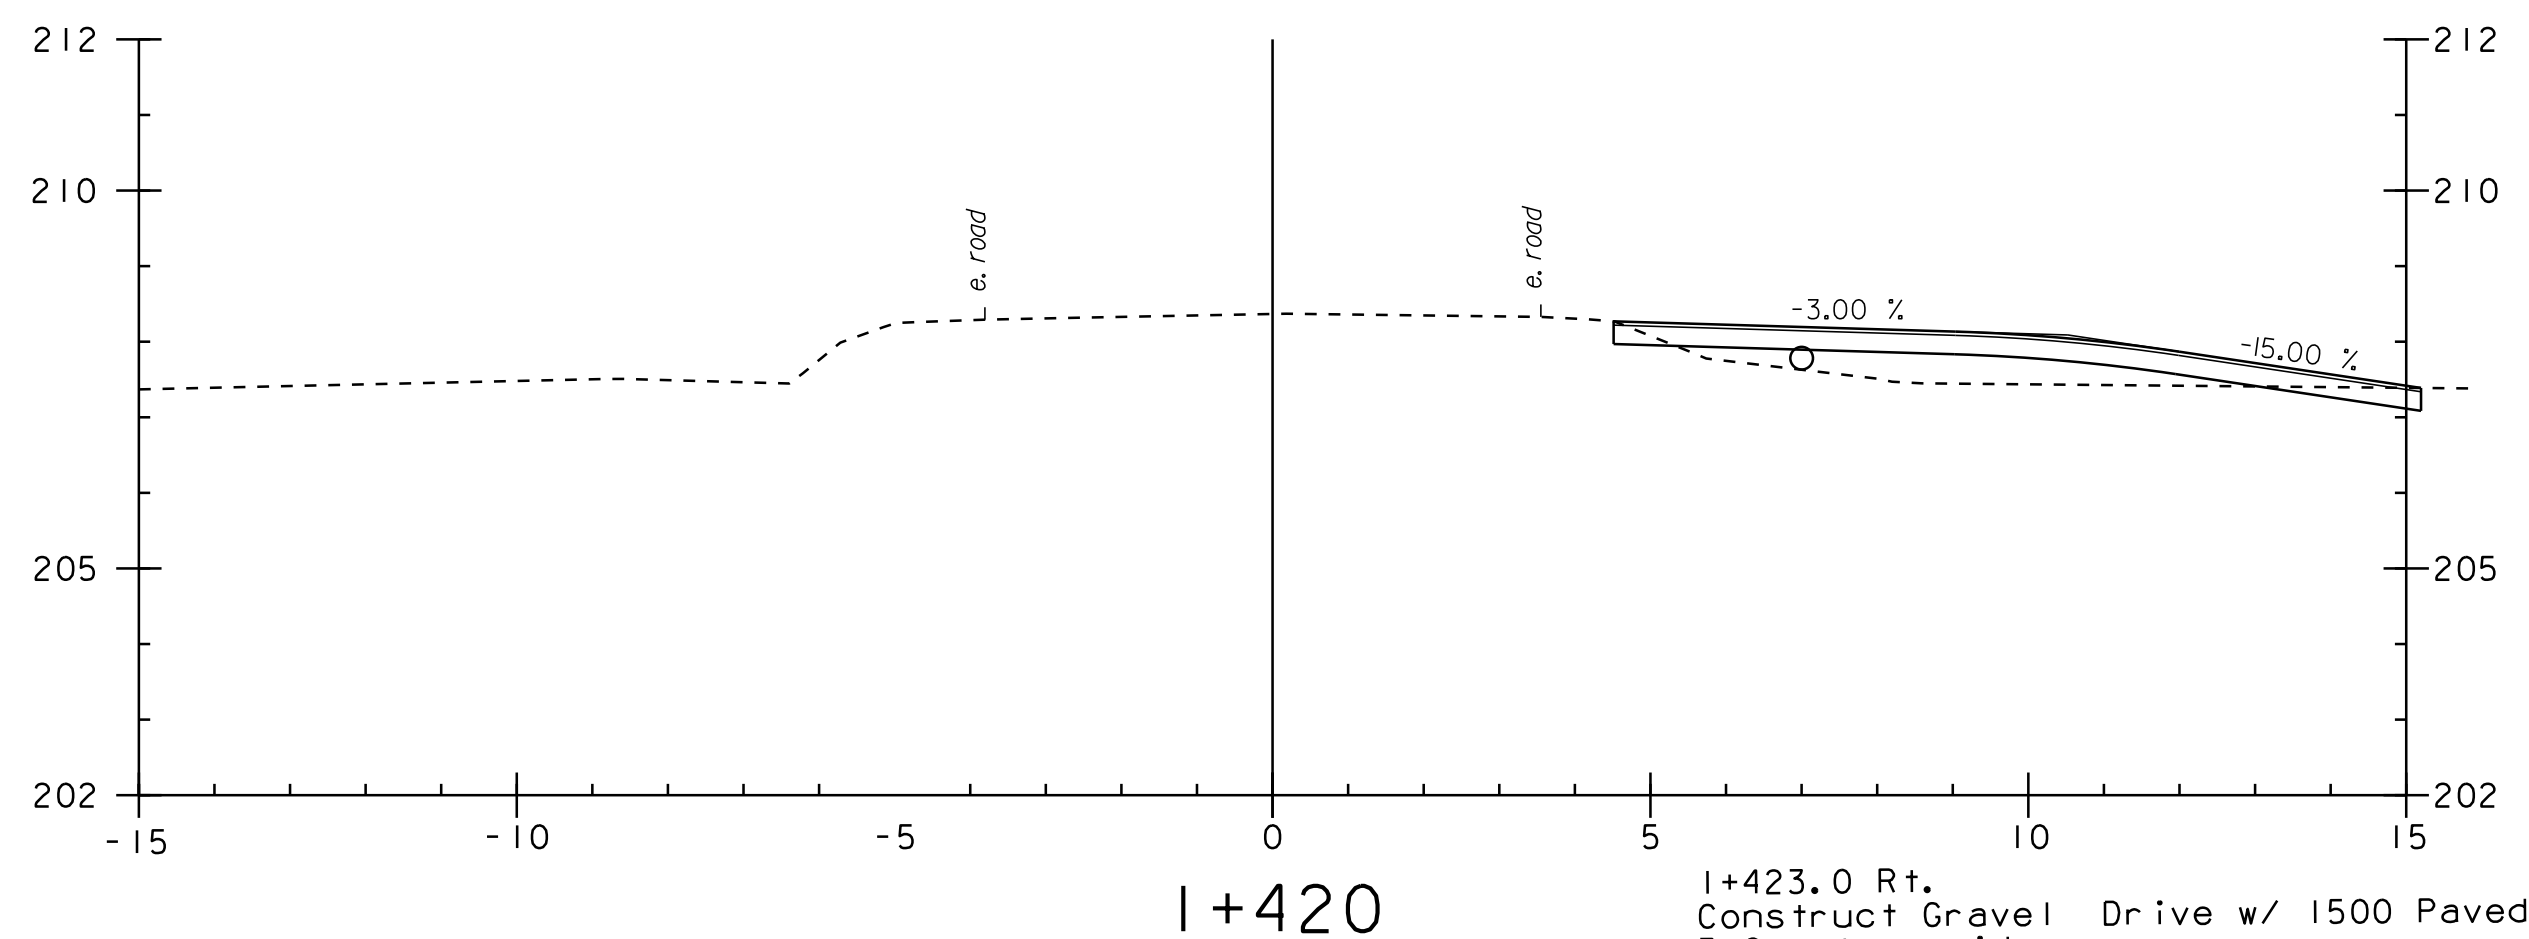


1+423.0 Rt.  
Construct Gravel Drive w/ 1500 Paved Apron  
3.6 meters wide  
50 Aggregate Surface Course  
over 300 Subbase of Dense Graded Crushed Stone

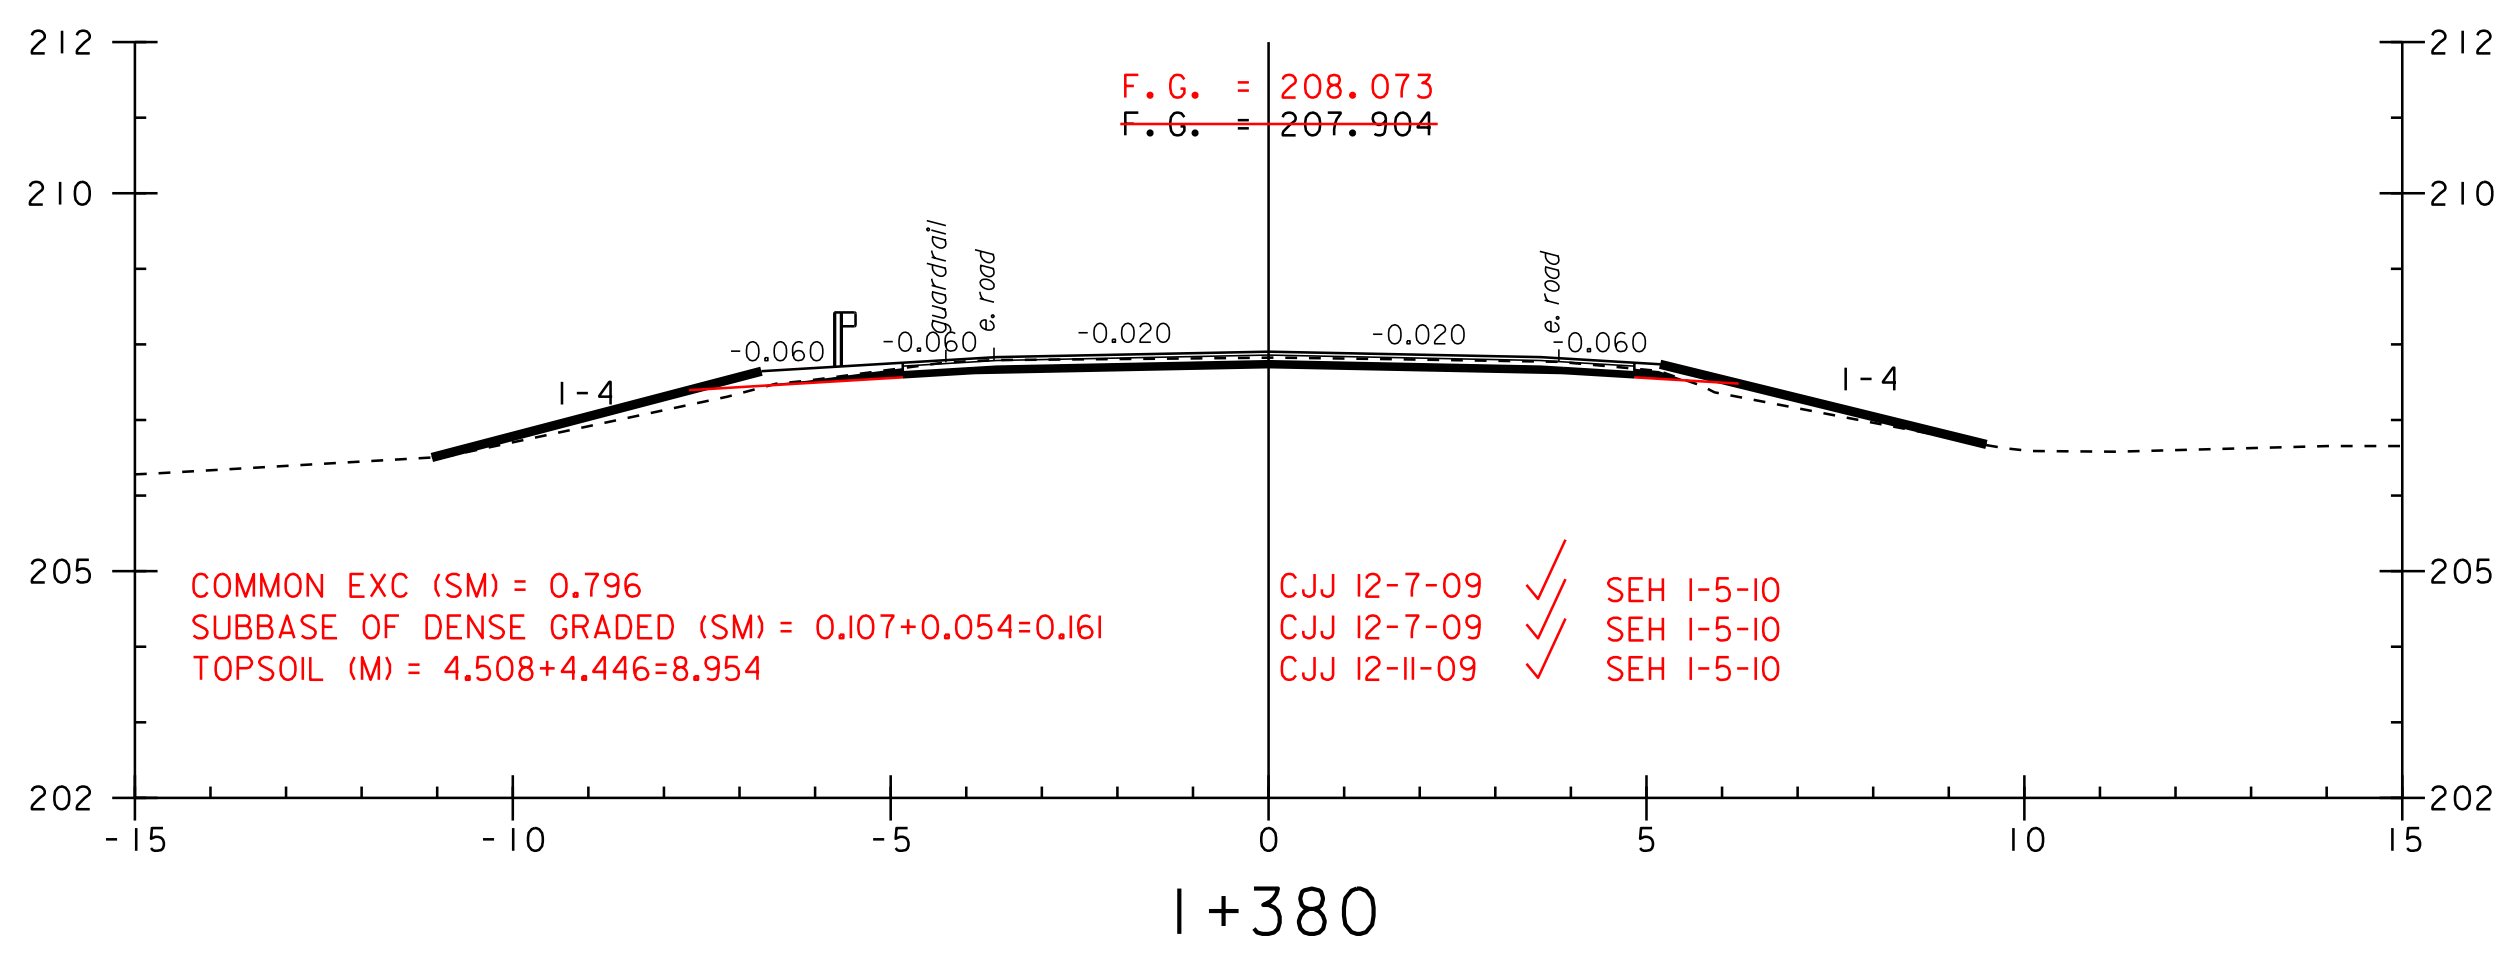

F.G. = 208.073  
F.G. = 207.904

COMMON EXC (SM) = 0.796  
SUBBASE OF DENSE GRADED (SM) = 0.107+0.054=0.161  
TOPSOIL (M) = 4.508+4.446=8.954

CJJ 12-7-09 ✓ SEH 1-5-10  
CJJ 12-7-09 ✓ SEH 1-5-10  
CJJ 12-11-09 ✓ SEH 1-5-10

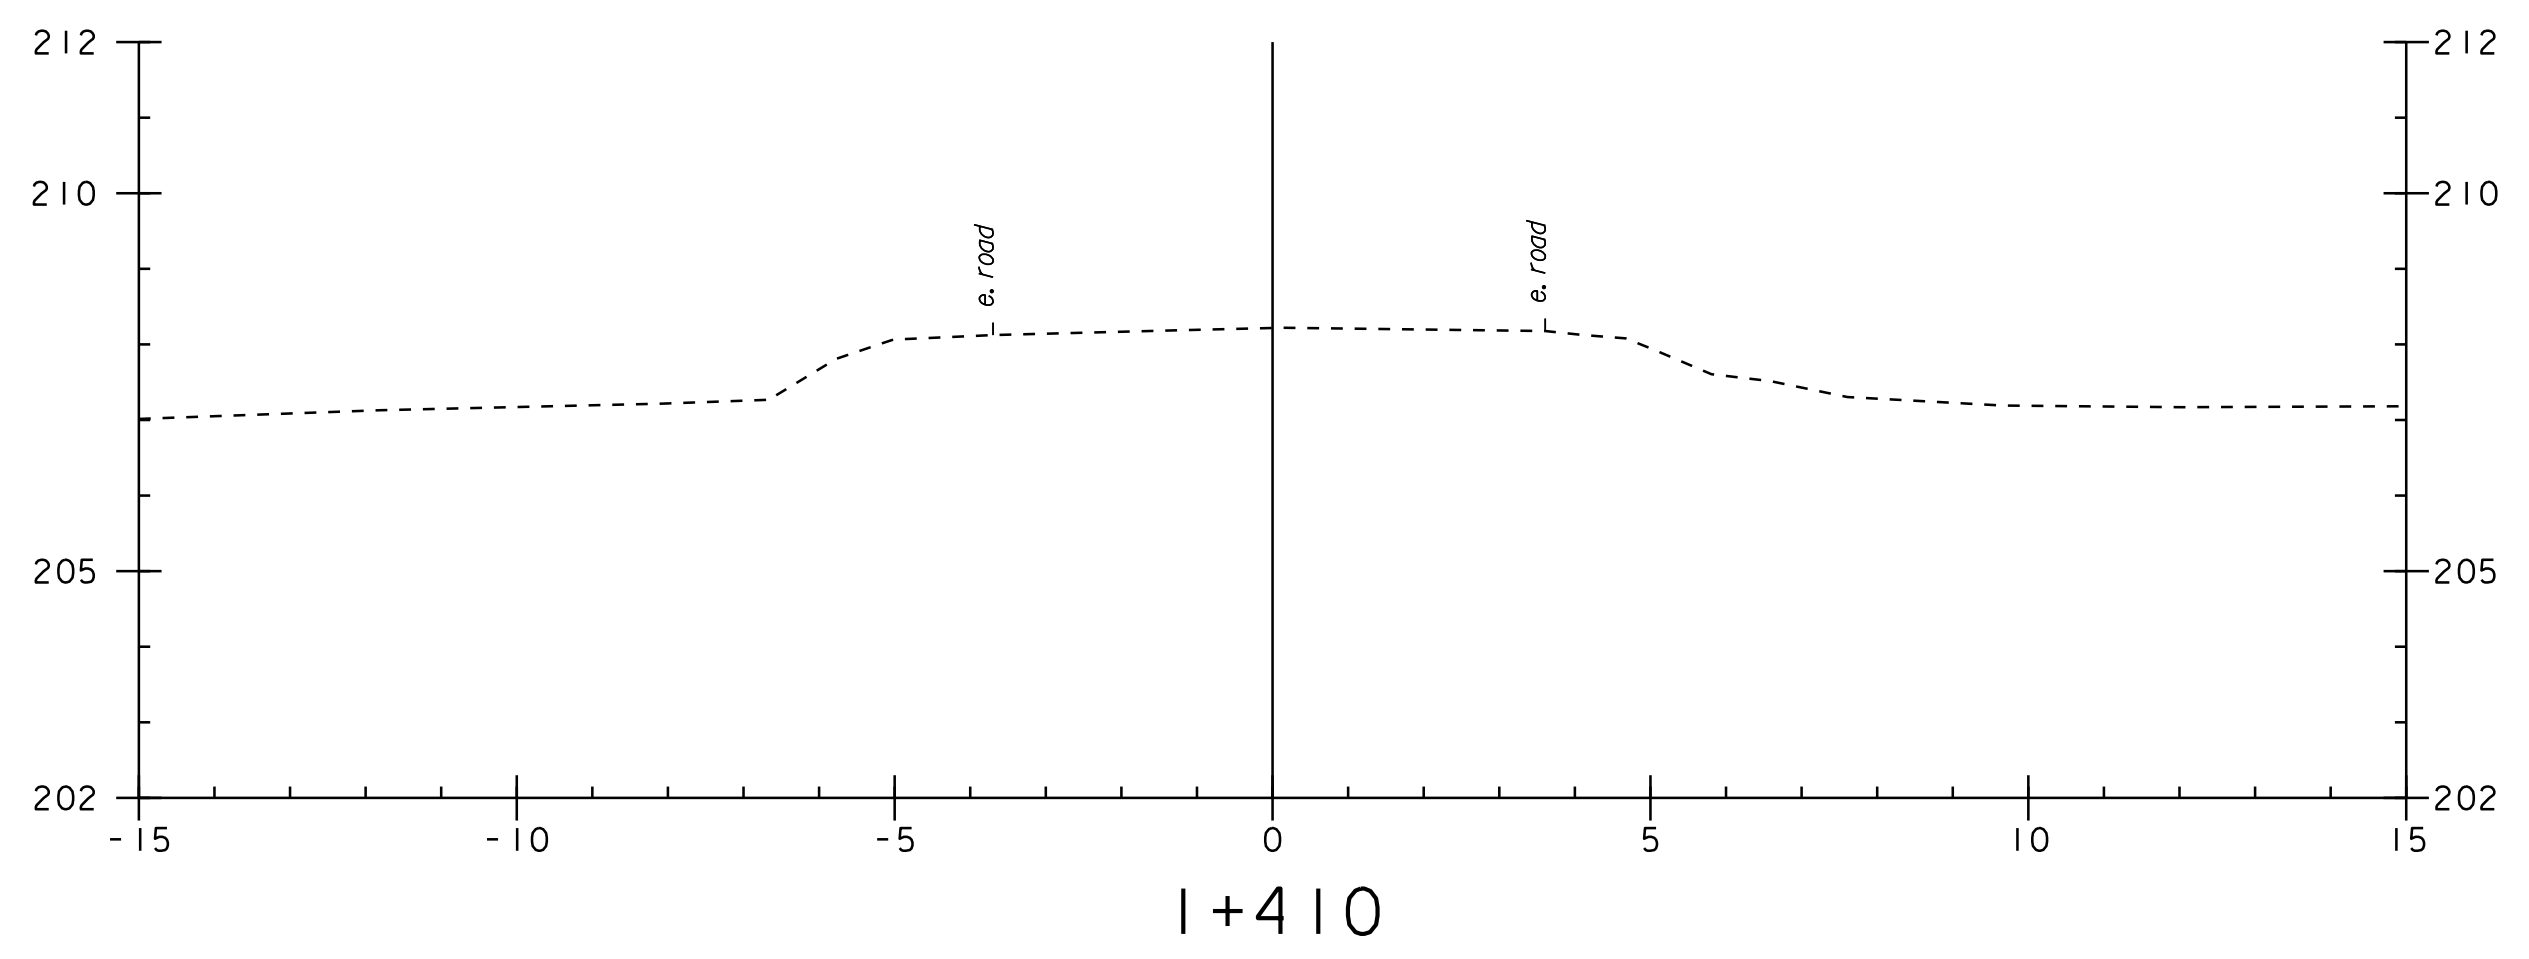

PROJECT: EAST MONTPELIER	PROJECT NO.: BRF 028-3(36)
DESIGN FILE NAME: /98b254/str/sb254xs.dgn	PLOT DATE: 21-MAY-2012 16:41
IPARM FILE NAME: sb254x7.i	DRAWN BY: R. PELLETT
DESIGNED BY: J. LACROIX	CHECKED BY: J. LACROIX
SQUAD LEADER: K. HIGGINS	SHEET: \$S*\$ OF \$T*\$
MAINLINE CROSS SECTIONS #5	