



DO NOT PLACE GRUBBING MATERIAL UNDER THE BRIDGE

STA 5+014.513 FAR RT
END GRUBBING MATERIAL

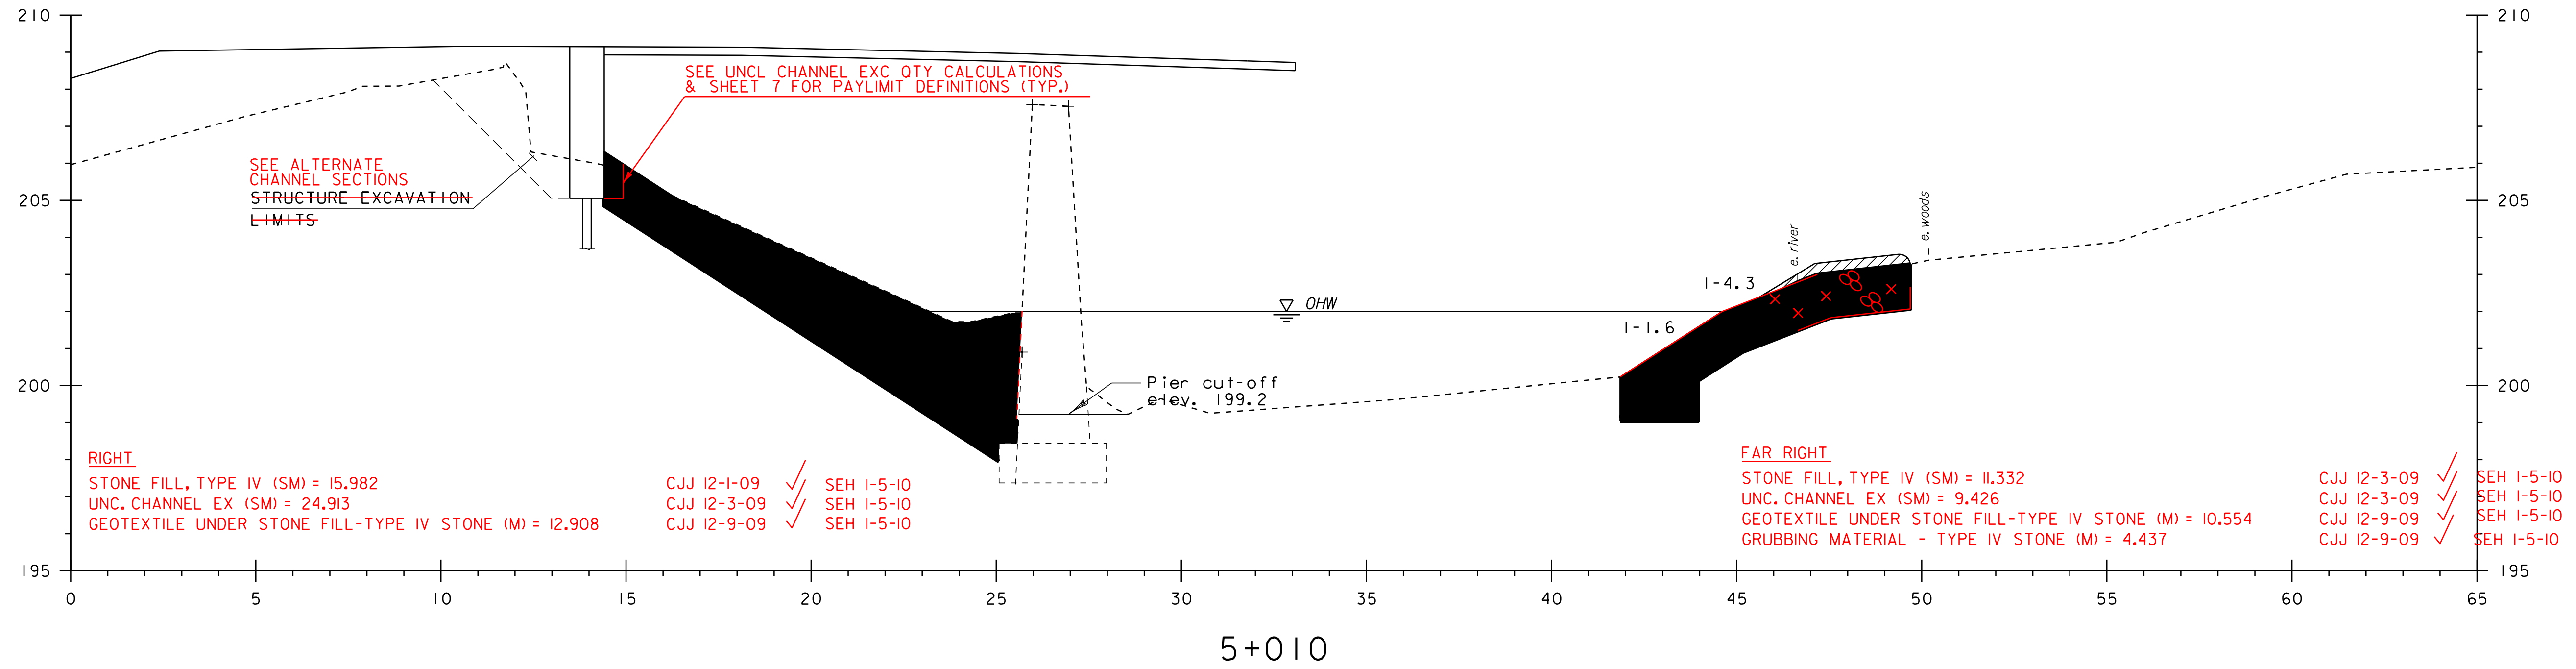

STA 5+000.431 FAR RT
BEGIN UNCLASSIFIED CHANNEL EXCAVATION
GEOTEXTILE UNDER STONE FILL
STONE FILL TYPE IV
GRUBBING MATERIAL

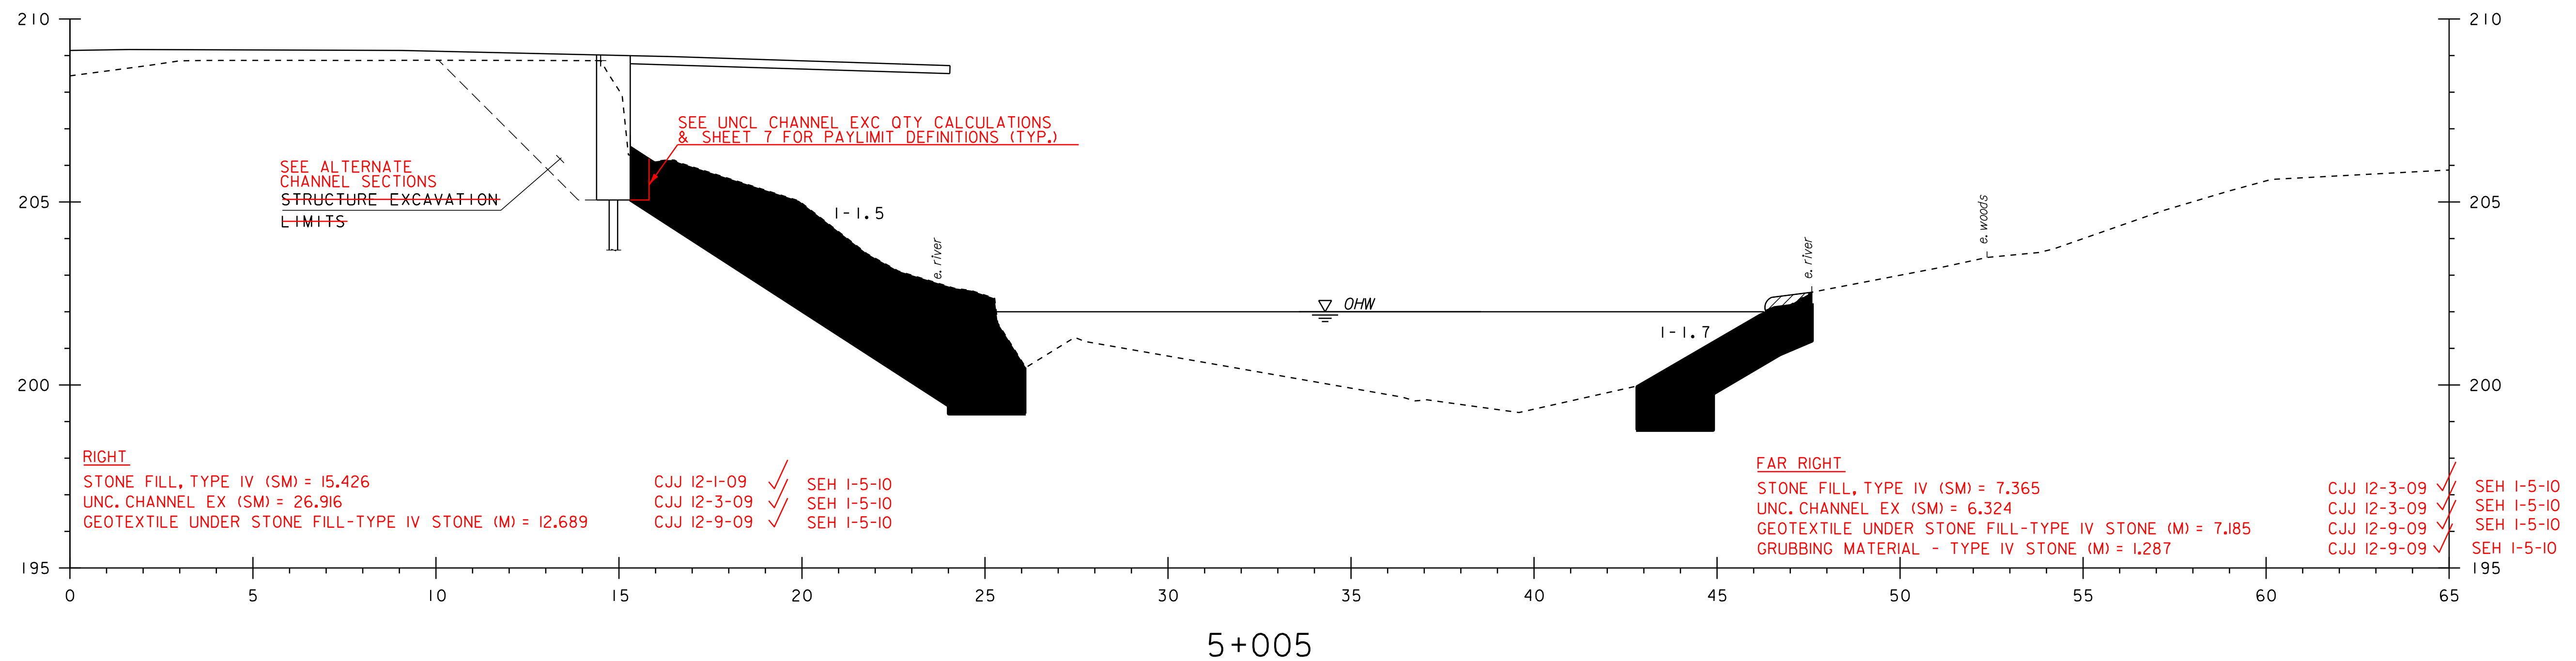

PROJECT: EAST MONTPELIER	PROJECT NO. : BRF 028-3(36)
DESIGN FILE NAME: /98b254/str/sb254xs.dgn	PLOT DATE: 21-MAY-2012 16:41
IPARM FILE NAME: sb254x14.i	DRAWN BY: R. PELLETT
DESIGNED BY: J. LACROIX	CHECKED BY: J. LACROIX
SQUAD LEADER: K. HIGGINS	SHEET: \$S*\$ OF \$T*\$
CHANNEL CROSS SECTIONS #3	