


STA 5+015.282 RT
 BEGIN GRUBBING MATERIAL

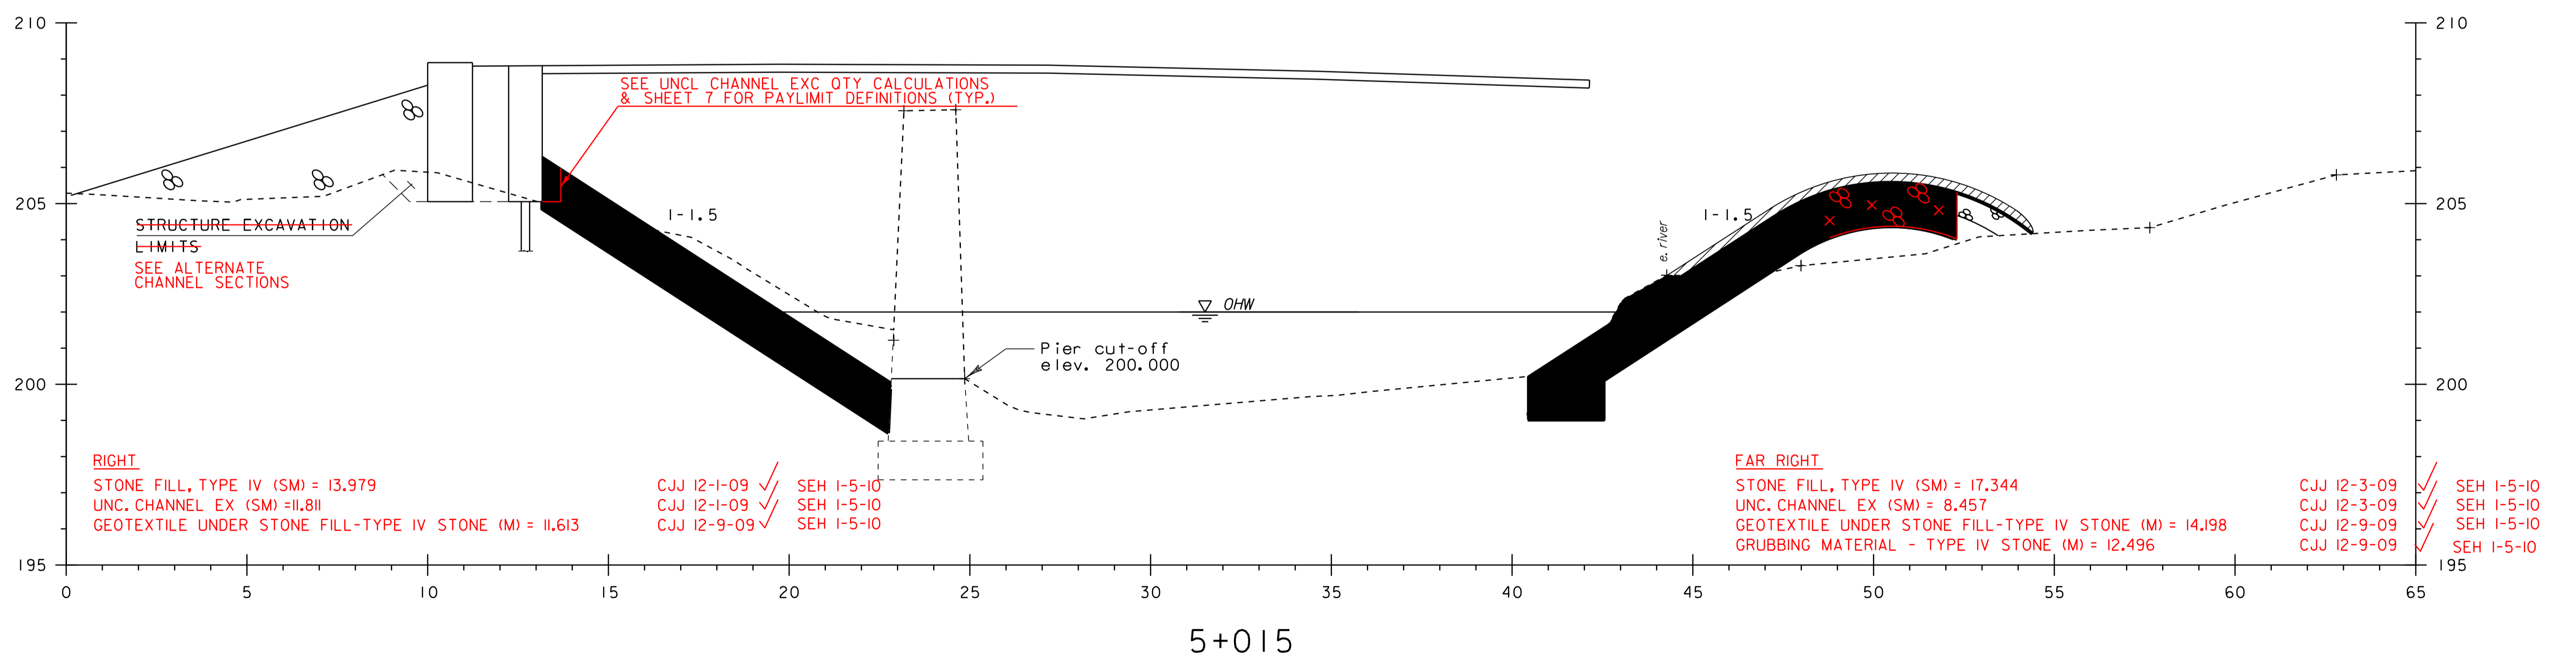

PROJECT: EAST MONTPELIER	PROJECT NO. : BRF 028-3(36)
DESIGN FILE NAME: /98b254/str/sb254xs.dgn	PLOT DATE: 21-MAY-2012 16:30
IPARM FILE NAME: sb254x15.1	DRAWN BY: R. PELLETT
DESIGNED BY: J. LACROIX	CHECKED BY: J. LACROIX
SQUAD LEADER: K. HIGGINS	SHEET: \$S*\$ OF \$T*\$
CHANNEL CROSS SECTIONS #4	