



STA 5+043.974 FAR RT  
 END UNCLASSIFIED CHANNEL EXCAVATION  
 GEOTEXTILE UNDER STONE FILL  
 STONE FILL TYPE IV  
 GRUBBING MATERIAL

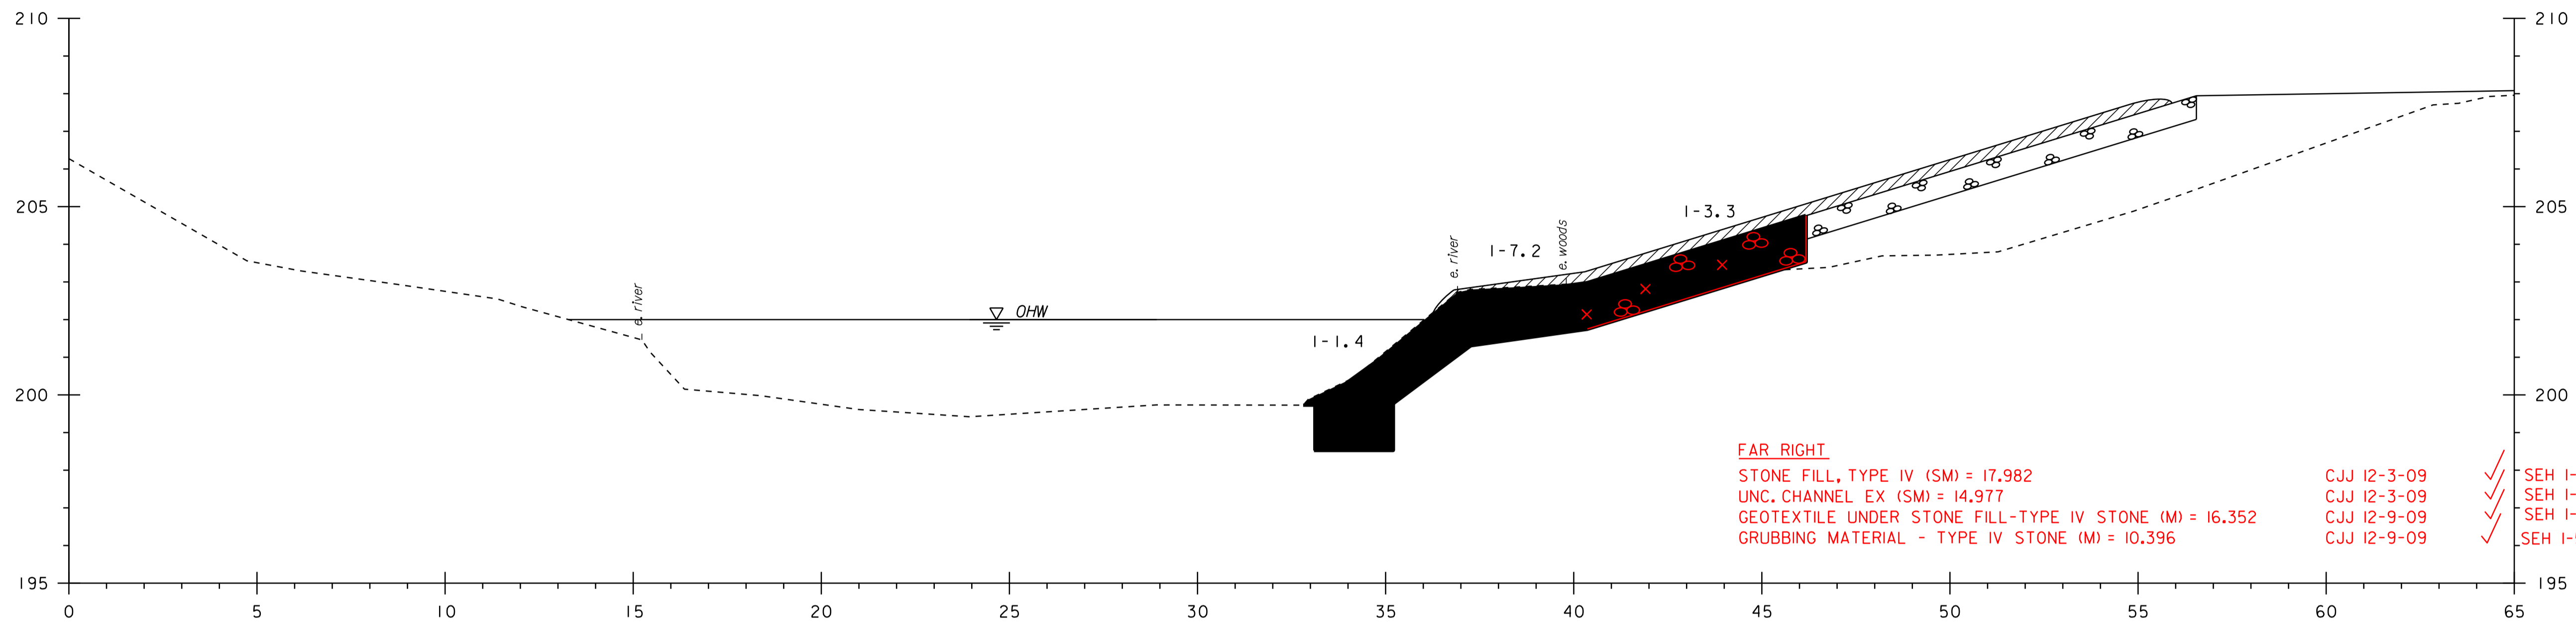

5+040

**FAR RIGHT**  
 STONE FILL, TYPE IV (SM) = 17.982  
 UNC. CHANNEL EX (SM) = 14.977  
 GEOTEXTILE UNDER STONE FILL-TYPE IV STONE (M) = 16.352  
 GRUBBING MATERIAL - TYPE IV STONE (M) = 10.396

CJJ 12-3-09 ✓ SEH 1-5-10  
 CJJ 12-3-09 ✓ SEH 1-5-10  
 CJJ 12-9-09 ✓ SEH 1-5-10  
 CJJ 12-9-09 ✓ SEH 1-5-10

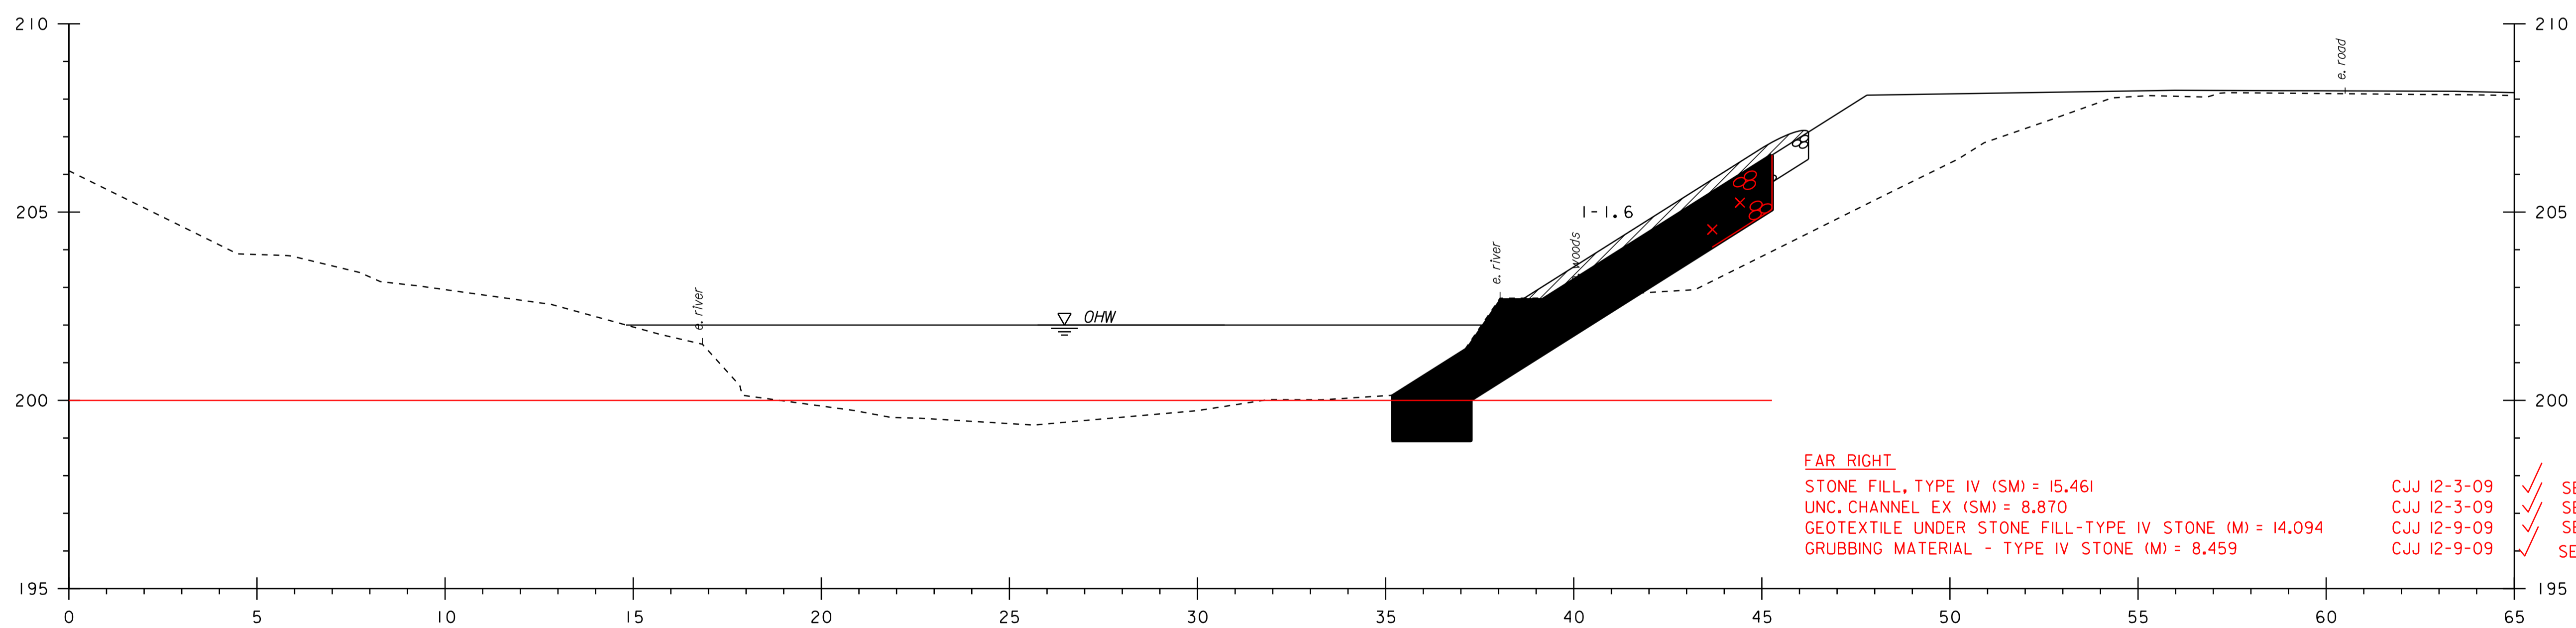

5+035

**FAR RIGHT**  
 STONE FILL, TYPE IV (SM) = 15.461  
 UNC. CHANNEL EX (SM) = 8.870  
 GEOTEXTILE UNDER STONE FILL-TYPE IV STONE (M) = 14.094  
 GRUBBING MATERIAL - TYPE IV STONE (M) = 8.459

CJJ 12-3-09 ✓ SEH 1-5-10  
 CJJ 12-3-09 ✓ SEH 1-5-10  
 CJJ 12-9-09 ✓ SEH 1-5-10  
 CJJ 12-9-09 ✓ SEH 1-5-10

PROJECT: EAST MONTPELIER	PROJECT NO. : BRF 028-3(36)
DESIGN FILE NAME: /98b254/str/sb254xs.dgn	PLOT DATE: 21-MAY-2012 16:41
IPARM FILE NAME: sb254x17.1	DRAWN BY: R. PELLETT
DESIGNED BY: J. LACROIX	CHECKED BY: J. LACROIX
SQUAD LEADER: K. HIGGINS	SHEET: \$S*\$ OF \$T*\$
CHANNEL CROSS SECTIONS #6	

