
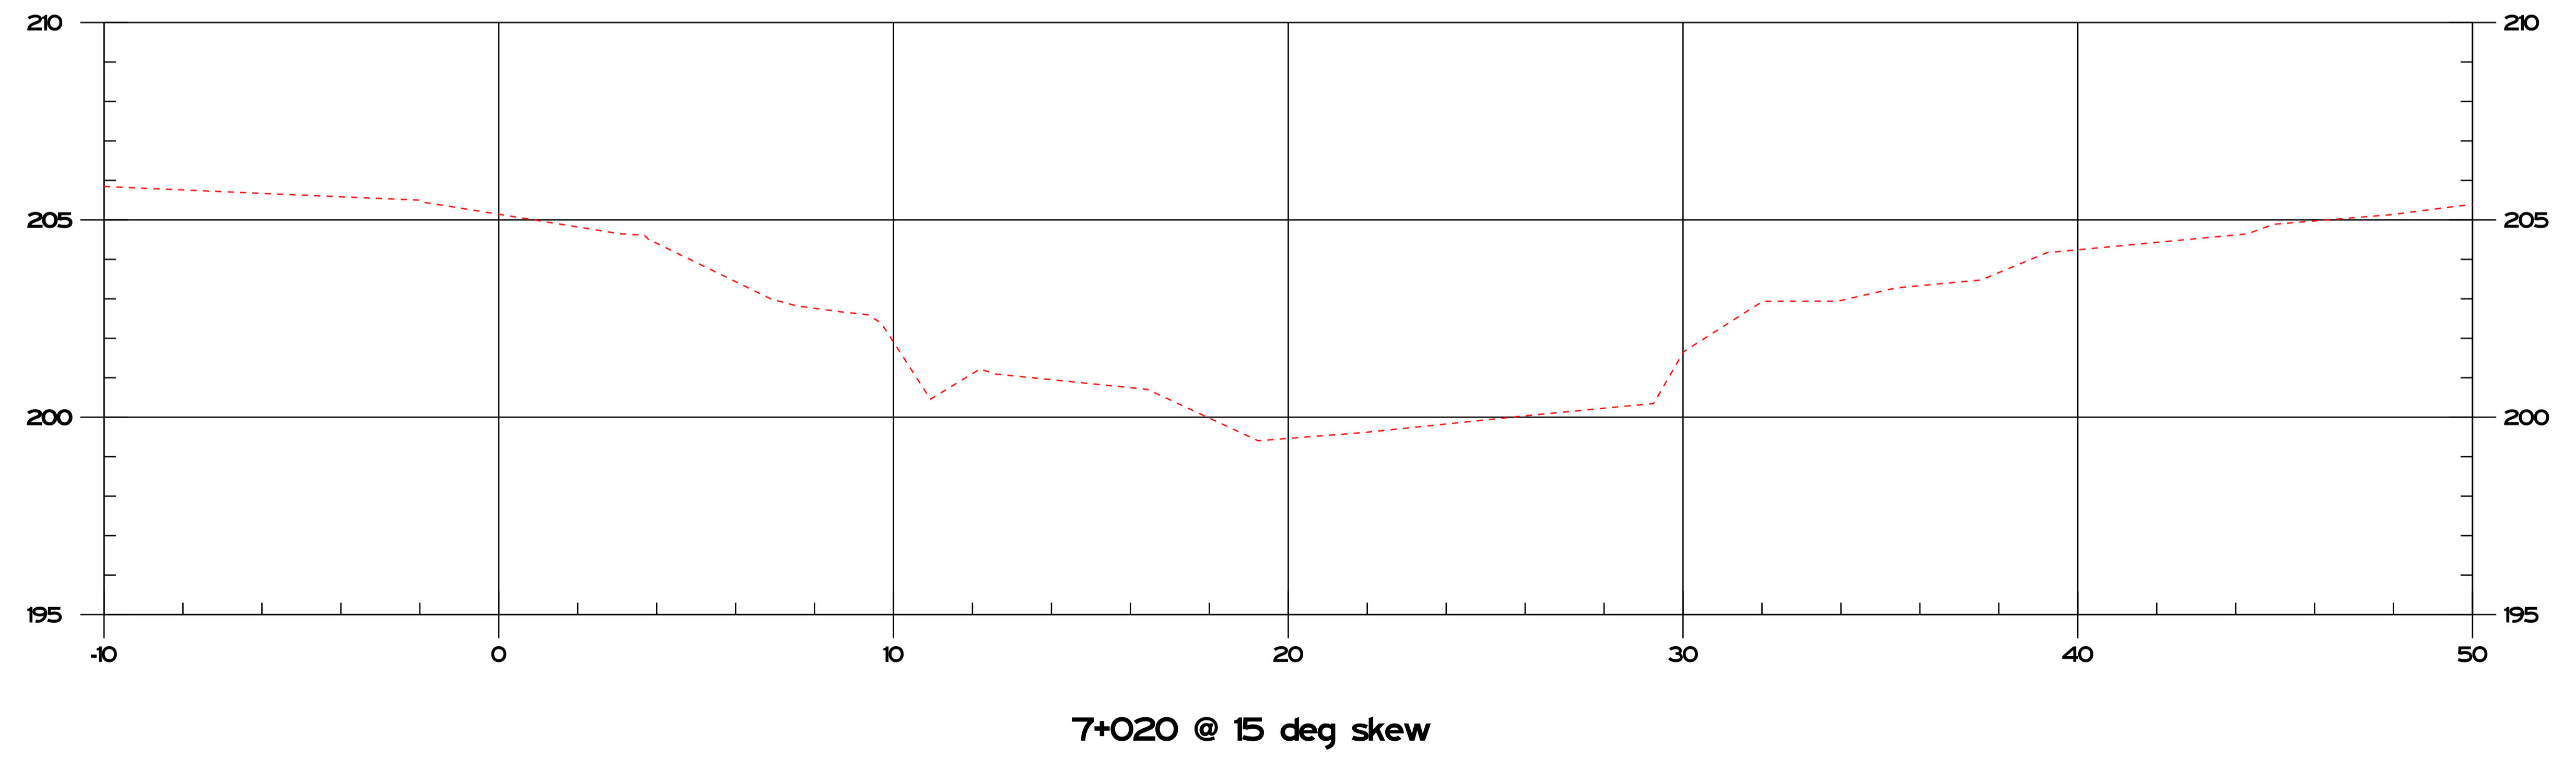


FINISH PRODUCTS DRAWN ON ALTERNATE CHANNEL SECTIONS ARE DRAWN  
 ACCORDING TO REVISED GRADES (SEE WO #2 DATED 6-8-09) FOR USE IN  
 DETERMINING STRUCTURE EXCAVATION AND GRANULAR BACKFILL QUANTITIES  
 CJJ 12-3-09

RIGHT  
 GRAN. BKFL. FOR STR. (SM) = 4.804 CJJ 12-3-09  
 STRUCTURE EXC. (SM) = 3.364 CJJ 12-3-09

FAR RIGHT  
 GRAN. BKFL. FOR STR. = 4.440 CJJ 12-3-09  
 STRUCTURE EXC. (SM) = 0 CJJ 12-3-09

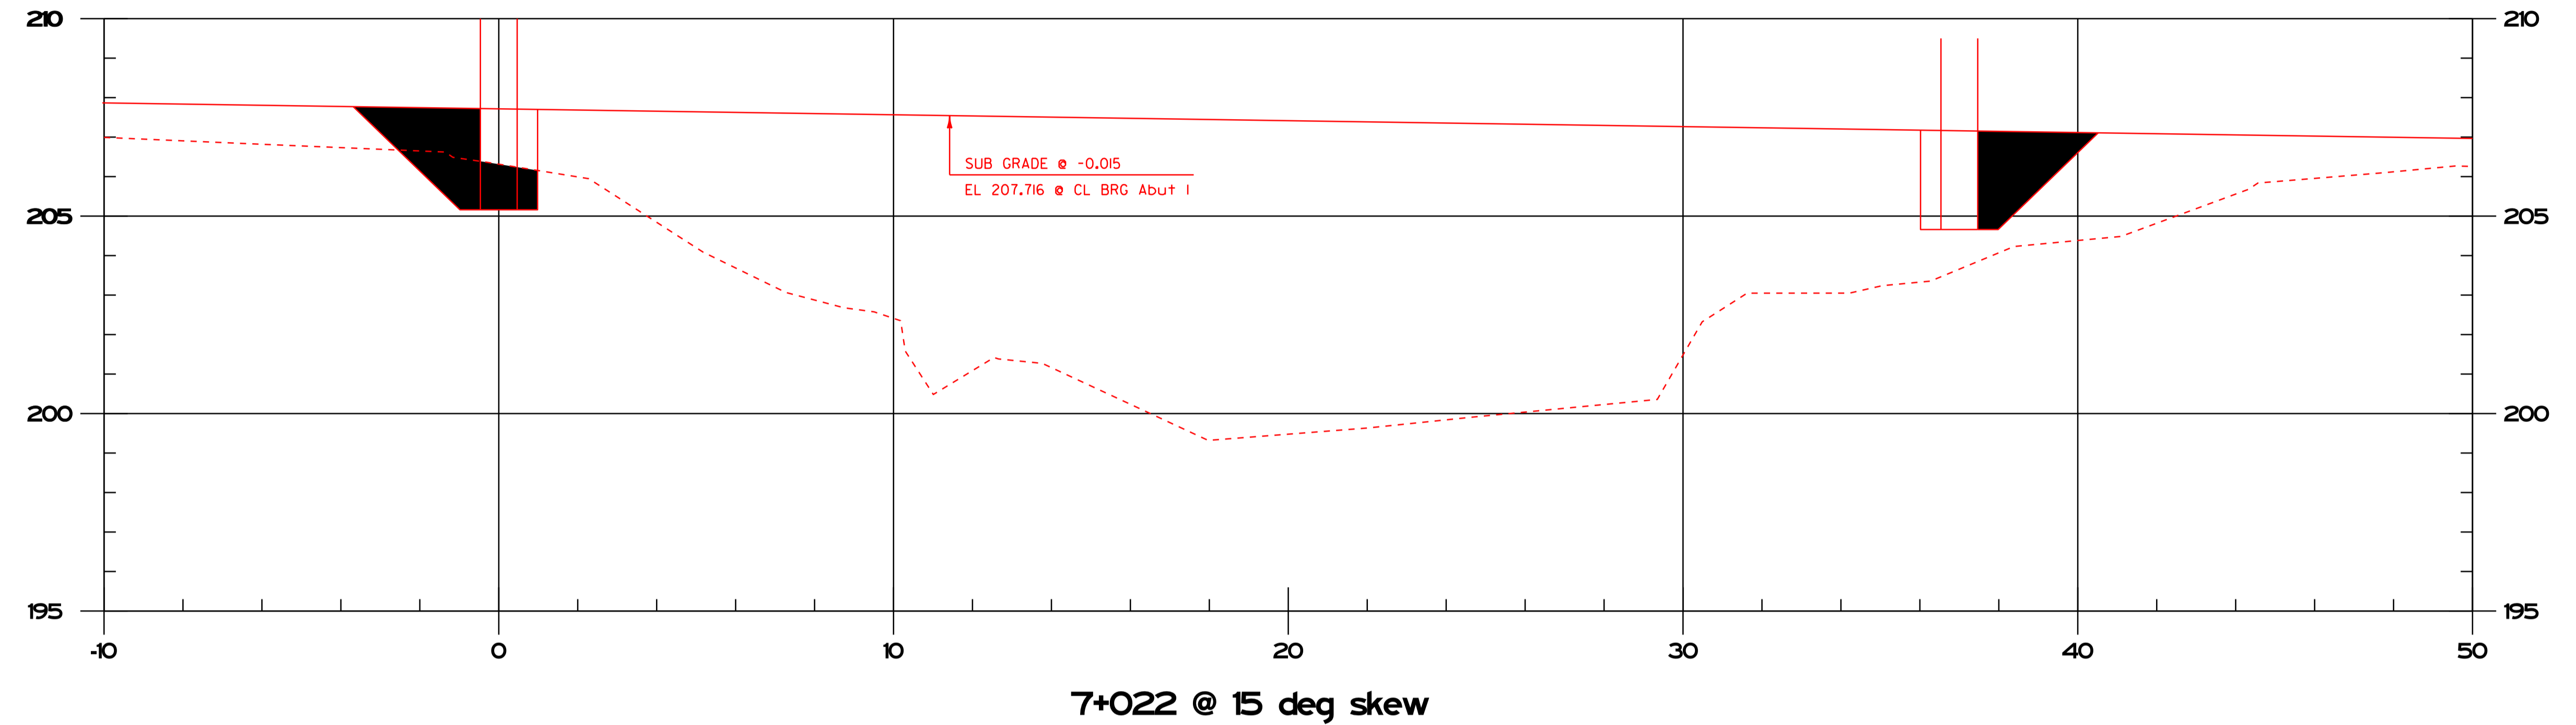

|   |                                |
|---|--------------------------------|
| PROJECT:<br>EAST MONTPELIER               | PROJECT NO. :<br>BRF 028-3(36) |
| DESIGN FILE NAME: /98b254/str/sb254xs.dgn | PLOT DATE: 21-MAY-2012 16:     |
| IPARM FILE NAME: sb254xi5.i               | DRAWN BY: R. PELLETT           |
| DESIGNED BY: C.JOLLY                      | CHECKED BY: J. LACROIX         |
| SQUAD LEADER: C.JOLLY                     | SHEET: \$S*\$ OF \$T*\$        |
| CHANNEL CROSS SECTIONS #4                 |                                |