



FINISH PRODUCTS DRAWN ON ALTERNATE CHANNEL SECTIONS ARE DRAWN ACCORDING TO REVISED GRADES (SEE WO #2 DATED 6-8-09) FOR USE IN DETERMINING STRUCTURE EXCAVATION AND GRANULAR BACKFILL QUANTITIES
CJJ 12-3-09

RIGHT
GRAN. BKFL. FOR STR. (SM) = 5.108 CJJ 12-3-09
STRUCTURE EXC. (SM) = 8.021 CJJ 12-3-09

FAR RIGHT
GRAN. BKFL. FOR STR. (SM) = 4.729 CJJ 12-3-09
STRUCTURE EXC. (SM) = 0 CJJ 12-3-09

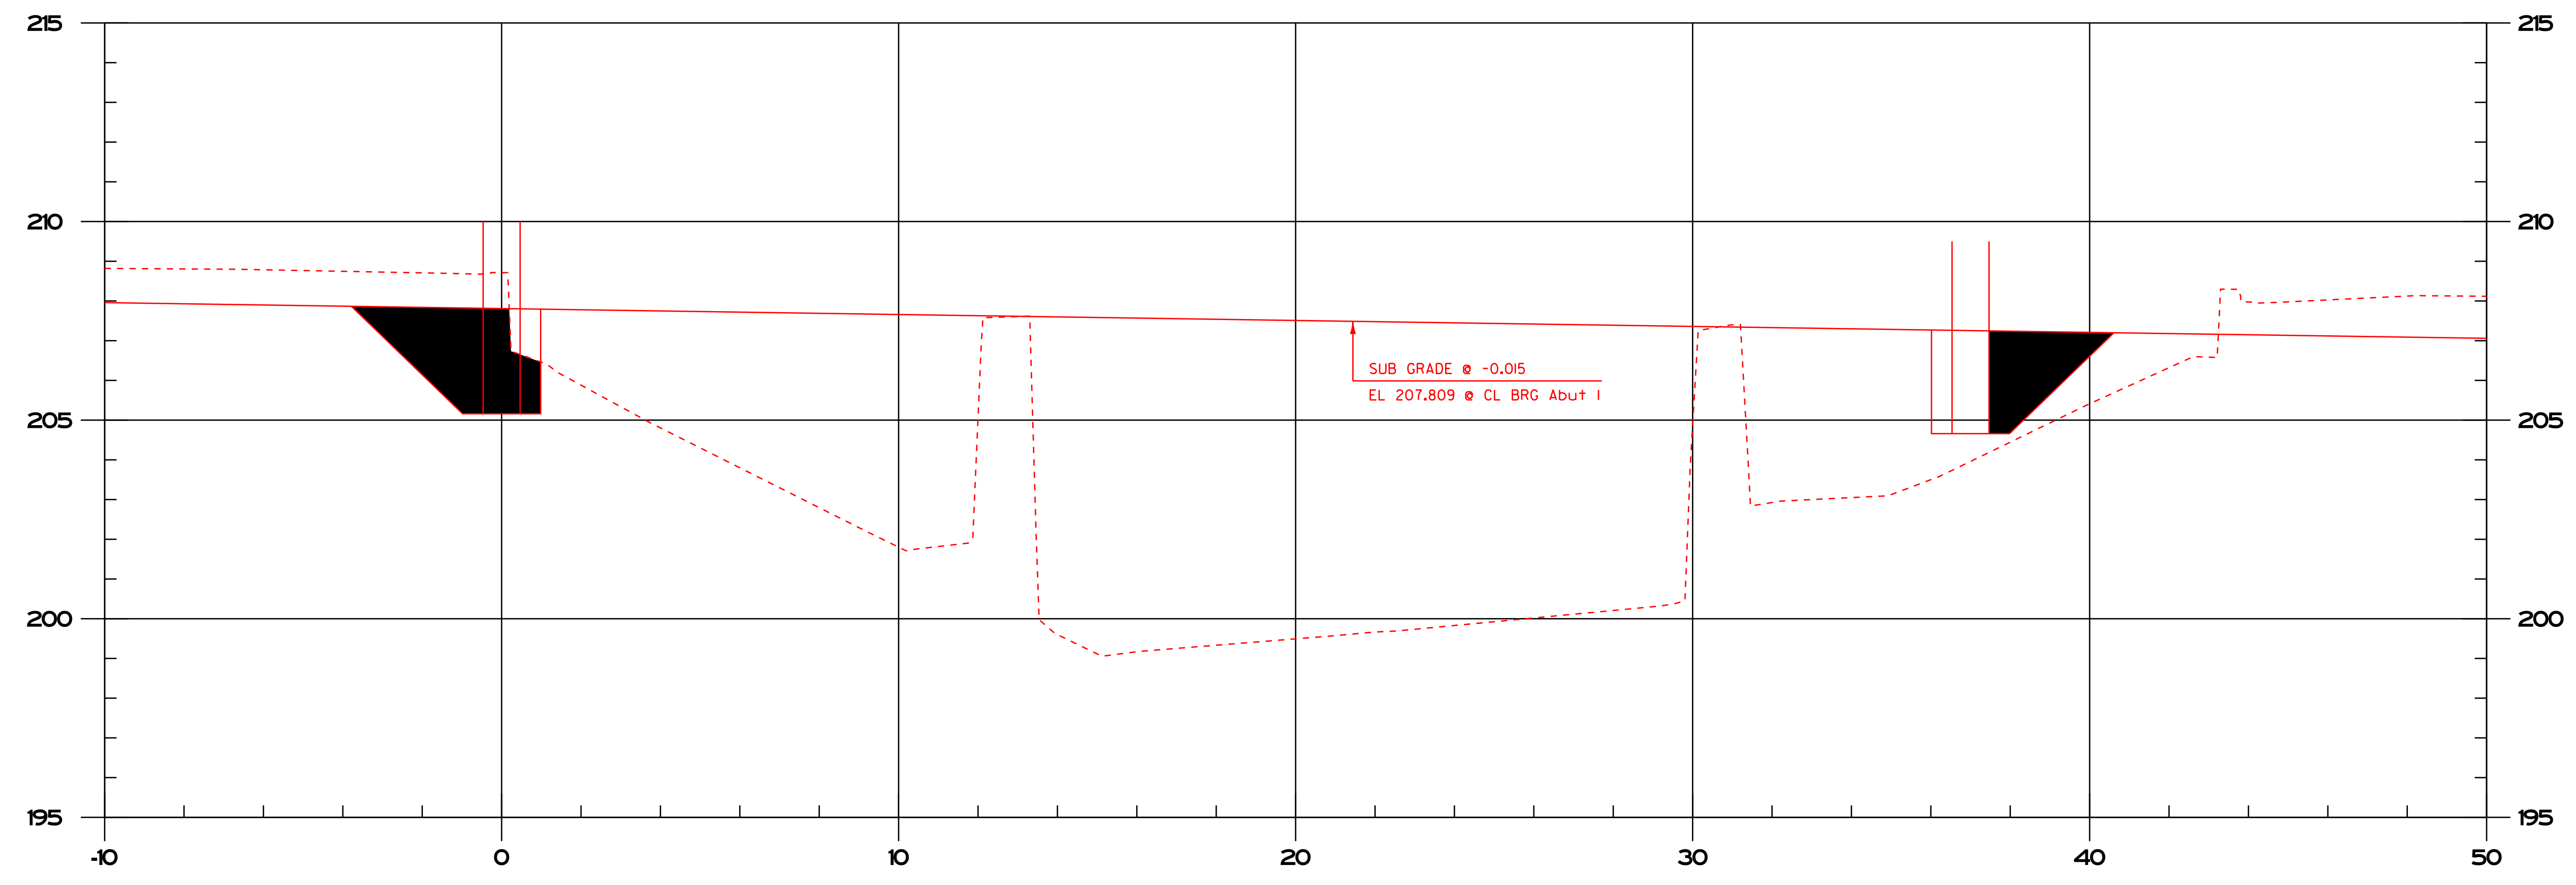

7+026 @ 15 deg skew

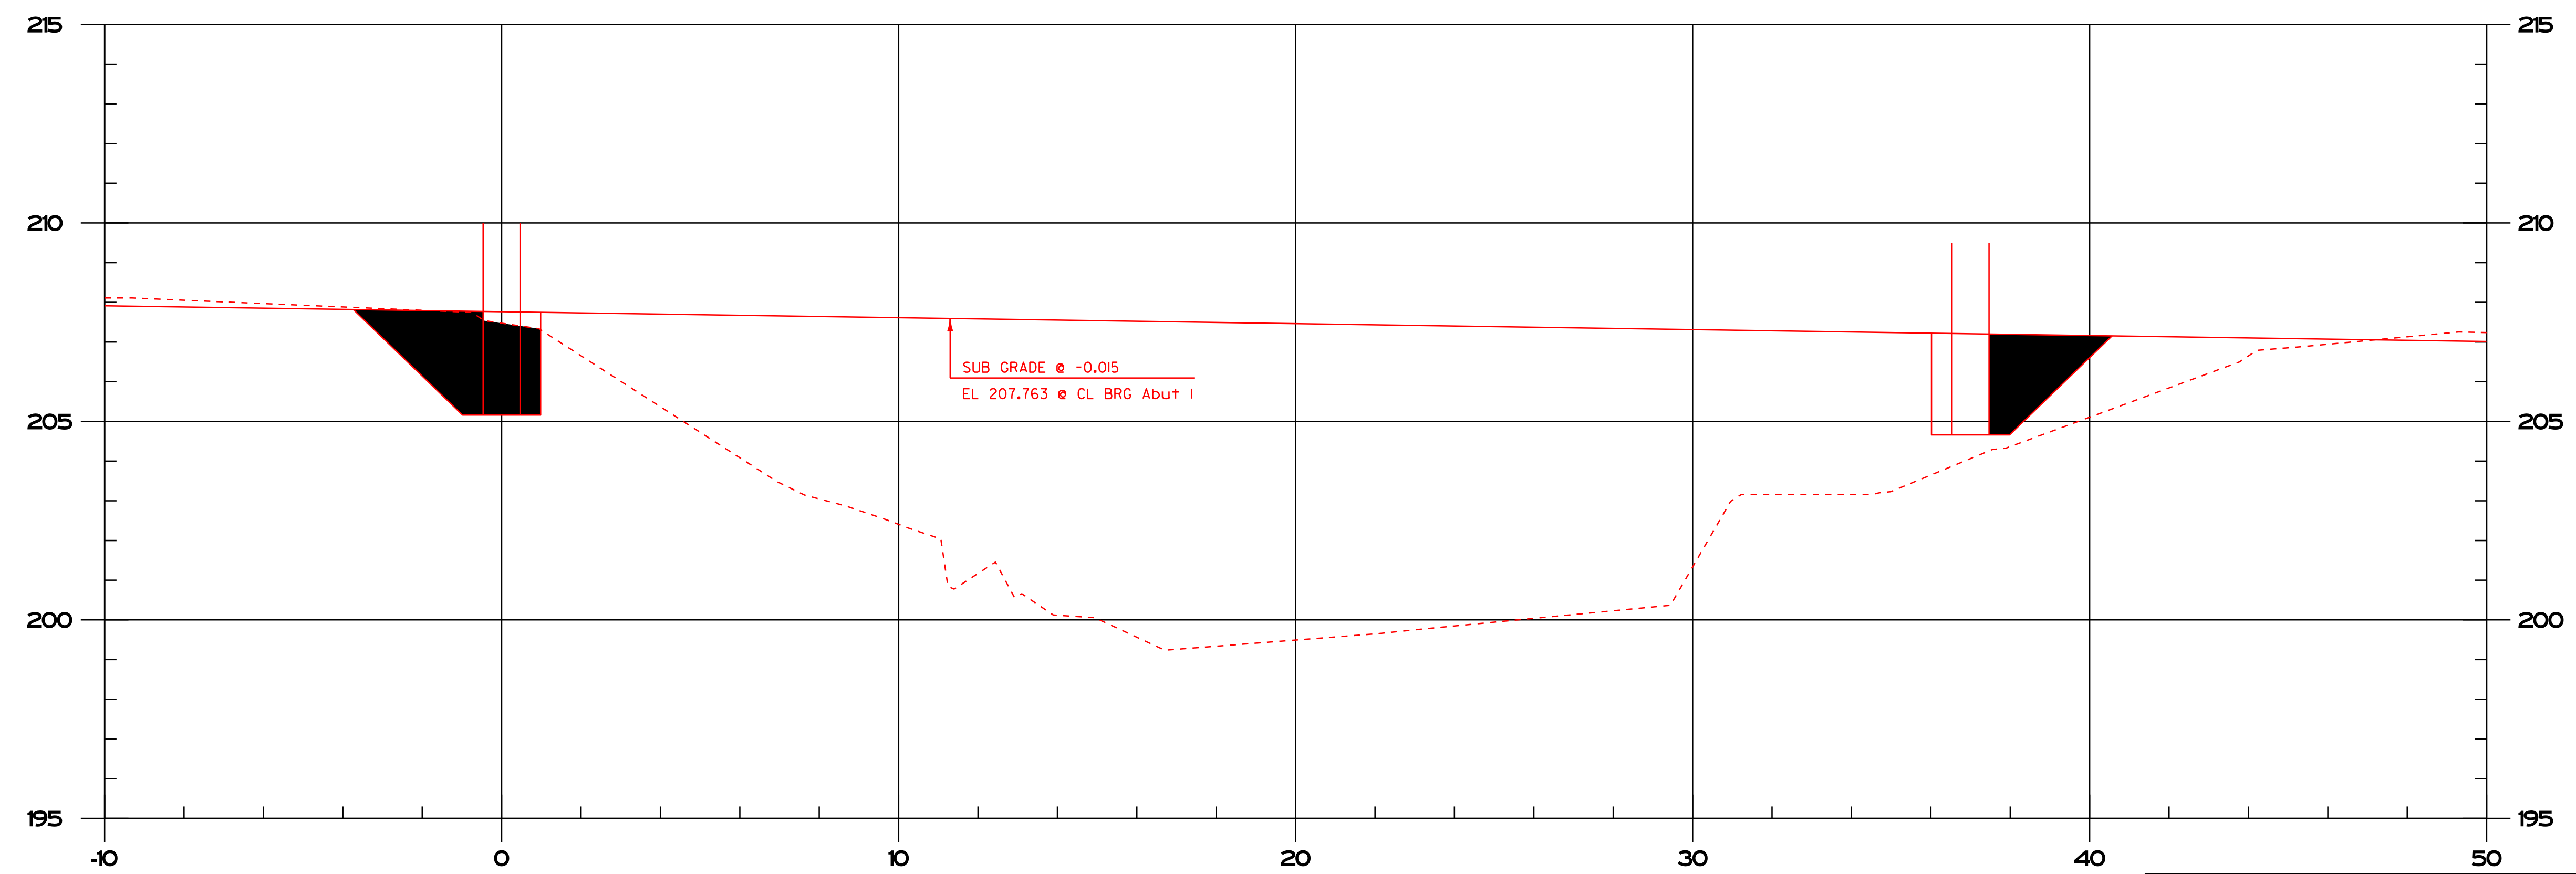

7+024 @ 15 deg skew

RIGHT
GRAN. BKFL. FOR STR. (SM) = 4.956 CJJ 12-3-09
STRUCTURE EXC. (SM) = 8.206 CJJ 12-3-09

FAR RIGHT
GRAN. BKFL. FOR STR. (SM) = 4.585 CJJ 12-3-09
STRUCTURE EXC. (SM) = 0 CJJ 12-3-09



PROJECT: EAST MONTPELIER	PROJECT NO. : BRF 028-3(36)
DESIGN FILE NAME: /98b254/str/sb254xs.dgn	PLOT DATE: 21-MAY-2012 16:00
IPARM FILE NAME: sb254xi5.i	DRAWN BY: R. PELLETT
DESIGNED BY: J. LACROIX	CHECKED BY: J. LACROIX
SQUAD LEADER: K. HIGGINS	SHEET:\$S*\$ OF \$T*\$
CHANNEL CROSS SECTIONS #4	