



FINISH PRODUCTS DRAWN ON ALTERNATE CHANNEL SECTIONS ARE DRAWN
 ACCORDING TO REVISED GRADES (SEE WO #2 DATED 6-8-09) FOR USE IN
 DETERMINING STRUCTURE EXCAVATION AND GRANULAR BACKFILL QUANTITIES
 CJJ 12-3-09

RIGHT
 GRAN. BKFL. FOR STR. (SM) = 5.421 CJJ 12-3-09
 STRUCTURE EXC. (SM) = 6.153 CJJ 12-3-09

FAR RIGHT
 GRAN. BKFL. FOR STR. (SM) = 5.026 CJJ 12-3-09
 STRUCTURE EXC. (SM) = 0 CJJ 12-3-09

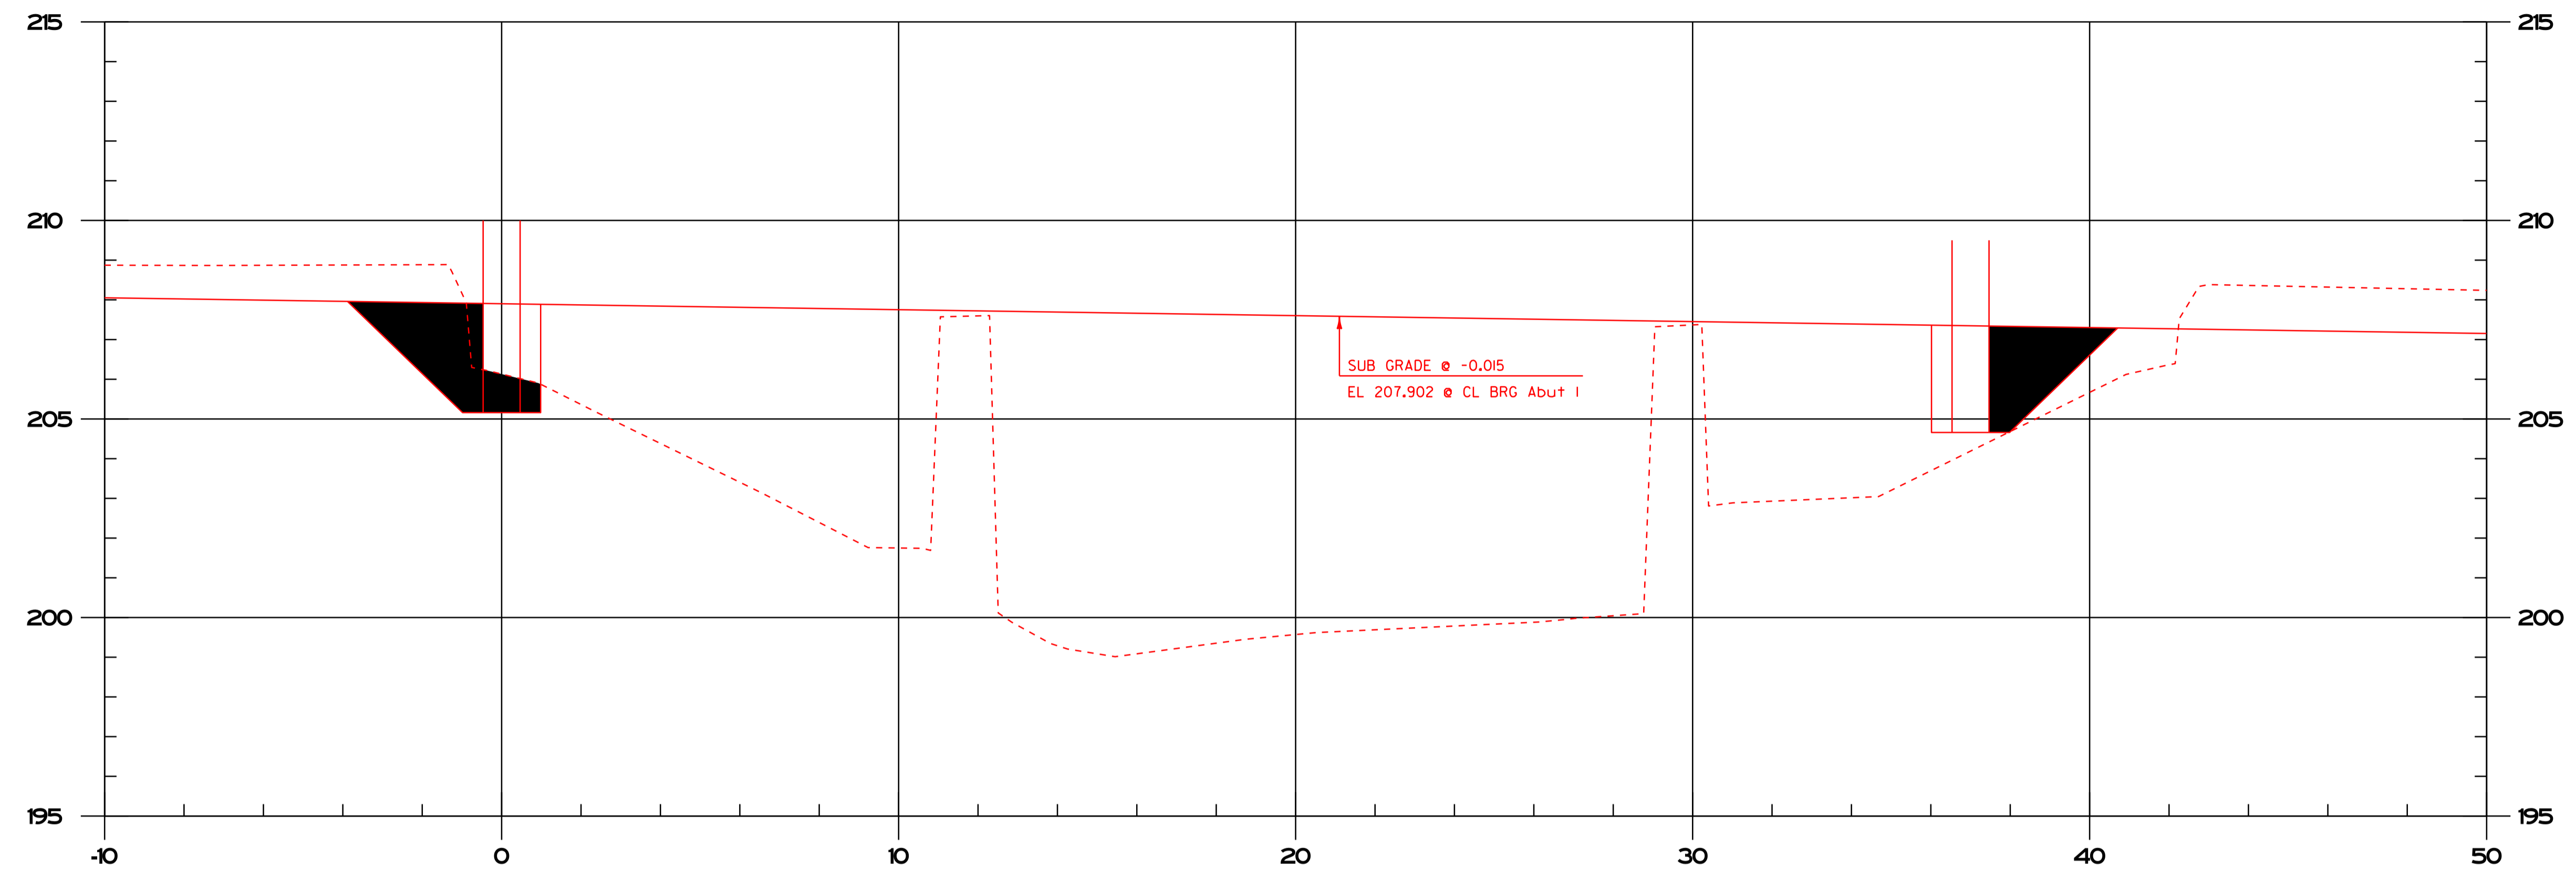

7+030 @ 15 deg skew

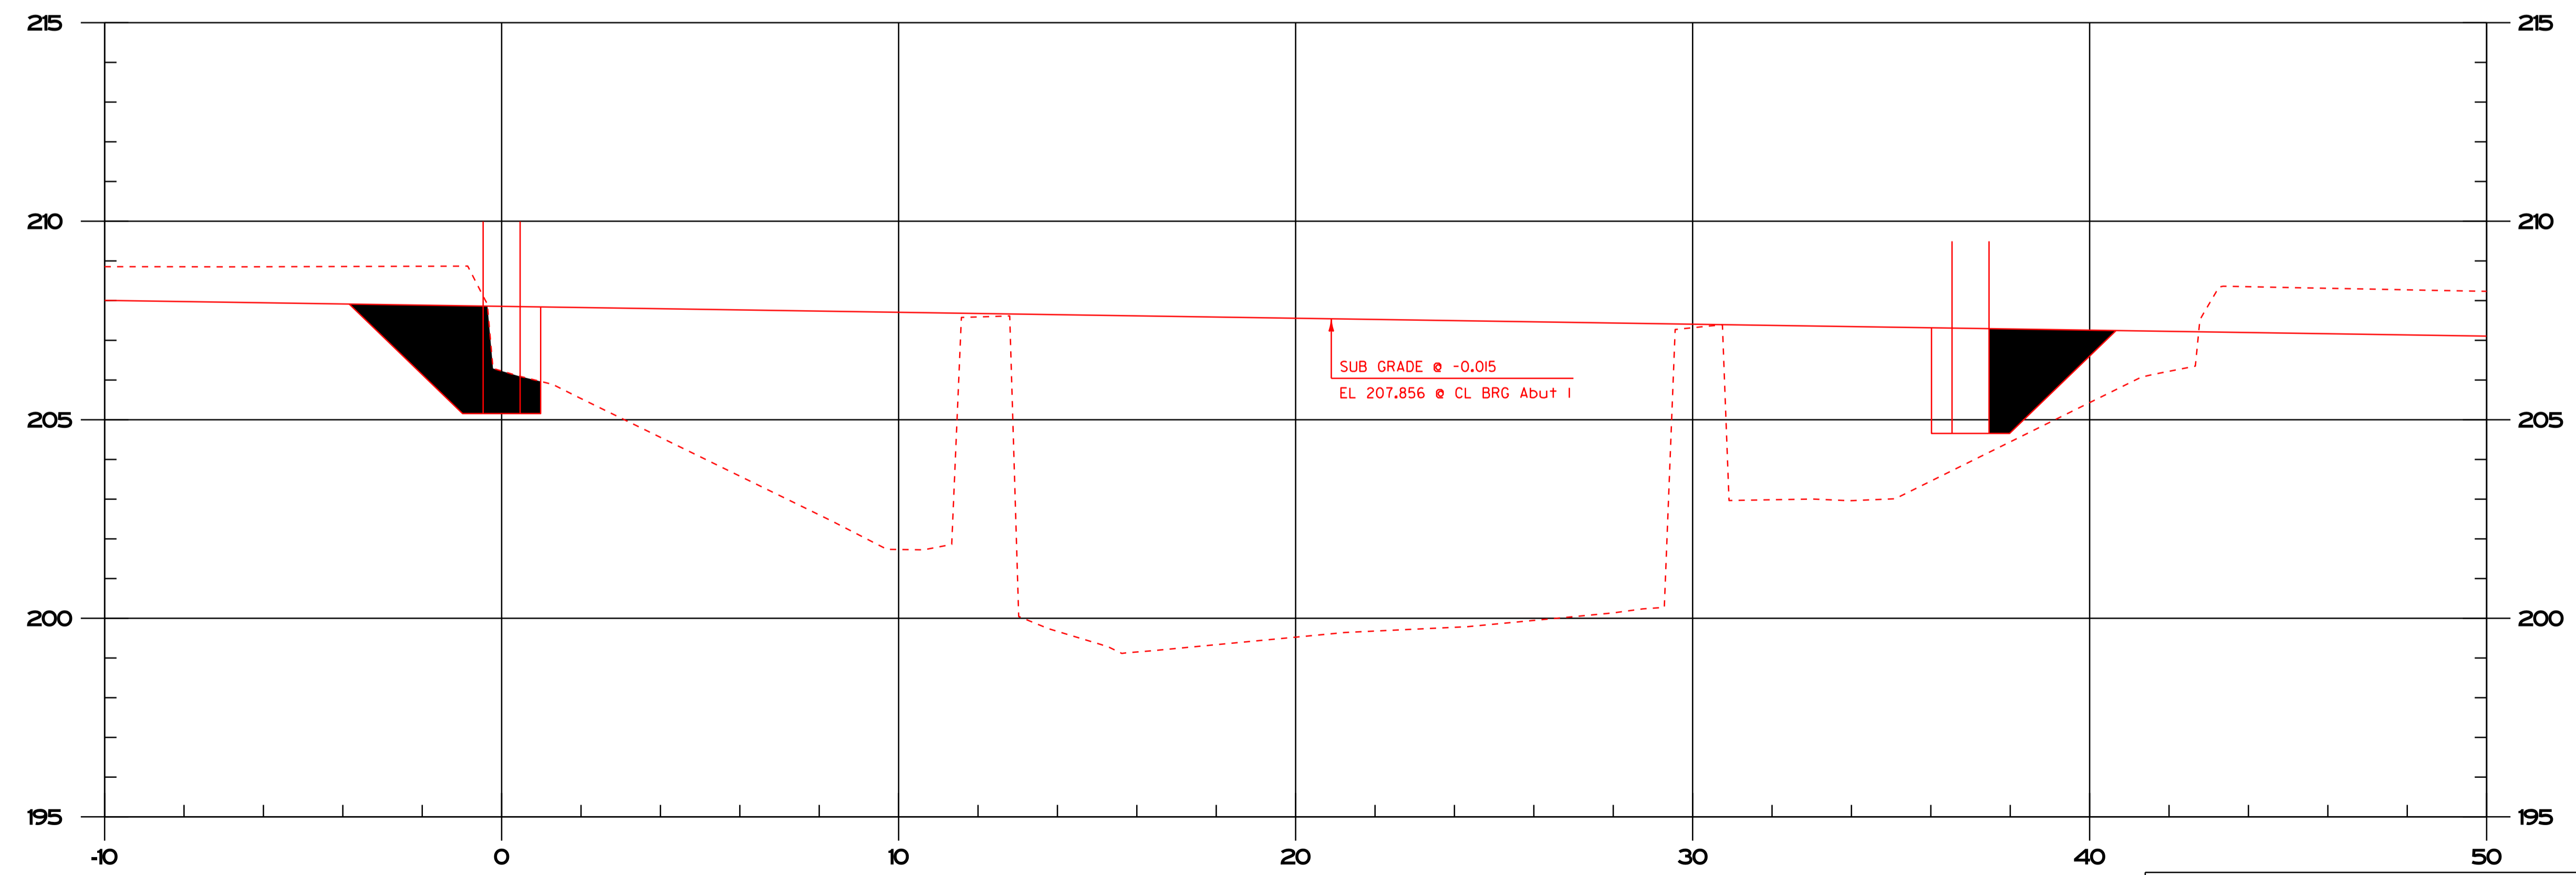

7+028 @ 15 deg skew

RIGHT
 GRAN. BKFL. FOR STR. (SM) = 5.282 CJJ 12-3-09
 STRUCTURE EXC. (SM) = 7.005 CJJ 12-3-09

FAR RIGHT
 GRAN. BKFL. FOR STR. (SM) = 4.894 CJJ 12-3-09
 STRUCTURE EXC. (SM) = 0 CJJ 12-3-09



PROJECT: EAST MONTPELIER	PROJECT NO. : BRF 028-3(36)
DESIGN FILE NAME: /98b254/str/sb254xs.dgn	PLOT DATE: 21-MAY-2012 16:
IPARM FILE NAME: sb254x15.1	DRAWN BY: R. PELLETT
DESIGNED BY: J. LACROIX	CHECKED BY: J. LACROIX
SQUAD LEADER: K. HIGGINS	SHEET: \$S*\$ OF \$T*\$
CHANNEL CROSS SECTIONS #4	7-31-09 jls