



FINISH PRODUCTS DRAWN ON ALTERNATE CHANNEL SECTIONS ARE DRAWN ACCORDING TO REVISED GRADES (SEE WO #2 DATED 6-8-09) FOR USE IN DETERMINING STRUCTURE EXCAVATION AND GRANULAR BACKFILL QUANTITIES  
CJJ 12-3-09

RIGHT  
GRAN. BKFL. FOR STR. (SM) = 5.211  
STRUCTURE EXC. (SM) = 5.158  
CJJ 12-3-09  
CJJ 12-3-09

FAR RIGHT  
GRAN. BKFL. FOR STR. (SM) = 4.827  
STRUCTURE EXC. (SM) = 0.724  
CJJ 12-3-09  
CJJ 12-3-09

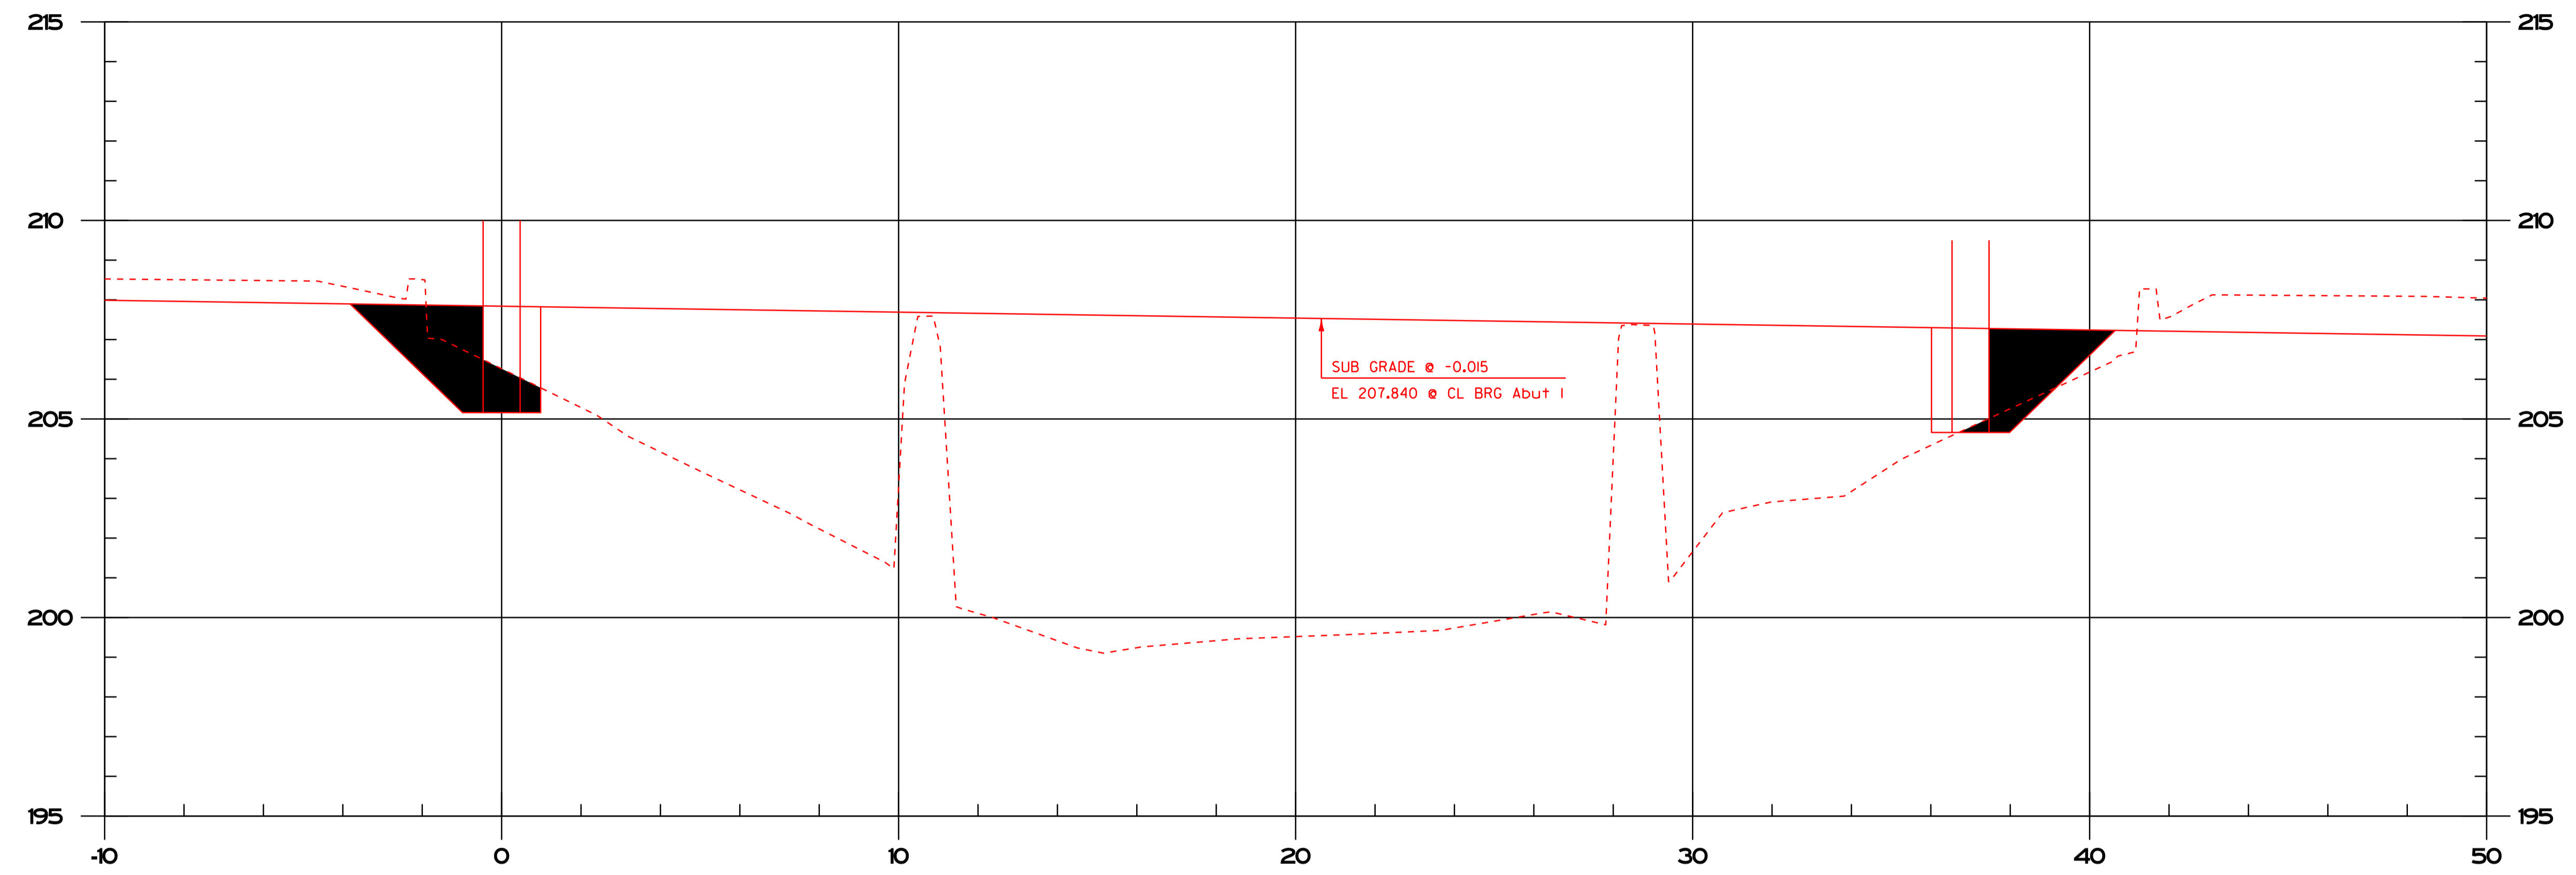

7+034 @ 15 deg skew

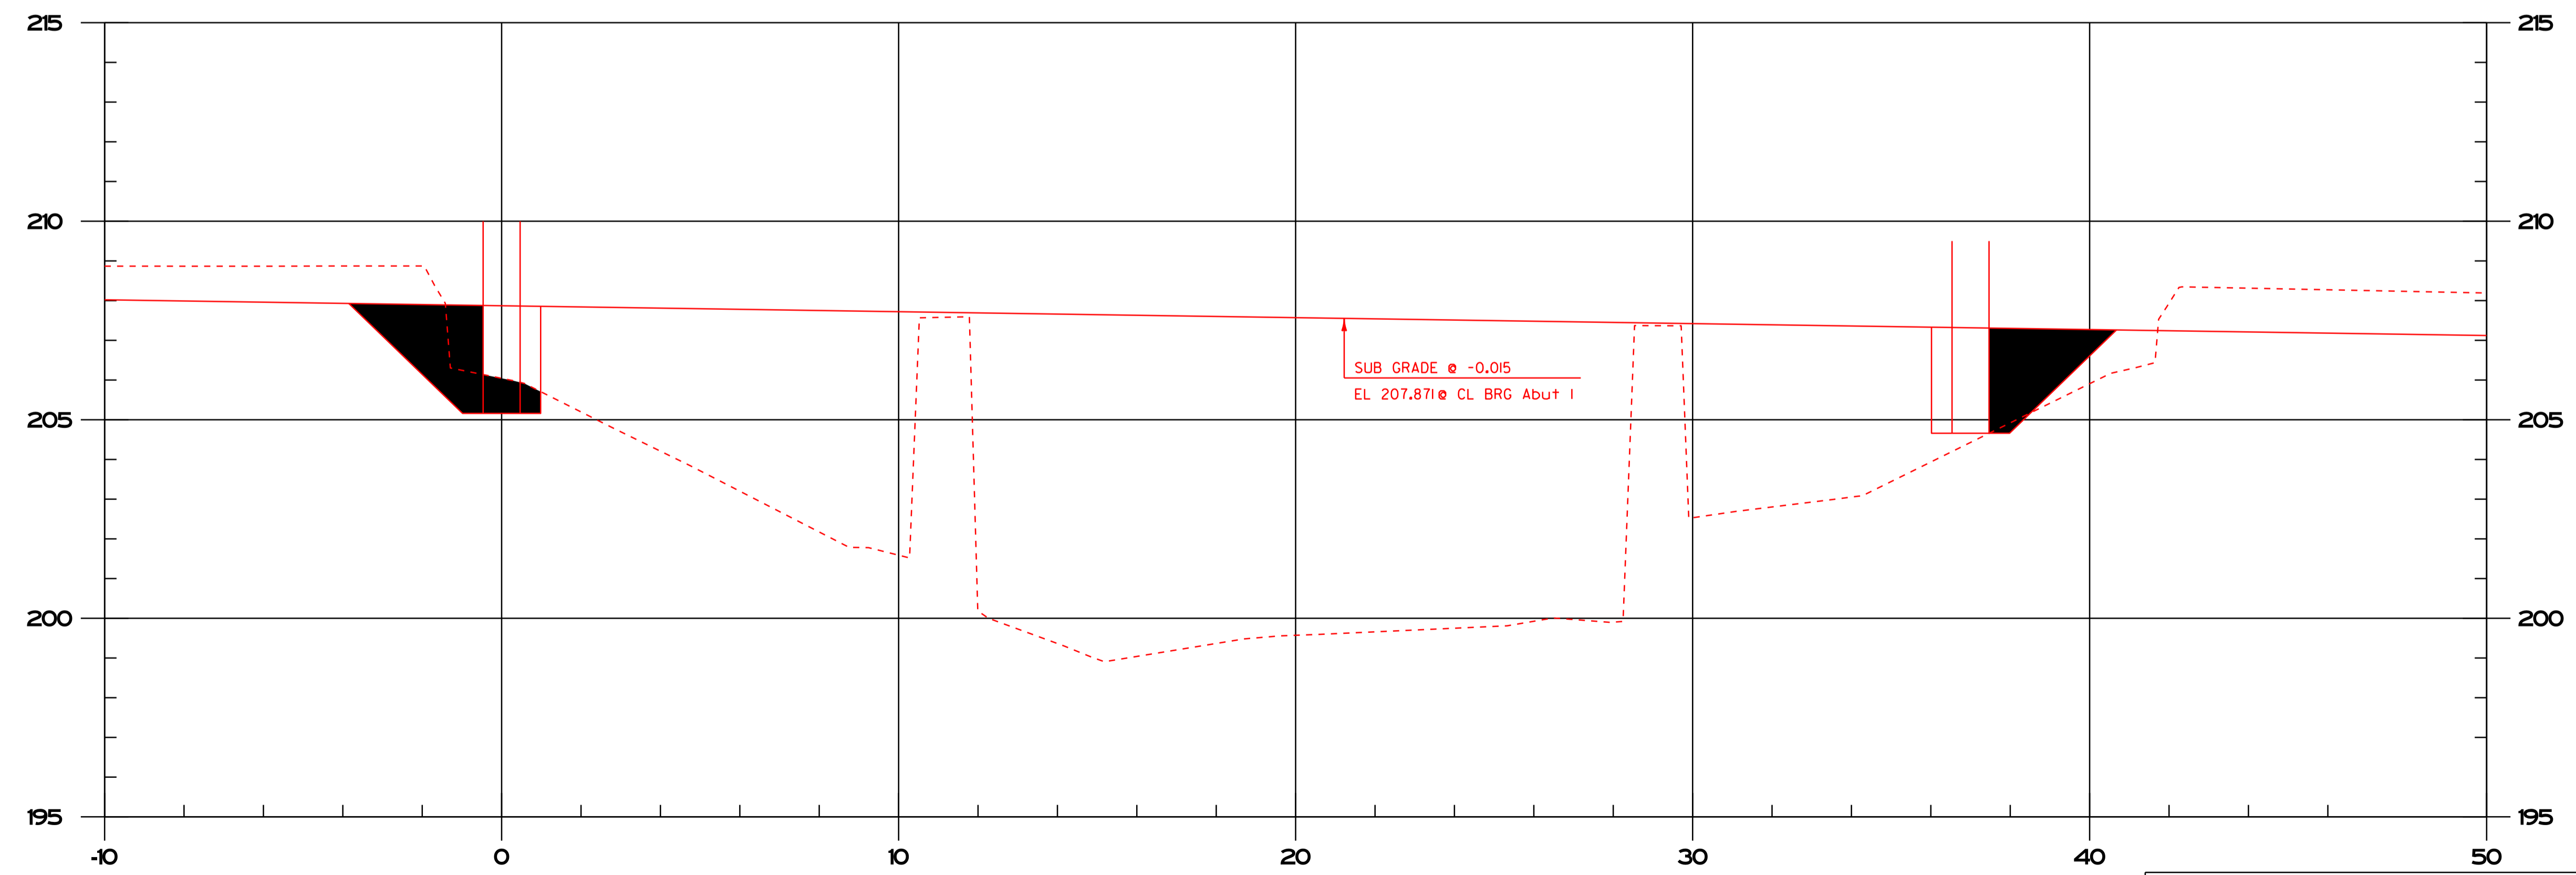

7+032 @ 15 deg skew

RIGHT  
GRAN. BKFL. FOR STR. (SM) = 5.316  
STRUCTURE EXC. (SM) = 5.016  
CJJ 12-3-09  
CJJ 12-3-09

FAR RIGHT  
GRAN. BKFL. FOR STR. (SM) = 4.926  
STRUCTURE EXC. (SM) = 0.133  
CJJ 12-3-09  
CJJ 12-3-09



PROJECT: <b>EAST MONTPELIER</b>	PROJECT NO. : BRF 028-3(36)
DESIGN FILE NAME: /98b254/str/sb254xs.dgn	PLOT DATE: 21-MAY-2012 16:00
IPARM FILE NAME: sb254xi5.1	DRAWN BY: R. PELLETT
DESIGNED BY: J. LACROIX	CHECKED BY: J. LACROIX
SQUAD LEADER: K. HIGGINS	SHEET: \$S*\$ OF \$T*\$
CHANNEL CROSS SECTIONS #4	<b>7-31-09 jls</b>