

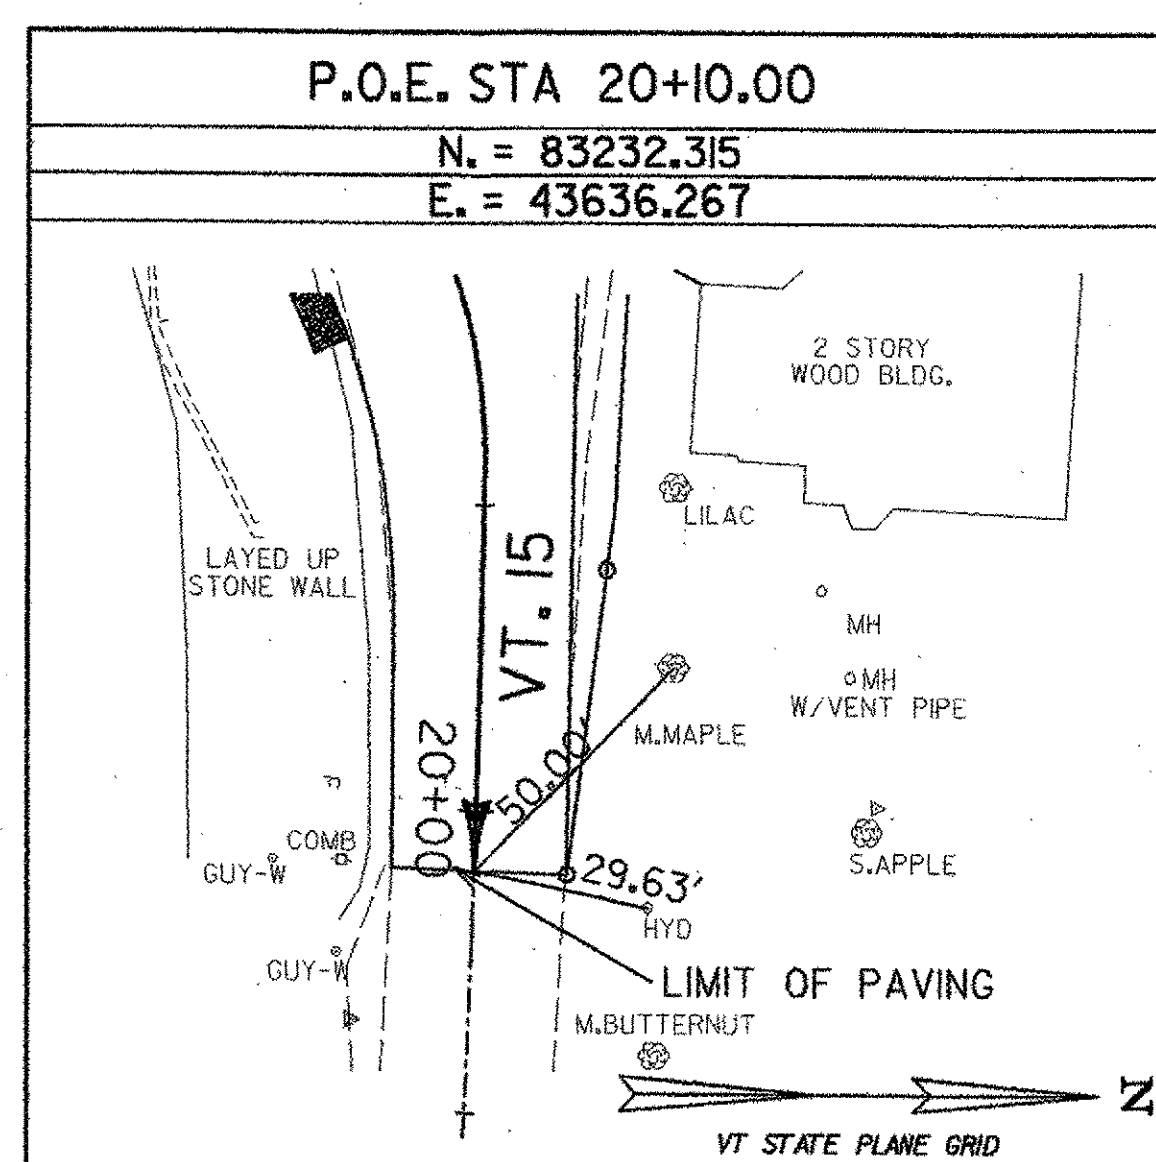
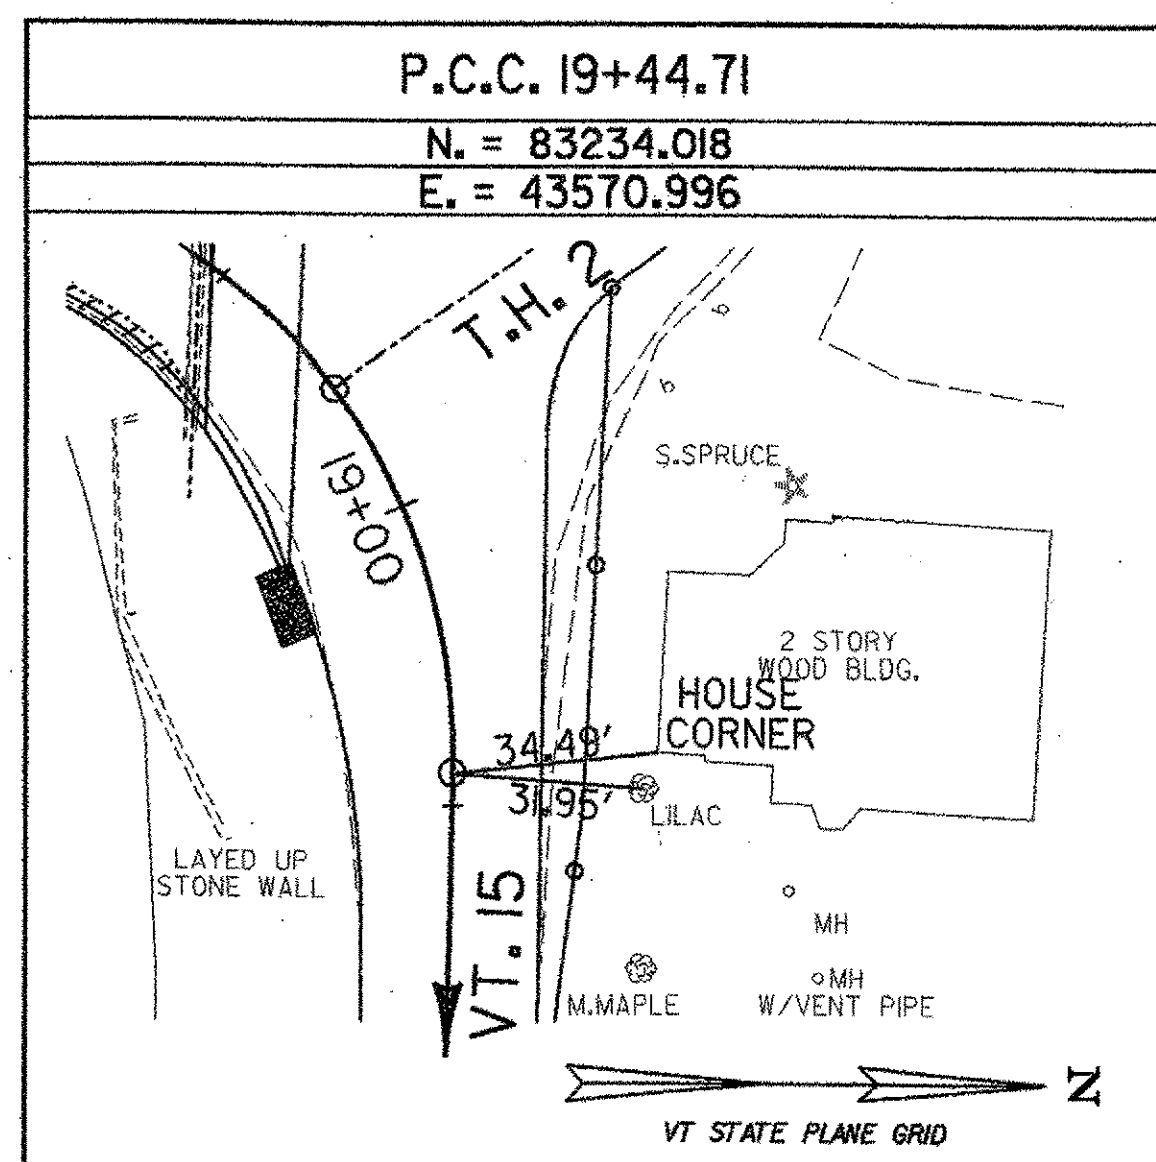
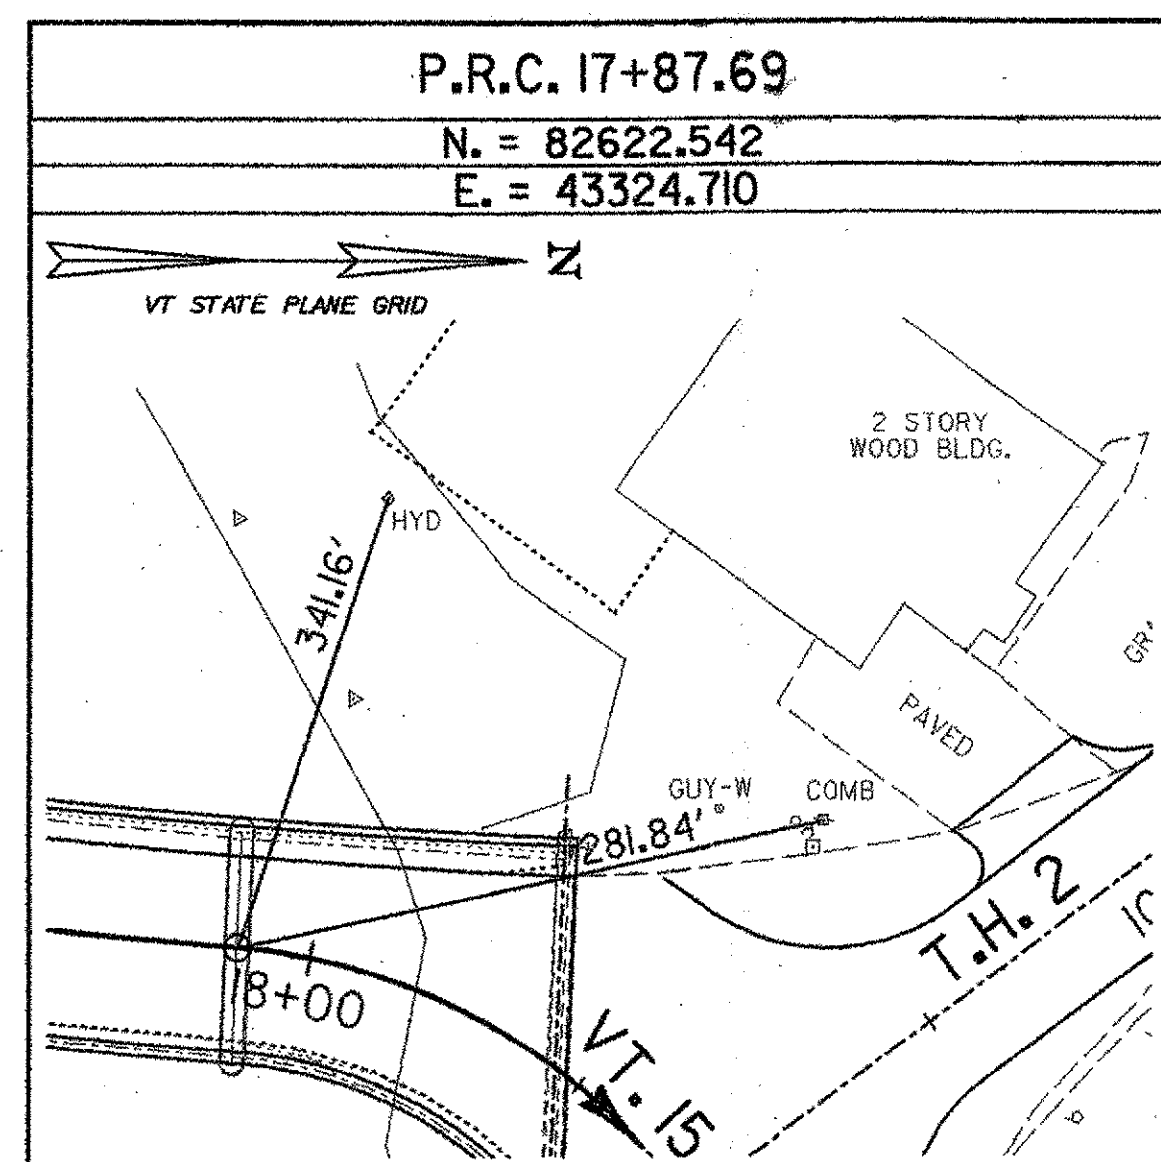
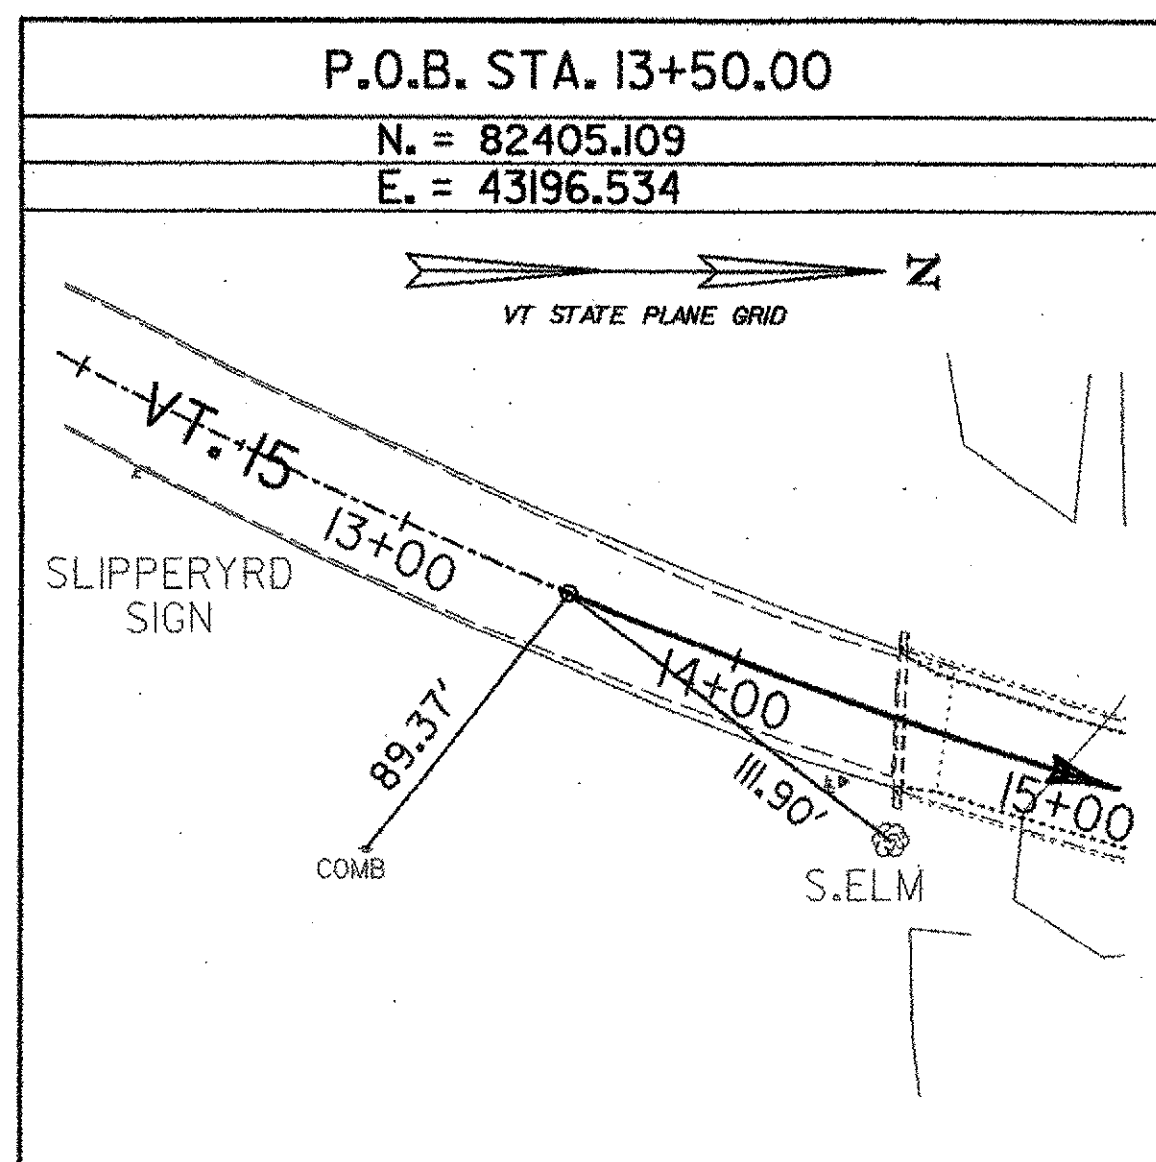
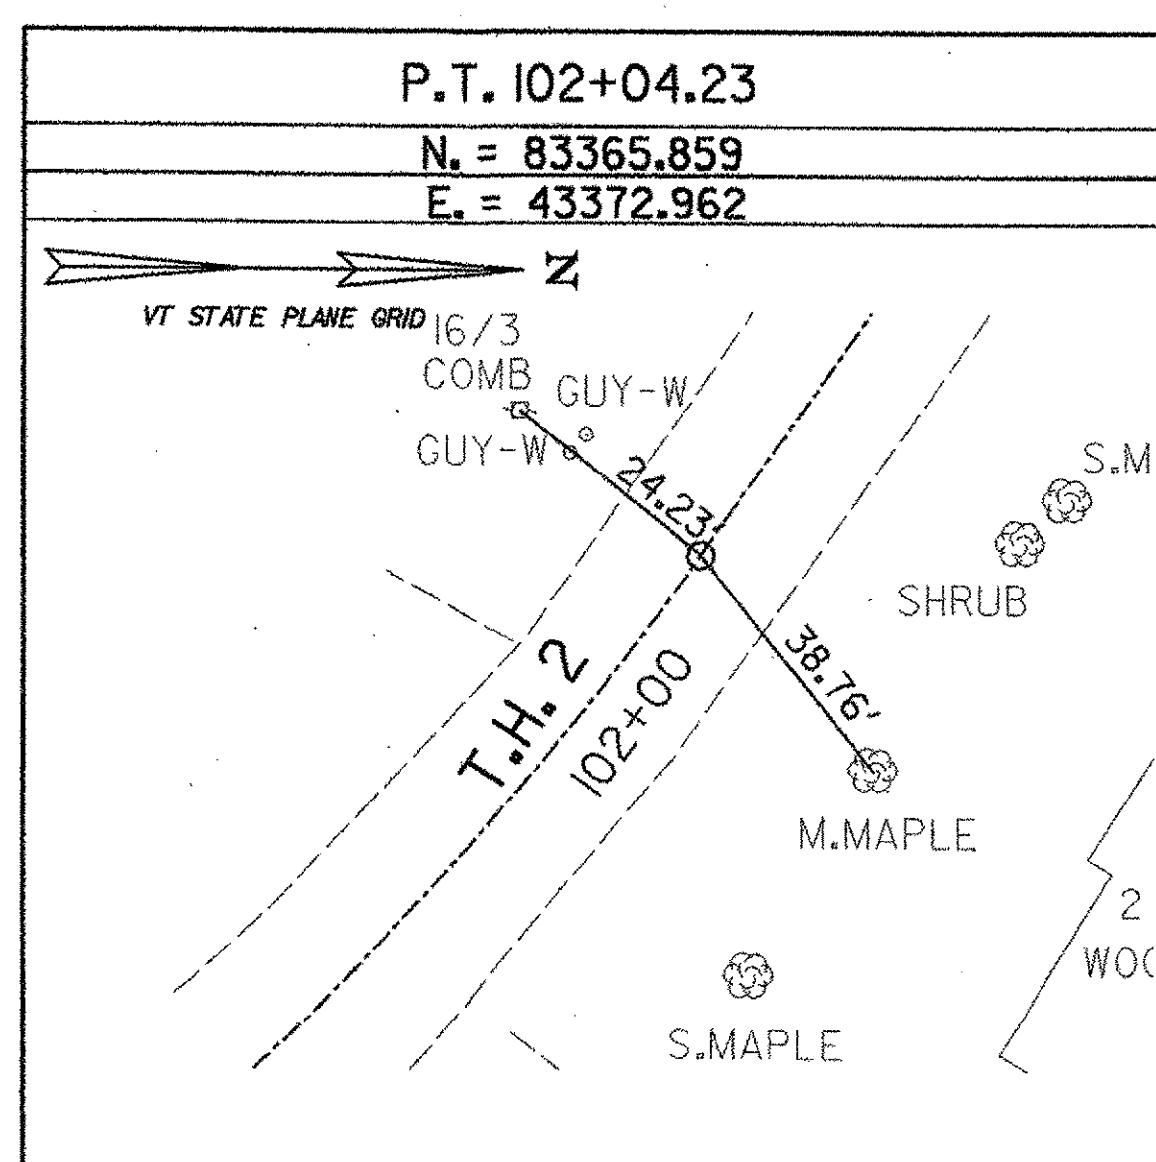
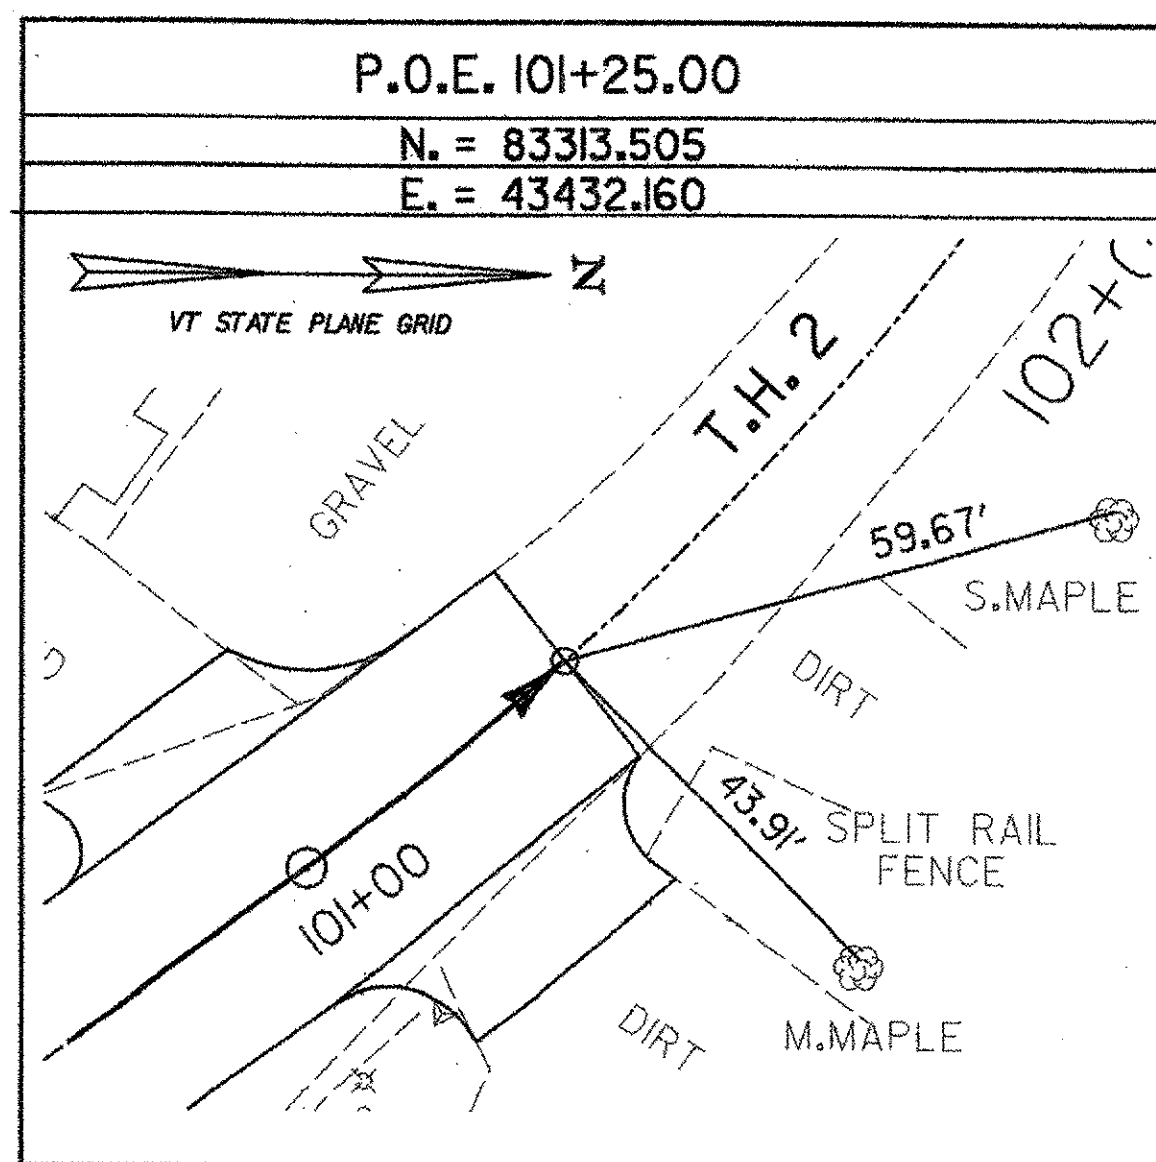


ALIGNMENT TIES ALONG VT. 15

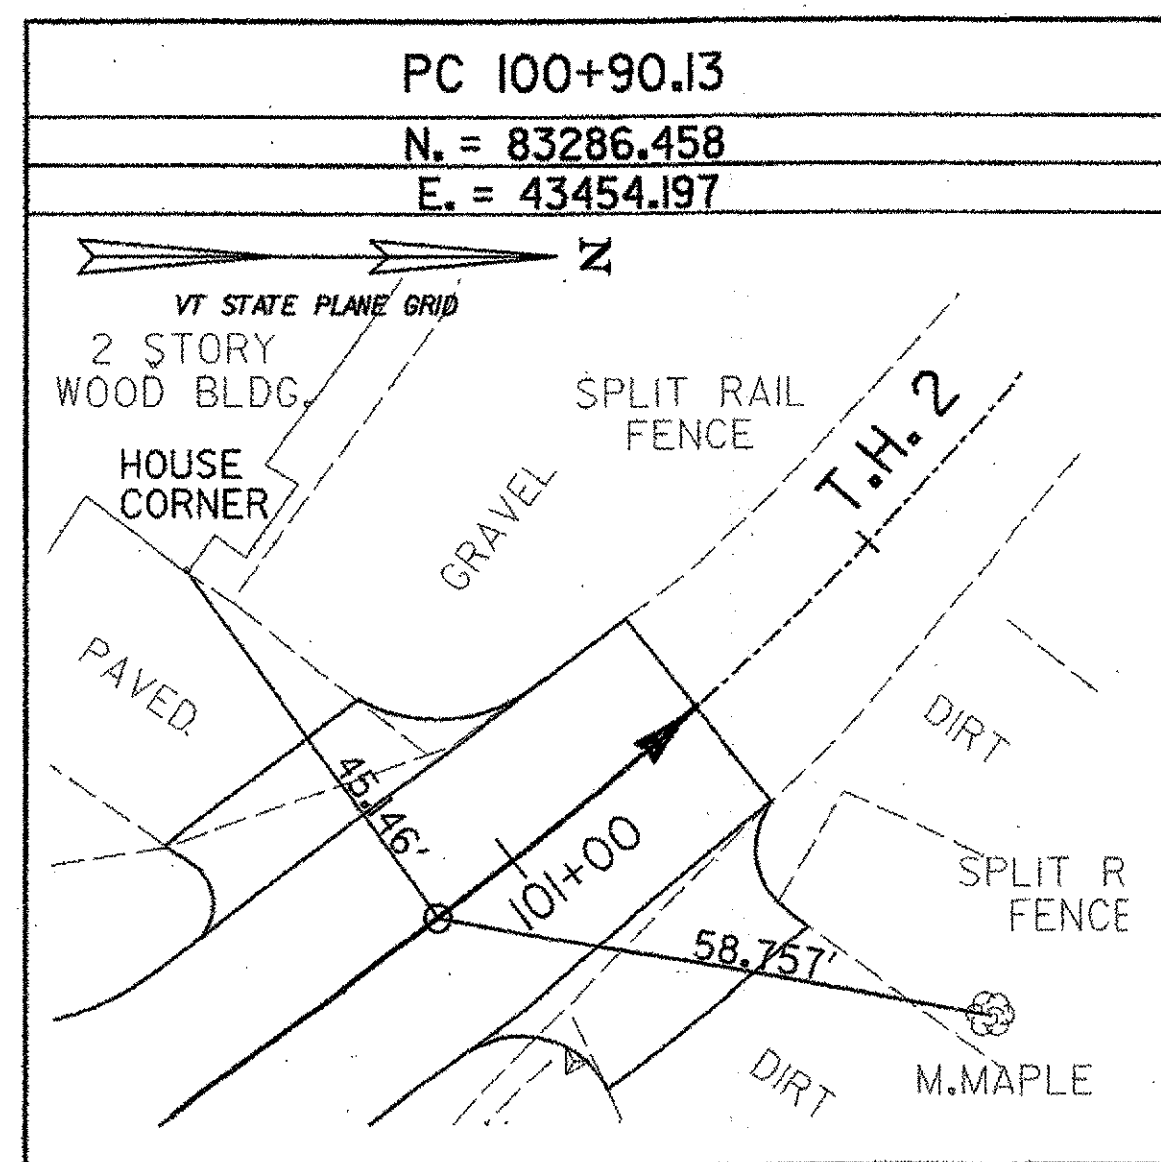

ALIGNMENT TIES ALONG T.H. 2

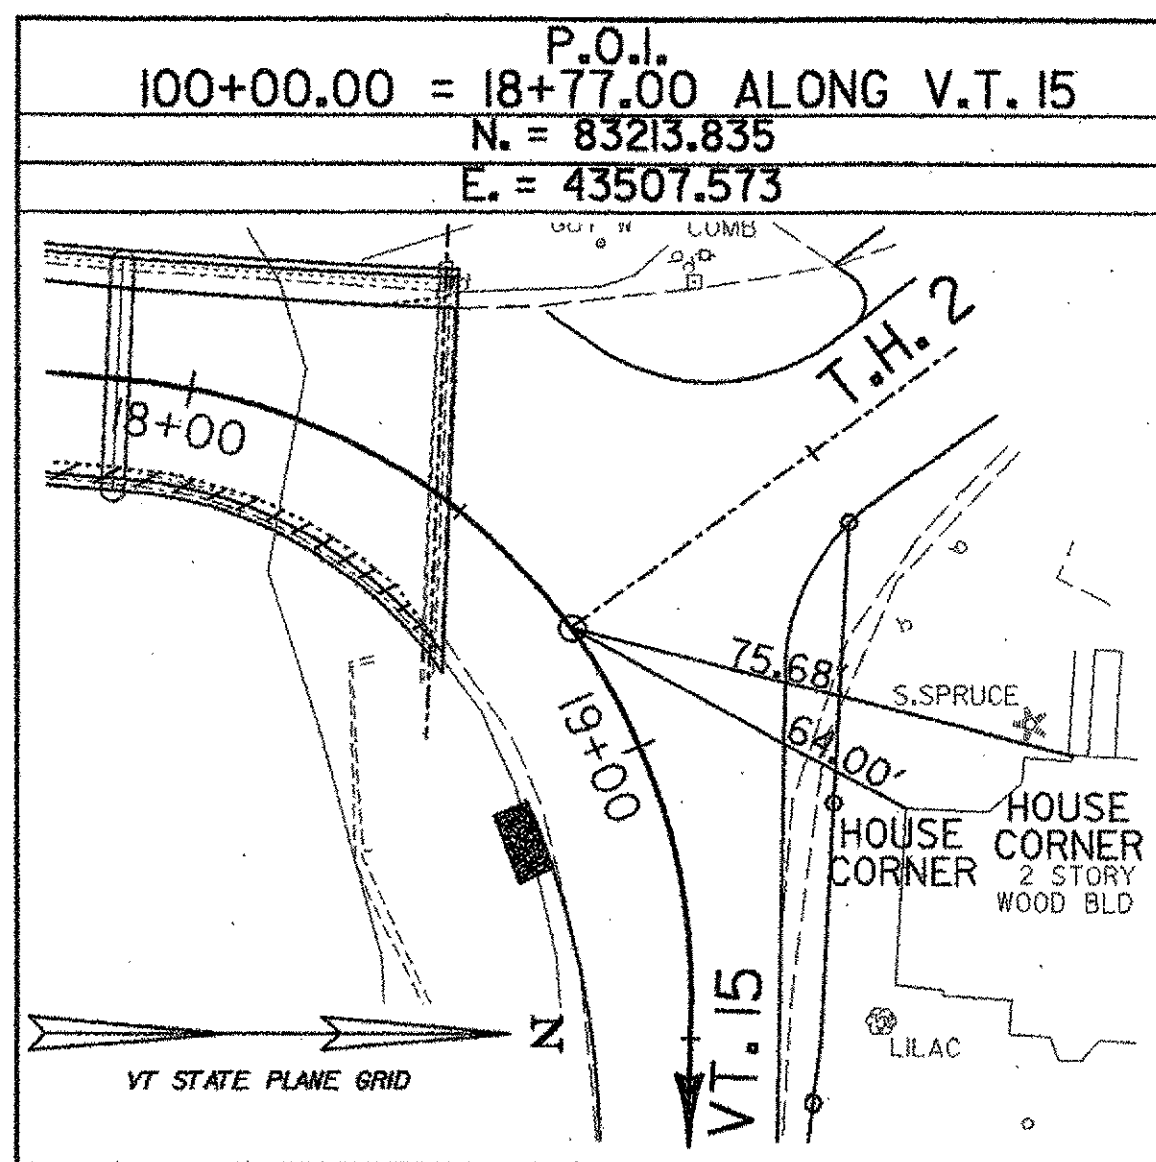

NOTE:
1. TIE DRAWINGS ARE NOT TO SCALE.

TIE SHEET #2

PROJECT NAME: CAMBRIDGE
PROJECT NUMBER: BHF 030-2 (19) S

FILE NAME: ZB308ALL.DGN
PROJECT LEADER: M. K. CHEVALIER
DESIGNED BY: B. ERNST
PLOT DATE: 7-07-00
DRAWN BY: A. N. BEY
CHECKED BY: M. K. CHEVALIER
SHEET 8 OF 68

DATUM
VERTICAL NAVD 88
HORIZONTAL NAD 83