


**PROFILE**

SCALE 1" = 40' HORIZONTAL  
1" = 4' VERTICAL

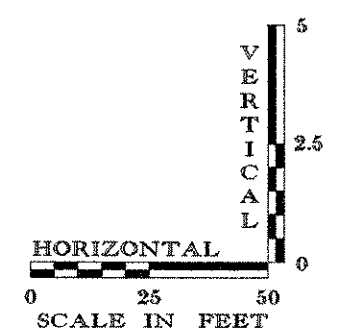

<b>DATUM</b>	
VERTICAL	NAVD 88
HORIZONTAL	NAD 83

NOTE:  
SPAN & SUBSTRUCTURE NUMBERING IS THE SAME AS ORIGINAL PLANS AND IS CONTRARY TO STATIONING USED FOR THIS PROJECT.

<b>PROFILE SHEET (VT 15)</b>	
PROJECT NAME:	CAMBRIDGE
PROJECT NUMBER:	BHF 030-2 (19) S
FILE NAME:	ZB308PRI.DGN
PROJECT LEADER:	M. K. CHEVALIER
DESIGNED BY:	B. W. ERNST
PLOT DATE:	22-NOV-2006
DRAWN BY:	A.N. BEY
CHECKED BY:	M. K. CHEVALIER
SHEET	14 OF 68