


LEGEND:
 BF = BACK FACE
 FF = FRONT FACE
 EF = EACH FACE
 ▲ = CUT TO FIT IN FIELD
 3' = CLR. UNLESS OTHERWISE SPECIFIED ON THE PLANS


* SEE SHEET 31 FOR SECTIONS
 * SEE SHEET 29 FOR SECTIONS

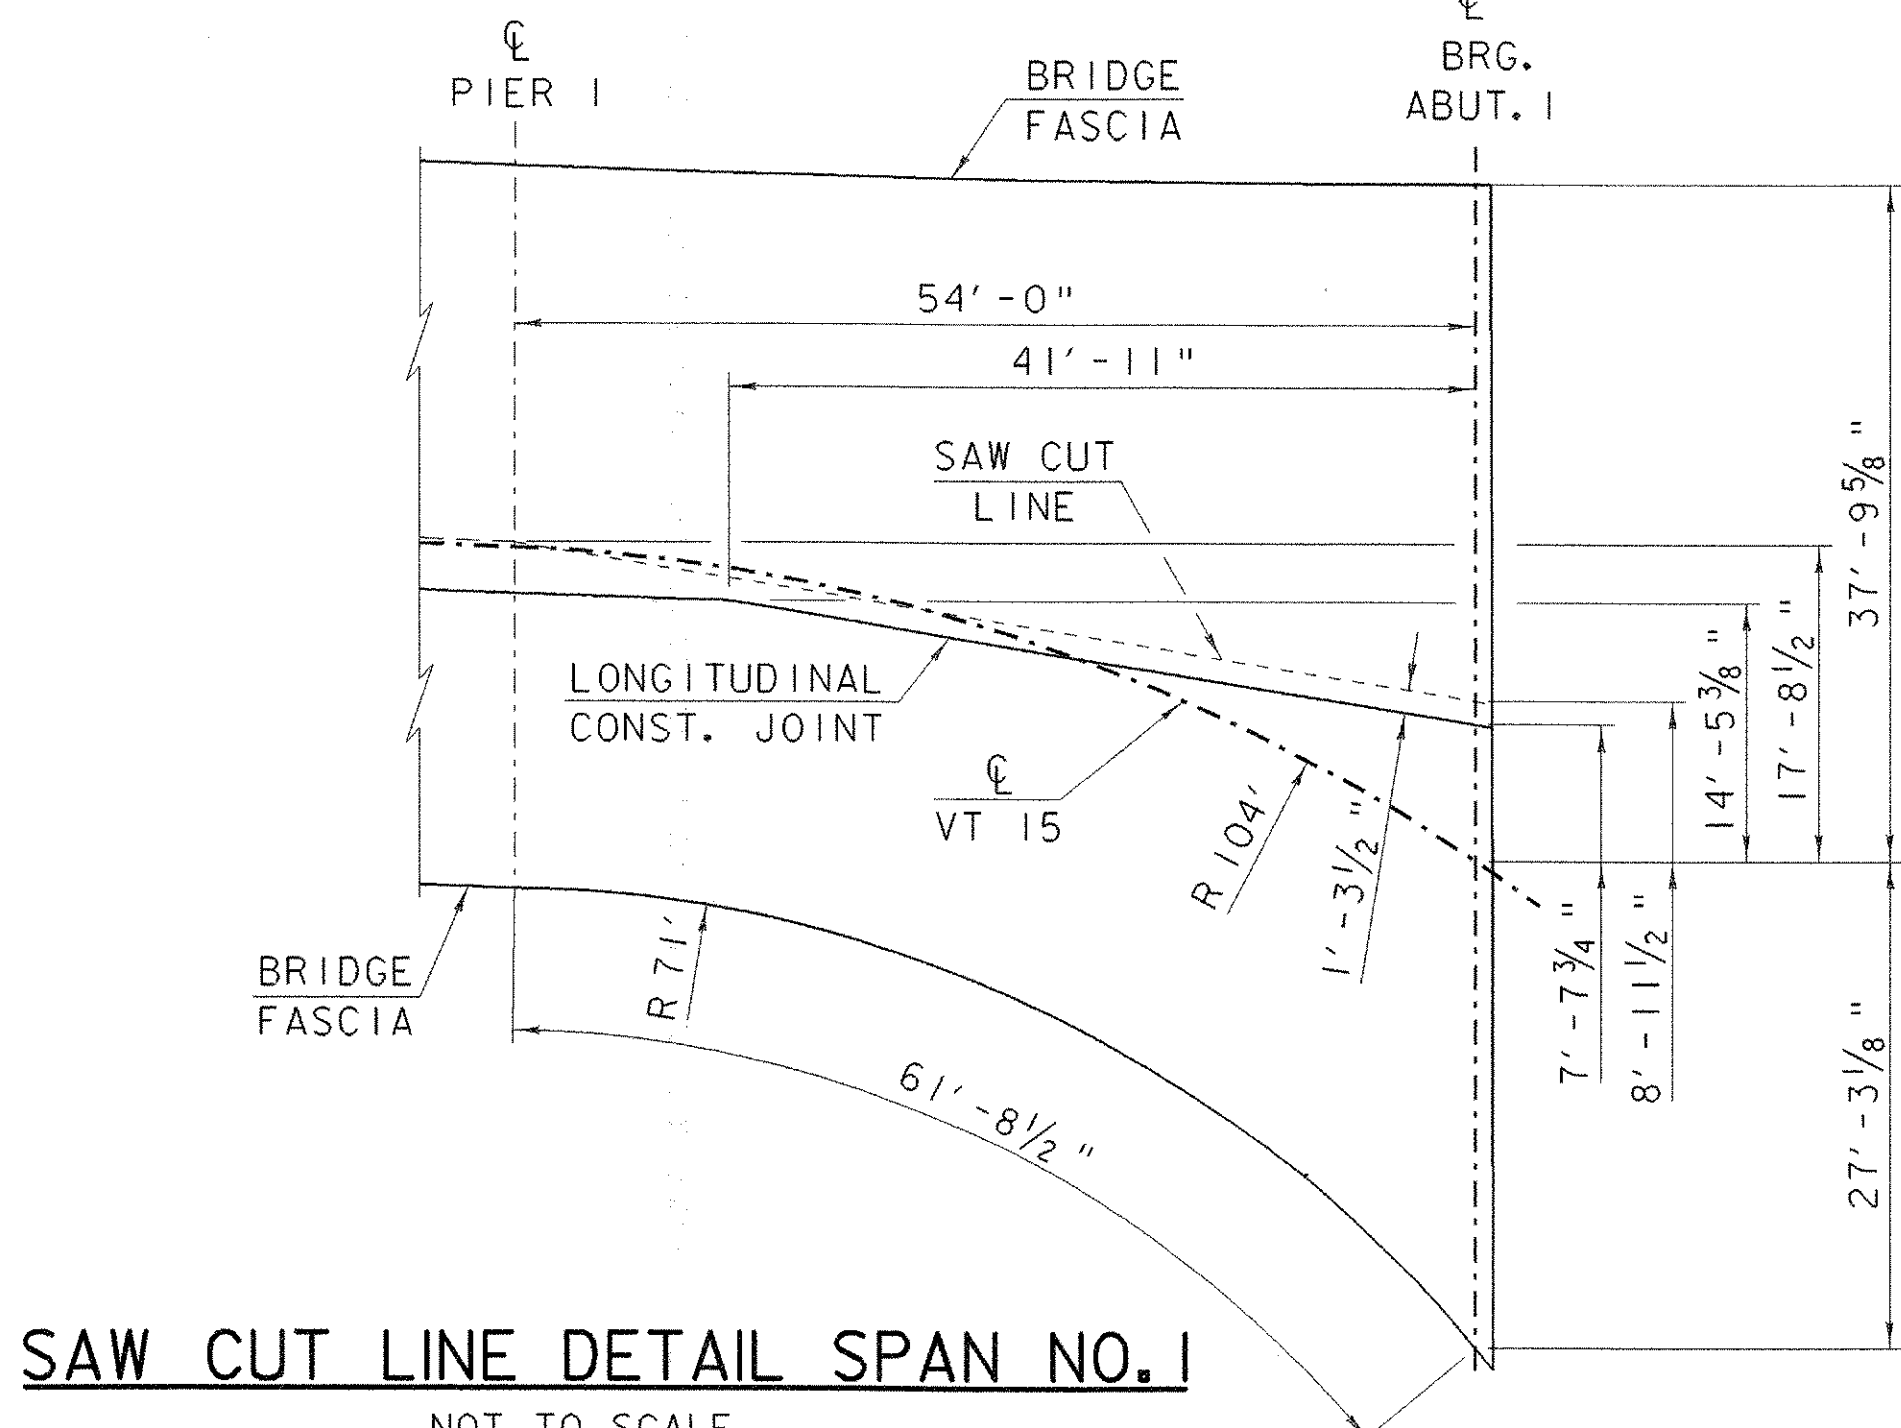

SAW CUT LINE DETAIL SPAN NO. 1
 NOT TO SCALE
 SEE SHEET 44 FOR LONGITUDINAL CONSTRUCTION JOINT DETAIL

NOTE:
 ALL DIMENSIONS GIVEN FROM CENTERLINE BEARING

SPANS 1 & 2 DECK REINFORCING PLAN
 SCALE: 3/16" = 1'-0"

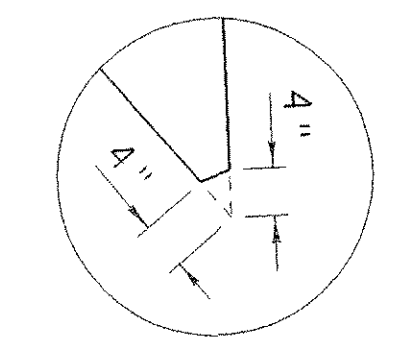

DETAIL "A"
 SCALE: 3/4" = 1'-0"

SCUPPER	LOCATION
C	STA. 17+60 RT.
D	STA. 17+60 LT.
E	STA. 18+37 RT.

SEE SHEET 42 FOR DETAILS

STATE OF VERMONT AGENCY OF TRANSPORTATION	
Town Of CAMBRIDGE	Bridge No. 20
Highway No. VT 15	Log Sta. Surv. Sta.
VT 15 OVER LAMOILLE RIVER	
DECK REINFORCING (SPANS 1 & 2)	
Designed By E. A. HARTWELL	Drawn By R. A. ROSS
Checked By R. SACCHI Date	Bridge Design Supervisor R. R. WHITCOMB Date 11/3/2006
PROJECT CAMBRIDGE	PROJECT NO. BHF 030-2(19)S
I.G.C. Info.	zb308dr 1-2.dgn
Bridge Sheet No.	Sheet 30 of 68