




16+00.00

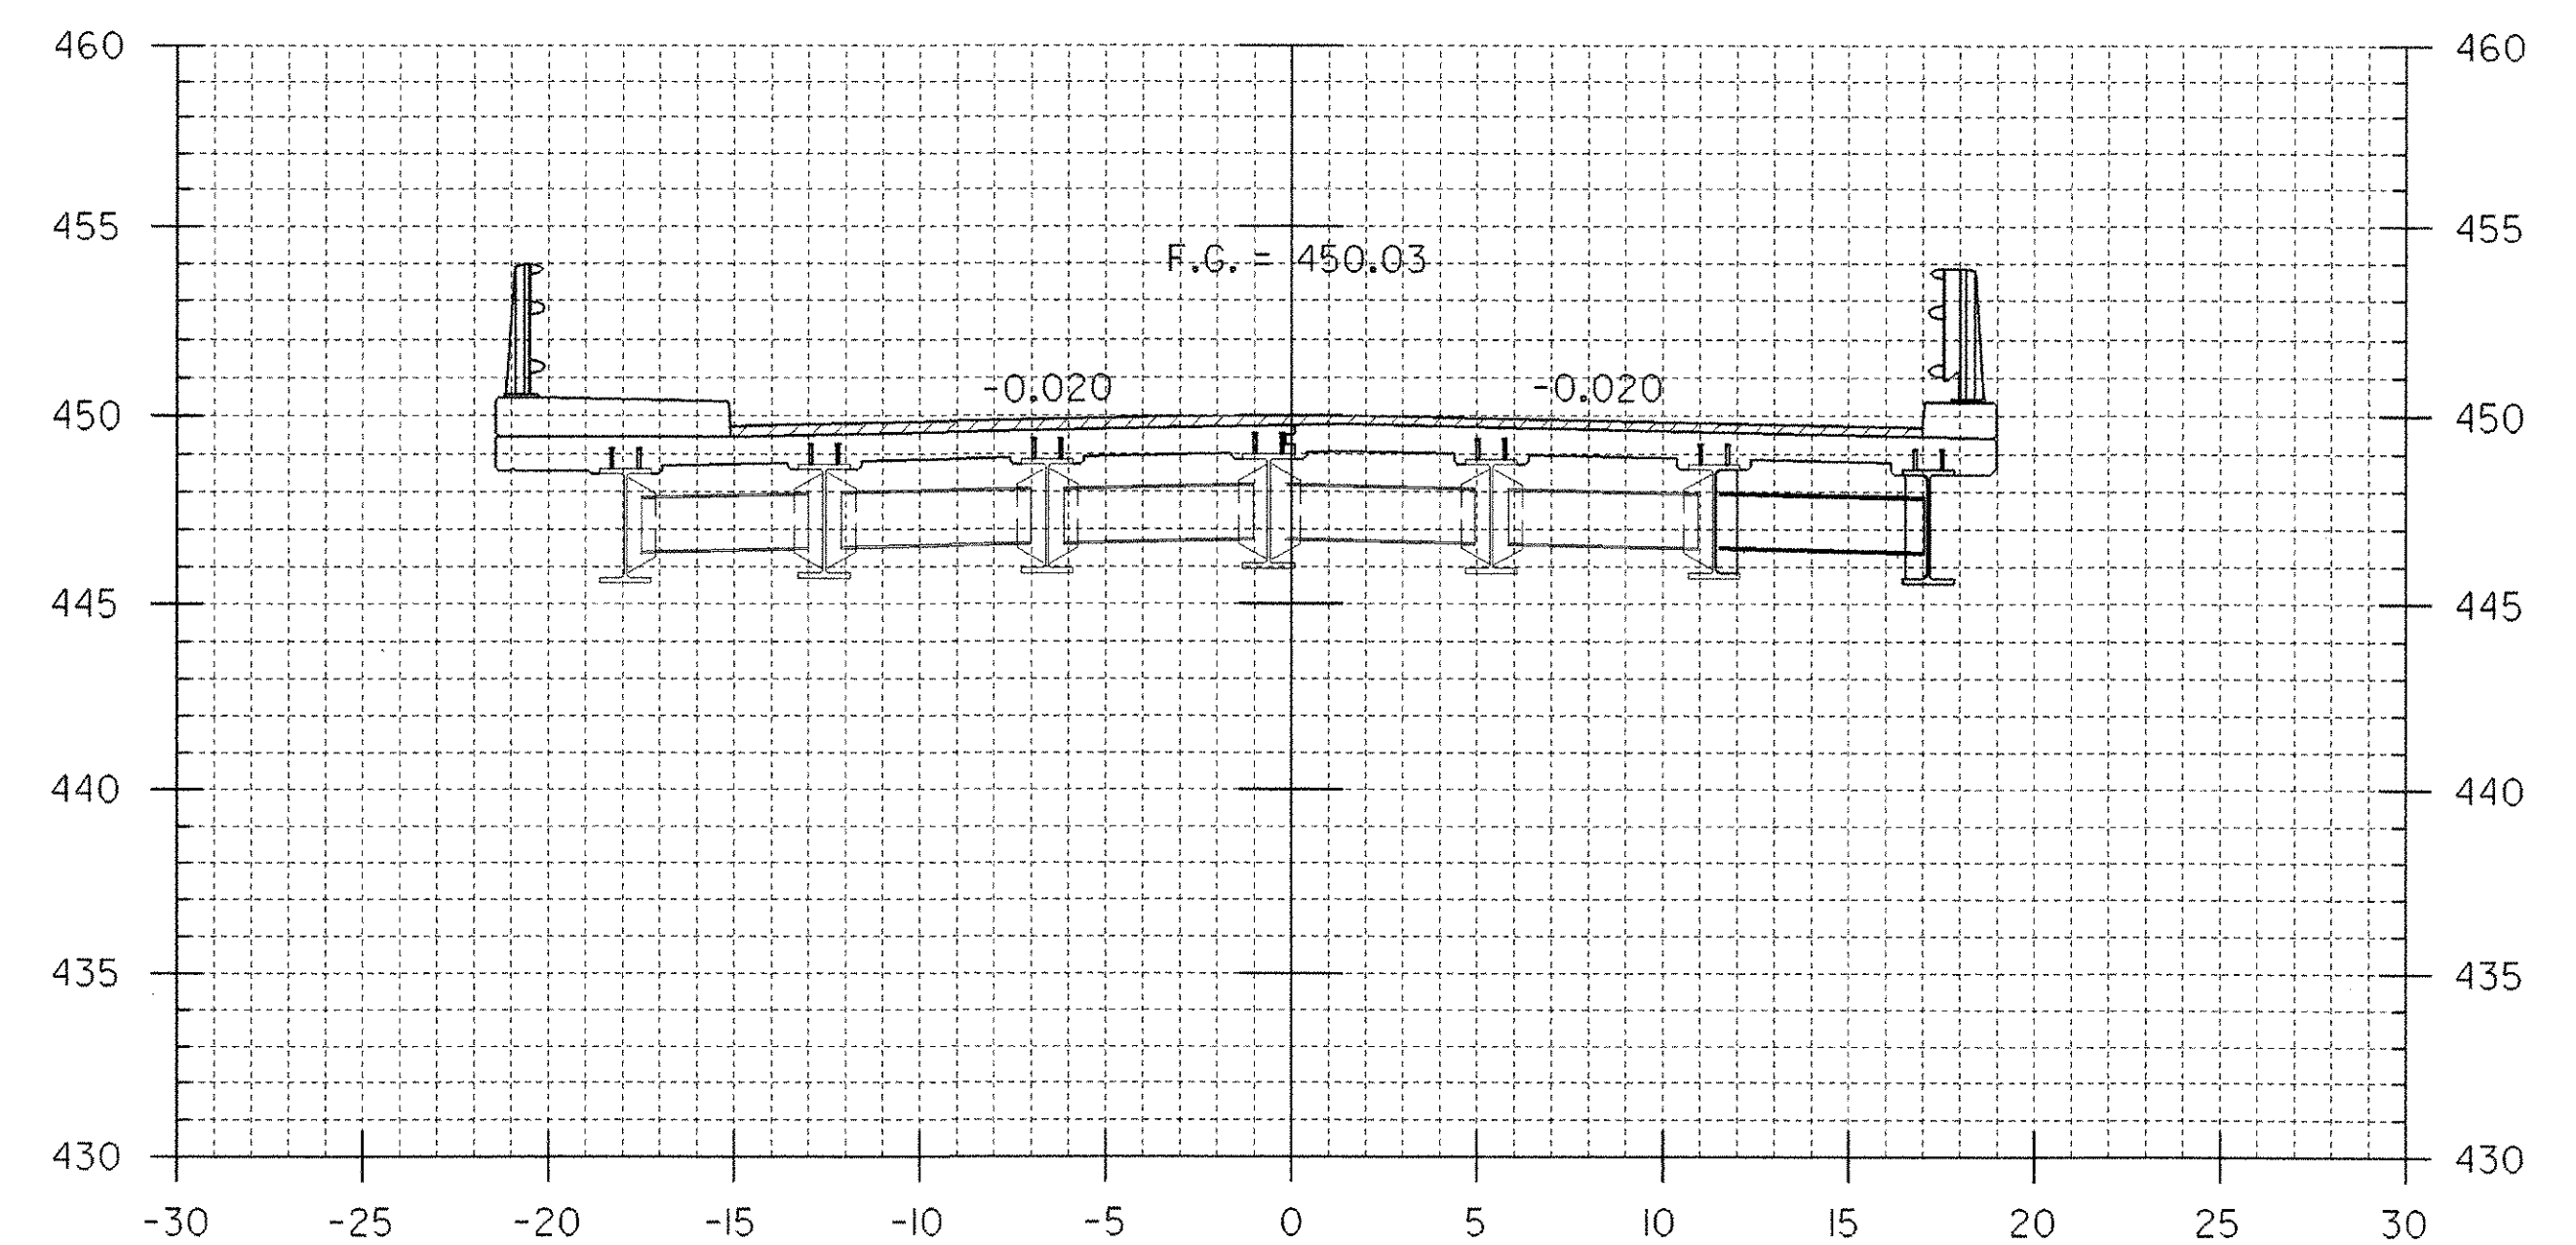

17+00.00

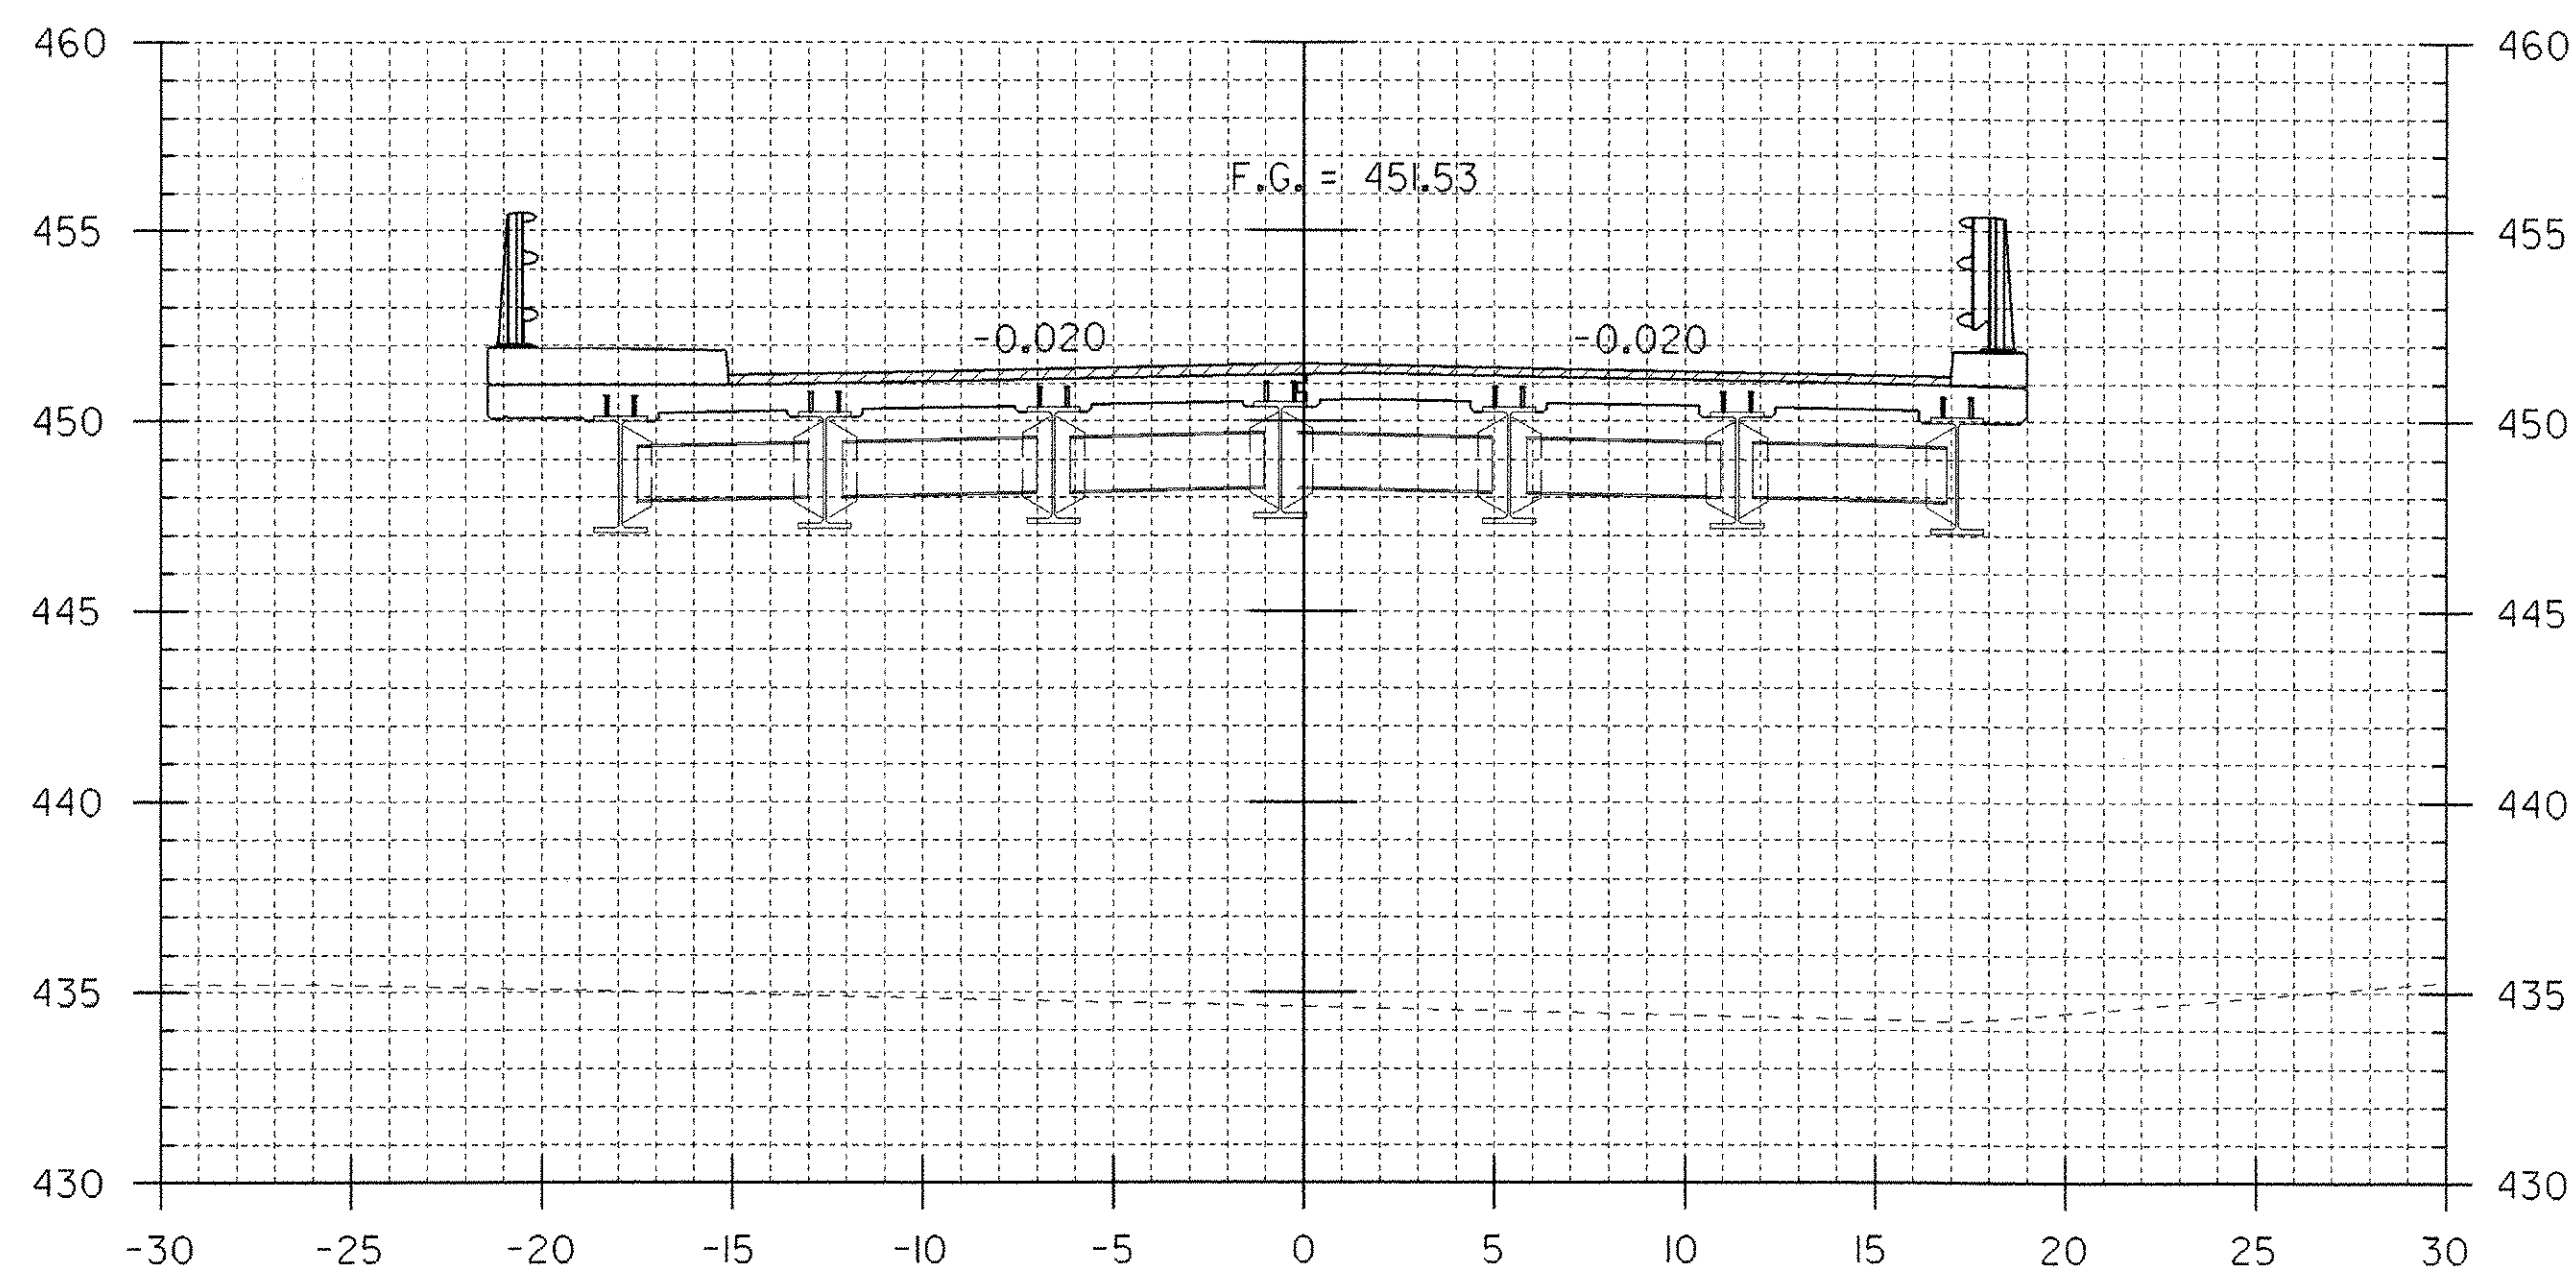


15+50.00

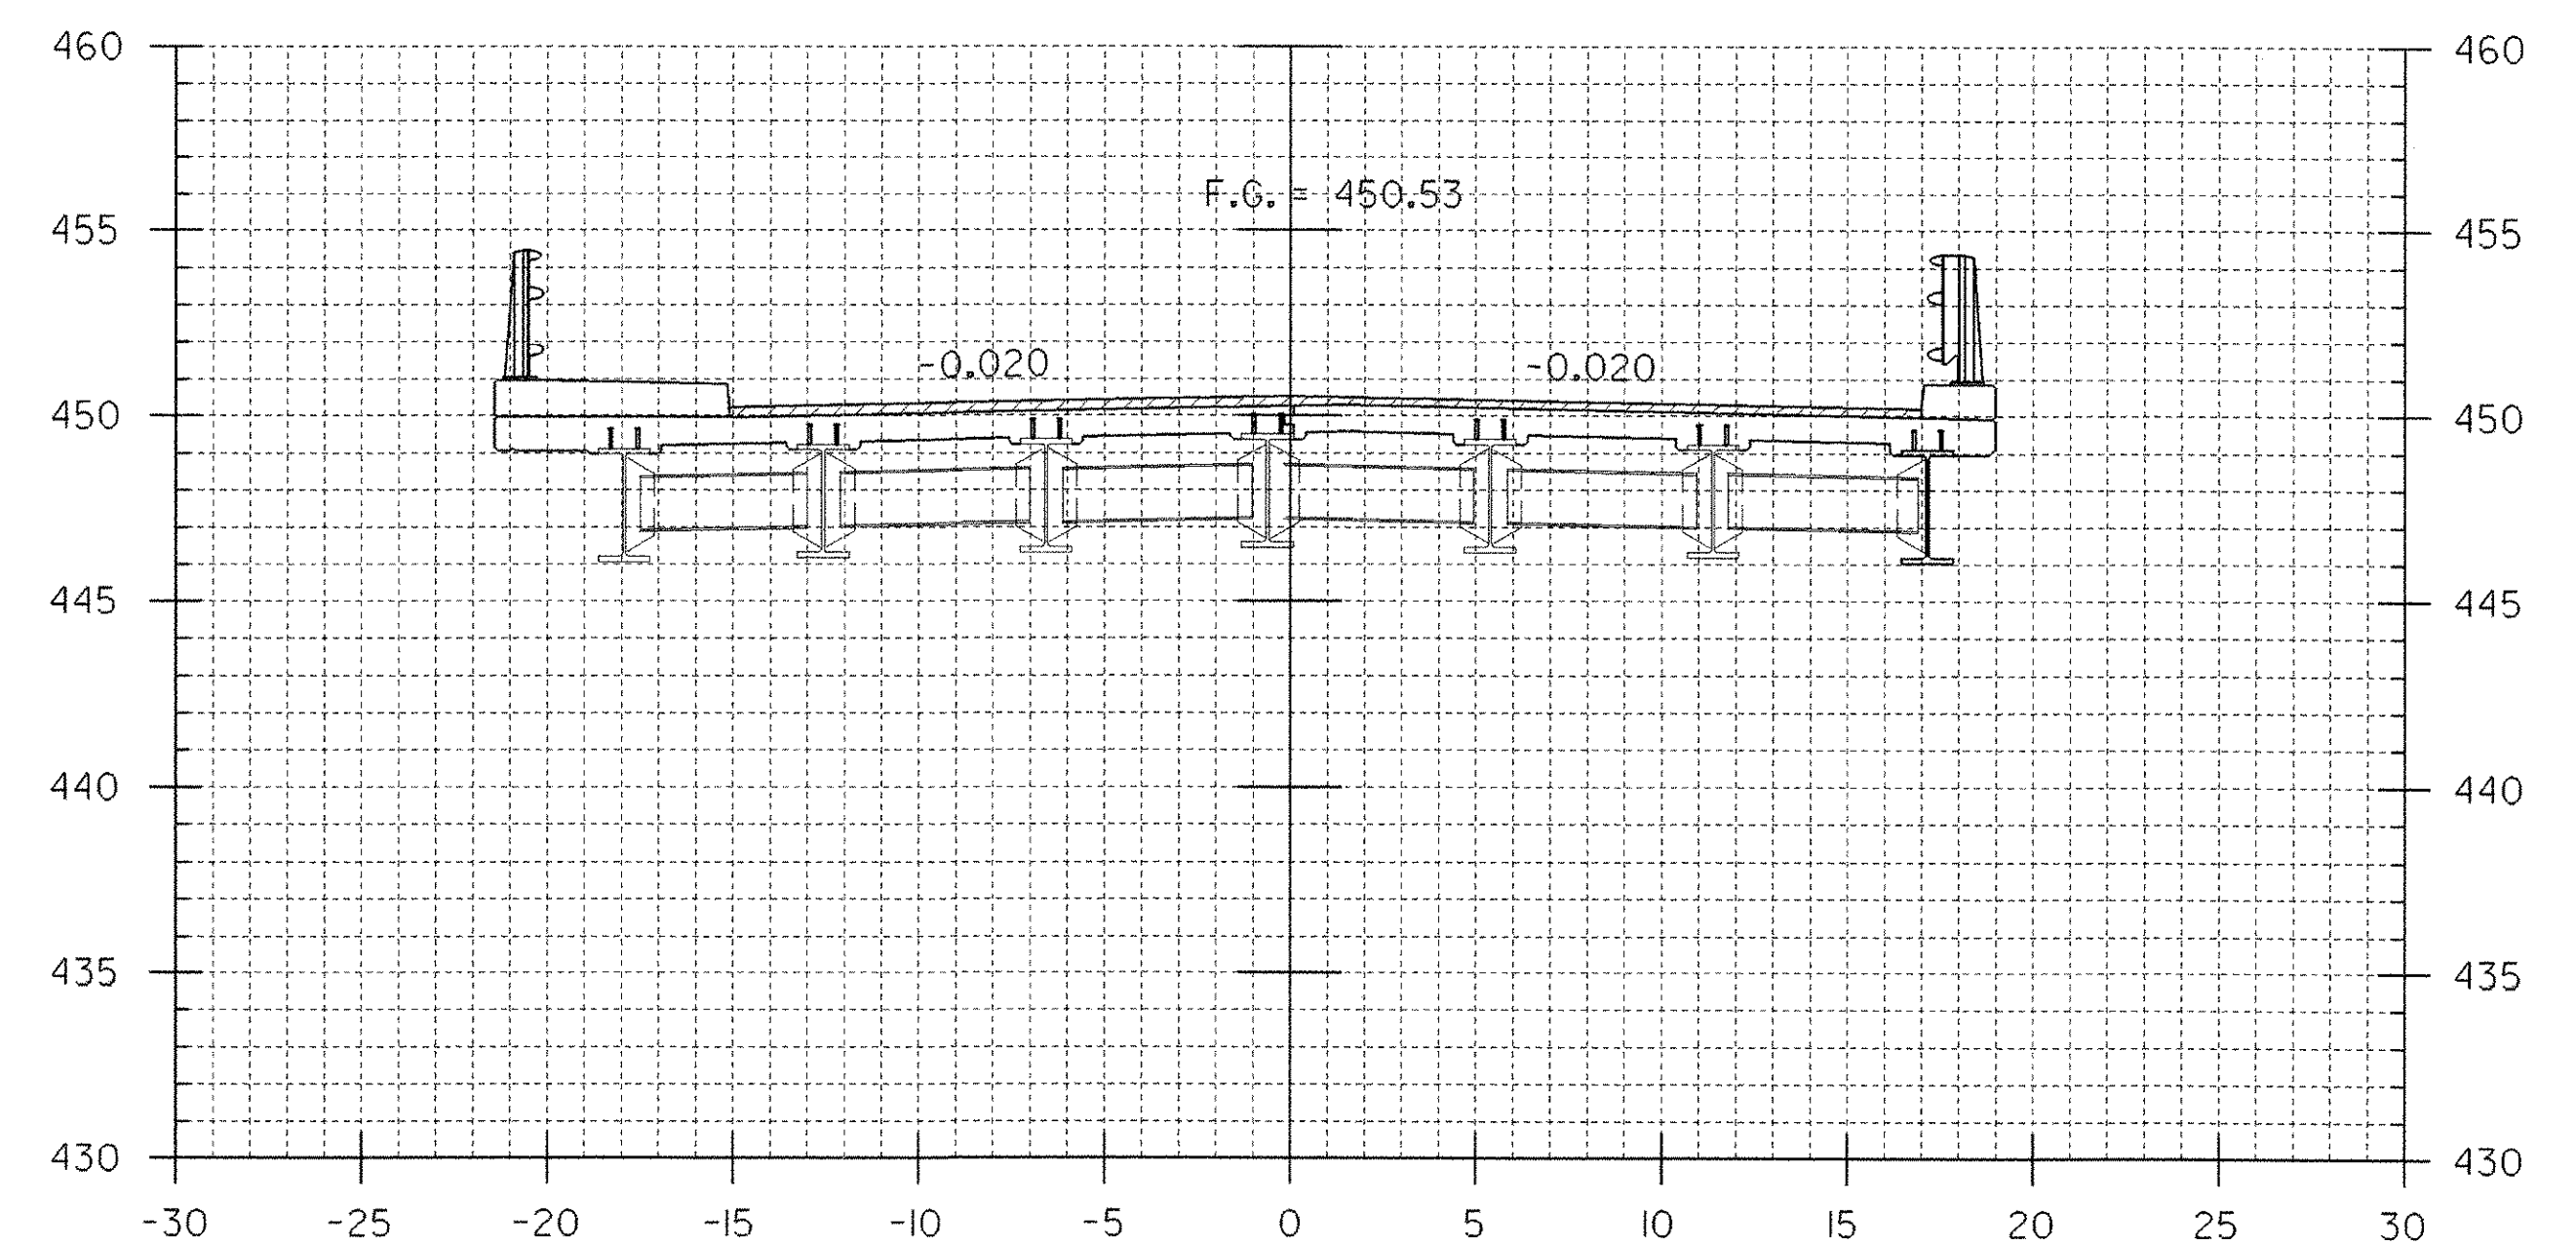

16+50.00

VT. 15
CROSS-SECTIONS

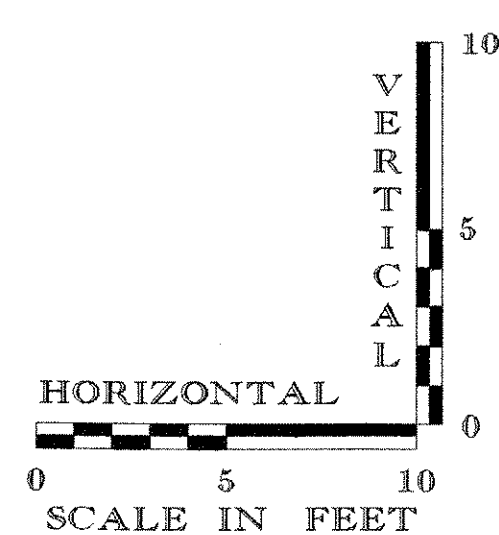

DATUM
VERTICAL _____
HORIZONTAL _____

ROADWAY CROSS SECTIONS (SHEET 2)

PROJECT NAME: CAMBRIDGE
PROJECT NUMBER: BHF 030-2 (19) S
FILE NAME: zb308ce2.dgn
PROJECT LEADER: M. K. CHEVALIER
DESIGNED BY: B. W. ERNST
PLOT DATE: 22-NOV-2006
DRAWN BY: A.N. BEY
CHECKED BY: M. K. CHEVALIER
SHEET 60 OF 68