




18+00.00

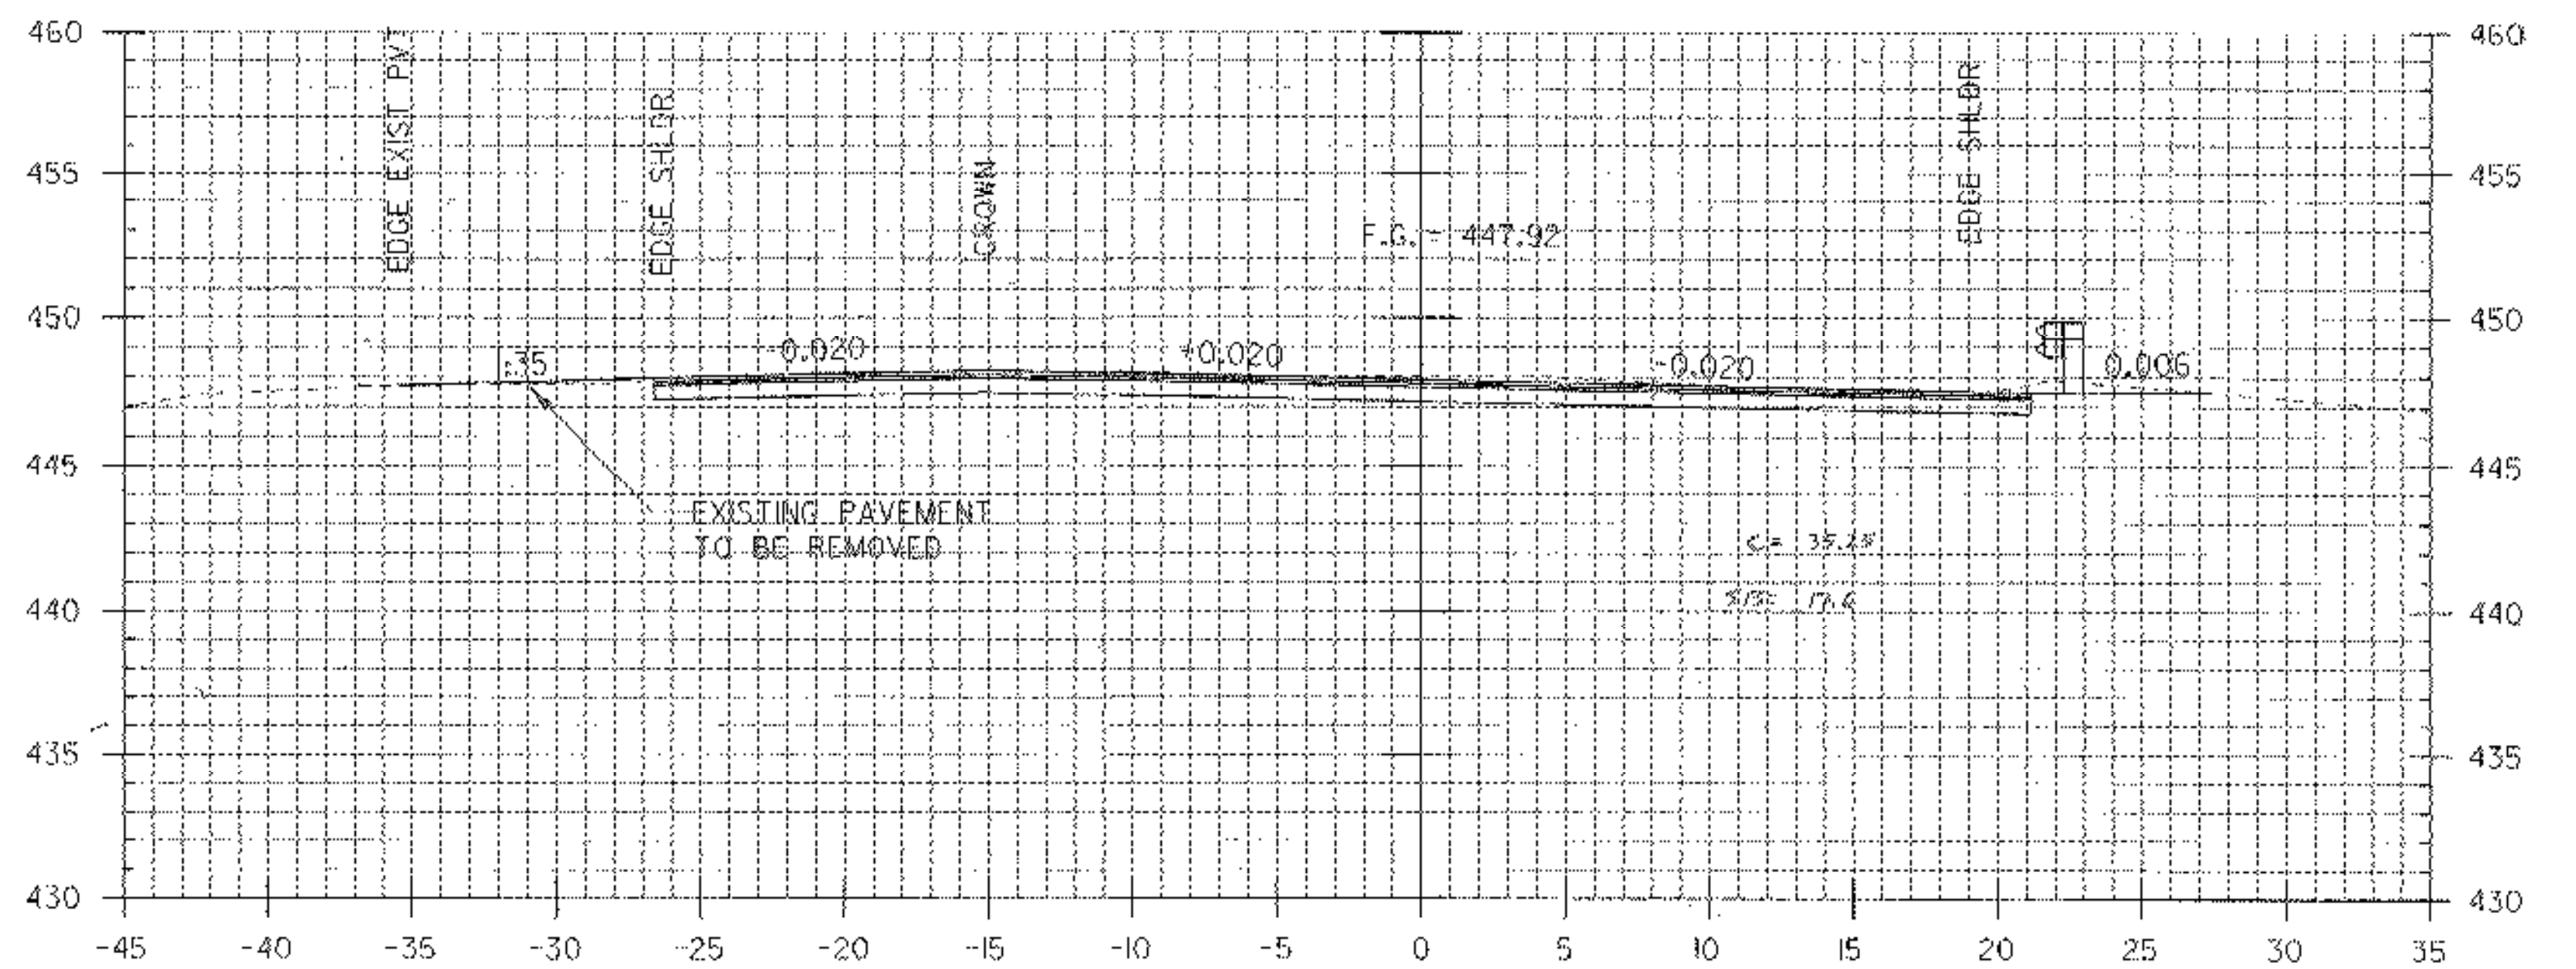

19+00.00

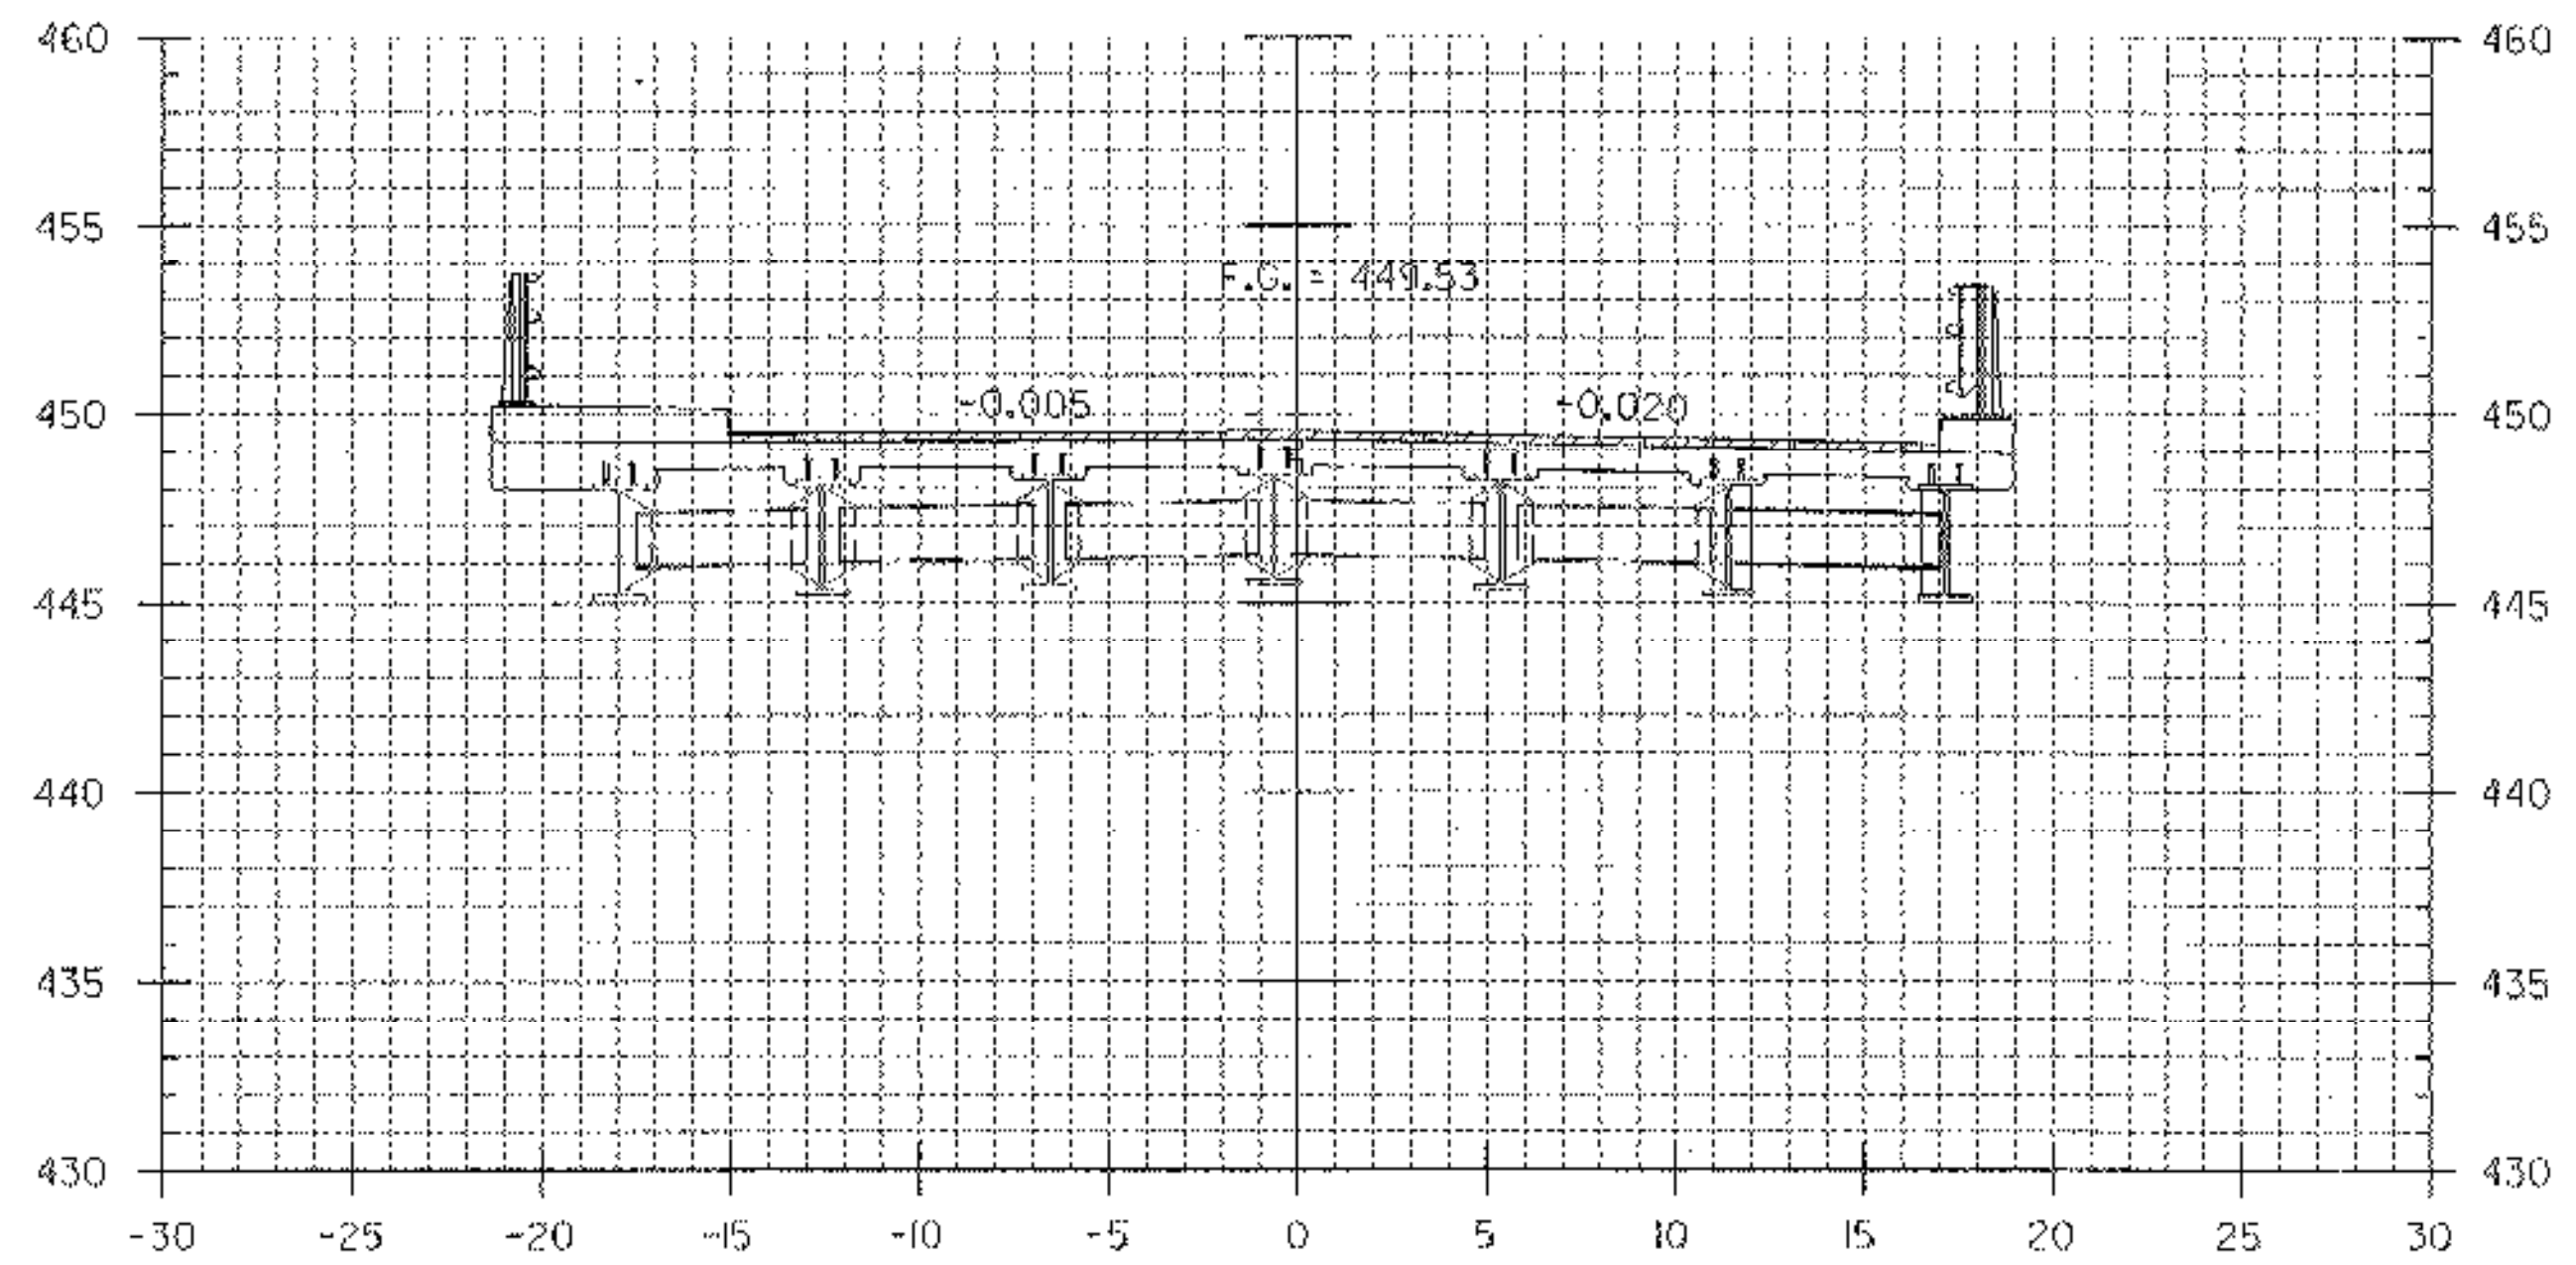

17+50.00

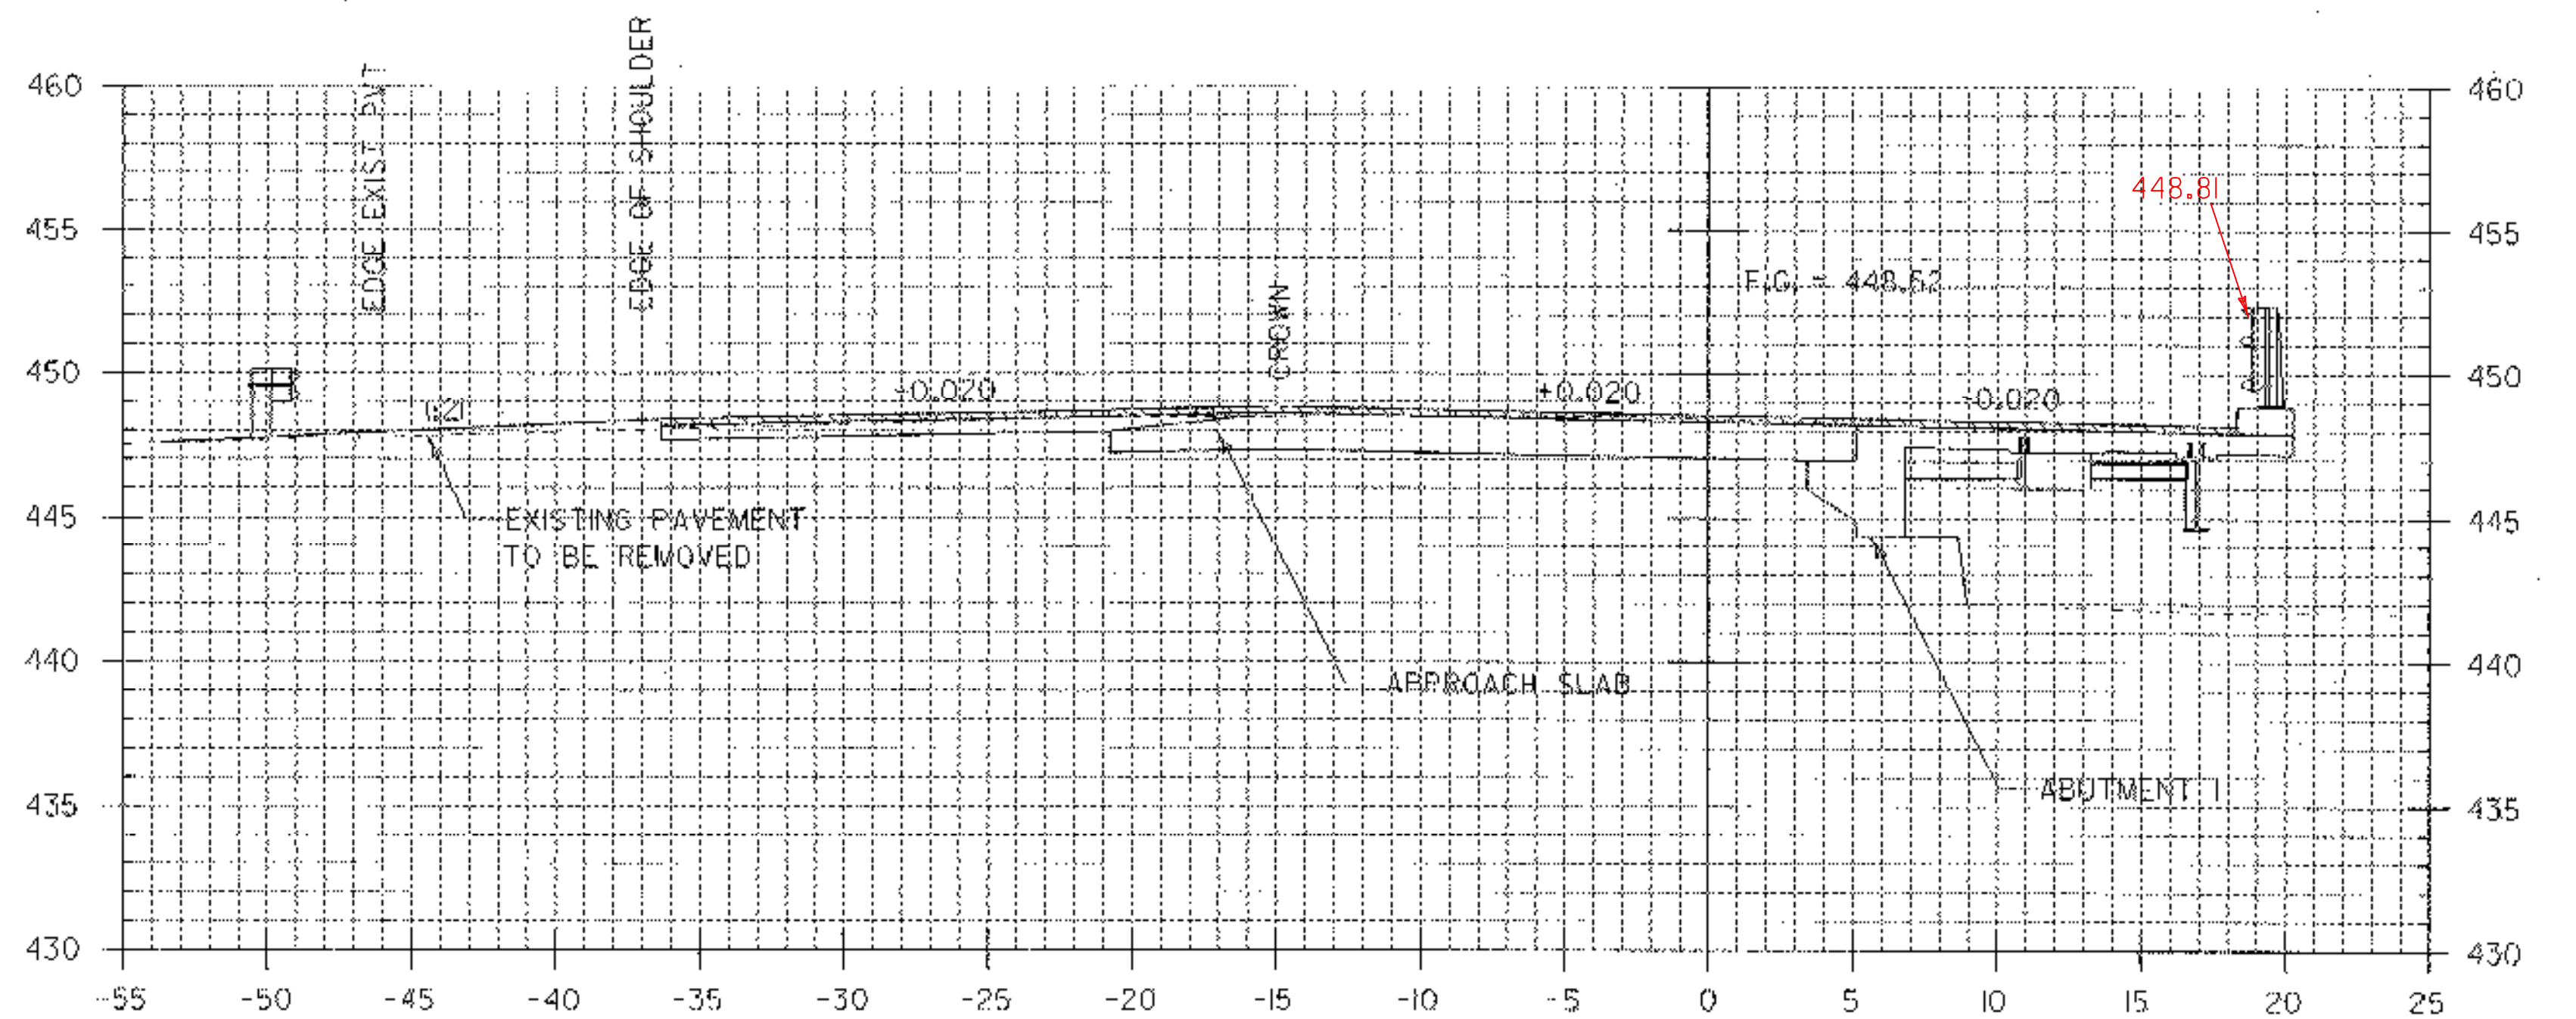


18+50.00
END BRIDGE 18+46.29

VT. 15
CROSS-SECTIONS

ROADWAY CROSS SECTIONS (SHEET 3)

| | |
|------------|-------|
| DATUM | |
| VERTICAL | _____ |
| HORIZONTAL | _____ |

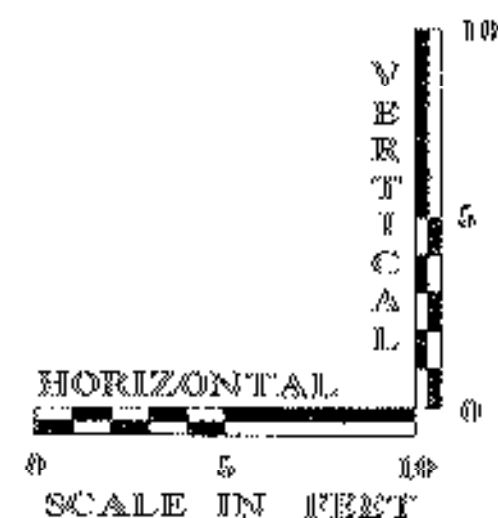

| | | | |
|-----------------|------------------|-------------|-----------------|
| PROJECT NAME: | CAMBRIDGE | PLOT DATE: | 22-NOV-2006 |
| PROJECT NUMBER: | BHF 030-2 (19) S | DRAWN BY: | A.M. BEY |
| FILE NAME: | zb308c63.dgn | CHECKED BY: | M. K. CHEVALIER |
| PROJECT LEADER: | M. K. CHEVALIER | SHEET | 61 OF 68 |
| DESIGNED BY: | B. W. ERNST | | |