



END PROJECT
STA 19+85

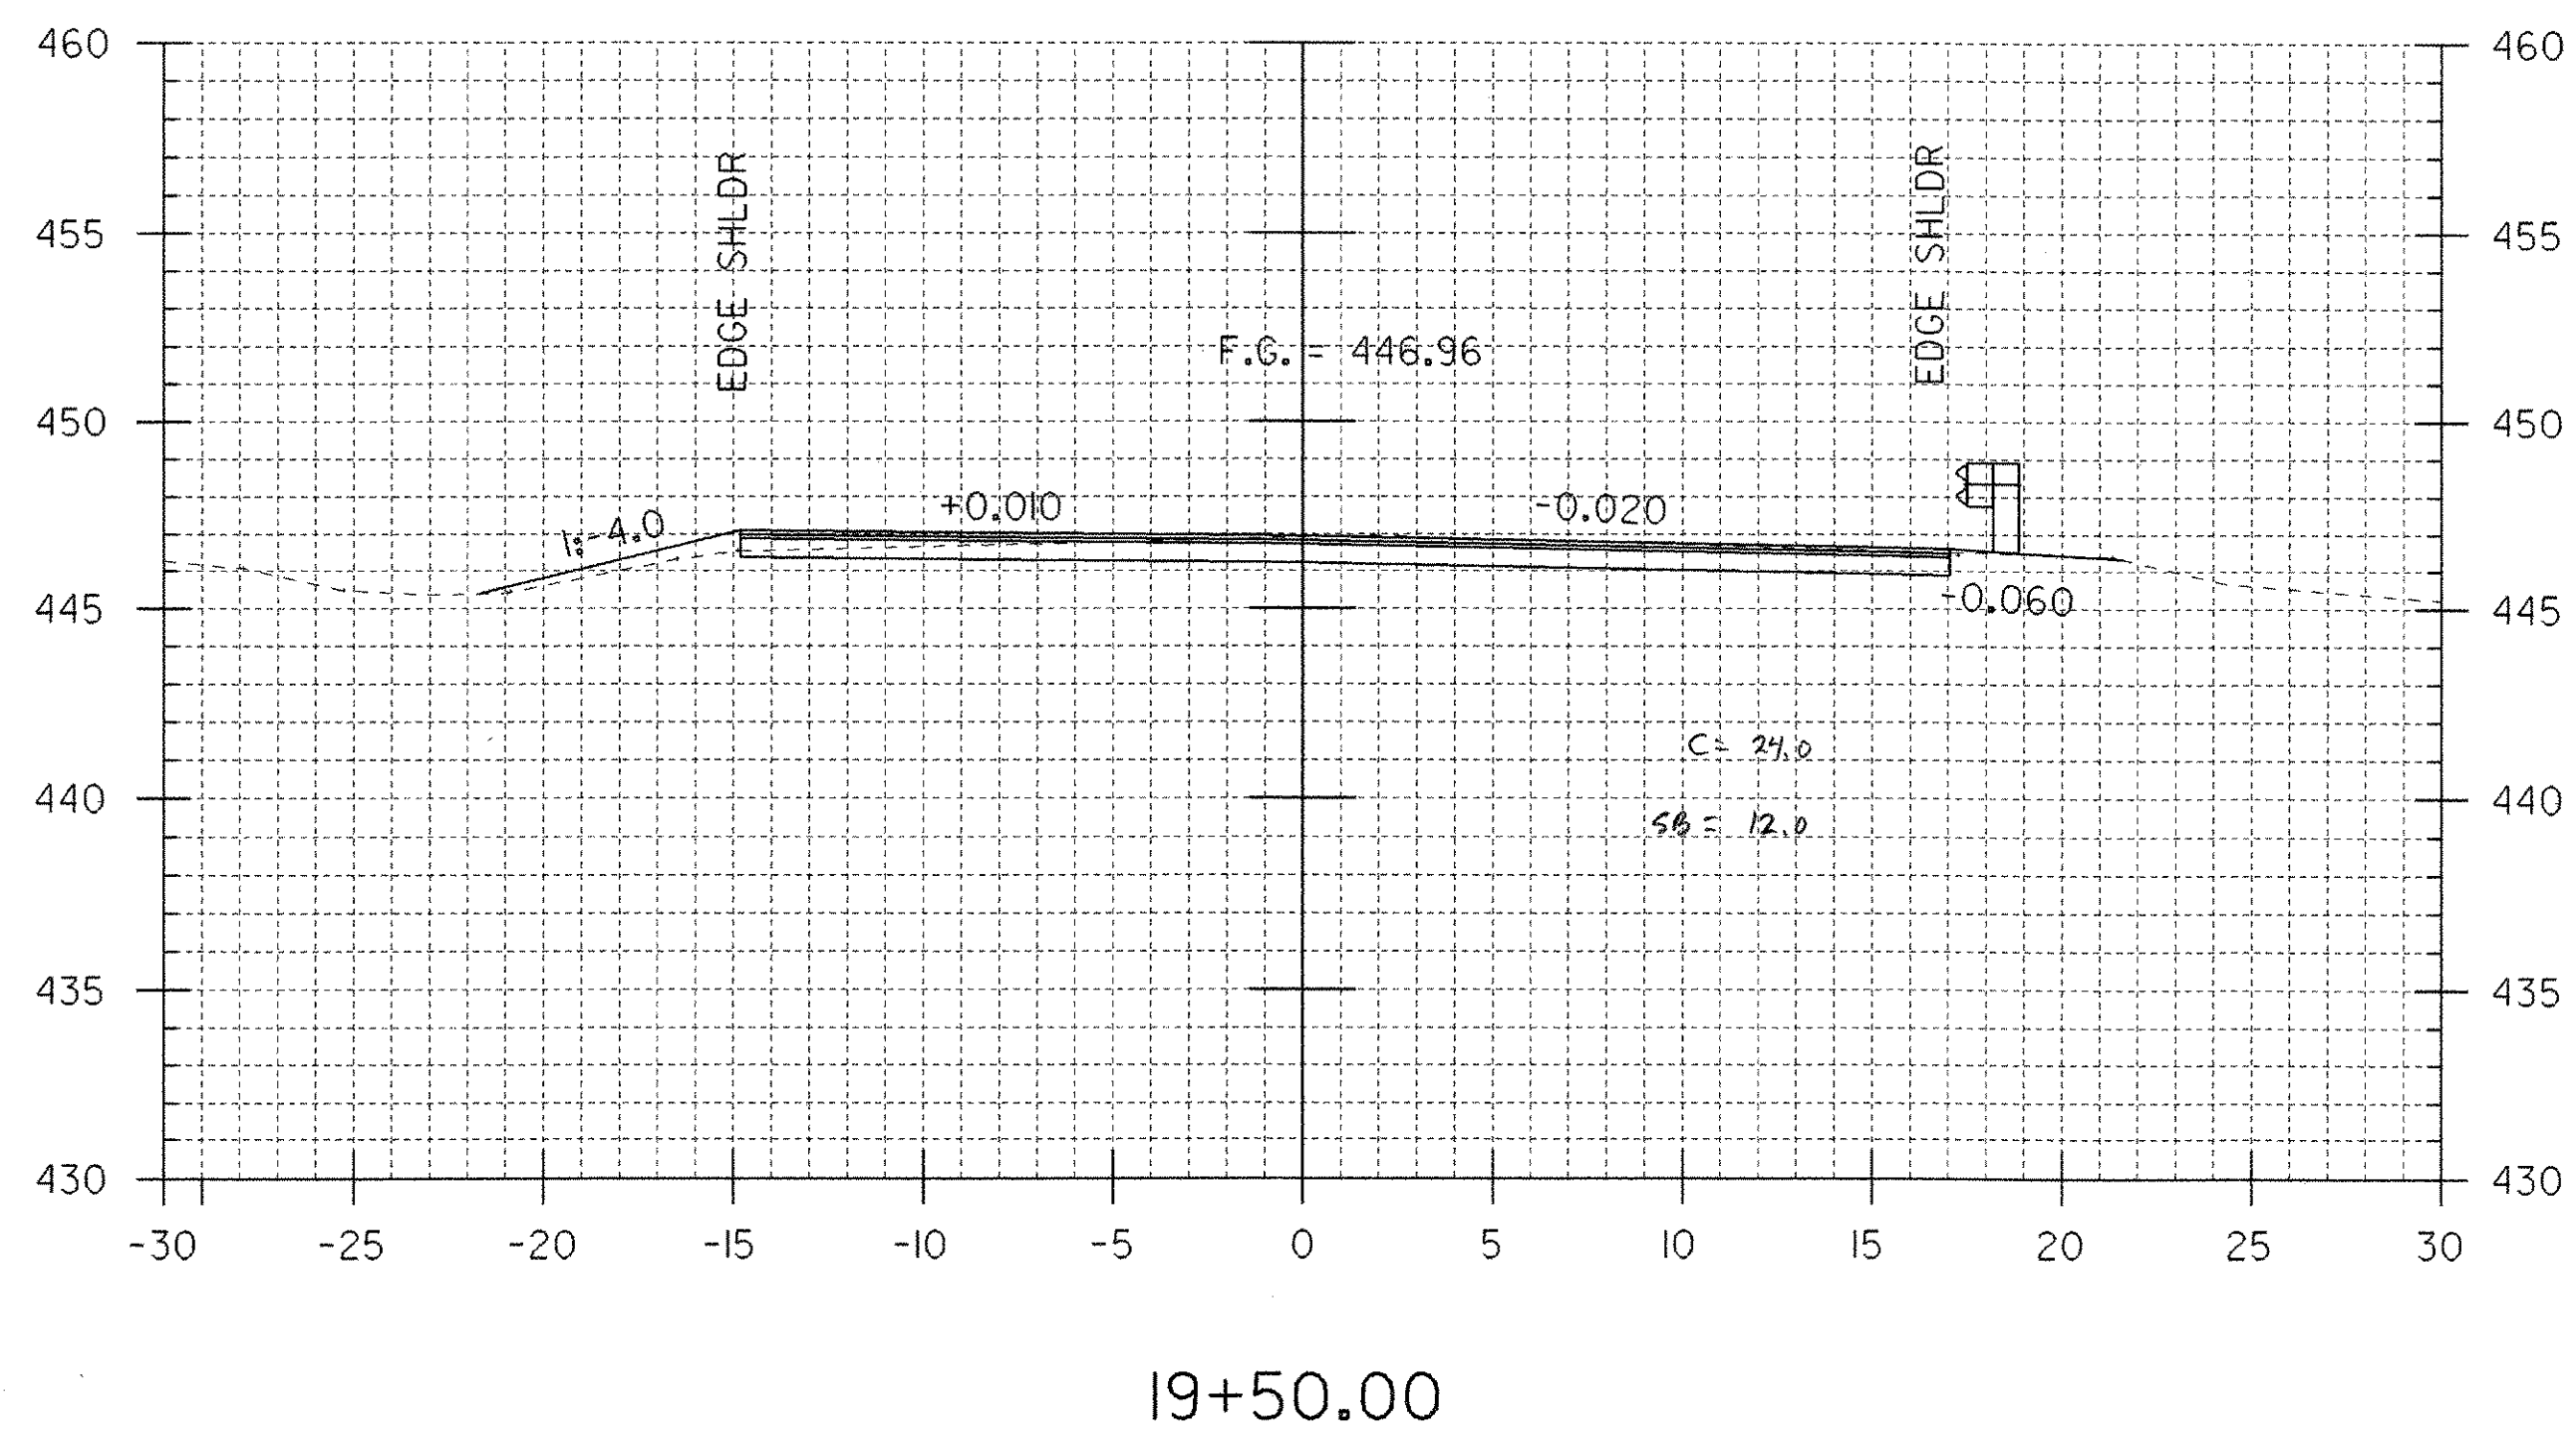


19+50.00

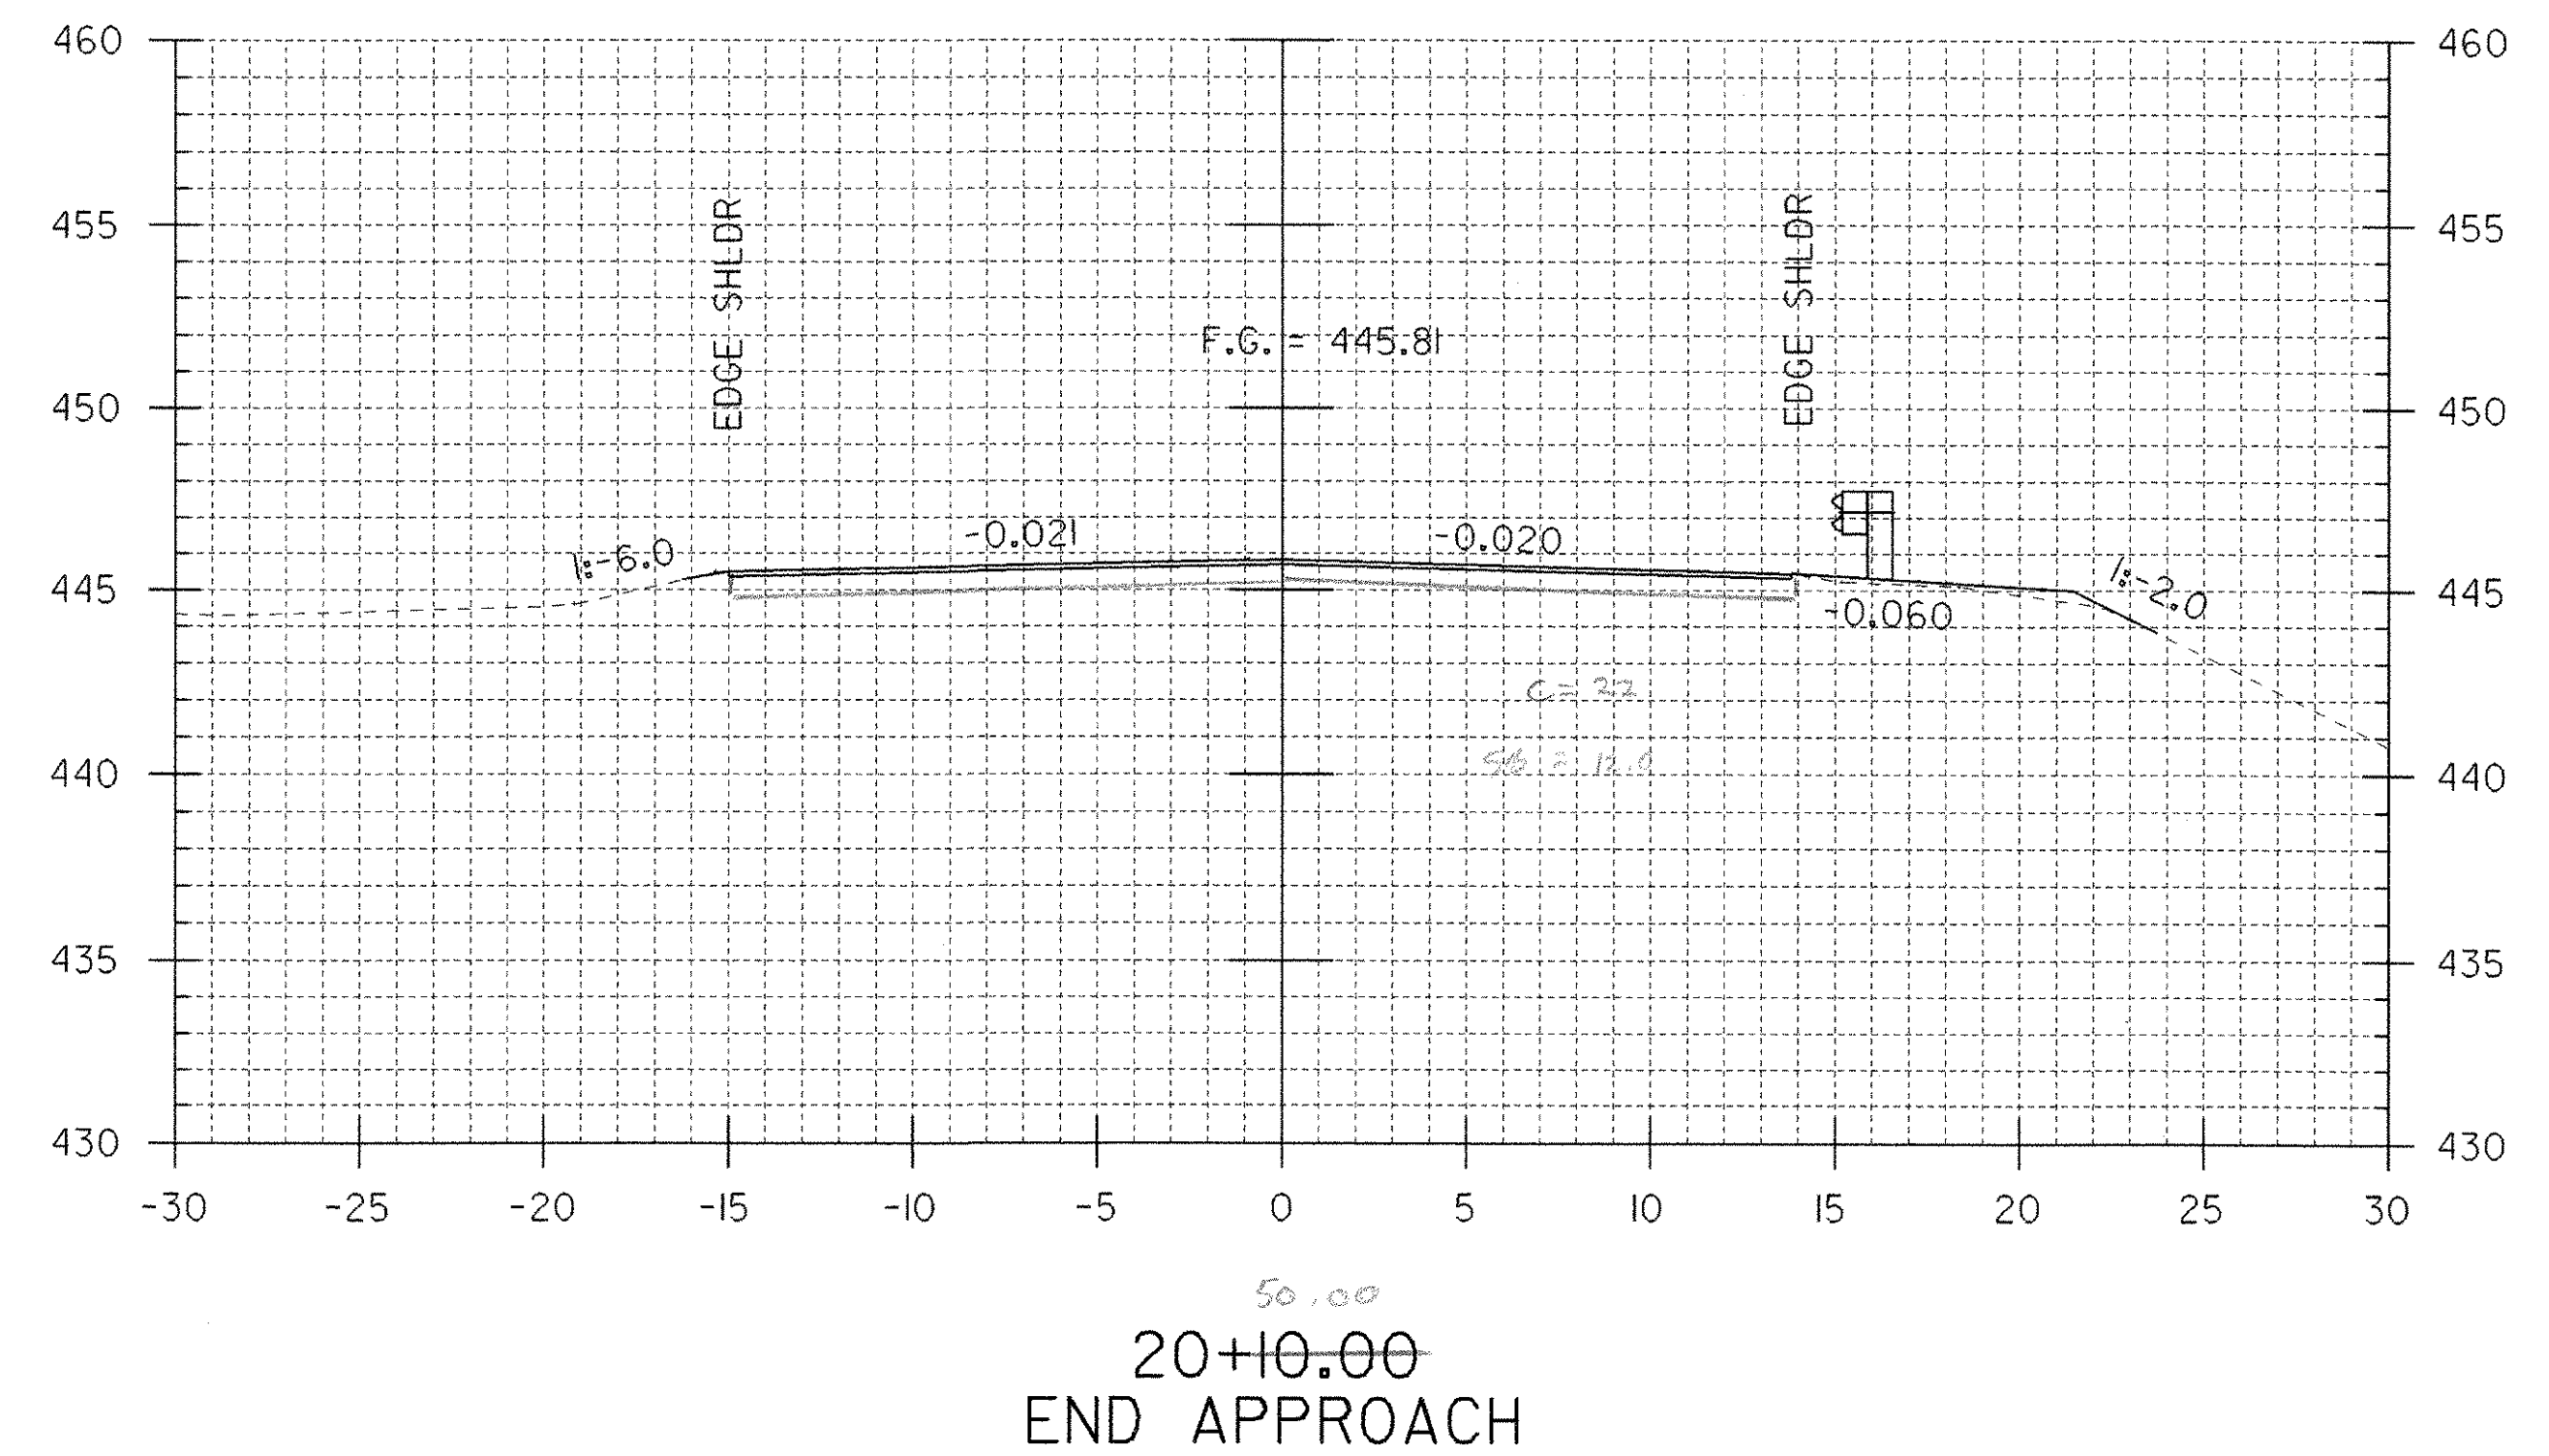

20+10.00
END APPROACH

VT. 15
CROSS-SECTIONS

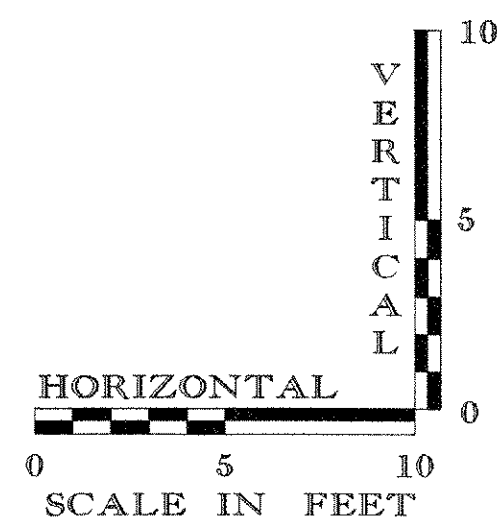

DATUM
VERTICAL _____
HORIZONTAL _____

ROADWAY CROSS SECTIONS (SHEET 4)	
PROJECT NAME: CAMBRIDGE	
PROJECT NUMBER: BHF 030-2 (19) S	
FILE NAME: zb308cs4.dgn	PLOT DATE: 22-NOV-2006
PROJECT LEADER: M. K. CHEVALIER	DRAWN BY: A.N. BEY
DESIGNED BY: B. W. ERNST	CHECKED BY: M. K. CHEVALIER
	SHEET 62 OF 68