


INSIDE ELEVATION OF NE (STA.18+63 RT - STA.20+20 RT.) APPROACH RAIL

NOTE:
 • RAIL LENGTHS DO NOT INCLUDE END CAPS AND/OR GAPS.
 • LENGTH OF APPROACH RAILING ON THIS SHEET IS 50.5 LF PAY LENGTH.

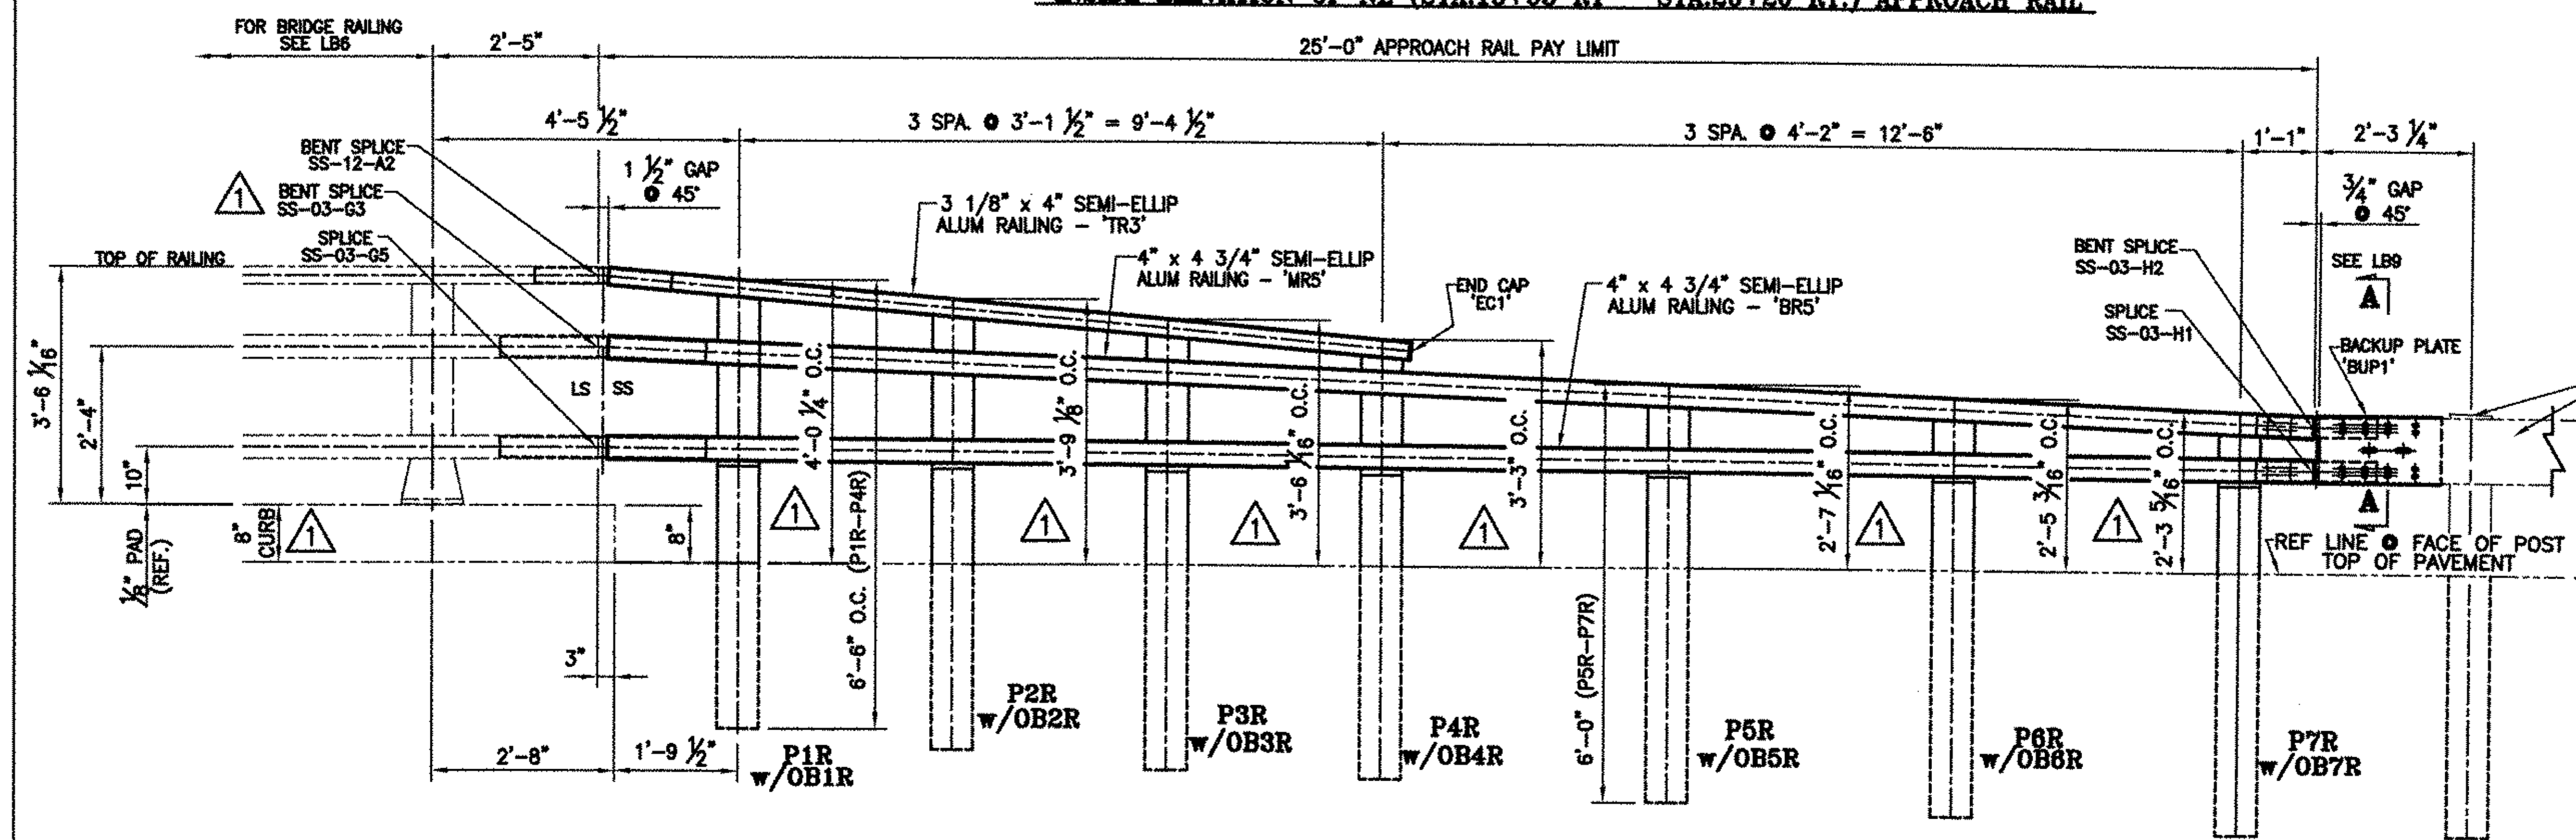

INSIDE ELEVATION OF SE APPROACH RAIL

ANODIZED
 (SEE NOTES ON LB1)

BRIDGE No. 20	PROJECT No. BHF 030-2(19)S	ITEM No: 621.74
APPROVED:	REC'D APPROVAL	DRAWING
L.B. FOSTER COMPANY 1016 GREENTREE ROAD PITTSBURGH, PENNSYLVANIA 15220		
FOR: BECK & BELLUCCI INCORPORATED VERMONT AGENCY OF TRANSPORTATION TOWN OF CAMBRIDGE, COUNTY LAMOILLE BRIDGE RAILING FOR VT15 (MINOR ARTERIAL) OVER LAMOILLE RIVER 3L ALUM BRIDGE APPROACH RAILING ~ ELEVATION VIEWS		
MADE CMS DATE 01/29/07	JOB No. ARO364	CUST. No.
CHECK_BJL DATE 02/28/07	DRAWING LBB	REV. No. ONE

REV.	DESCRIPTION	BY	DATE
1	REVISED PER APPROVAL MARKUP	Dd	03 22 07