

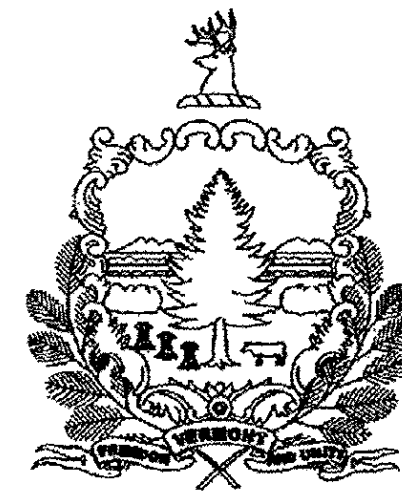


STATE OF VERMONT AGENCY OF TRANSPORTATION

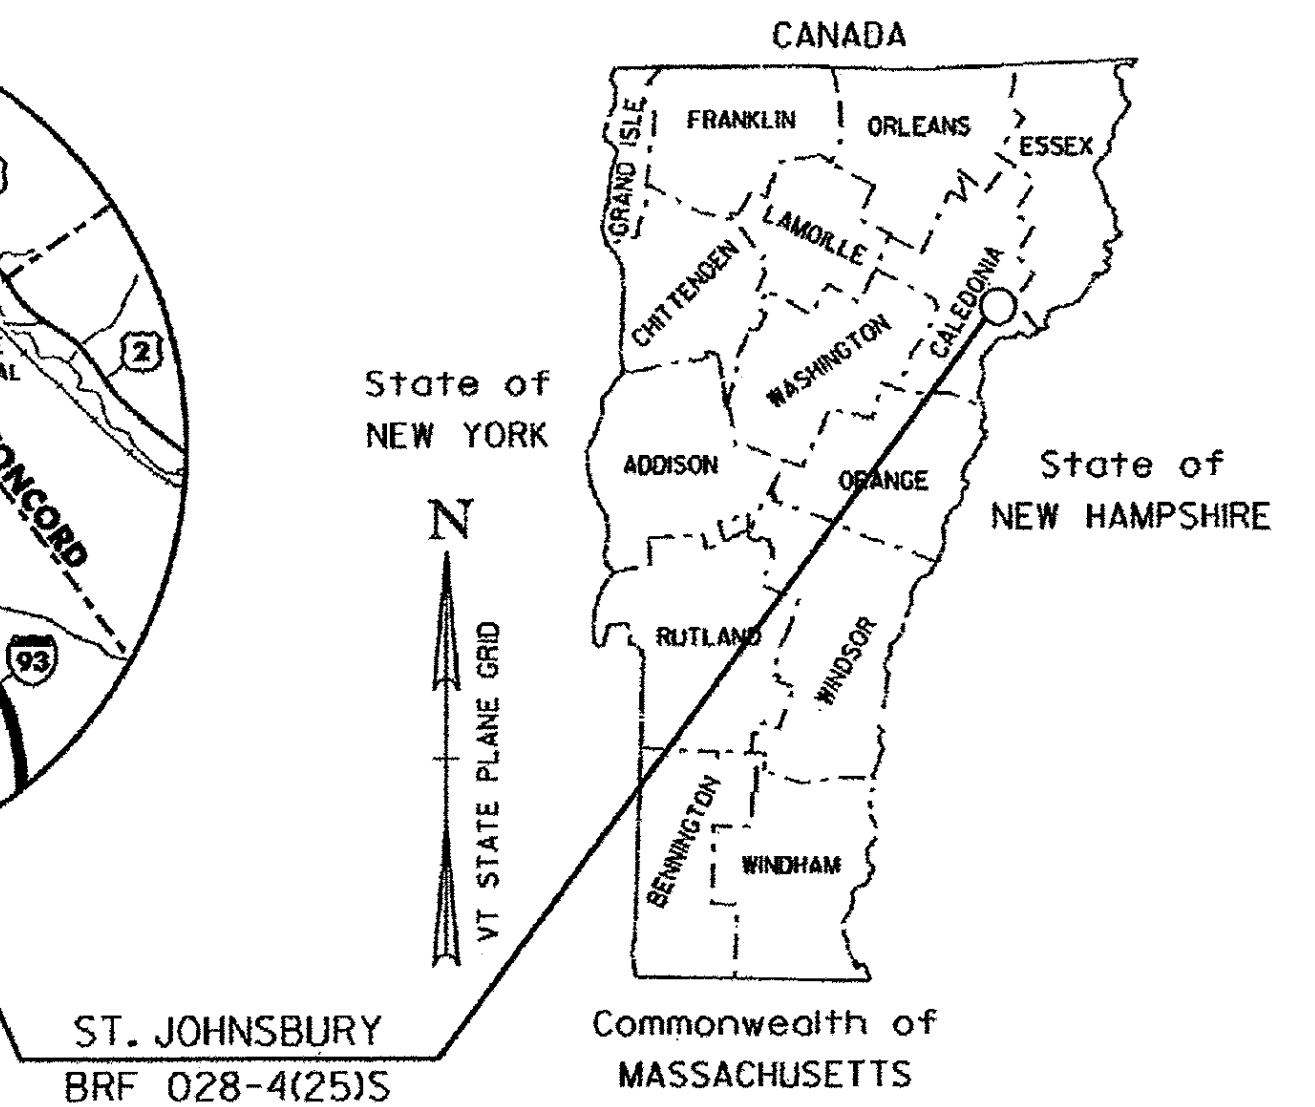

RECORD PLANS

RESIDENT ENGINEER : KEVIN MCCLURE
CONTRACTOR : WINTerset, INC.
PROJECT START DATE : 12-10-12
PROJECT COMPLETION DATE : 5-27-14

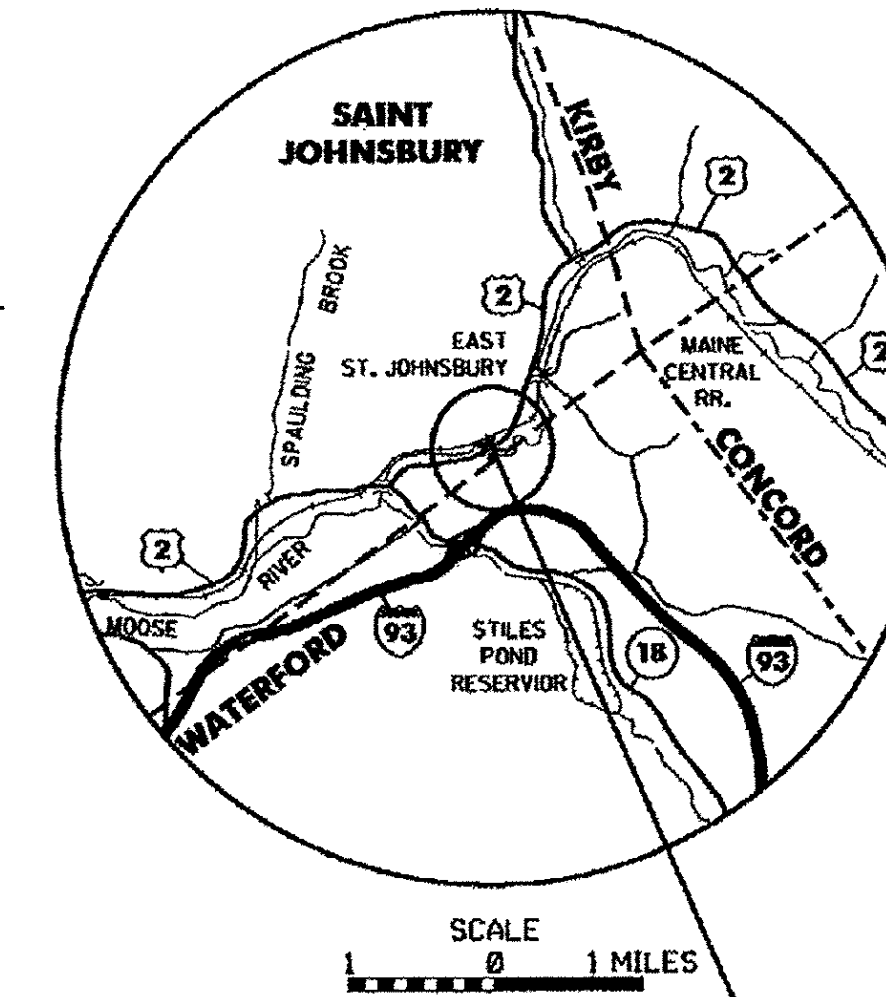


PROPOSED IMPROVEMENT BRIDGE PROJECT TOWN OF ST. JOHNSBURY COUNTY OF CALEDONIA US ROUTE 2 - PRINCIPAL ARTERIAL BRIDGE NO. 108

RECORD PLANS	
CONTRACTOR:	WINTerset, INC. - LYNDONVILLE, VT
RESIDENT ENGINEER:	KEVIN MCCLURE
CONSTRUCTION BEGAN:	APRIL 15, 2013
CONSTRUCTION COMPLETE:	MAY 27, 2014
RECORD PLANS BY:	KEVIN MCCLURE & C. PIERCE
I HEREBY CERTIFY THAT ALL THE CONSTRUCTION REQUIRED BY THIS SET OF DRAWINGS HAS BEEN ACCOMPLISHED AS INDICATED HEREIN.	
BY:	<i>Kevin McClure</i> RESIDENT ENGINEER
DATE:	3/5/15
NOTE: Any further information concerning final quantities, amounts or other details relative to this project may be found at Central Files in the electronic archives.	

PROJECT LOCATION
BEGINNING AT A POINT 0.579 MILES EAST OF THE INTERSECTION OF US ROUTE 2 AND VT ROUTE 18 AND EXTENDING EASTERLY ALONG U.S. ROUTE 2 FOR A DISTANCE OF 0.09 MILES.


PROJECT DESCRIPTION
THIS PROJECT SHALL CONSIST OF THE REPLACEMENT OF THE EXISTING STRUCTURE WITH RELATED APPROACH AND CHANNEL WORK.

LENGTH OF BRIDGE: 102.66 FEET
LENGTH OF ROADWAY: 397.34 FEET
LENGTH OF PROJECT: 500.00 FEET

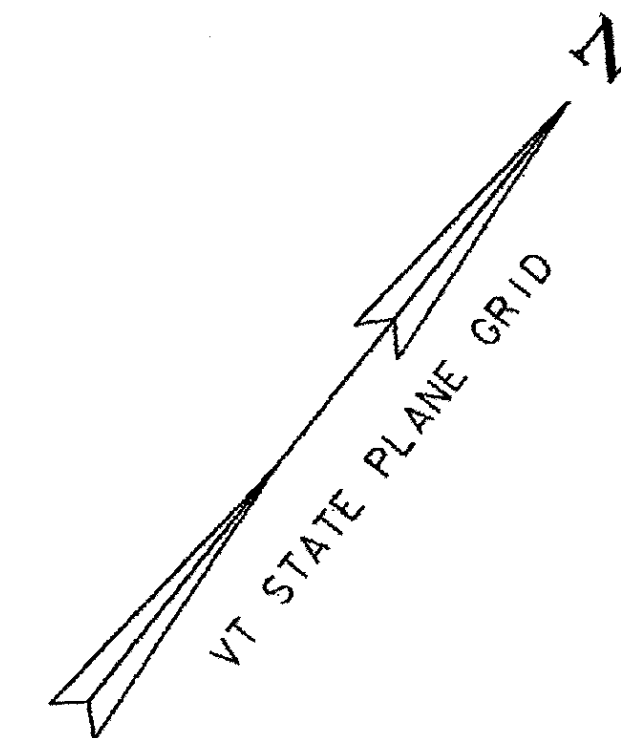


QUALITY ASSURANCE PROGRAM: **LEVEL 1**

CONVENTIONAL SYMBOLS	
COUNTY LINE	
TOWN LINE	
LIMITS OF ACCESS	
POINT OF ACCESS	
FENCE LINE	
STONE WALL	
TRAVELED WAY	
GUARD RAIL	
RAILROAD	
SURVEY LINE	
CULVERT	
POWER POLE	
TELEPHONE POLE	
TREES	
CONTROL OF ACCESS	
PROPERTY LINE	
R.O.W. TAKING LINE	
SLOPE RIGHTS	
TOP OF CUT	
TOE OF SLOPE	

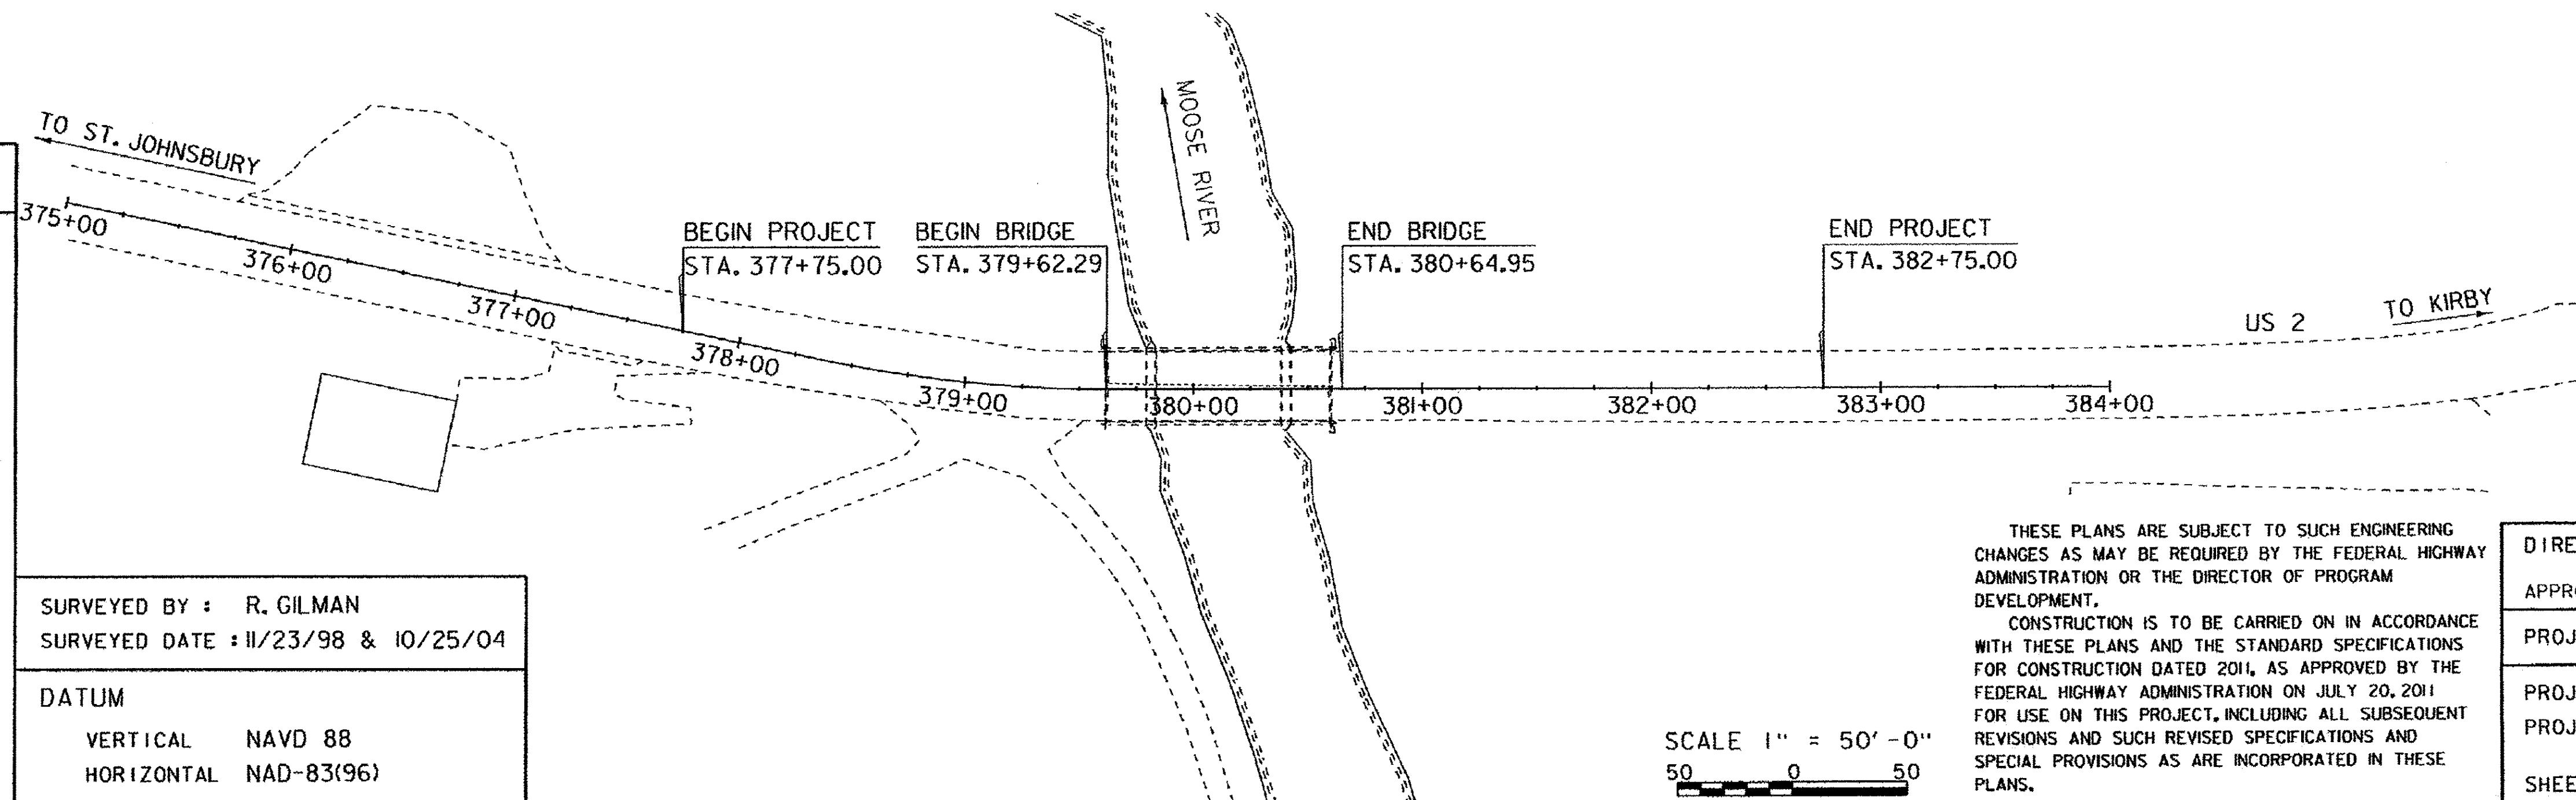

SURVEYED BY : R. GILMAN
SURVEYED DATE : 11/23/98 & 10/25/04
DATUM
VERTICAL NAVD 88
HORIZONTAL NAD-83(96)

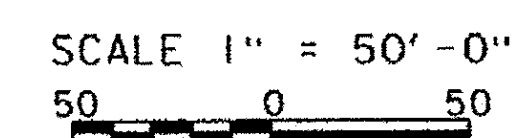

THESE PLANS ARE SUBJECT TO SUCH ENGINEERING CHANGES AS MAY BE REQUIRED BY THE FEDERAL HIGHWAY ADMINISTRATION OR THE DIRECTOR OF PROGRAM DEVELOPMENT.
CONSTRUCTION IS TO BE CARRIED ON IN ACCORDANCE WITH THESE PLANS AND THE STANDARD SPECIFICATIONS FOR CONSTRUCTION DATED 2011, AS APPROVED BY THE FEDERAL HIGHWAY ADMINISTRATION ON JULY 20, 2011 FOR USE ON THIS PROJECT, INCLUDING ALL SUBSEQUENT REVISIONS AND SUCH REVISED SPECIFICATIONS AND SPECIAL PROVISIONS AS ARE INCORPORATED IN THESE PLANS.

DIRECTOR OF PROGRAM DEVELOPMENT	
APPROVED	<i>Kevin A. Marchis</i> DATE 8/27/12
PROJECT MANAGER : CAROLYN CARLSON	
PROJECT NAME :	ST. JOHNSBURY
PROJECT NUMBER :	BRF 028-4(25)S
SHEET 1 OF 62 SHEETS	