


PLAN  
SCALE 1" = 10'-0"  
10 0 10

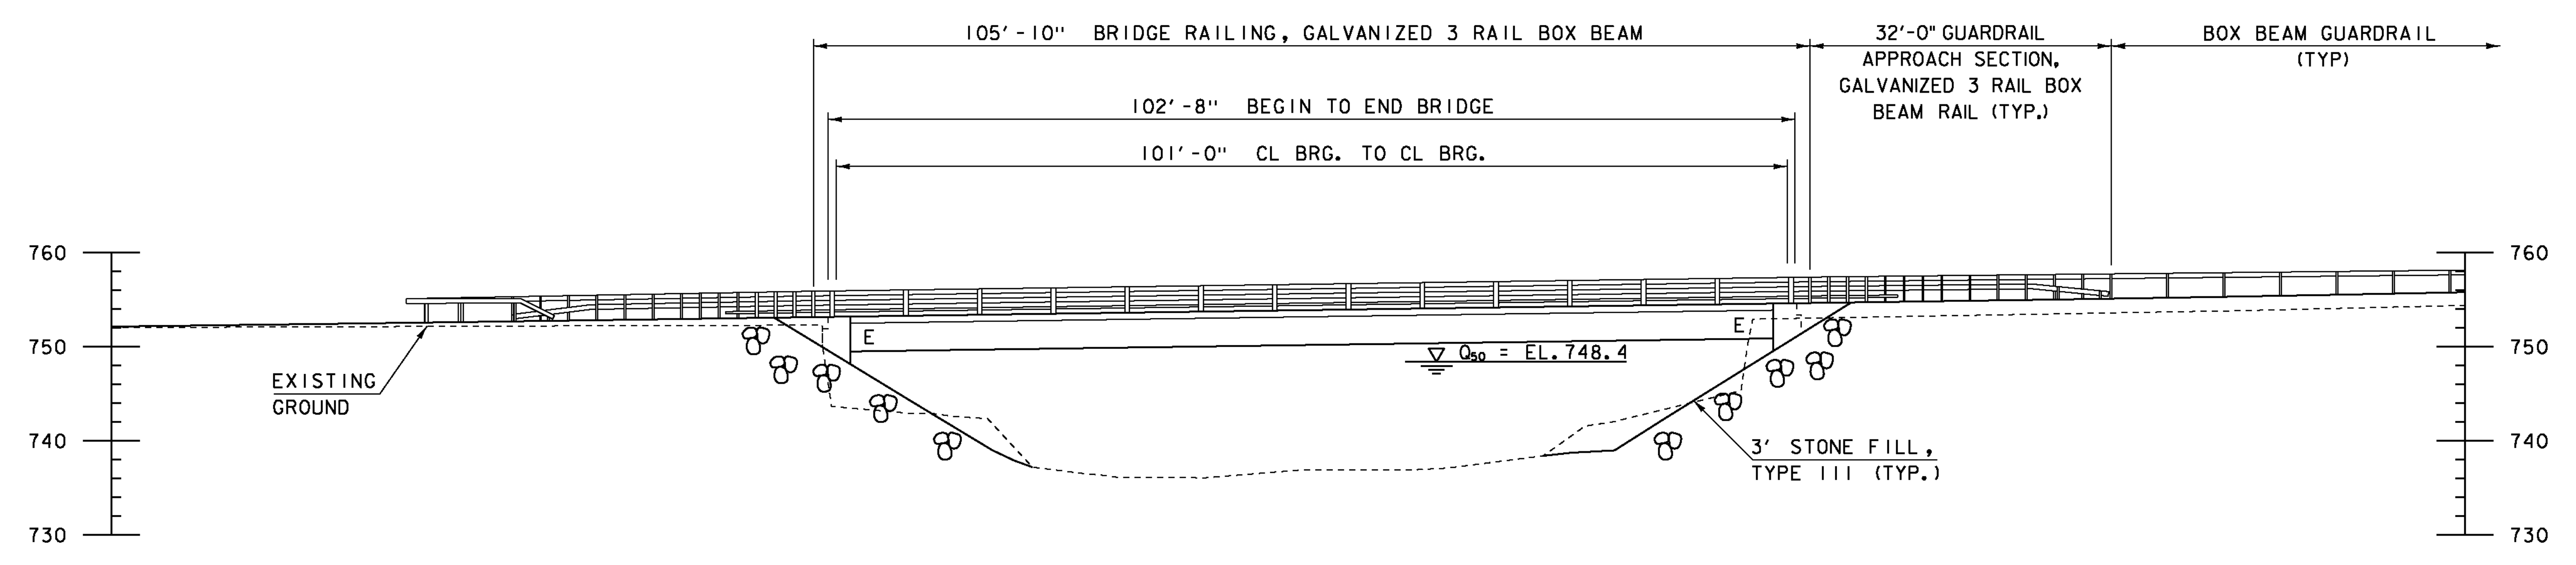

ELEVATION  
SCALE 1" = 10'-0"  
10 0 10

PROJECT NAME: ST. JOHNSBURY	PLOT DATE: 28-AUG-2012
PROJECT NUMBER: BRF 028-4(25)S	DRAWN BY: C. MOONEY
FILE NAME: s98b320pe.dgn	CHECKED BY: C. CARLSON
PROJECT LEADER: C. CARLSON	SHEET 22 OF 62
DESIGNED BY: H. SALLS	
PLAN AND ELEVATION	