


**INTEGRAL ABUTMENT NO. 1 PLAN**  
SCALE 1/2" = 1'-0"

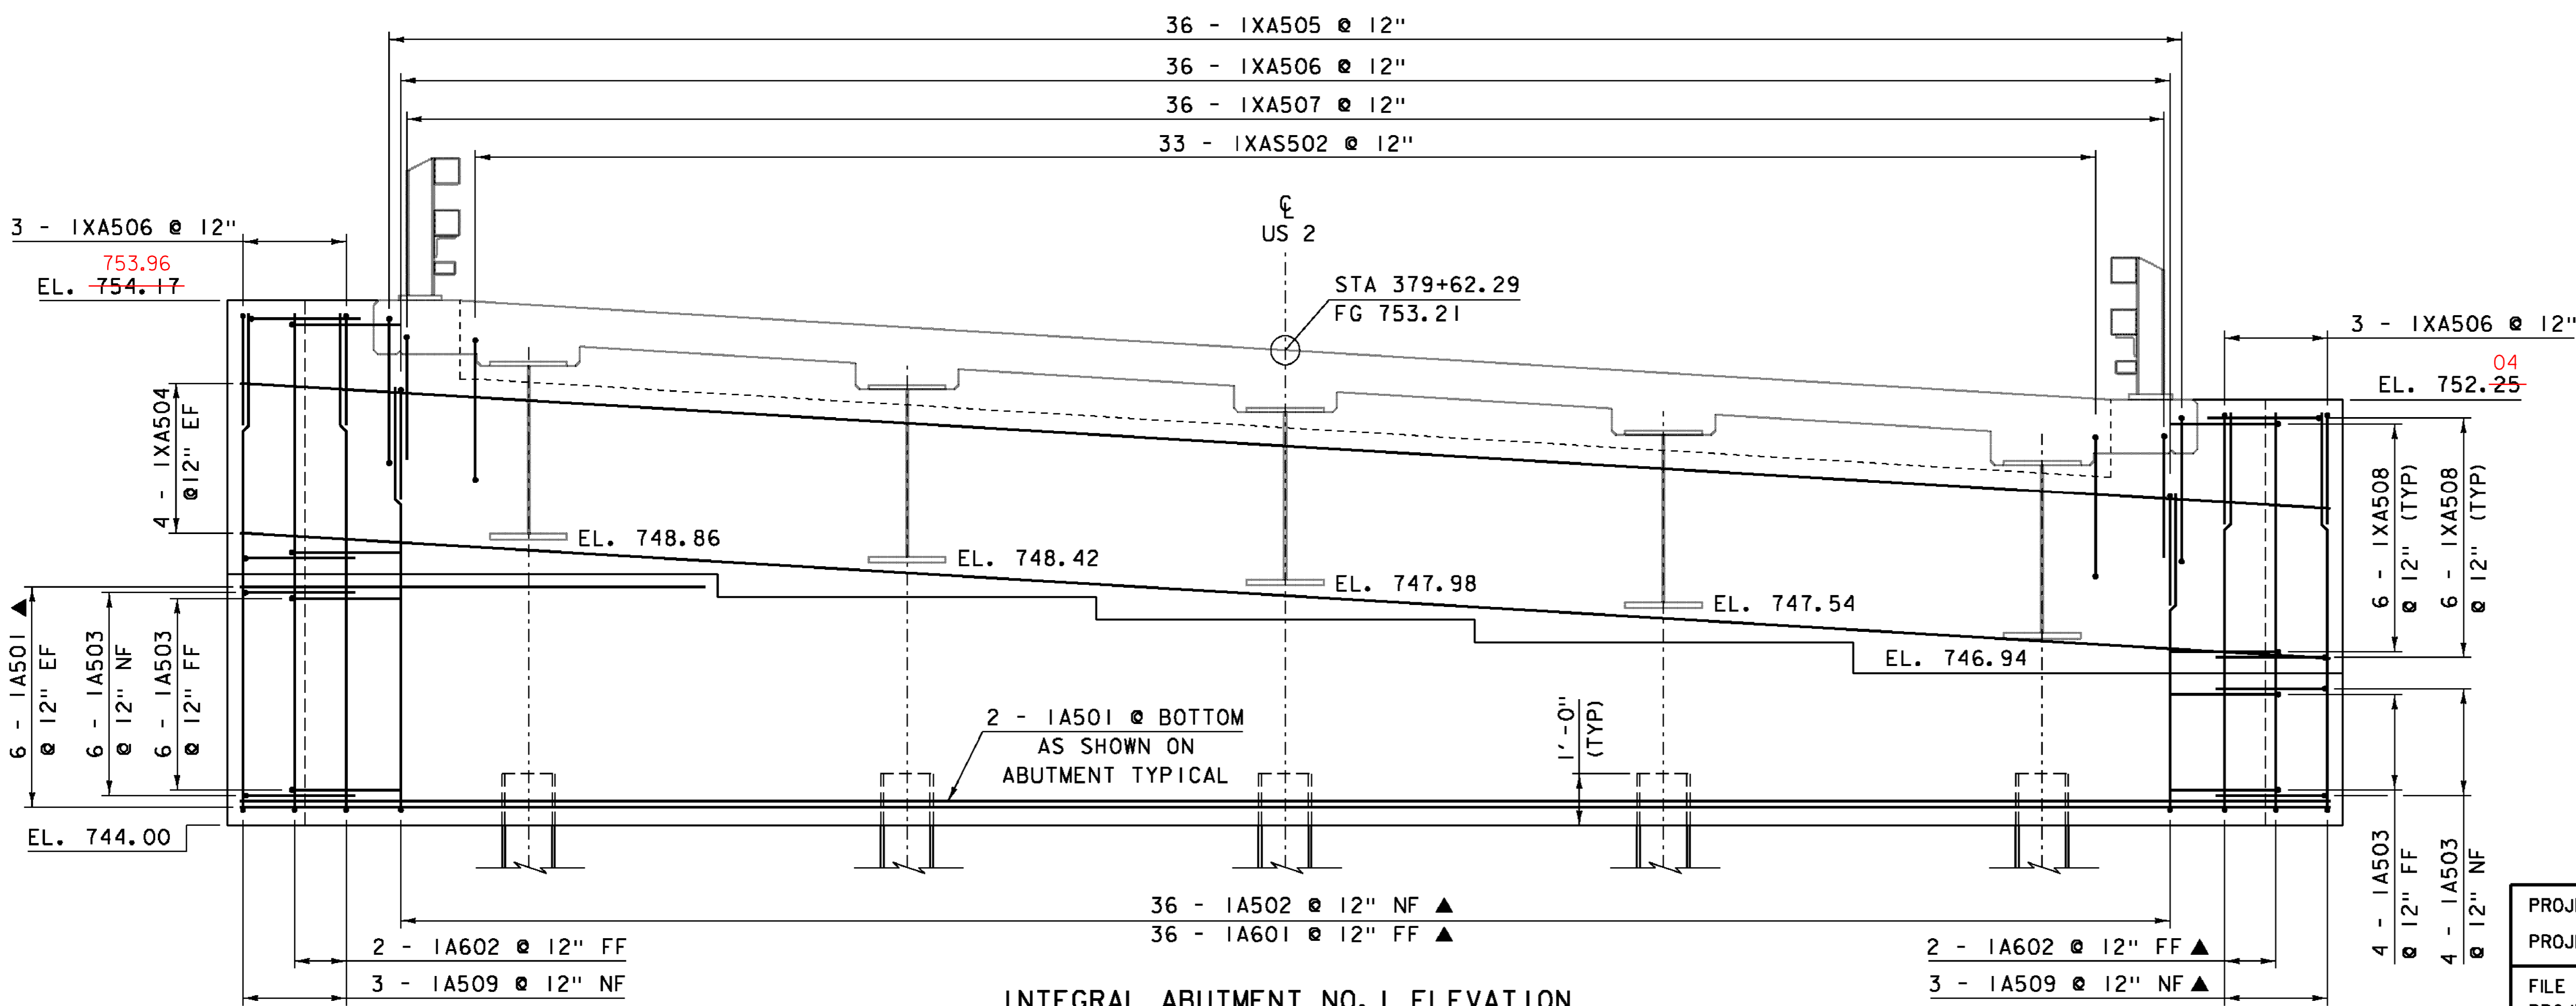

**INTEGRAL ABUTMENT NO. 1 ELEVATION**  
SCALE 1/2" = 1'-0"

SEE STRUCTURES DETAIL SHEET SD-502.00 FOR BRIDGE PLAGUE DETAILS.

SEE ABUTMENT TYPICAL SECTIONS SHEET FOR ABUTMENT TYPICAL.

**NOTE:**  
 NF = NEAR FACE  
 FF = FAR FACE  
 EF = EACH FACE  
 ▲ = CUT TO FIT IN FIELD  
 3" CLEAR, UNLESS OTHERWISE SPECIFIED ON THE PLANS.  
 2'-2" BAR LAP UNLESS OTHERWISE SPECIFIED ON THE PLANS.

PROJECT NAME:	ST. JOHNSBURY	FILE NAME:	s98b320sub.dgn	PLOT DATE:	28-AUG-2012
PROJECT NUMBER:	BRF 028-4(25)S	PROJECT LEADER:	C. CARLSON	DRAWN BY:	R. PELLETT
		DESIGNED BY:	H. SALLS	CHECKED BY:	C. CARLSON
		ABUTMENT NO. 1 DETAILS			SHEET 26 OF 62