


INTEGRAL ABUTMENT NO. 2 PLAN
 SCALE 1/2" = 1'-0"

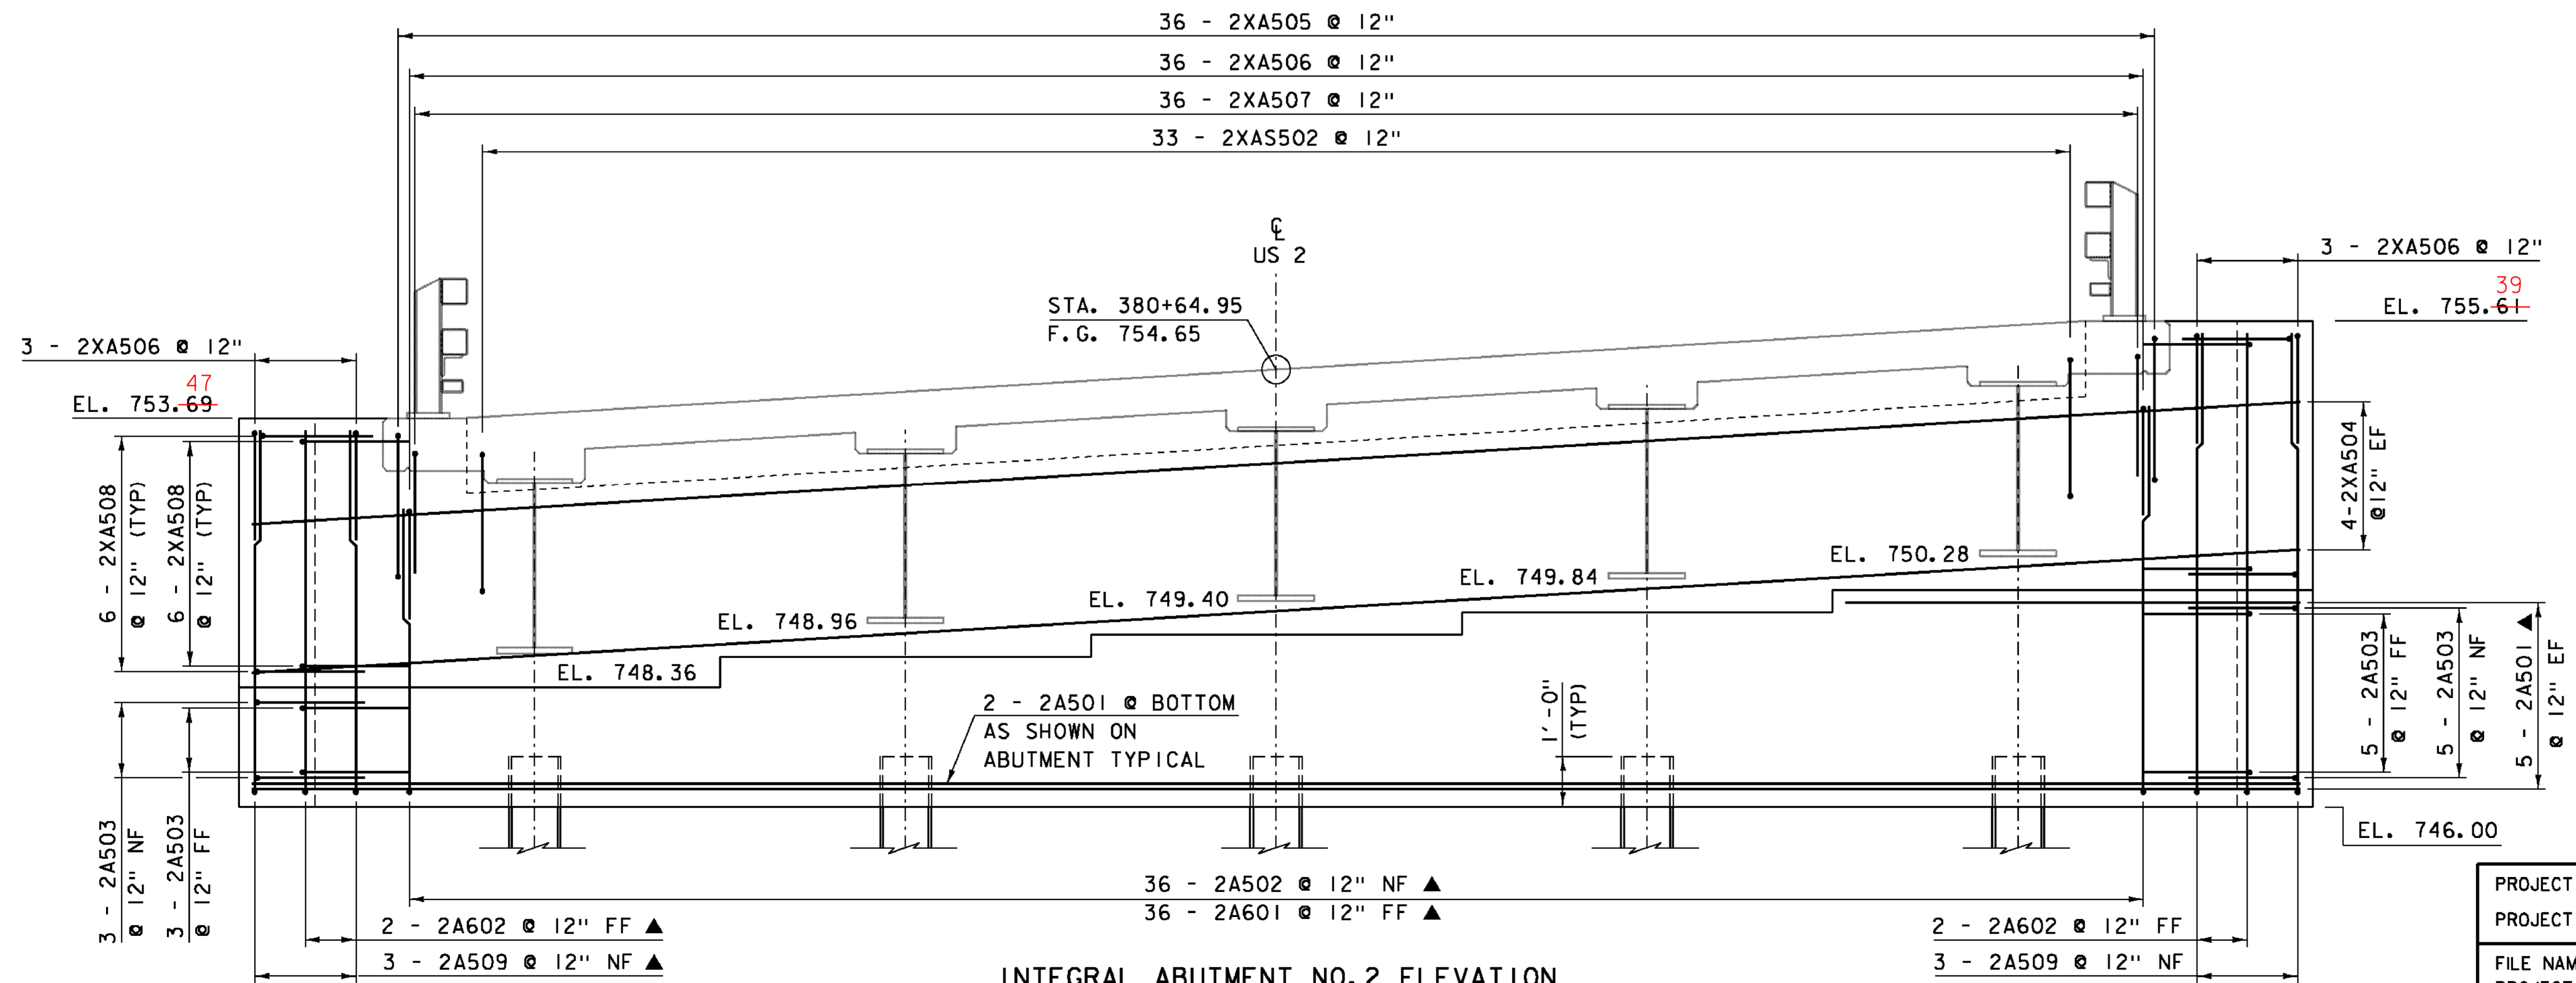

INTEGRAL ABUTMENT NO. 2 ELEVATION
 SCALE 1/2" = 1'-0"

SEE ABUTMENT TYPICAL SECTIONS SHEET FOR ABUTMENT TYPICAL.

NOTE:
 NF = NEAR FACE
 FF = FAR FACE
 EF = EACH FACE
 ▲ = CUT TO FIT IN FIELD
 3" CLEAR, UNLESS OTHERWISE SPECIFIED ON THE PLANS.
 2'-2" BAR LAP UNLESS OTHERWISE SPECIFIED ON THE PLANS.

PROJECT NAME:	ST. JOHNSBURY	FILE NAME:	s98b320sub.dgn	PLOT DATE:	28-AUG-2012
PROJECT NUMBER:	BRF 028-4(25)S	PROJECT LEADER:	C. CARLSON	DRAWN BY:	R. PELLETT
		DESIGNED BY:	H. SALLS	CHECKED BY:	C. CARLSON
		ABUTMENT NO. 2 DETAILS			SHEET 27 OF 62