



378+50

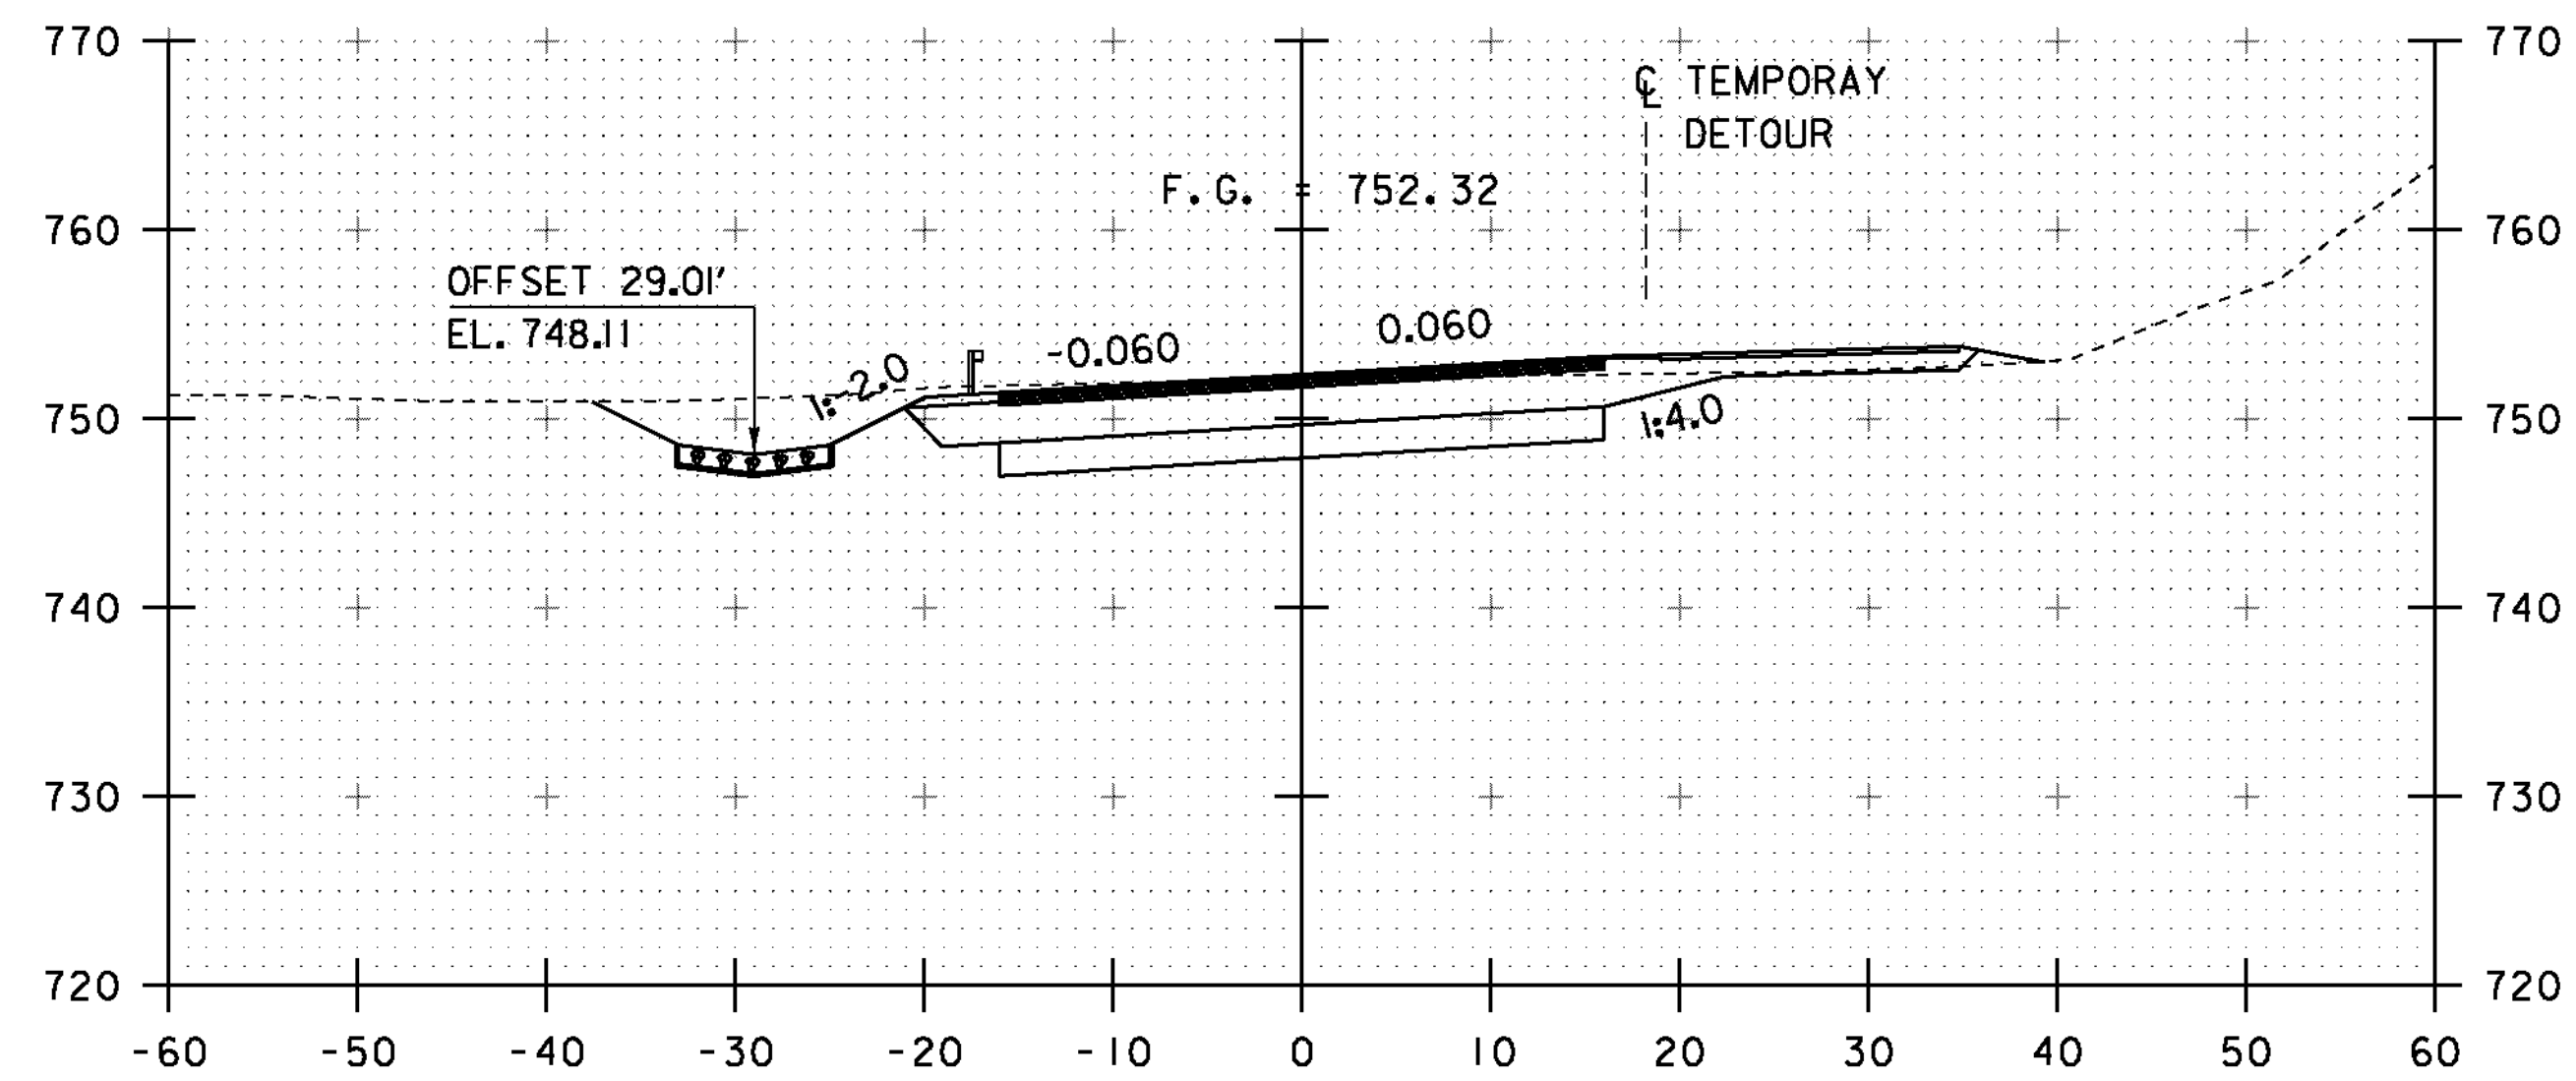


379+00

STA. 378+88 TO 379+20 RT
CONSTRUCT 3'-0" PAVED APRON

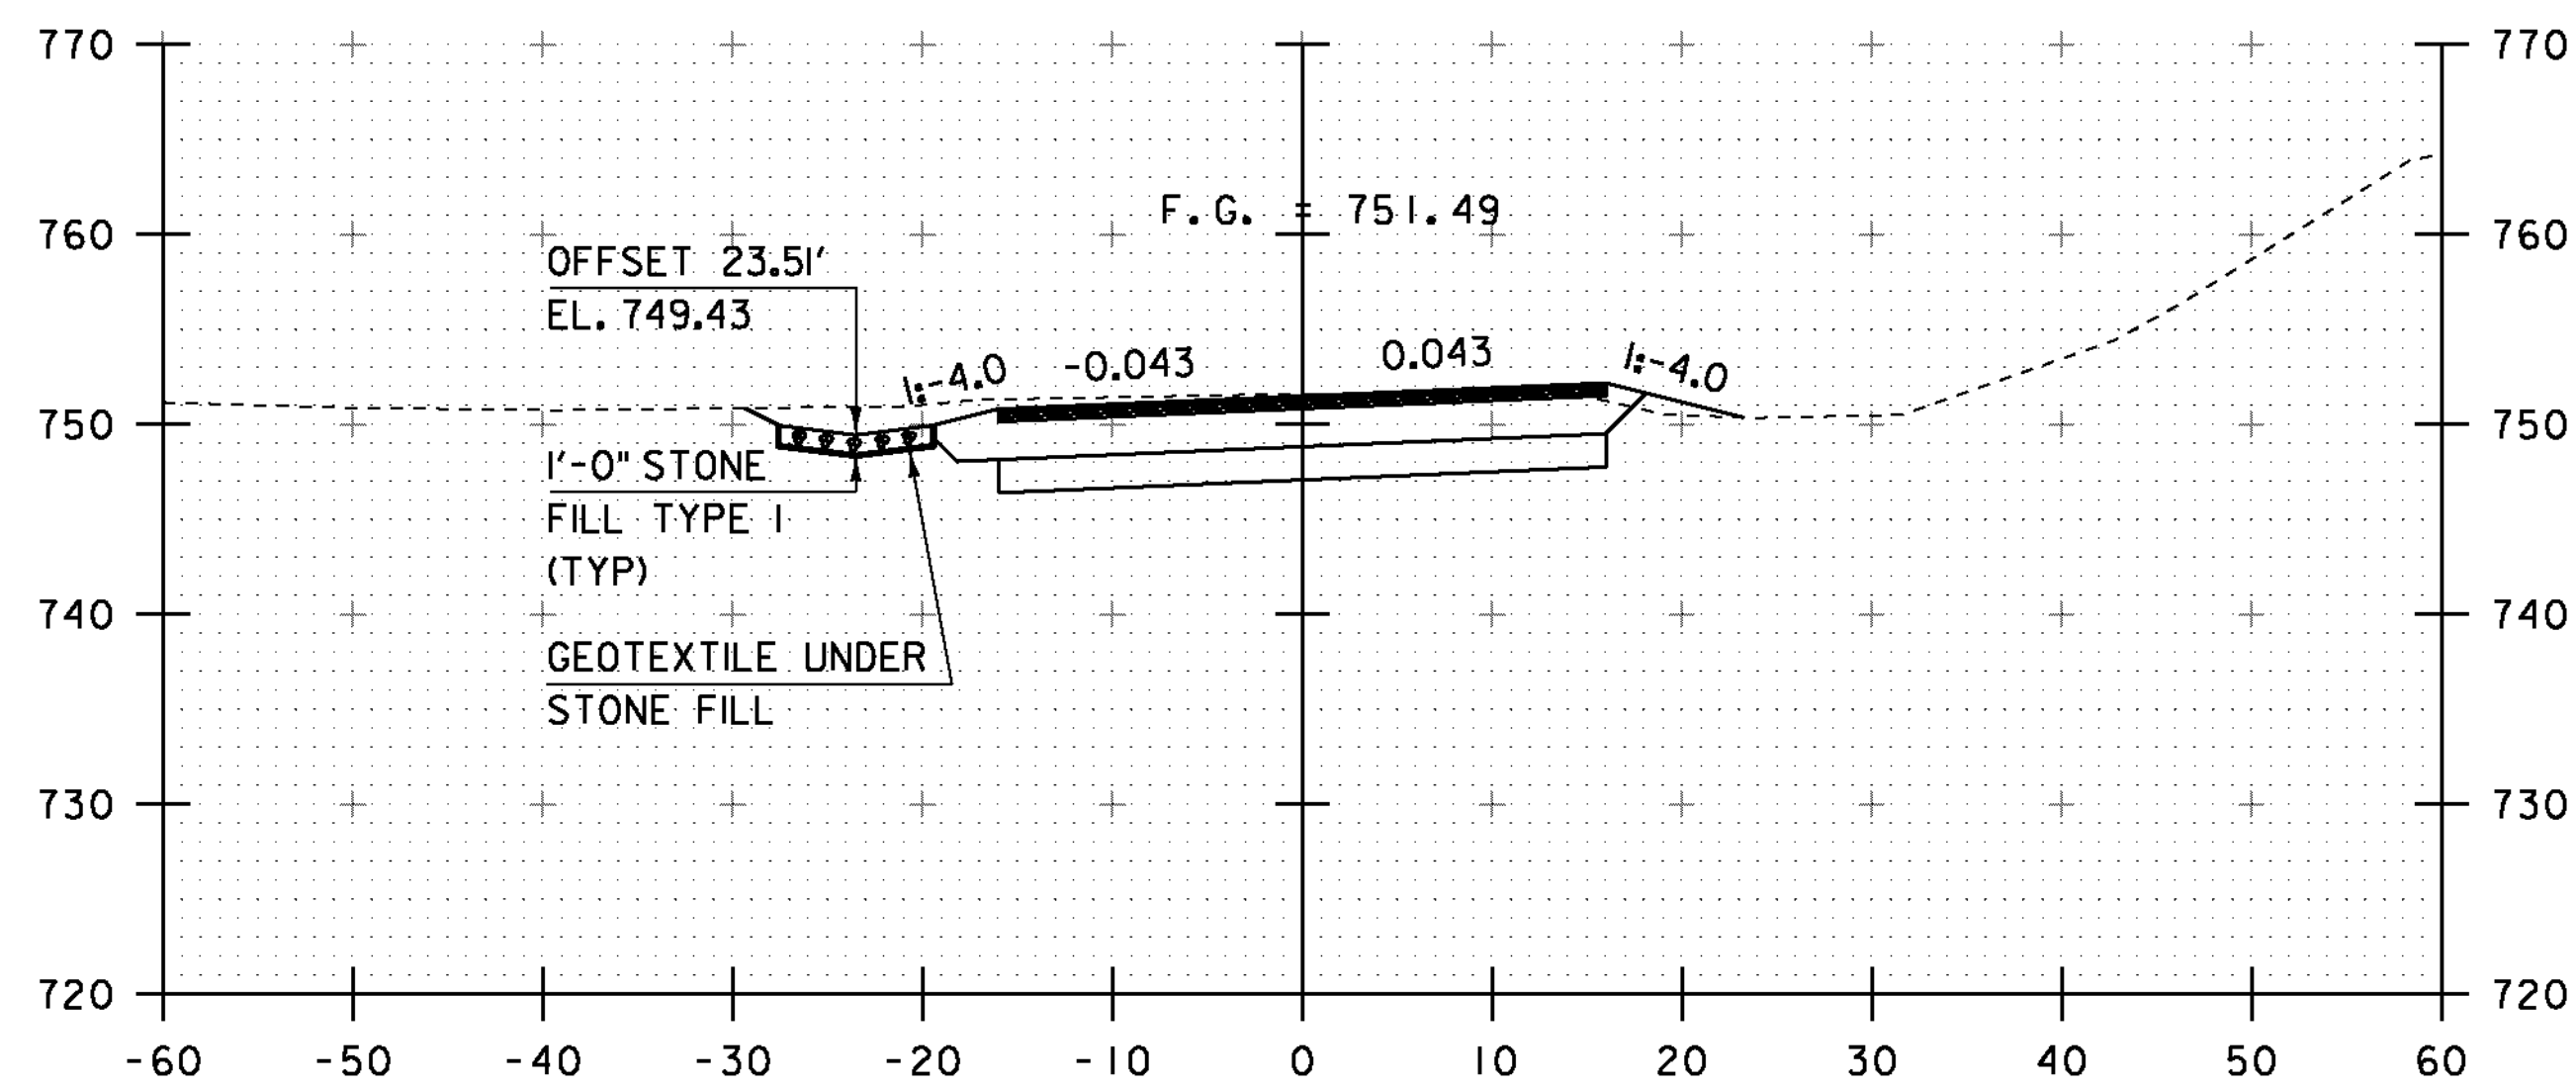

378+25

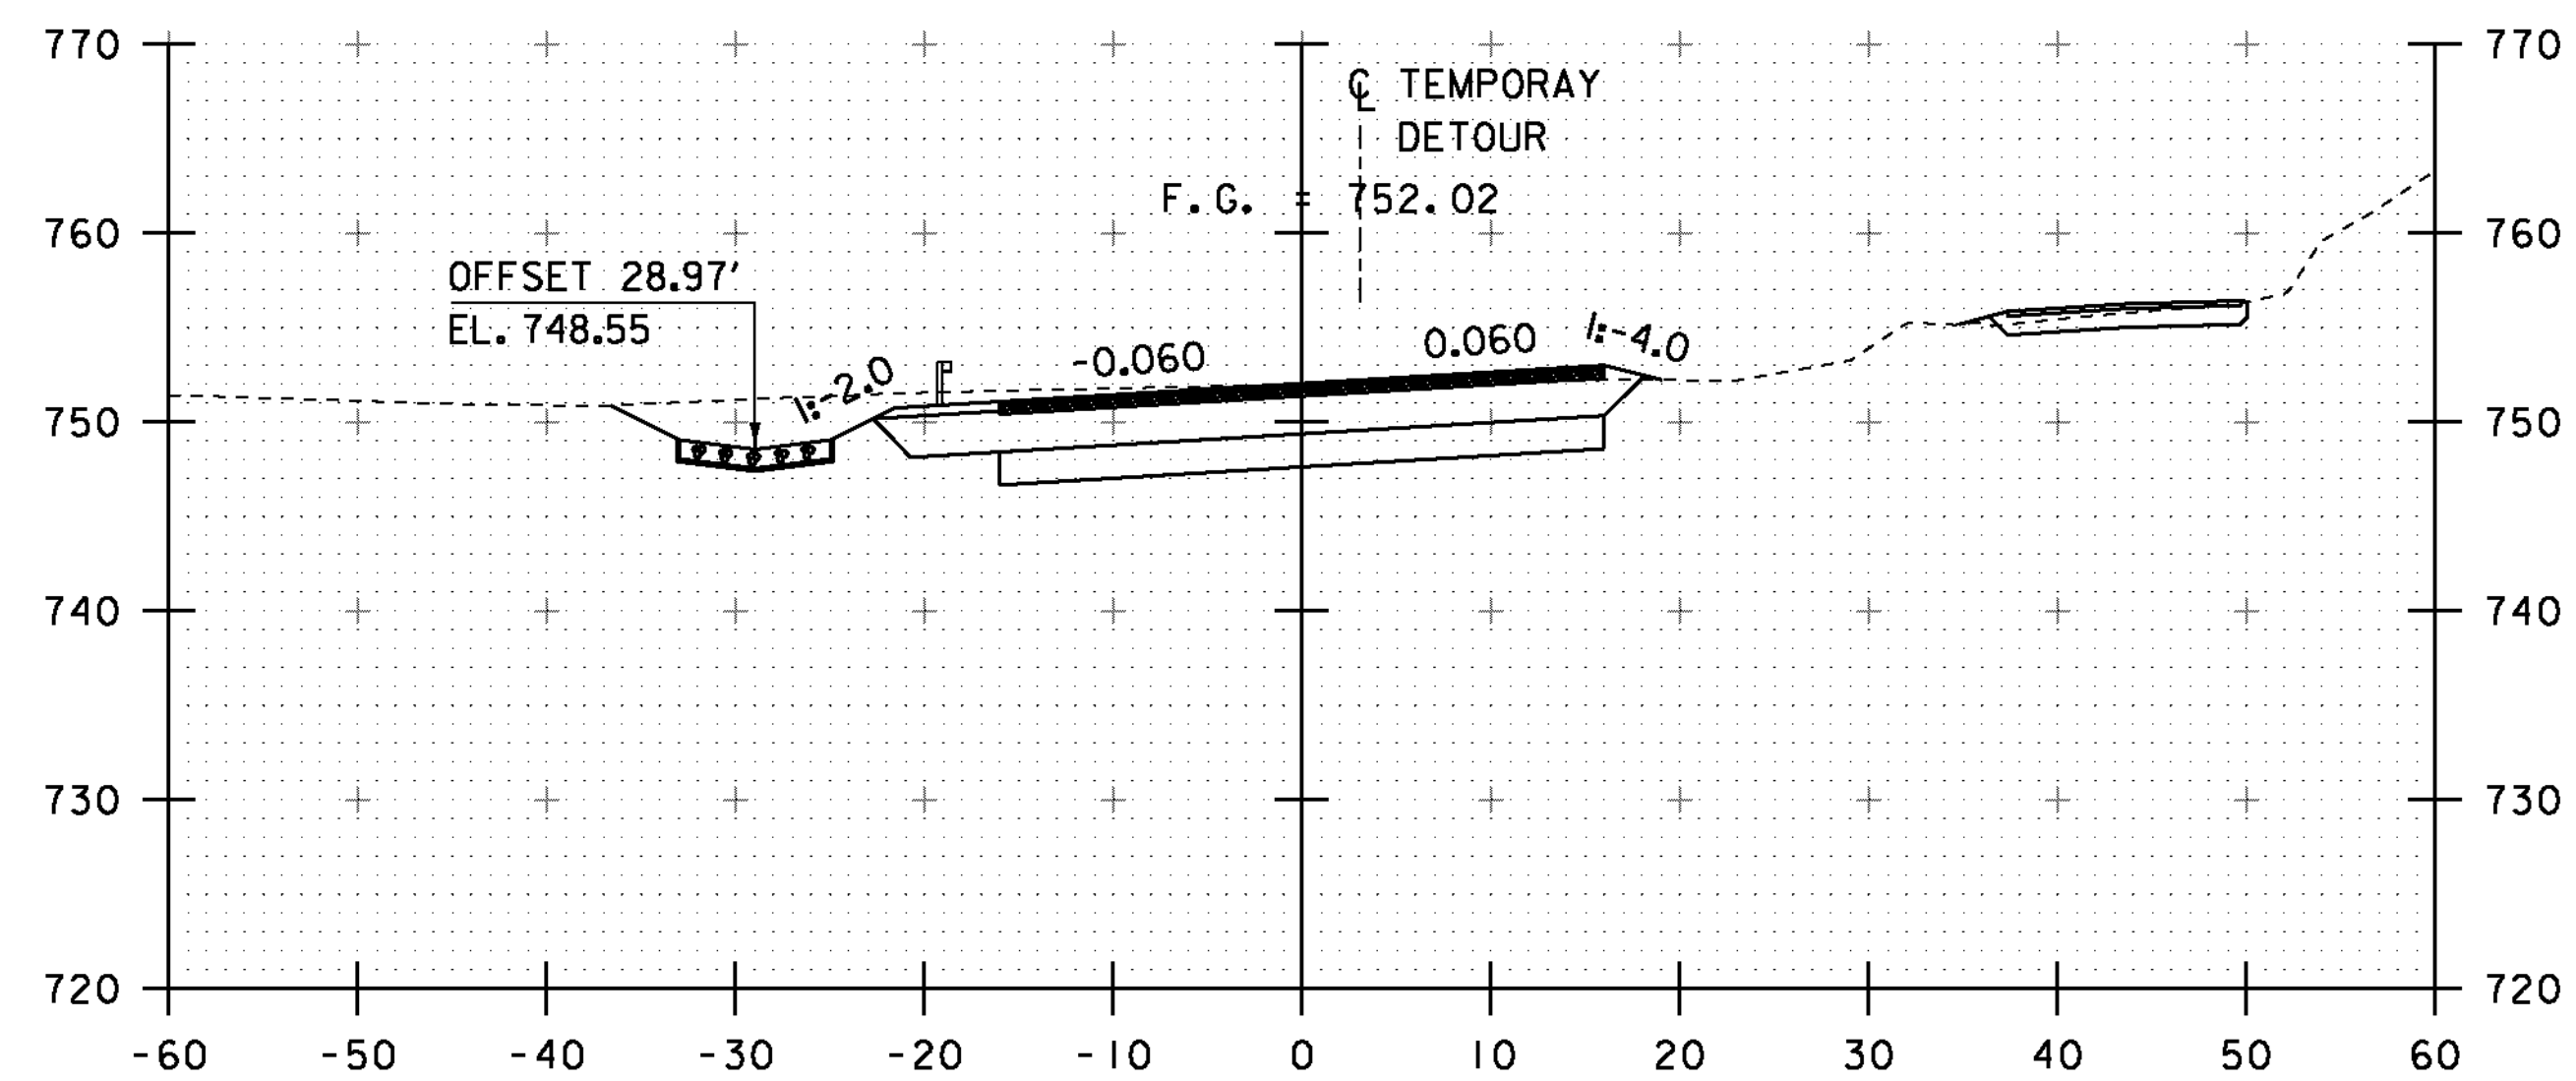

378+75

10 0 10
SCALE: 1" = 10'-0"
STA. 378+25 TO STA. 379+00

PROJECT NAME: ST. JOHNSBURY	PLOT DATE: 28-AUG-2012
PROJECT NUMBER: BRF 028-4(25)S	DRAWN BY: C. MOONEY
FILE NAME: s98b320xsl.dgn	CHECKED BY: C. CARLSON
PROJECT LEADER: C. CARLSON	SHEET 33 OF 62
DESIGNED BY: H. SALLS	
ROADWAY CROSS SECTIONS 3	