



379+25

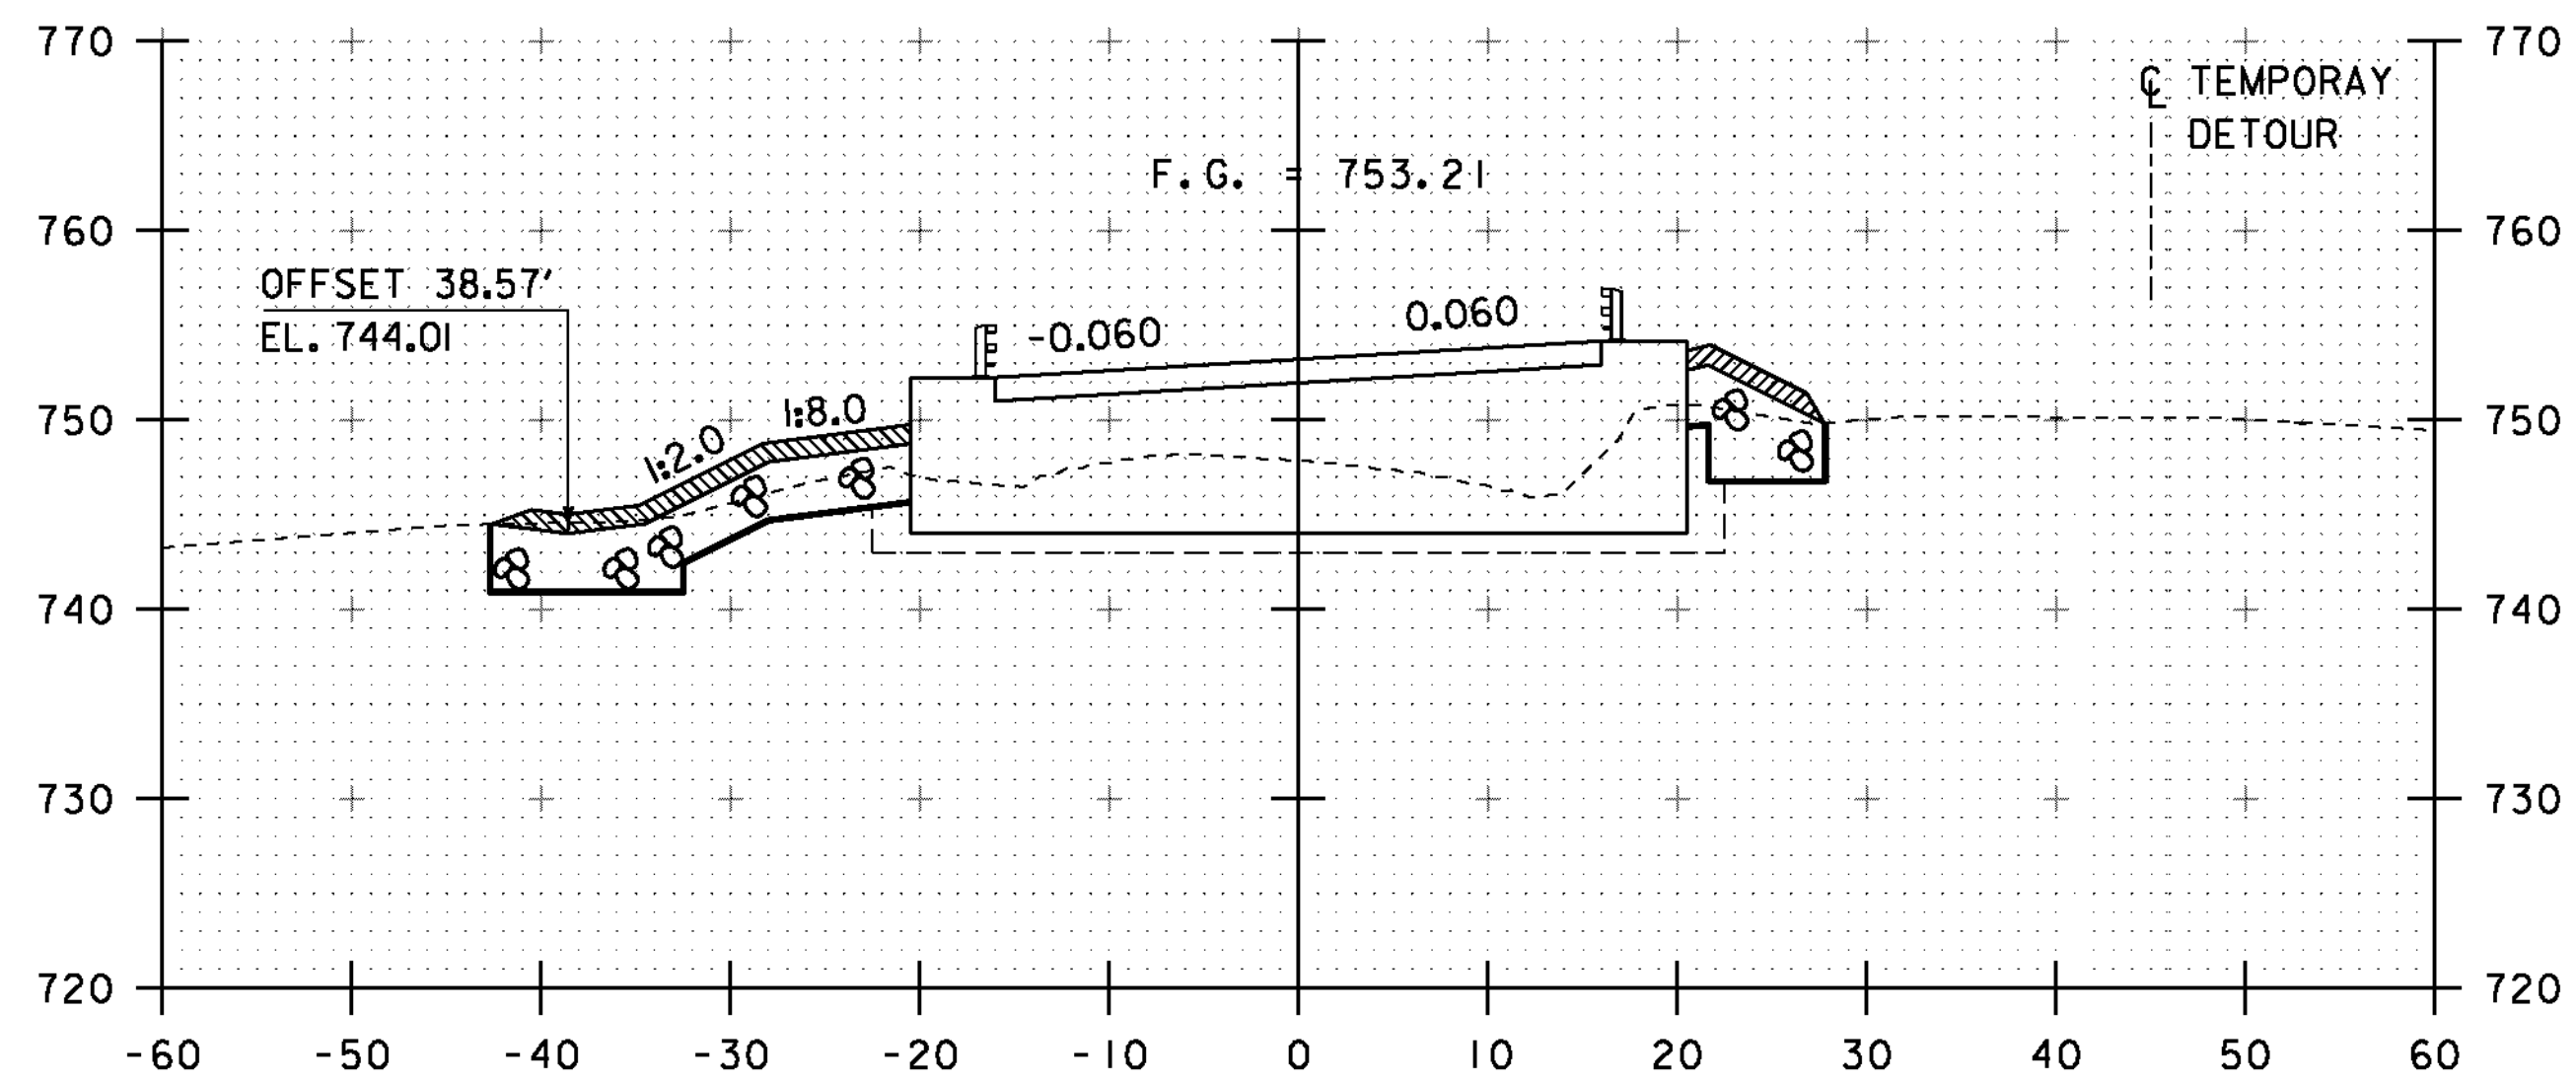


STA. 379+62.29
BEGIN BRIDGE


379+62

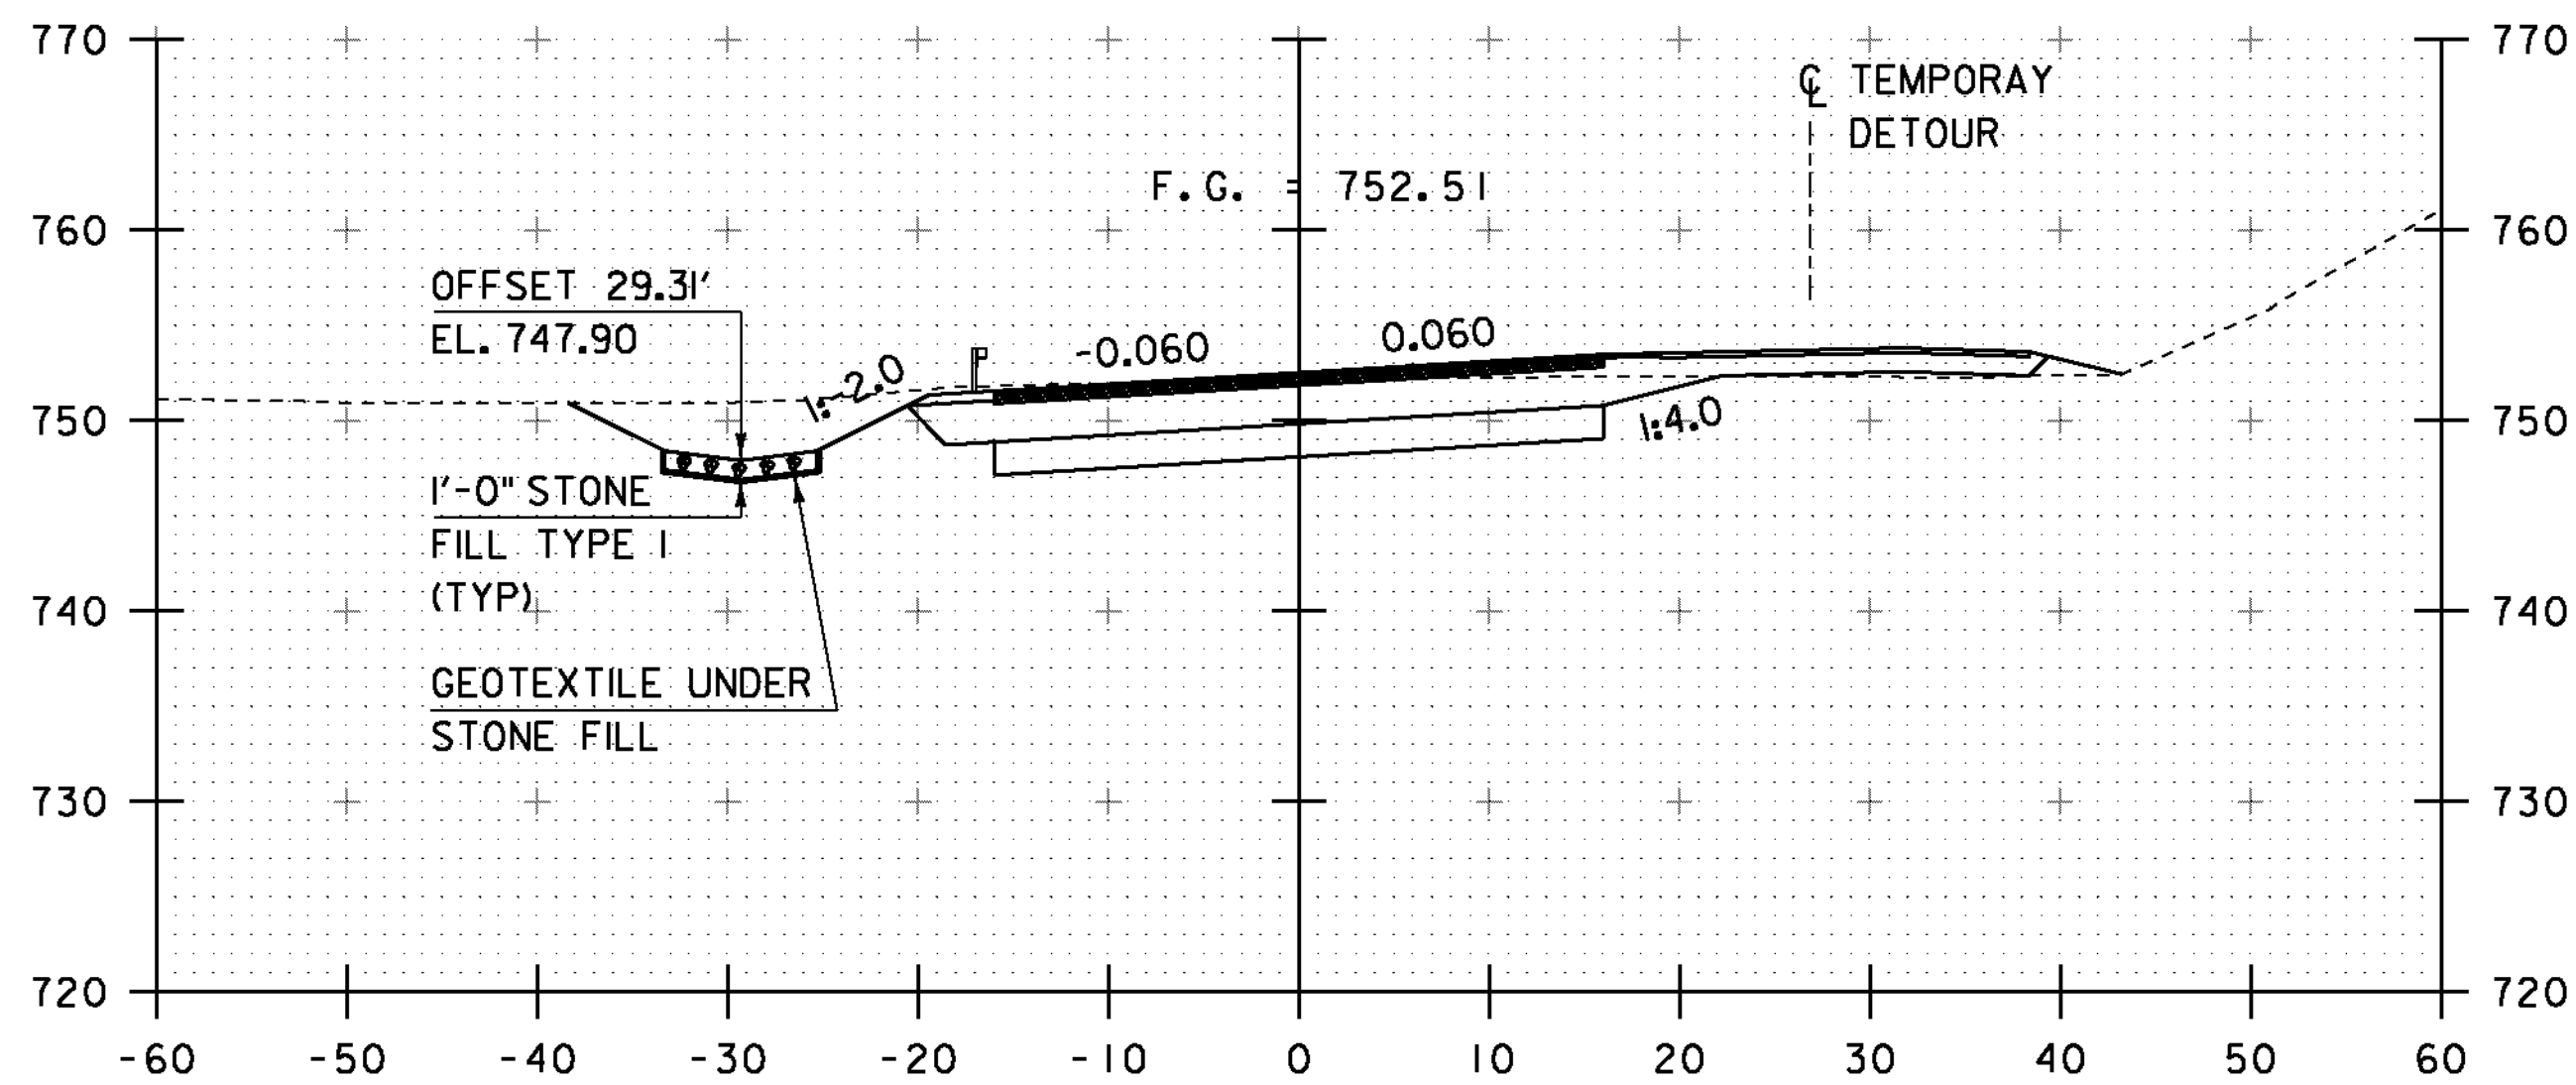

379+12

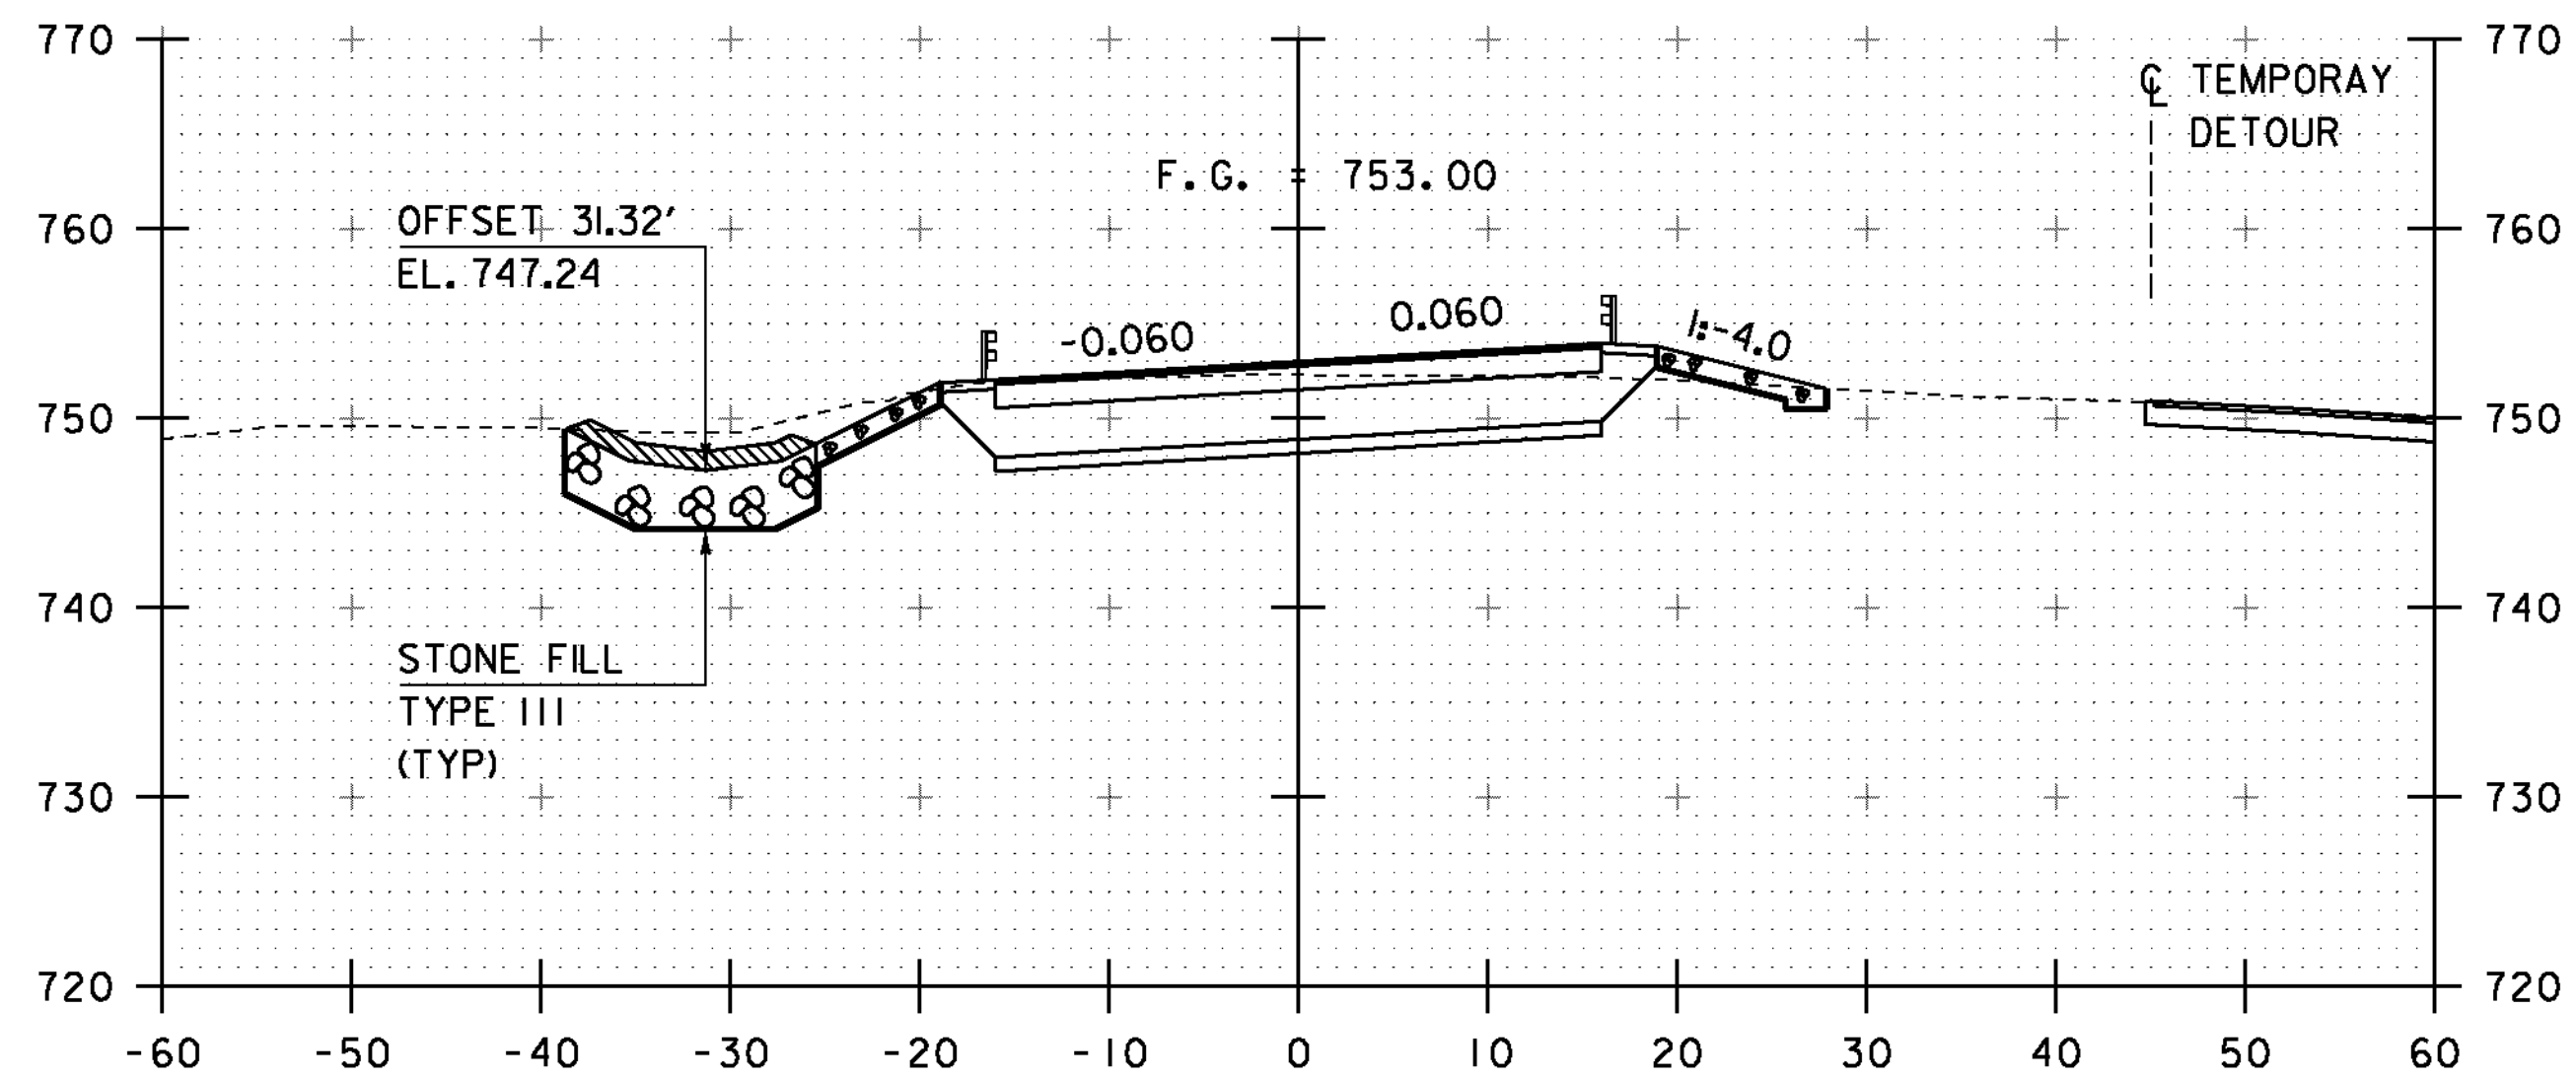

379+50

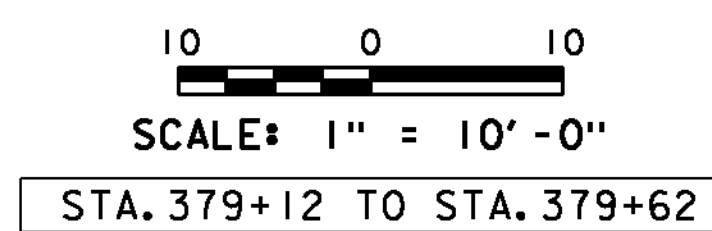

PROJECT NAME: ST. JOHNSBURY	PLOT DATE: 28-AUG-2012
PROJECT NUMBER: BRF 028-4(25)S	DRAWN BY: C. MOONEY
FILE NAME: s98b320xsl.dgn	CHECKED BY: C. CARLSON
PROJECT LEADER: C. CARLSON	SHEET 34 OF 62
DESIGNED BY: H. SALLS	
ROADWAY CROSS SECTIONS 4	