




380+00

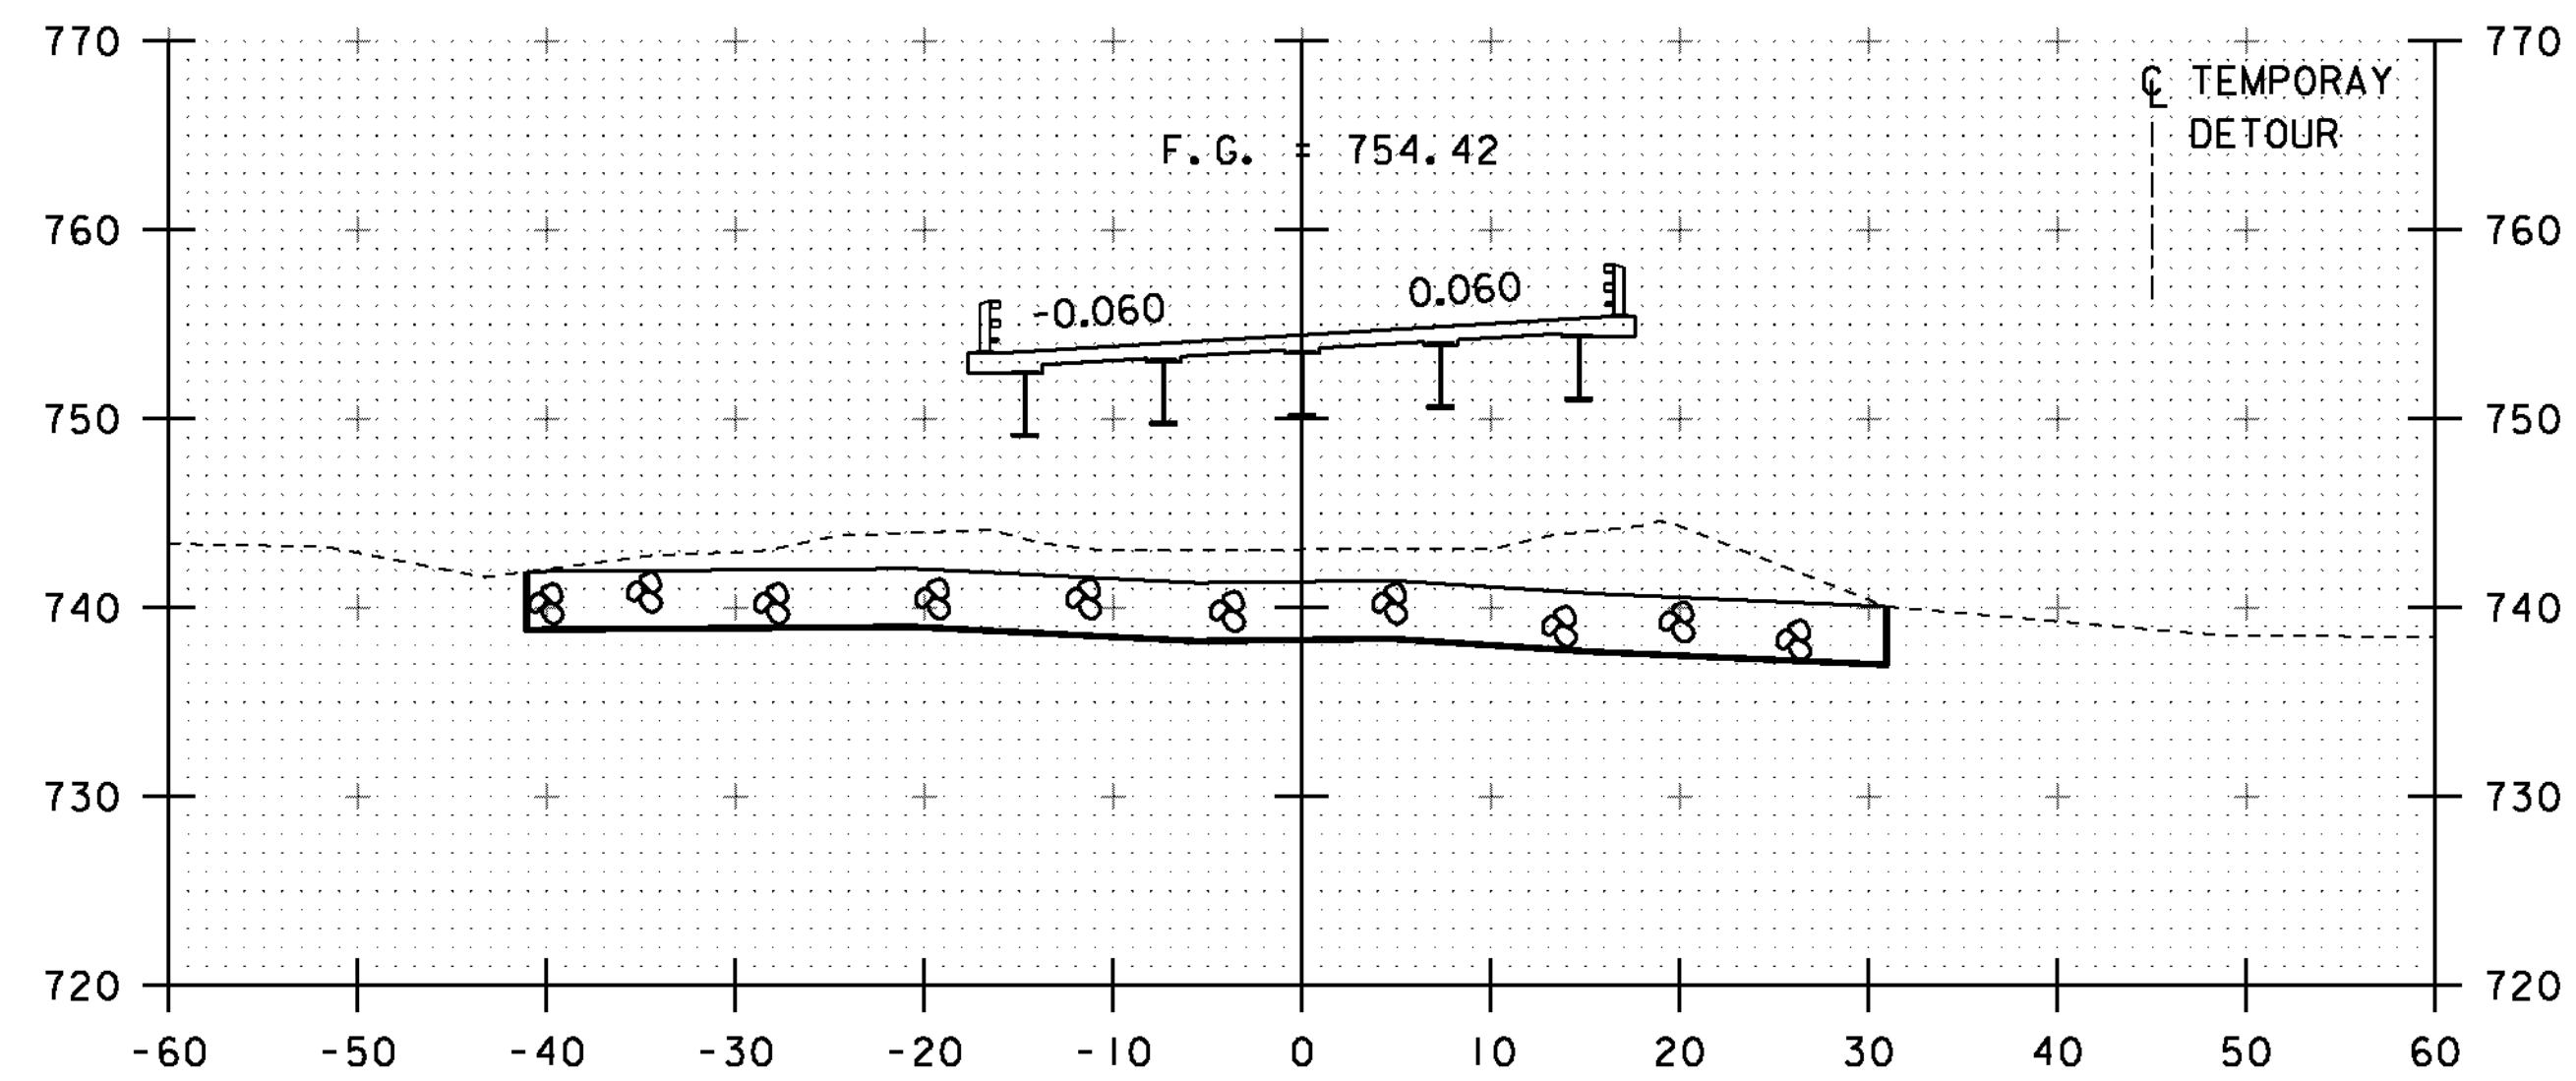


380+50

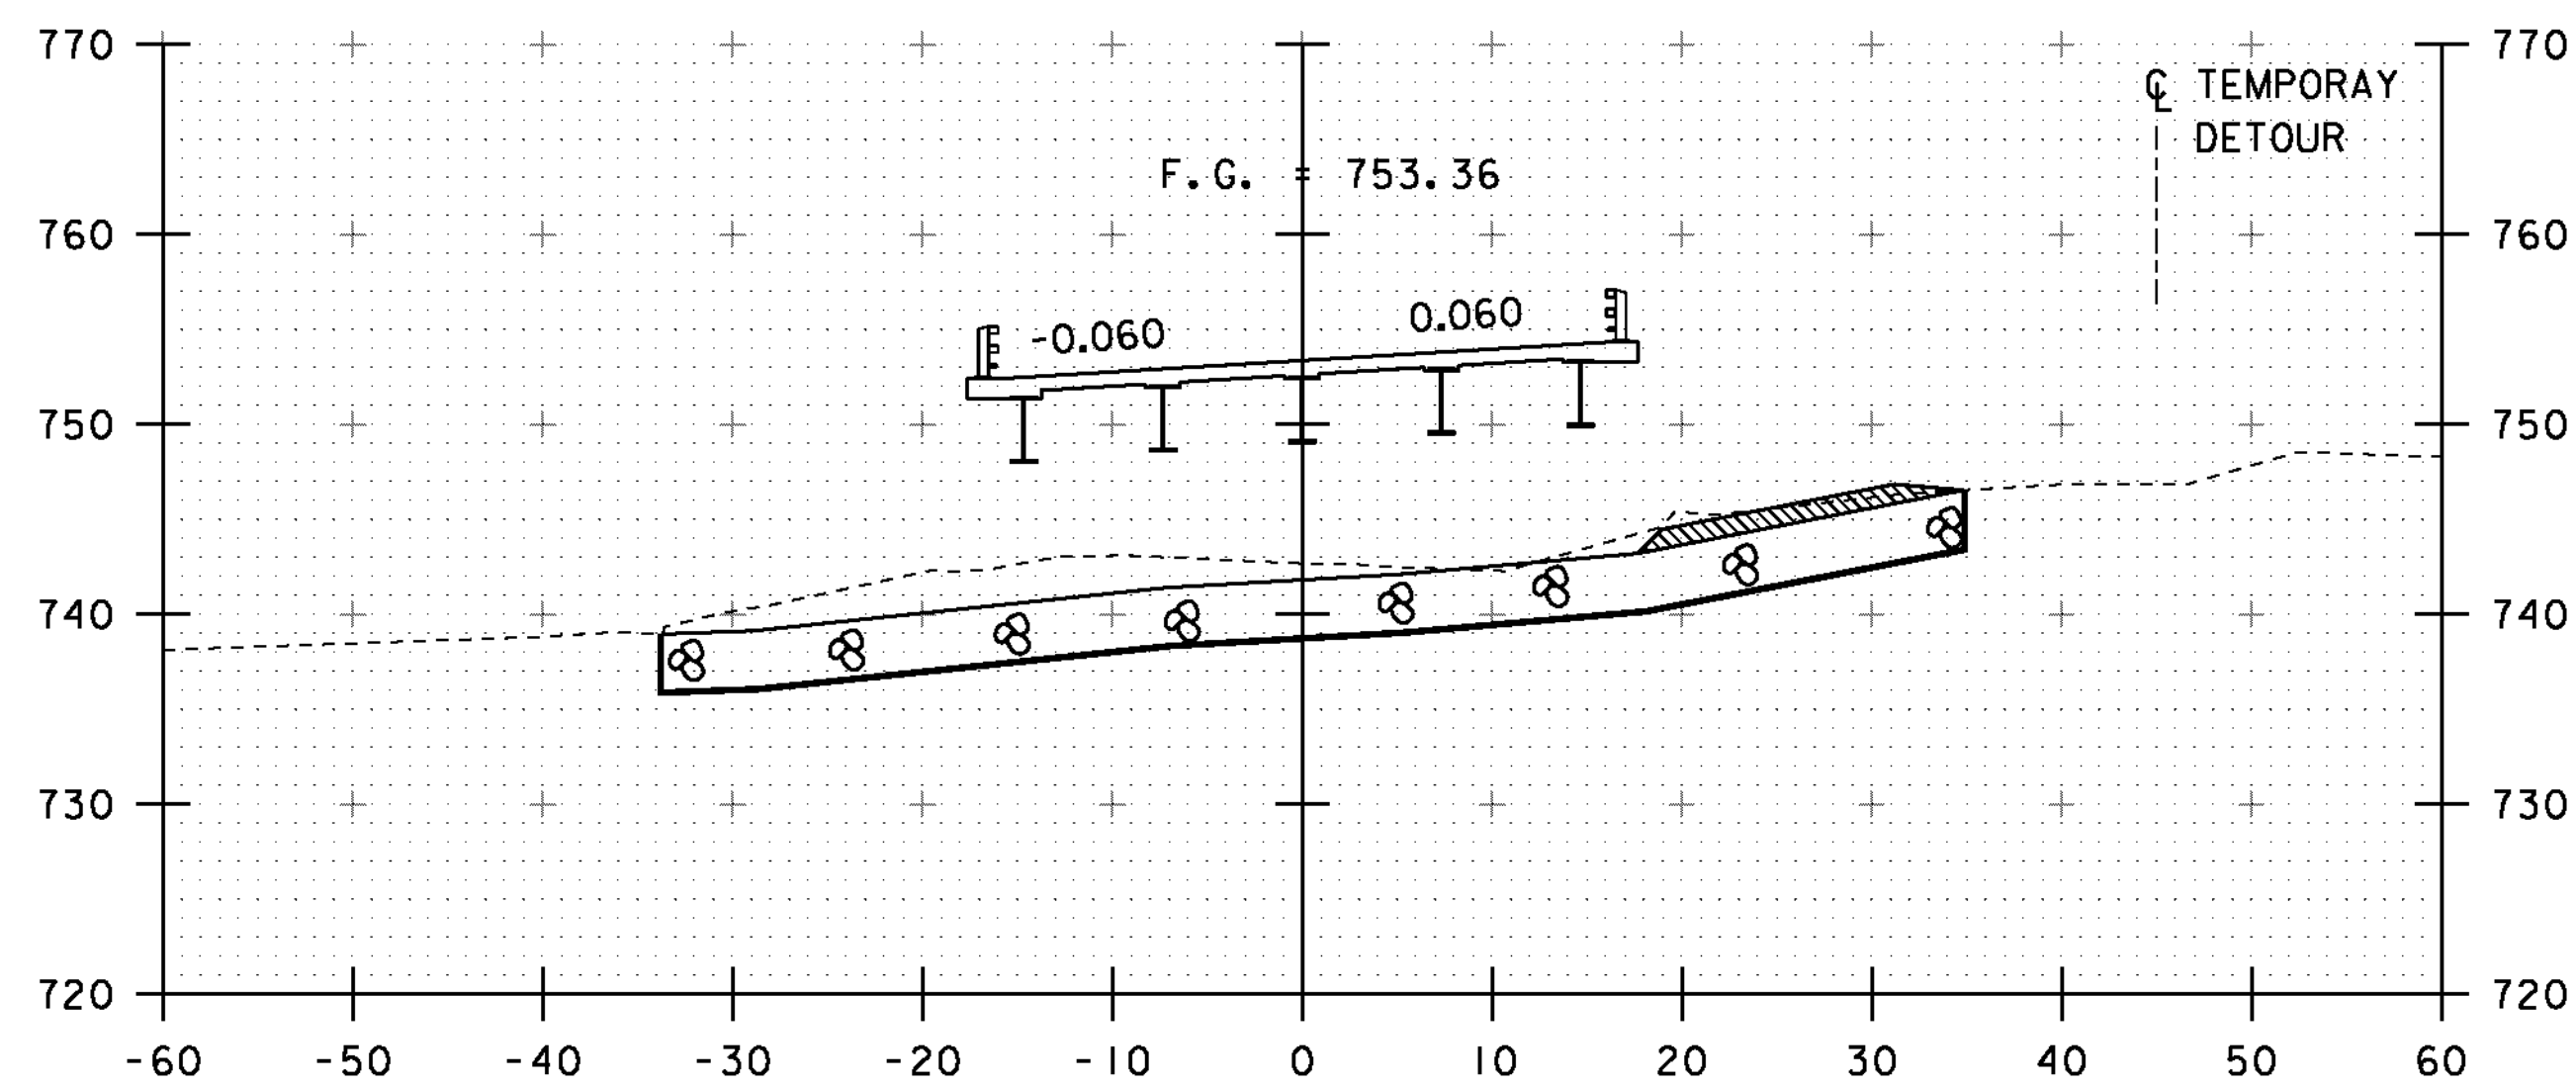

379+75

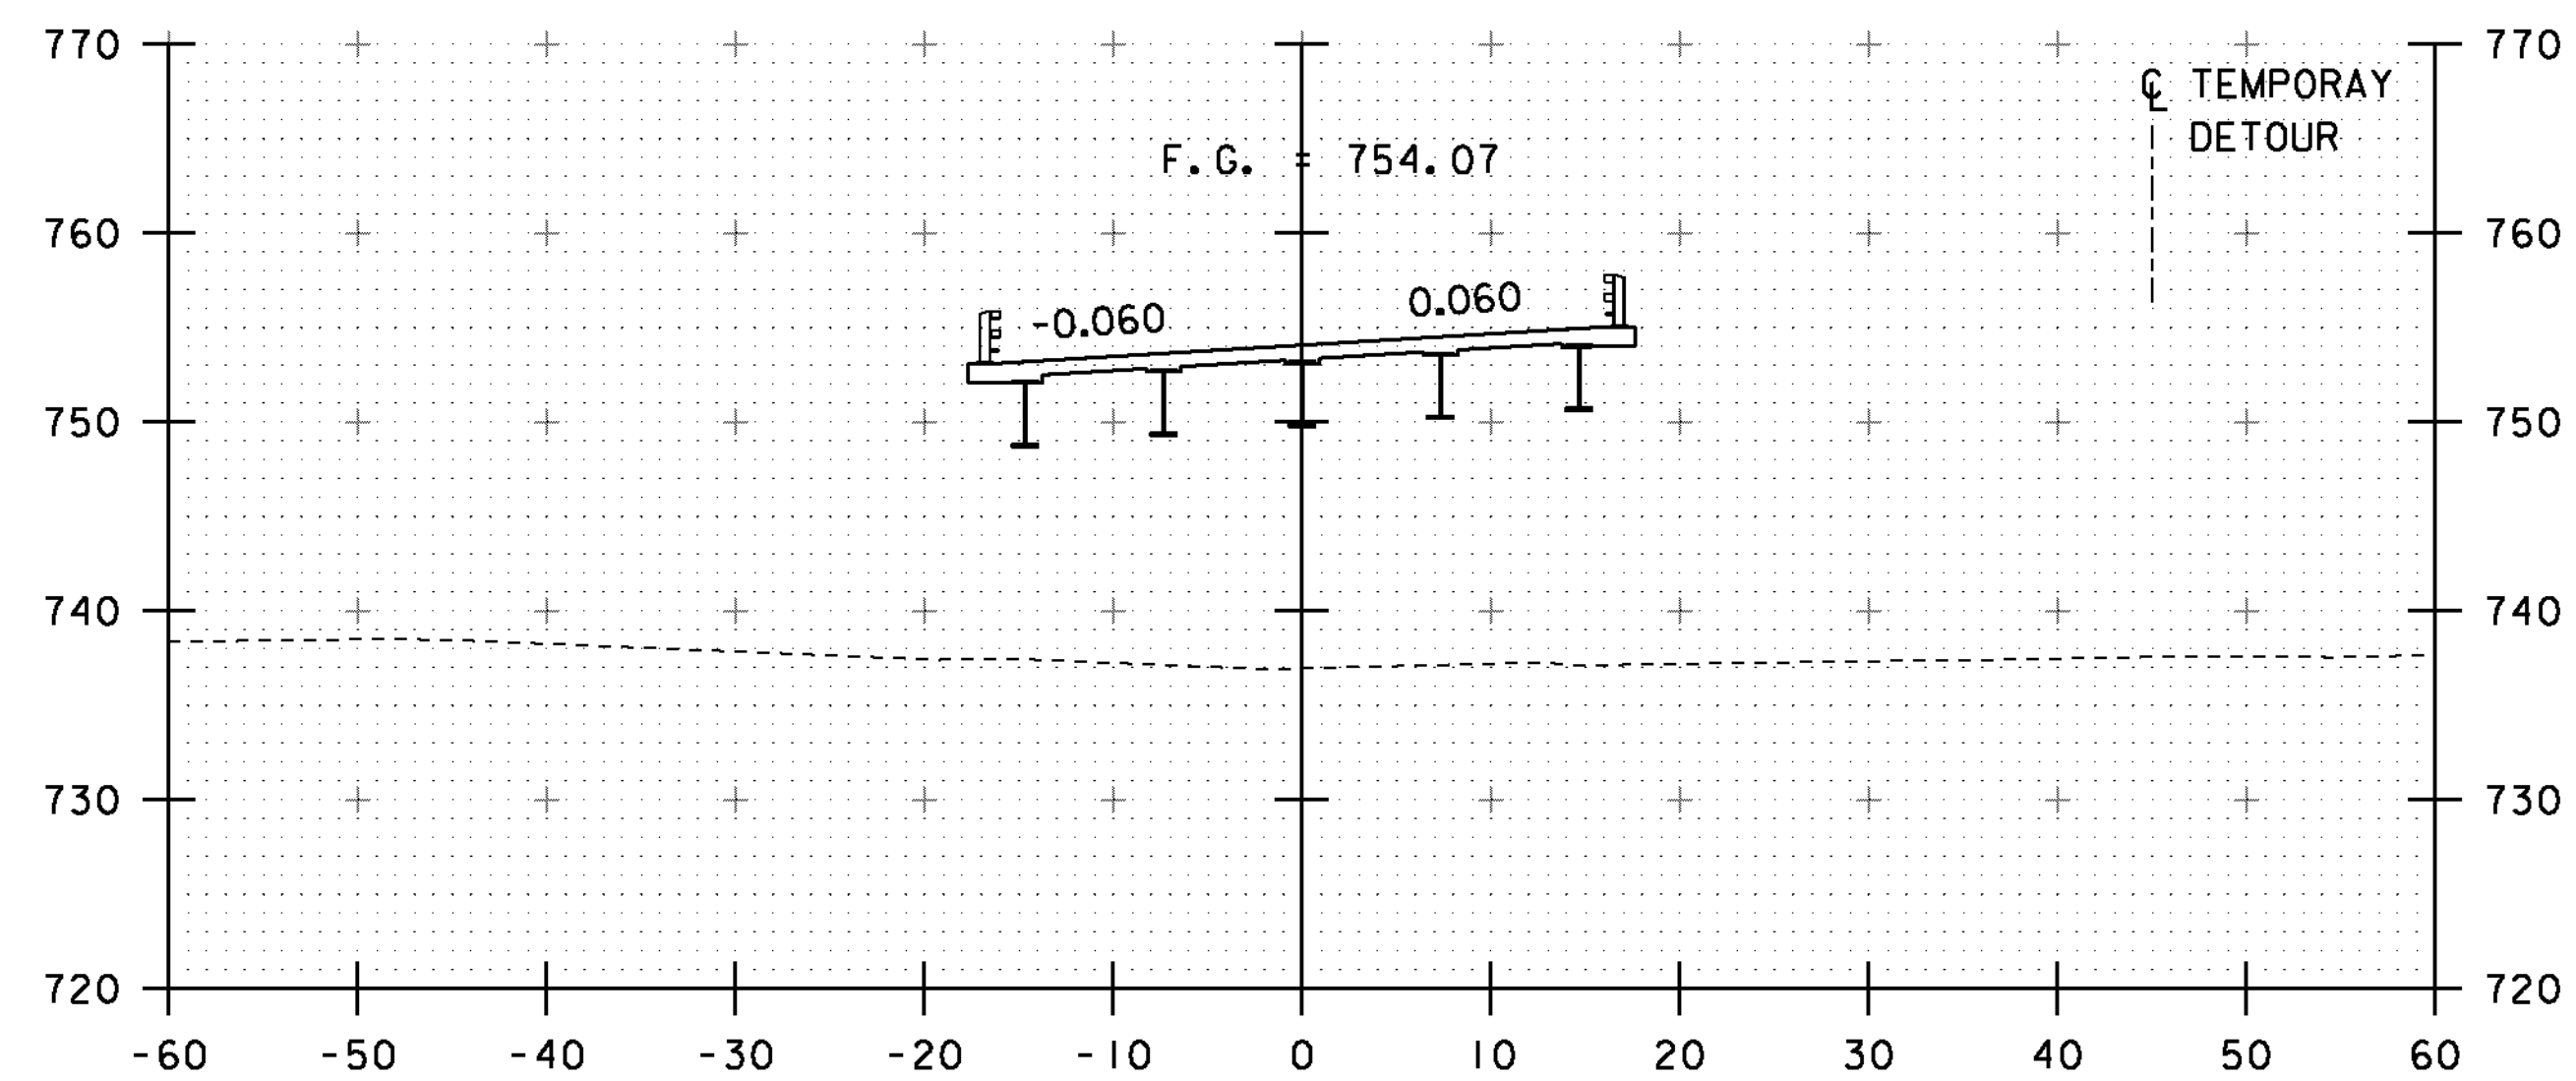

380+25

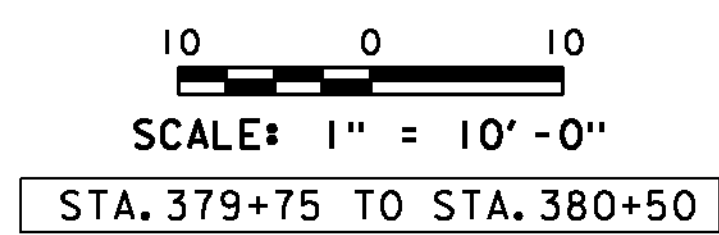

PROJECT NAME: ST. JOHNSBURY	PLOT DATE: 28-AUG-2012
PROJECT NUMBER: BRF 028-4(25)S	DRAWN BY: C. MOONEY
FILE NAME: s98b320xsl.dgn	CHECKED BY: C. CARLSON
PROJECT LEADER: C. CARLSON	SHEET 35 OF 62
DESIGNED BY: H. SALLS	
ROADWAY CROSS SECTIONS 5	