




381+50

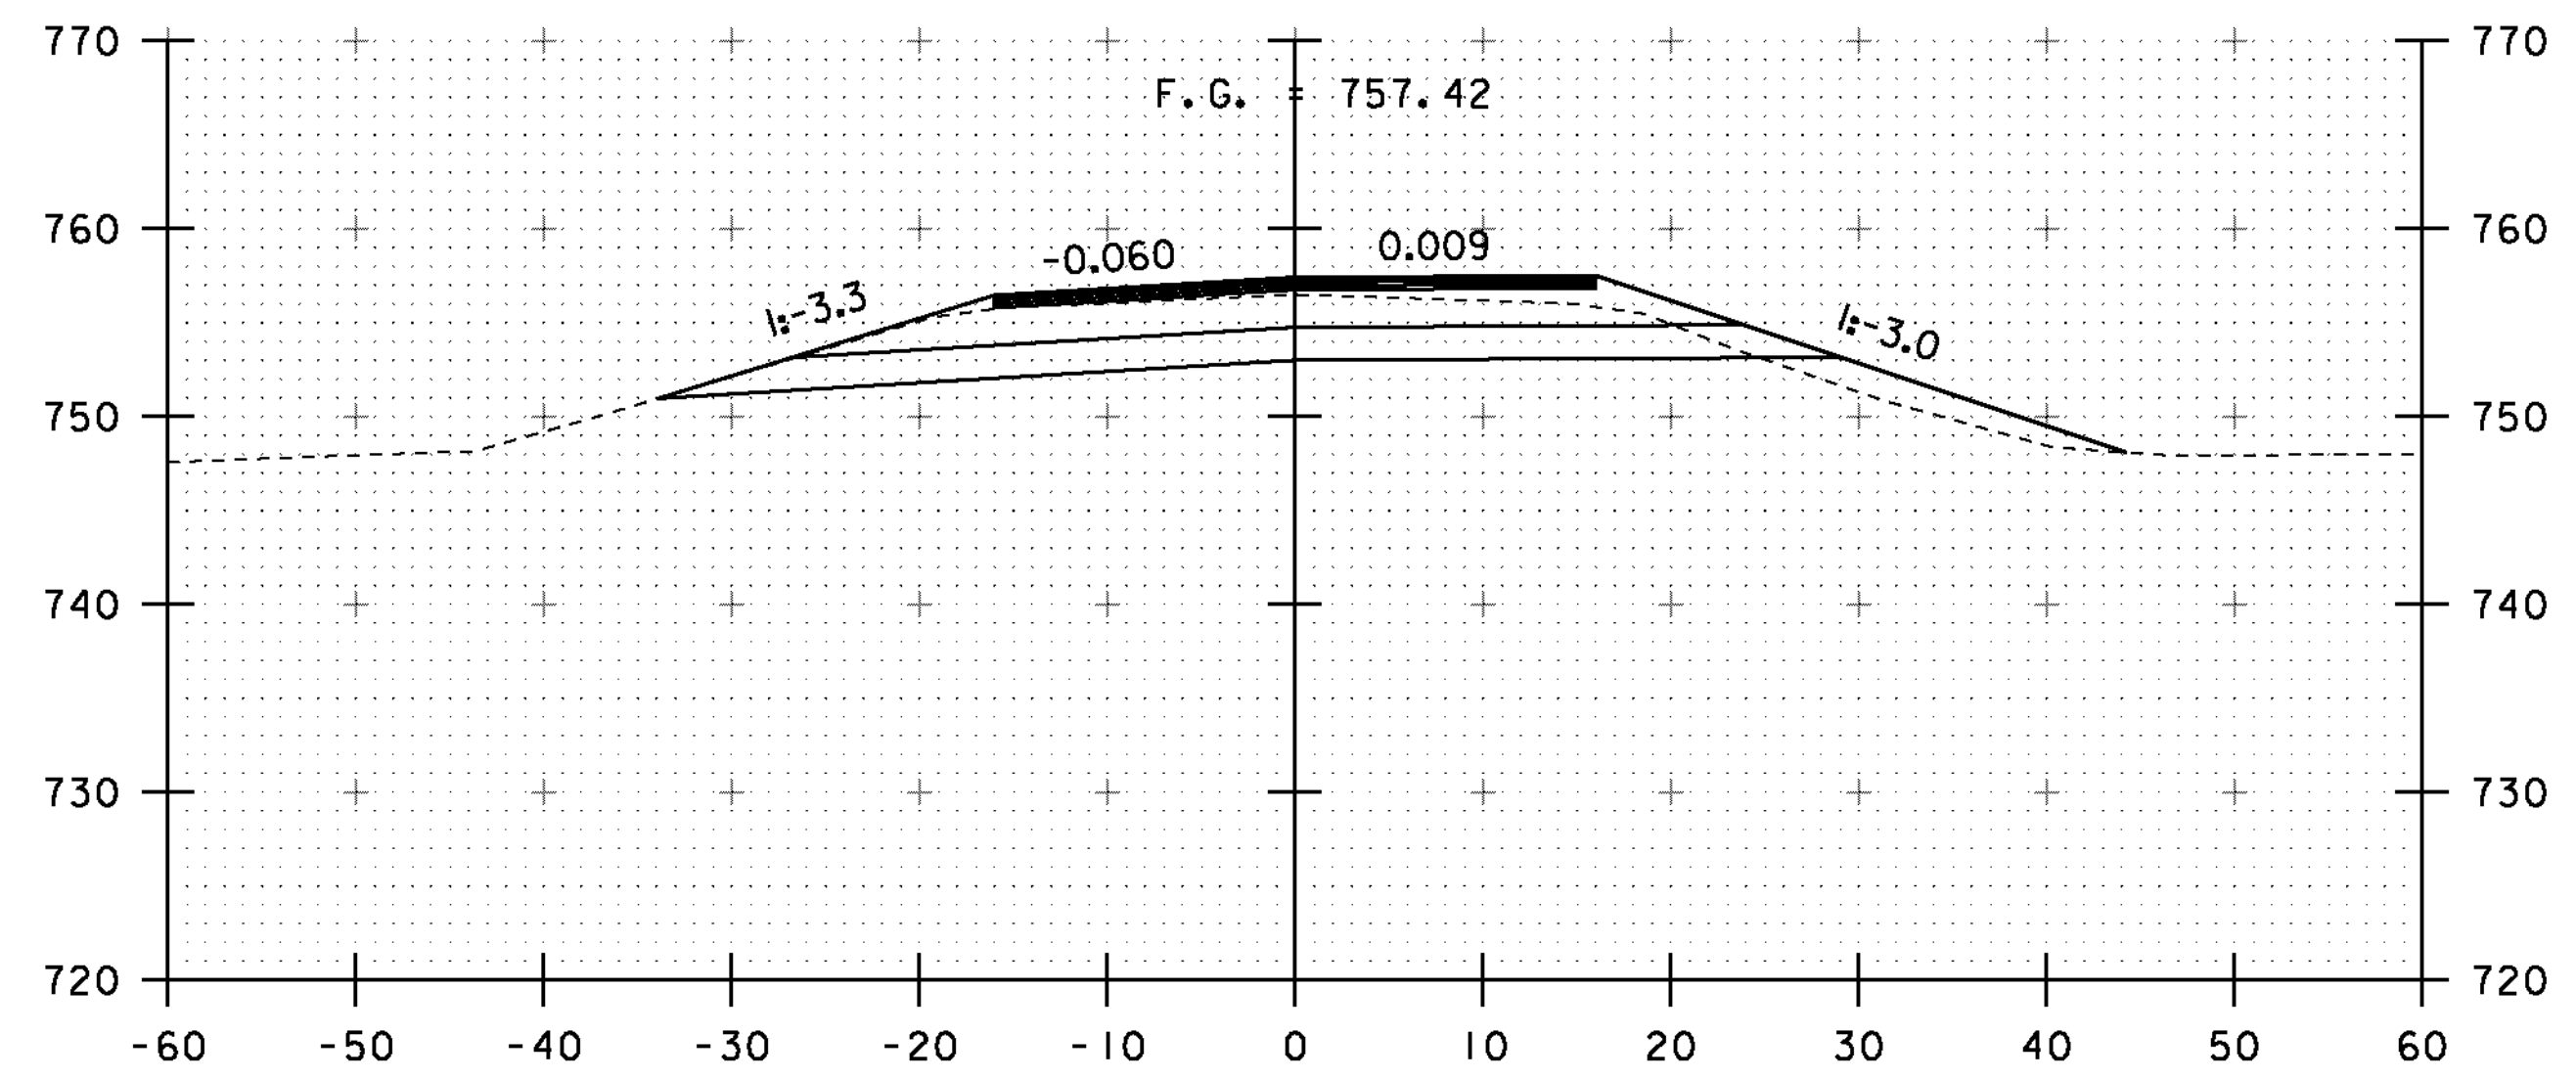


382+00

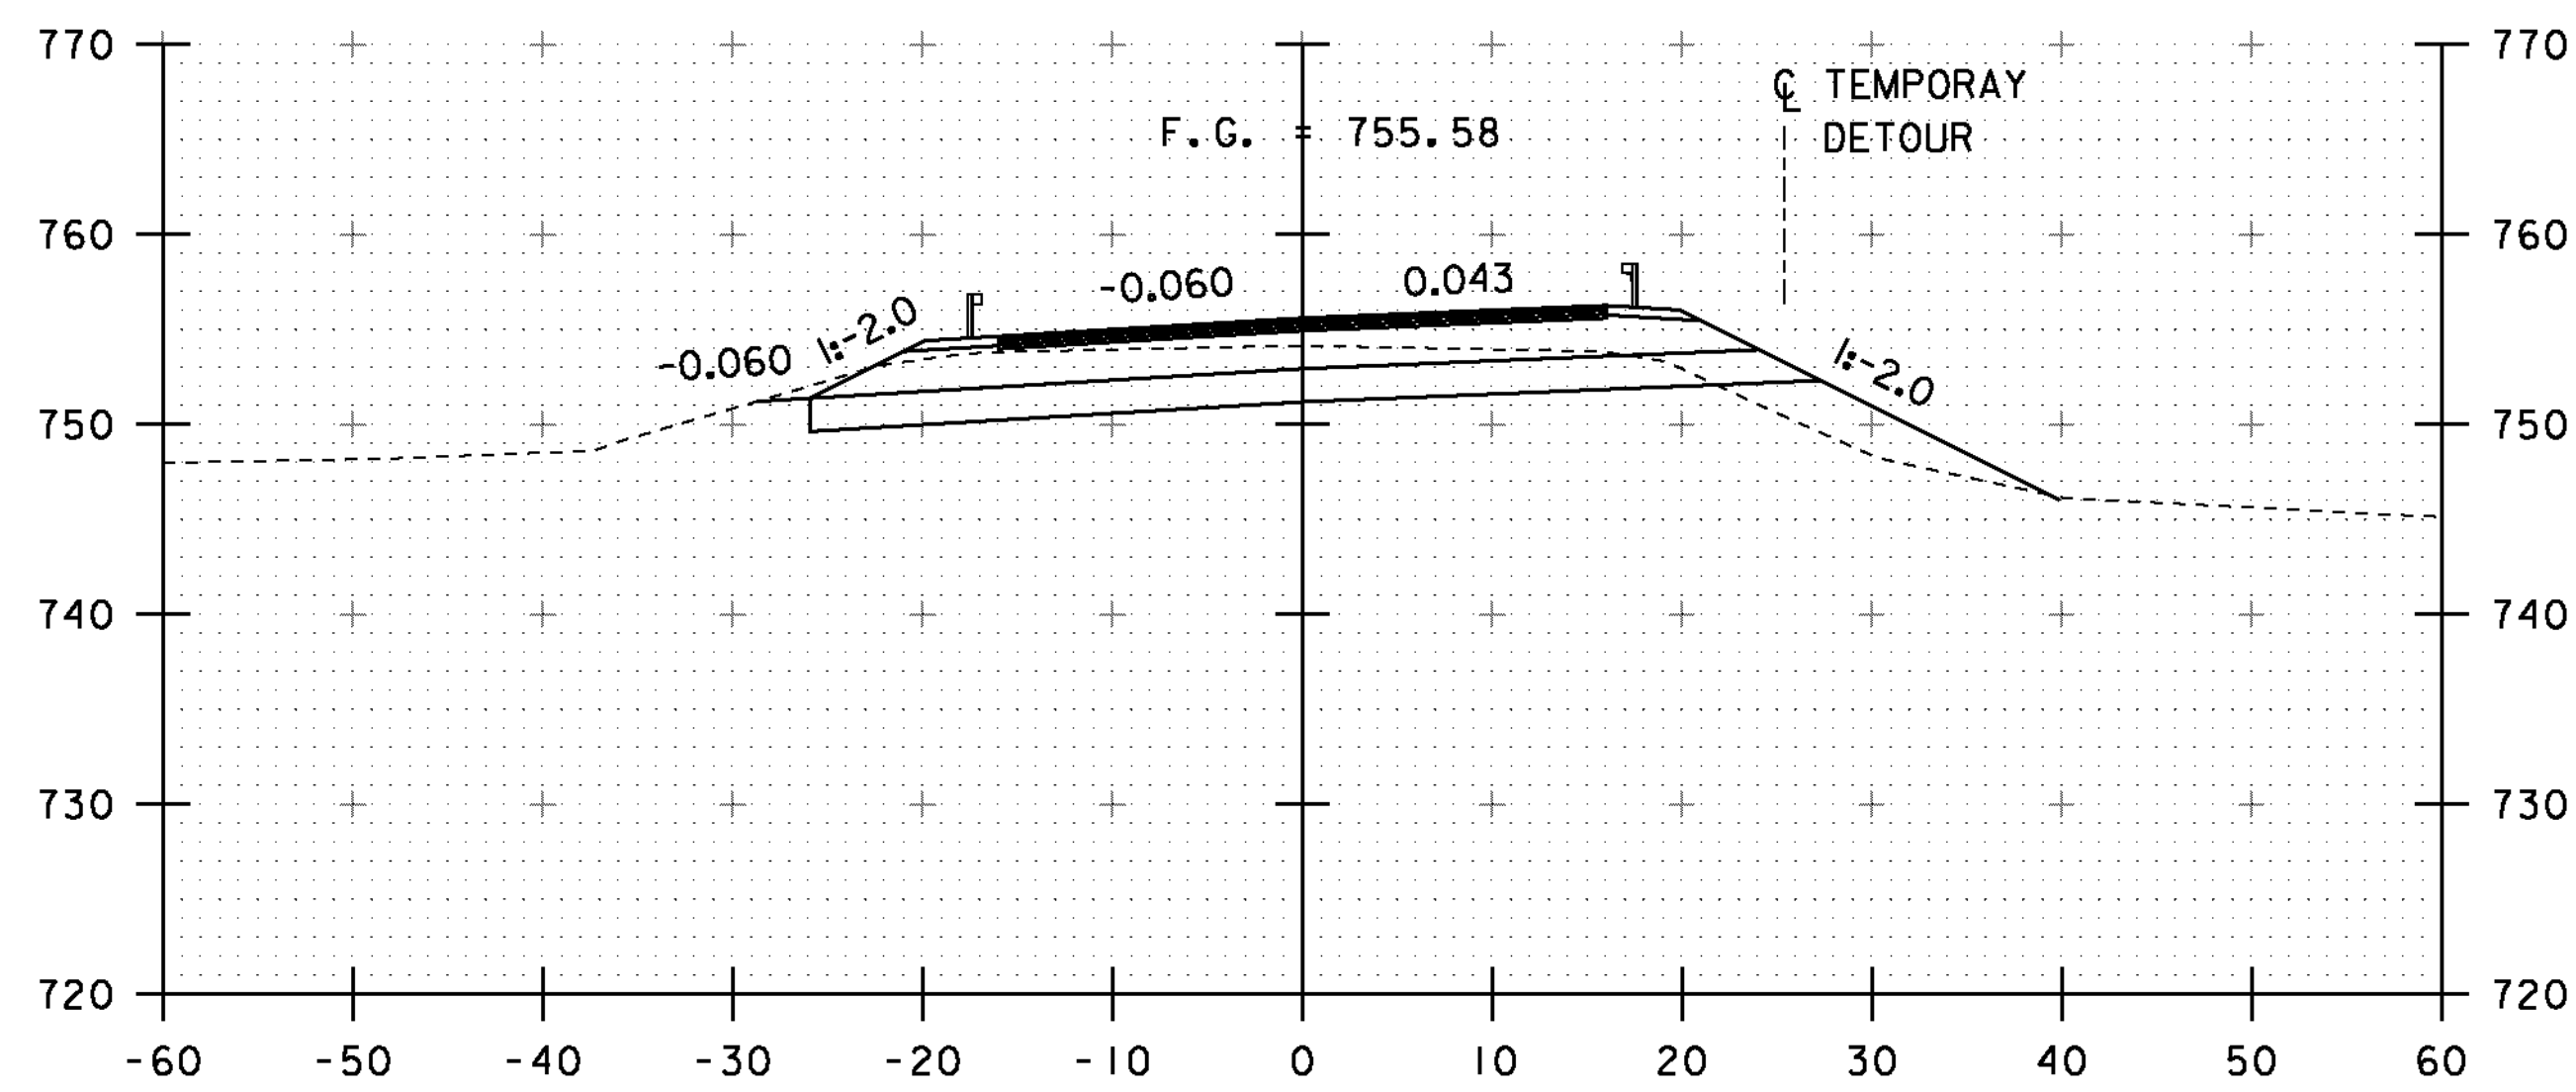

381+25

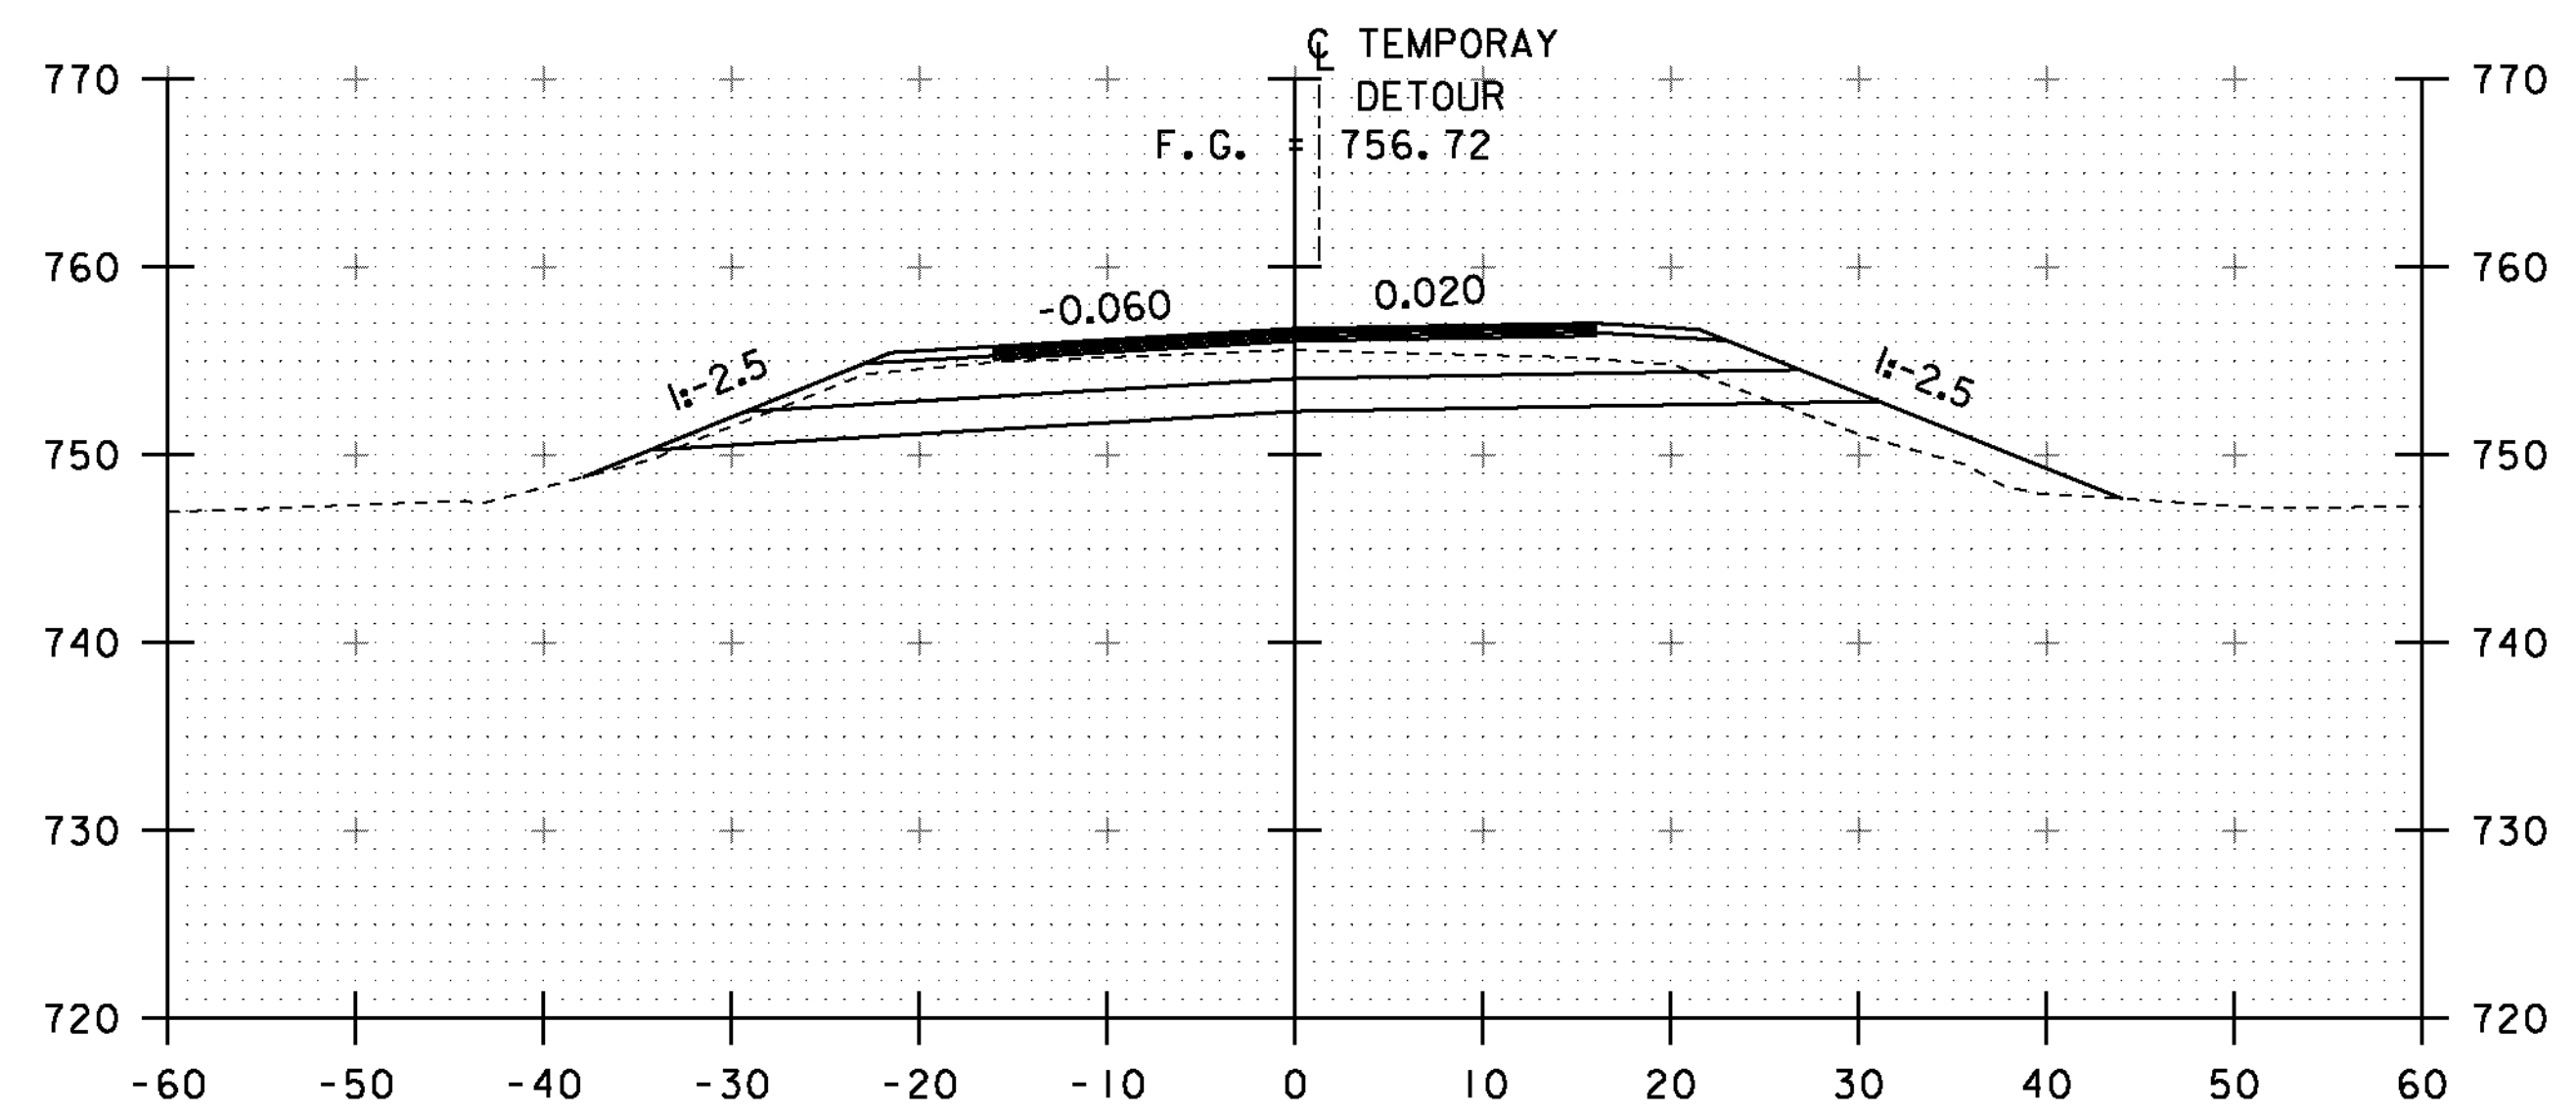

381+75

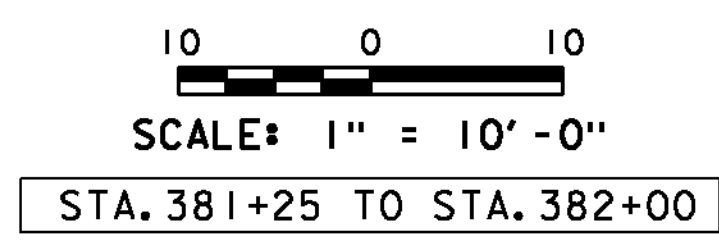

PROJECT NAME:	ST. JOHNSBURY	PLOT DATE:	28-AUG-2012
PROJECT NUMBER:	BRF 028-4(25)S	DRAWN BY:	C. MOONEY
FILE NAME:	s98b320xsl.dgn	DESIGNED BY:	H. SALLS
PROJECT LEADER:	C. CARLSON	ROADWAY CROSS SECTIONS	7
CHECKED BY:	C. CARLSON	SHEET	37 OF 62