




21+00

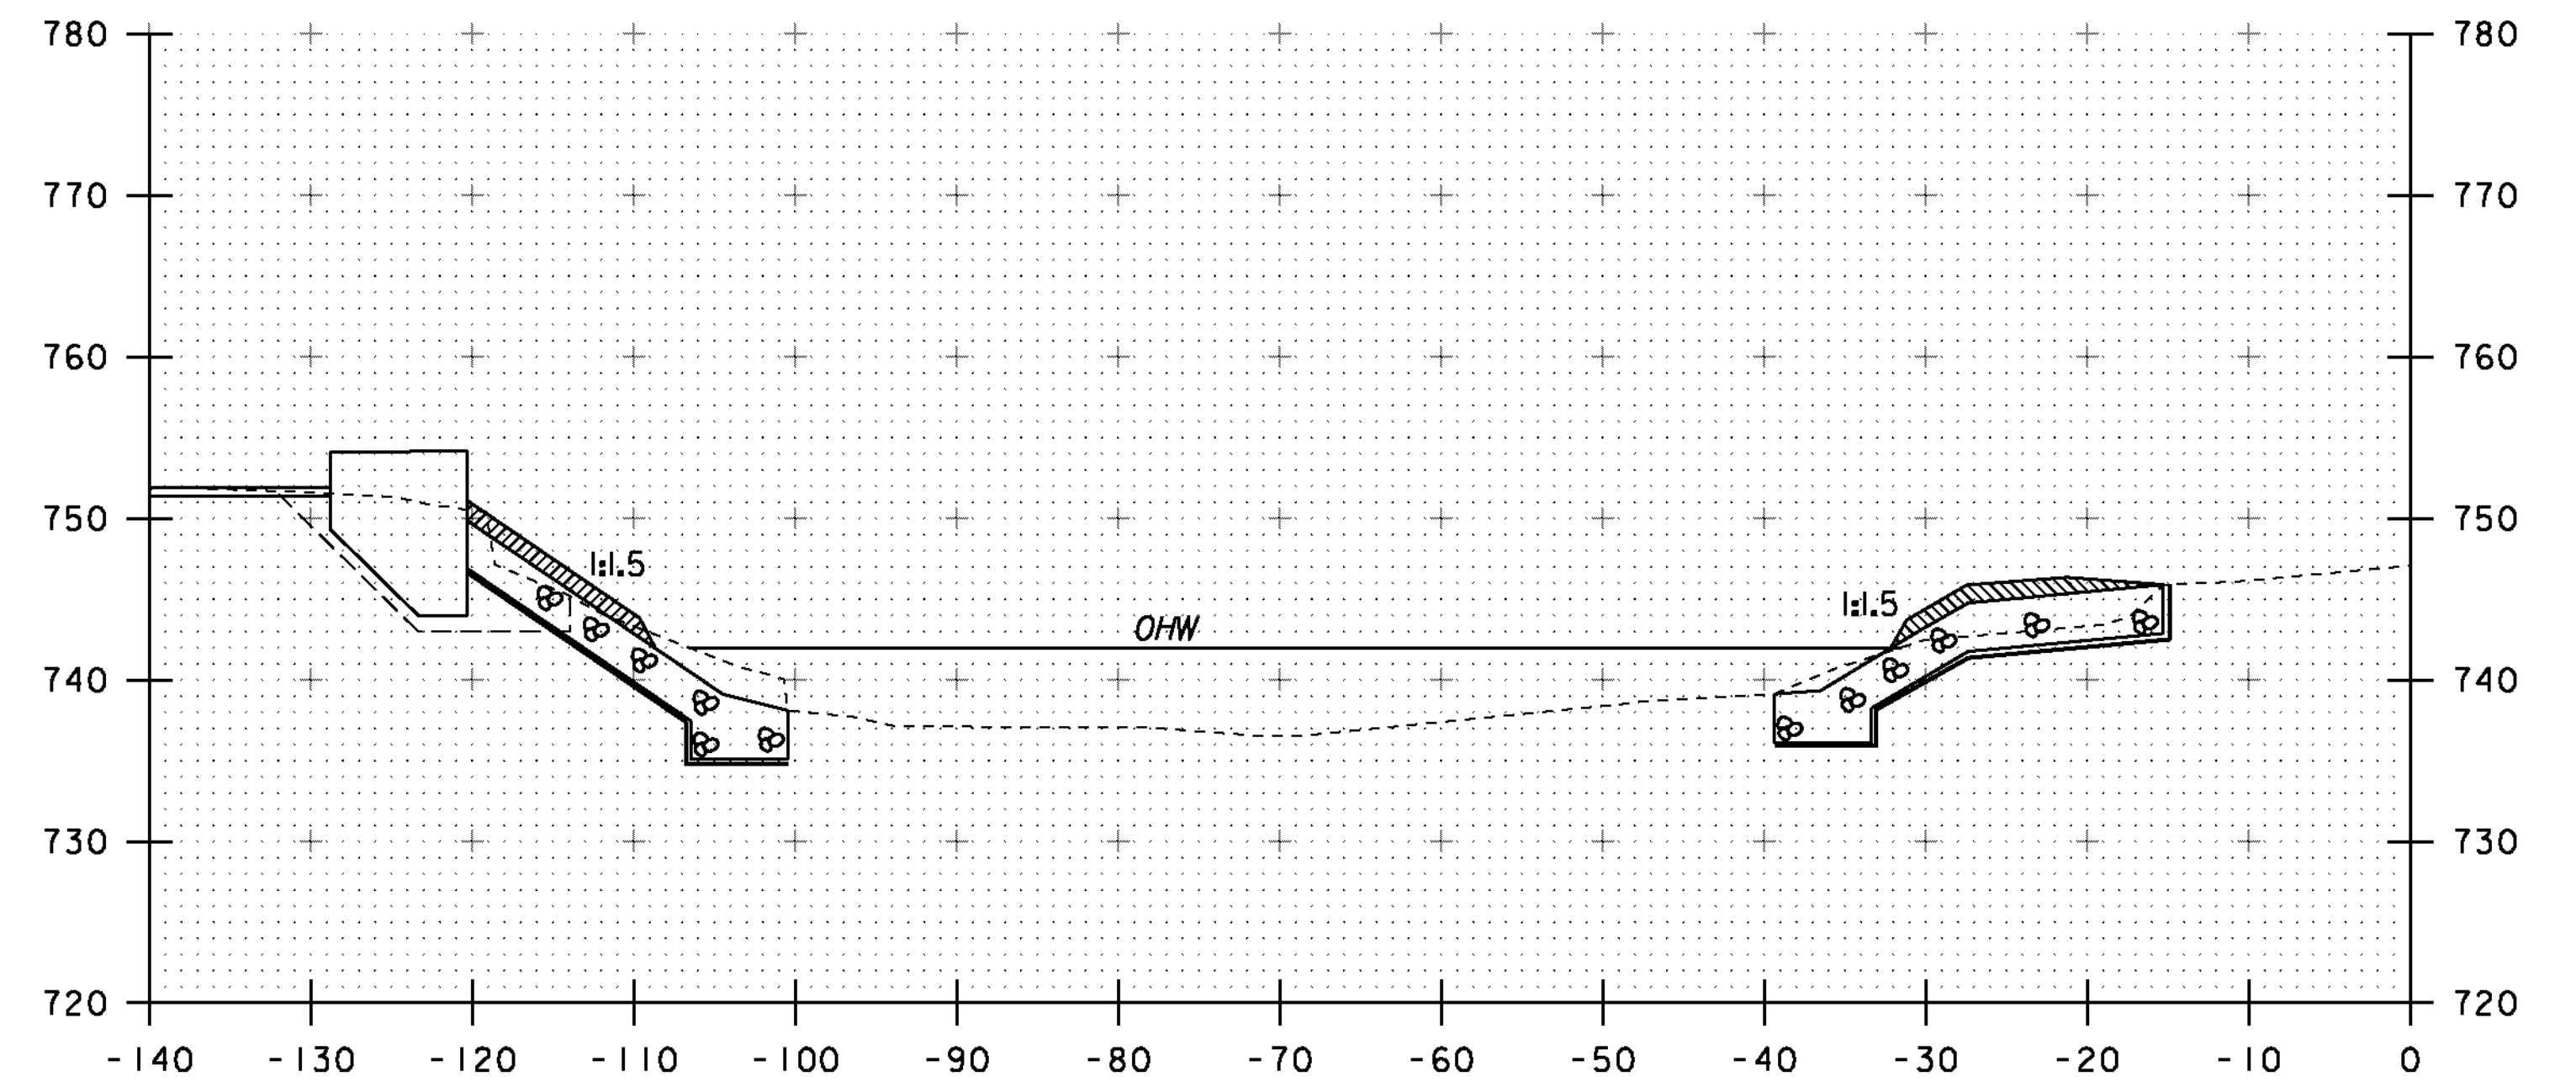

21+42

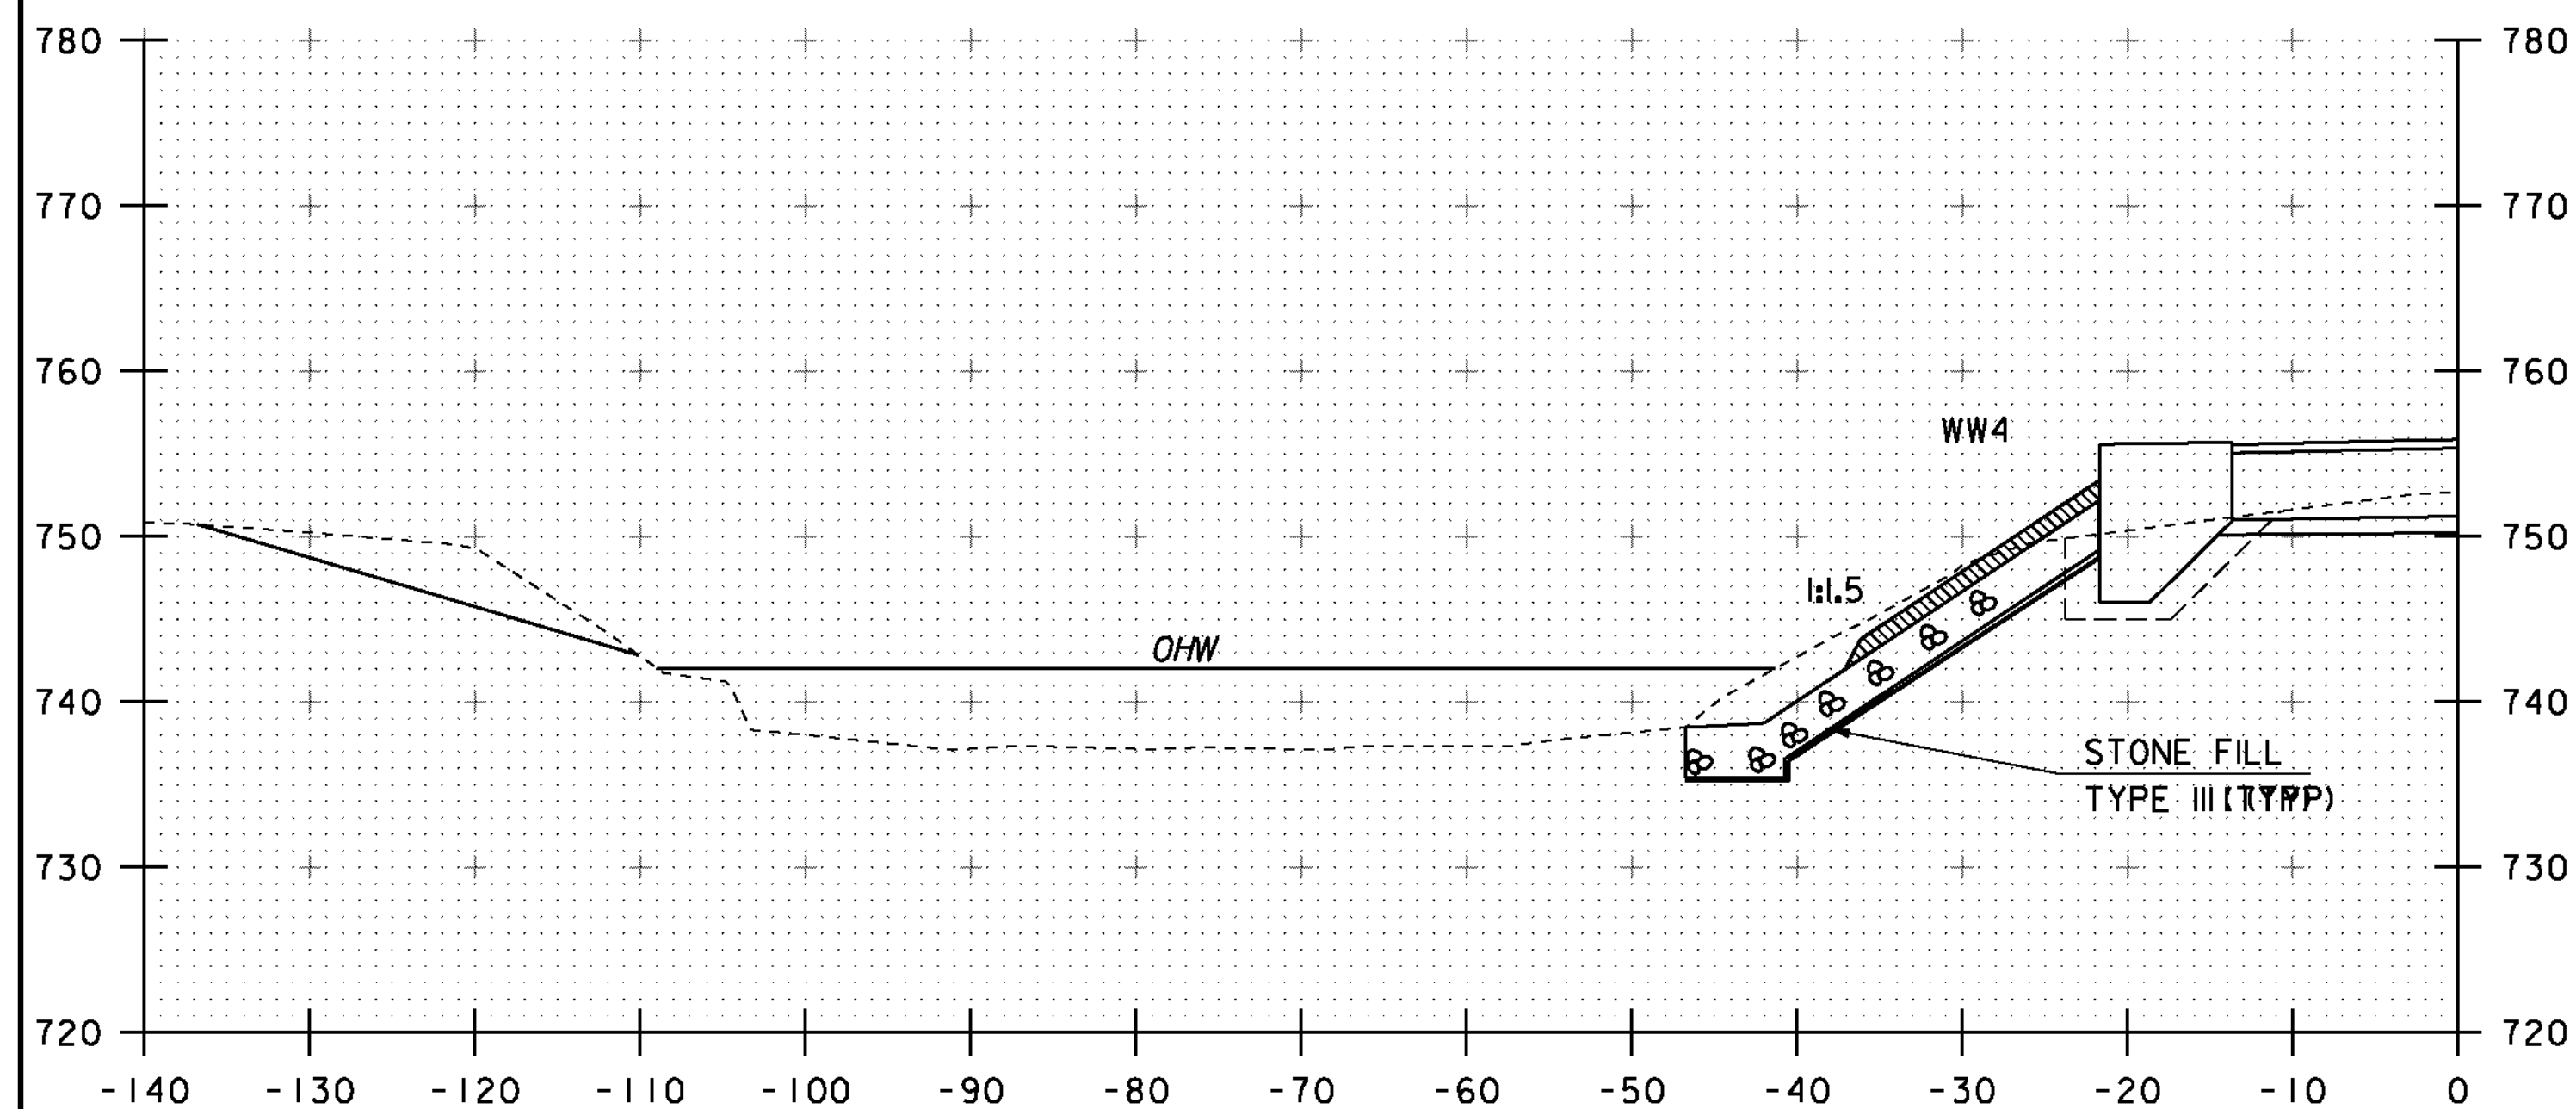

20+83

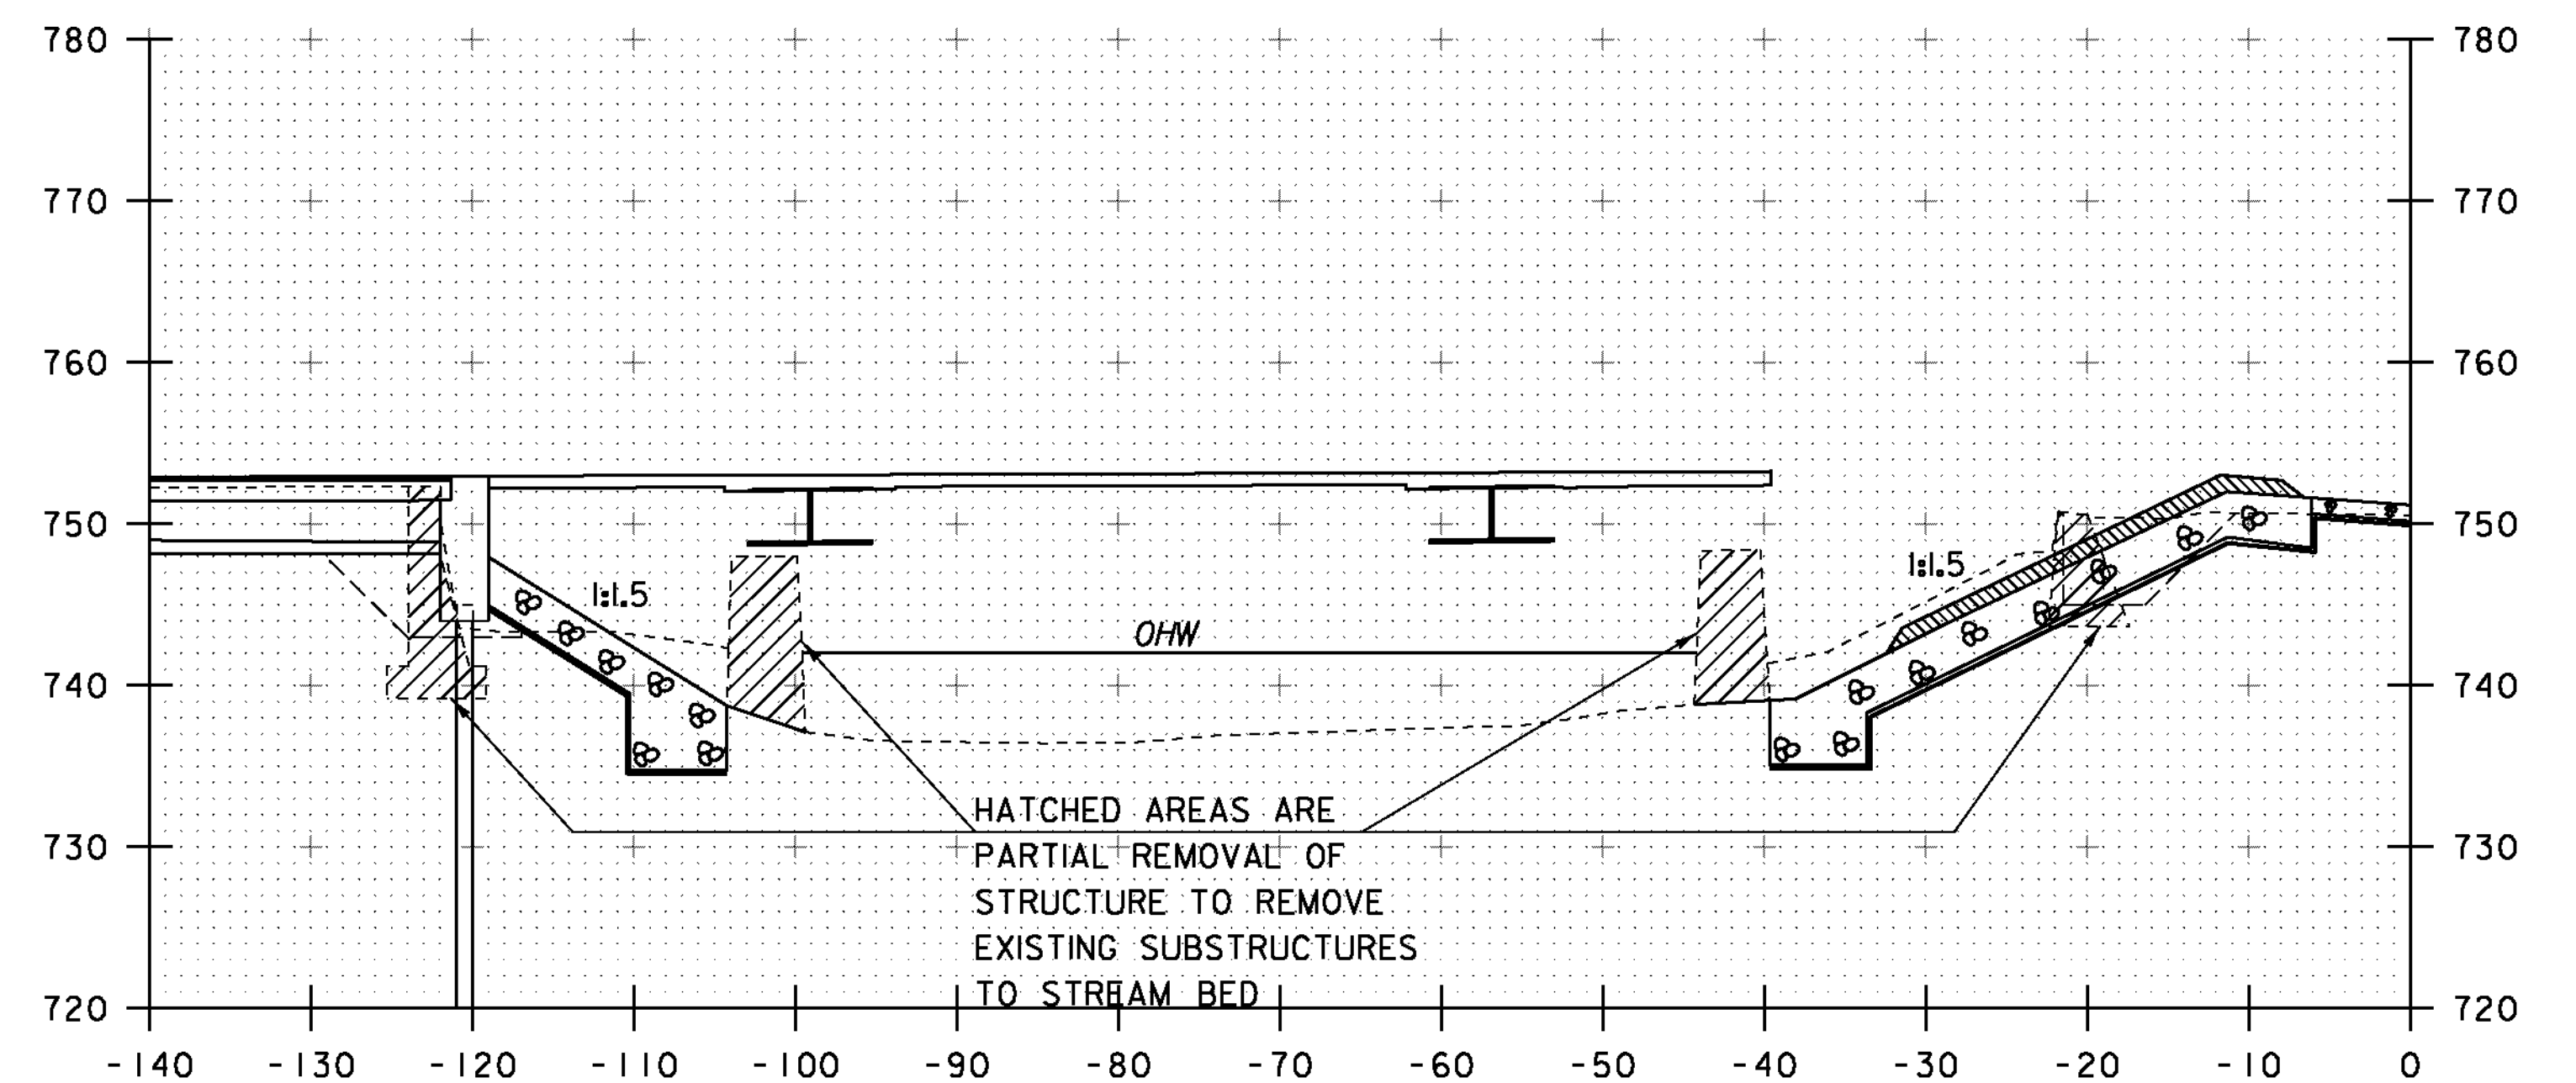

21+25

STA. 20+85.00 FAR LT  
 BEGIN UNCLASSIFIED CHANNEL EXCAVATION  
 GEOTEXTILE UNDER STONE FILL  
 STONE FILL, TYPE III  
 GRUBBING MATERIAL

10 0 10  
 SCALE: 1" = 10'-0"

STA. 20+83 TO STA. 21+42

PROJECT NAME: ST. JOHNSBURY  
 PROJECT NUMBER: BRF 028-4(25)S

FILE NAME: s98b320xsl.dgn  
 PROJECT LEADER: C. CARLSON  
 DESIGNED BY: H. SALLS  
 CHANNEL CROSS SECTIONS 2

PLOT DATE: 28-AUG-2012  
 DRAWN BY: C. MOONEY  
 CHECKED BY: C. CARLSON  
 SHEET 42 OF 62