




21+75

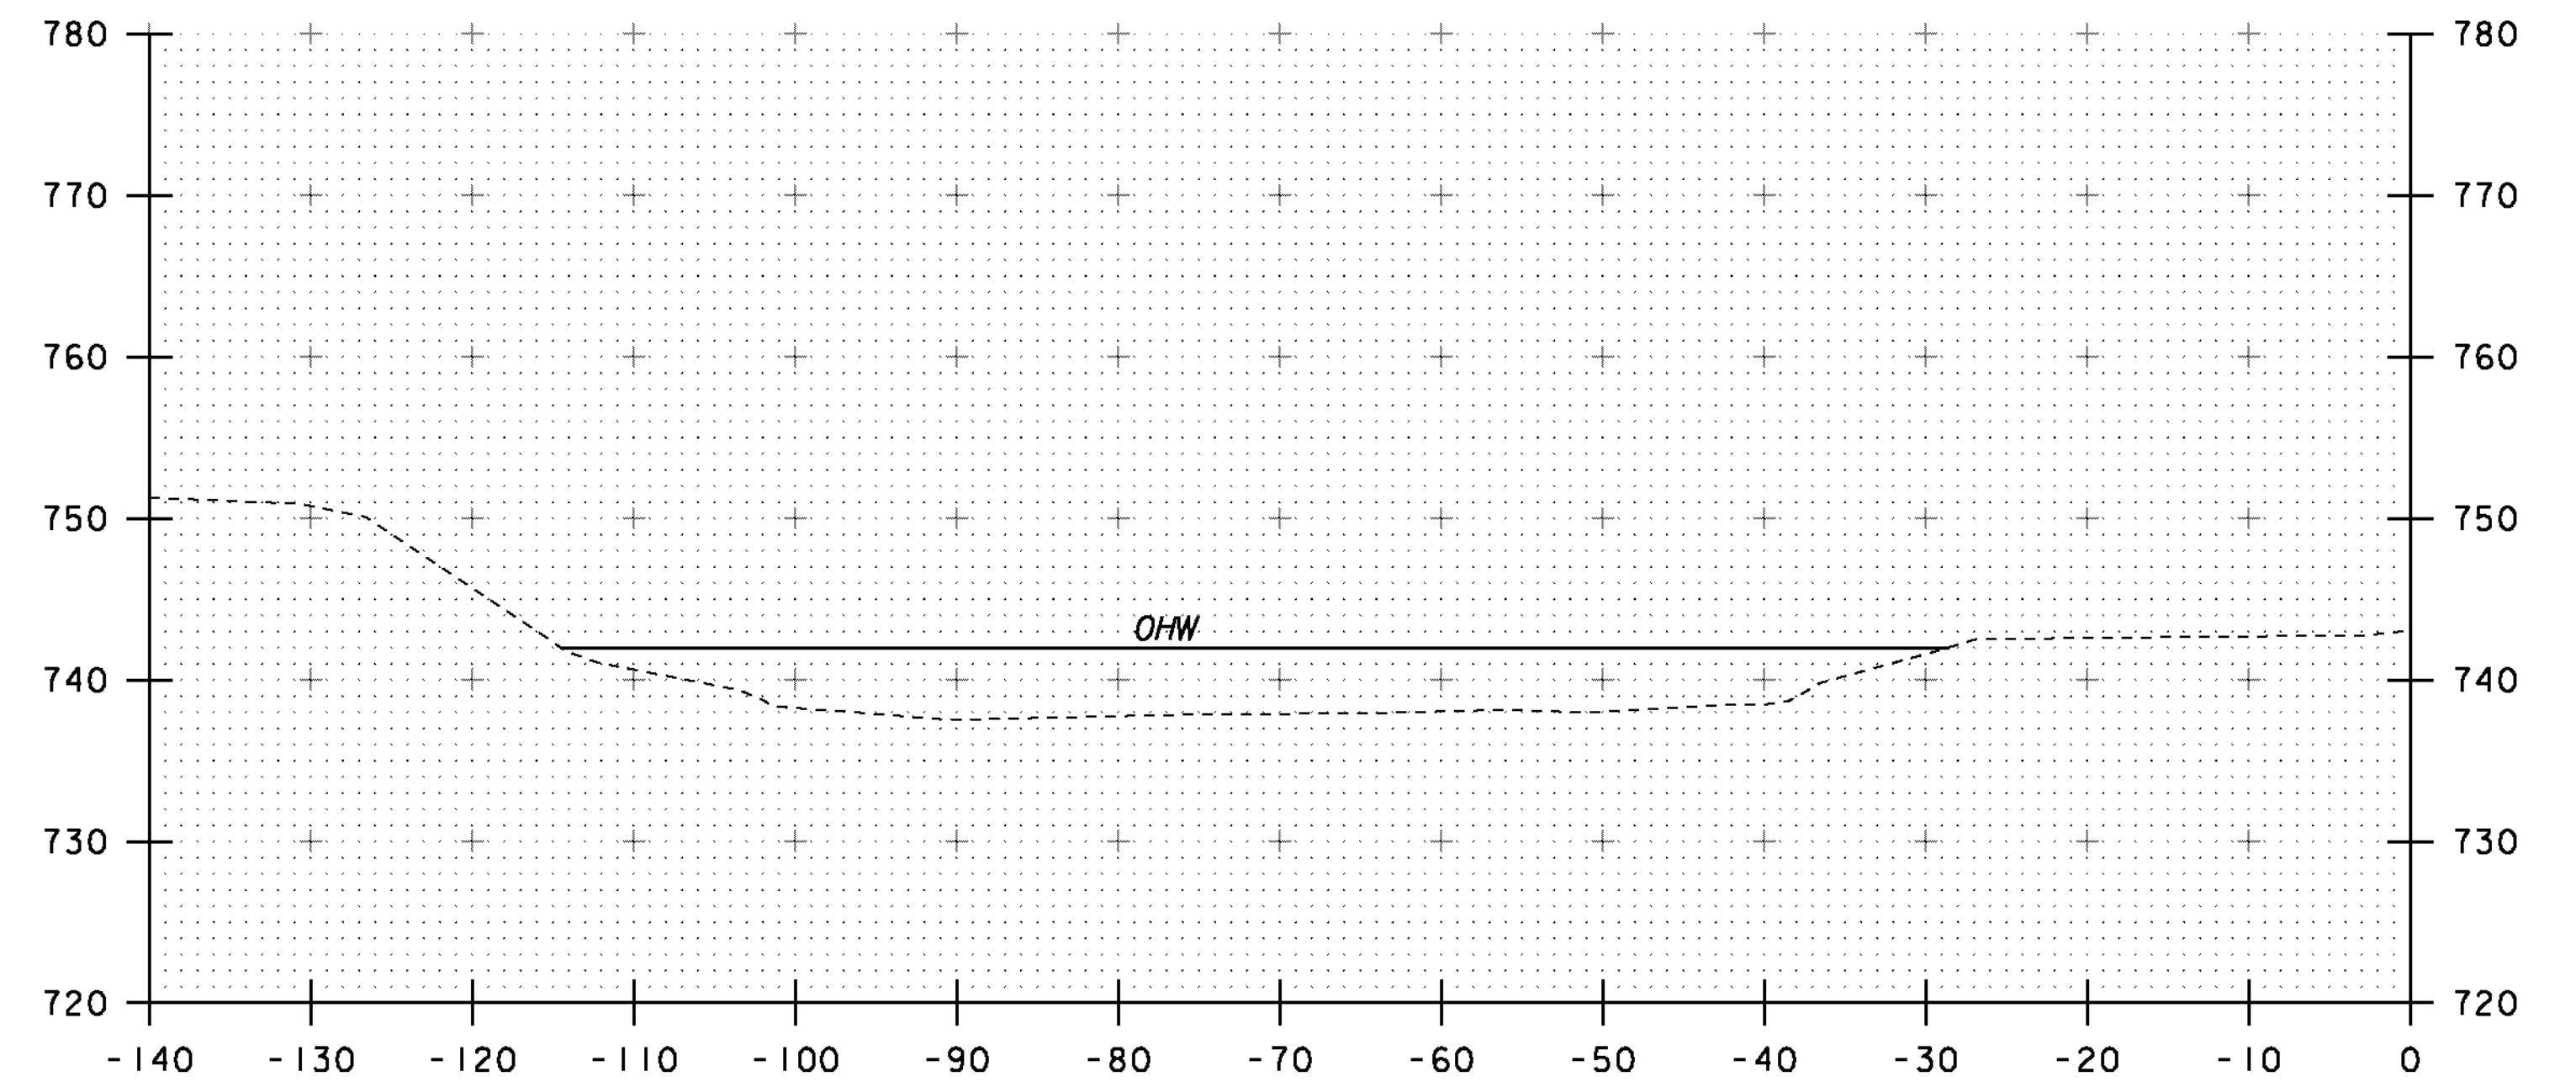

22+25

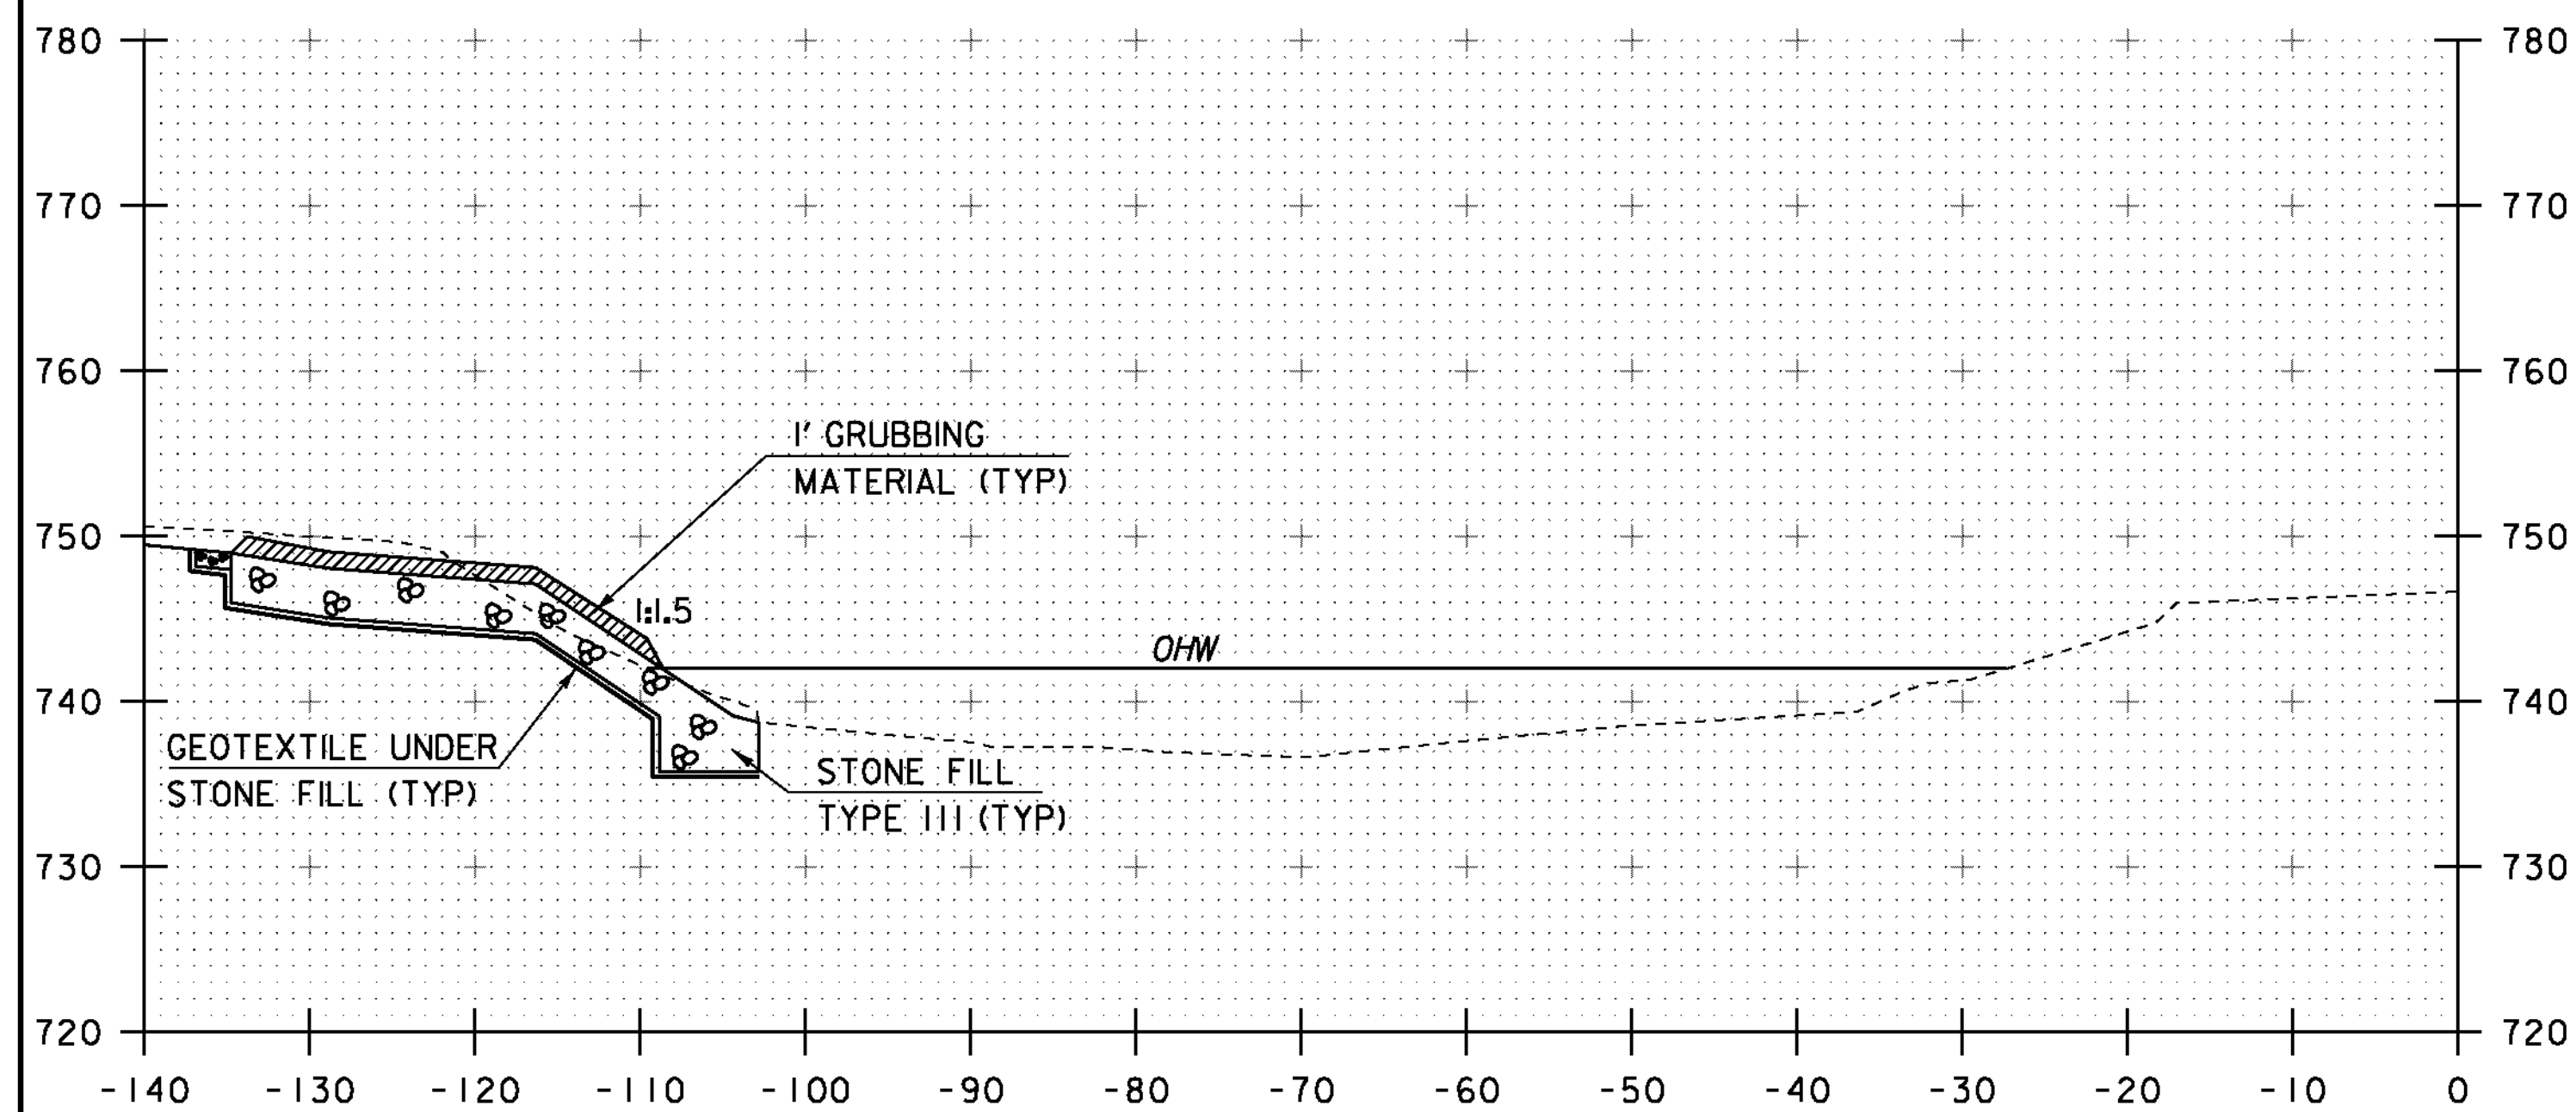


21+50

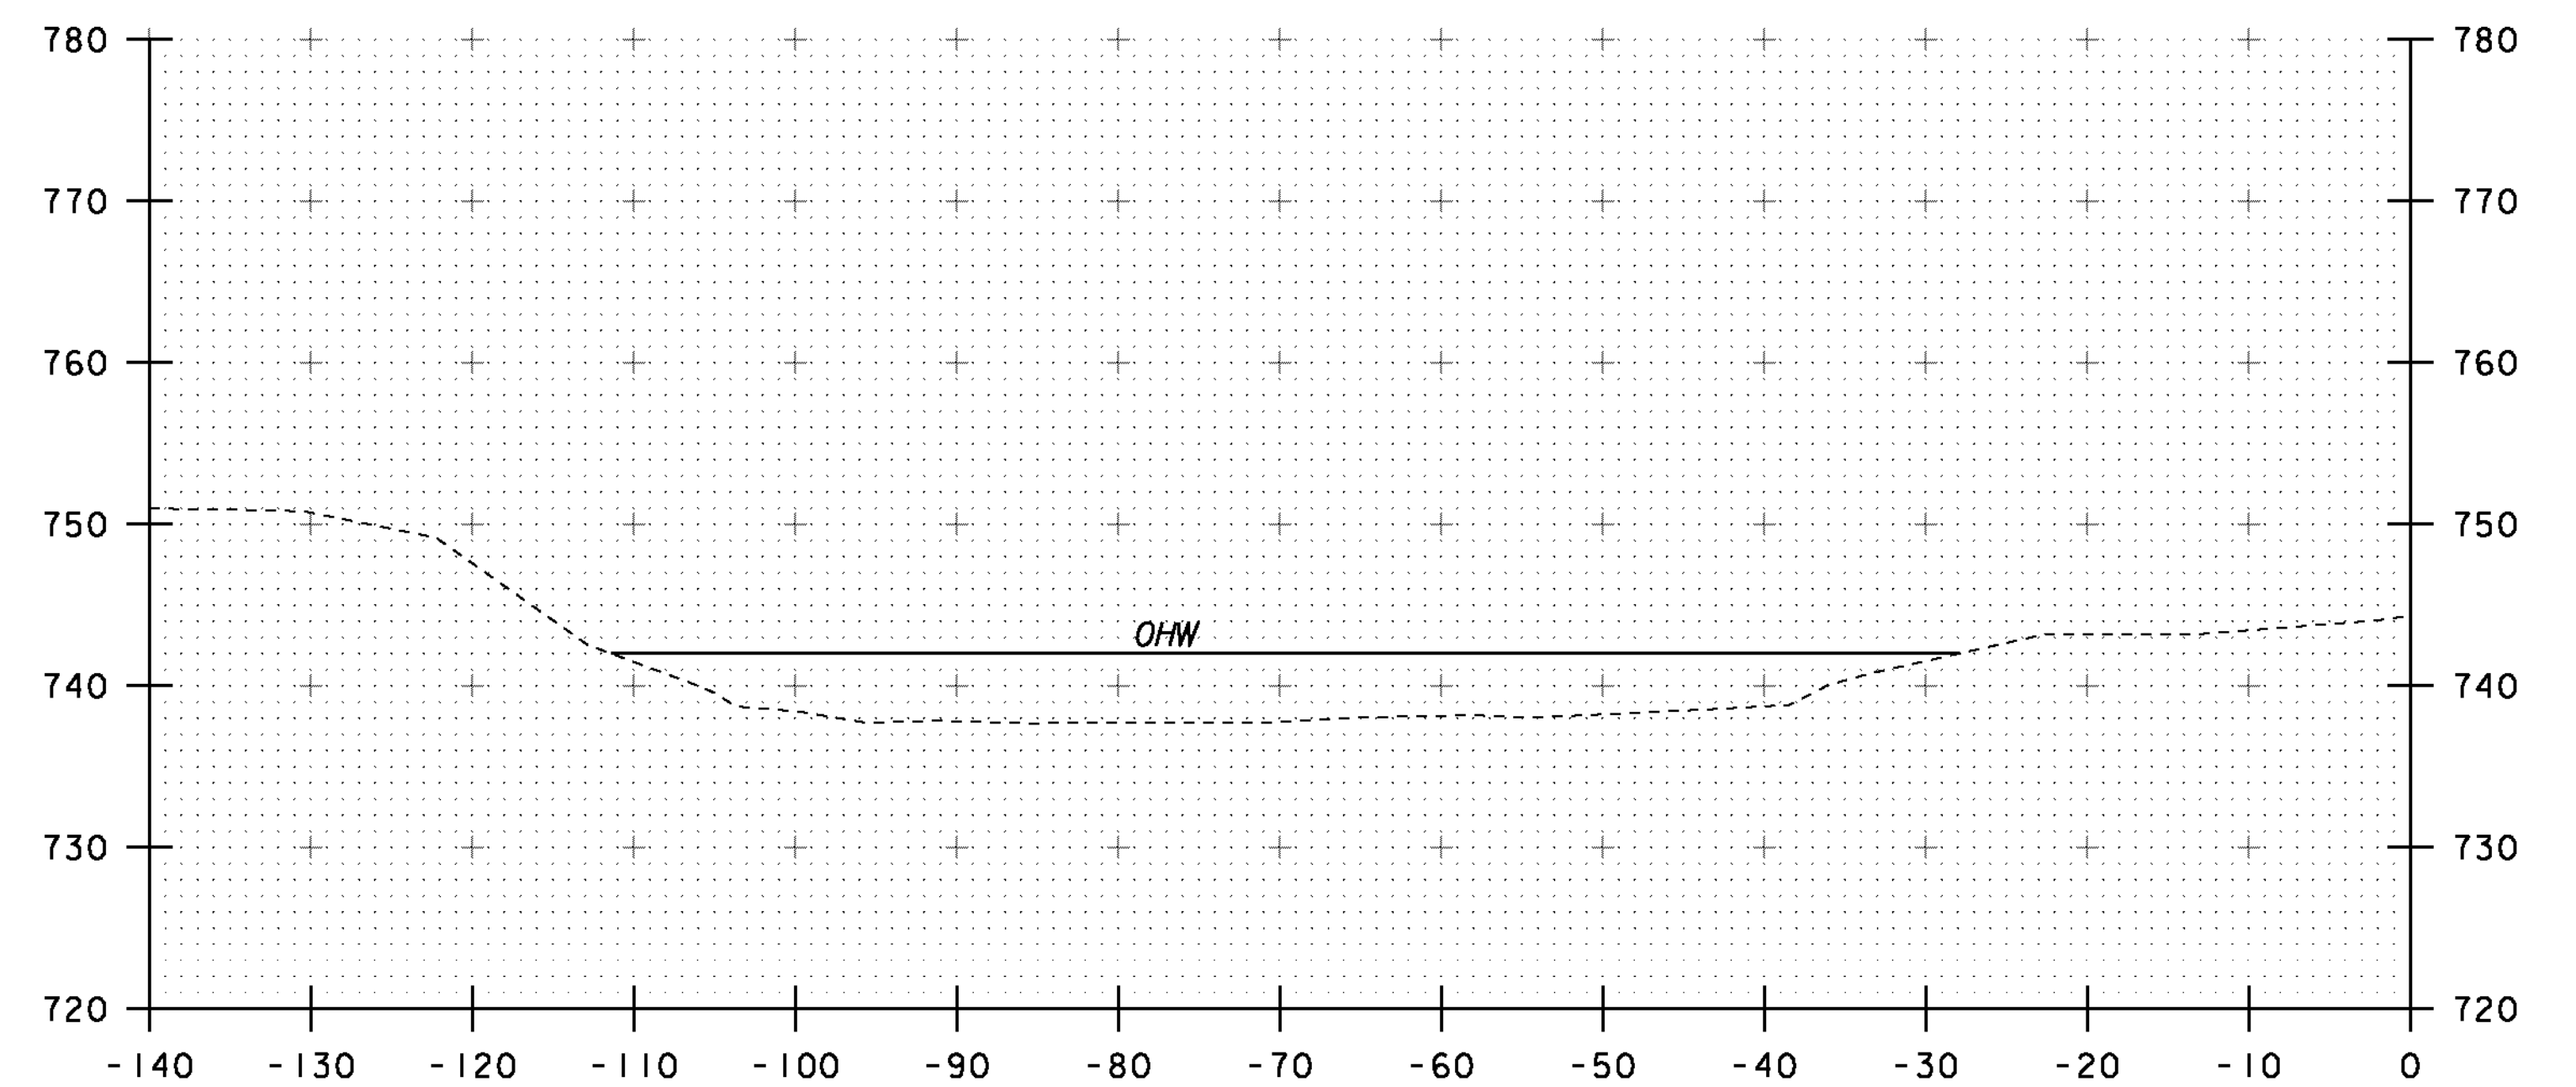

22+00

STA. 21+67 FAR LT
 END UNCLASSIFIED CHANNEL EXCAVATION
 GEOTEXTILE UNDER STONE FILL
 STONE FILL TYPE III
 GRUBBING MATERIAL

STA. 21+52 LT
 END UNCLASSIFIED CHANNEL EXCAVATION
 GEOTEXTILE UNDER STONE FILL
 STONE FILL TYPE III
 GRUBBING MATERIAL

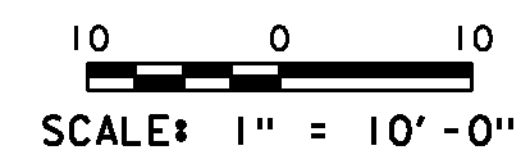

STA. 21+50 TO STA. 22+25

PROJECT NAME: ST. JOHNSBURY	PLOT DATE: 28-AUG-2012
PROJECT NUMBER: BRF 028-4(25)S	DRAWN BY: C. MOONEY
FILE NAME: s98b320xsl.dgn	CHECKED BY: C. CARLSON
PROJECT LEADER: C. CARLSON	SHEET 43 OF 62
DESIGNED BY: H. SALLS	
CHANNEL CROSS SECTIONS 3	