


STA. 30+15.96  
BEGIN DRIVE 1

30+16

30+50

30+00

30+25

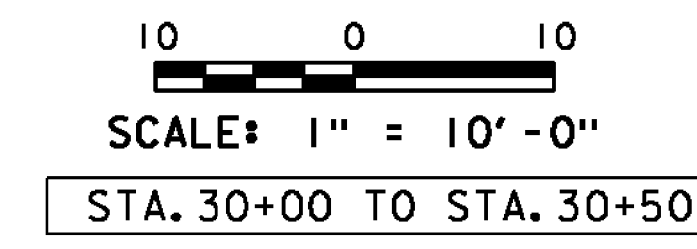

PROJECT NAME: ST. JOHNSBURY	
PROJECT NUMBER: BRF 028-4(25)S	
FILE NAME: s98b320xsl.dgn	PLOT DATE: 28-AUG-2012
PROJECT LEADER: C. CARLSON	DRAWN BY: C. MOONEY
DESIGNED BY: H. SALLS	CHECKED BY: C. CARLSON
DRIVE 1 CROSS SECTIONS 1	SHEET 45 OF 62