



STA. 40+16.01  
BEGIN DRIVE 2


40+16

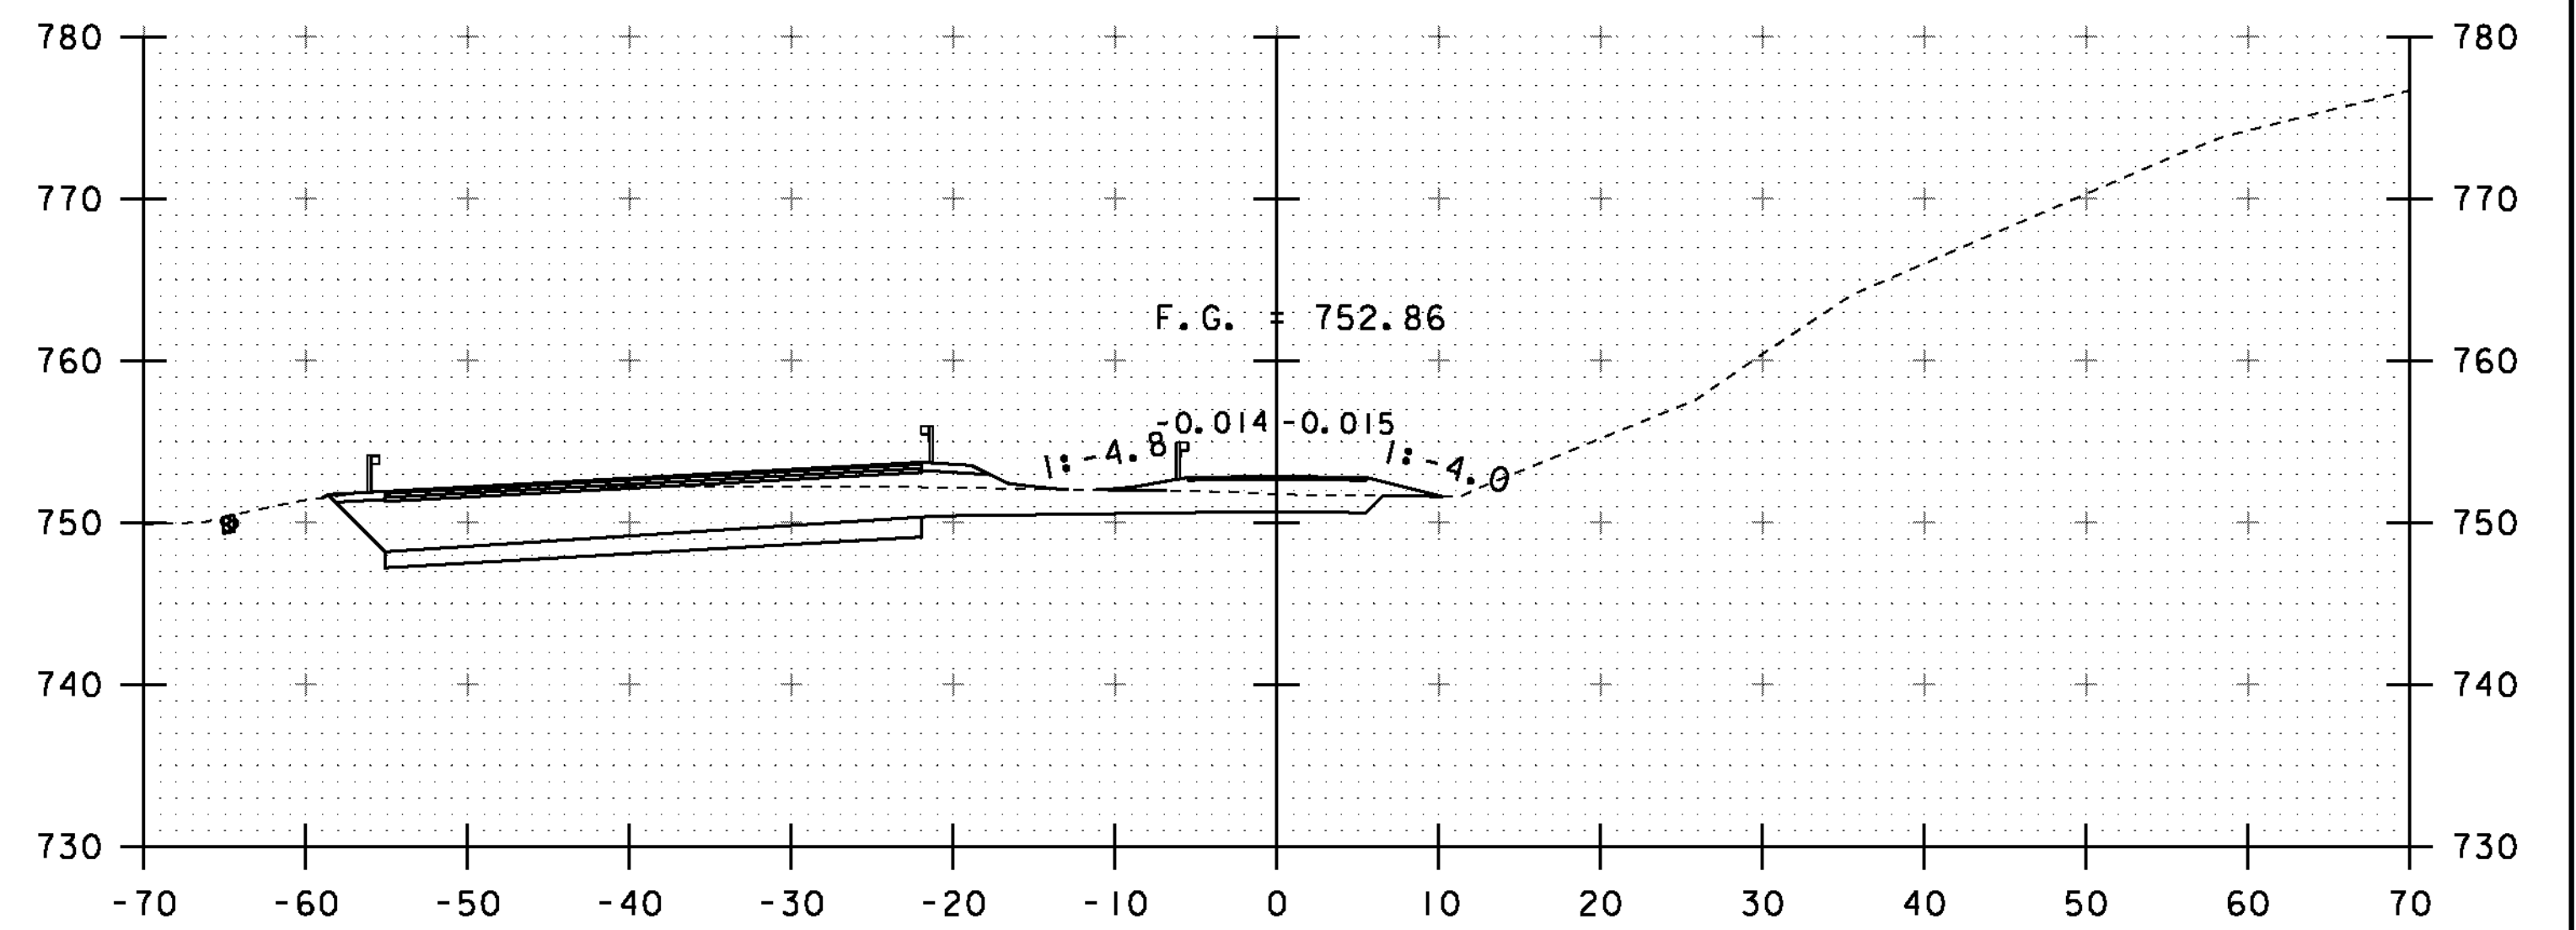


40+50

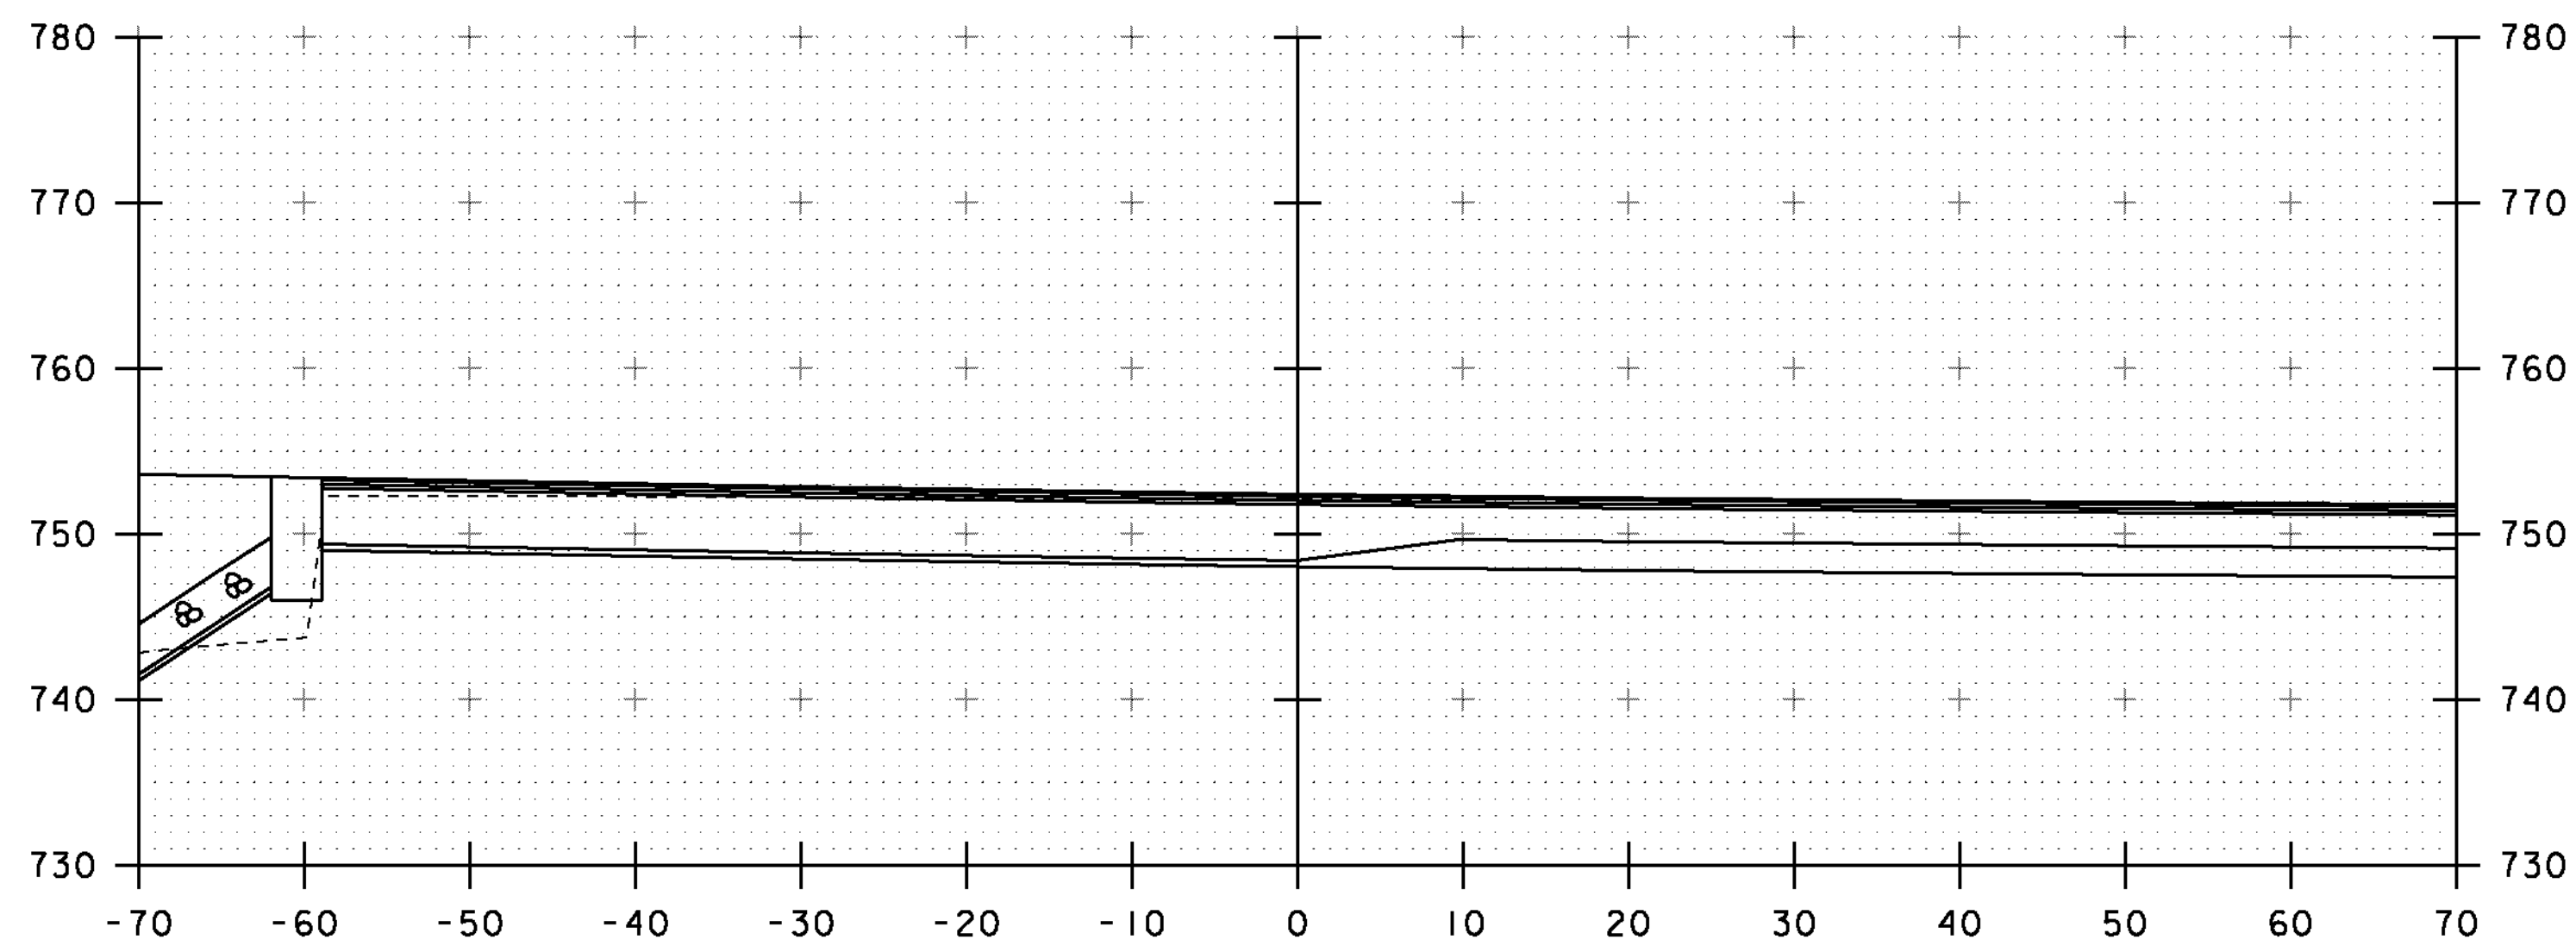

40+00

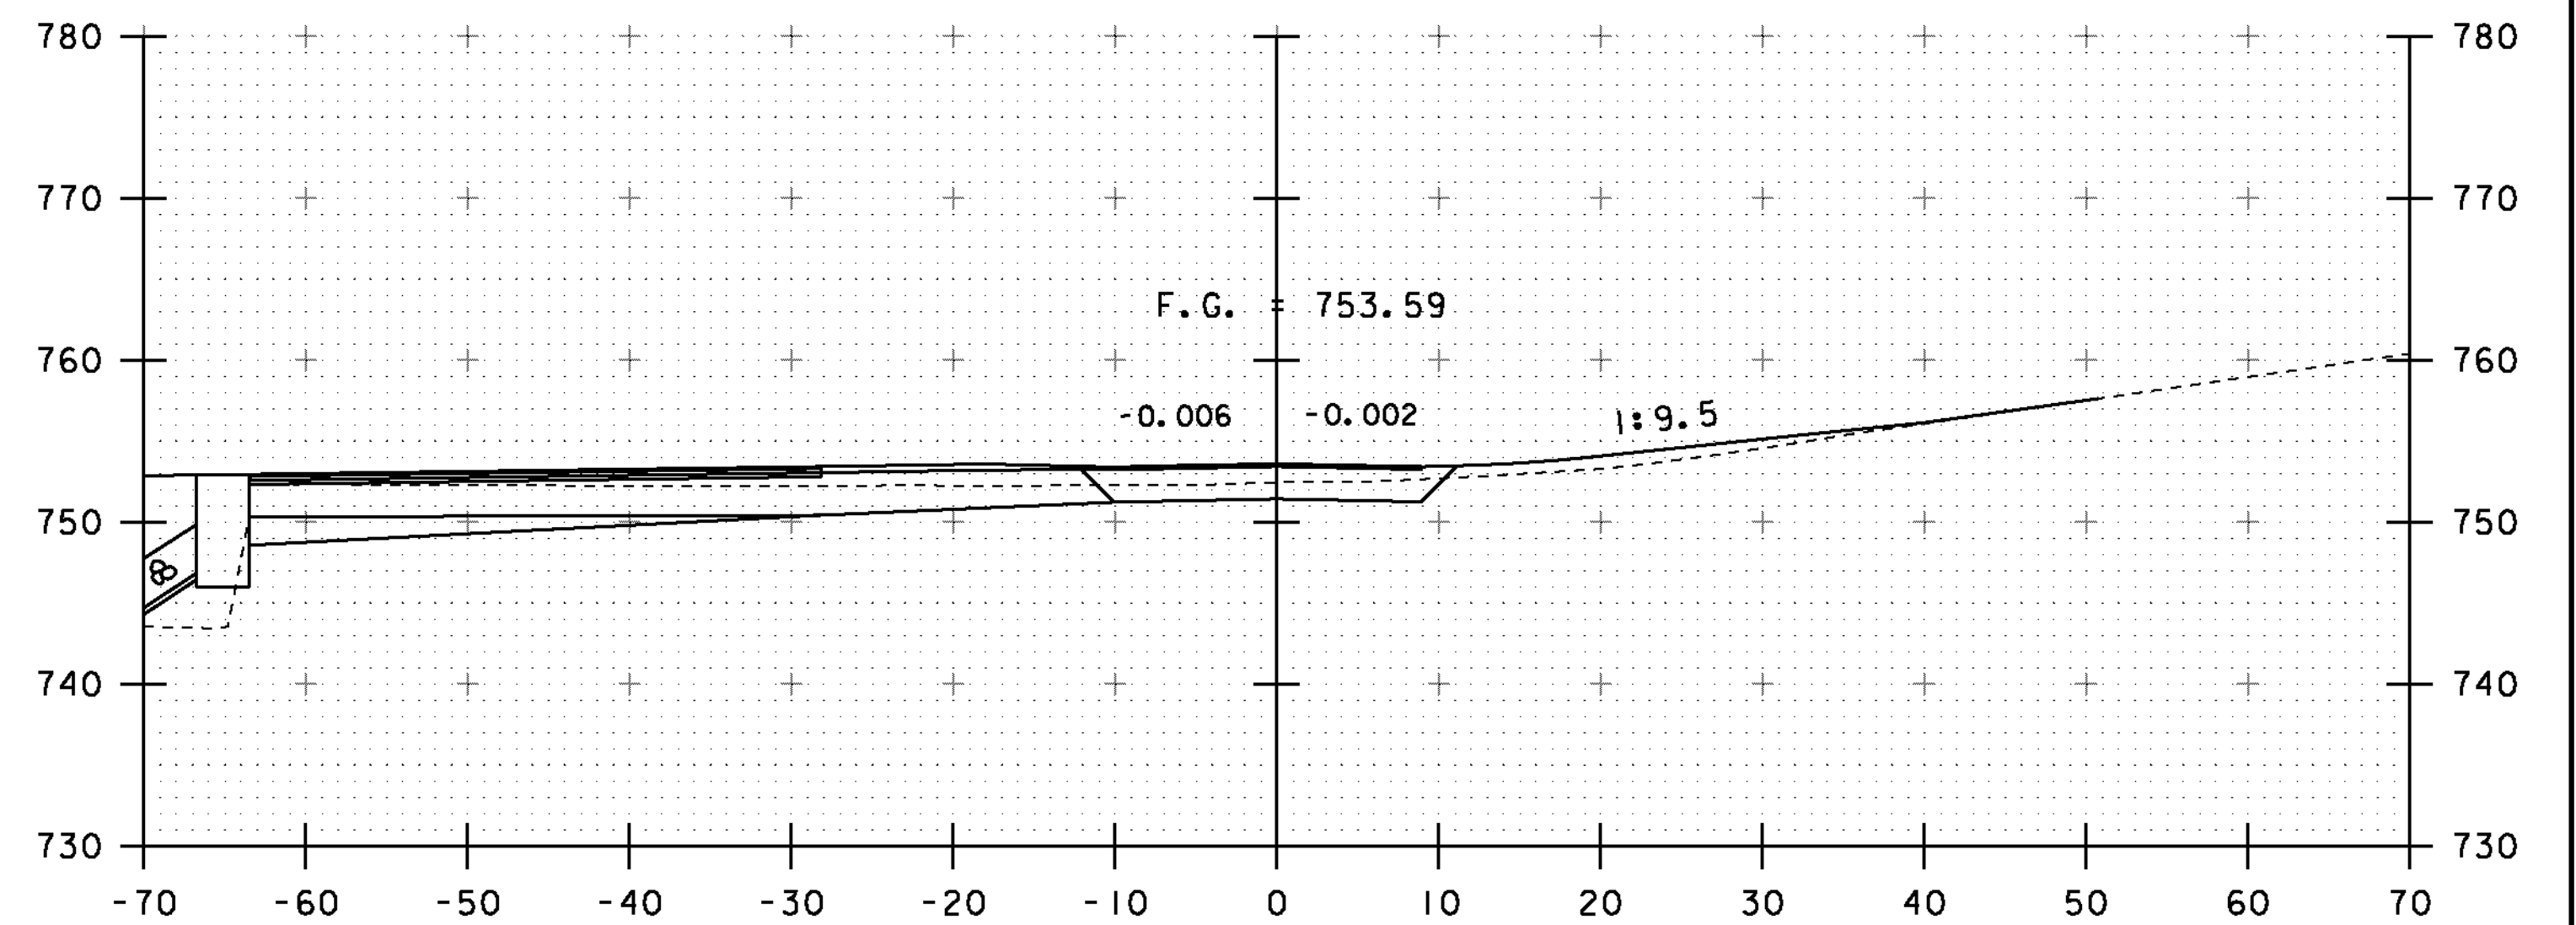

40+25

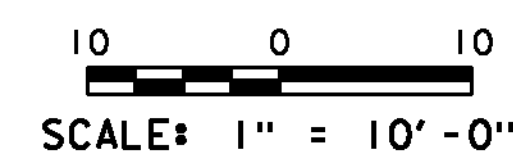

STA. 40+00 TO STA. 40+50

PROJECT NAME: ST. JOHNSBURY	PLOT DATE: 28-AUG-2012
PROJECT NUMBER: BRF 028-4(25)S	DRAWN BY: C. MOONEY
FILE NAME: s98b320xsl.dgn	CHECKED BY: C. CARLSON
PROJECT LEADER: C. CARLSON	SHEET 47 OF 62
DESIGNED BY: H. SALLS	
DRIVE 2 CROSS SECTIONS 1	