



41+00

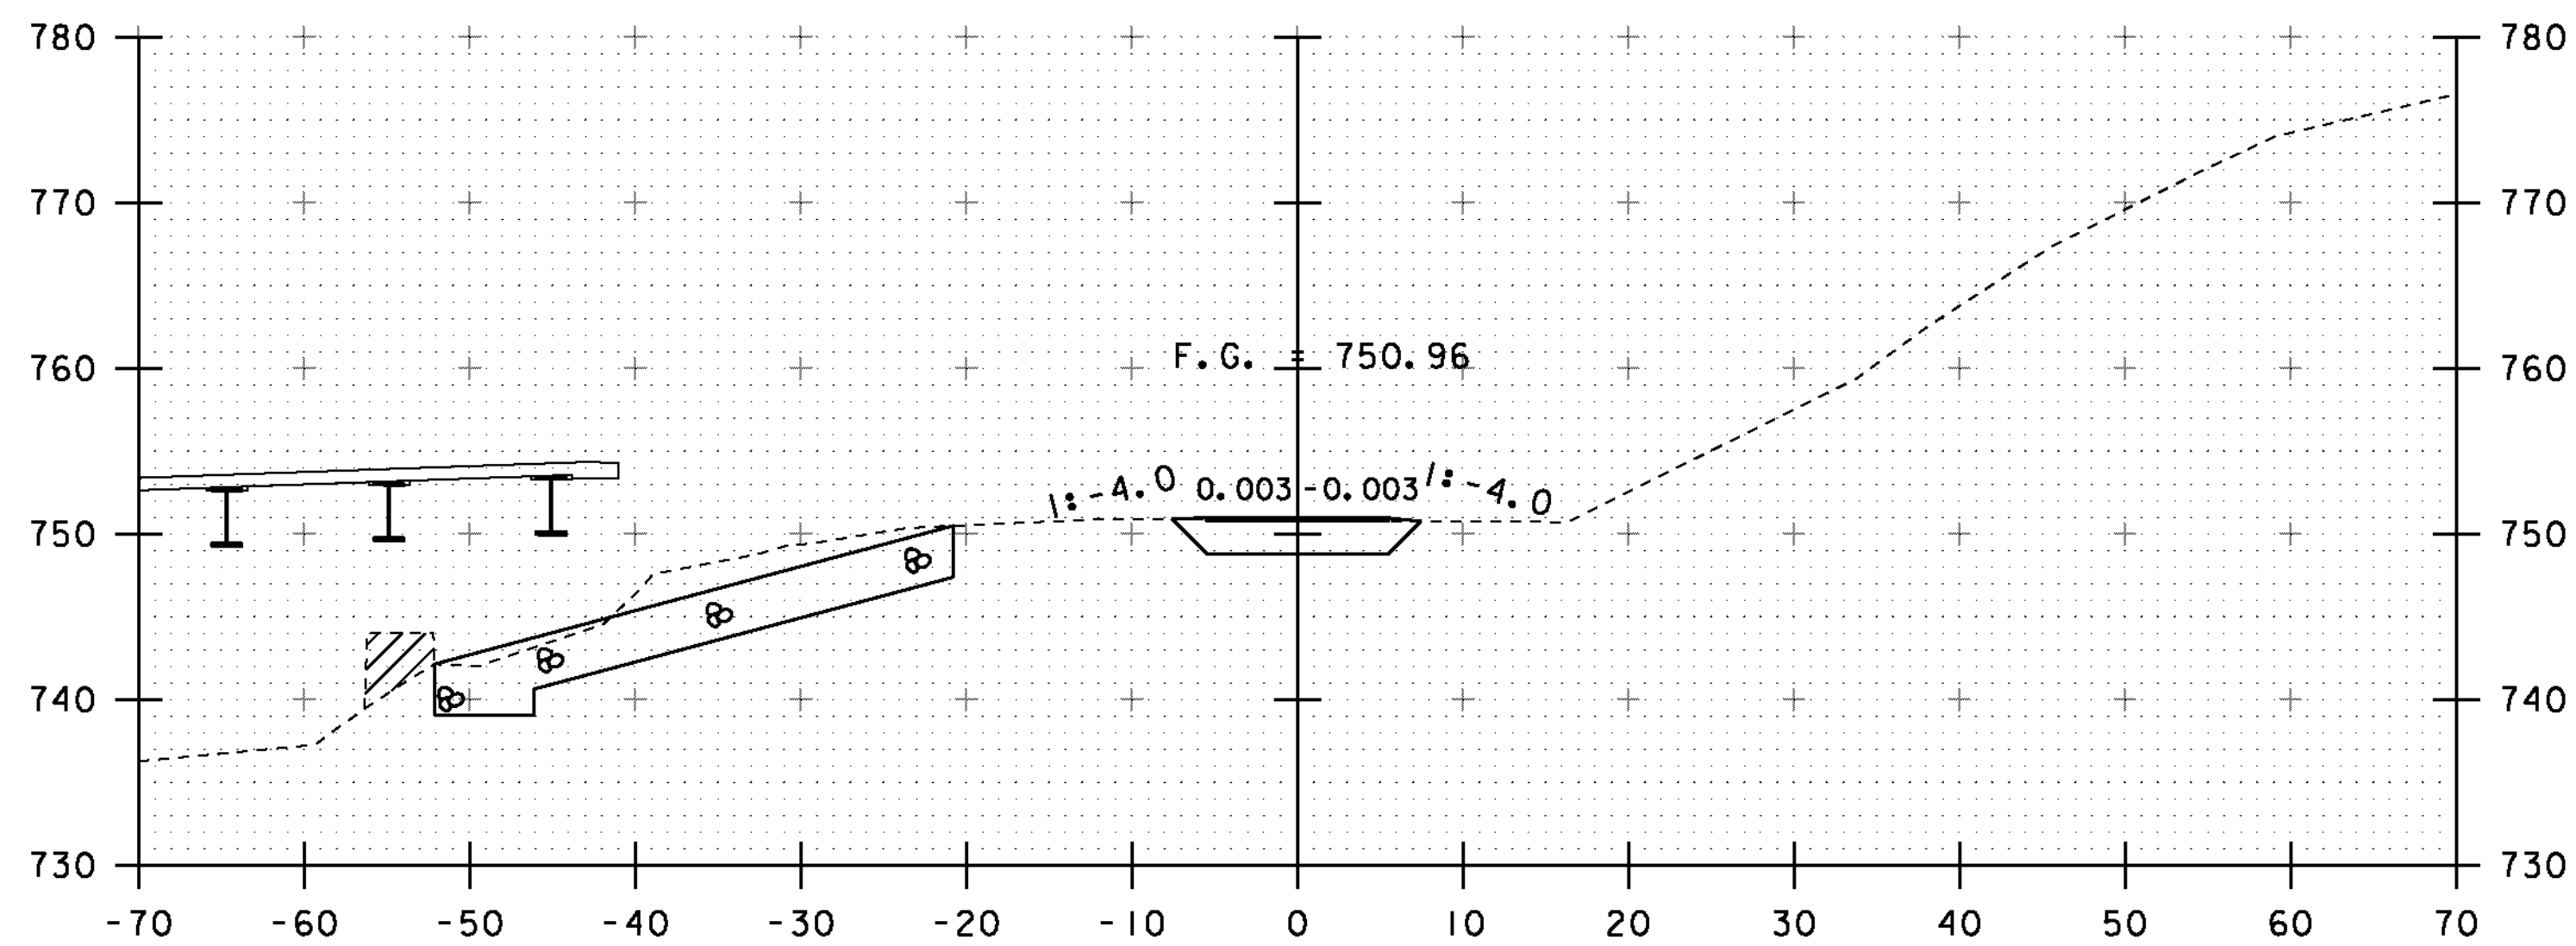


40+75

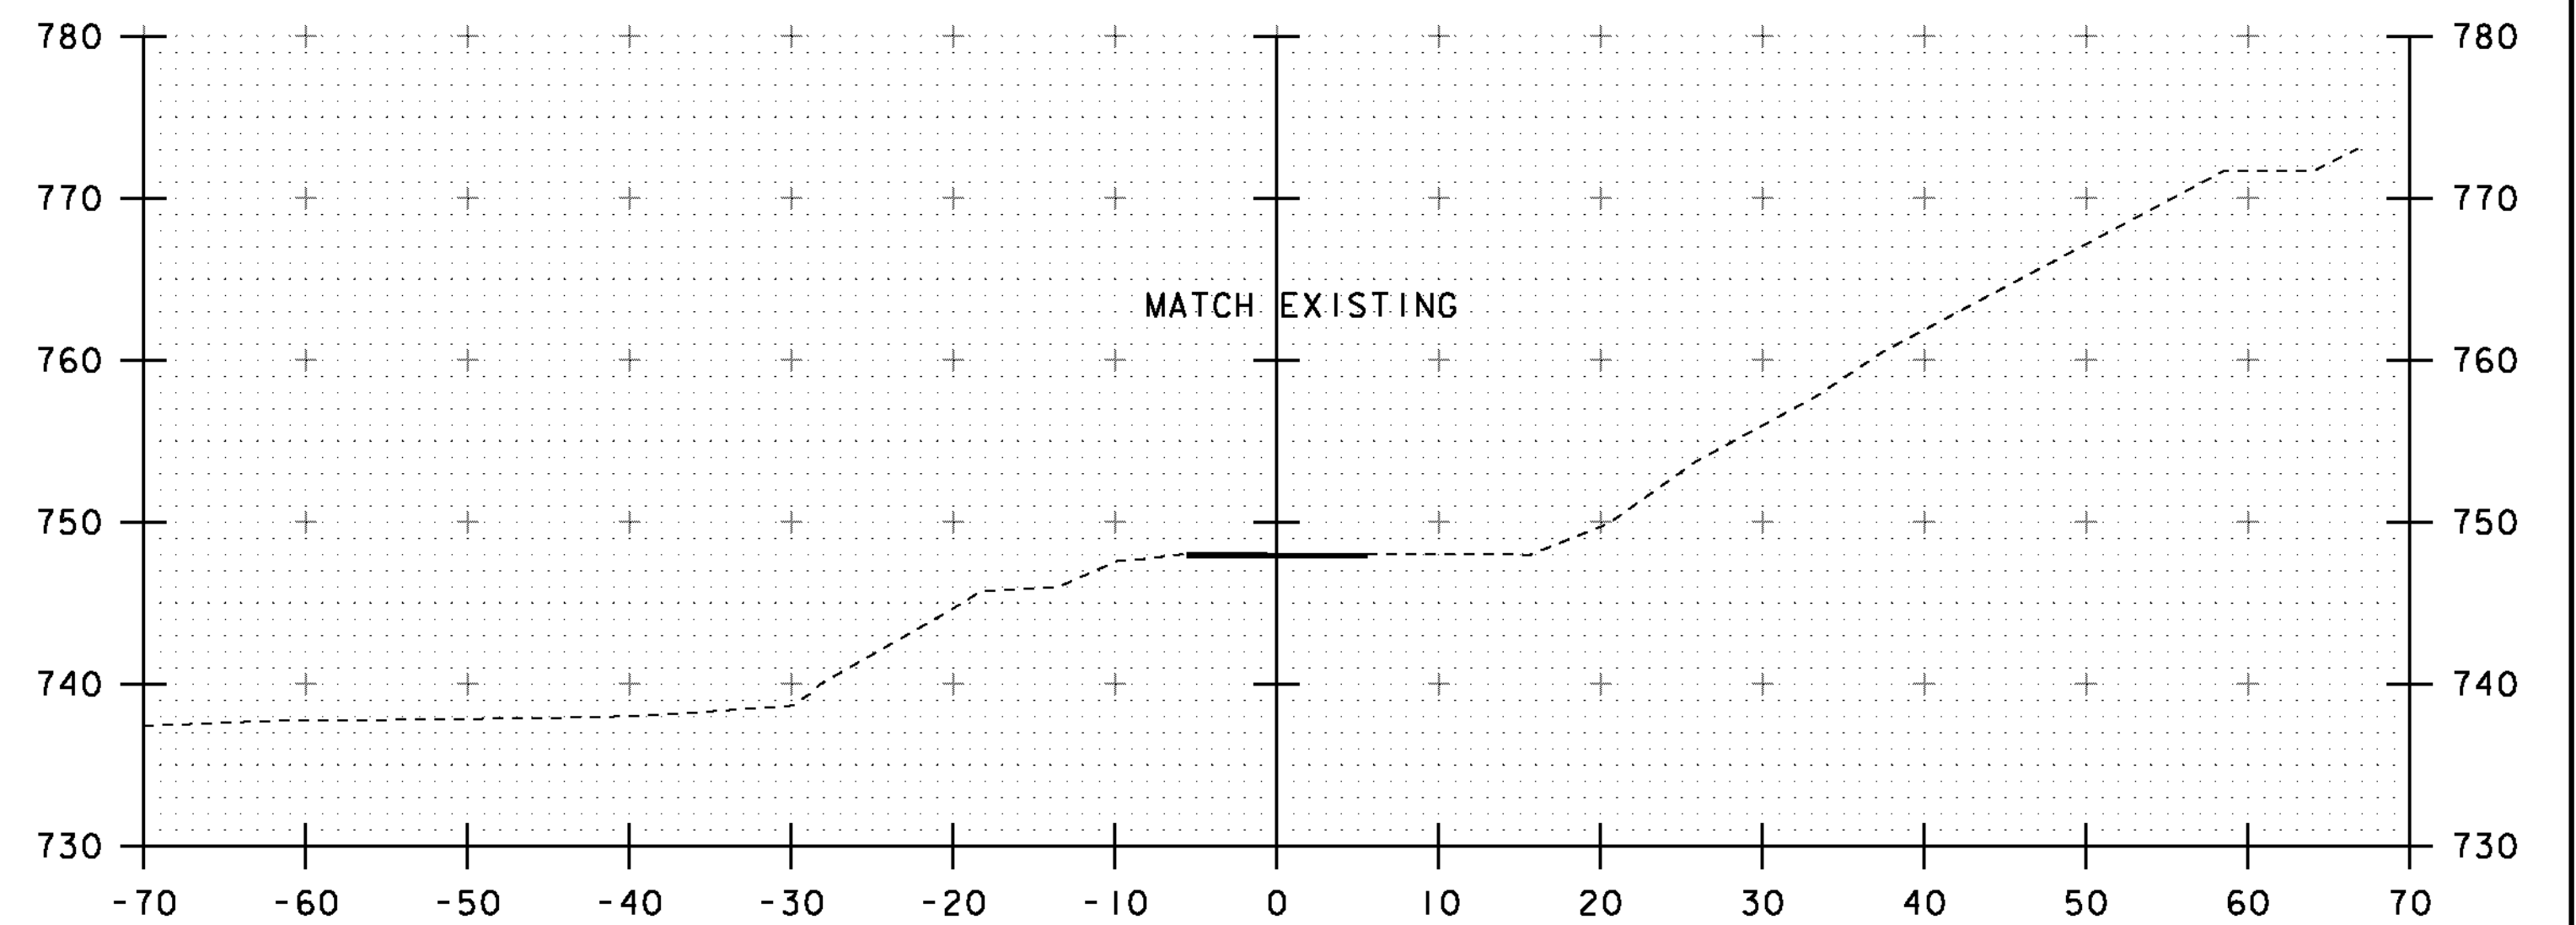

STA. 41+14.00
END DRIVE 2

41+14

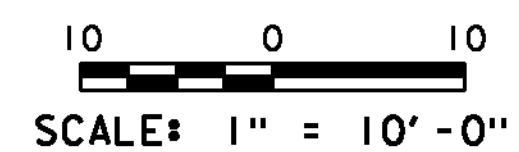

STA. 40+75 TO STA. 41+14

PROJECT NAME: ST. JOHNSBURY
PROJECT NUMBER: BRF 028-4(25)S

FILE NAME: s98b320xsl.dgn
PROJECT LEADER: C. CARLSON
DESIGNED BY: H. SALLS
DRIVE 2 CROSS SECTIONS 2

PLOT DATE: 28-AUG-2012
DRAWN BY: C. MOONEY
CHECKED BY: C. CARLSON
SHEET 48 OF 62