


LAYOUT PLAN 2

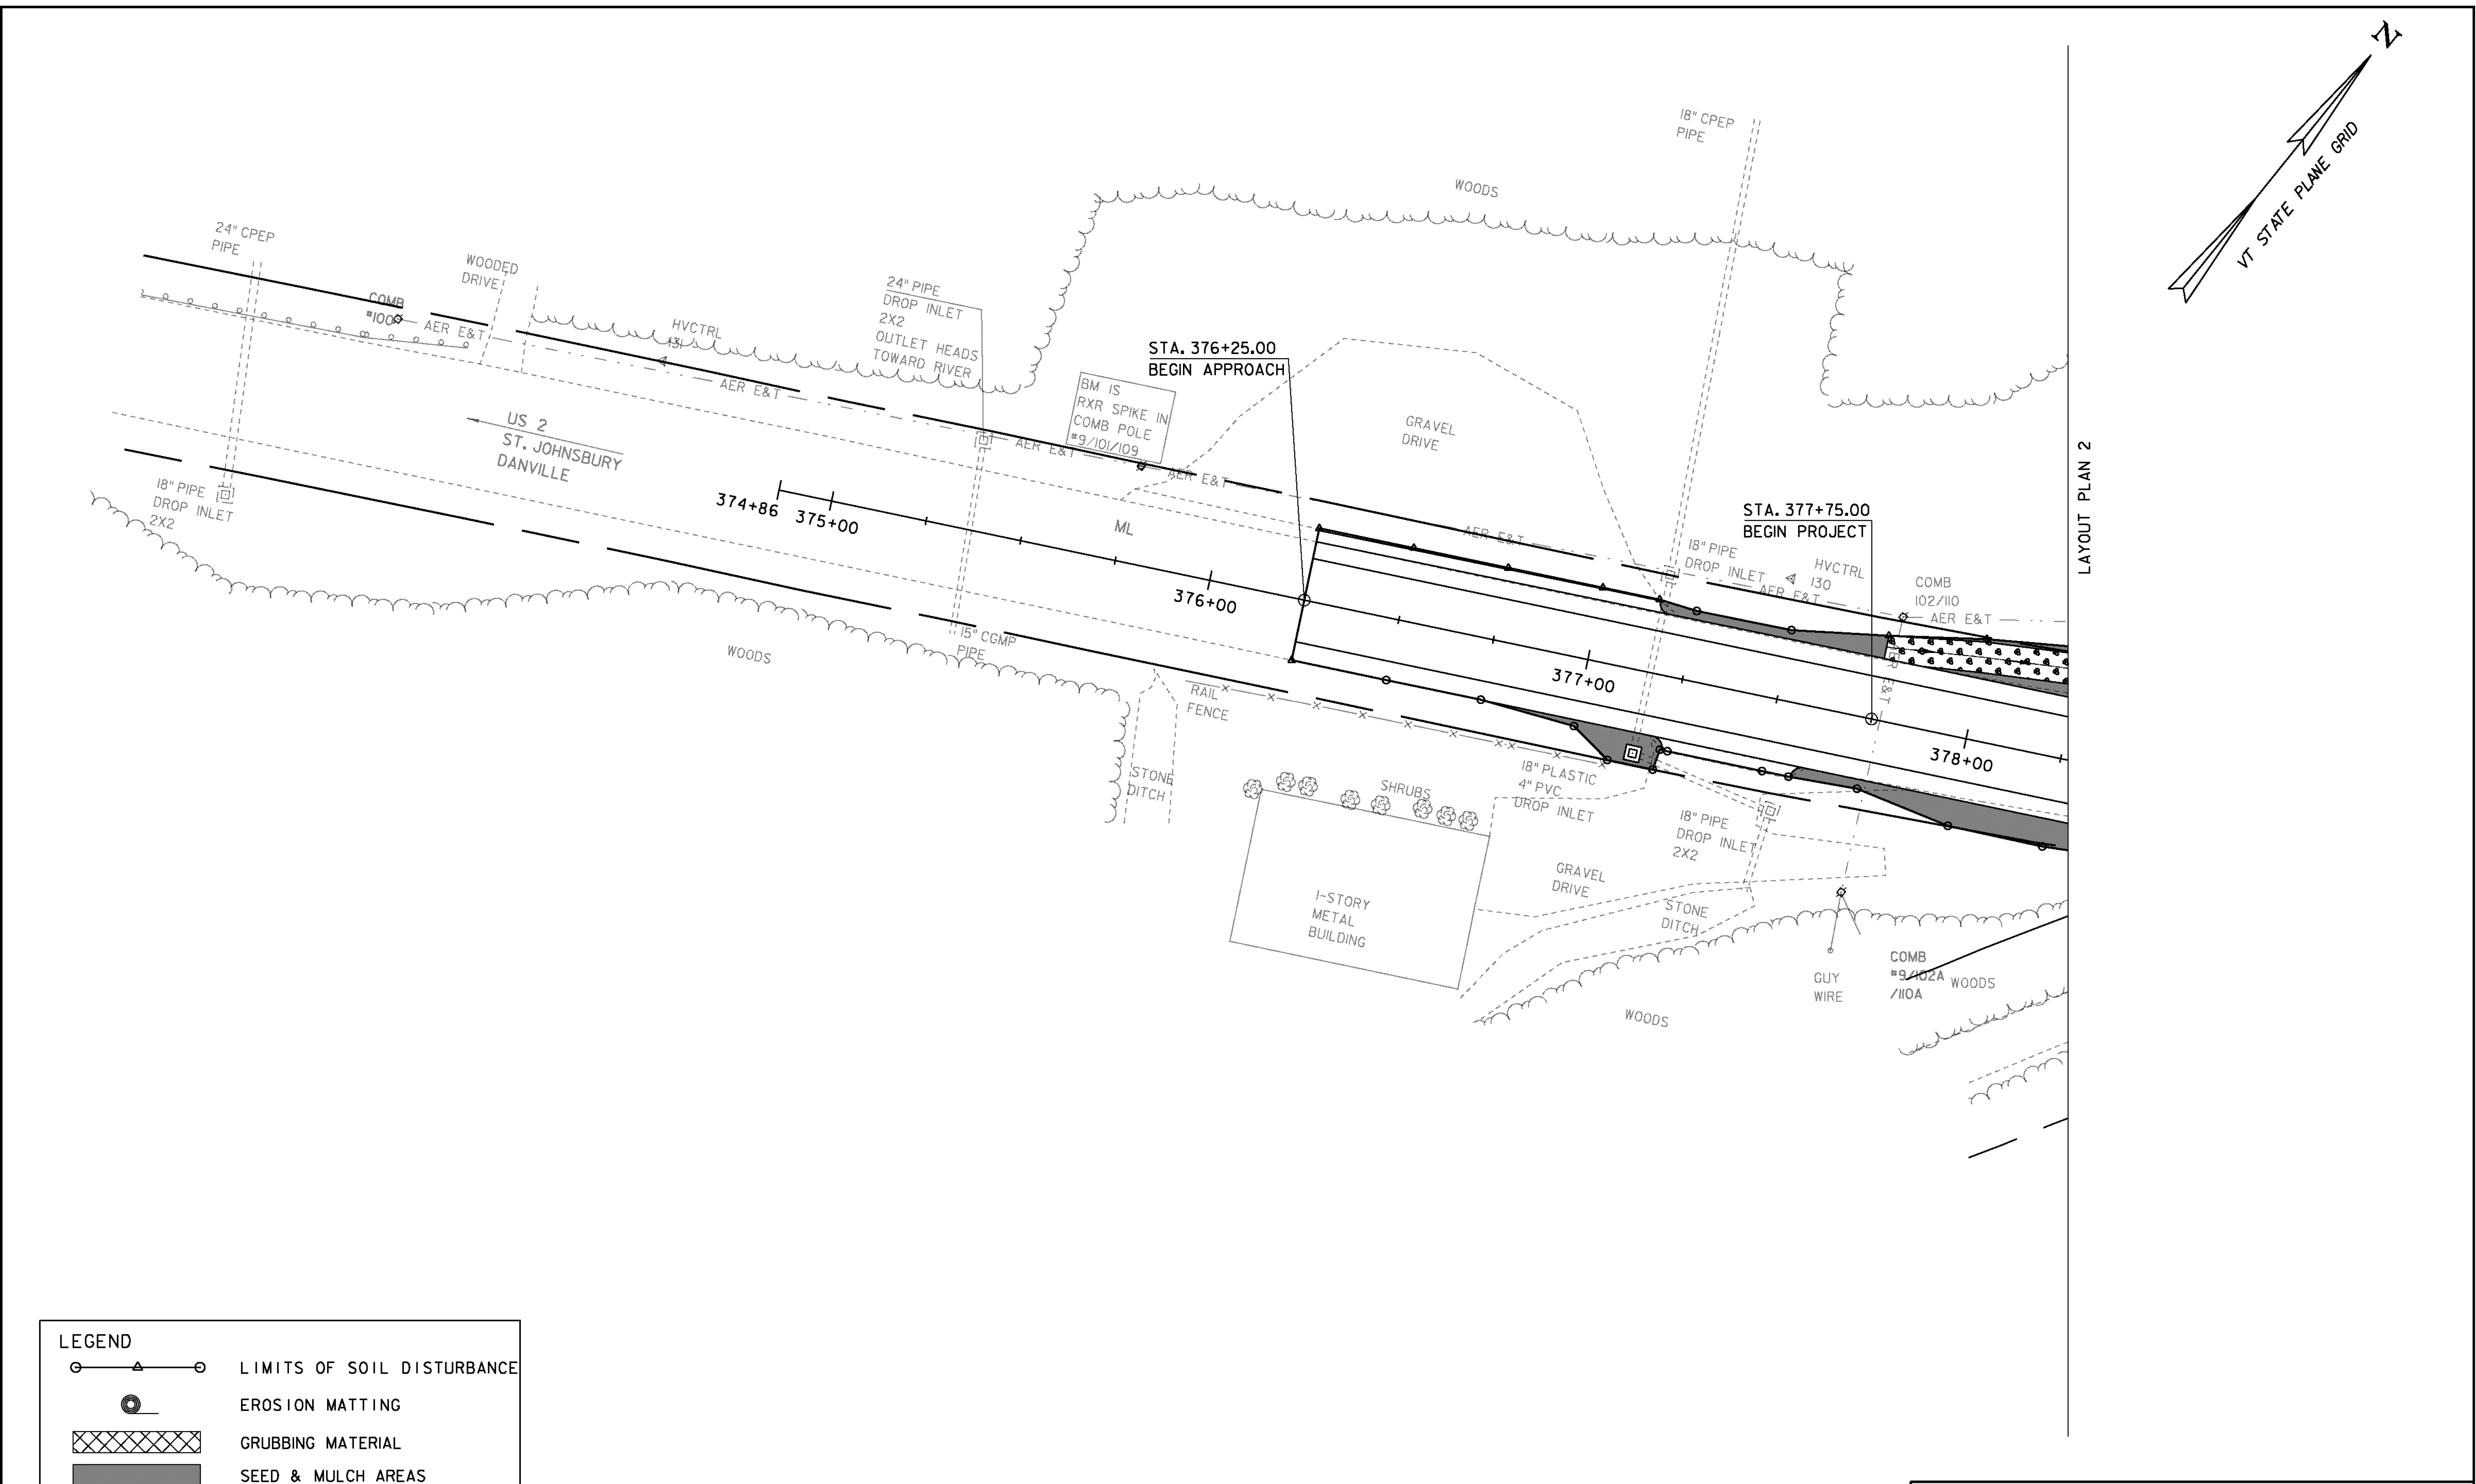

LEGEND	
	LIMITS OF SOIL DISTURBANCE
	EROSION MATTING
	GRUBBING MATERIAL
	SEED & MULCH AREAS
	50' RIPARIAN BUFFER RIPARIAN BUFFER ZONE
	50' WETLAND BUFFER WETLAND BUFFER ZONE
	WETLAND LIMITS

SCALE 1" = 20' - 0"

PROJECT NAME: ST. JOHNSBURY	
PROJECT NUMBER: BRF 028-4(25)S	
FILE NAME: s98b320epscFinal.dgn	PLOT DATE: 28-AUG-2012
PROJECT LEADER: C. CARLSON	DRAWN BY: C. MOONEY
DESIGNED BY: H. SALLS	CHECKED BY: C. CARLSON
EPSC FINAL CONDITION PLAN 1	SHEET 54 OF 62