

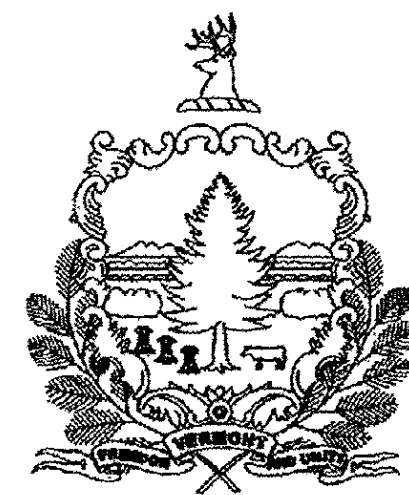


STATE OF VERMONT AGENCY OF TRANSPORTATION

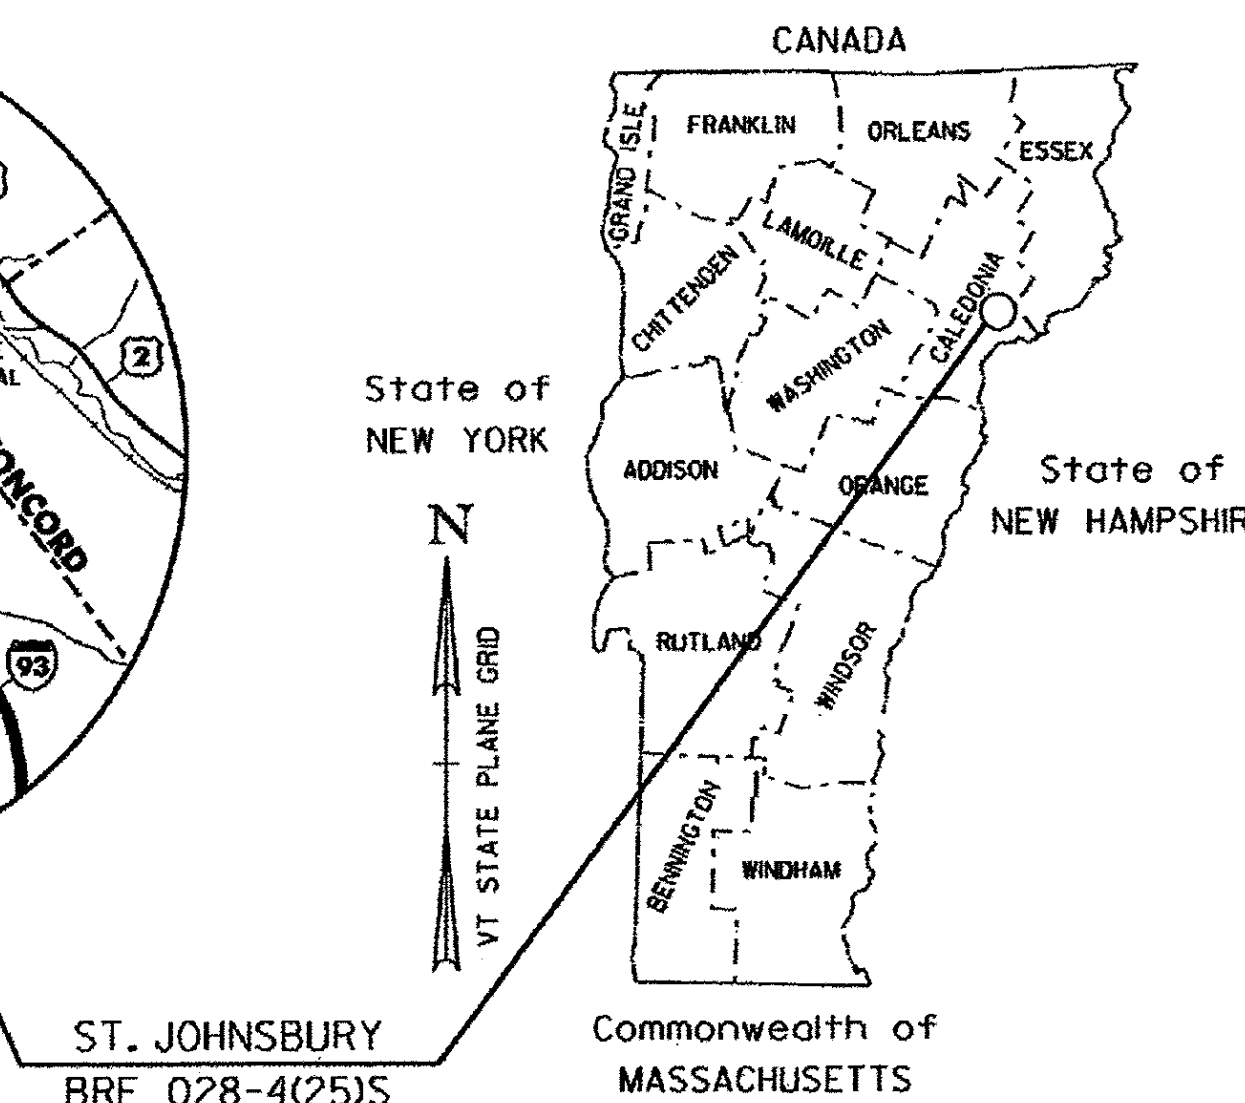

RECORD PLANS

RESIDENT ENGINEER : KEVIN MCCLURE
CONTRACTOR : WINTerset, INC.
PROJECT START DATE : 12-10-12
PROJECT COMPLETION DATE : 5-27-14

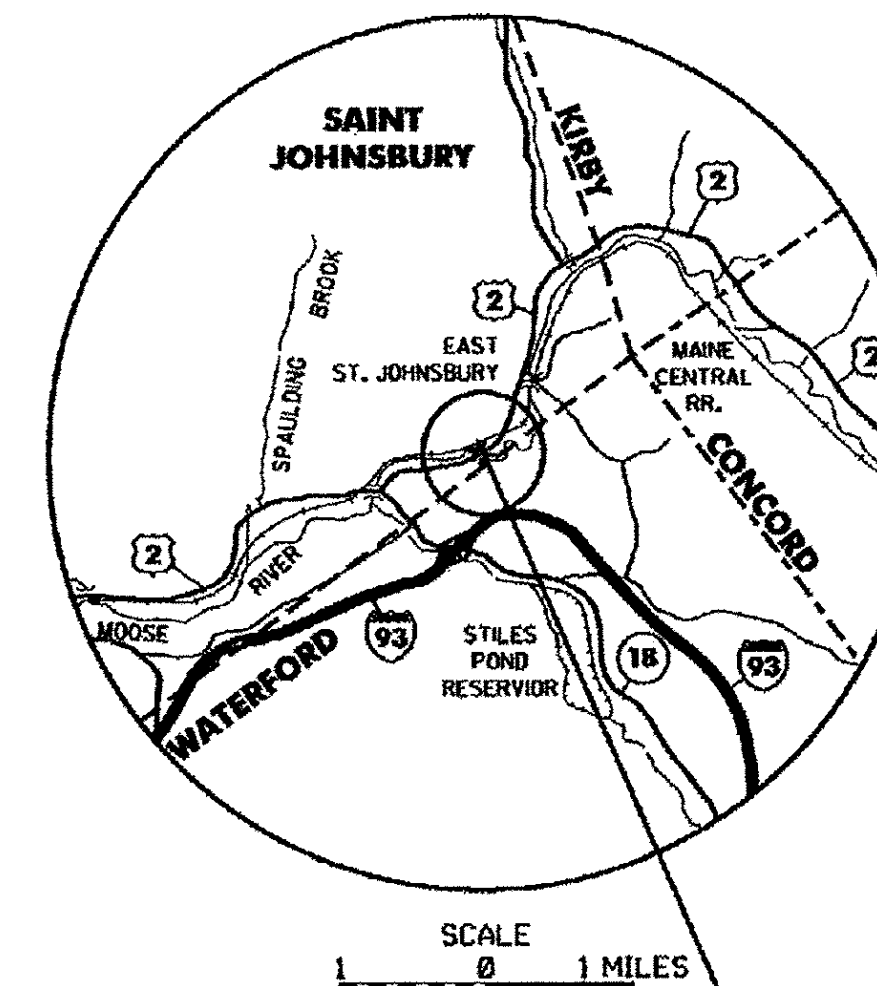

PROPOSED IMPROVEMENT BRIDGE PROJECT TOWN OF ST. JOHNSBURY COUNTY OF CALEDONIA US ROUTE 2 - PRINCIPAL ARTERIAL BRIDGE NO. 108

RECORD PLANS	
CONTRACTOR:	WINTerset, INC. - LYNDONVILLE, VT
RESIDENT ENGINEER:	KEVIN MCCLURE
CONSTRUCTION BEGAN:	APRIL 15, 2013
CONSTRUCTION COMPLETE:	MAY 27, 2014
RECORD PLANS BY:	KEVIN MCCLURE & C. PIERCE
I HEREBY CERTIFY THAT ALL THE CONSTRUCTION REQUIRED BY THIS SET OF DRAWINGS HAS BEEN ACCOMPLISHED AS INDICATED HEREIN.	
BY:	<i>Kevin McClure</i> RESIDENT ENGINEER
DATE:	3/5/15
NOTE: Any further information concerning final quantities, amounts or other details relative to this project may be found at Central Files in the electronic archives.	


PROJECT LOCATION
BEGINNING AT A POINT 0.579 MILES EAST OF THE INTERSECTION OF US ROUTE 2 AND VT ROUTE 18 AND EXTENDING EASTERLY ALONG U.S. ROUTE 2 FOR A DISTANCE OF 0.09 MILES.

PROJECT DESCRIPTION
THIS PROJECT SHALL CONSIST OF THE REPLACEMENT OF THE EXISTING STRUCTURE WITH RELATED APPROACH AND CHANNEL WORK.


LENGTH OF BRIDGE: 102.66 FEET
LENGTH OF ROADWAY: 397.34 FEET
LENGTH OF PROJECT: 500.00 FEET

QUALITY ASSURANCE PROGRAM: **LEVEL 1**

CONVENTIONAL SYMBOLS	
COUNTY LINE	
TOWN LINE	
LIMITS OF ACCESS	
POINT OF ACCESS	
FENCE LINE	
STONE WALL	
TRAVELED WAY	
GUARD RAIL	
RAILROAD	
SURVEY LINE	
CULVERT	
POWER POLE	
TELEPHONE POLE	
TREES	
CONTROL OF ACCESS	
PROPERTY LINE	
R.O.W. TAKING LINE	
SLOPE RIGHTS	
TOP OF CUT	
TOE OF SLOPE	

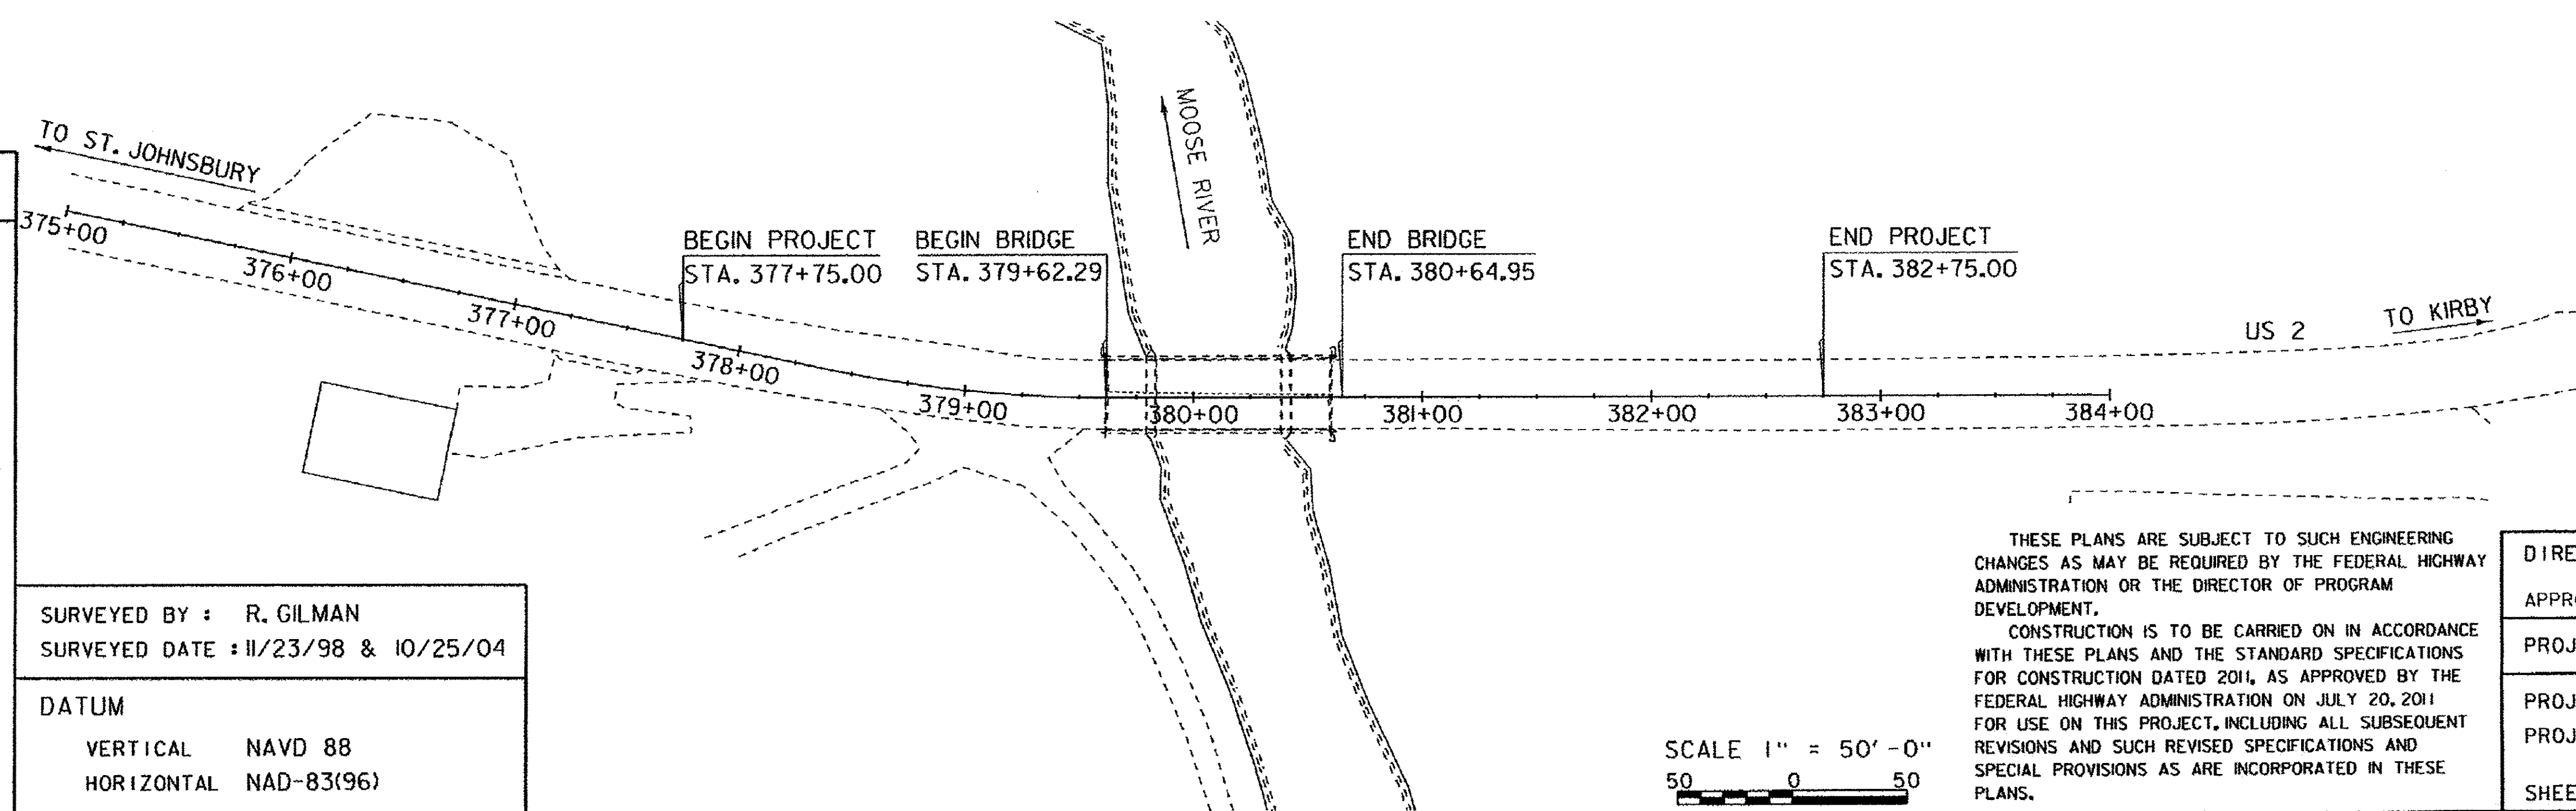

SURVEYED BY : R. GILMAN
SURVEYED DATE : 11/23/98 & 10/25/04
DATUM
VERTICAL NAVD 88
HORIZONTAL NAD-83(96)

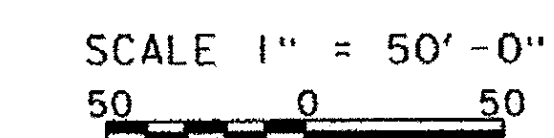

THESE PLANS ARE SUBJECT TO SUCH ENGINEERING CHANGES AS MAY BE REQUIRED BY THE FEDERAL HIGHWAY ADMINISTRATION OR THE DIRECTOR OF PROGRAM DEVELOPMENT.
CONSTRUCTION IS TO BE CARRIED ON IN ACCORDANCE WITH THESE PLANS AND THE STANDARD SPECIFICATIONS FOR CONSTRUCTION DATED 2011, AS APPROVED BY THE FEDERAL HIGHWAY ADMINISTRATION ON JULY 20, 2011 FOR USE ON THIS PROJECT, INCLUDING ALL SUBSEQUENT REVISIONS AND SUCH REVISED SPECIFICATIONS AND SPECIAL PROVISIONS AS ARE INCORPORATED IN THESE PLANS.

DIRECTOR OF PROGRAM DEVELOPMENT	
APPROVED	<i>Kevin A. Marchisio</i> DATE 8/27/12
PROJECT MANAGER : CAROLYN CARLSON	
PROJECT NAME :	ST. JOHNSBURY
PROJECT NUMBER :	BRF 028-4(25)S
SHEET 1 OF 62 SHEETS	

PRELIMINARY INFORMATION SHEET (BRIDGE)

LRFD

INDEX OF SHEETS

FINAL HYDRAULIC REPORT

PLAN SHEETS

NO.	TITLE
1	PRELIMINARY INFORMATION SHEET
2	PROJECT NOTES
3	QUANTITY SHEETS
4 - 5	BRIDGE QUANTITY SHEET
6	BRIDGE TYPICAL SECTION
7	ROADWAY TYPICAL SECTION
8	TIE SHEET
9	LAYOUT
10 - 11	ROADWAY PROFILE
12 - 14	DRIVE PROFILE
15	SIGN AND STRIPING PLAN
16 - 17	TRAFFIC SIGN SUMMARY
18	GUARDRAIL LAYOUT
19	BORING LAYOUT
20	BORING LOGS
21	PLAN AND ELEVATION
22	DECK DETAILS
23	FRAMING PLAN
24	APPROACH SLABS
25	ABUTMENT NO. 1 DETAILS
26	ABUTMENT NO. 2 DETAILS
27	ABUTMENT TYPICAL SECTIONS
28	WINGWALL DETAILS
29	REINFORCING STEEL SCHEDULE
30	ROADWAY CROSS SECTIONS
31 - 40	CHANNEL CROSS SECTIONS
41 - 44	DRIVE 1 CROSS SECTIONS
45 - 46	DRIVE 2 CROSS SECTIONS
47 - 48	EPSC NARRATIVE
49	EPSC EXISTING CONDITION PLAN
50 - 51	EPSC CONSTRUCTION CONDITION PLAN
52 - 53	EPSC FINAL CONDITION PLAN
54 - 55	EPSC DETAILS
56 - 58	R.O.W. DETAIL SHEET
59	R.O.W. LAYOUT SHEETS
60 - 62	

STANDARDS LIST

NO.	TITLE	DATE
B-71	STANDARD FOR RESIDENTIAL AND COMMERCIAL DRIVES	07-08-2005
D-6	REINFORCED CONCRETE DROP INLET W/GRATE (DITCHES)	06-01-1994
E-100	CONSTRUCTION APPROACH SIGNS	01-02-2004
E-100A	SIDE ROAD CONSTRUCTION - APPROACH SIGNS	01-02-2004
E-101	CONSTRUCTION SIGN DETAILS	05-30-2003
E-102	CONSTRUCTION SIGN DETAILS	06-30-2003
E-102A	CONSTRUCTION SIGN DETAILS	05-01-2004
E-106	TRAFFIC CONTROL - MISCELLANEOUS DETAILS	03-01-2004
E-107	DELINEATION, BARRICADES AND DETOURS FOR CONSTRUCTION AREAS	06-30-2003
E-107A	BREAKAWAY BARRICADE DETAILS	06-08-2009
E-108	CONSTRUCTION ZONE LONGITUDINAL DROP OFFS	06-08-2009
E-121	STANDARD SIGN PLACEMENT - CONVENTIONAL ROAD	08-08-1995
E-134	BRIDGE NUMBER PLAQUE	08-08-1995
E-138	MILE MARKER DETAILS - STATE & TOWN HIGHWAYS	05-30-2003
E-153B	WARNING SIGN DETAILS	05-30-2003
E-160	FLANGED CHANNEL STEEL SIGN POST	05-20-1999
E-164	SQUARE STEEL SIGN POST	08-08-2009
G-1B	BOX BEAM GUARD RAIL	06-01-1994
S-364A	BRIDGE RAILING, GALVANIZED 3 RAIL BOX BEAM	04-23-2012
S-364B	GUARDRAIL APPROACH SECTION, GALVANIZED 3 RAIL BOX BEAM	04-23-2012
S-364C	GUARDRAIL APPROACH SECTION, GALVANIZED 3 RAIL BOX BEAM	04-23-2012
S-364D	GUARDRAIL APPROACH SECTION, GALVANIZED 3 RAIL BOX BEAM	04-23-2012

STRUCTURAL DETAIL SHEETS

SD-501.00	CONCRETE DETAILS AND NOTES
SD-502.00	CONCRETE DETAILS AND NOTES
SD-516.10	BRIDGE JOINT ASPHALTIC PLUG
SD-601.00	STRUCTURAL STEEL DETAILS & NOTES
SD-602.00	STRUCTURAL STEEL PLATE GIRDER DETAILS & NOTES

HYDROLOGIC DATA

Date: April 12, 2010

DRAINAGE AREA : 116.9 sq. mi.
 CHARACTER OF TERRAIN : Hilly to mountainous, mostly forested with some open areas
 STREAM CHARACTERISTICS : Sinuous to meandering, incised and stable
 NATURE OF STREAMBED : Mostly cobbles with some gravel, sand and a few boulders

PEAK FLOW DATA

Q 2.33 =	2500 cfs	Q 50 =	6700 cfs
Q 10 =	4500 cfs	Q 100 =	7600 cfs
Q 25 =	5700 cfs	Q 500 =	9700 cfs

DATE OF FLOOD OF RECORD : unknown
 ESTIMATED DISCHARGE : unknown
 WATER SURFACE ELEV. : unknown
 NATURAL STREAM VELOCITY : @ Q50 = 8.0 fps
 ICE CONDITIONS : Moderate to heavy
 DEBRIS : Moderate
 DOES THE STREAM REACH MAXIMUM HIGHWATER ELEV. RAPIDLY? : Yes
 IS ORDINARY RISE RAPID? : Yes
 IS STAGE AFFECTED BY UPSTREAM OR DOWNSTREAM CONDITIONS? : No
 IF YES, DESCRIBE :

WATERSHED STORAGE : <1% HEADWATERS :
 UNIFORM :
 IMMEDIATELY ABOVE SITE :

EXISTING STRUCTURE INFORMATION

STRUCTURE TYPE : Three span steel beam bridge with concrete deck
 YEAR BUILT : Built in 1929 and reconstructed in 1950
 CLEAR SPAN(NORMAL TO STREAM) : 17' + 54' + 17' = 88' total
 VERTICAL CLEARANCE ABOVE STREAMBED : 11'
 WATERWAY OF FULL OPENING : 810 sq. ft.
 DISPOSITION OF STRUCTURE : Remove and replace
 TYPE OF MATERIAL UNDER SUBSTRUCTURE : See boring logs

WATER SURFACE ELEVATIONS AT:

Q2.33 =	744.3'	VELOCITY =	7.3 fps
Q10 =	747.1'	"	8.6 fps
Q25 =	748.3'	"	9.9 fps
Q50 =	749.2'	"	10.8 fps
Q100 =	750.0'	"	11.9 fps

LONG TERM STREAMBED CHANGES : There is a 2' - 3' deep scour hole through the bridge area. No other changes were noted, and the streambed appears stable.

IS THE ROADWAY OVERTOPPED BELOW Q100 : No
 FREQUENCY : Above Q100
 RELIEF ELEVATION : 752.0'
 DISCHARGE OVER ROAD @Q100 : None

UPSTREAM STRUCTURE

TOWN : St. Johnsbury DISTANCE : 4600'
 HIGHWAY # : Railway STRUCTURE # :
 CLEAR SPAN : No information available. CLEAR HEIGHT :
 YEAR BUILT : FULL WATERWAY :
 STRUCTURE TYPE :

DOWNSTREAM STRUCTURE

TOWN : St. Johnsbury DISTANCE : 3400'
 HIGHWAY # : U.S. Route 2 STRUCTURE # : 107
 CLEAR SPAN : 62' CLEAR HEIGHT : 13'
 YEAR BUILT : Built 1929 rehab. 1950 & 1978 FULL WATERWAY : 870 sq. ft.
 STRUCTURE TYPE : Single span steel beam bridge with concrete deck

LRFR LOAD RATING FACTORS

LOADING LEVELS	TRUCK						
	H-20	HL-93	3S2	6 AXLE	3A. STR.	4A. STR.	5A. SEMI
TONNAGE	20	36	36	66	30	34.5	38
INVENTORY	2.20	1.40	2.23	1.38	2.18	1.93	1.97
POSTING							
OPERATING	2.85	1.81	2.89	1.79	2.83	2.51	2.55
COMMENTS:							

PILE DRIVING AND TESTING REQUIREMENTS

- NOMINAL PILE DRIVING CAPACITY P_{dr} : 486.0 KIP
- PILE TEST RESISTANCE FACTOR ϕ : 0.65
- REQUIRED PILE PENETRATION BELOW ABUTMENT STEM 35.00 FT
- PERFORM ONE DYNAMIC PILE LOADING TEST FOR EACH ABUTMENT. PILES MUST BE DRIVEN TO THE REQUIRED DEPTH REGARDLESS IF THE REQUIRED DRIVING RESISTANCE HAS BEEN MET.

PROPOSED STRUCTURE

STRUCTURE TYPE : Single span steel plate girder bridge with concrete deck

CLEAR SPAN(NORMAL TO STREAM) : 97.4' (99.0' along roadway)
 VERTICAL CLEARANCE ABOVE STREAMBED : 11'
 WATERWAY OF FULL OPENING : 898 sq. ft.

WATER SURFACE ELEVATIONS AT:

Q2.33 =	743.9'	VELOCITY =	6.0 fps
Q10 =	746.6'	"	6.8 fps
Q25 =	747.6'	"	7.8 fps
Q50 =	748.4'	"	8.6 fps
Q100 =	749.0'	"	9.4 fps

IS THE ROADWAY OVERTOPPED BELOW Q100 : No
 FREQUENCY : Above Q100
 RELIEF ELEVATION : 752.0'
 DISCHARGE OVER ROAD @Q100 : None

AVERAGE LOW ELEVATION OF SUPERSTRUCTURE : 750.5' upstream, 748.7' downstream
 VERTICAL CLEARANCE : @ Q50 = 2.1' upstream girder, 1.2' downstream girder

SCOUR : Contraction scour = 3' up to Q500.

REQUIRED CHANNEL PROTECTION : Stone Fill, Type III

PERMIT INFORMATION

AVERAGE DAILY FLOW : 240 cfs DEPTH OR ELEVATION :
 ORDINARY LOW WATER : 110 cfs Elevation 739'
 ORDINARY HIGH WATER : 1075 cfs Elevation 742'

TEMPORARY BRIDGE REQUIREMENTS

STRUCTURE TYPE : Single span bridge
 CLEAR SPAN(NORMAL TO STREAM) : 96' minimum
 VERTICAL CLEARANCE ABOVE STREAMBED : Elevation 748.0' minimum
 WATERWAY AREA OF FULL OPENING : 756 sq. ft. minimum

ADDITIONAL INFORMATION

TRAFFIC MAINTENANCE NOTES

- MAINTAIN TWO-WAY TRAFFIC ON A TEMPORARY BRIDGE.
- TRAFFIC SIGNALS ARE NOT NECESSARY.
- SIDEWALKS ARE NOT NECESSARY
- THE APPROACHES FOR THE TEMPORARY BRIDGE SHALL BE PAVED.

DESIGN VALUES

1. DESIGN LIVE LOAD	HL-93
2. FUTURE PAVEMENT	d_p : 3.0 INCH
3. DESIGN SPAN	L : 101.00 FT
4. MIN. MID-SPAN POS. CAMBER @ RELEASE (PRESTRESSED UNITS)	Δ : ---
5. PRESTRESSING STRAND	f_y : ---
6. PRESTRESSED CONCRETE STRENGTH	$f'c$: ---
7. PRESTRESSED CONCRETE RELEASE STRENGTH	$f'c_i$: ---
8. CONCRETE, HIGH PERFORMANCE CLASS AA	$f'c$: ---
9. CONCRETE, HIGH PERFORMANCE CLASS A	$f'c$: 4.0 KSI
10. CONCRETE, HIGH PERFORMANCE CLASS B	$f'c$: 3.5 KSI
11. CONCRETE, CLASS C	$f'c$: ---
12. REINFORCING STEEL	f_y : 60 KSI
13. STRUCTURAL STEEL AASHTO M270	f_y : 50 KSI
14. SOIL UNIT WEIGHT	γ : 0.140 KCF
15. NOMINAL BEARING RESISTANCE OF SOIL	q_n : ---
16. SOIL BEARING RESISTANCE FACTOR (REFER TO AASHTO LRFD)	ϕ : ---
17. NOMINAL BEARING RESISTANCE OF ROCK	q_n : ---
18. ROCK BEARING RESISTANCE FACTOR (REFER TO AASHTO LRFD)	ϕ : ---
19. NOMINAL AXIAL PILE RESISTANCE	q_p : 486.0 KIPS
20. PILE YIELD STRENGTH ASTM A572	f_y : 50 KSI
21. PILE SIZE	HP 12X 84
22. EST. PILE LENGTHS (TWO SUBSTRUCTURES)	L_p : ---
(ABUTMENT 1 = 55 AND ABUTMENT 2 = 54) FT	
23. PILE RESISTANCE FACTOR	ϕ : 0.65
24. LATERAL PILE DEFLECTION	Δ : 0.41 INCH
25. BASIC WIND SPEED	V_{3s} : ---
26. MINIMUM GROUND SNOW LOAD	p_g : ---
27. SEISMIC DATA	PGA: --- S : --- S_I : ---


PROJECT NAME : ST. JOHNSBURY

PROJECT NUMBER : BRF 028-4(25)S

FILE NAME : s98b320pi.xls PLOT DATE : 8/28/2012
 PROJECT LEADER : C. CARLSON DRAWN BY : R. PELLETT
 DESIGNED BY : H. SALLS CHECKED BY : C. CARLSON
 PRELIMINARY INFORMATION SHEET SHEET 2 OF 62

TRAFFIC DATA

TEMPORARY BRIDGE PROFILE ALONG TEMP CL

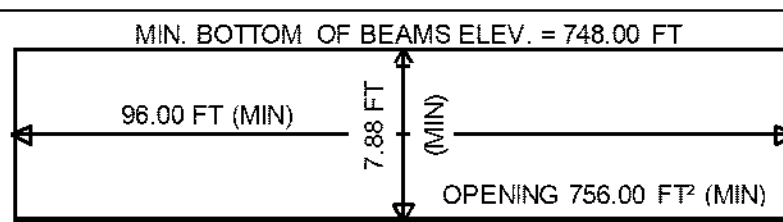

YEAR	ADT	DHV	% D	% T	ADTT	20 year ESAL for flexible pavement from 2013 to 2033 : 4401000	40 year ESAL for flexible pavement from 2013 to 2053 : 10806000	Design Speed : 40 mph
2013	4600	520	58	5.6	440			
2033	5200	590	58	8.3	750			

GENERAL

1. ALL MATERIALS AND CONSTRUCTION SHALL CONFORM TO THE STATE OF VERMONT AGENCY OF TRANSPORTATION STANDARD SPECIFICATIONS FOR CONSTRUCTION DATED 2011, AND ITS LATEST REVISIONS, THE AASHTO LRFD BRIDGE DESIGN SPECIFICATIONS FIFTH EDITION, DATED 2010 AND ITS LATEST REVISIONS AND THE AASHTO LRFD BRIDGE CONSTRUCTION SPECIFICATIONS THIRD EDITION, DATED 2010 AND ITS LATEST REVISIONS.
2. THE BRIDGE WAS DESIGNED FOR THE HL-93 LIVE LOAD.
3. ITEM 529.20 "PARTIAL REMOVAL OF STRUCTURE" SHALL BE USED FOR REMOVAL OF THE EXISTING STRUCTURE INCLUDING THE SUPERSTRUCTURE, PIERS AND ANY PORTION OF THE ABUTMENTS OUTSIDE THE LIMITS OF STRUCTURE EXCAVATION OR UNCLASSIFIED CHANNEL EXCAVATION. THE PIERS SHALL BE REMOVED TO STREAMBED ELEVATION.
4. THERE ARE 3 DROP INLETS INSIDE THE PROJECT AREA; THEY WILL NEED TO BE PROTECTED DURING CONSTRUCTION. PAYMENT FOR THE ADJUSTMENT OF ELEVATION OF ANY DROP INLET TO MATCH THE NEW FINAL GRADE WILL BE MADE UNDER ITEM 604.40 "CHANGING ELEVATION OF DROP INLETS, CATCH BASINS, OR MANHOLES". THE DROP INLETS SHALL BE CLEANED AND FLUSHED AT THE END OF THE PROJECT. PAYMENT FOR CLEANING AND FLUSHING WILL BE CONSIDERED INCIDENTAL TO ALL OTHER CONTRACT ITEMS.
5. ALL DIMENSIONS SHOWN IN THE PLANS ARE HORIZONTAL OR VERTICAL AND ARE GIVEN AT 68 DEGREES FAHRENHEIT, UNLESS NOTED OTHERWISE.
6. THE TEMPORARY BRIDGE APPROACHES SHALL BE PAVED.

EARTHWORK AND RELATED ITEMS

7. TEMPORARY CONSTRUCTION FILLS WITHIN THE WATERCOURSE FOR ANY PURPOSE SHALL CONSIST OF CLEAN STONE FILL ONLY. NO OTHER FILLING IN THE STREAM SHALL OCCUR WITHOUT THE APPROVAL OF THE STREAM ALTERATION ENGINEER. THE STONE FILL, TYPE III SHALL BE PLACED IN FRONT OF THE ABUTMENTS BEFORE THE STEEL GIRDERS ARE SET.
8. THE BACKFILL BEHIND THE ABUTMENTS SHALL NOT BE PLACED HIGHER THAN THE BRIDGE SEAT UNTIL THE ABUTMENT AND DECK CONSTRUCTION IS COMPLETED. THE DIFFERENCE IN ELEVATION OF FILL BEHIND THE TWO ABUTMENTS AT ANY TIME DURING BACKFILLING OPERATIONS SHALL NOT EXCEED 2 FEET.

STRUCTURAL STEEL

9. THE EXISTING STRUCTURAL STEEL IS PAINTED WITH A MATERIAL THAT MAY CONTAIN LEAD. THE CONTRACTOR SHALL FOLLOW ALL APPLICABLE REGULATIONS WHEN HANDLING AND WORKING WITH THIS STEEL. THE REMOVED STRUCTURAL STEEL IS THE PROPERTY OF THE CONTRACTOR. THE CONTRACTOR SHALL INDEMNIFY AND HOLD THE STATE, ITS OFFICERS, AND EMPLOYEES HARMLESS CONCERNING THE CONTRACTOR'S USE OR DISPOSITION OF THE REMOVED EXISTING STRUCTURAL STEEL.
10. THE PILES SHALL BE HP 12 X 84.
11. PILE SHOES SHALL BE REQUIRED AND SHALL CONFORM TO SUBSECTION 505.04.
12. TO ENSURE THAT THE NOMINAL CAPACITY HAS BEEN ATTAINED AND TO PREVENT THE OVERSTRESSING OF THE PILES DURING DRIVING OPERATIONS, DYNAMIC TESTING SHALL BE PERFORMED IN ACCORDANCE WITH SUBSECTION 505.04 OF THE STANDARD SPECIFICATIONS. PAYMENT FOR PILE TESTING SHALL BE MADE UNDER ITEM 505.45 "DYNAMIC PILE LOADING TEST". A MINIMUM OF ONE DYNAMIC PILE TEST SHALL BE CONDUCTED ON THE FIRST PILE DRIVEN FOR EACH SUBSTRUCTURE UNIT, FOR A TOTAL OF 2 TESTS. MORE TESTS MAY BE REQUIRED BY THE RESIDENT ENGINEER.
13. THE PILES SHALL BE DRIVEN TO A NOMINAL RESISTANCE OF 486 KIPS, AS DETERMINED BY THE RESULTS OF DYNAMIC TESTING, AS INTERPRETED BY THE RESIDENT ENGINEER. HOWEVER, THE PILES SHALL BE DRIVEN TO A MINIMUM DEPTH OF 35 FEET BELOW THE BOTTOM OF STEM ELEVATION.
14. FOR ESTIMATING PURPOSES, THE PILE TIP ELEVATIONS WERE ASSUMED TO BE AS SHOWN ON THE BORING LOGS SHEET IN THE PLANS. THE ACTUAL IN PLACE LENGTH MAY VARY.
15. UNLESS OTHERWISE NOTED, ALL NEW STRUCTURAL STEEL SHALL CONFORM TO AASHTO M 270M/M 270 GRADE 50 AND SHALL BE PAID FOR UNDER ITEM 506.55 "STRUCTURAL STEEL, PLATE GIRDER". ALL NEW STRUCTURAL STEEL SHALL BE PAINTED BROWN (COLOR CHIP #20059)
16. STRUCTURAL STEEL MEMBERS DESIGNATED "CVN" IN THE PLANS SHALL BE CHARPY V-NOTCH TESTED IN ACCORDANCE WITH SUBSECTION 714.01 OF THE STANDARD SPECIFICATIONS.

17. AFTER SUPERSTRUCTURE STEEL HAS BEEN ERECTED, ELEVATIONS ALONG THE TOP OF THE GIRDERS SHALL BE TAKEN AS DIRECTED BY THE RESIDENT ENGINEER FOR USE IN DETERMINING FINISHED GRADES.
18. FLEMING BRACKETS OR SIMILAR FALSEWORK SHALL BE SPACED AS REQUIRED BY DESIGN, BUT SHALL BE LIMITED TO A MAXIMUM SPACING OF 4 FEET. THE DESIGN OF FALSEWORK SHALL BE THE RESPONSIBILITY OF THE CONTRACTOR.
19. ANY BOLT HOLES IN THE WEBS OF FASCIA GIRDERS NOT OTHERWISE FILLED SHALL BE FILLED WITH BUTTON HEAD OR HEX HEAD BOLTS. THE BOLTS SHALL BE TIGHTENED IN ACCORDANCE WITH SUBSECTION 506.19 OF THE STANDARD SPECIFICATIONS.
20. ALL MATERIALS, LABOR, EQUIPMENT, AND INCIDENTALS NECESSARY FOR PLACING THE PILES IN THEIR ACCEPTED FINAL POSITION SHALL BE CONSIDERED INCIDENTAL TO ITEM 505.165 "STEEL PILING, HP 12 X 84." THE CONTRACTOR MAY SUBMIT AN ALTERNATIVE METHOD OF DRIVING FOR APPROVAL BY THE RESIDENT ENGINEER.
21. THE PRE-EXCAVATION OF PILES MAY BE NEEDED ON THIS PROJECT. PAYMENT FOR THIS WORK WILL BE MADE UNDER ITEM 900.640 "SPECIAL PROVISION (OBSTRUCTION REMOVAL FOR DRIVING PILES)".

CONCRETE

22. APPROACH SLABS AND SUBSTRUCTURE CONCRETE BELOW CONSTRUCTION JOINT SHALL BE HIGH PERFORMANCE CLASS B AND SHALL BE PAID FOR UNDER ITEM 501.34 "CONCRETE, HIGH PERFORMANCE CLASS B". THE DECK, INCLUDING SUBSTRUCTURE CONCRETE ABOVE CONSTRUCTION JOINT, SHALL BE HIGH PERFORMANCE CLASS A AND SHALL BE PAID FOR UNDER ITEM 501.33 "CONCRETE, HIGH PERFORMANCE CLASS A".
23. CONCRETE PORTIONS OF ABUTMENTS AND WINGWALLS ABOVE ADJACENT BRIDGE SEAT ELEVATIONS SHALL NOT BE PLACED UNTIL FINISH GRADES HAVE BEEN DETERMINED BY THE RESIDENT ENGINEER.
24. LOADING ALLOWANCE ON THE NEW DECK SHALL BE IN ACCORDANCE WITH SUBSECTION 501.18(B) OF THE STANDARD SPECIFICATIONS.
25. ALL EXPOSED EDGES OF CONCRETE SHALL BE CHAMFERED 1 INCH X 1 INCH.
26. ITEM 514.10 "WATER REPELLENT, SILANE", SHALL BE APPLIED TO ALL EXPOSED CONCRETE SURFACES, EXCEPT THE UNDERSIDE OF THE DECK BETWEEN DRIP NOTCHES.
27. JOINTS AND SCORE MARKS IN CONCRETE SHALL BE CONSTRUCTED AS SHOWN IN THE PLANS OR AS DIRECTED BY THE RESIDENT ENGINEER.
28. THE TOP SURFACE OF THE PILE CAP SHALL BE GIVEN A FLOAT FINISH TO GRADE. THE CONCRETE WITHIN THE REINFORCING CAGE SHALL BE ROUGHENED BY RAKING PARALLEL TO THE FACE OF THE ABUTMENT TO AN AMPLITUDE OF 1/2 INCH. THE CONCRETE OUTSIDE THE REINFORCING CAGE SHALL REMAIN SMOOTH.
29. ALL REINFORCING STEEL ABOVE THE CONSTRUCTION JOINT WILL BE CORROSION PROTECTION LEVEL III AND ALL REINFORCING STEEL BELOW THE CONSTRUCTION JOINT AND IN APPROACH SLABS WILL BE CORROSION PROTECTION LEVEL I. PAYMENT WILL BE MADE UNDER THE APPROPRIATE SECTION 507 CONTRACT ITEM.
30. REINFORCING STEEL PLACEMENT TOLERANCES SHALL BE:
SPACING: +/- 1 INCH
CLEARANCE: +/- 1/4 INCH
31. INDIVIDUAL POUR SEGMENTS ARE TO BE PLACED IN ONE CONTINUOUS POUR WITH A MAXIMUM DURATION OF EIGHT HOURS. IF A POUR SEGMENT CANNOT BE PLACED IN THE EIGHT HOUR PERIOD, A CONSTRUCTION JOINT SHALL BE USED. A 96 HOUR DELAY BETWEEN THE COMPLETION OF ONE DAY'S POUR AND THE BEGINNING OF ANY OTHER ADJACENT POUR SHALL BE OBSERVED.
32. THE ABUTMENT AND WINGWALL CONCRETE ABOVE HORIZONTAL CONSTRUCTION JOINTS SHALL BE PLACED MONOLITHICALLY WITH DECK POURS.

TRAFFIC CONTROL

33. THE CONTRACTOR SHALL BE RESPONSIBLE FOR THE DESIGN AND INSTALLATION OF A SITE SPECIFIC TRAFFIC CONTROL PLAN. THE CONTRACTOR SHALL SUBMIT FOR APPROVAL A DETAILED TRAFFIC CONTROL PLAN TO THE ENGINEER FOR ALL STAGES OF CONSTRUCTION. NO WORK SHALL BEGIN UNTIL THE TRAFFIC CONTROL PLAN HAS BEEN APPROVED. SEE CONTRACT SPECIAL PROVISIONS FOR DETAILS. ALL COSTS SHALL BE INCLUDED IN ITEM 900.645 "SPECIAL PROVISION (TRAFFIC CONTROL, ALL-INCLUSIVE)".

34. ALL WORK ASSOCIATED WITH THE INSTALLATION AND REMOVAL OF THE TEMPORARY BRIDGE AND ITS APPROACHES, INCLUDING TEMPORARY TRAFFIC BARRIER, PAVEMENT, AND PAVEMENT MARKINGS WILL BE INCLUDED IN THE UNIT BID PRICE FOR ITEM 528.11 "TWO-WAY TEMPORARY BRIDGE".
35. ANY TEMPORARY MEANS OF SUPPORTING FILL SHALL BE INCIDENTAL TO THE ITEM 528.11 "TWO-WAY TEMPORARY BRIDGE". CONSTRUCTION DRAWINGS SHALL BE REQUIRED AS PER SUBSECTION 105.03.
36. PAYMENT FOR ALL ON AND OFF-PROJECT CONSTRUCTION SIGNING AND TRAFFIC CONTROL DEVICES, INCLUDING DRUMS AND BARRICADES, WILL BE PAID FOR UNDER ITEM 900.645 "SPECIAL PROVISION (TRAFFIC CONTROL, ALL-INCLUSIVE)".
37. THE CONTRACTOR SHALL ADD SIGN G20-5AP TO THE TOP OF ALL TEMPORARY SPEED LIMIT SIGNS AS DETAILED IN THE MUTCD.
38. TRAFFIC SHALL BE MAINTAINED DURING CONSTRUCTION ON A TWO-WAY TEMPORARY BRIDGE WITH PAVED APPROACHES CONSTRUCTED UPSTREAM OF THE EXISTING STRUCTURE. THE TWO-WAY TEMPORARY BRIDGE WILL BE PAID FOR UNDER ITEM 528.11 "TWO-WAY TEMPORARY BRIDGE".
39. MAINTAIN FULL ACCESS TO ALL SIDE ROADS AND DRIVES WITHIN THE PROJECT LIMITS AT ALL TIMES. IF THE CONTRACTOR MUST RESTRICT ACCESS, THEN THE CONTRACTOR SHALL NOTIFY THE PROPERTY OWNERS IN ADVANCE. THIS WORK SHALL BE CONSIDERED INCIDENTAL TO ITEM 900.645 "SPECIAL PROVISION (TRAFFIC CONTROL, ALL-INCLUSIVE)".
40. FLAGGERS AND UNIFORM TRAFFIC OFFICERS WILL BE PAID FOR SEPARATELY UNDER THEIR INDIVIDUAL PAY ITEM.

PROJECT NAME:	ST. JOHNSBURY
PROJECT NUMBER:	BRF 028-4(25)S
FILE NAME:	s98b320gen.dgn
PROJECT LEADER:	C. CARLSON
DESIGNED BY:	H. SALLS
PROJECT NOTES	
PLOT DATE:	28-AUG-2012
DRAWN BY:	R. PELLETT
CHECKED BY:	C. CARLSON
SHEET	3 OF 62

QUANTITY SHEET 1

SUMMARY OF ESTIMATED QUANTITIES										TOTALS		DESCRIPTIONS				DETAILED SUMMARY OF QUANTITIES		
					ROADWAY	TRAINING	EROSION CONTROL	BRIDGE	FULL C.E. ITEMS	GRAND TOTAL	FINAL	UNIT	ITEMS	ITEM NUMBER	ROUND	QUANTITIES	UNIT	ITEMS
					1					1		LS	CLEARING AND GRUBBING, INCLUDING INDIVIDUAL TREES AND STUMPS	201.10	-			
					3130					3130		CY	COMMON EXCAVATION	203.15	0.78			
								460		460		CY	UNCLASSIFIED CHANNEL EXCAVATION	203.27	8.53			
					1200					1200		CY	SAND BORROW	203.31	8.6			
							10			10		CY	TRENCH EXCAVATION OF EARTH	204.20	EST.			
					1					1		CY	TRENCH EXCAVATION OF EARTH, EXPLORATORY (N.A.B.I.)	204.22	EST.			
								230		230		CY	STRUCTURE EXCAVATION	204.25	8.45			
								80		80		CY	GRANULAR BACKFILL FOR STRUCTURES	204.30	2.72			
					350					350		SY	COLD PLANING, BITUMINOUS PAVEMENT	210.10	4.56			
					2250					2250		CY	SUBBASE OF DENSE GRADED CRUSHED STONE	301.35	5.71			
					90					90		CY	AGGREGATE SURFACE COURSE	401.10	9.54			
					9			0.4		9.4		CWT	EMULSIFIED ASPHALT	404.65	0.19			
					1					1		LU	PRICE ADJUSTMENT, ASPHALT CEMENT (N.A.B.I.)	406.50	-			
								171		171		CY	CONCRETE, HIGH PERFORMANCE CLASS A	501.33	0.87			
								99		99		CY	CONCRETE, HIGH PERFORMANCE CLASS B	501.34	1.74			
								1		1		LS	FURNISHING EQUIPMENT FOR DRIVING PILING	504.10	-			
								545		545		LF	STEEL PILING, HP 12 X 84	505.165	EST.			
								2		2		EACH	DYNAMIC PILE LOADING TEST	505.45	-			
								119500		119500		LB	STRUCTURAL STEEL, PLATE GIRDER	506.55	6.95			
								13370		13370		LB	REINFORCING STEEL, LEVEL I	507.11	32.65			
								29910		29910		LB	REINFORCING STEEL, LEVEL III	507.13	20.4			
								1		1		LS	SHEAR CONNECTORS (1740- 7/8" X 7")	508.15	-			
								370		370		SY	LONGITUDINAL DECK GROOVING	509.10	0.22			
								55		55		GAL	WATER REPELLENT, SILANE	514.10	1.54			
								64		64		LF	BRIDGE EXPANSION JOINT, ASPHALTIC PLUG	516.10	-			
								64		64		LF	JOINT SEALER, HOT POURED	524.11	-			
								212		212		LF	BRIDGE RAILING, GALVANIZED 3 RAIL BOX BEAM	525.335	0.34			
					1					1		LS	TWO-WAY TEMPORARY BRIDGE (2400 SF - EST.)	528.11	-			
								1		1		EACH	PARTIAL REMOVAL OF STRUCTURE	529.20	-			
					1					1		EACH	CHANGING ELEVATION OF DROP INLETS, CATCH BASINS, OR MANHOLES	604.40	-			
					10					10		HR	ALL PURPOSE EXCAVATOR RENTAL, TYPE I	608.25	EST.			
					90					90		CY	STONE FILL, TYPE I	613.10	0.09			
								450		450		CY	STONE FILL, TYPE III	613.12	8.97			
					245					245		LF	BOX BEAM GUARDRAIL	621.30	0.17			
					4					4		EACH	GUARDRAIL APPROACH SECTION, GALVANIZED 3 RAIL BOX BEAM	621.725	-			
					290					290		LF	REMOVAL AND DISPOSAL OF GUARDRAIL	621.80	3.04			
					100					100		HR	UNIFORMED TRAFFIC OFFICERS	630.10	EST.			
					1120					1120		HR	FLAGGERS	630.15	EST.			
									1	1		LS	FIELD OFFICE, ENGINEERS	631.10	-			
									1	1		LS	TESTING EQUIPMENT, CONCRETE	631.16	-			

PROJECT NAME: **ST. JOHNSBURY**
PROJECT NUMBER: **BRF 028-4(25)S**
FILE NAME: s98b320qs.dgn PLOT DATE: 08/27/2012
PROJECT LEADER: C. CARLSON DRAWN BY: R. PELLETT
DESIGNED BY: H. SALLS CHECKED BY: G. ROY
QUANTITY SHEET #1 SHEET 4 OF 62


QUANTITY SHEET 2

SUMMARY OF ESTIMATED QUANTITIES										TOTALS		DESCRIPTIONS				DETAILED SUMMARY OF QUANTITIES			
						ROADWAY	TRAINING	EROSION CONTROL	BRIDGE	FULL C.E. ITEMS	GRAND TOTAL	FINAL	UNIT	ITEMS	ITEM NUMBER	ROUND	QUANTITIES	UNIT	ITEMS
										1	1		LS	TESTING EQUIPMENT, BITUMINOUS	631.17	-			
										3000	3000		DL	FIELD OFFICE TELEPHONE (N.A.B.I.)	631.26	-			
							520				520		HR	EMPLOYEE TRAINEESHIP	634.10	-			
						1					1		LS	MOBILIZATION/DEMOBILIZATION	635.11	-			
						1550					1550		LF	DURABLE 4 INCH WHITE LINE	646.400	-			
						1550					1550		LF	DURABLE 4 INCH YELLOW LINE	646.410	-			
						300			680		980		SY	GEOTEXTILE UNDER STONE FILL	649.31	16.34			
								170			170		SY	GEOTEXTILE FOR SILT FENCE	649.51	5.99			
								80			80		SY	GEOTEXTILE FOR SILT FENCE, WOVEN WIRE REINFORCED	649.515	8.3			
								330			330		SY	GEOTEXTILE FOR FILTER CURTAIN	649.61	7.35			
								10			10		LB	SEED	651.15	5.8			
								10			10		LB	SEED, WINTER RYE	651.17	5.8			
								40			40		LB	FERTILIZER	651.18	5			
								1			1		TON	AGRICULTURAL LIMESTONE	651.20	0.86			
								1			1		TON	HAY MULCH	651.25	0.86			
								20			20		CY	TOPSOIL	651.35	0.22			
									140		140		SY	GRUBBING MATERIAL	651.40	4.21			
								1			1		LS	EPSC PLAN	652.10	-			
								50			50		HR	MONITORING EPSC PLAN	652.20	-			
								1			1		LU	MAINTENANCE OF EPSC PLAN (N.A.B.I.)	652.30	-			
								400			400		SY	TEMPORARY EROSION MATTING	653.20	2.75			
								50			50		CY	TEMPORARY STONE CHECK DAM, TYPE I	653.25	8.18			
								20			20		CY	VEHICLE TRACKING PAD	653.35	EST.			
								3			3		EACH	INLET PROTECTION DEVICE, TYPE I	653.40	-			
								730			730		LF	BARRIER FENCE	653.50	7.72			
								700			700		LF	PROJECT DEMARCATION FENCE	653.55	5.1			
						10.15					10.15		SF	TRAFFIC SIGNS, TYPE A	675.20	-			
						30					30		LF	FLANGED CHANNEL SIGN POST	675.301	-			
						30					30		LF	SQUARE TUBE SIGN POST AND ANCHOR	675.341	-			
						5					5		EACH	REMOVING SIGNS	675.50	-			
						1					1		LU	PRICE ADJUSTMENT, FUEL (N.A.B.I.)	690.50	-			
									150		150		LF	SPECIAL PROVISION (OBSTRUCTION REMOVAL FOR DRIVING PILES)	900.640	6.85			
									1		1		LS	SPECIAL PROVISION (QC/QA CLEANING AND PAINTING STRUCTURAL COMPONENTS)	900.645	-			
						1					1		LS	SPECIAL PROVISION (TRAFFIC CONTROL, ALL-INCLUSIVE)	900.645	-			
						1					1		LU	SPECIAL PROVISION (MAT DENSITY PAY ADJUSTMENT, SMALL QUANTITY)(N.A.B.I.)	900.650	-			
						1					1		LU	SPECIAL PROVISION (MXTURE PAY ADJUSTMENT)(N.A.B.I.)	900.650	-			
						890			24		914		TON	SPECIAL PROVISION (BITUMINOUS CONCRETE PAVEMENT, SMALL QUANTITY)	900.680	3.69			


PROJECT NAME: **ST. JOHNSBURY**
 PROJECT NUMBER: **BRF 028-4(25)S**
 FILE NAME: s98b320qs.dgn
 PROJECT LEADER: C. CARLSON
 DESIGNED BY: H. SALLS
 QUANTITY SHEET #2
 PLOT DATE: 08/27/2012
 DRAWN BY: R. PELLETT
 CHECKED BY: G. ROY
 SHEET 5 OF 62

BRIDGE QUANTITY SHEET 1


SUMMARY OF BRIDGE QUANTITIES										TOTALS		DESCRIPTIONS			DETAILED SUMMARY OF QUANTITIES		
						SUPERSTRUC- TURE	APPROACH SLAB 1	APPROACH SLAB 2	ABUTMENT 1	ABUTMENT 2	BRIDGE TOTAL	UNIT	ITEMS	ITEM NUMBER	QUANTITIES	UNIT	ITEMS
									210	250	460	CY	UNCLASSIFIED CHANNEL EXCAVATION	203.27			
									100	130	230	CY	STRUCTURE EXCAVATION	204.25			
									40	40	80	CY	GRANULAR BACKFILL FOR STRUCTURES	204.30			
							0.2	0.2			0.4	CWT	EMULSIFIED ASPHALT	404.65			
						105			33	33	171	CY	CONCRETE, HIGH PERFORMANCE CLASS A	501.33			
							30	30	21	18	99	CY	CONCRETE, HIGH PERFORMANCE CLASS B	501.34			
									0.5	0.5	1	LS	FURNISHING EQUIPMENT FOR DRIVING PILING	504.10			
									275	270	545	LF	STEEL PILING, HP 12 X 84	505.165			
									1	1	2	EACH	DYNAMIC PILE LOADING TEST	505.45			
						119500					119500	LB	STRUCTURAL STEEL, PLATE GIRDER	506.55			
							3620	3620	3190	2940	13370	LB	REINFORCING STEEL, LEVEL I	507.11			
						26470	180	180	1540	1540	29910	LB	REINFORCING STEEL, LEVEL III	507.13			
						1					1	LS	SHEAR CONNECTORS (1740- 7/8" X 7")	508.15			
						370					370	SY	LONGITUDINAL DECK GROOVING	509.10			
						42			7	6	55	GAL	WATER REPELLENT, SILANE	514.10			
							32	32			64	LF	BRIDGE EXPANSION JOINT, ASPHALTIC PLUG	516.10			
							32	32			64	LF	JOINT SEALER, HOT Poured	524.11			
						212					212	LF	BRIDGE RAILING, GALVANIZED 3 RAIL BOX BEAM	525.335			
						1					1	EACH	PARTIAL REMOVAL OF STRUCTURE	529.20			
									190	260	450	CY	STONE FILL, TYPE III	613.12			
									280	400	680	SY	GEOTEXTILE UNDER STONE FILL	649.31			
									50	90	140	SY	GRUBBING MATERIAL	651.40			
									100	50	150	LF	SPECIAL PROVISION (OBSTRUCTION REMOVAL FOR DRIVING PILES)	900.640			
						1					1	LS	SPECIAL PROVISION (QC/QA CLEANING AND PAINTING STRUCTURAL COMPONENTS)	900.645			
							12	12			24	TON	SPECIAL PROVISION (BITUMINOUS CONCRETE PAVEMENT, SMALL QUANTITY)	900.680			

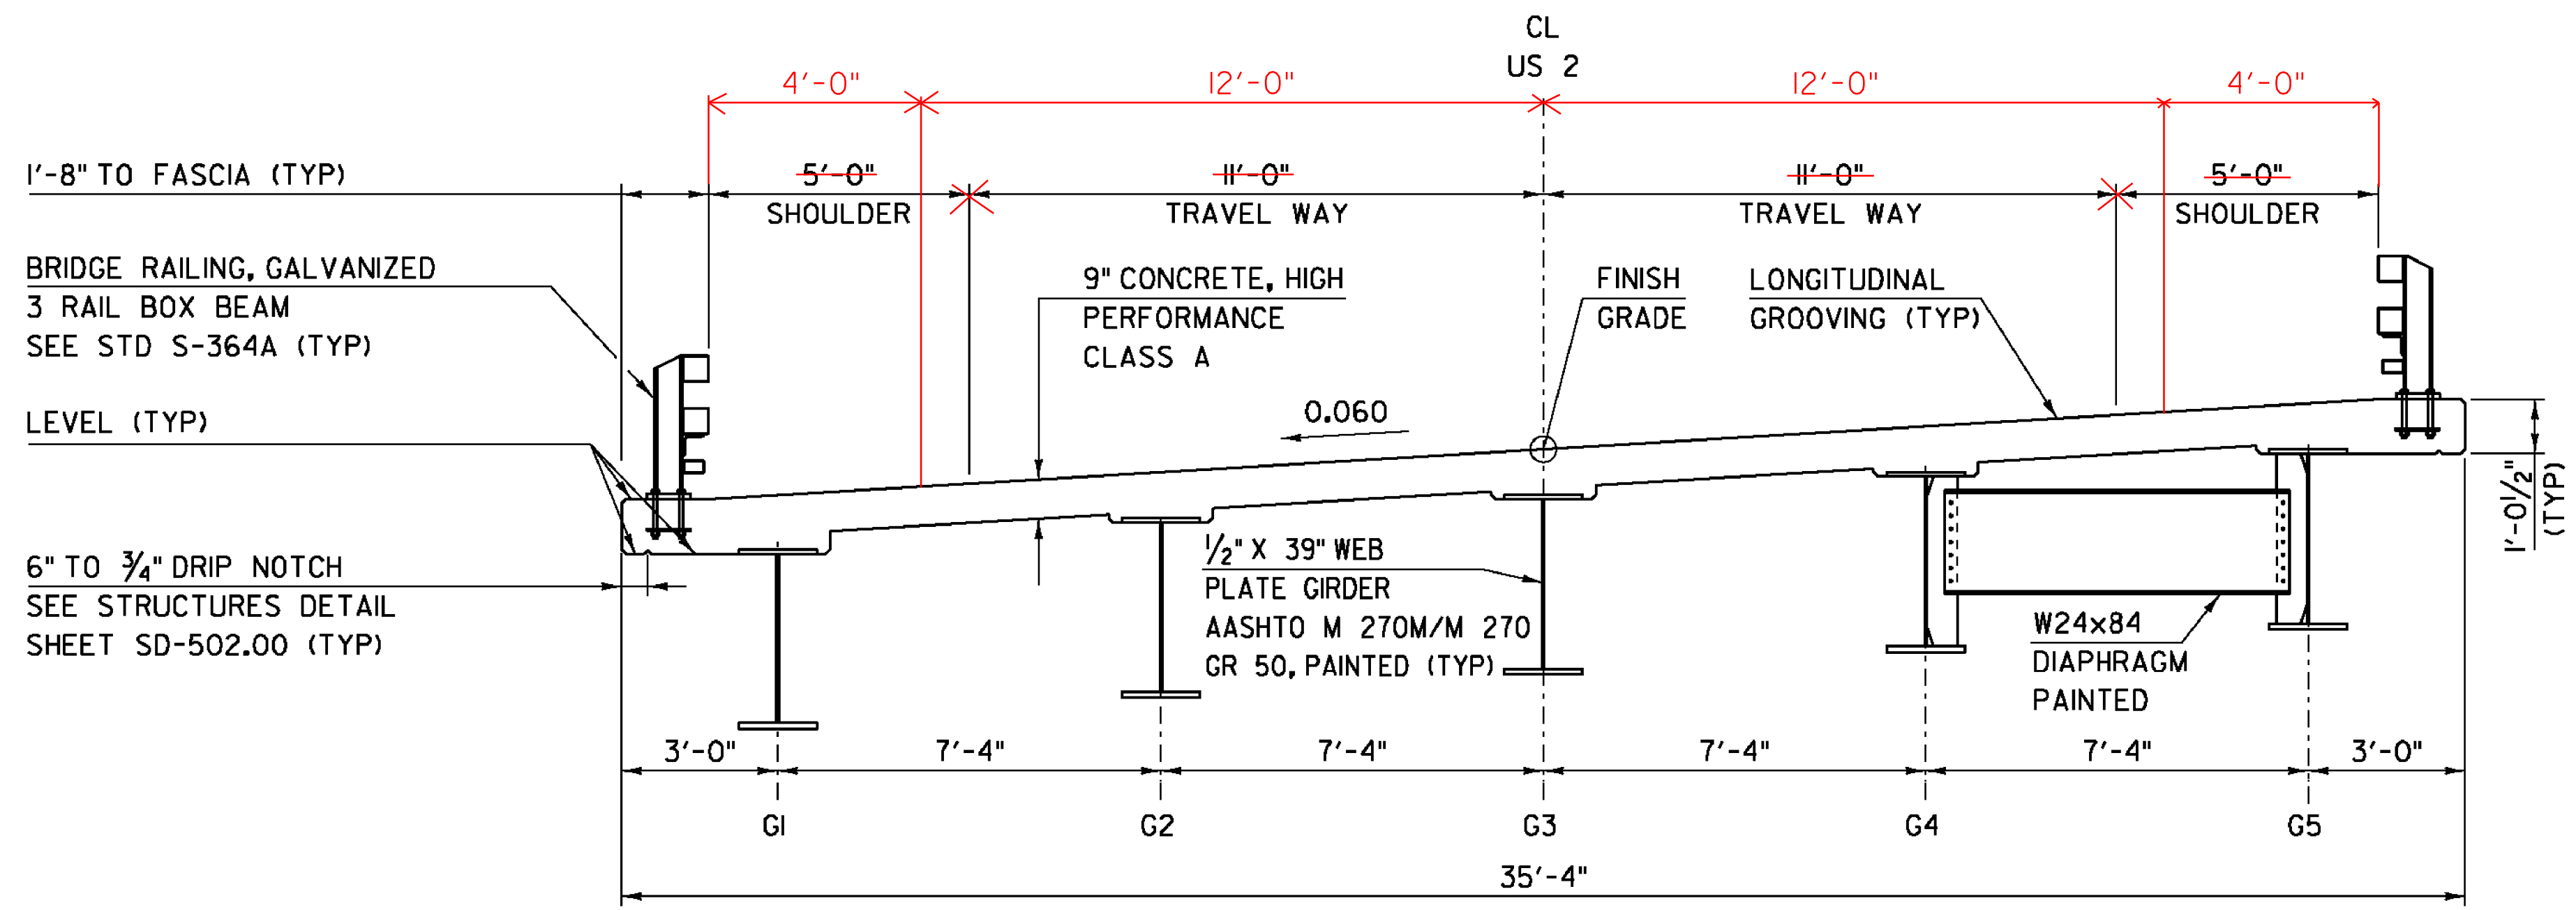


BRIDGE TYPICAL SECTION
SCALE 3/8" = 1'-0"

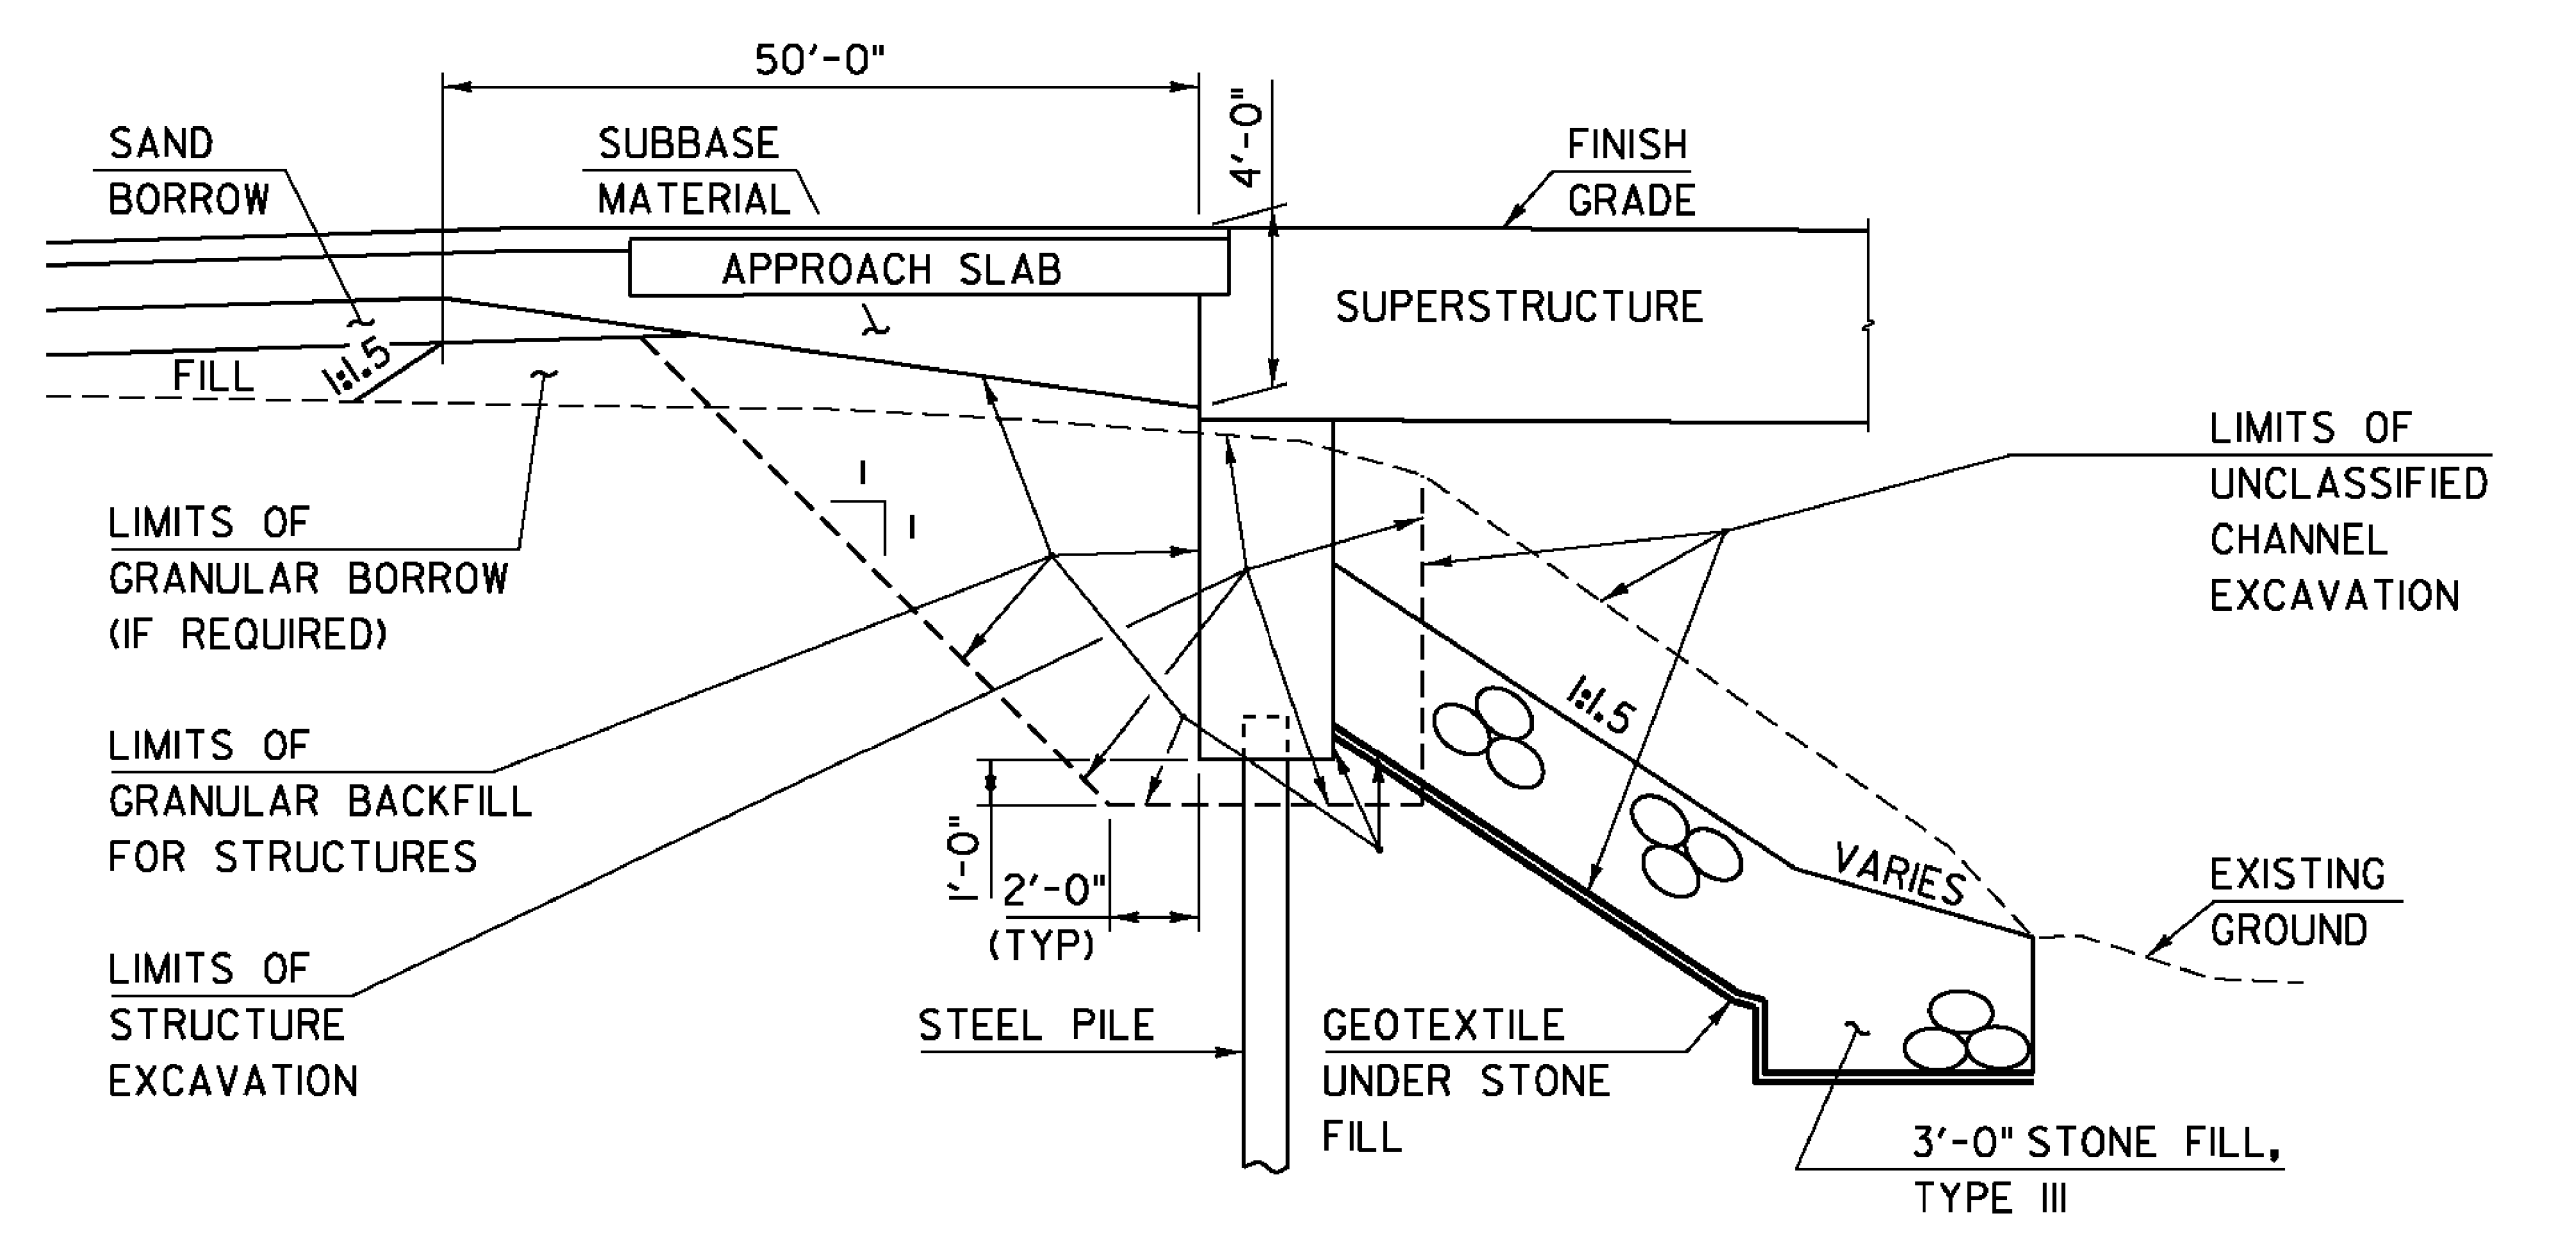

ABUTMENT EARTHWORK TYPICAL SECTION
NTS

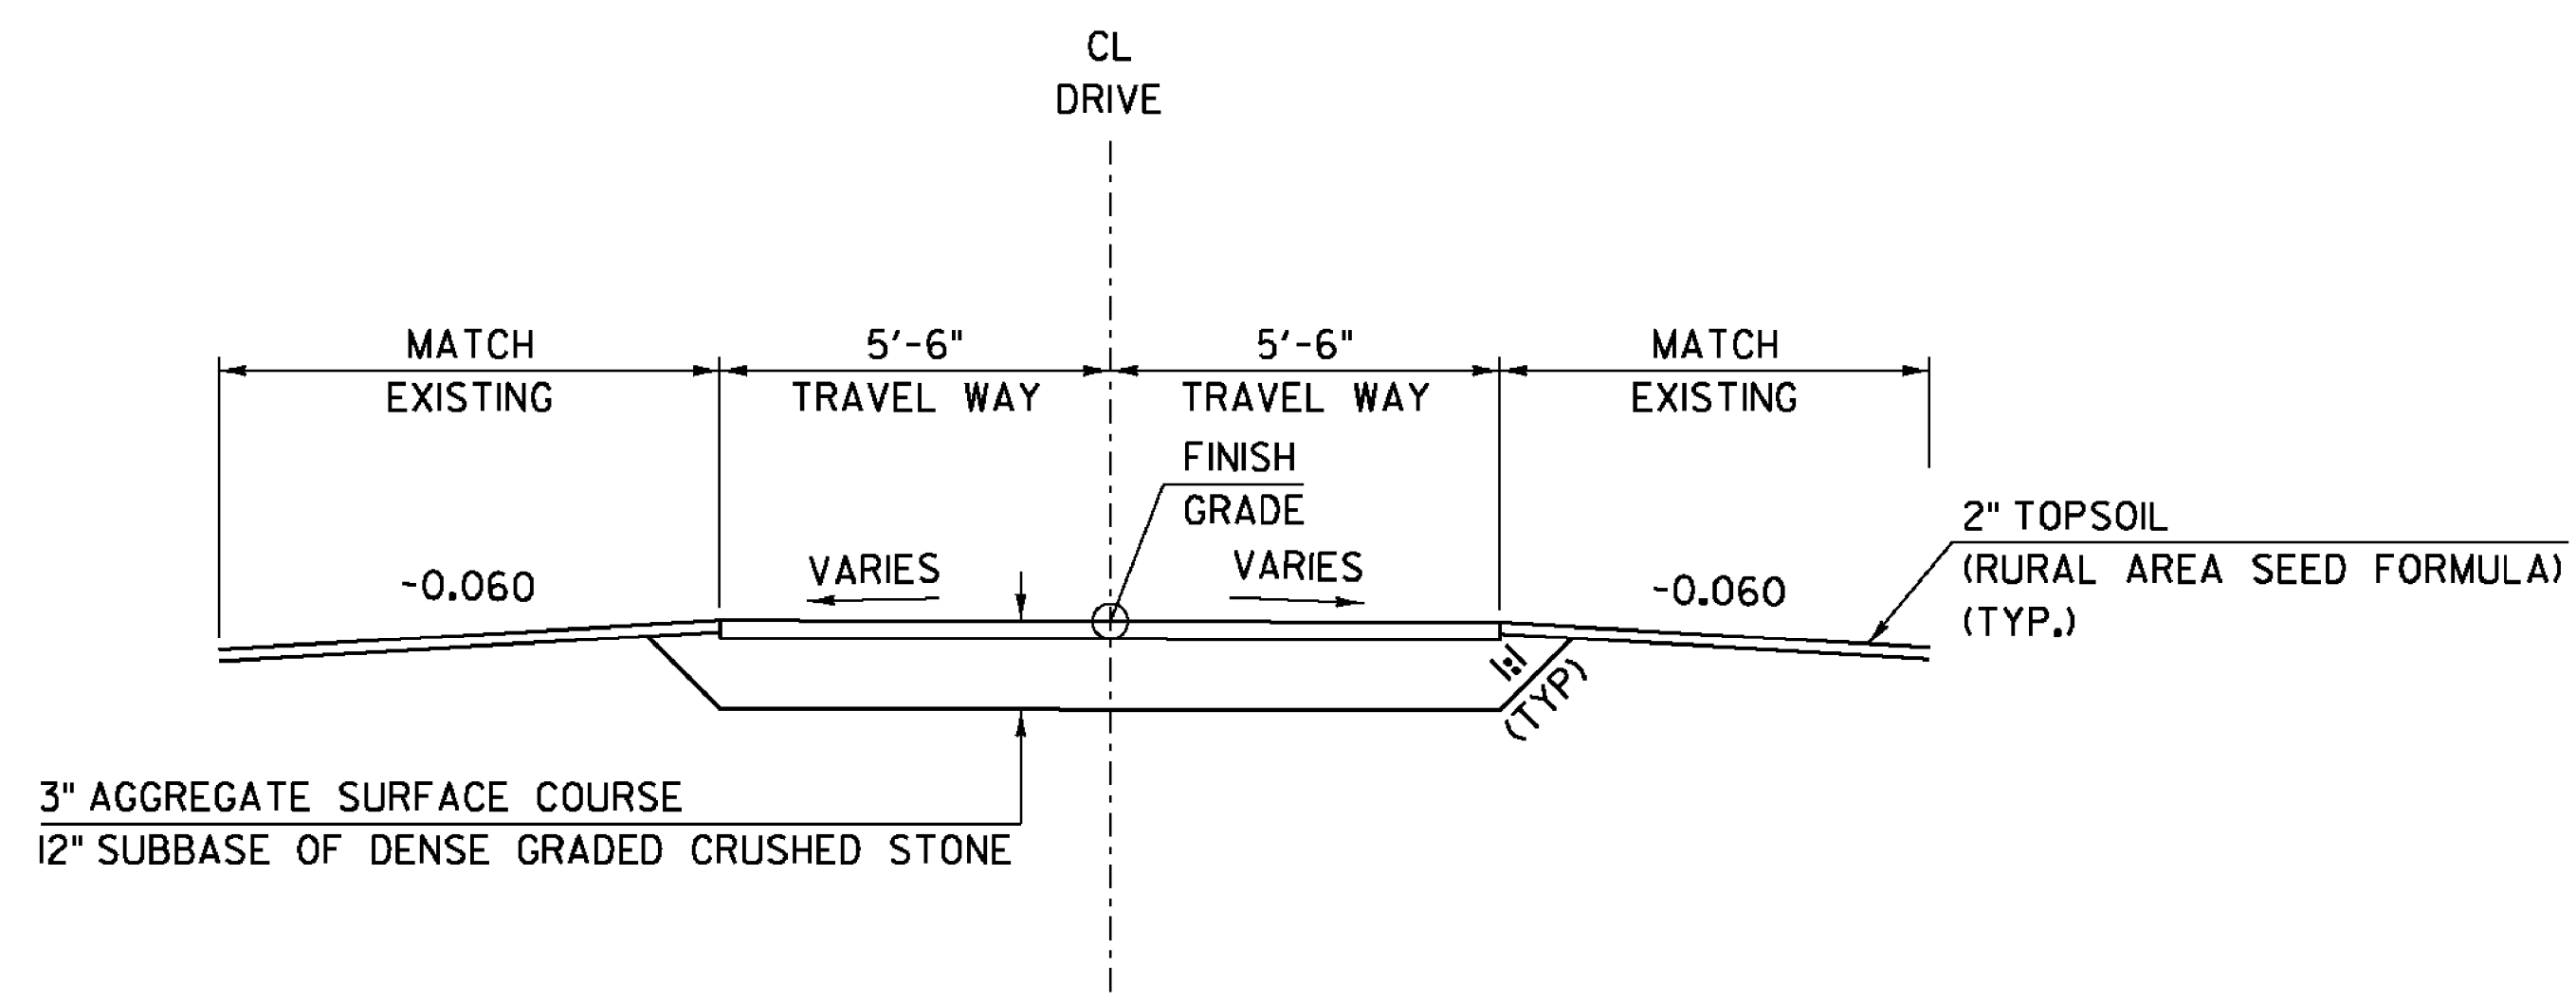

DRIVE TYPICAL SECTION
SCALE 3/8" = 1'-0"

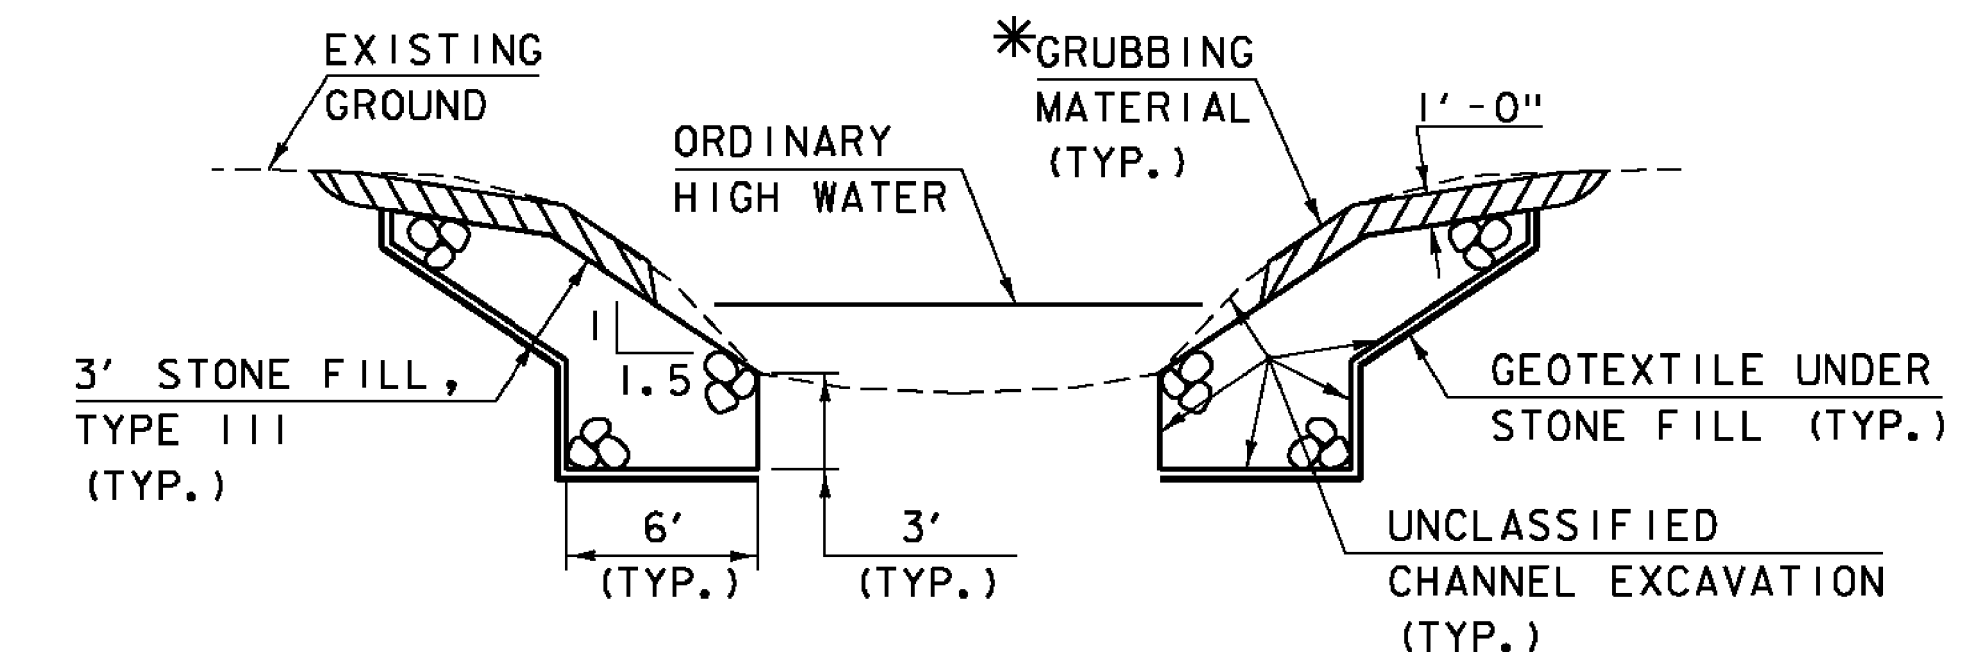

TYPICAL CHANNEL SECTION
NTS

*GRUBBING MATERIAL SHALL NOT BE PLACED ON THE STONE FILL IN THE AREA UNDER THE BRIDGE. WHENEVER CHANNEL SLOPE INTERSECTS ROADWAY SUBBASE, GRUBBING MATERIAL SHALL BEGIN AT THE BOTTOM OF SUBBASE.

PROJECT NAME:	ST. JOHNSBURY	PLOT DATE:	28-AUG-2012
PROJECT NUMBER:	BRF 028-4(25)S	DRAWN BY:	C. MOONEY
FILE NAME:	s98b320typ.dgn	DESIGNED BY:	H. SALLS
PROJECT LEADER:	C. CARLSON	CHECKED BY:	C. CARLSON
BRIDGE TYPICAL SECTION			SHEET 7 OF 62

GPS CONTROL POINTS

OLCOTT

NORTH = 711607.222
 EAST = 1786695.475
 ELEV. = 895.667





GENERAL LOCATION, EAST ST. JOHNSBURY, VT. OWNERSHIP, LEN OLCOTT, P.O. BOX 40, EAST ST. JOHNSBURY, VT 05838. PHONE (802) 748-9475.
 TO REACH FROM THE INTERSECTION OF U.S. ROUTE 2 AND VT ROUTE 18 EAST OF ST. JOHNSBURY GO EAST ALONG U.S. ROUTE 2 FOR 1.8 MI (2.9 KM) TO THE INTERSECTION OF SEVERANCE HILL ROAD LEFT. CONTINUE STRAIGHT AHEAD AND GO EAST ALONG U.S. ROUTE 2 FOR 0.1 MI (0.2 KM) TO THE INTERSECTION OF A GRAVEL DRIVE LEFT JUST WEST OF THE GROVE CEMETERY. TURN LEFT AND GO NORTH ALONG THE GRAVEL DRIVE FOR 0.1 MI (0.2 KM) TO THE OLCOTT RESIDENCE AND SITE OF MARK NORTH OF THE HOUSE AND JUST NORTH OF THE NORTH EDGE OF A LAWN. THE MARK IS SET IN THE TOP OF THE SOUTH END OF A MASSIVE ROCK OUTCROP. IT IS 22.8 M (74.8 FT) NORTH OF THE NORTHWEST CORNER OF THE PORCH, 27.4 M (89.9 FT) NORTHWEST OF THE NORTHEAST CORNER OF THE HOUSE, AND 36.7 M (120.4 FT) WEST OF A WIRE FENCE SEPERATING THE OLCOTT PROPERTY AND THE GROVE CEMETERY.

OLCOTT AZ MK

NORTH = 709931.612
 EAST = 1785554.372
 ELEV. = 800.425

GENERAL LOCATION, EAST ST. JOHNSBURY, VT. TO REACH FROM THE INTERSECTION OF U.S. ROUTE 2 AND VT ROUTE 18 EAST OF ST. JOHNSBURY GO EAST ALONG U.S. ROUTE 2 FOR 1.6 MI (2.6 KM) TO A SMALL ROCK CUT ON THE LEFT AND THE SITE OF THE MARK ON THE LEFT AT THE NORTHEAST END OF ROCK CUT. IT IS 0.2 MI (0.3 KM) SOUTHWEST ALONG U.S. ROUTE 2 FROM THE INTERSECTION OF U.S. ROUTE 2 AND SEVERANCE HILL ROAD. THE MARK IS 7.0 M (23.0 FT) NORTHWEST OF AND ABOUT 1.2 M (3.9 FT) HIGHER THAN THE CENTERLINE OF U.S. ROUTE 2, 51.1 M (167.7 FT) SOUTHWEST OF THE CENTERLINE OF A GATED GRAVEL ROAD, 29.8 M (97.8 FT) SOUTHWEST OF POLE NO. 139, 0.6 M (2.0 FT) NORTHWEST OF THE SOUTHEAST FACE OF THE ROCK CUT, AND 1.0 M (3.3 FT) SOUTHEAST OF A FIBERGLASS WITNESS POST.

TRAVERSE TIES

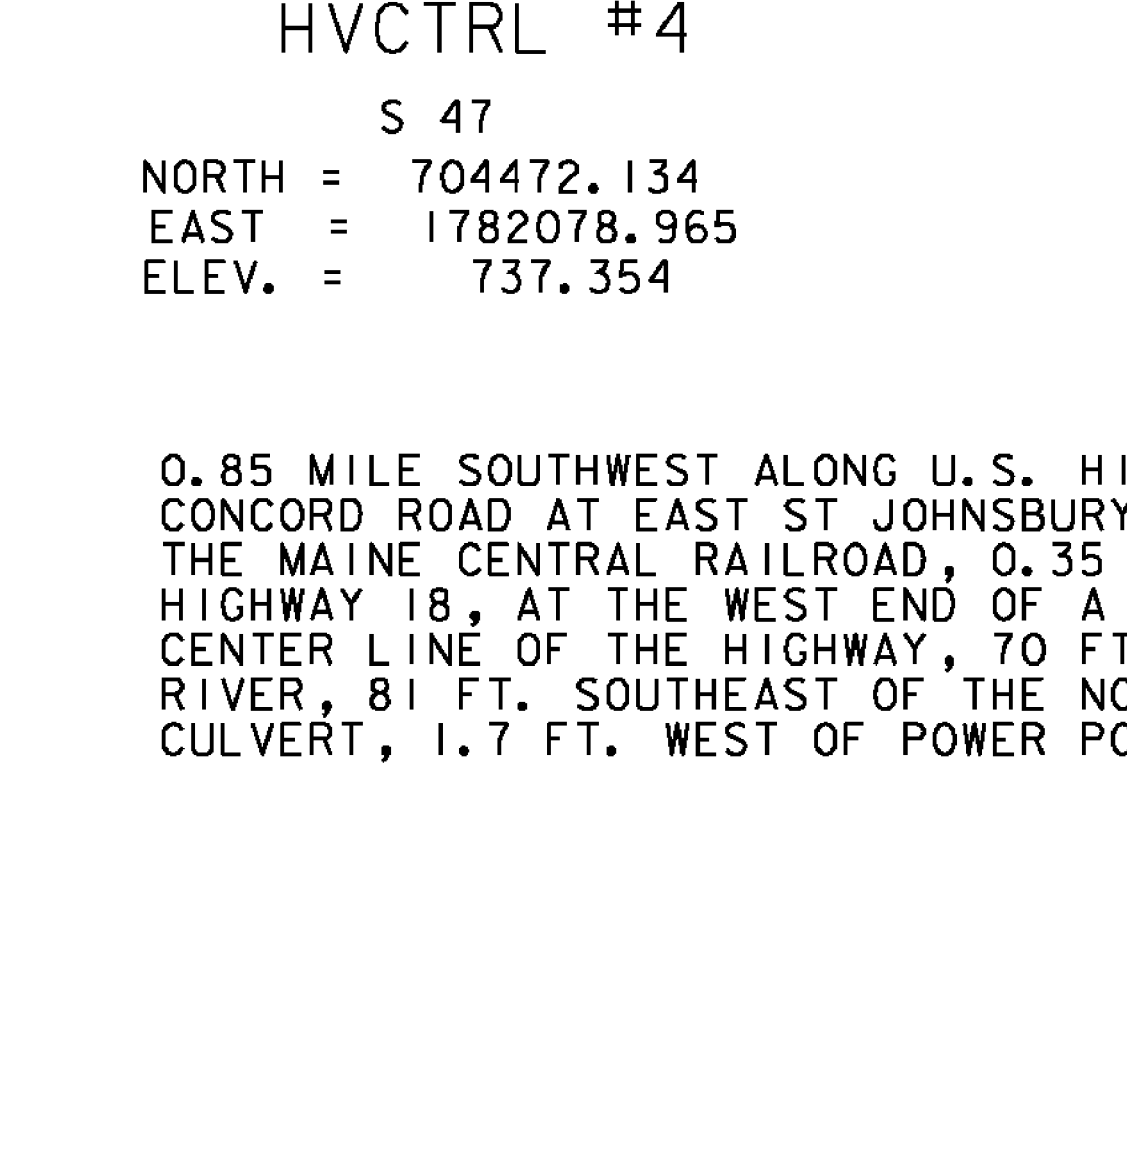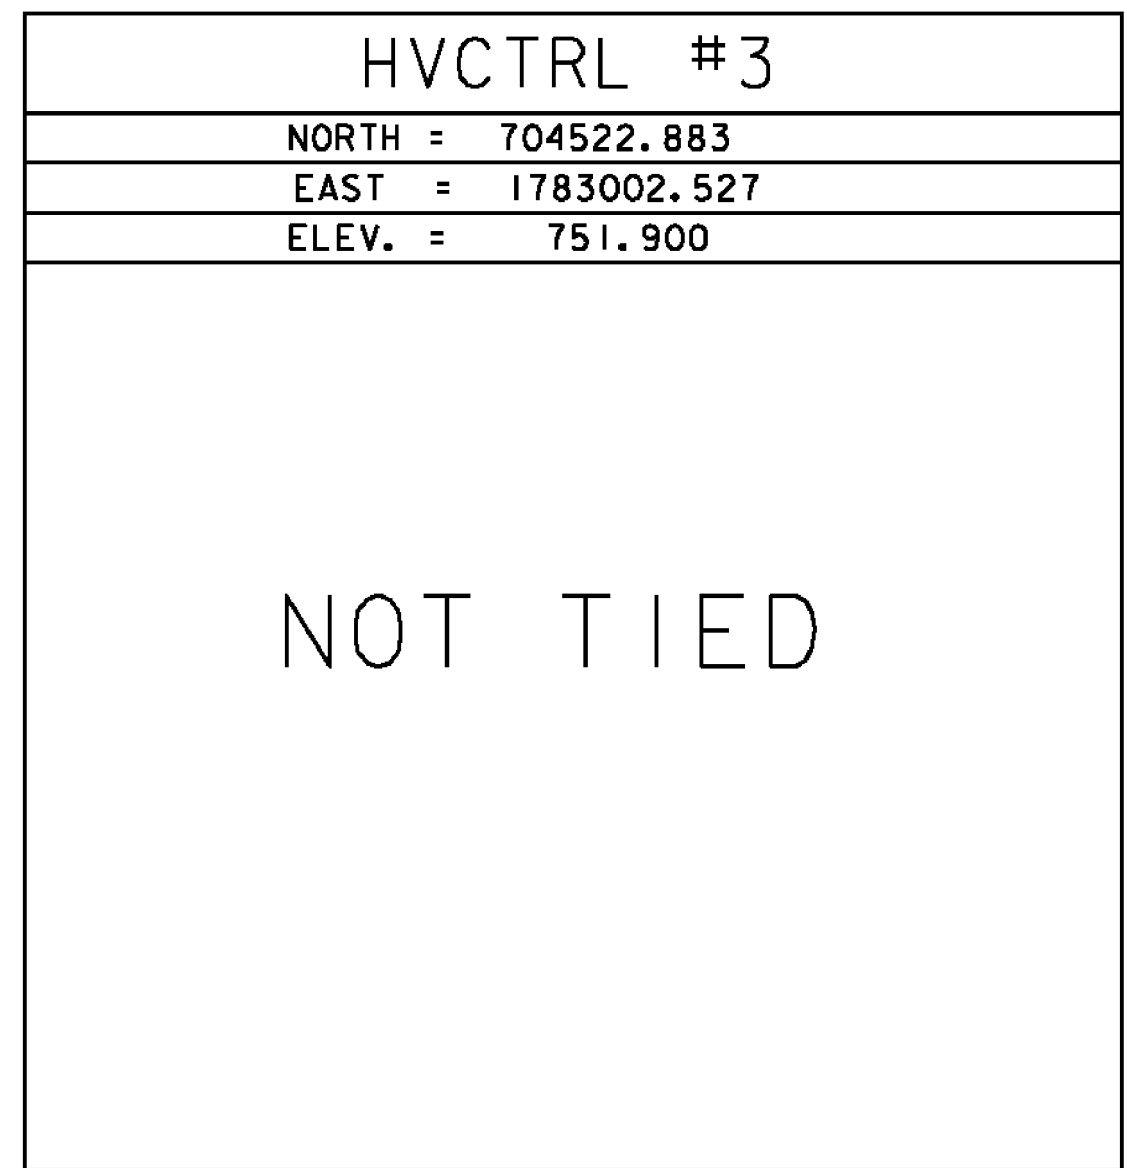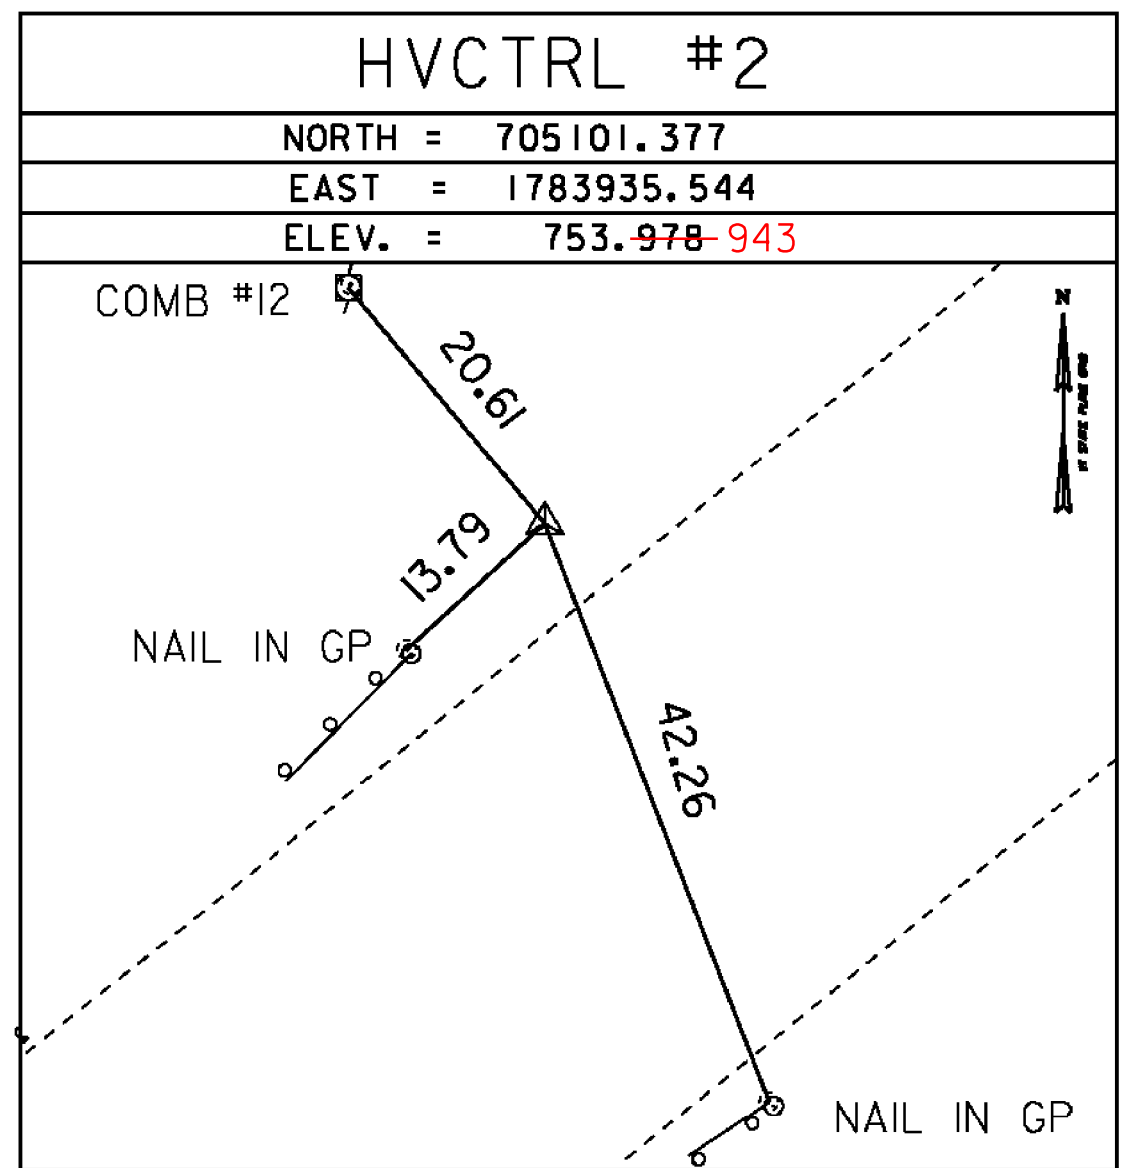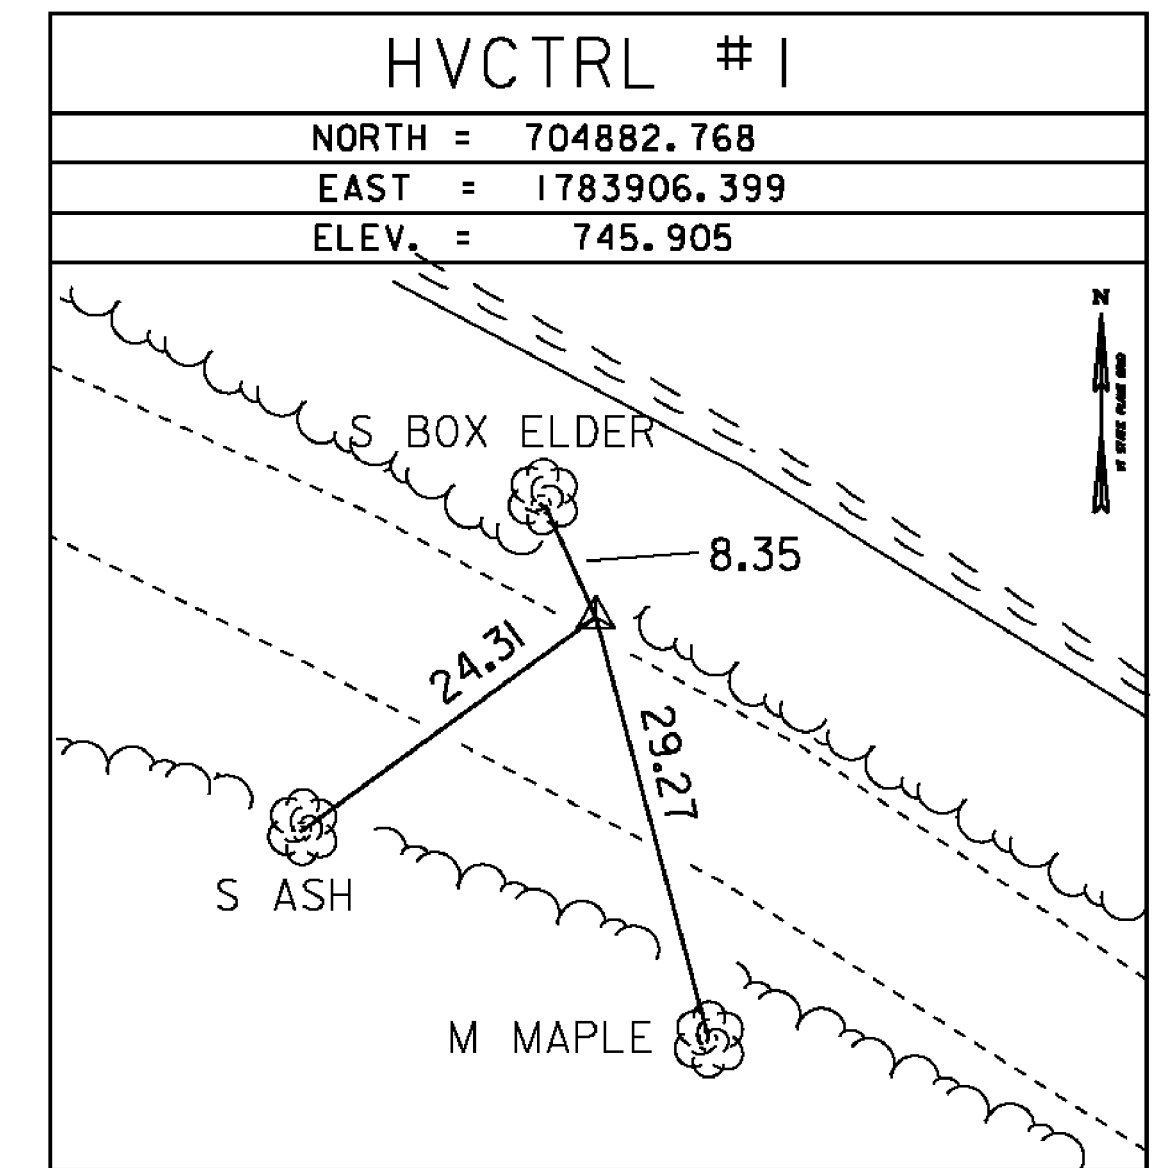



* MAIN TRAVERSE COMPLETED: NOV 10 1998 BY R. GILMAN PC, T. COMPANION

ALIGNMENT DATA

	US 2			DRIVE 1			DRIVE 2			
	STATION	NORTHING	EASTING	STATION	NORTHING	EASTING	STATION	NORTHING	EASTING	
POB	374+86.12	704724.9597	1783378.9489	29+99.95	704921.3301	1783746.3975	40+00.00	704921.3301	1783746.3975	
PC	378+37.84	704888.1126	1783690.5441	30+13.98	704909.6839	1783754.2073	40+12.46	704910.9813	1783753.3373	
PI	379+00.03	704916.9560	1783745.6302	30+29.61	704896.6992	1783762.9147	40+33.05	704893.8826	1783764.8035	
	Radius:		600.00	Radius:		24.00	Radius:		24.00	
	Delta:		11°50'00" Left	Delta:		66°09'42" Right	Delta:		81°14'47" Left	
	Degree of Curvature (Arc):		9°32'57"	Degree of Curvature (Arc):		238°43'57"	Degree of Curvature (Arc):		238°43'57"	
	Length:		123.92	Length:		27.71	Length:		34.03	
	Tangent:		62.18	Tangent:		15.63	Tangent:		20.59	
	Chord:		123.70	Chord:		26.20	Chord:		31.25	
	Middle Ordinate:		3.20	Middle Ordinate:		3.89	Middle Ordinate:		5.78	
	External:		3.21	External:		4.64	External:		7.62	
PT	379+61.76	704956.4826	1783793.6308	PT	30+41.69	704883.4868	PT	40+46.49	704902.6131	
PC	384+11.77	705242.5425	1784141.0178	POE	30+71.49	704858.3047	1783738.6275	PI	40+66.25	704910.9908
PI	385+34.18	705320.3555	1784235.5129							
	Radius:		1146.30				Radius:		60.00	
	Delta:		12°11'26" Left				Delta:		36°26'57" Right	
	Degree of Curvature (Arc):		4°59'54"				Degree of Curvature (Arc):		95°29'35"	
	Length:		243.90				Length:		38.17	
	Tangent:		122.41				Tangent:		19.76	
	Chord:		243.44				Chord:		37.53	
	Middle Ordinate:		6.48				Middle Ordinate:		3.01	
	External:		6.52				External:		3.17	
PT	386+55.67	705416.3681	1784311.4456	PT	40+84.66	704907.1004	1783820.7079			
POE	386+81.31	705436.4808	1784327.3520	POE	41+13.82	704901.3588	1783849.2927			

DATUM	
VERTICAL	NAVD 88
HORIZONTAL	NAD-83(96)
ADJUSTMENT	COMPASS

PROJECT NAME:	ST. JOHNSBURY
PROJECT NUMBER:	BRF 028-4(25)S
FILE NAME:	s98b320tie.dgn
PROJECT LEADER:	C. CARLSON
DESIGNED BY:	H. SALLS
TIE SHEET	
PLOT DATE:	28-AUG-2012
DRAWN BY:	R. BULLOCK
CHECKED BY:	C. CARLSON
SHEET	9 OF 62

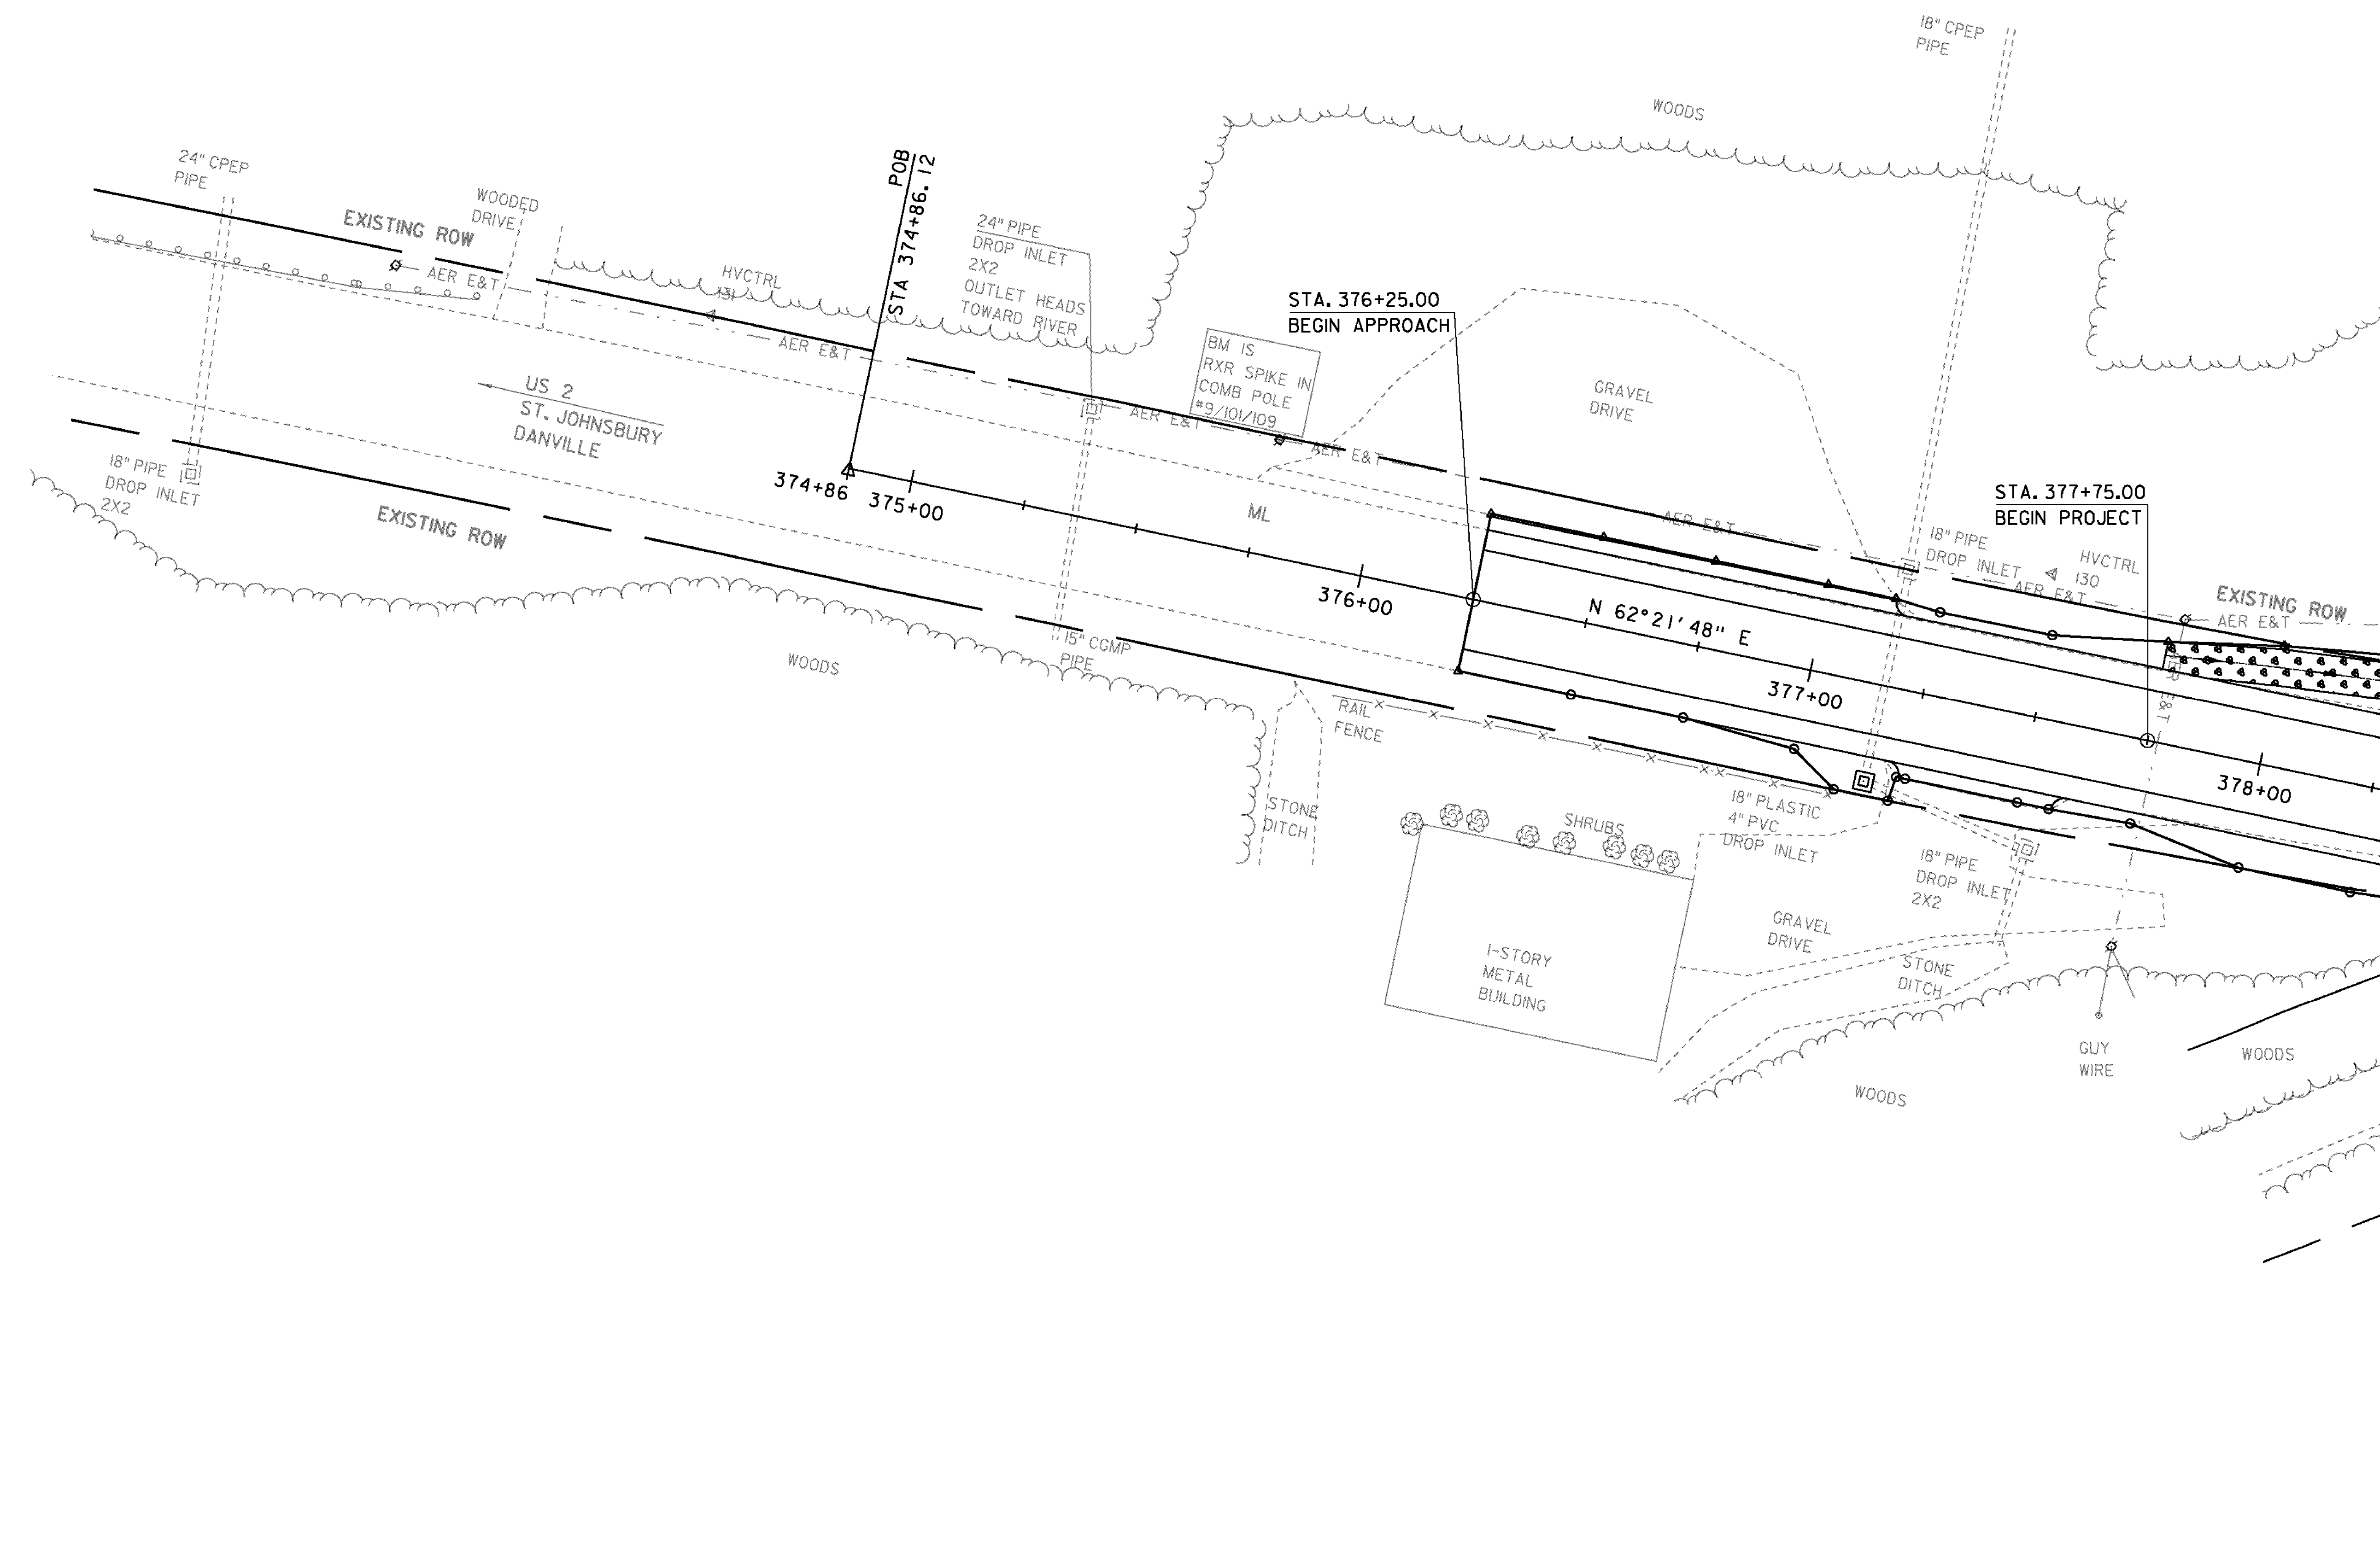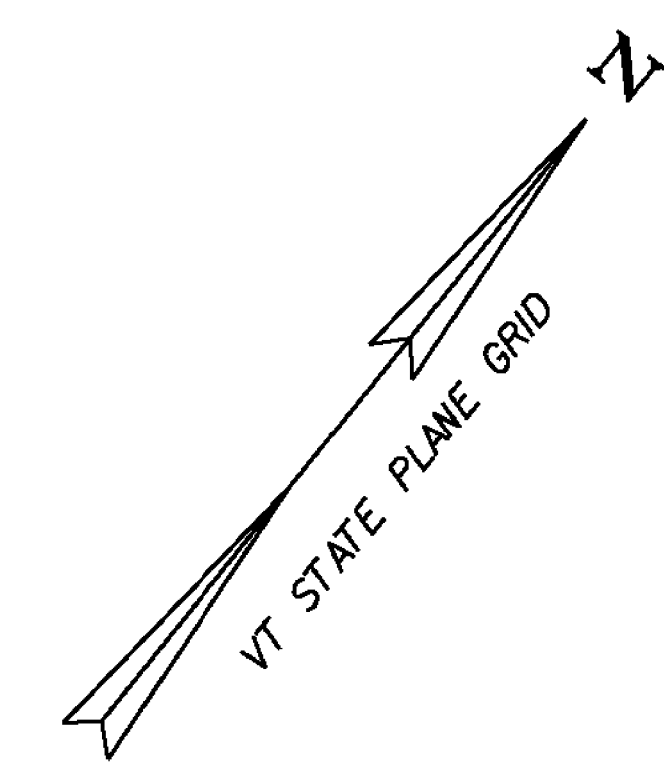

MATCH LINE - STA. 378+30.00

NO WORK NEEDED
~~CHANGING ELEVATION OF DROP INLET,
 CATCH BASIN OR MANHOLE
 STA. 377+16.30 RT.~~



CONSTRUCT 3'-0" PAVED APRON
 STA. 376+25 TO STA. 377+18 LT
 STA. 377+20 TO STA. 377+60 RT

CONSTRUCT STONE-LINED DITCH, TYPE I
 STA. 377+75 TO STA. 378+30 LT

SCALE 1" = 20'-0"
 20 0 20



PROJECT NAME: ST. JOHNSBURY	
PROJECT NUMBER: BRF 028-4(25)S	
FILE NAME: s98b320bdr.dgn	PLOT DATE: 28-AUG-2012
PROJECT LEADER: C. CARLSON	DRAWN BY: C. MOONEY
DESIGNED BY: H. SALLS	CHECKED BY: C. CARLSON
LAYOUT 1	SHEET 10 OF 62

MAINLINE PROFILE I

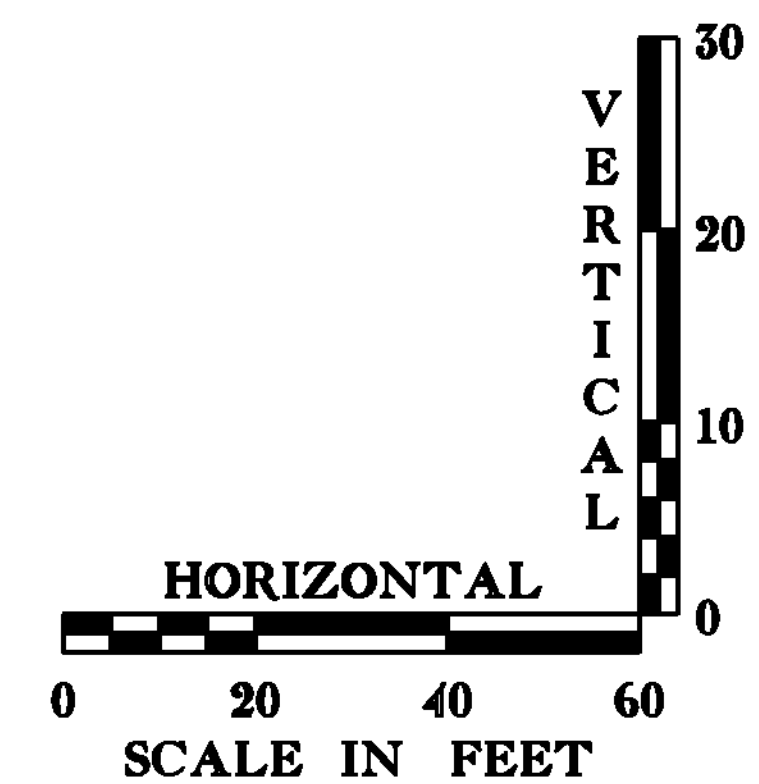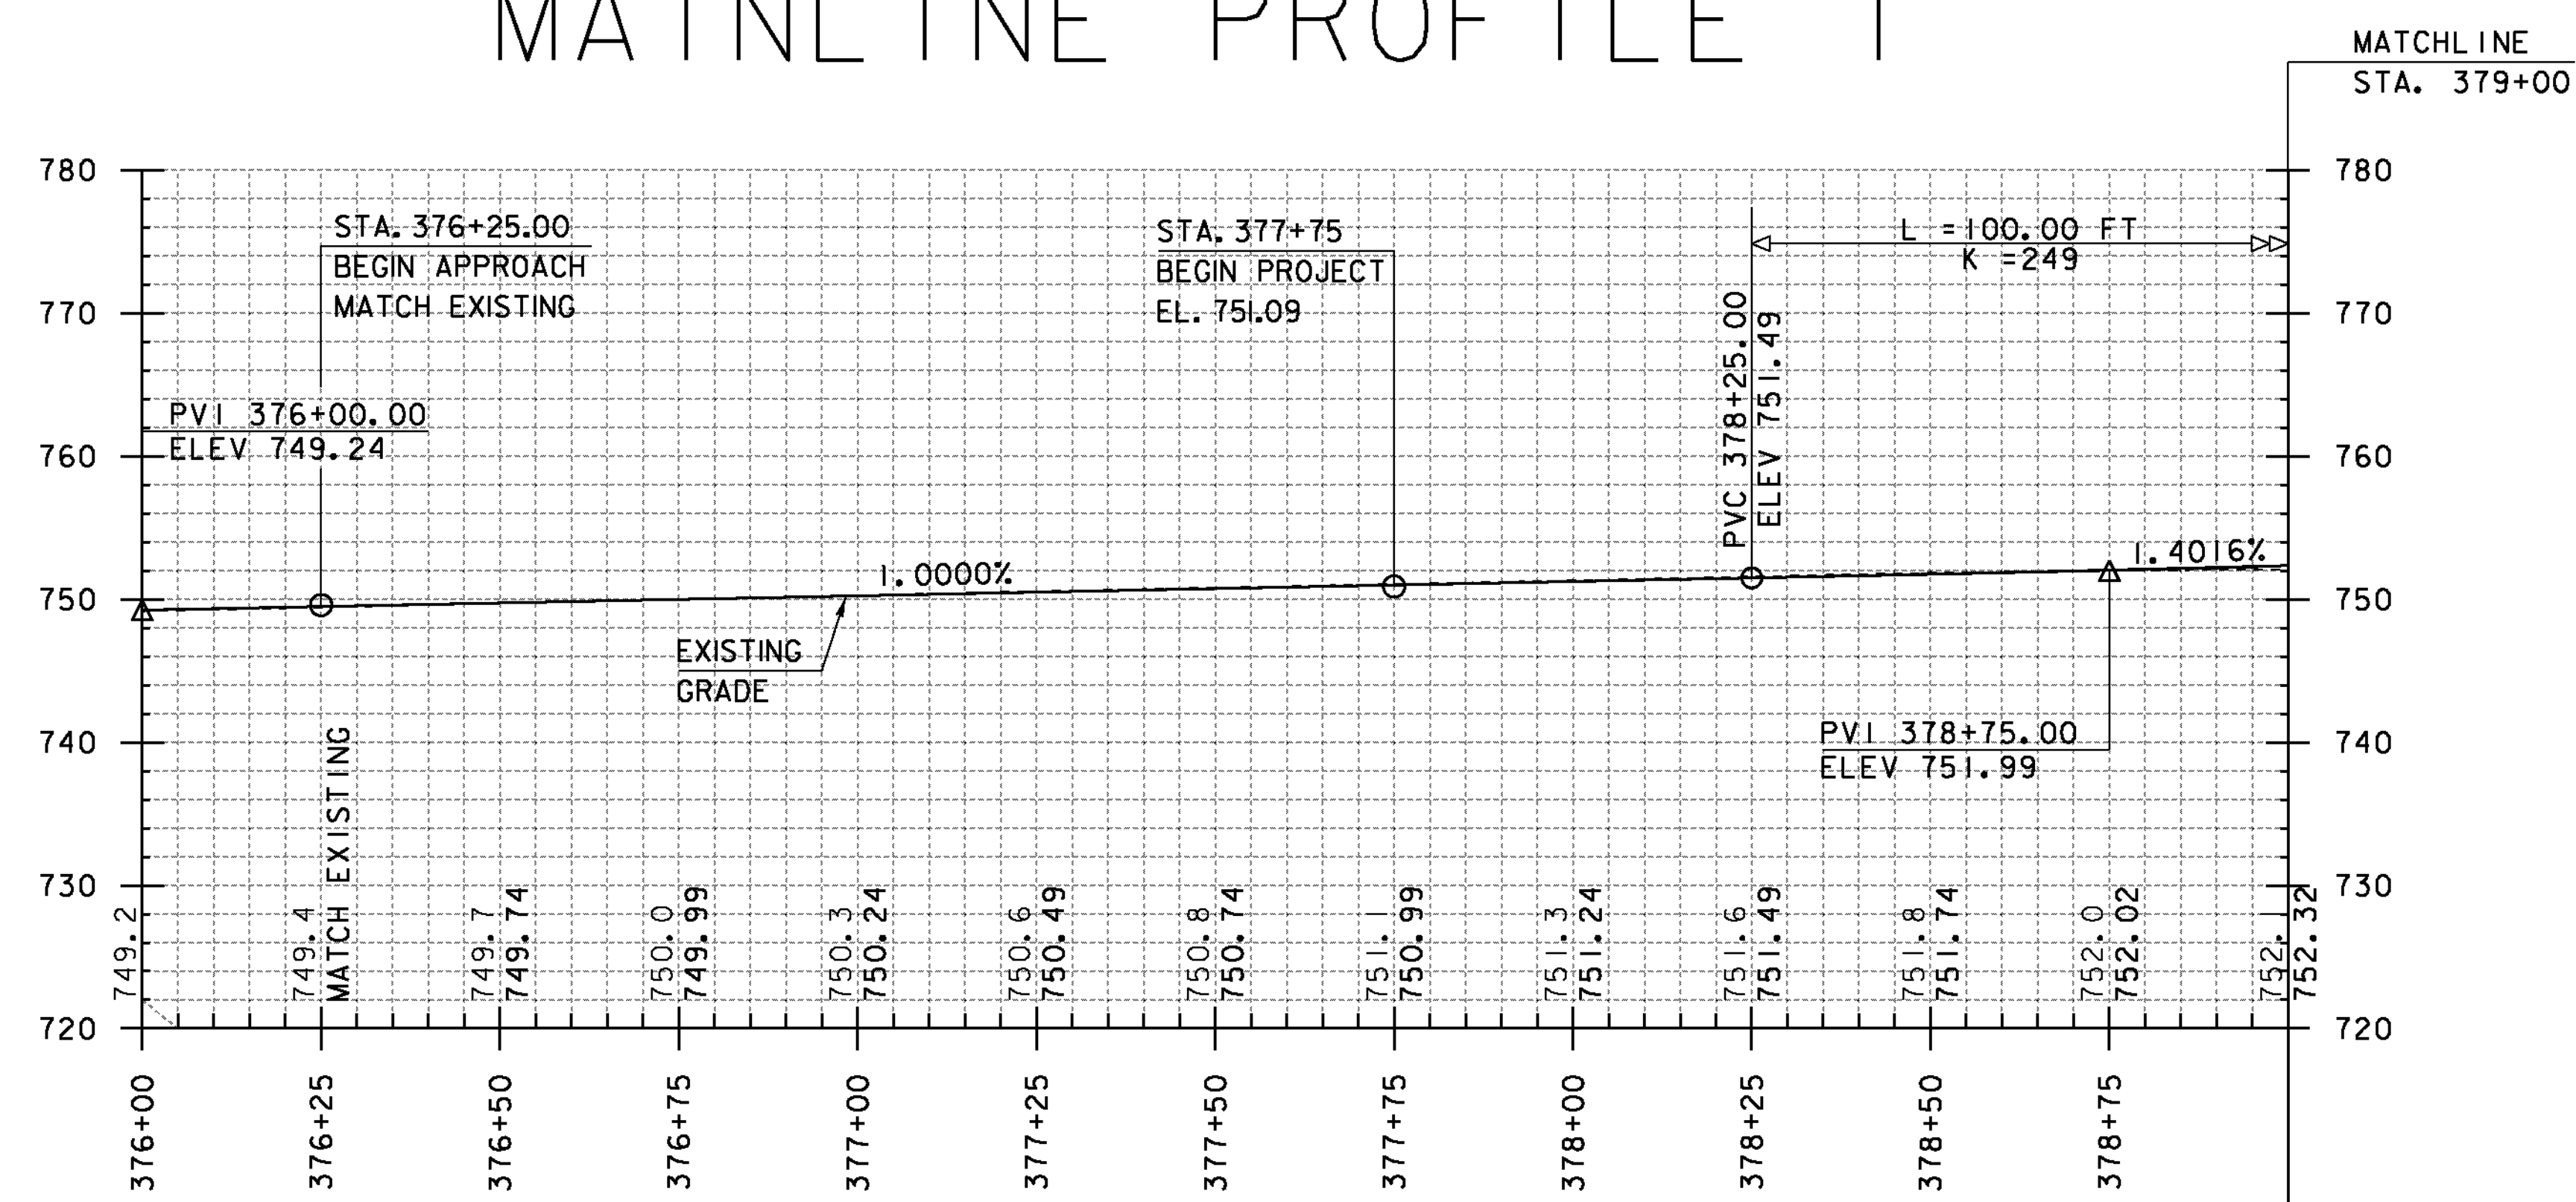

THE GRADES SHOWN TO THE NEAREST TENTH ARE THE ORIGINAL GROUND ELEVATIONS ALONG THE PROPOSED ALIGNMENT.



THE GRADES SHOWN TO THE NEAREST HUNDREDTH ARE THE FINISH GRADES ALONG THE PROPOSED ALIGNMENT.

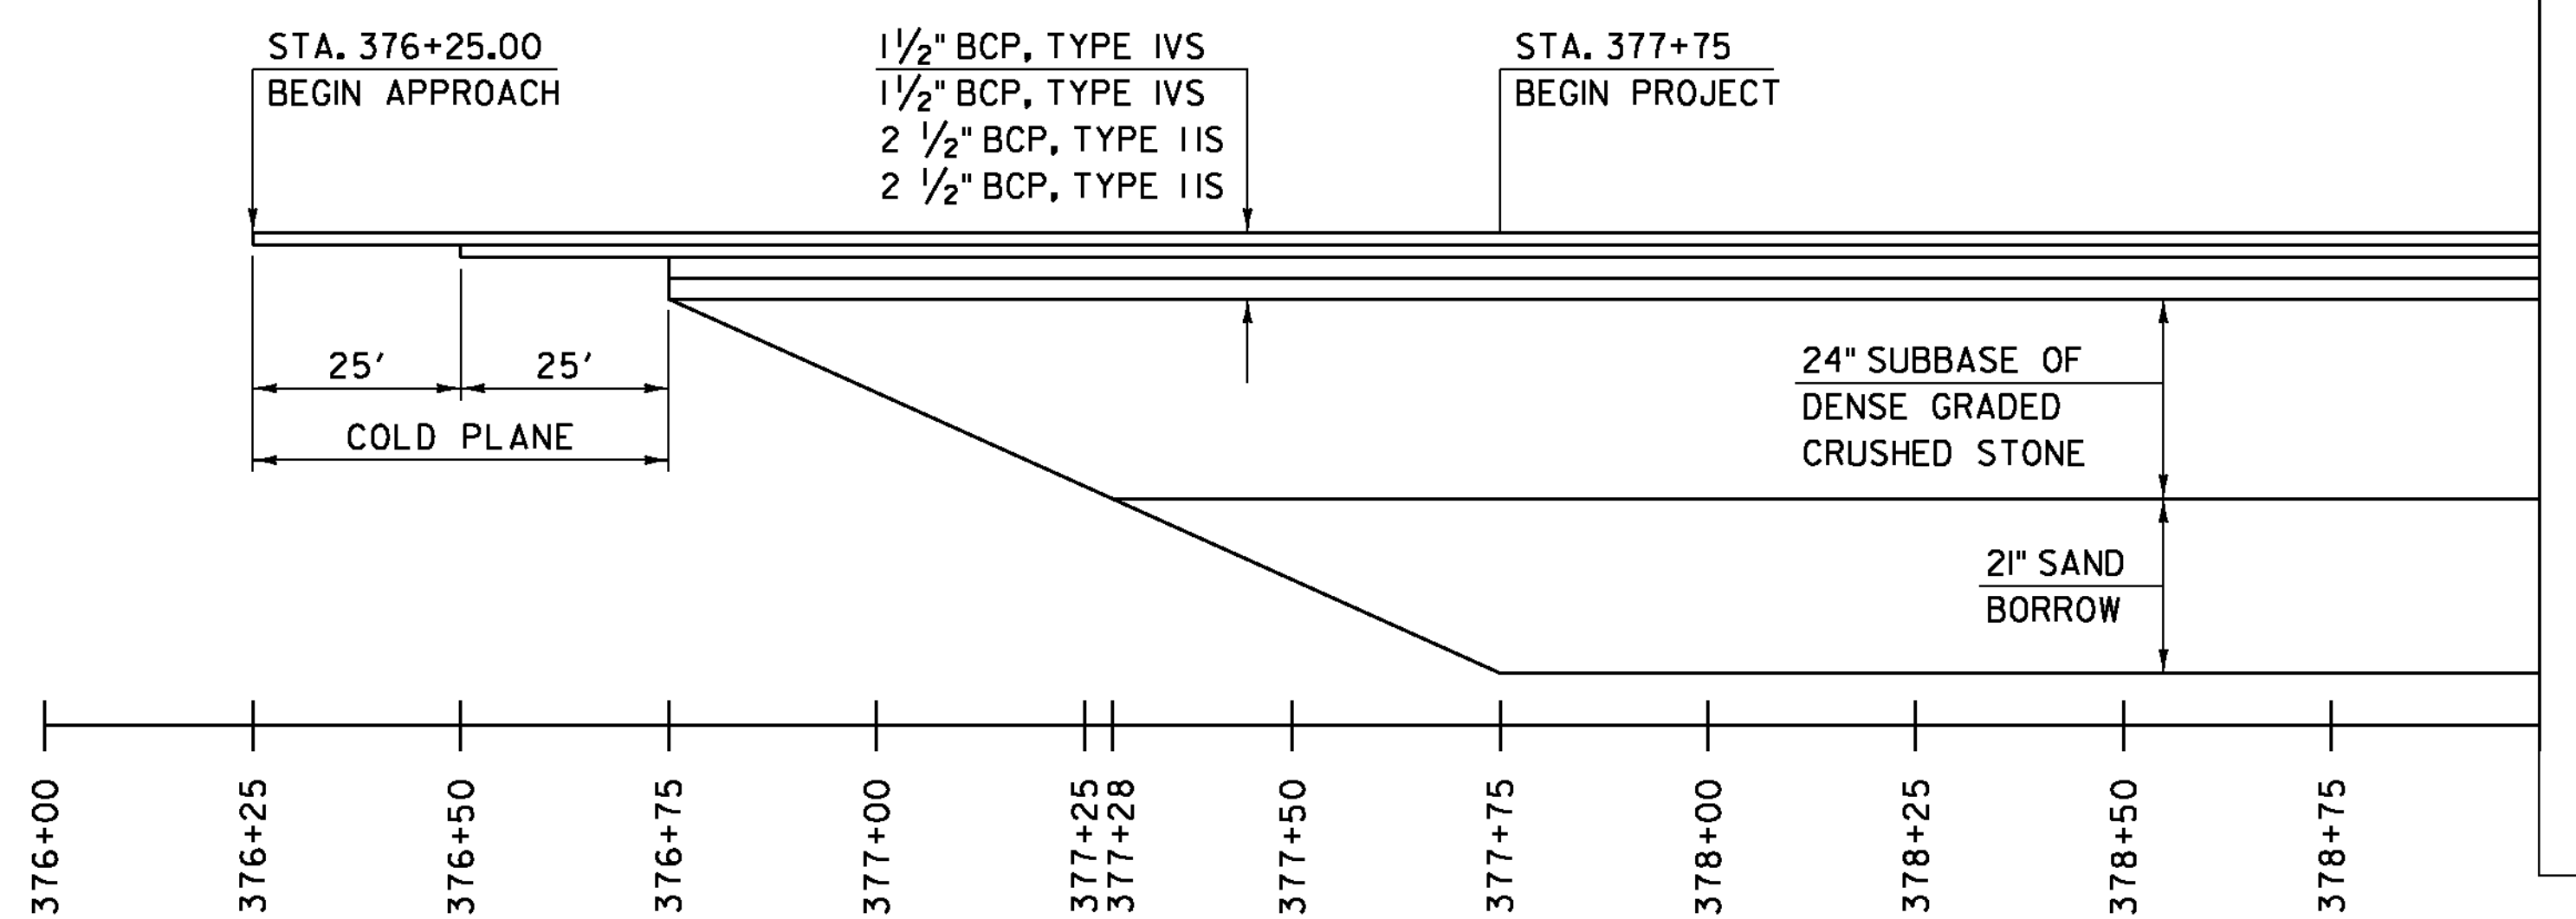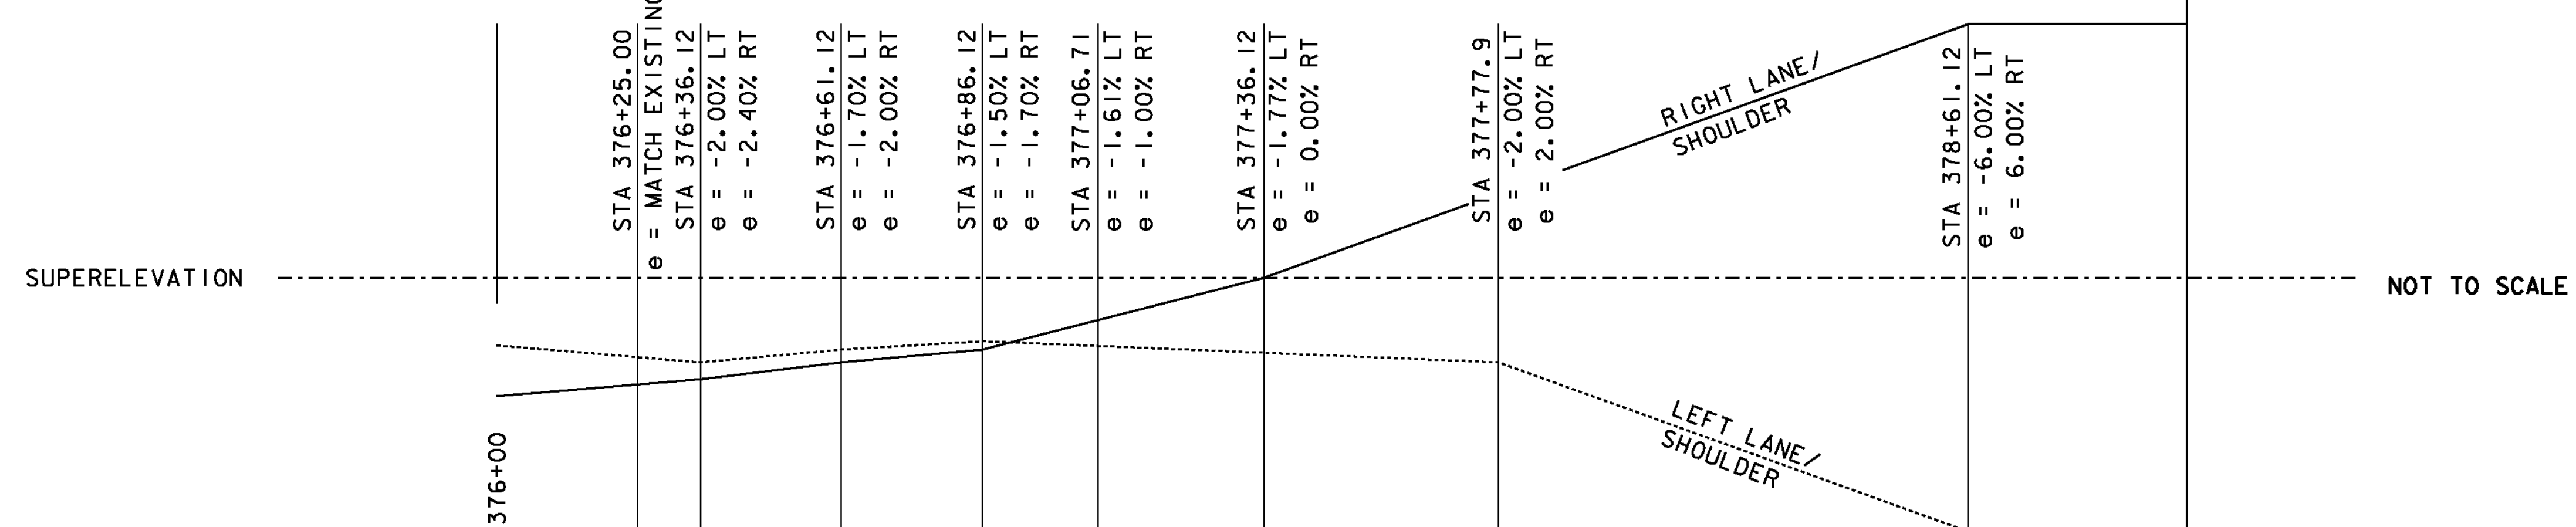

MATERIAL TRANSITION DIAGRAM I

PROJECT NAME: ST. JOHNSBURY	PLOT DATE: 28-AUG-2012
PROJECT NUMBER: BRF 028-4(25)S	DRAWN BY: C. MOONEY
FILE NAME: s98b320xsl.dgn	CHECKED BY: C. CARLSON
PROJECT LEADER: C. CARLSON	SHEET 12 OF 62
DESIGNED BY: H. SALLS	
ROADWAY PROFILE I	

MAINLINE PROFILE 2

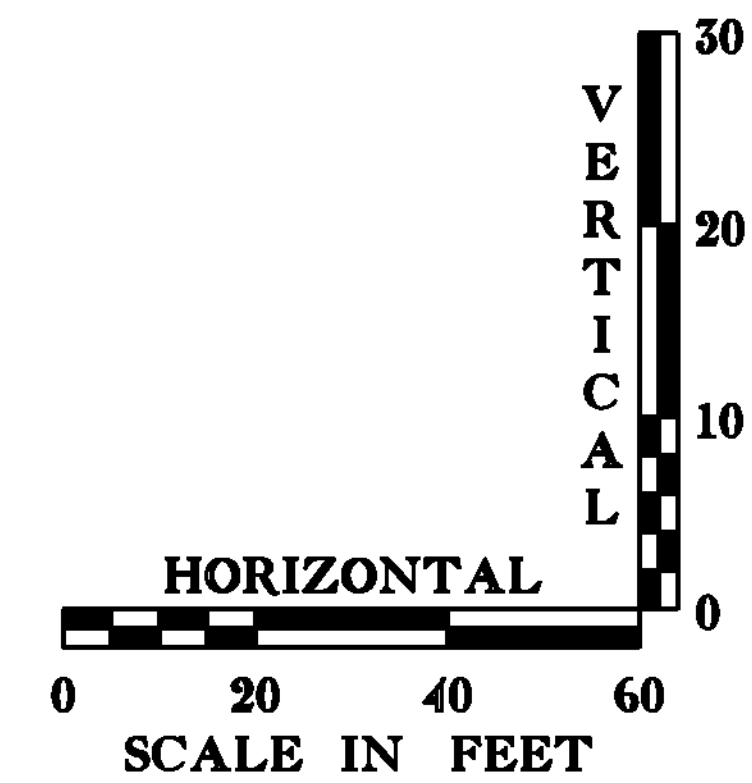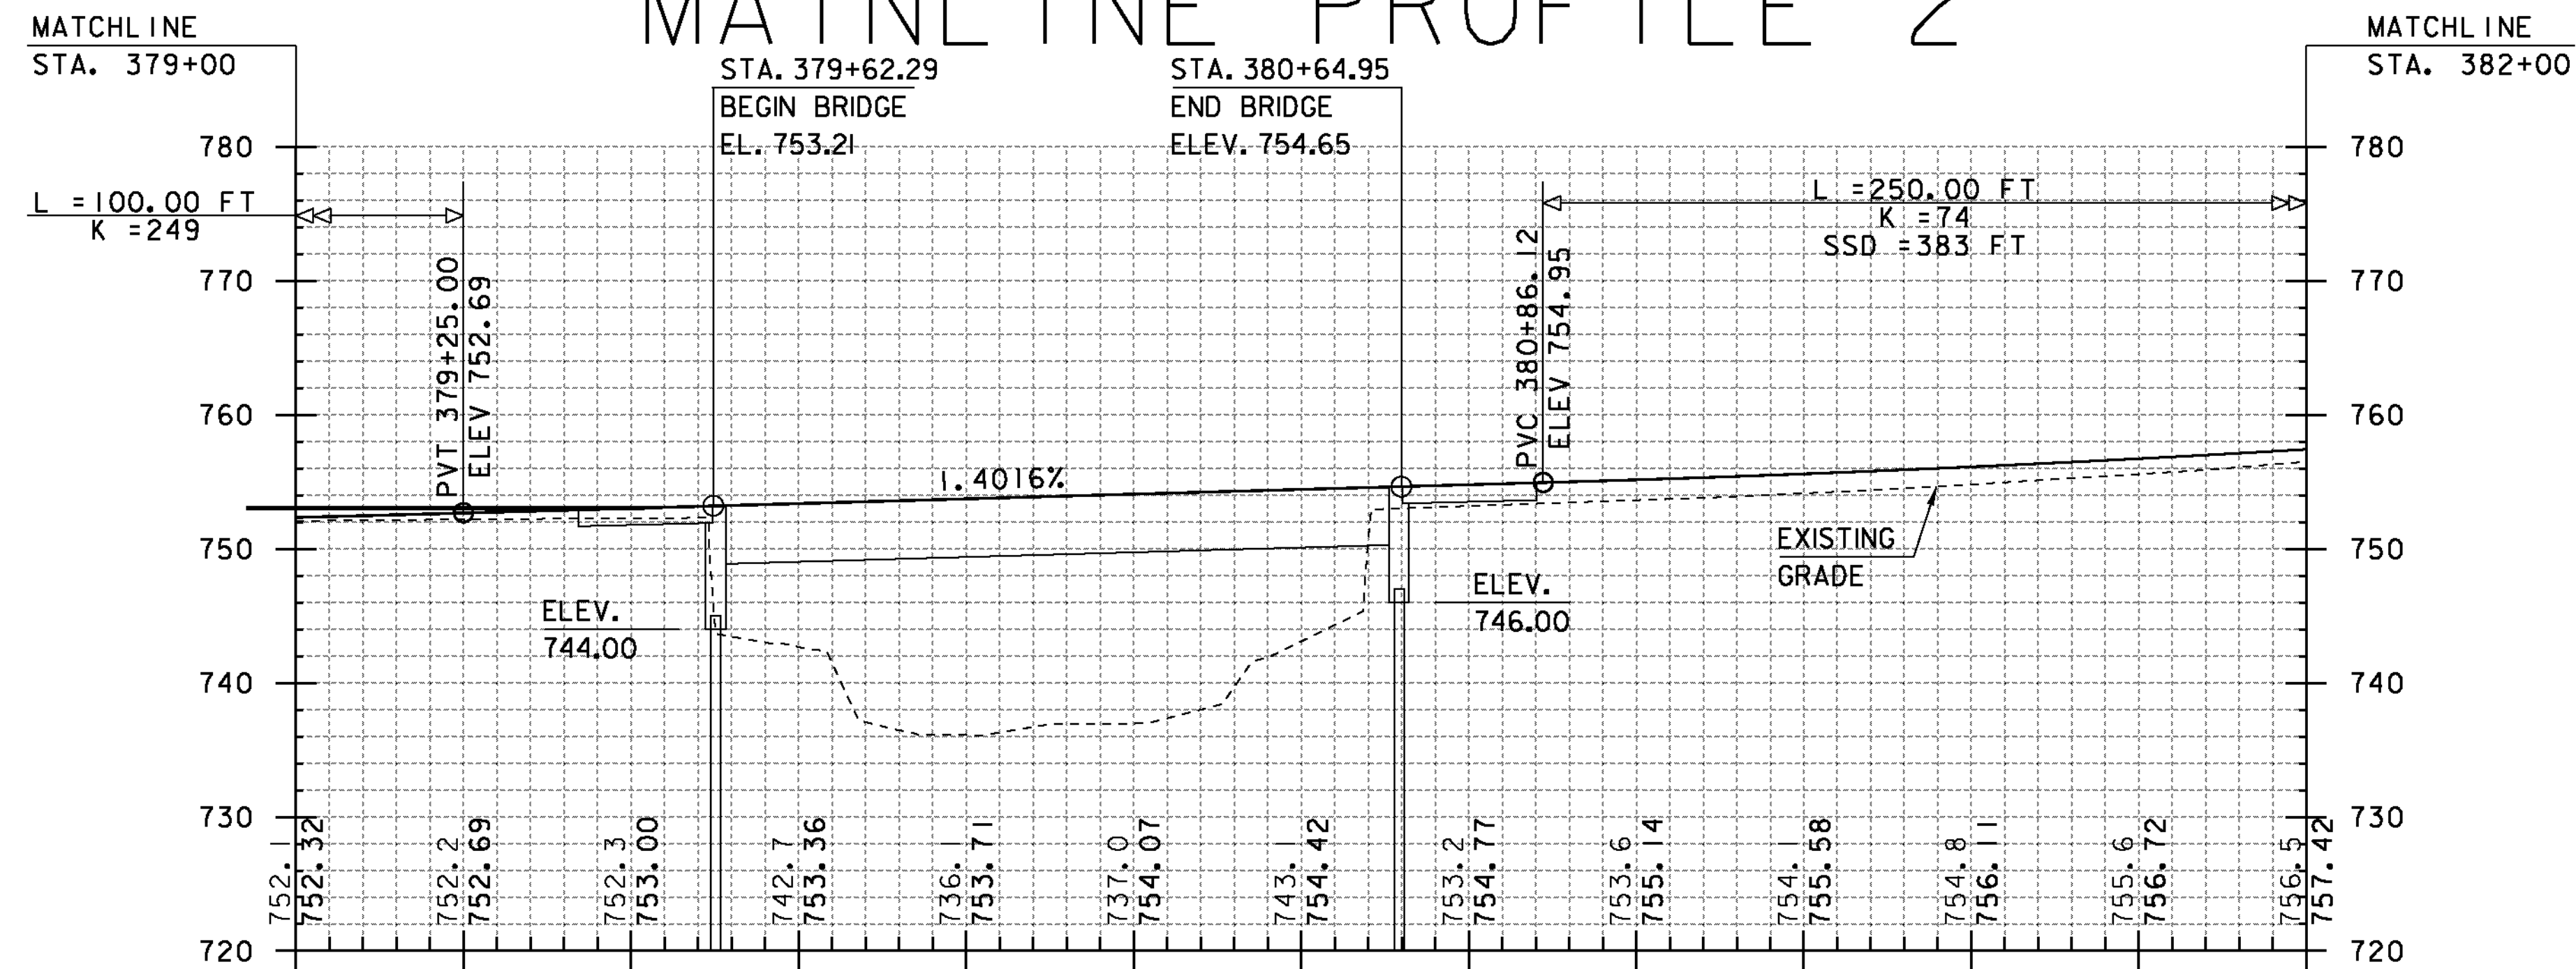


THE GRADES SHOWN TO THE NEAREST TENTH ARE THE ORIGINAL GROUND ELEVATIONS ALONG THE PROPOSED ALIGNMENT.

THE GRADES SHOWN TO THE NEAREST HUNDREDTH ARE THE FINISH GRADES ALONG THE PROPOSED ALIGNMENT.

SUPERELEVATION

NOT TO SCALE


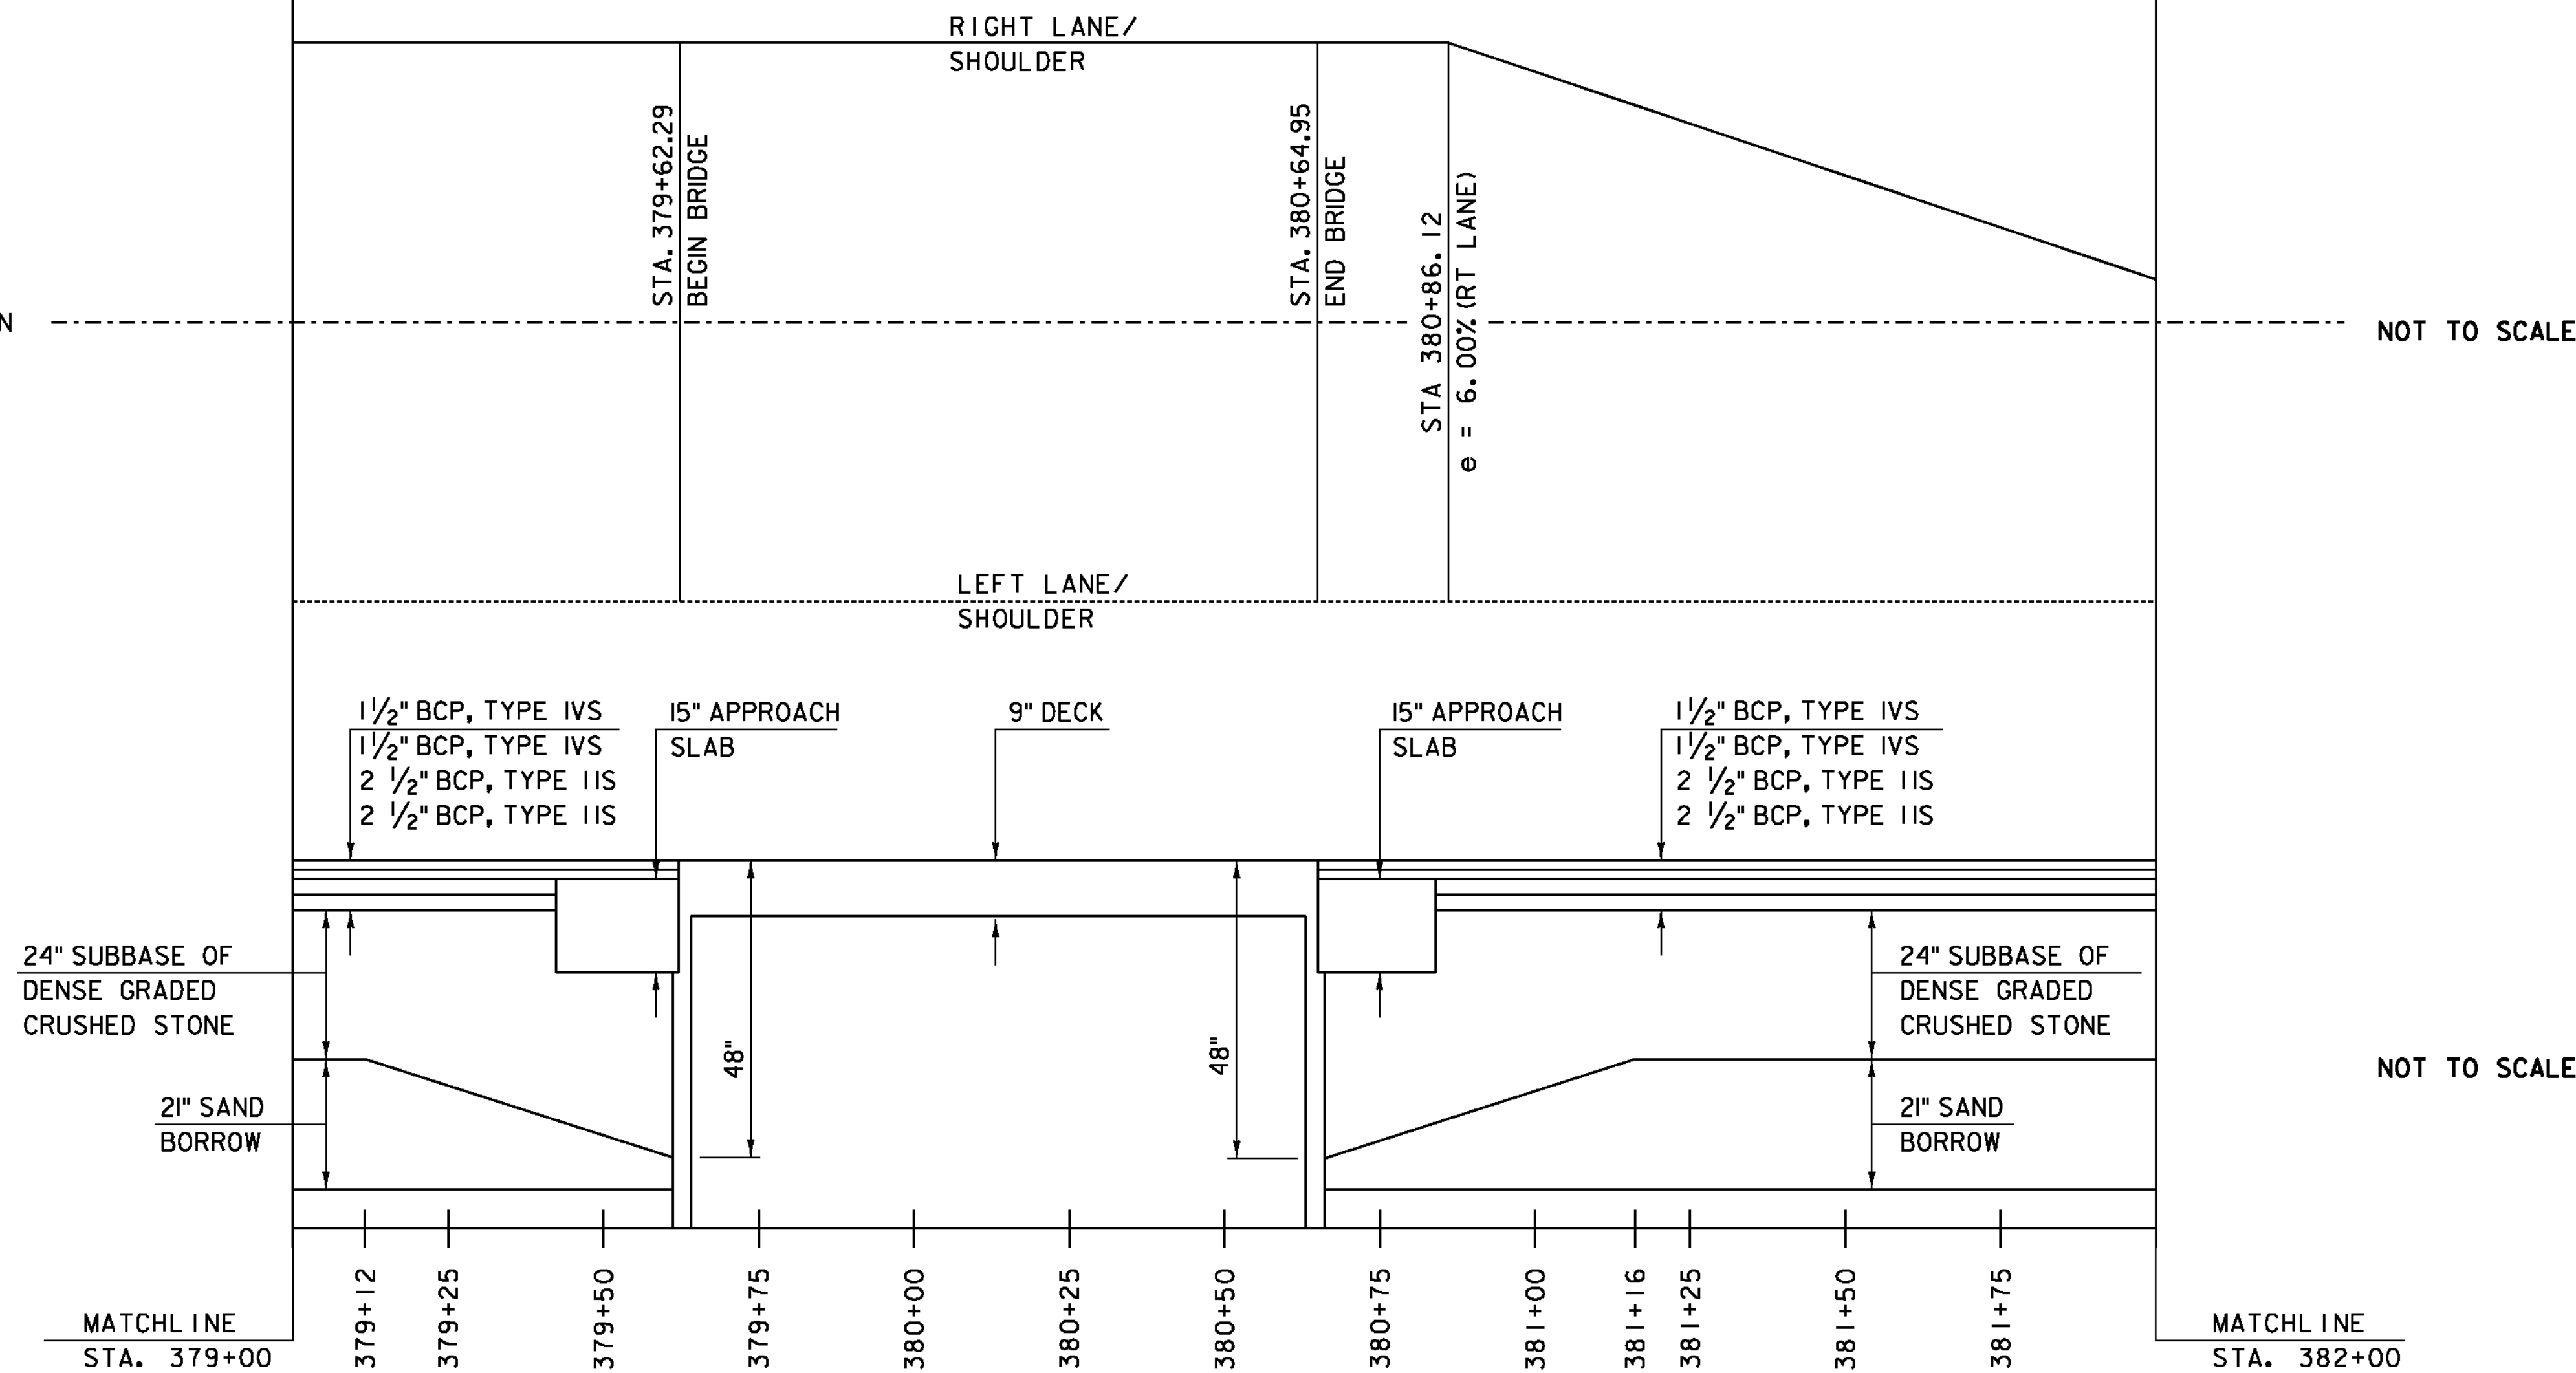


NOT TO SCALE

MATERIAL TRANSITION DIAGRAM 2


PROJECT NAME: ST. JOHNSBURY	PLOT DATE: 28-AUG-2012
PROJECT NUMBER: BRF 028-4(25)S	DRAWN BY: C. MOONEY
FILE NAME: s98b320xsl.dgn	CHECKED BY: C. CARLSON
PROJECT LEADER: C. CARLSON	SHEET 13 OF 62
DESIGNED BY: H. SALLS	
ROADWAY PROFILE 2	

MAINLINE PROFILE 3

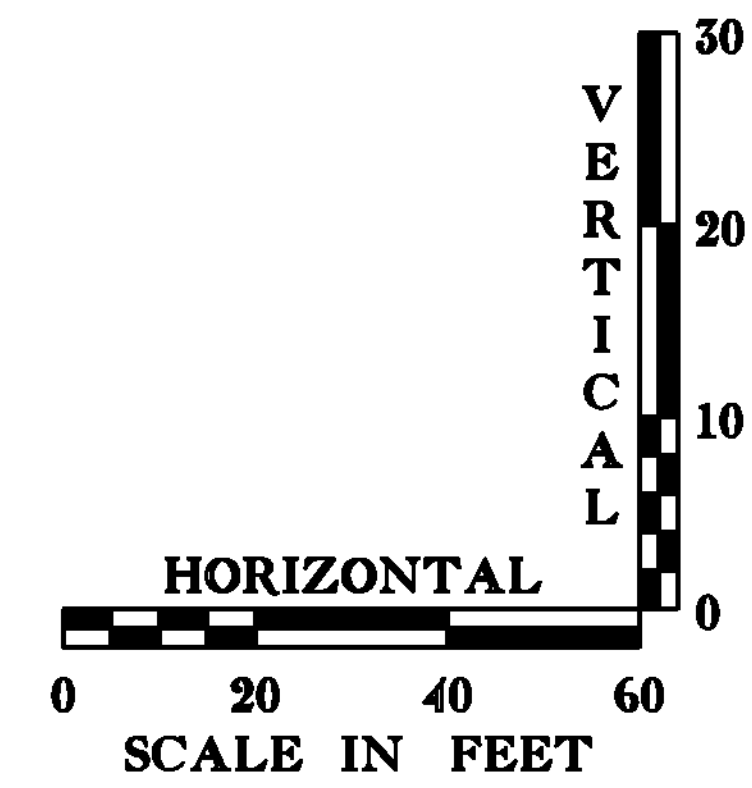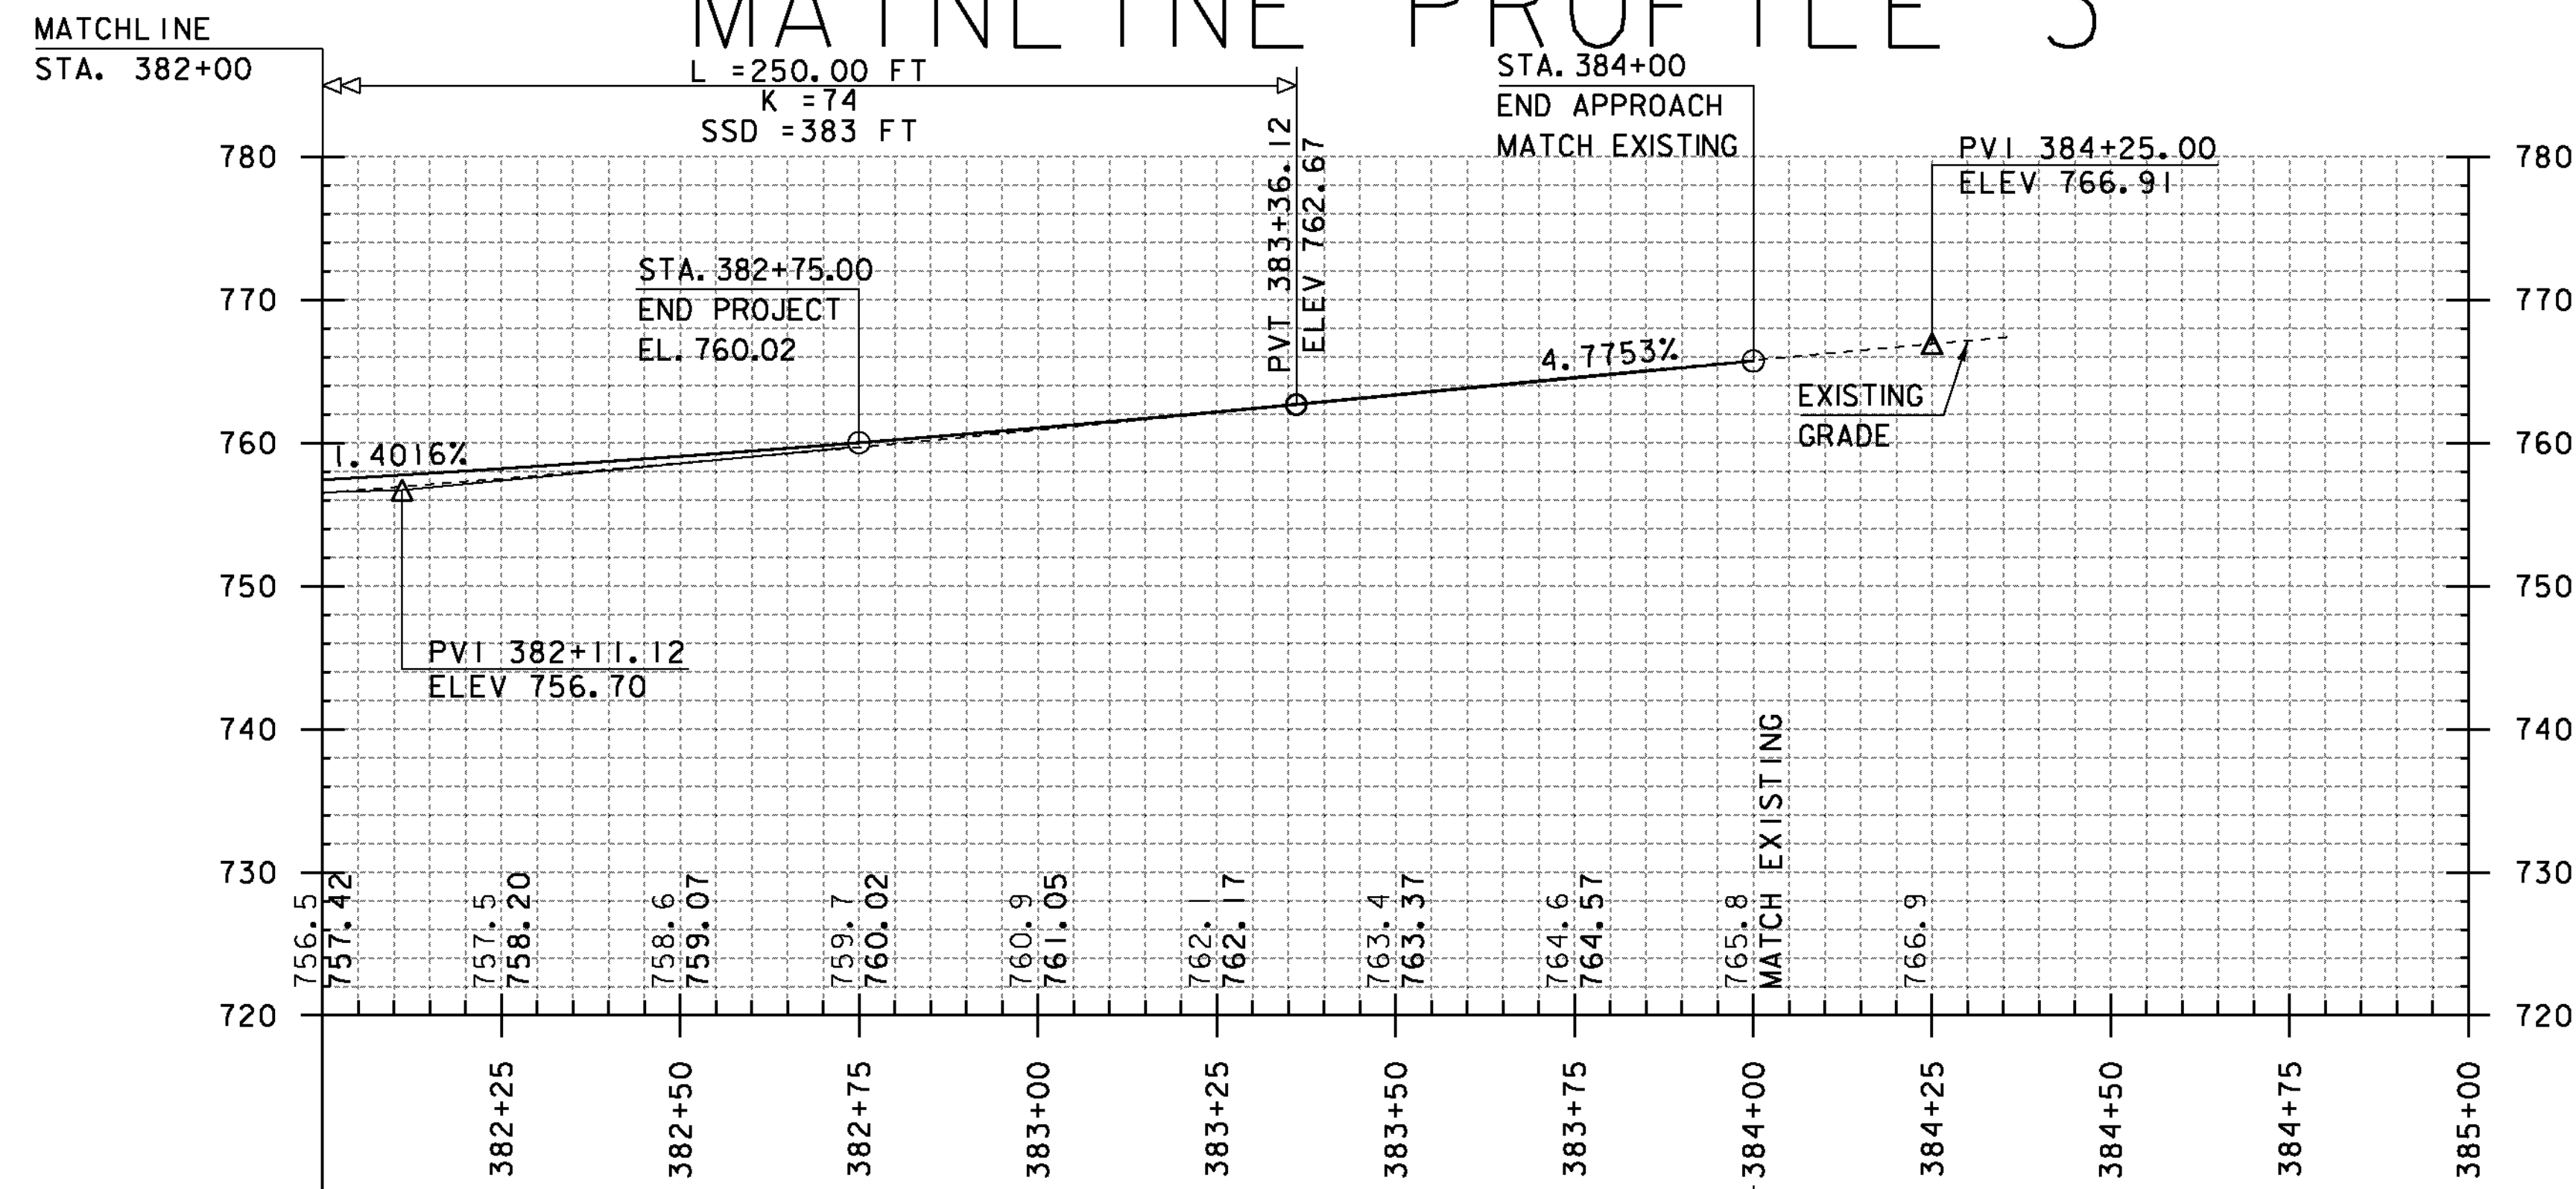

THE GRADES SHOWN TO THE NEAREST TENTH ARE THE ORIGINAL GROUND ELEVATIONS ALONG THE PROPOSED ALIGNMENT.

THE GRADES SHOWN TO THE NEAREST HUNDREDTH ARE THE FINISH GRADES ALONG THE PROPOSED ALIGNMENT.

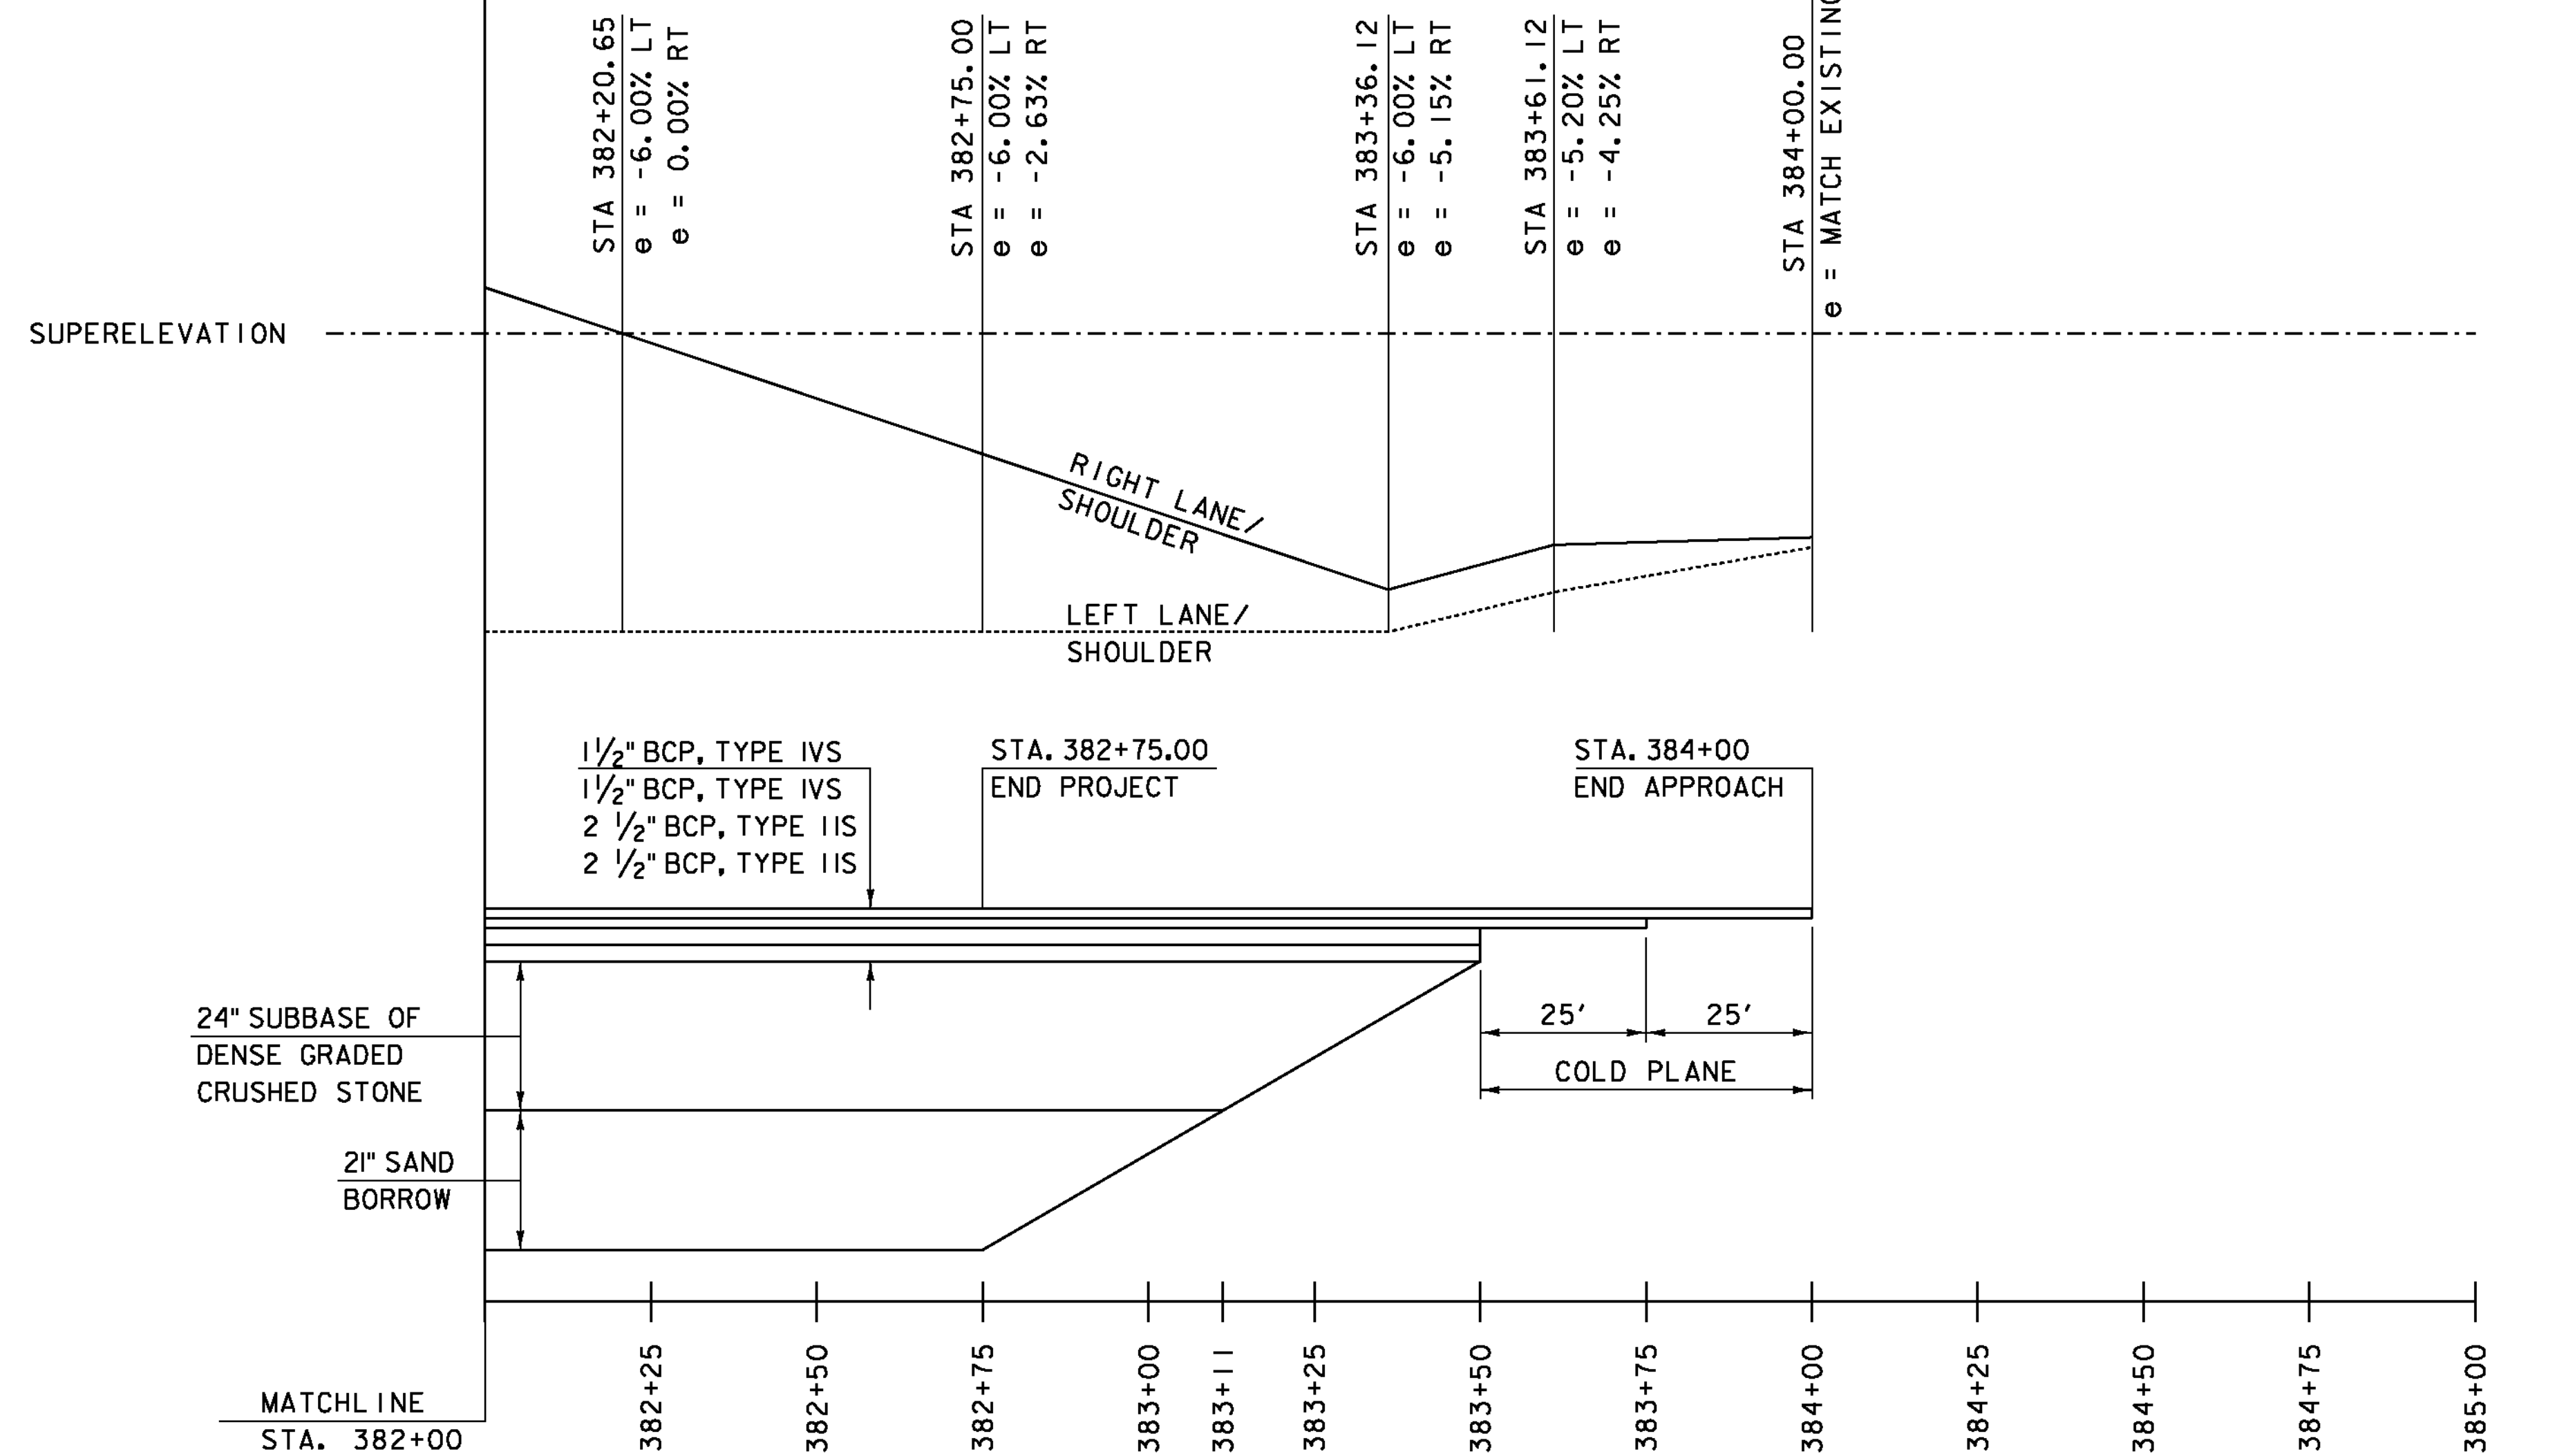


NOT TO SCALE

NOT TO SCALE



MATERIAL TRANSITION DIAGRAM 3

PROJECT NAME:	ST. JOHNSBURY	PLOT DATE:	28-AUG-2012
PROJECT NUMBER:	BRF 028-4(25)S	DRAWN BY:	C. MOONEY
FILE NAME:	s98b320xsl.dgn	CHECKED BY:	C. CARLSON
PROJECT LEADER:	C. CARLSON	ROADWAY PROFILE:	3
DESIGNED BY:	H. SALLS		SHEET 14 OF 62

DRIVE 1 (TH #59)

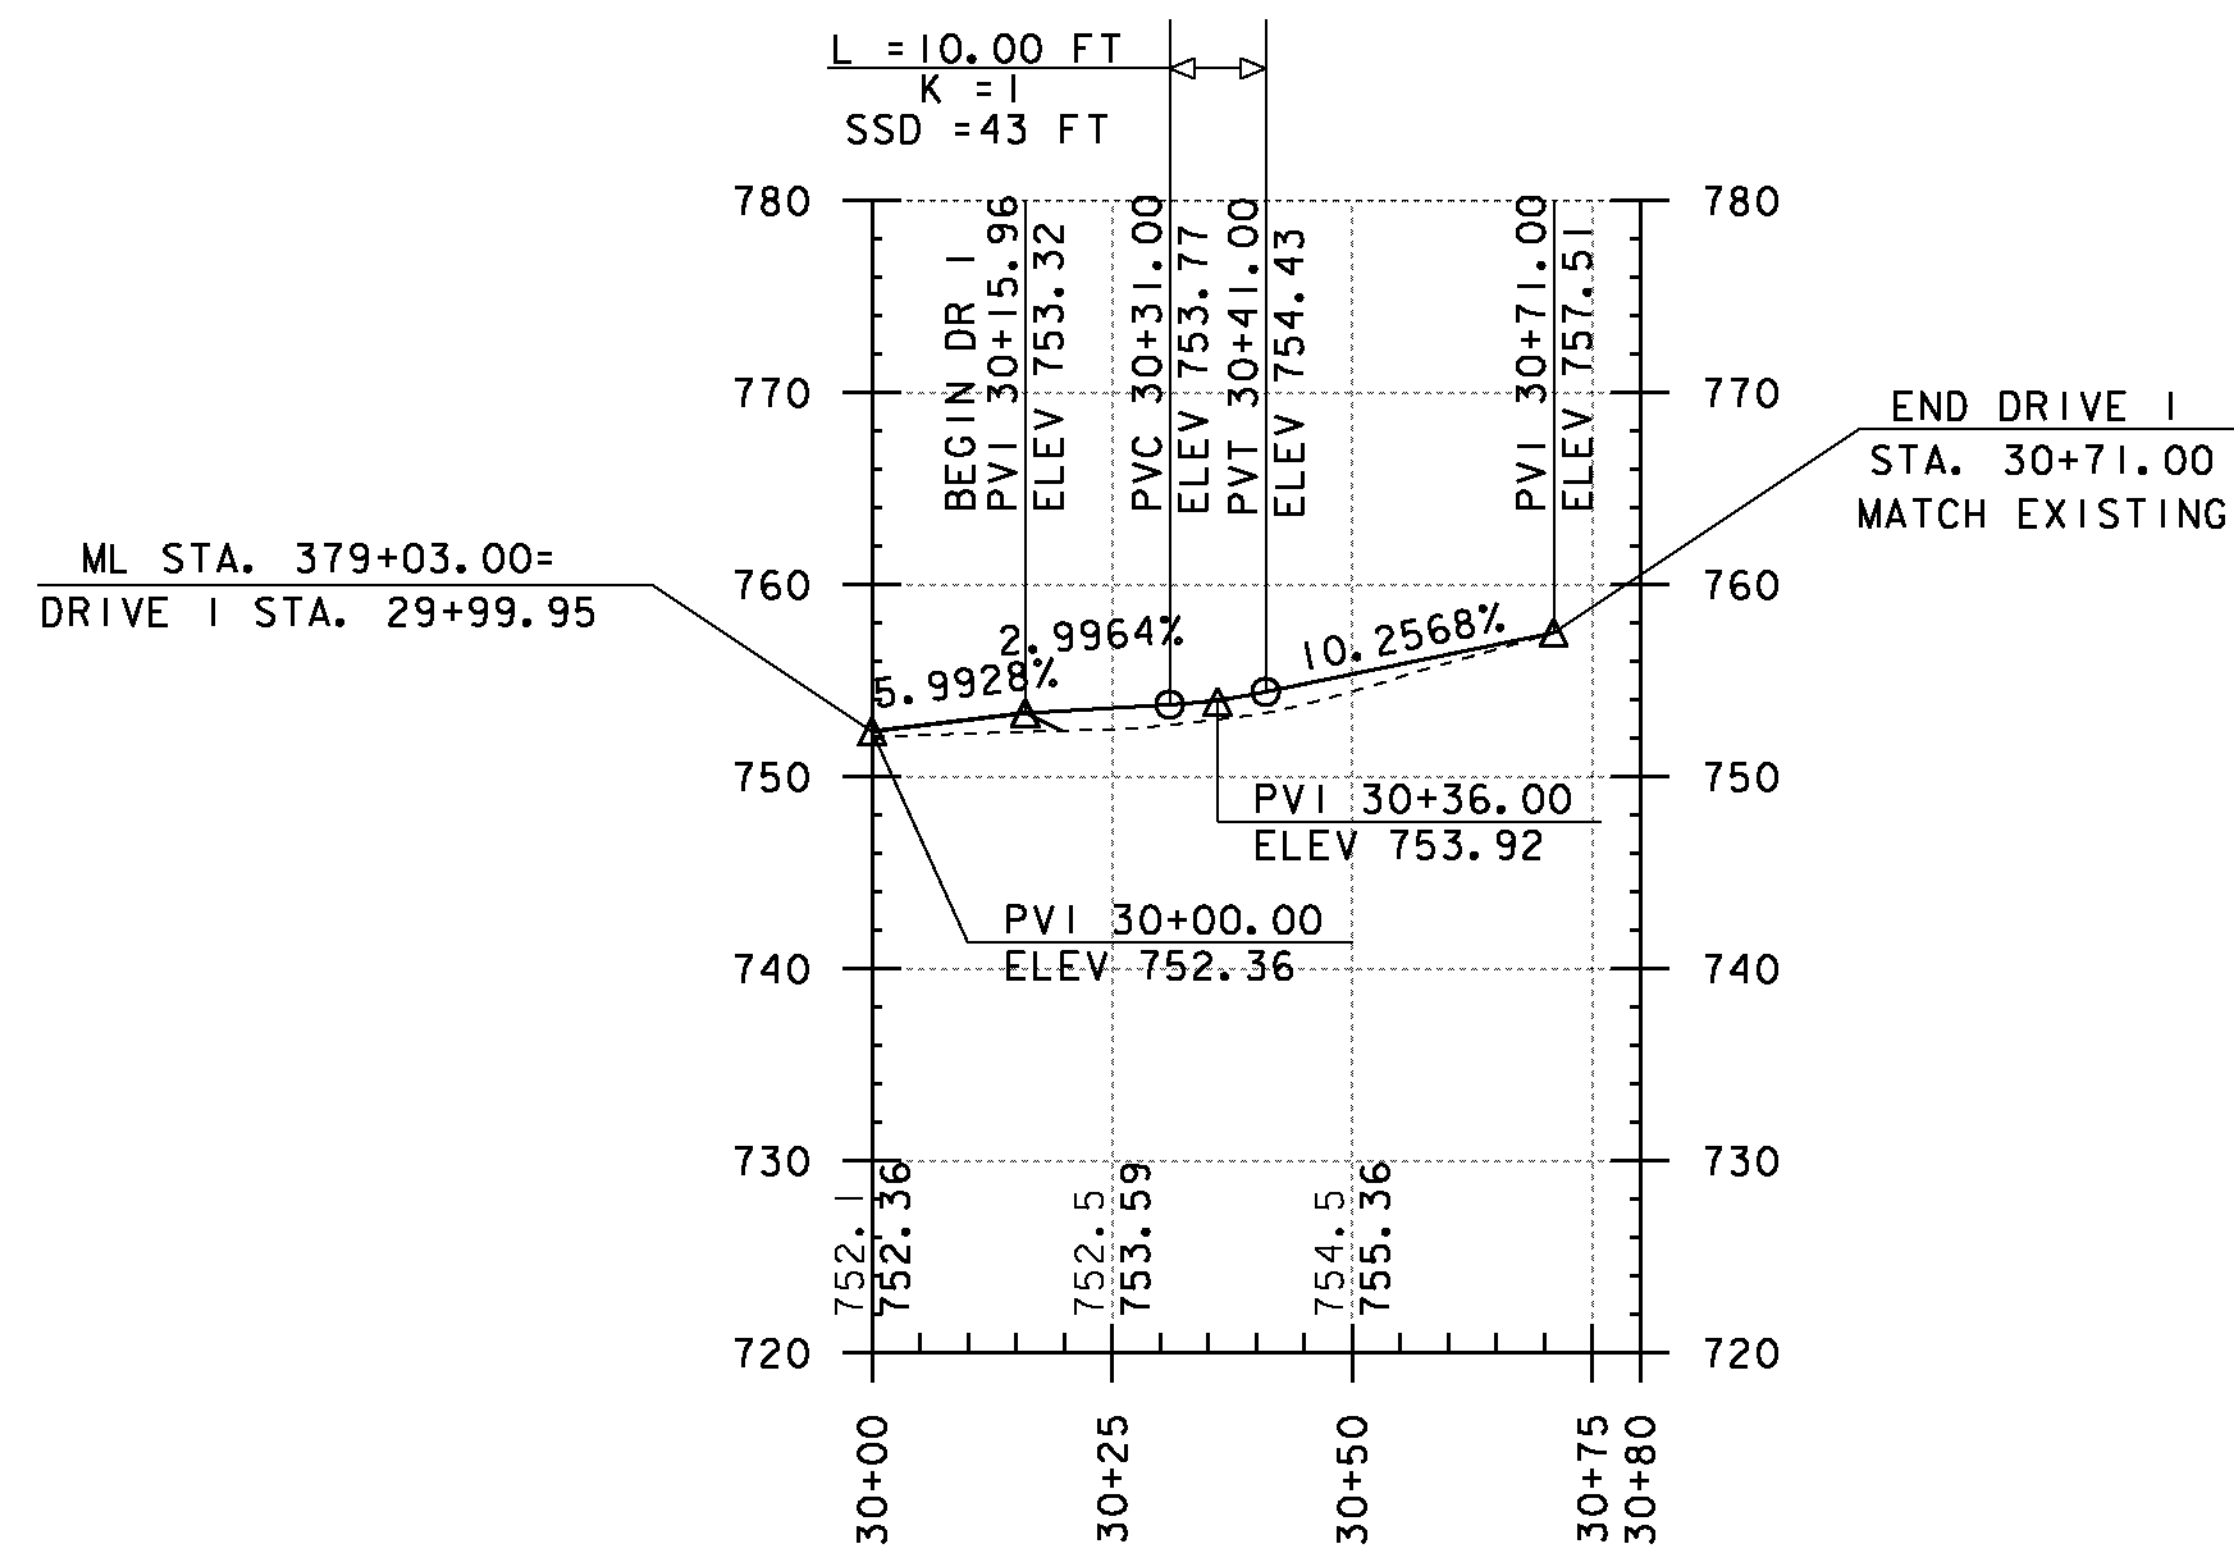



DRIVE 2

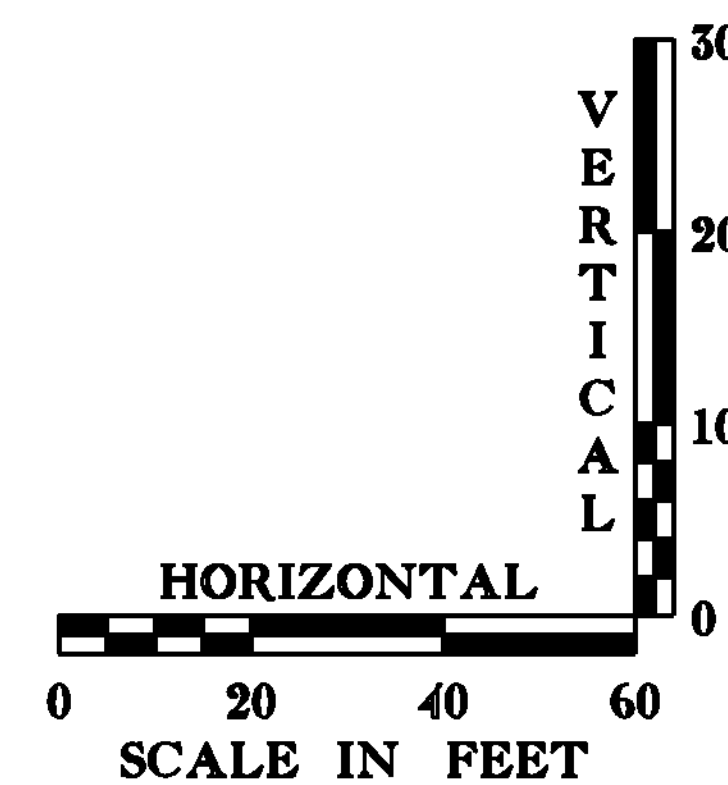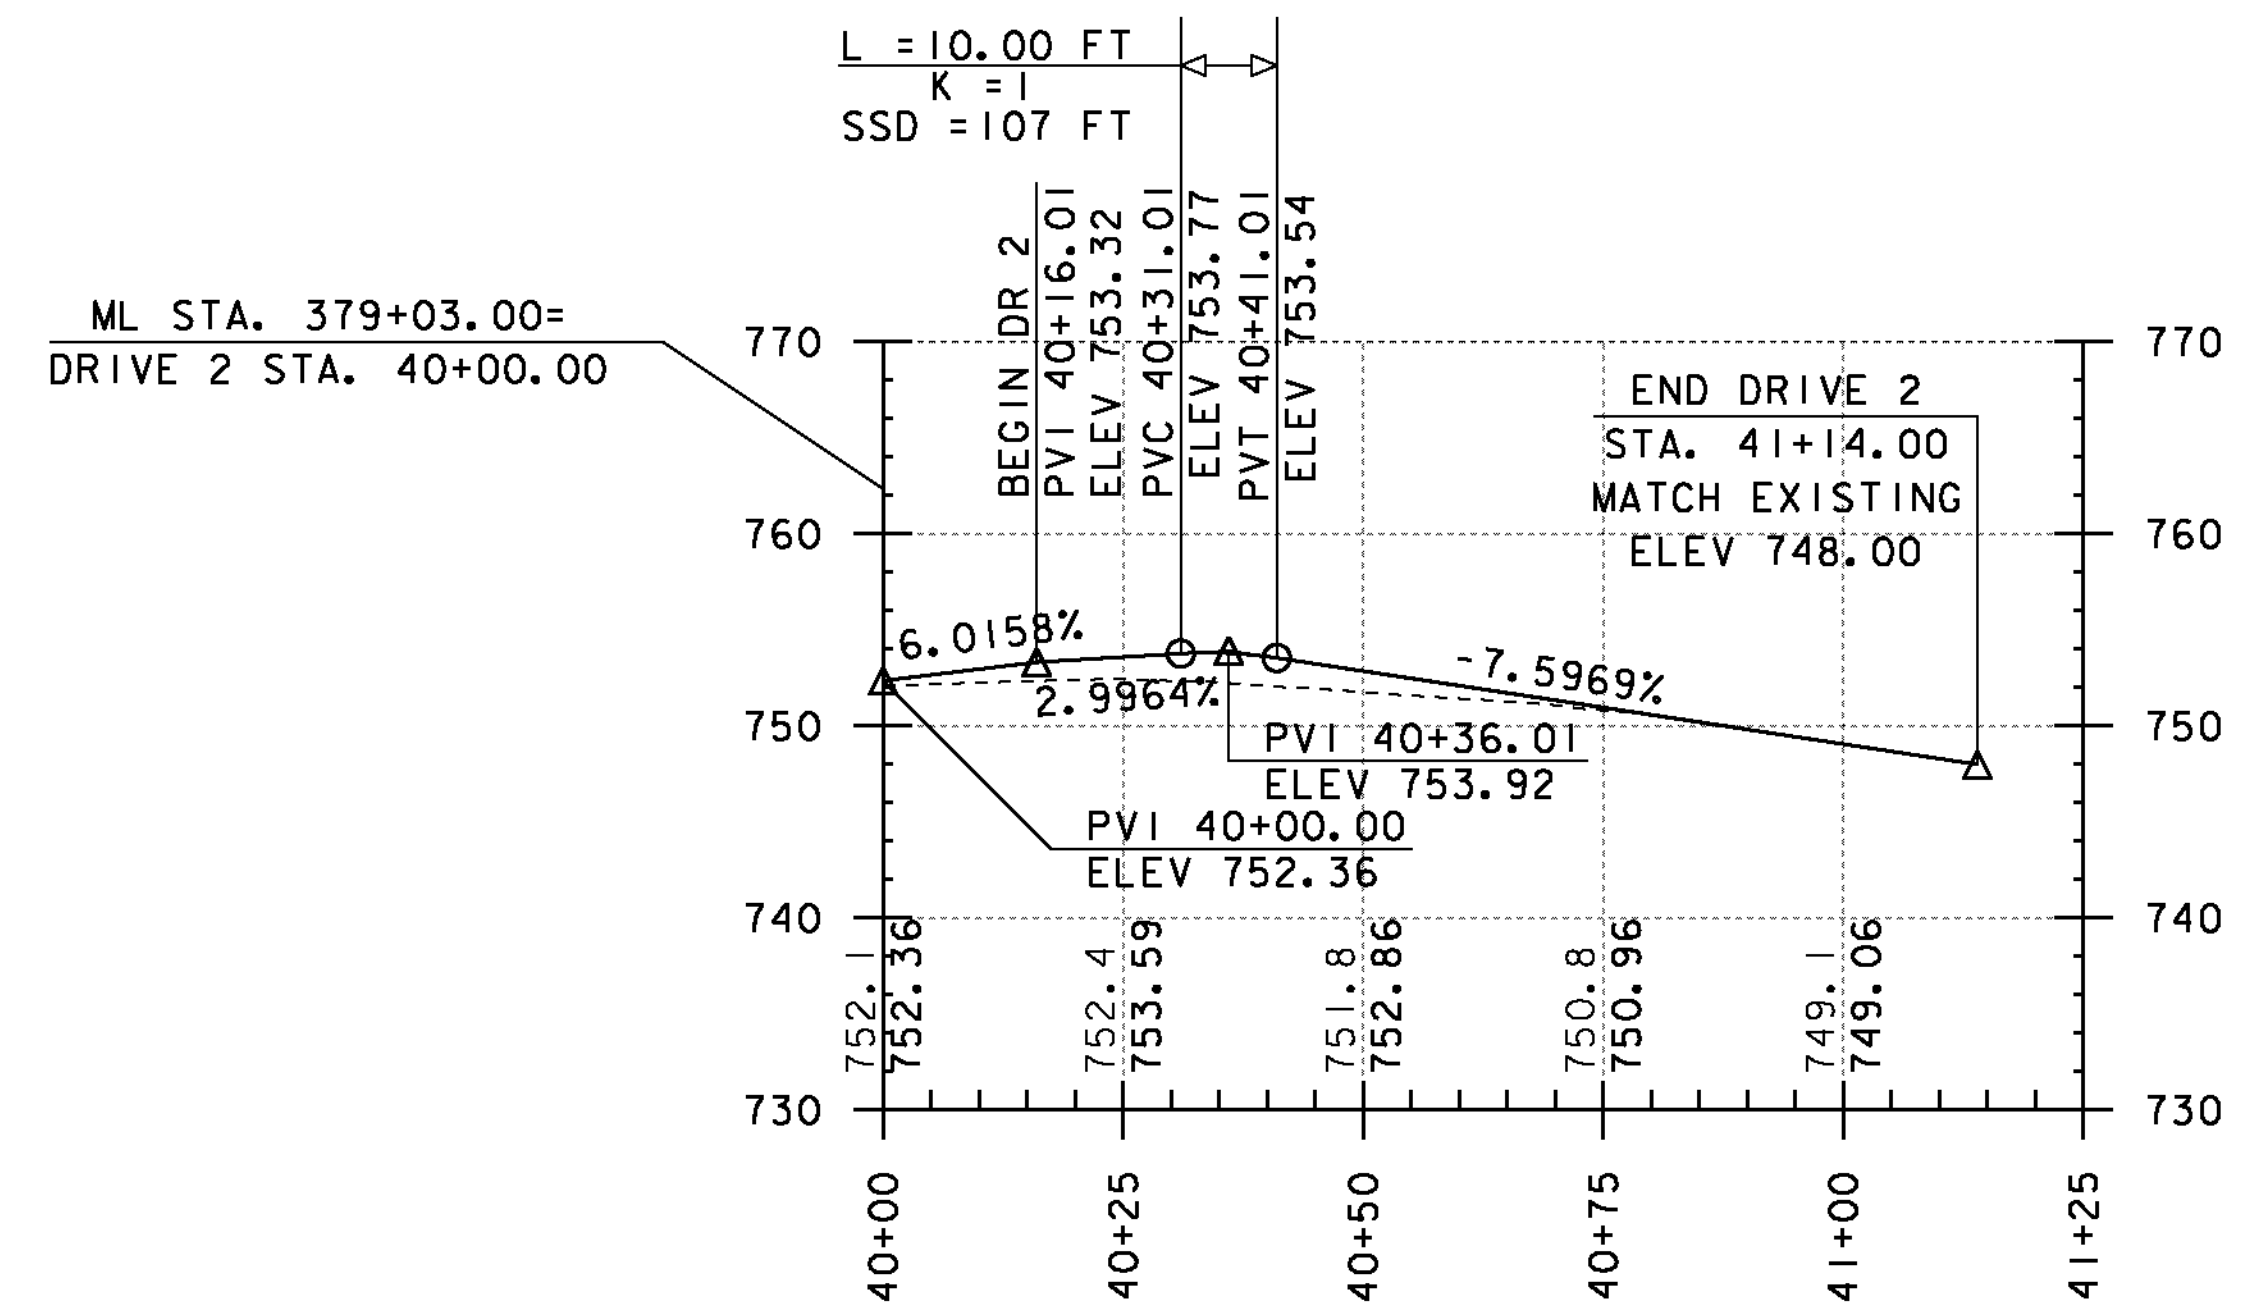

THE GRADES SHOWN TO THE NEAREST TENTH ARE THE ORIGINAL GROUND ELEVATIONS ALONG THE PROPOSED ALIGNMENT.

 THE GRADES SHOWN TO THE NEAREST HUNDREDTH ARE THE FINISH GRADES ALONG THE PROPOSED ALIGNMENT.

PROJECT NAME: ST. JOHNSBURY	PLOT DATE: 28-AUG-2012
PROJECT NUMBER: BRF 028-4(25)S	DRAWN BY: C. MOONEY
FILE NAME: s98b320xsl.dgn	CHECKED BY: C. CARLSON
PROJECT LEADER: C. CARLSON	SHEET 15 OF 62
DESIGNED BY: H. SALLS	
DRIVE PROFILE	

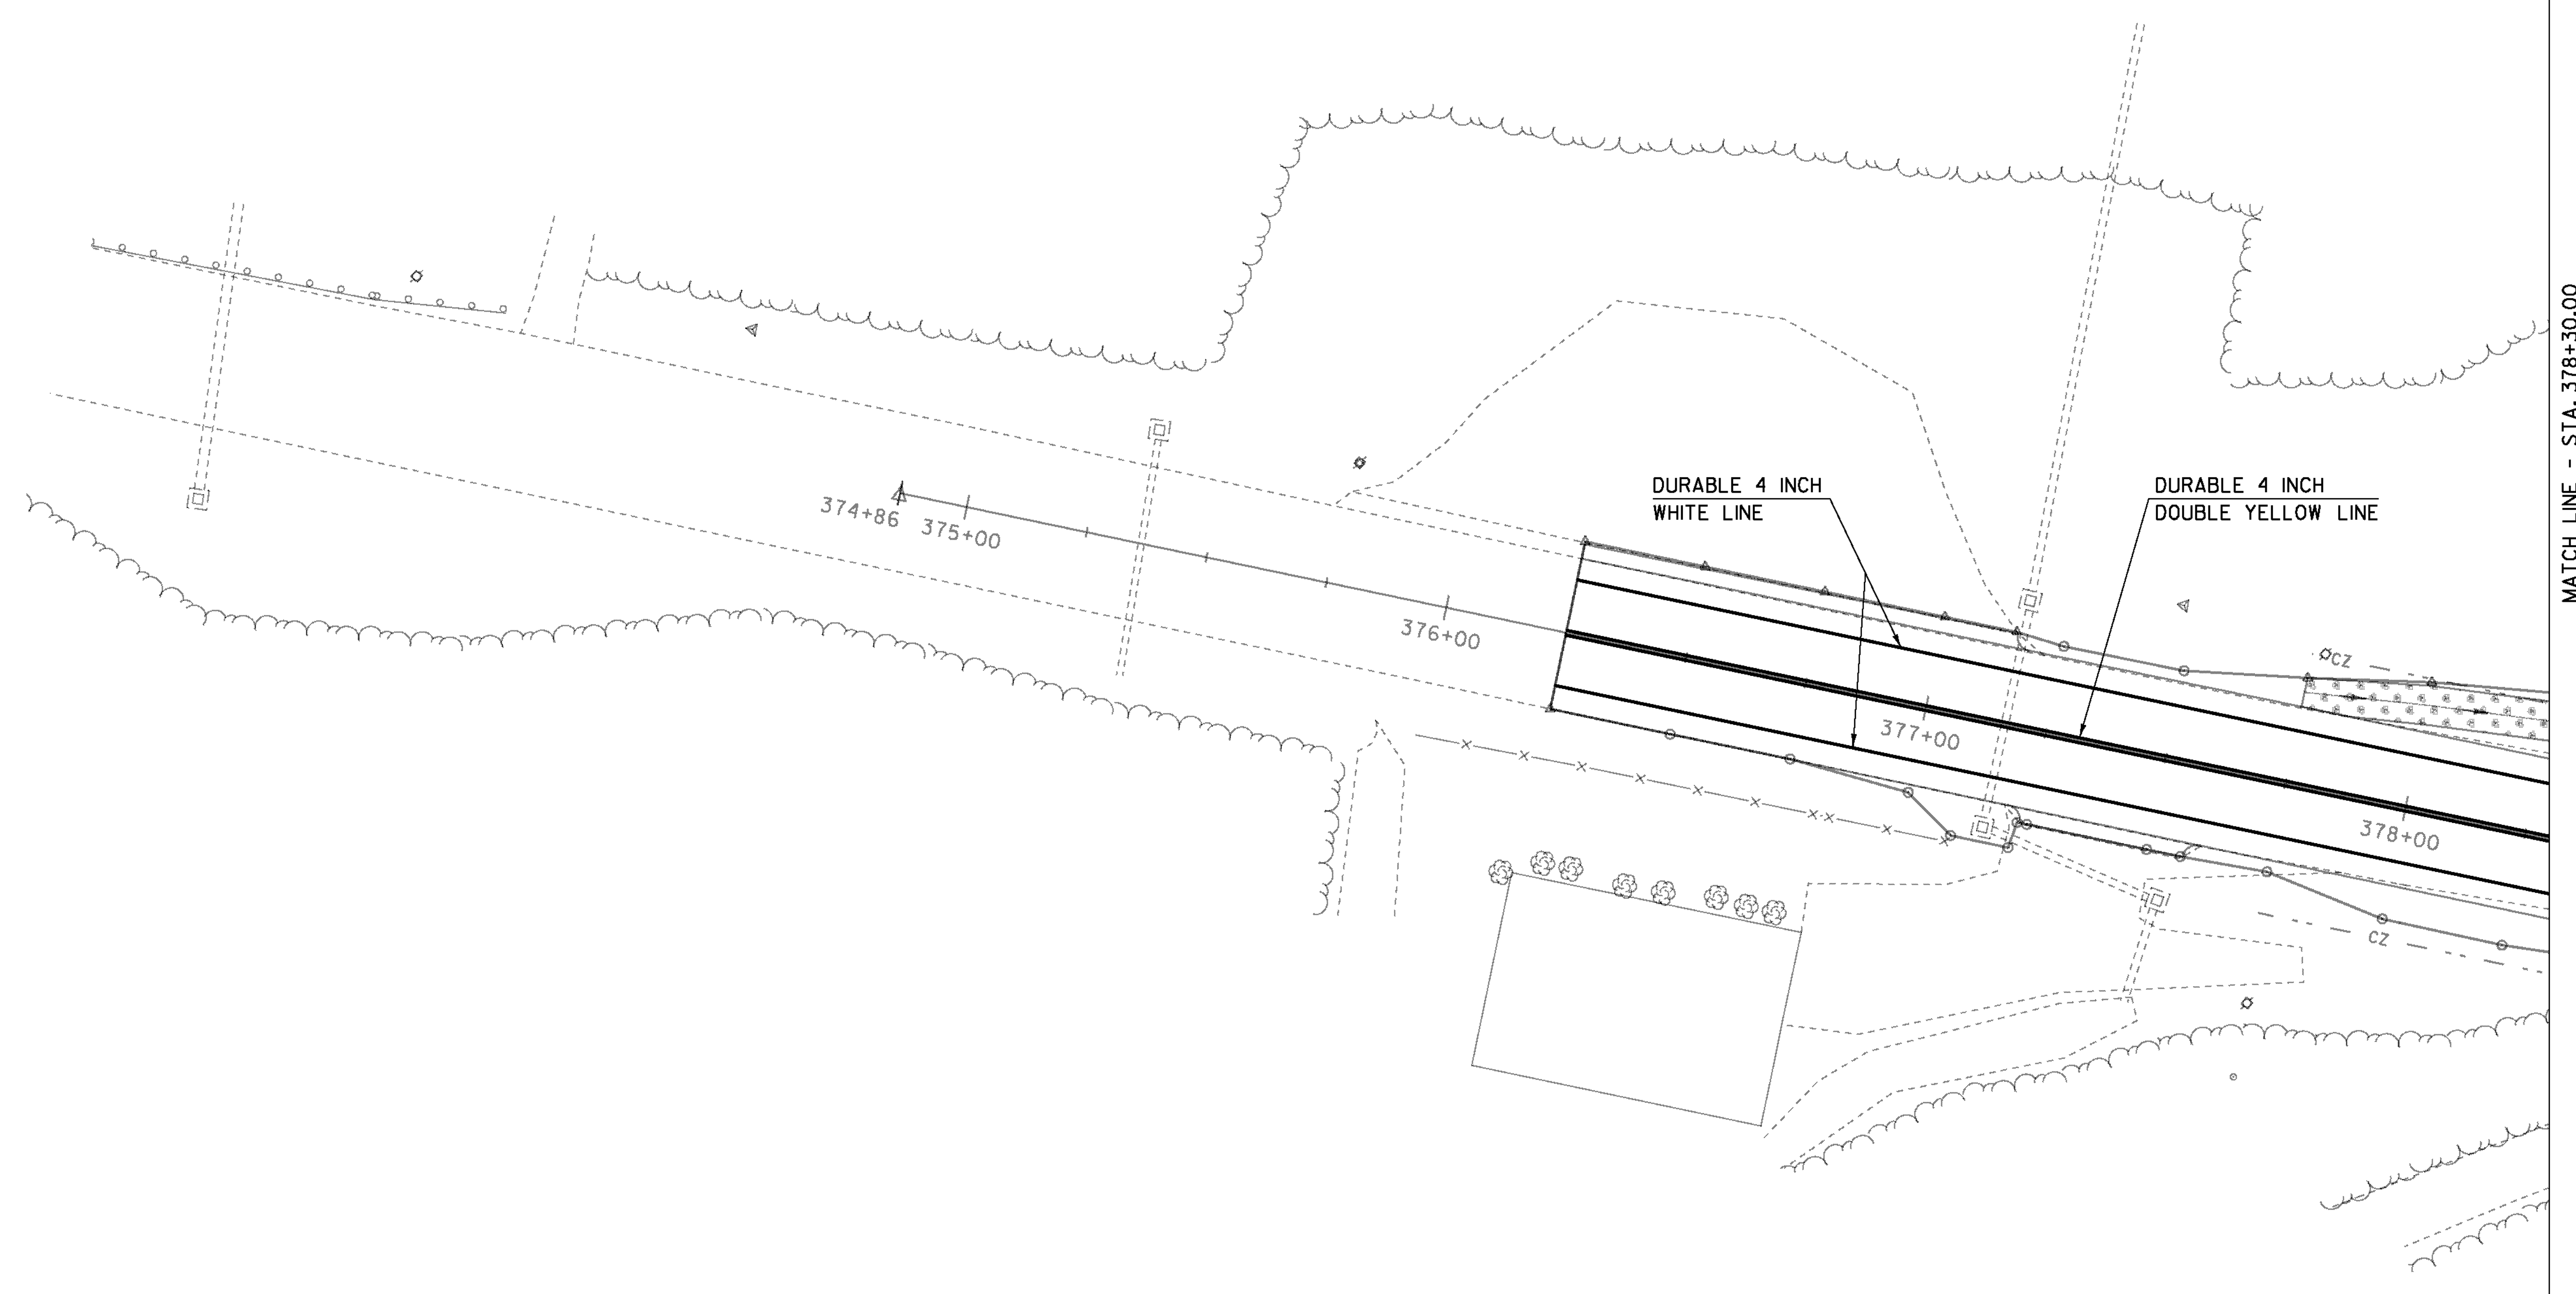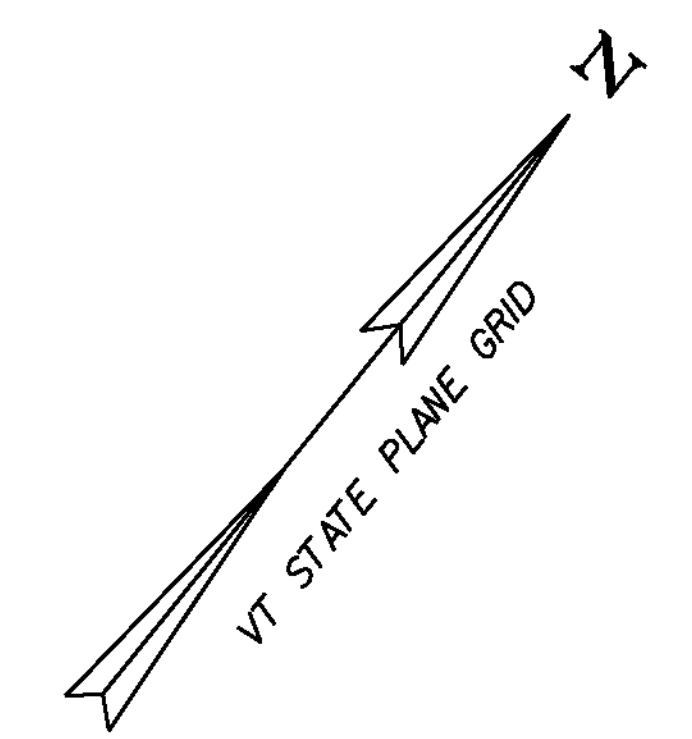



MATCH LINE - STA. 378+30.00

DURABLE 4 INCH YELLOW LINE
STA. 376+25 TO STA. 378+30 (DOUBLE Q)

DURABLE 4 INCH WHITE LINE
STA. 376+25 TO STA. 378+30 LT
STA. 376+25 TO STA. 378+30 RT

SCALE 1" = 20' - 0"
20 0 20



PROJECT NAME: ST. JOHNSBURY	PLOT DATE: 28-AUG-2012
PROJECT NUMBER: BRF 028-4(25)S	DRAWN BY: C. MOONEY
FILE NAME: s98b320trf.dgn	CHECKED BY: C. CARLSON
PROJECT LEADER: C. CARLSON	SHEET 16 OF 62
DESIGNED BY: H. SALLS	
SIGN AND STRIPING PLAN I	

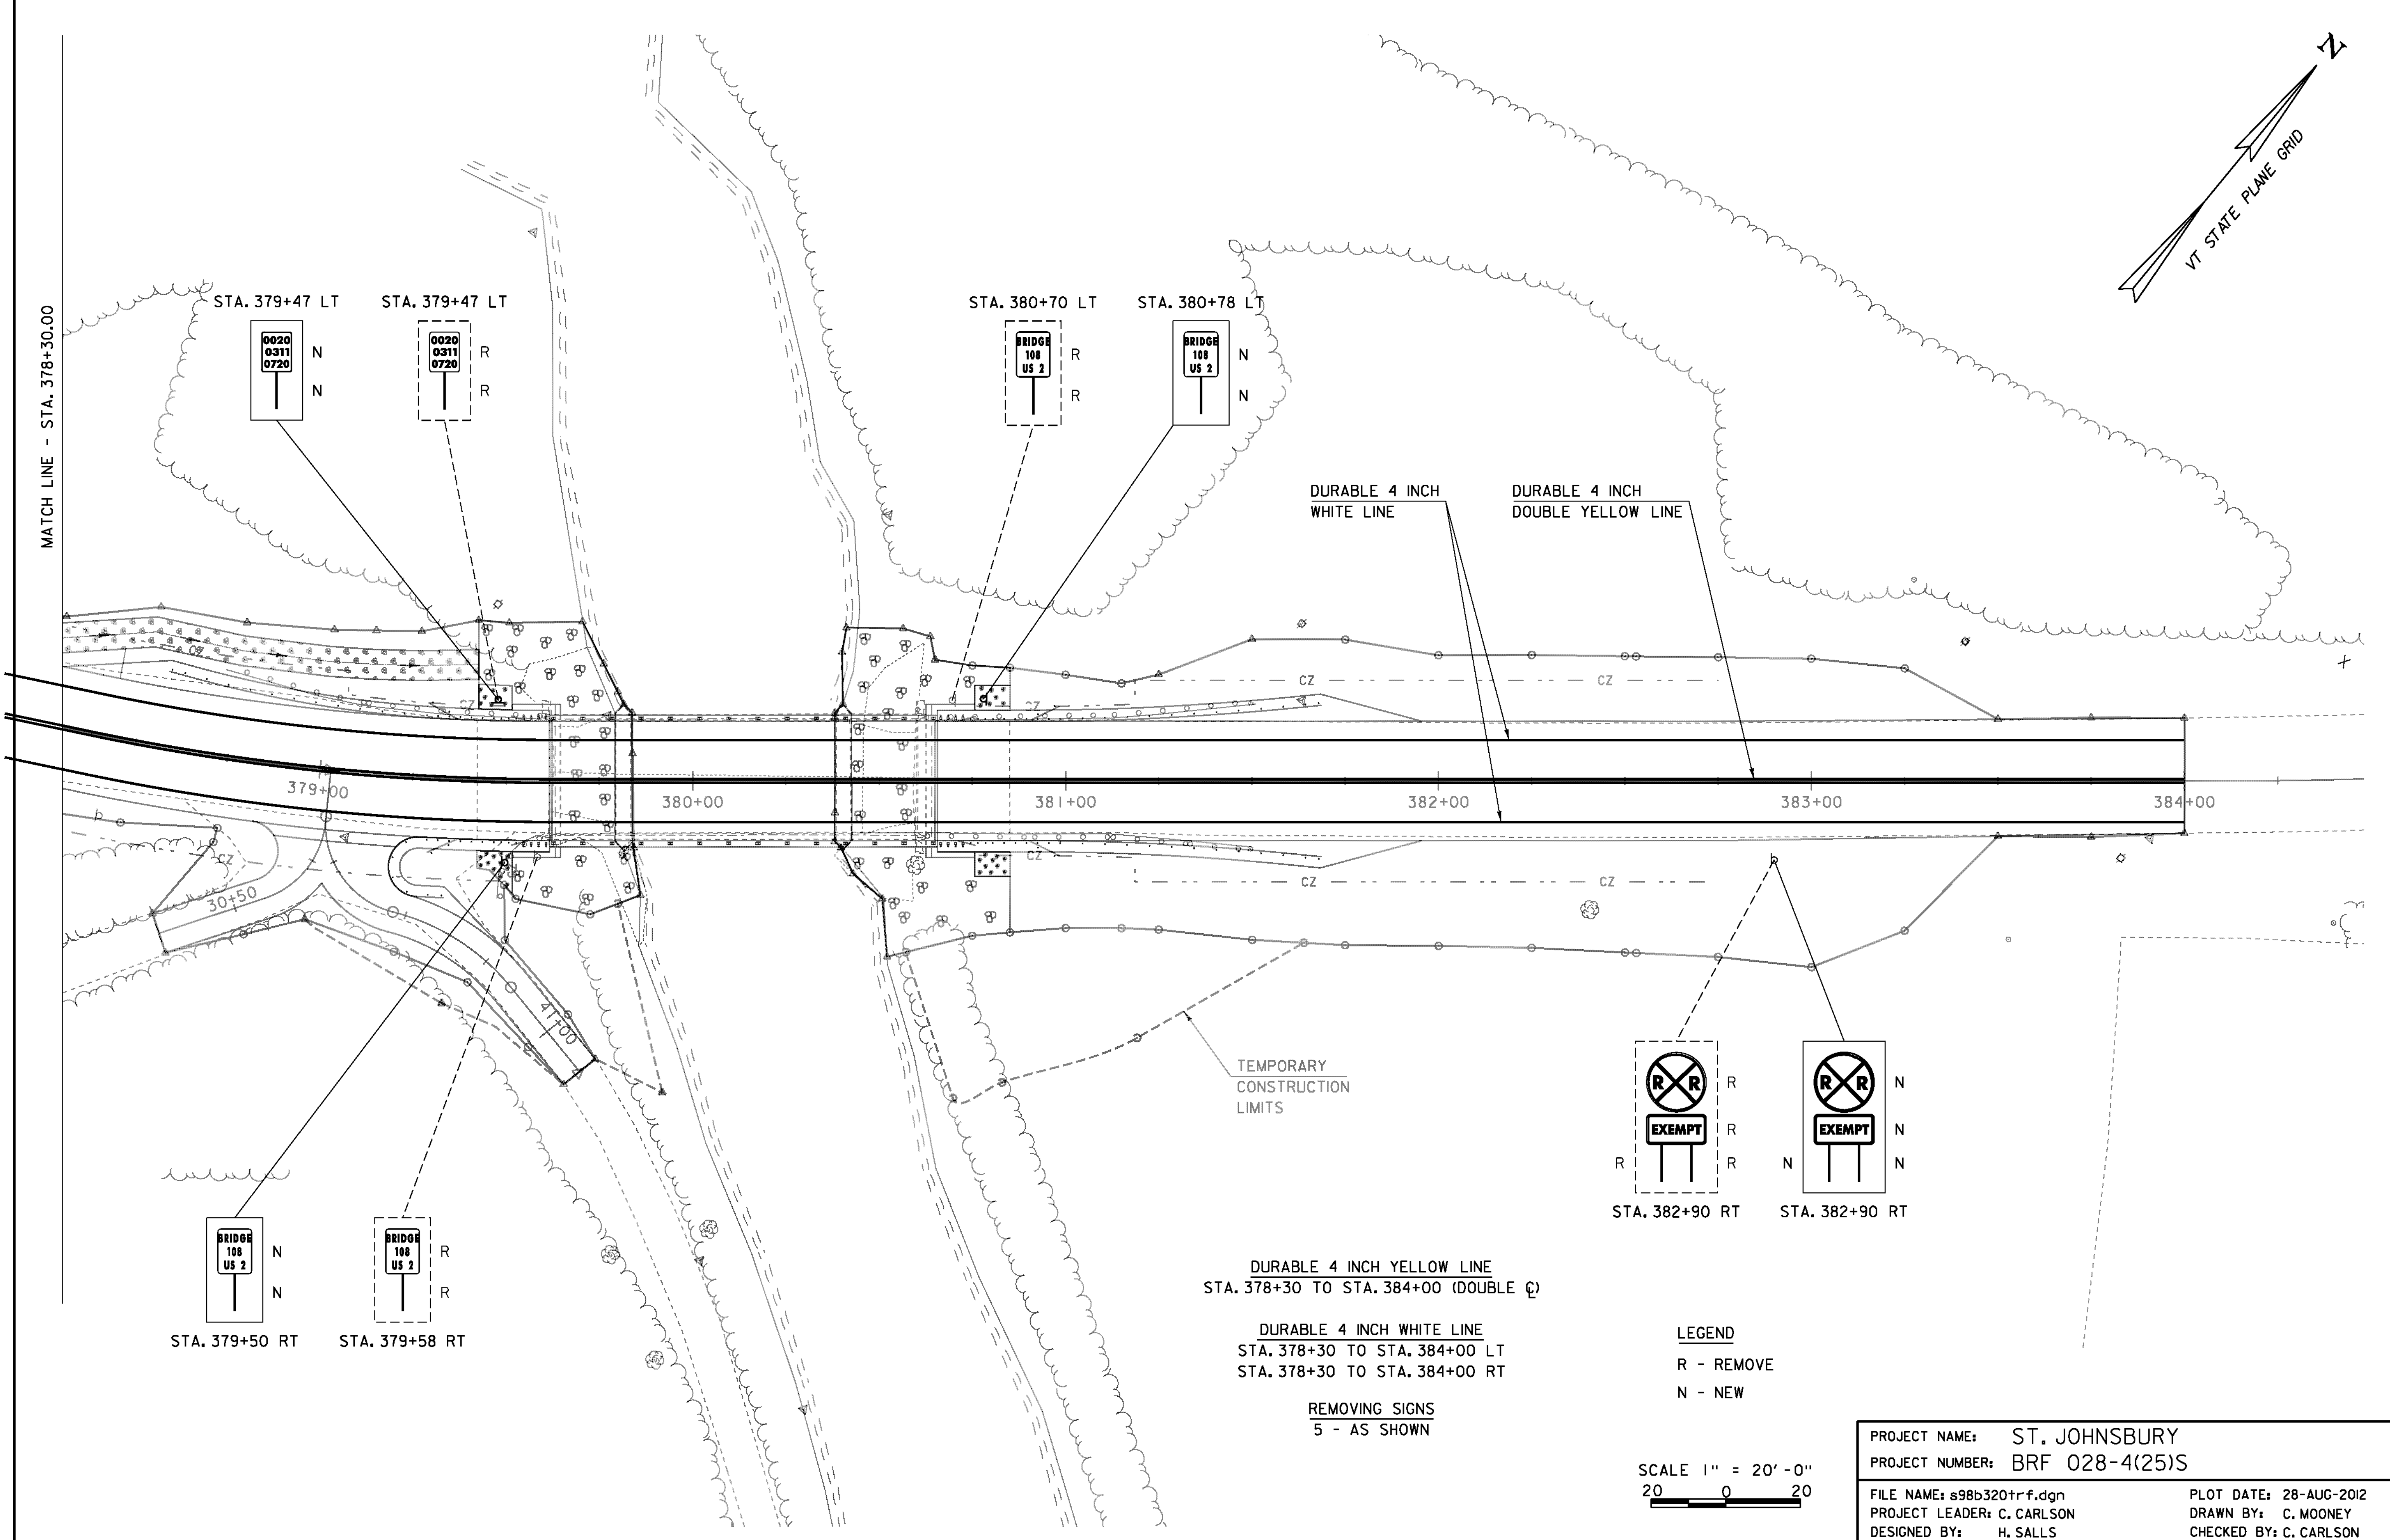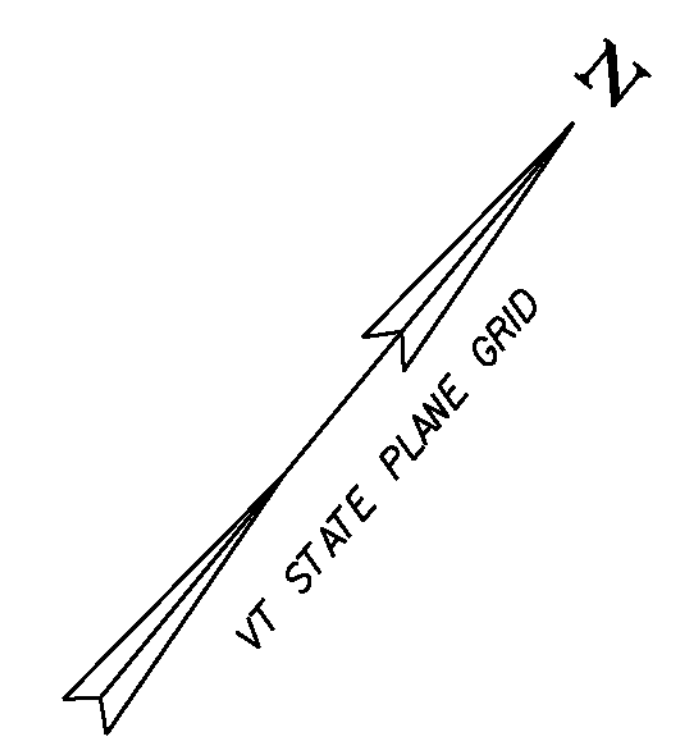

MATCH LINE - STA. 378+30.00



STA. 379+47 LT STA. 379+47 LT

STA. 380+70 LT STA. 380+78 LT

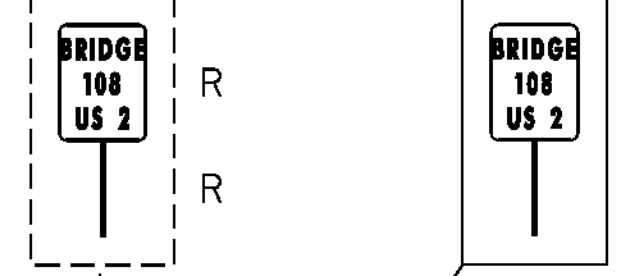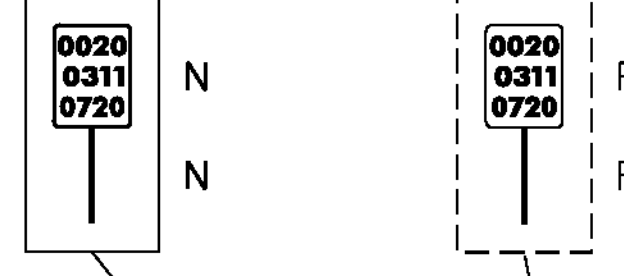

DURABLE 4 INCH WHITE LINE
DURABLE 4 INCH DOUBLE YELLOW LINE

379+00 380+00 381+00 382+00 383+00 384+00

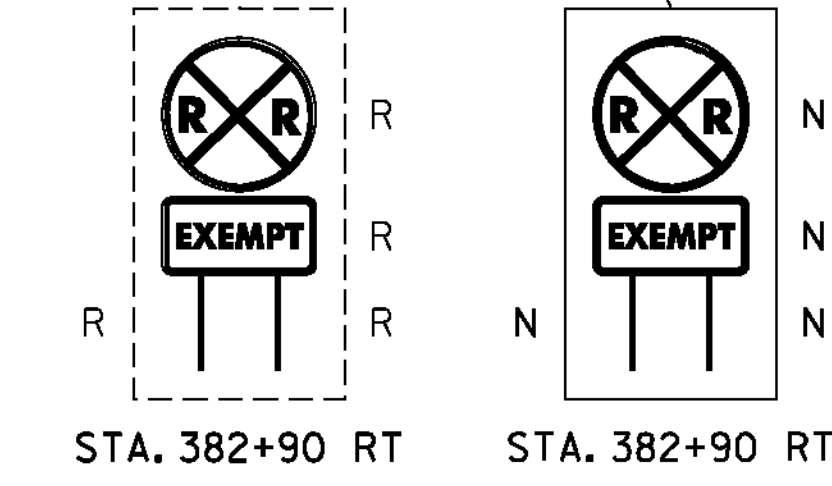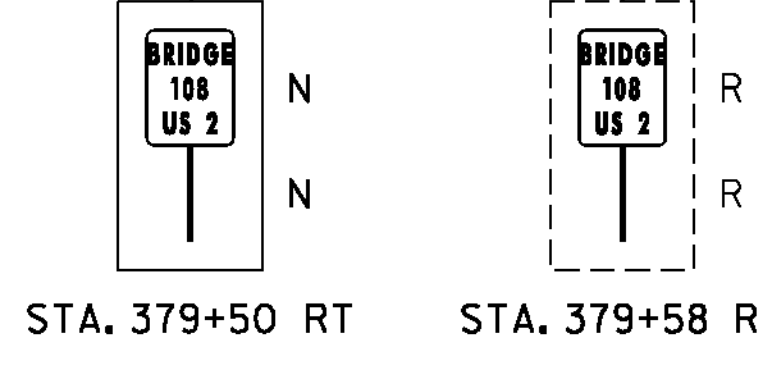

DURABLE 4 INCH YELLOW LINE
STA. 378+30 TO STA. 384+00 (DOUBLE C)



DURABLE 4 INCH WHITE LINE
STA. 378+30 TO STA. 384+00 LT
STA. 378+30 TO STA. 384+00 RT

REMOVING SIGNS
5 - AS SHOWN

LEGEND
R - REMOVE
N - NEW

SCALE 1" = 20' - 0"
20 0 20

PROJECT NAME: ST. JOHNSBURY	PLOT DATE: 28-AUG-2012
PROJECT NUMBER: BRF 028-4(25)S	DRAWN BY: C. MOONEY
FILE NAME: s98b320trf.dgn	CHECKED BY: C. CARLSON
PROJECT LEADER: C. CARLSON	SHEET 17 OF 62
DESIGNED BY: H. SALLS	
SIGN AND STRIPING PLAN 2	

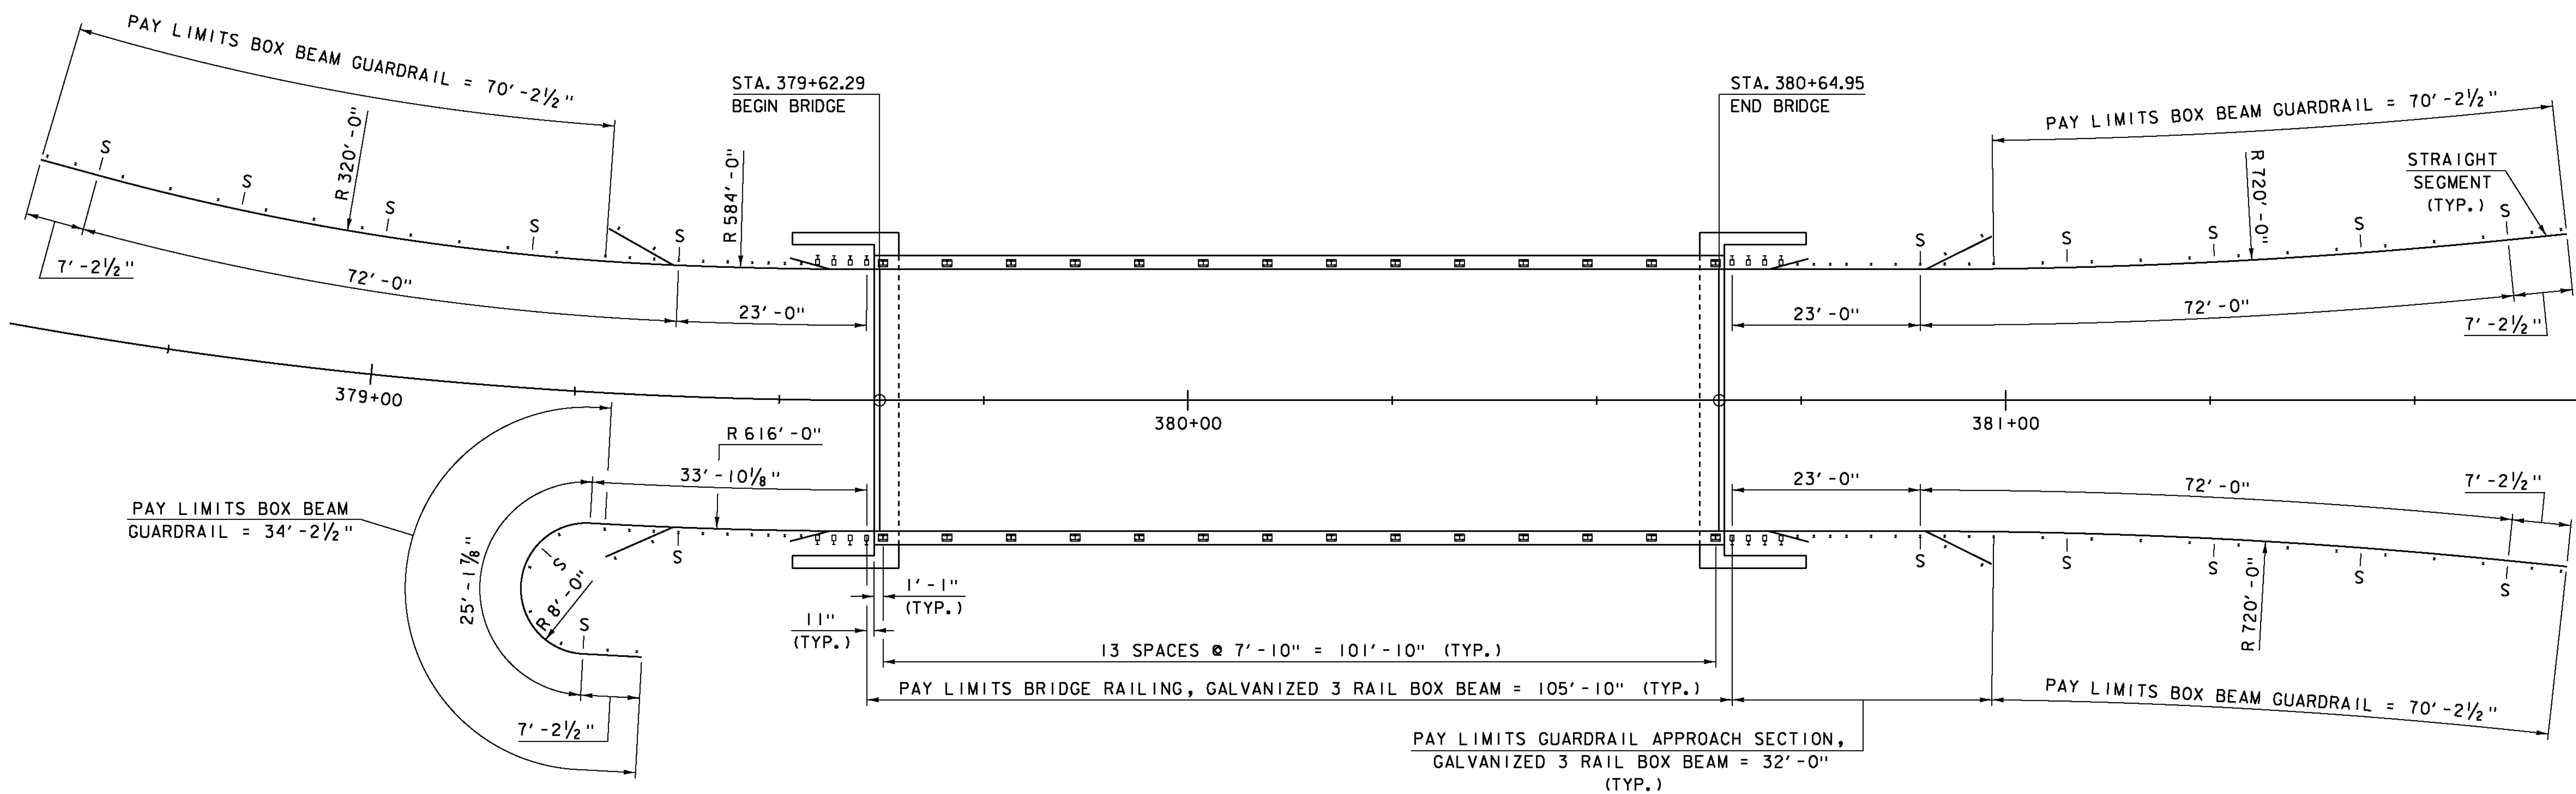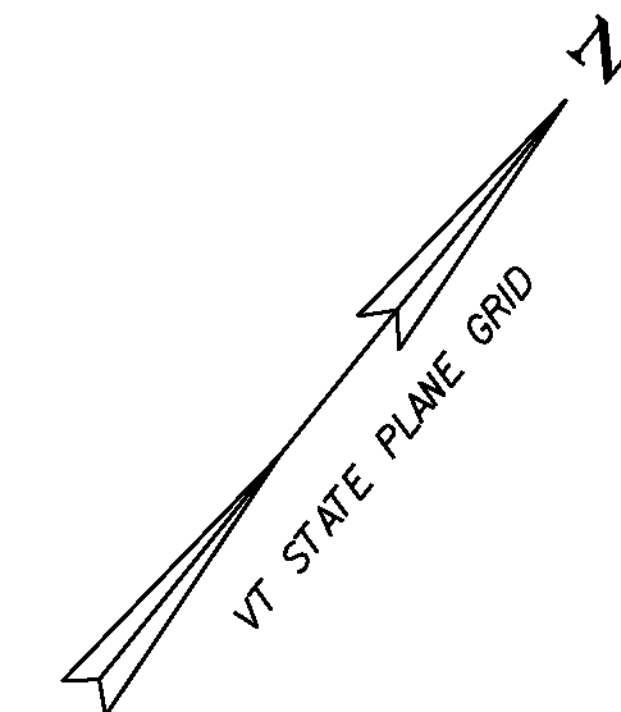

PAY LIMITS BOX BEAM GUARDRAIL = 34'-2 1/2"


PAY LIMITS BRIDGE RAILING, GALVANIZED 3 RAIL BOX BEAM = 105'-10" (TYP.)

PAY LIMITS GUARDRAIL APPROACH SECTION,
GALVANIZED 3 RAIL BOX BEAM = 32'-0" (TYP.)

S = SPLICE LOCATION
BOX BEAM GUARDRAIL

SEE STDS:
G-1B, S-364A, S-364B,
S-364C, S-364D
FOR DETAILS

PROJECT NAME:	ST. JOHNSBURY
PROJECT NUMBER:	BRF 028-4(25)S
FILE NAME:	s98b320rdll.dgn
PROJECT LEADER:	C. CARLSON
DESIGNED BY:	H. SALLS
GUARDRAIL LAYOUT	
PLOT DATE:	28-AUG-2012
DRAWN BY:	R. PELLETT
CHECKED BY:	C. CARLSON
SHEET	19 OF 62

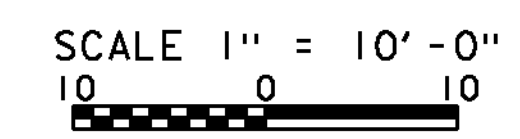

SOIL CLASSIFICATION

AASHTO

A1	Gravel and Sand
A3	Fine Sand
A2	Silty or Clayey Gravel and Sand
A4	Silty Soil - Low Compressibility
A5	Silty Soil - Highly Compressible
A6	Clayey Soil - Low Compressibility
A7	Clayey Soil - Highly Compressible

ROCK QUALITY DESIGNATION

R.Q.D. (%)	ROCK DESCRIPTION
<25	Very Poor
25 to 50	Poor
51 to 75	Fair
76 to 90	Good
>90	Excellent

SHEAR STRENGTH

UNDRAINED SHEAR STRENGTH IN P.S.F.	CONSISTENCY
<250	Very Soft
250-500	Soft
500-1000	Med. Stiff
1000-2000	Stiff
2000-4000	Very Stiff
>4000	Hard


CORRELATION GUIDE OF "N" TO DENSITY/CONSISTENCY

DENSITY (GRANULAR SOILS)		CONSISTENCY (COHESIVE SOILS)	
N	DESCRIPTIVE TERM	N	DESCRIPTIVE TERM
<5	Very Loose	<2	Very Soft
5-10	Loose	2-4	Soft
11-24	Med. Dense	5-8	Med. Stiff
25-50	Dense	9-15	Stiff
>50	Very Dense	16-30	Very Stiff
		31-60	Hard
		>60	Very Hard

COMMONLY USED SYMBOLS

- ▼ Water Elevation
- ⊕ Standard Penetration Boring
- ⊗ Auger Boring
- ⊙ Rod Sounding
- S Sample
- N Standard Penetration Test
- Blow Count Per Foot For:
- 2" O.D. Sampler
- 1 3/8" I.D. Sampler
- Hammer Weight Of 140 Lbs.
- Hammer Fall Of 30"
- VS Field Vane Shear Test
- US Undisturbed Soil Sample
- B Blast
- DC Diamond Core
- MD Mud Drill
- WA Wash Ahead
- HSA Hollow Stem Auger
- AX Core Size 1 1/8"
- BX Core Size 1 5/8"
- NX Core Size 2 1/8"
- M Double Tube Core Barrel Used
- LL Liquid Limit
- PL Plastic Limit
- PI Plasticity Index
- NP Non Plastic
- w Moisture Content (Dry Wgt. Basis)
- D Dry
- M Moist
- MTW Moist To Wet
- W Wet
- Sat Saturated
- Bo Boulder
- Gr Gravel
- Sa Sand
- Si Silt
- Cl Clay
- HP Hardpan
- Le Ledge
- NLTD No Ledge To Depth
- CNPF Can Not Penetrate Further
- TLOB To Ledge Or Boulder
- NR No Recovery
- Rec. Recovery
- %Rec. Percent Recovery
- RQD Rock Quality Designation
- CBR California Bearing Ratio
- < Less Than
- > Greater Than
- R Refusal (N > 100)

COLOR			
blk	Black	pnk	Pink
bl	Blue	pu	Purple
brn	Brown	rd	Red
dk	Dark	tn	Tan
gry	Gray	wh	White
gn	Green	yel	Yellow
lt	Light	mltc	Multicolored
or	Orange		

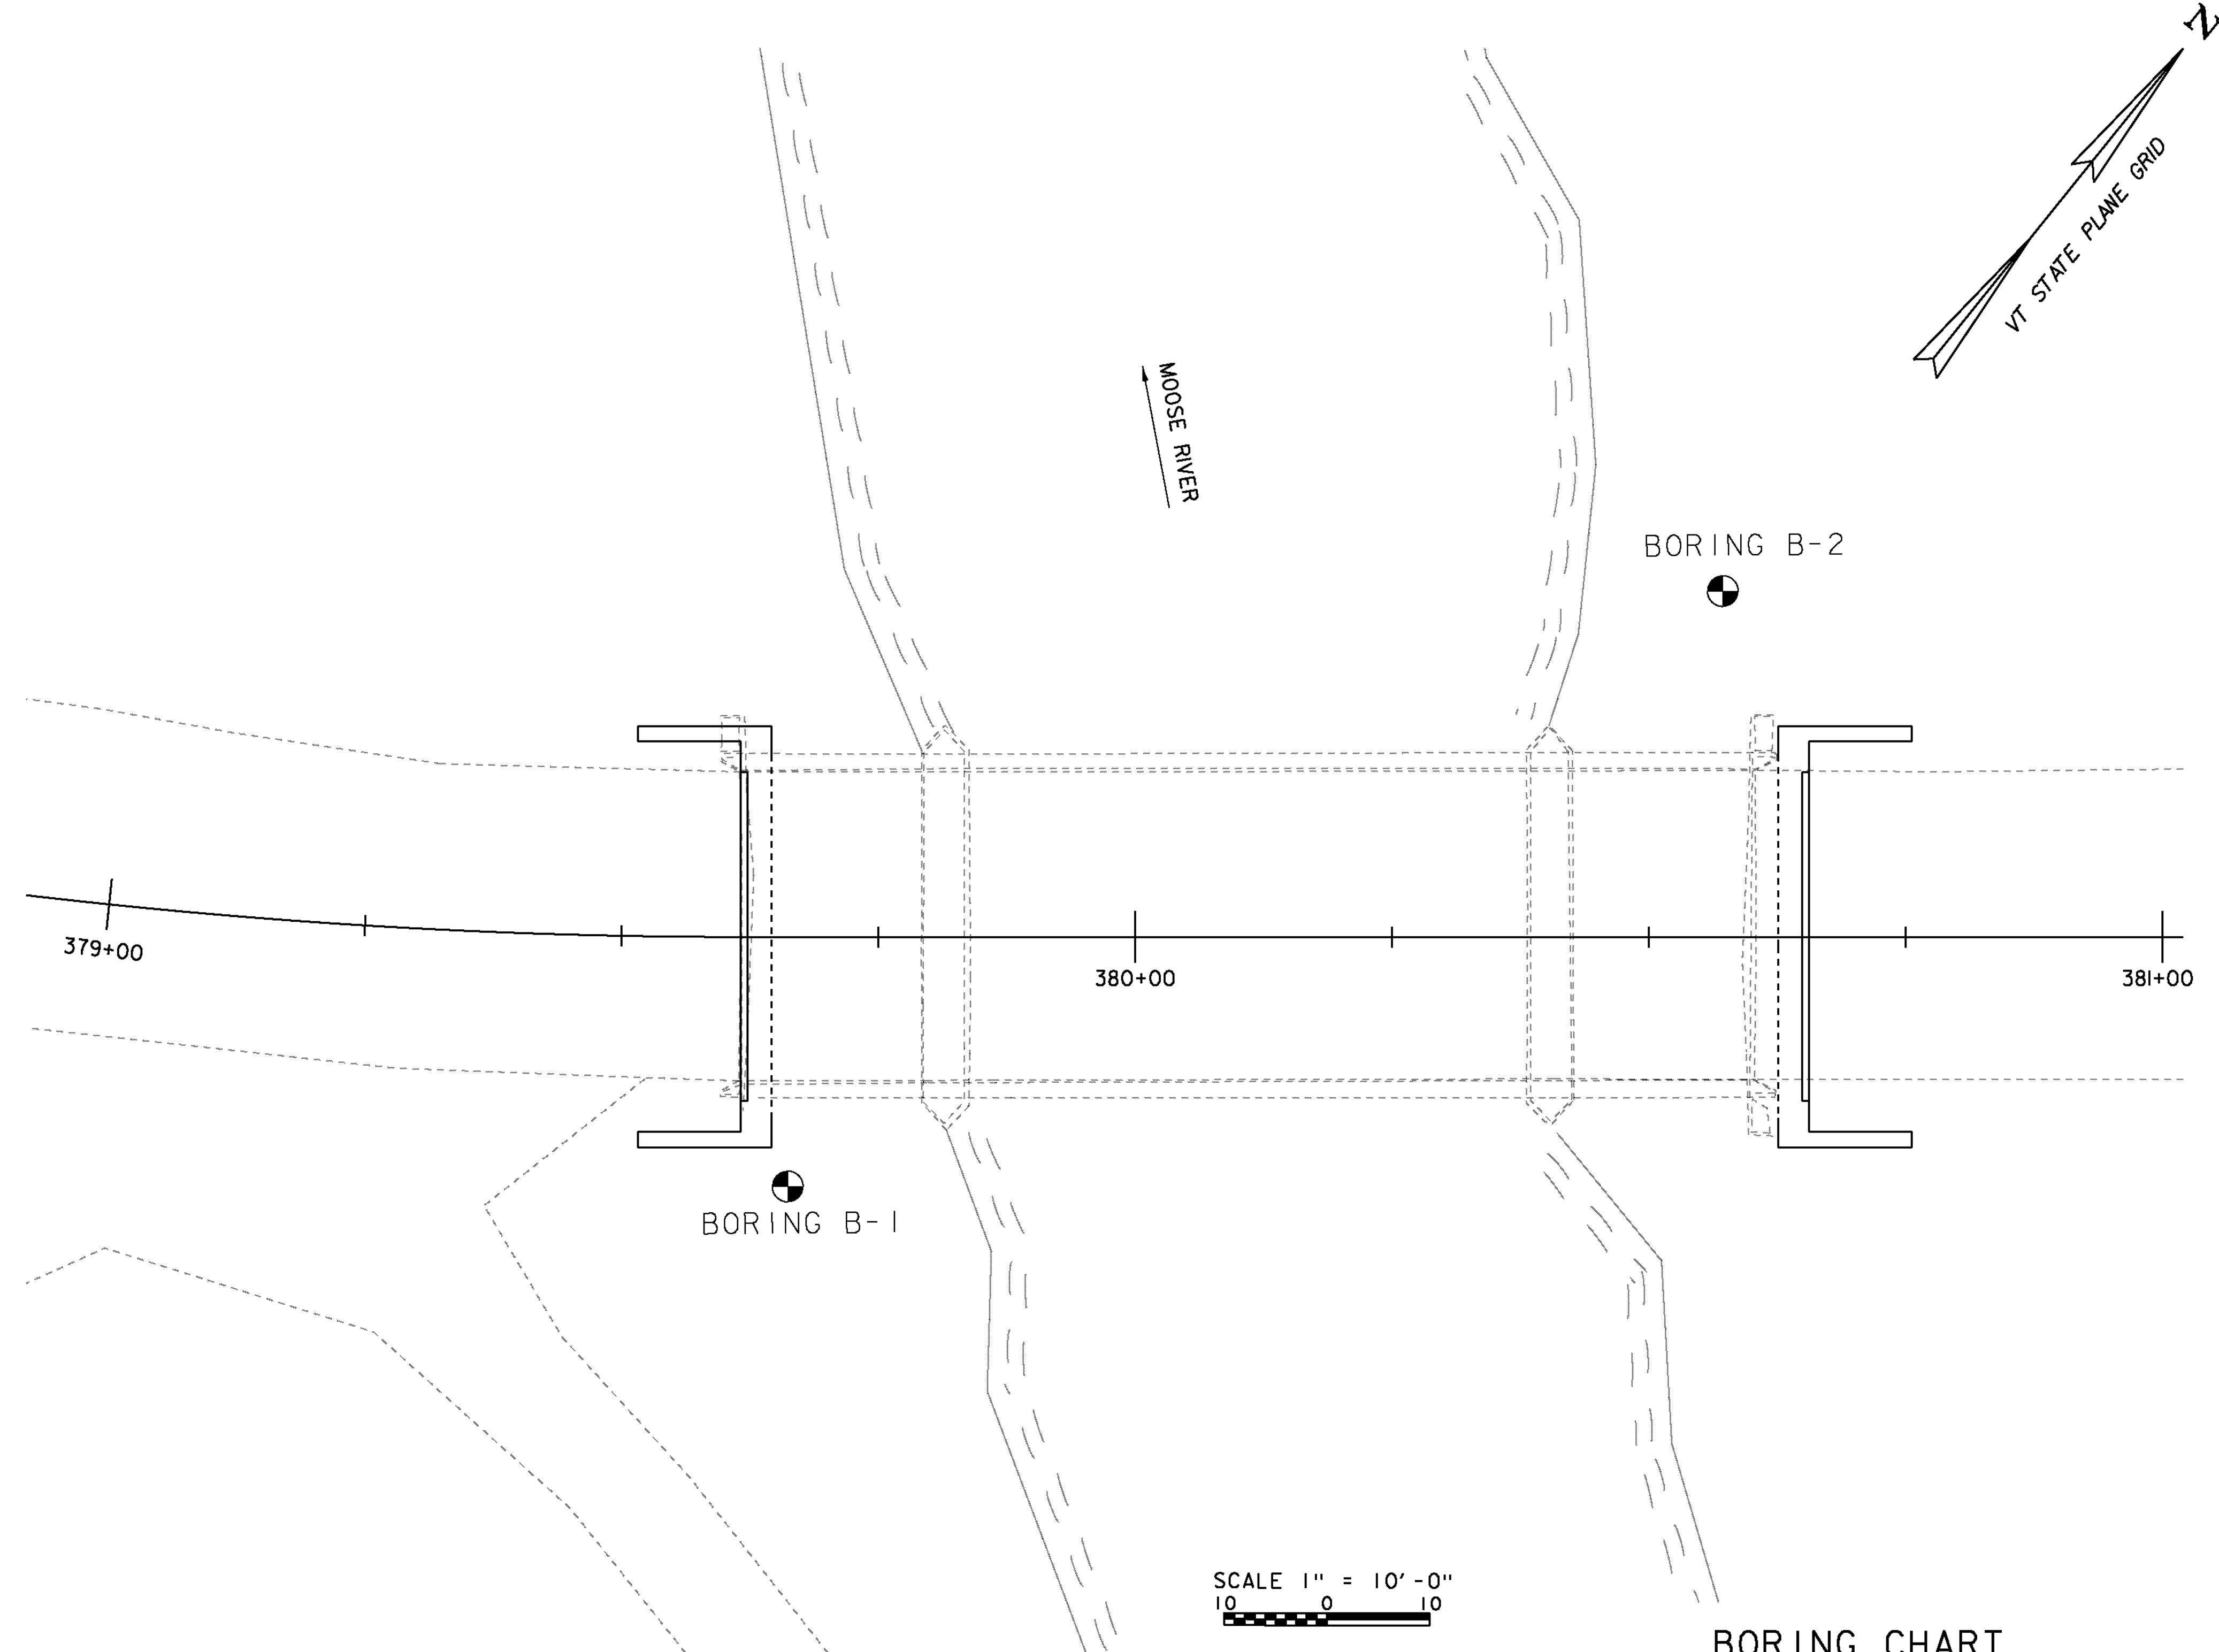

SCALE 1" = 10'-0"
10 0 10

BORING CHART

HOLE NO.	ML STATION	OFFSET	GROUND ELEV.	ELEV. TLOB
B-1	379+66	25.00 RT	749.94	689.94
B-2	380+57	34.00 LT	744.19	693.19


DEFINITIONS (AASHTO)

- BEDROCK (LEDGE)** - Rock in its native location of indefinite thickness.
- BOULDER** - A rock fragment with an average dimension > 12 inches.
- COBBLE** - Rock fragments with an average dimension between 3 and 12 inches.
- GRAVEL** - Rounded particles of rock < 3" and > 0.075" (#10 sieve).
- SAND** - Particles of rock < 0.075" (#10 sieve) and > 0.0025" (#200 sieve).
- SILT** - Soil < 0.0025" (#200 sieve), non or slightly plastic and exhibits no strength when air-dried.
- CLAY** - Fine grained soil, exhibits plasticity when moist and considerable strength when air-dried.
- VARVED** - Alternate layers of silt and clay.
- HARDPAN** - Extremely dense soil, cemented layer, not softened when wet.
- MUCK** - Soft organic soil (containing > 10% organic material).
- MOISTURE CONTENT** - Weight of water divided by dry weight of soil.
- FLOWING SAND** - Granular soil so saturated (loose) that it flows into drill casing during extraction of wash rod.
- STRIKE** - Angle from magnetic north to line of intersection of bed with a horizontal plane.
- DIP** - Inclination of bed with a horizontal plane.


GENERAL NOTES

- The subsurface explorations shown herein were made between 10/13/05 and 11/02/05 by the Agency.
- Soil and rock classifications, properties and descriptions are based on engineering interpretation from available subsurface information by the Agency and may not necessarily reflect actual variations in subsurface conditions that may be encountered between individual boring or sample locations.
- Observed water levels and/or conditions indicated are as recorded at the time of exploration and may vary according to the prevailing rainfall, methods of exploration and other factors.
- Engineering judgment was exercised in preparing the subsurface information presented herein. Analysis and interpretation of subsurface data was performed and interpreted for Agency design and estimating purposes. Presentation of the information in the Contract is intended to provide the Contractor access to the same data available to the Agency. The subsurface information is presented in good faith and is not intended as a substitute for personal investigation, independent interpretation, independent analysis or judgment by the Contractor.
- Pictorial structure details shown on the boring plan layout or soils profile are for illustrative purposes only and may not accurately portray final contract details.
- Terminology used on boring logs to describe the hardness, degree of weathering, and spacing of fractures, joints and other discontinuities in the bedrock is defined in the AASHTO Manual on Subsurface Investigations, 1988.

PROJECT NAME: ST. JOHNSBURY
 PROJECT NUMBER: BRF 028-4(25)
 FILE NAME: s98b320bor.dgn PLOT DATE: 28-AUG-2012
 PROJECT LEADER: C. CARLSON DRAWN BY: C. MOONEY
 DESIGNED BY: H. SALLS CHECKED BY: C. CARLSON
 BORING LAYOUT SHEET 20 OF 62


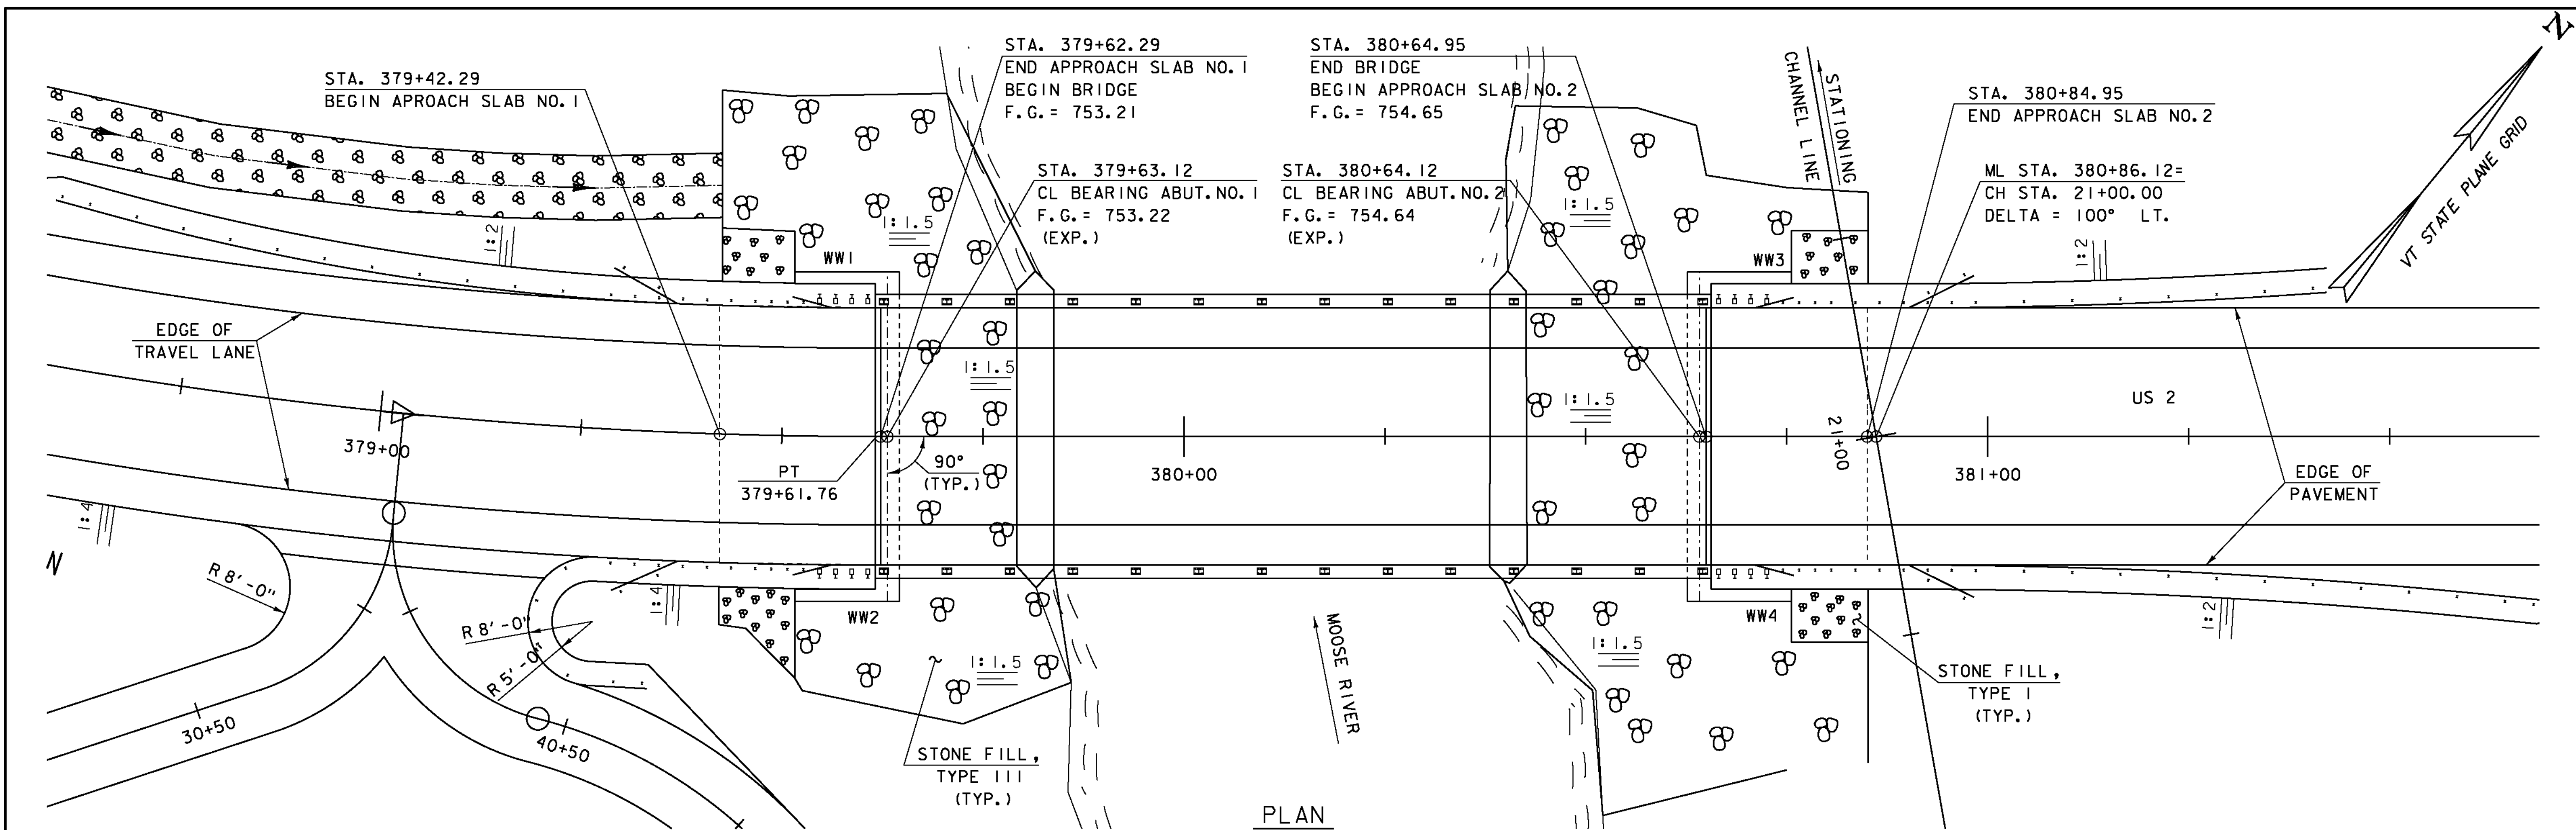


PLAN
SCALE 1" = 10'-0"
10 0 10

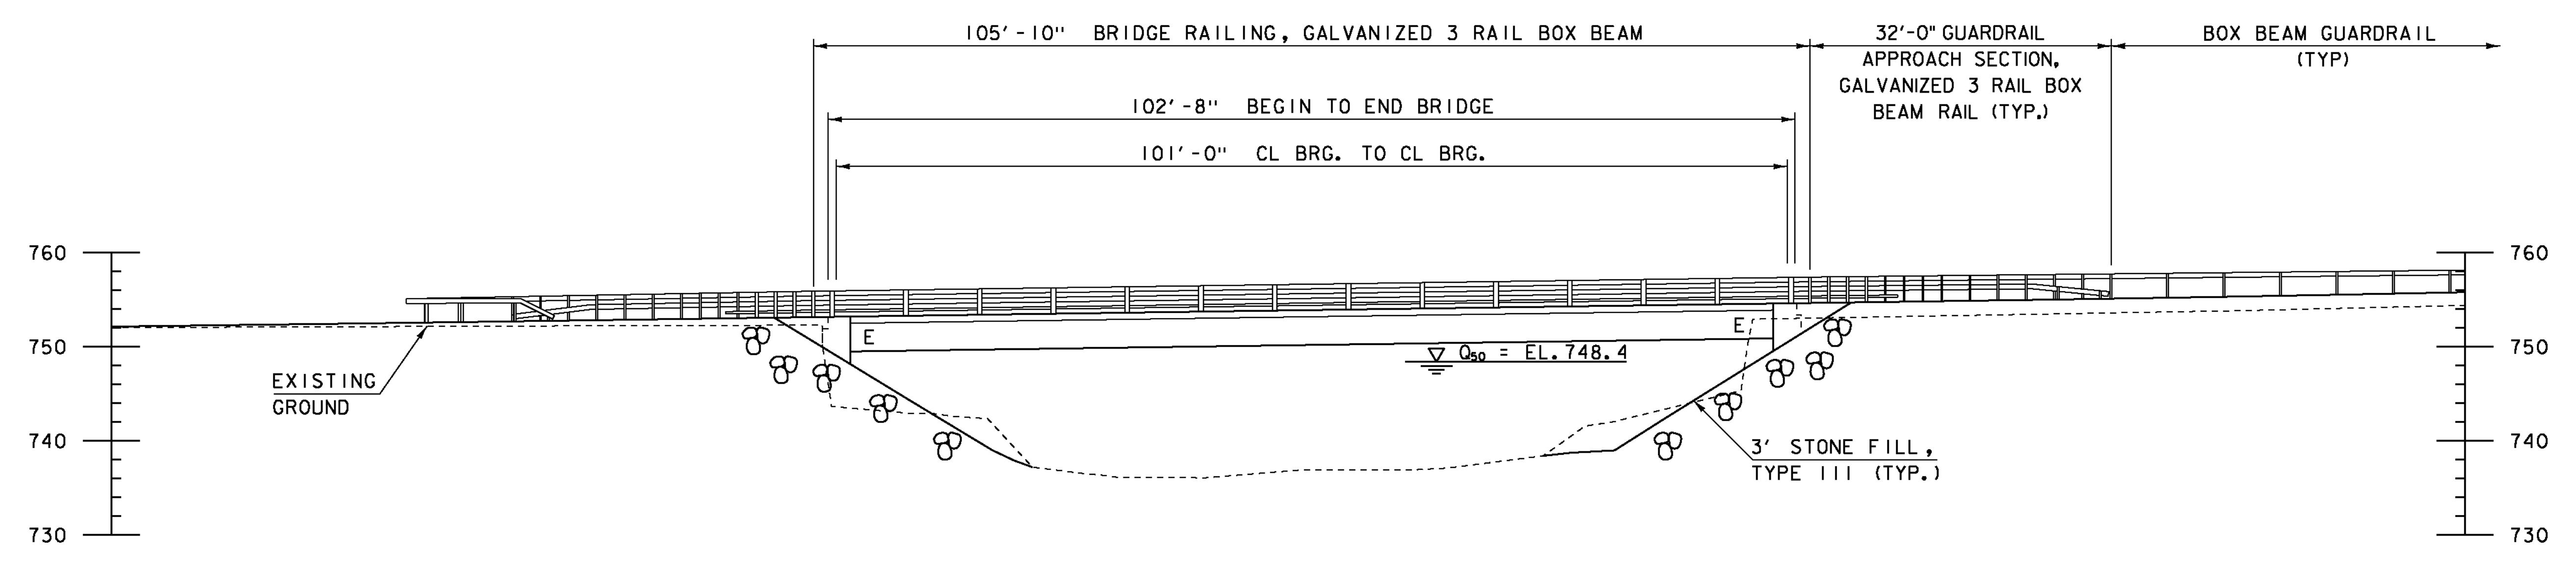




ELEVATION
SCALE 1" = 10'-0"
10 0 10

PROJECT NAME: ST. JOHNSBURY	PLOT DATE: 28-AUG-2012
PROJECT NUMBER: BRF 028-4(25)S	DRAWN BY: C. MOONEY
FILE NAME: s98b320pe.dgn	CHECKED BY: C. CARLSON
PROJECT LEADER: C. CARLSON	SHEET 22 OF 62
DESIGNED BY: H. SALLS	
PLAN AND ELEVATION	

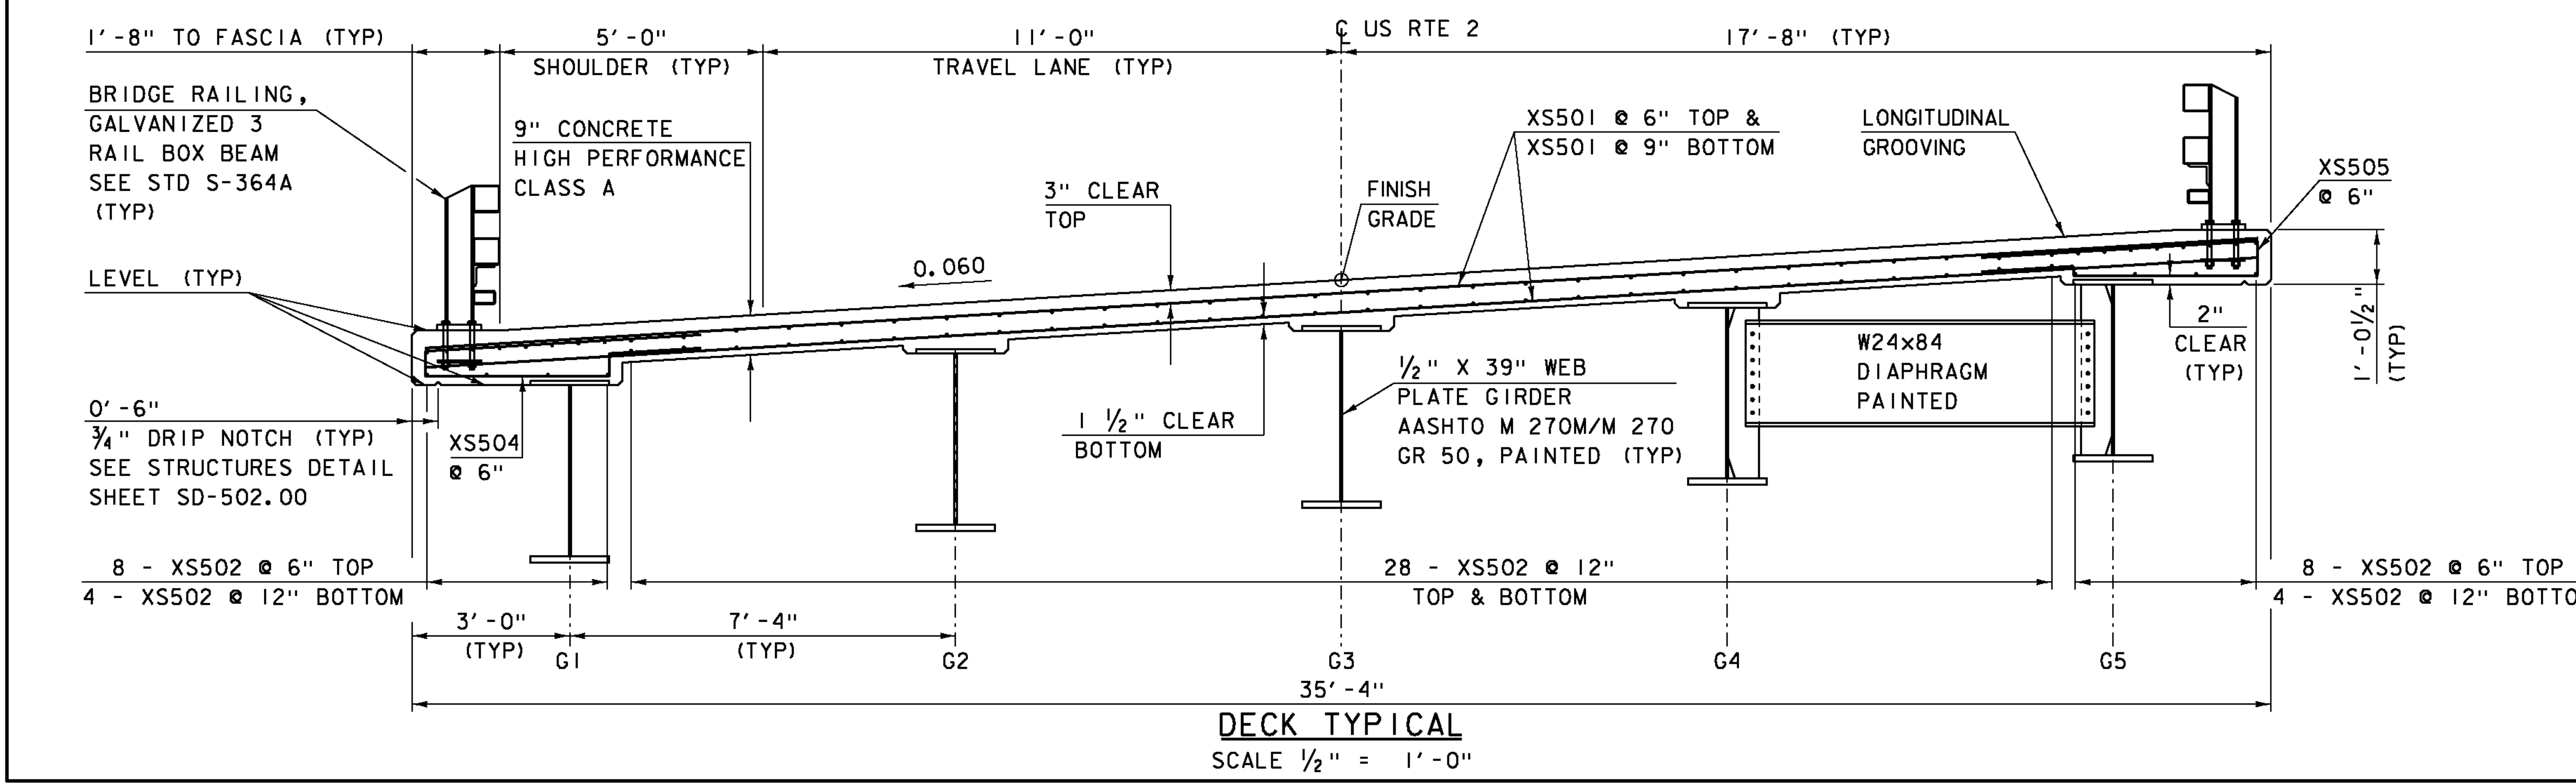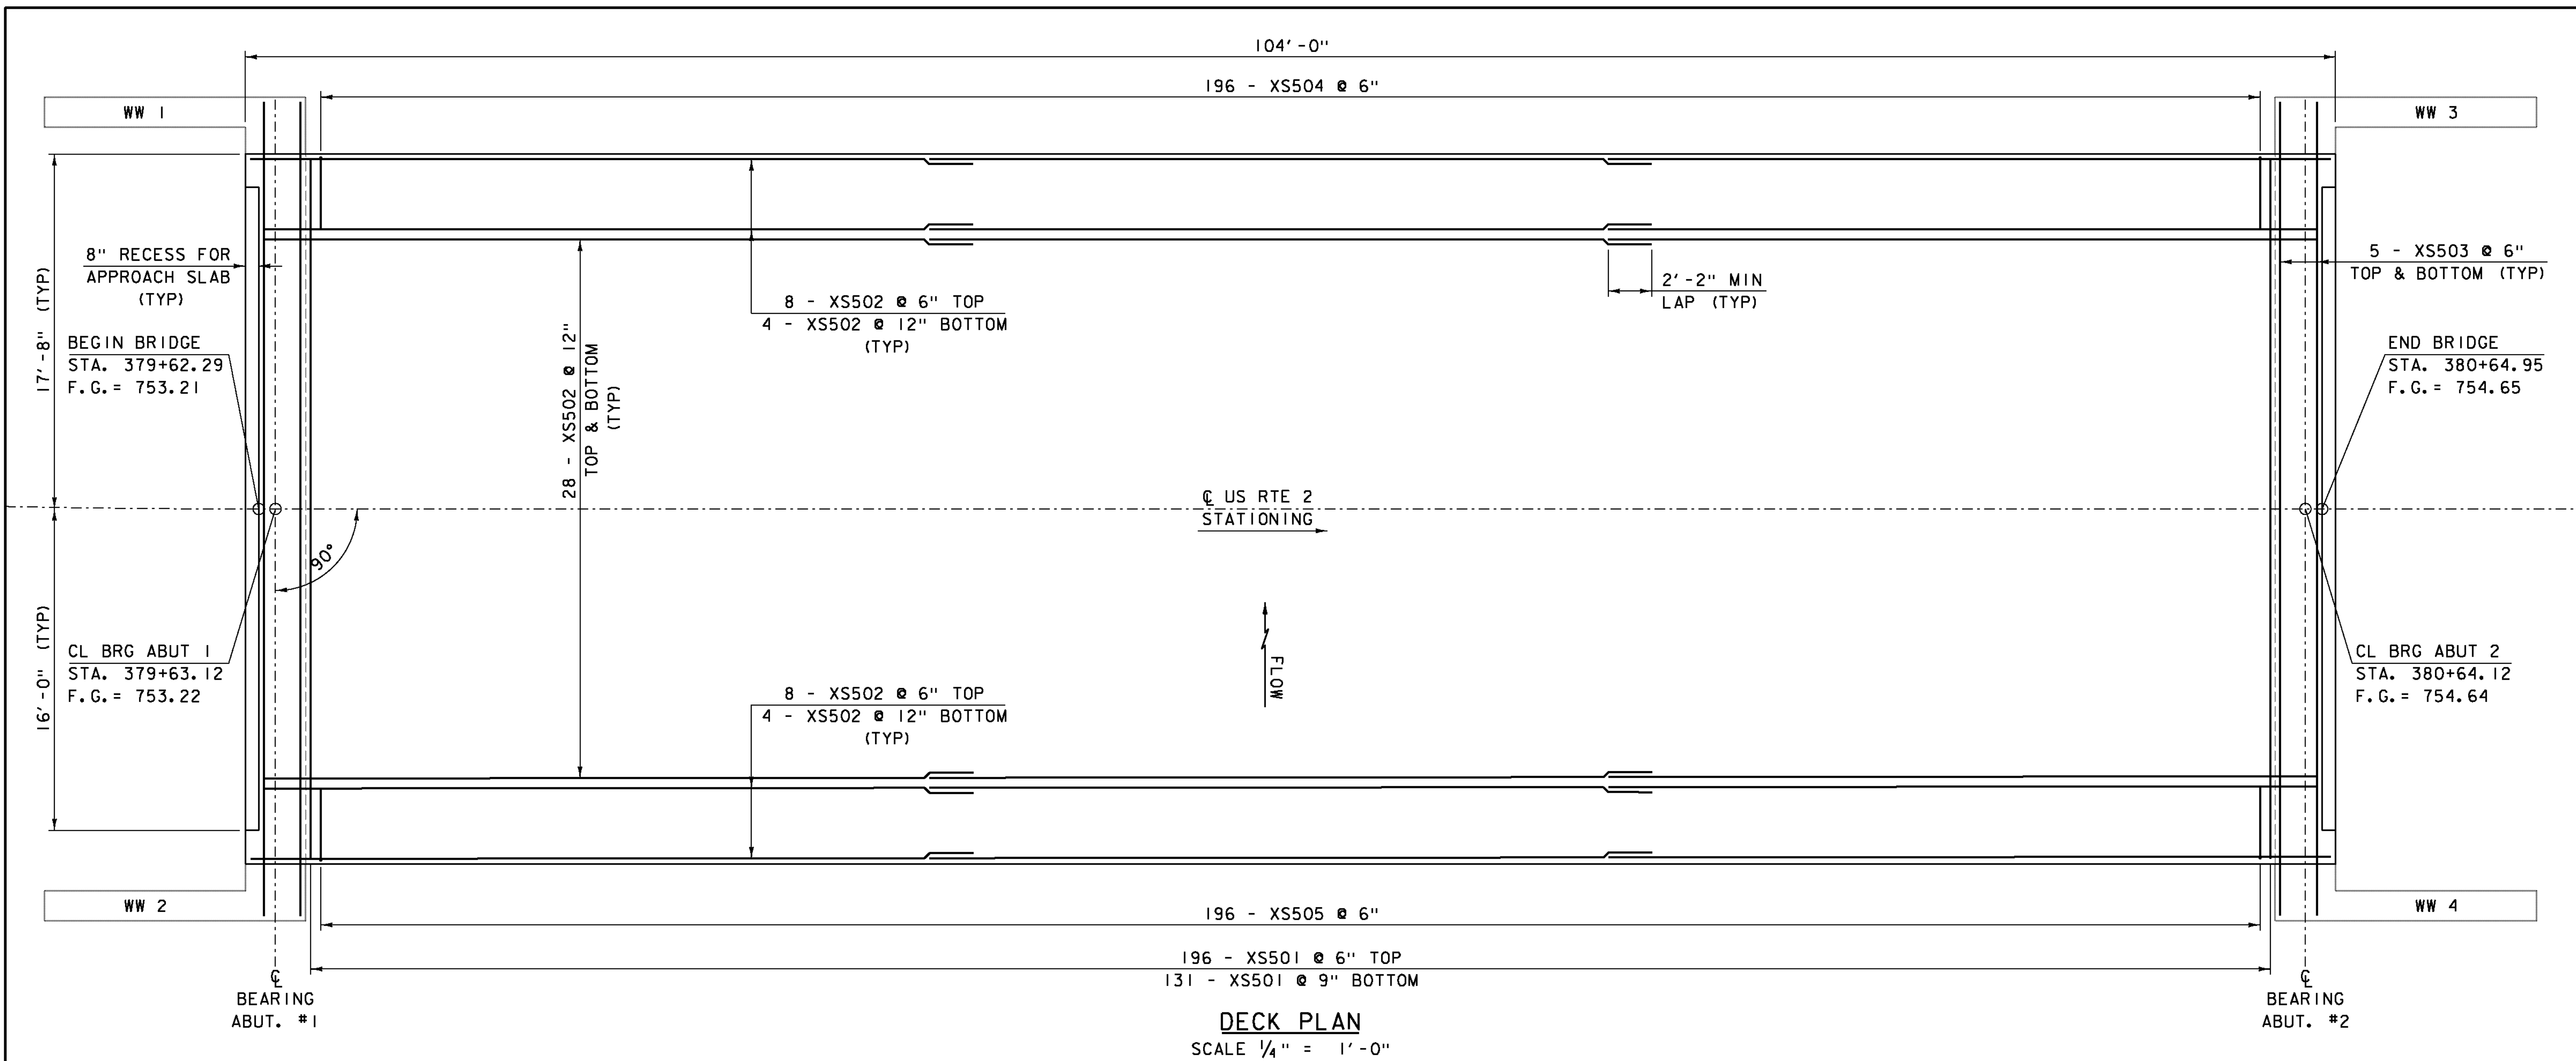

NOTE:
 NF = NEAR FACE
 FF = FAR FACE
 EF = EACH FACE
 ▲ = CUT TO FIT IN FIELD
 3" CLEAR, UNLESS OTHERWISE SPECIFIED ON THE PLANS.
 2'-2" BAR LAP UNLESS OTHERWISE SPECIFIED ON THE PLANS.

PROJECT NAME:	ST. JOHNSBURY
PROJECT NUMBER:	BRF 028-4(25)
FILE NAME:	s98b320sup.dgn
PROJECT LEADER:	C. CARLSON
DESIGNED BY:	H. SALLS
DECK DETAILS	
PLOT DATE:	28-AUG-2012
DRAWN BY:	R. PELLET
CHECKED BY:	C. CARLSON
SHEET	23 OF 62


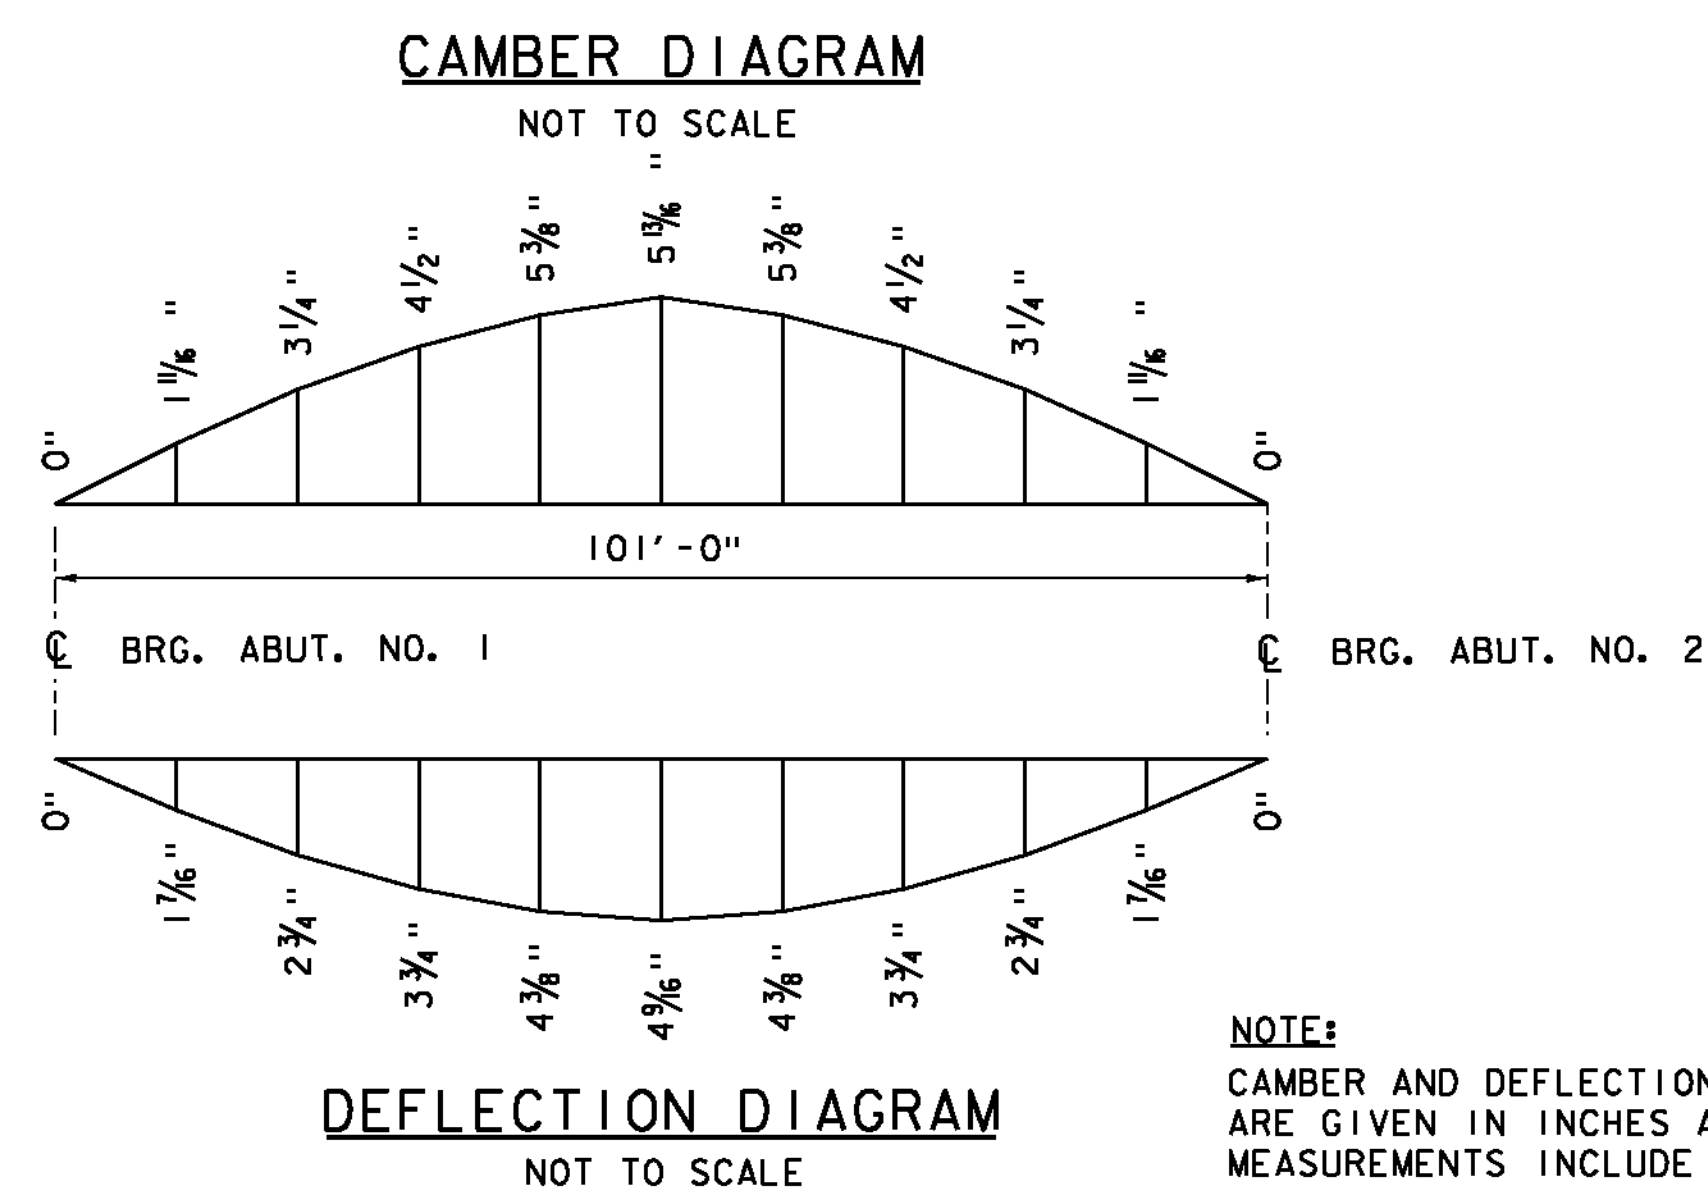
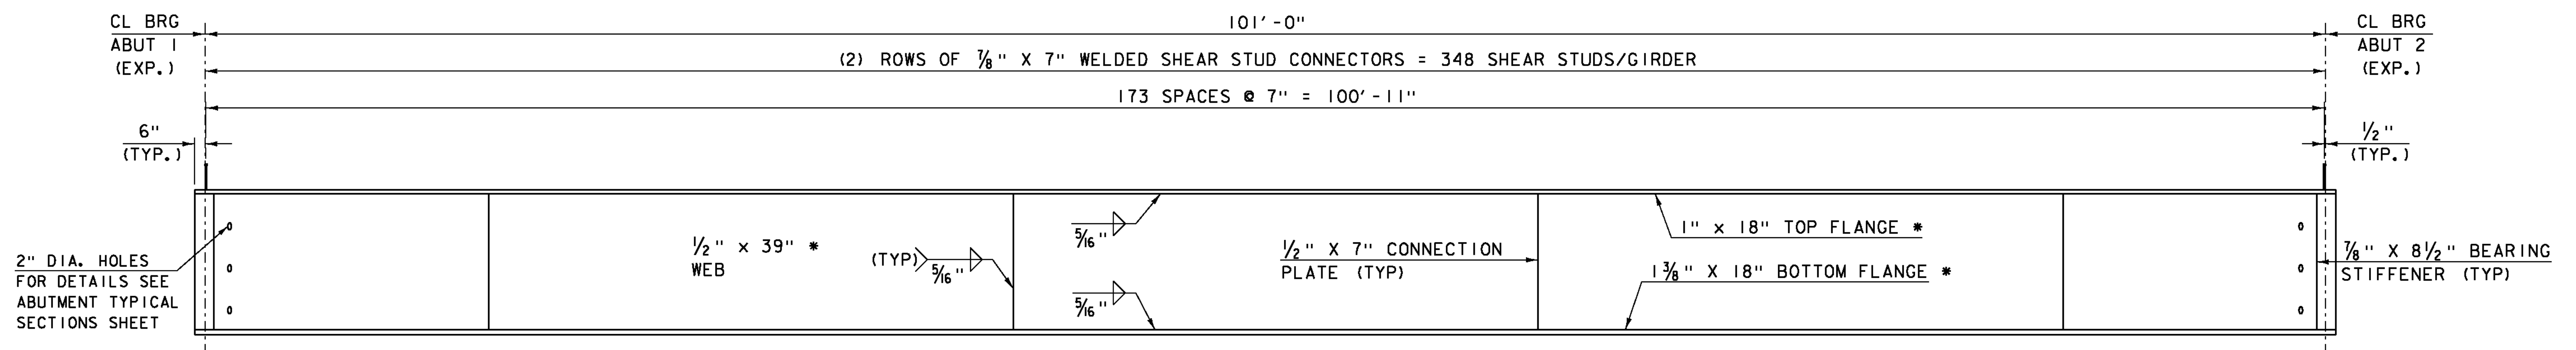
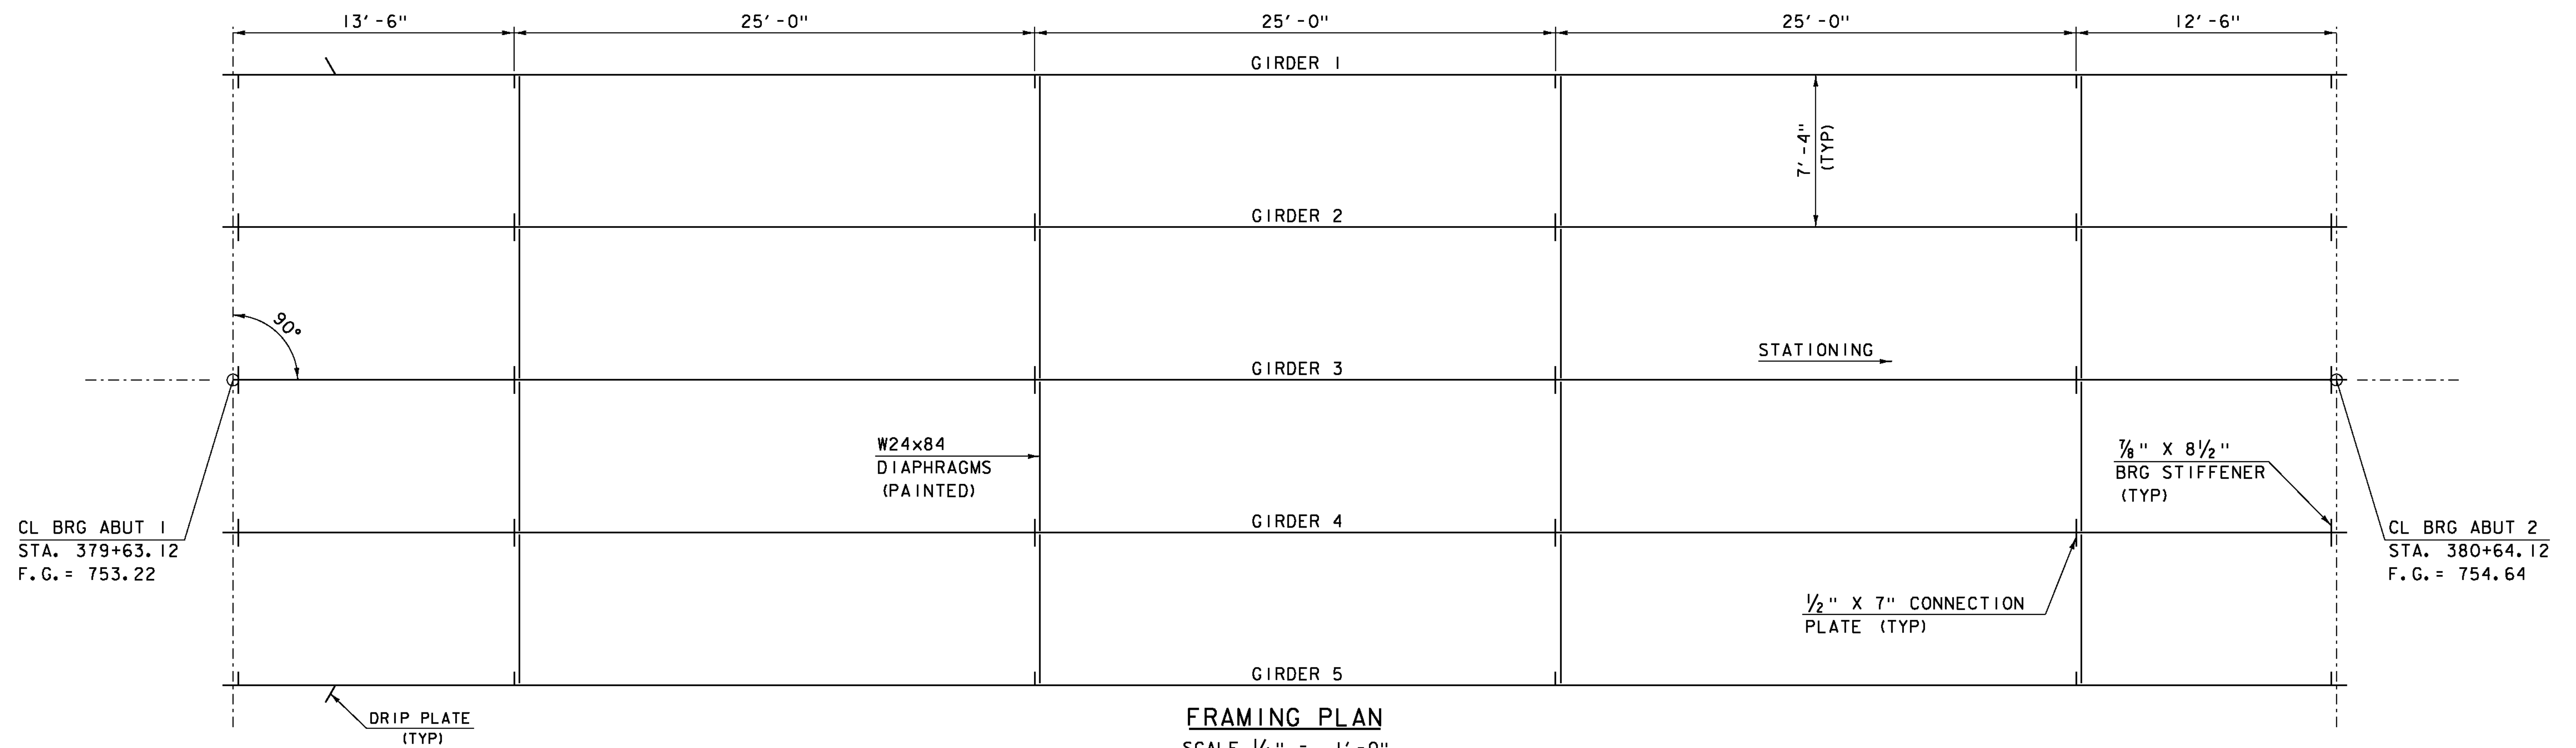


NOTE:
CAMBER AND DEFLECTION MEASUREMENTS
ARE GIVEN IN INCHES AT TENTH POINTS.
MEASUREMENTS INCLUDE GIRDER SELFWEIGHT.

NOTES:

1. ALL STRUCTURAL STEEL SHALL BE AASHTO M 270M/ M 270 GRADE 50, PAINTED BROWN (COLOR CHIP #20059).
2. SEE STRUCTURE DETAIL SHEETS SD-601.00 AND SD-602.00 FOR ADDITIONAL DETAILING INFORMATION AND REQUIREMENTS.

PROJECT NAME: ST. JOHNSBURY	PLOT DATE: 28-AUG-2012
PROJECT NUMBER: BRF 028-4(25)	DRAWN BY: R. PELLETT
FILE NAME: s98b320sup.dgn	CHECKED BY: C. CARLSON
PROJECT LEADER: C. CARLSON	SHEET 24 OF 62
DESIGNED BY: H. SALLS	
FRAMING PLAN	

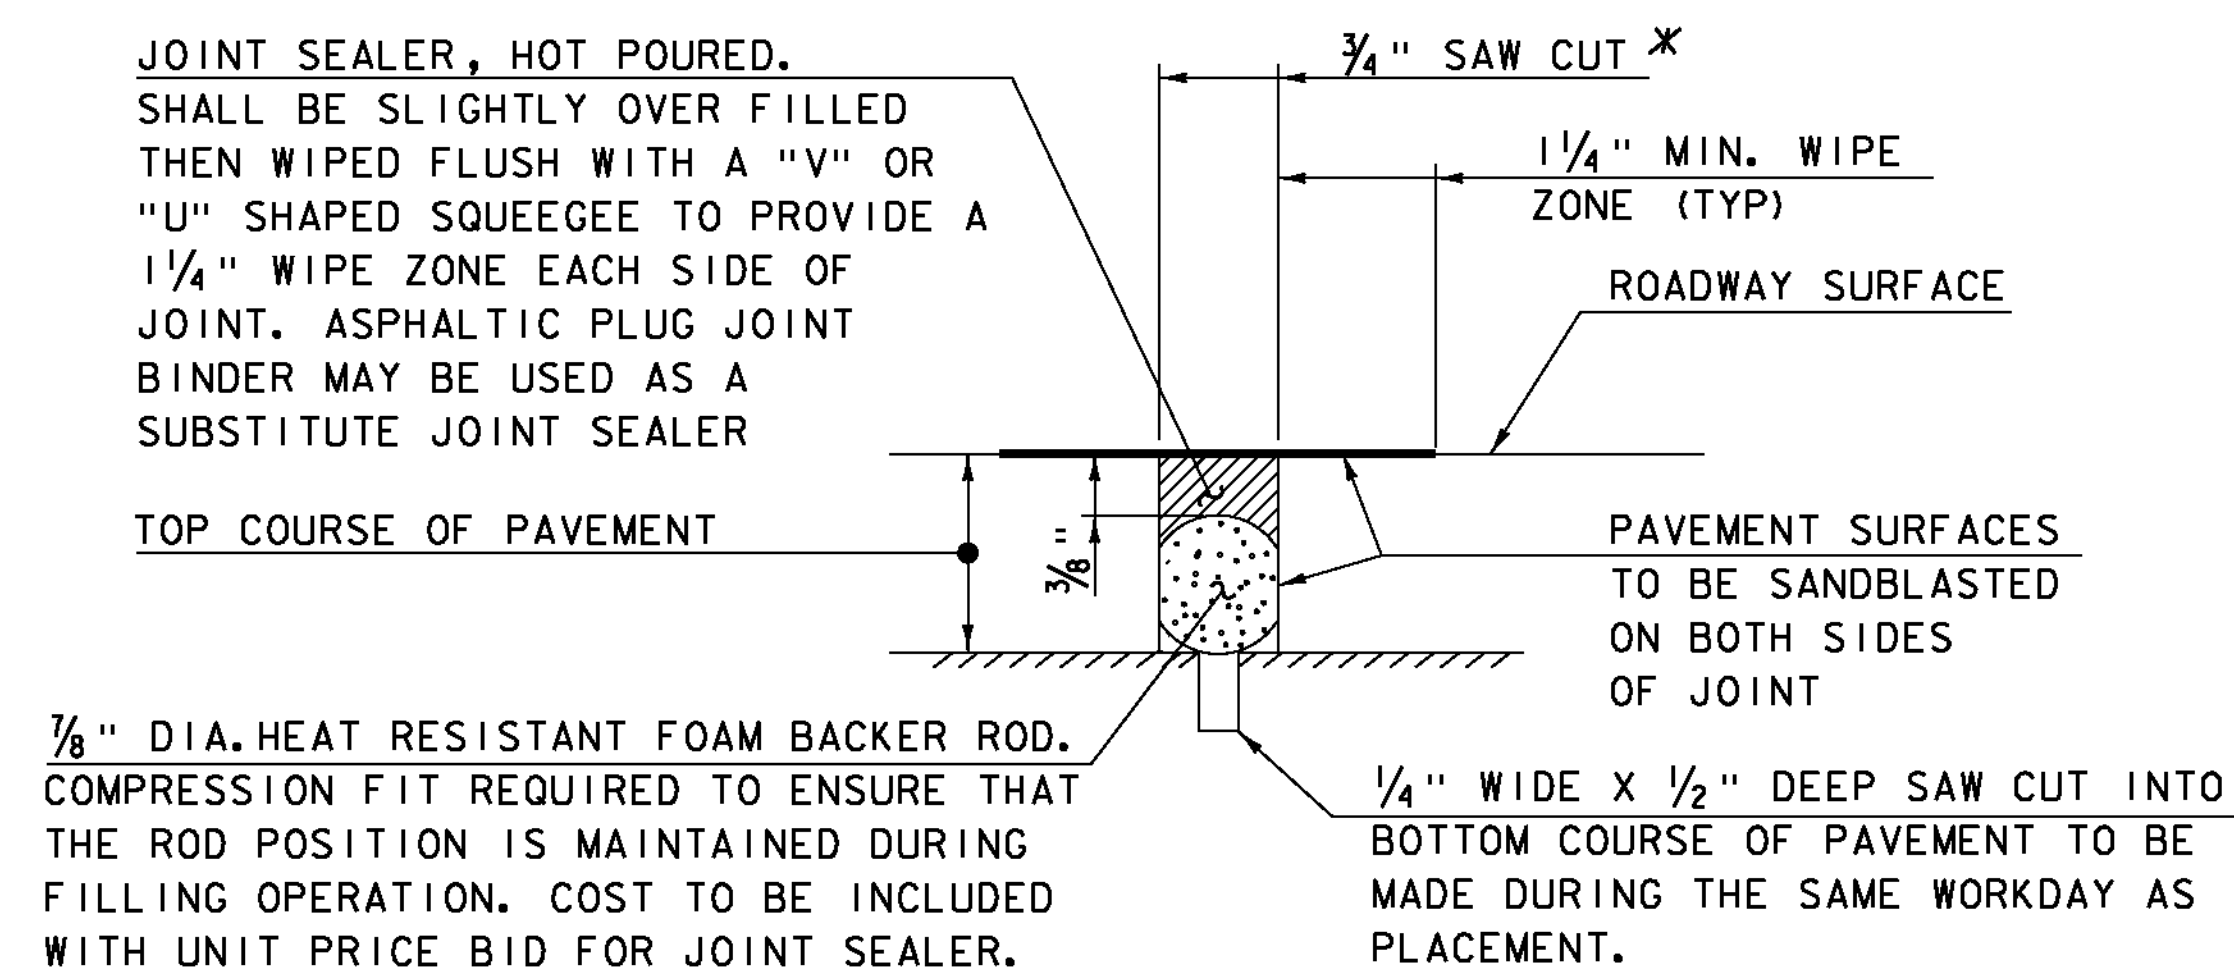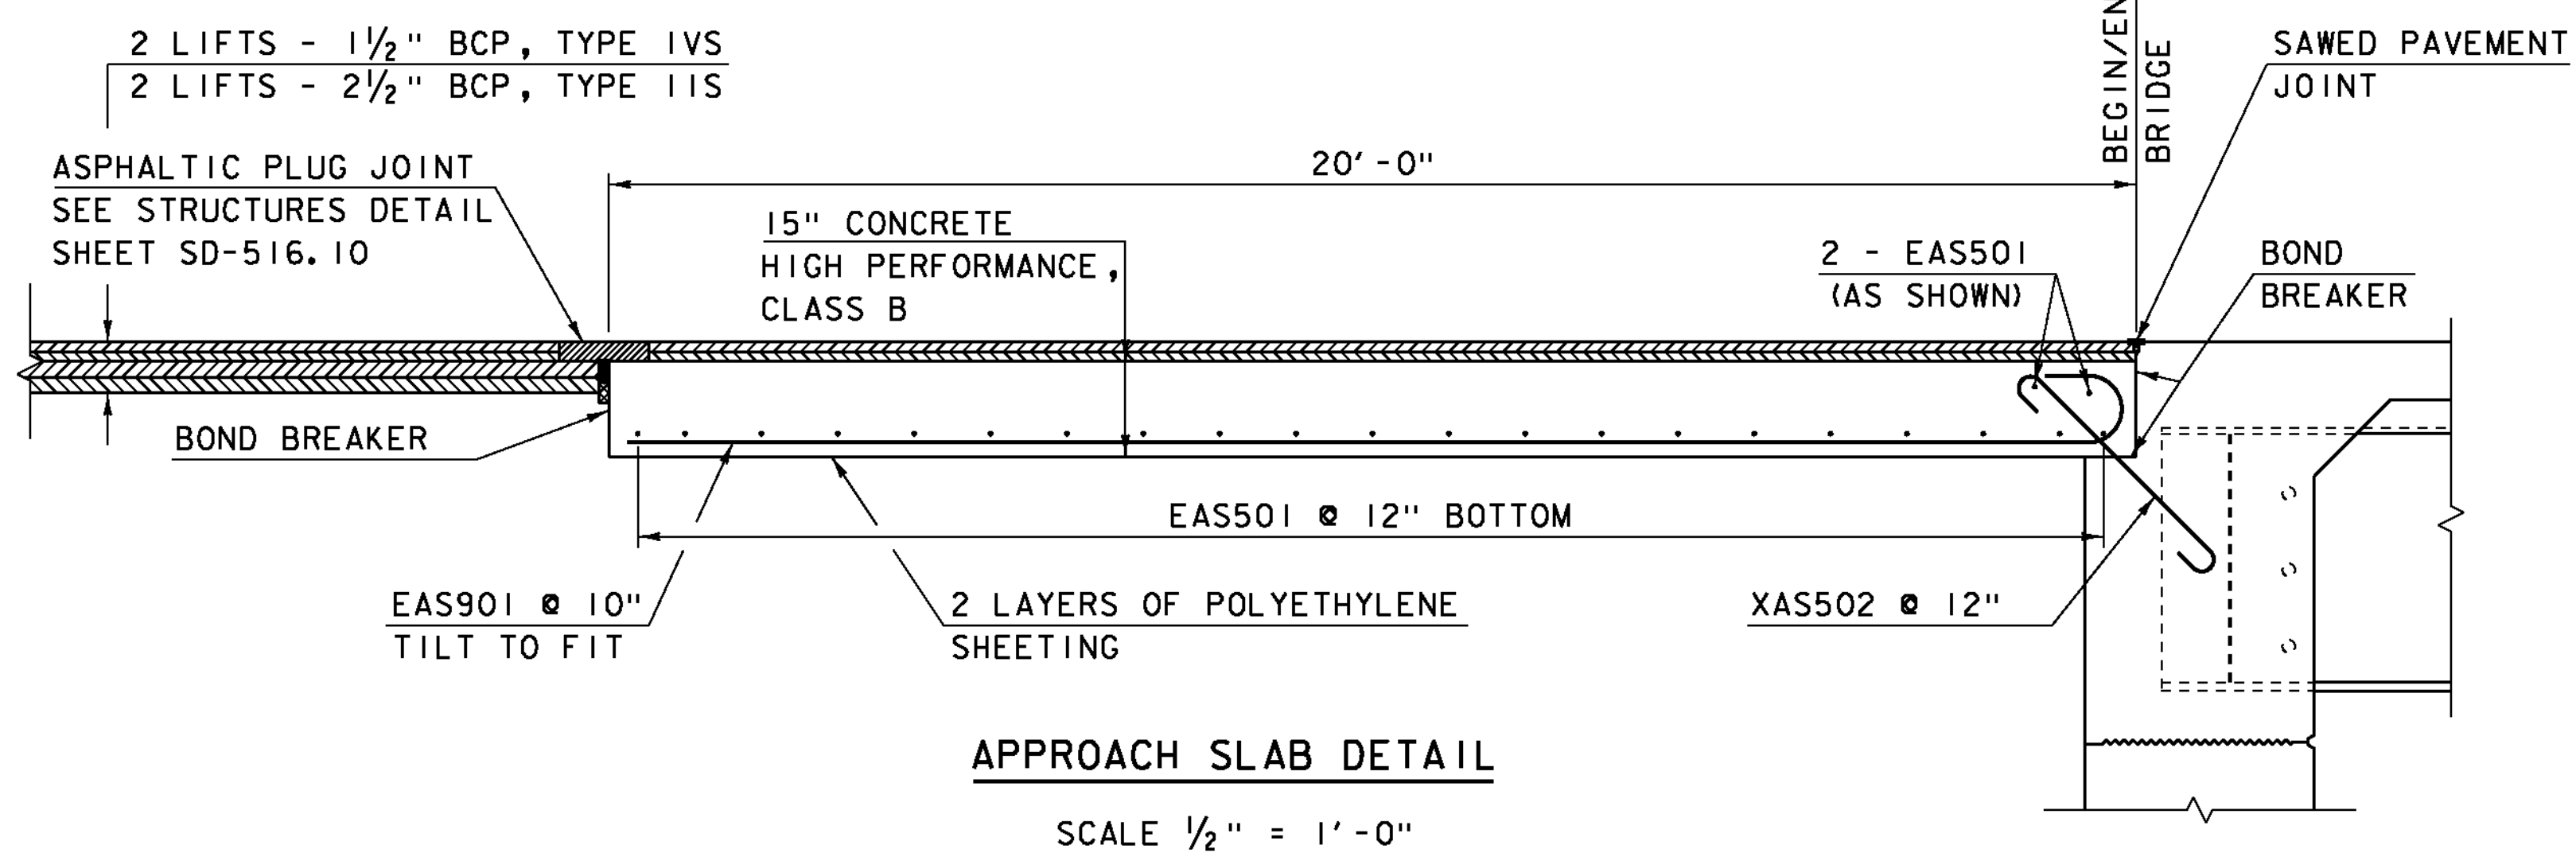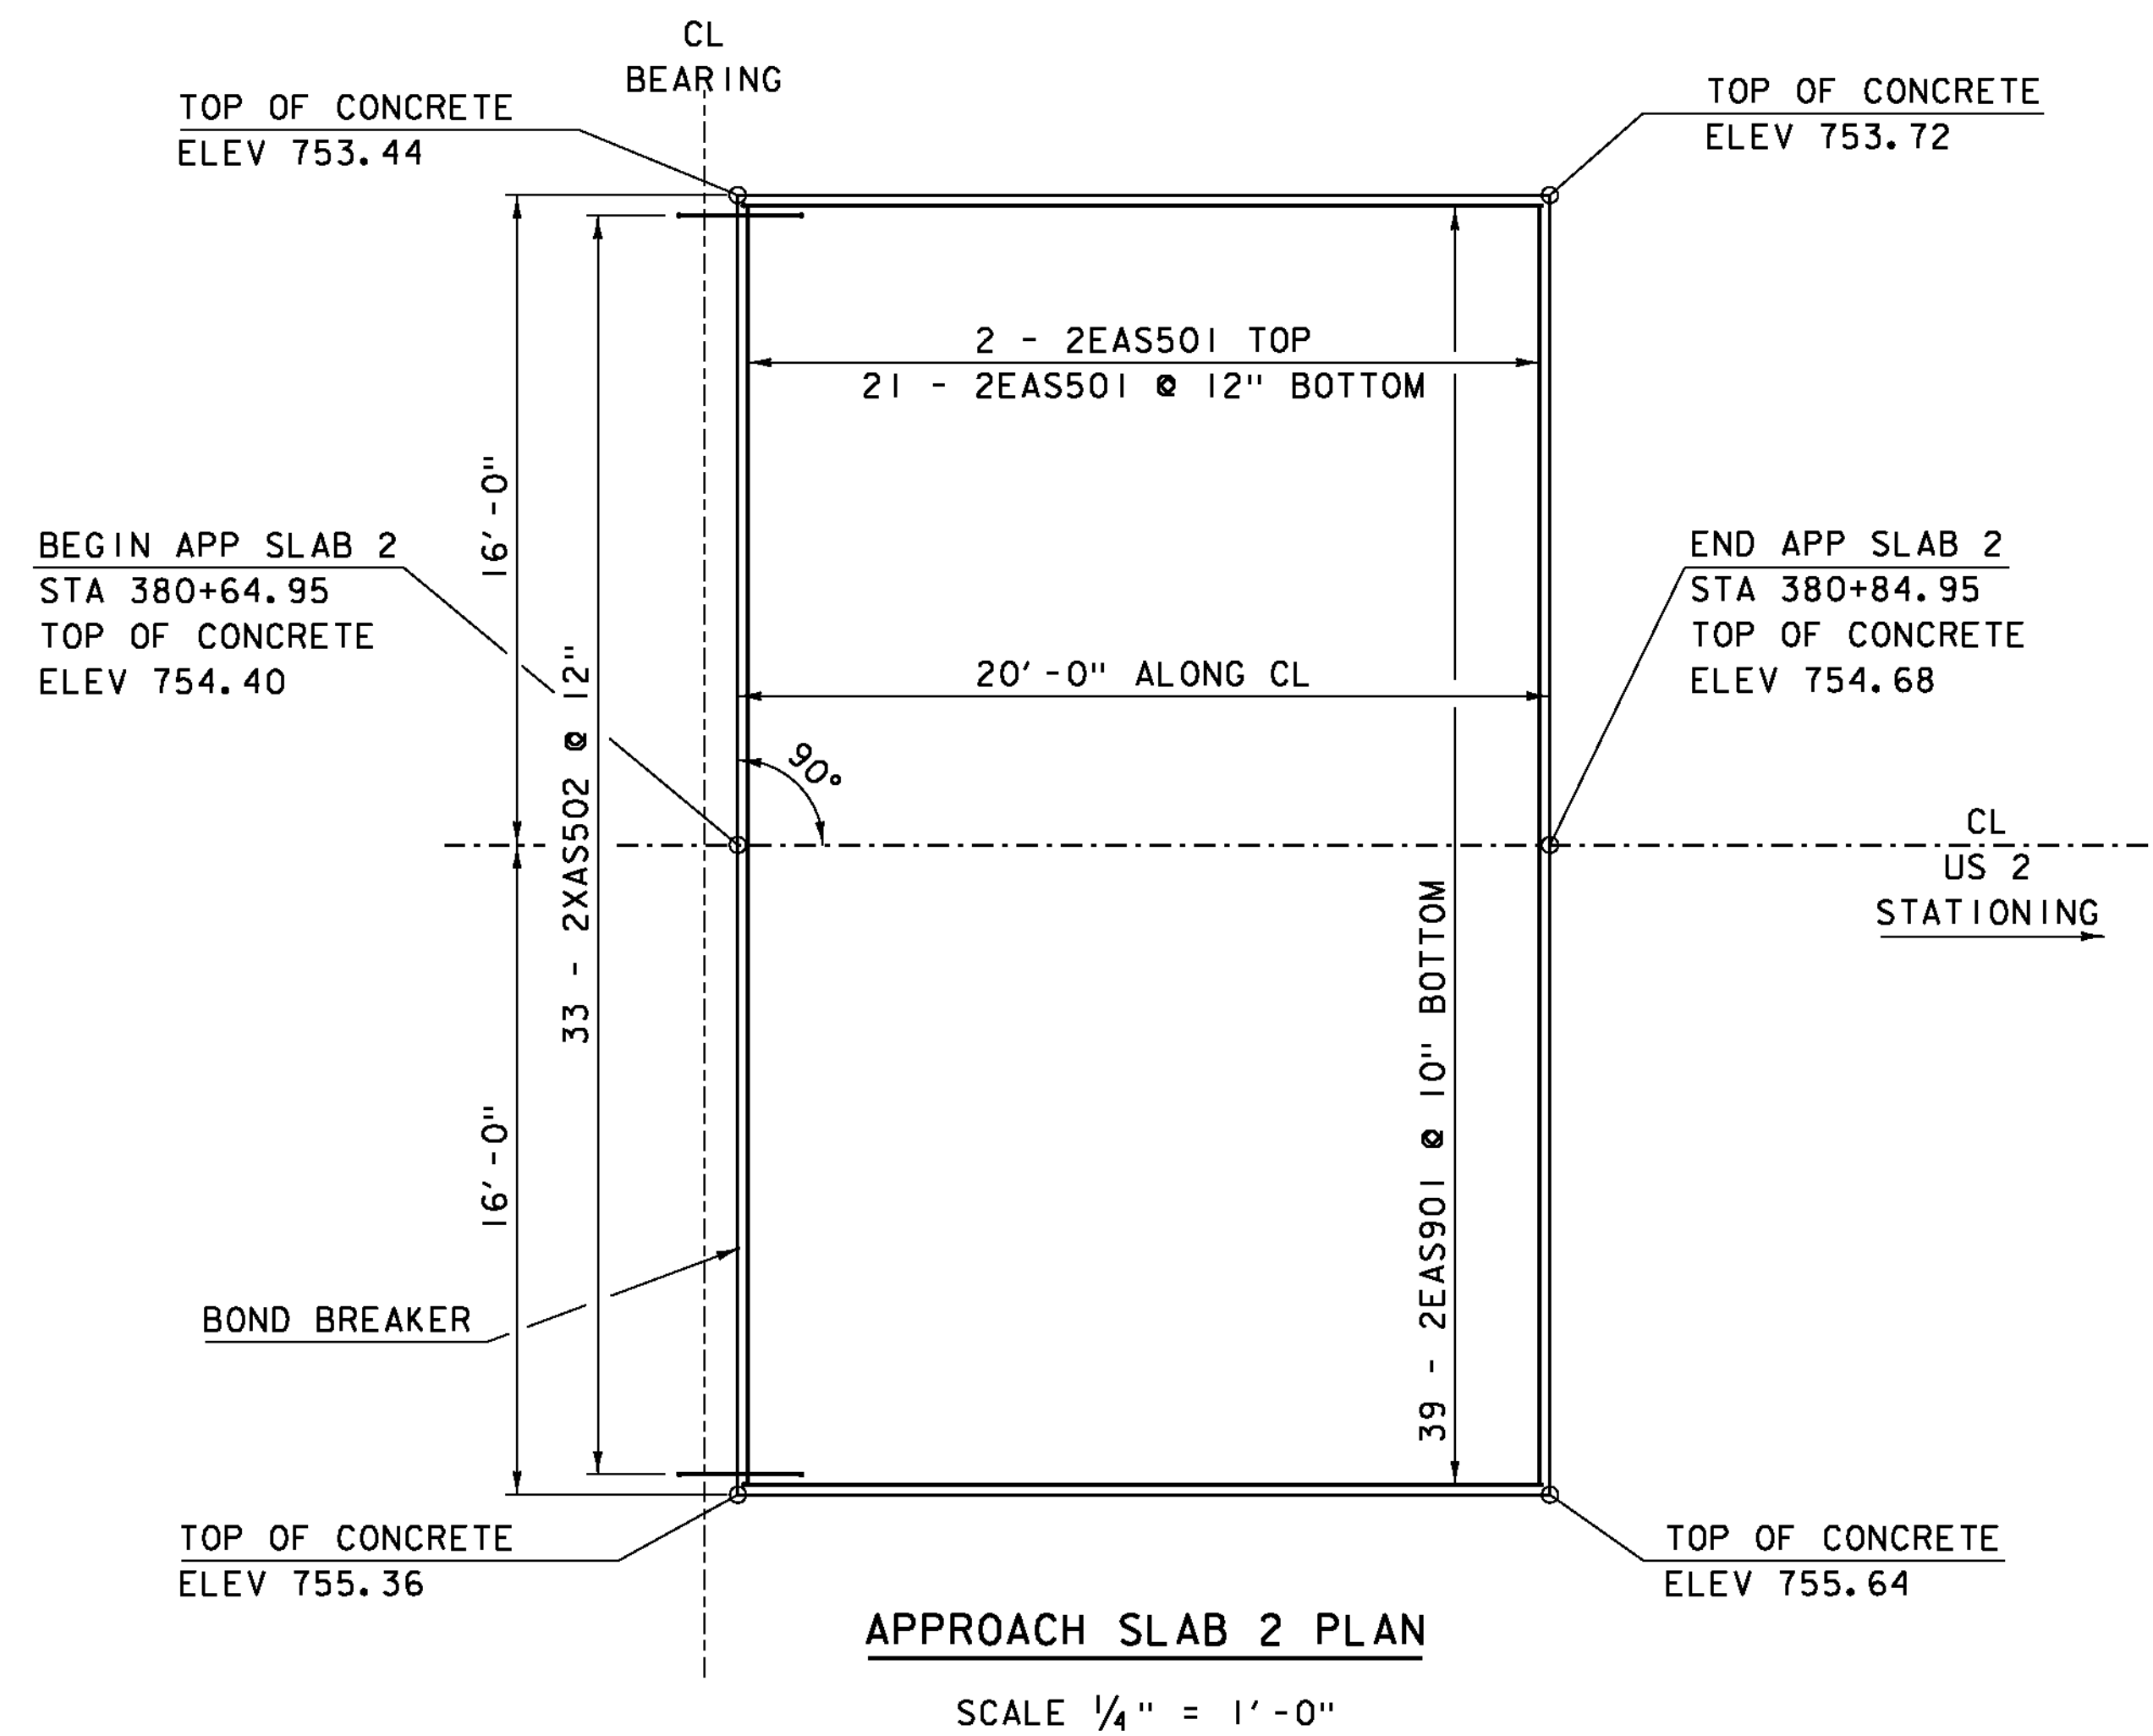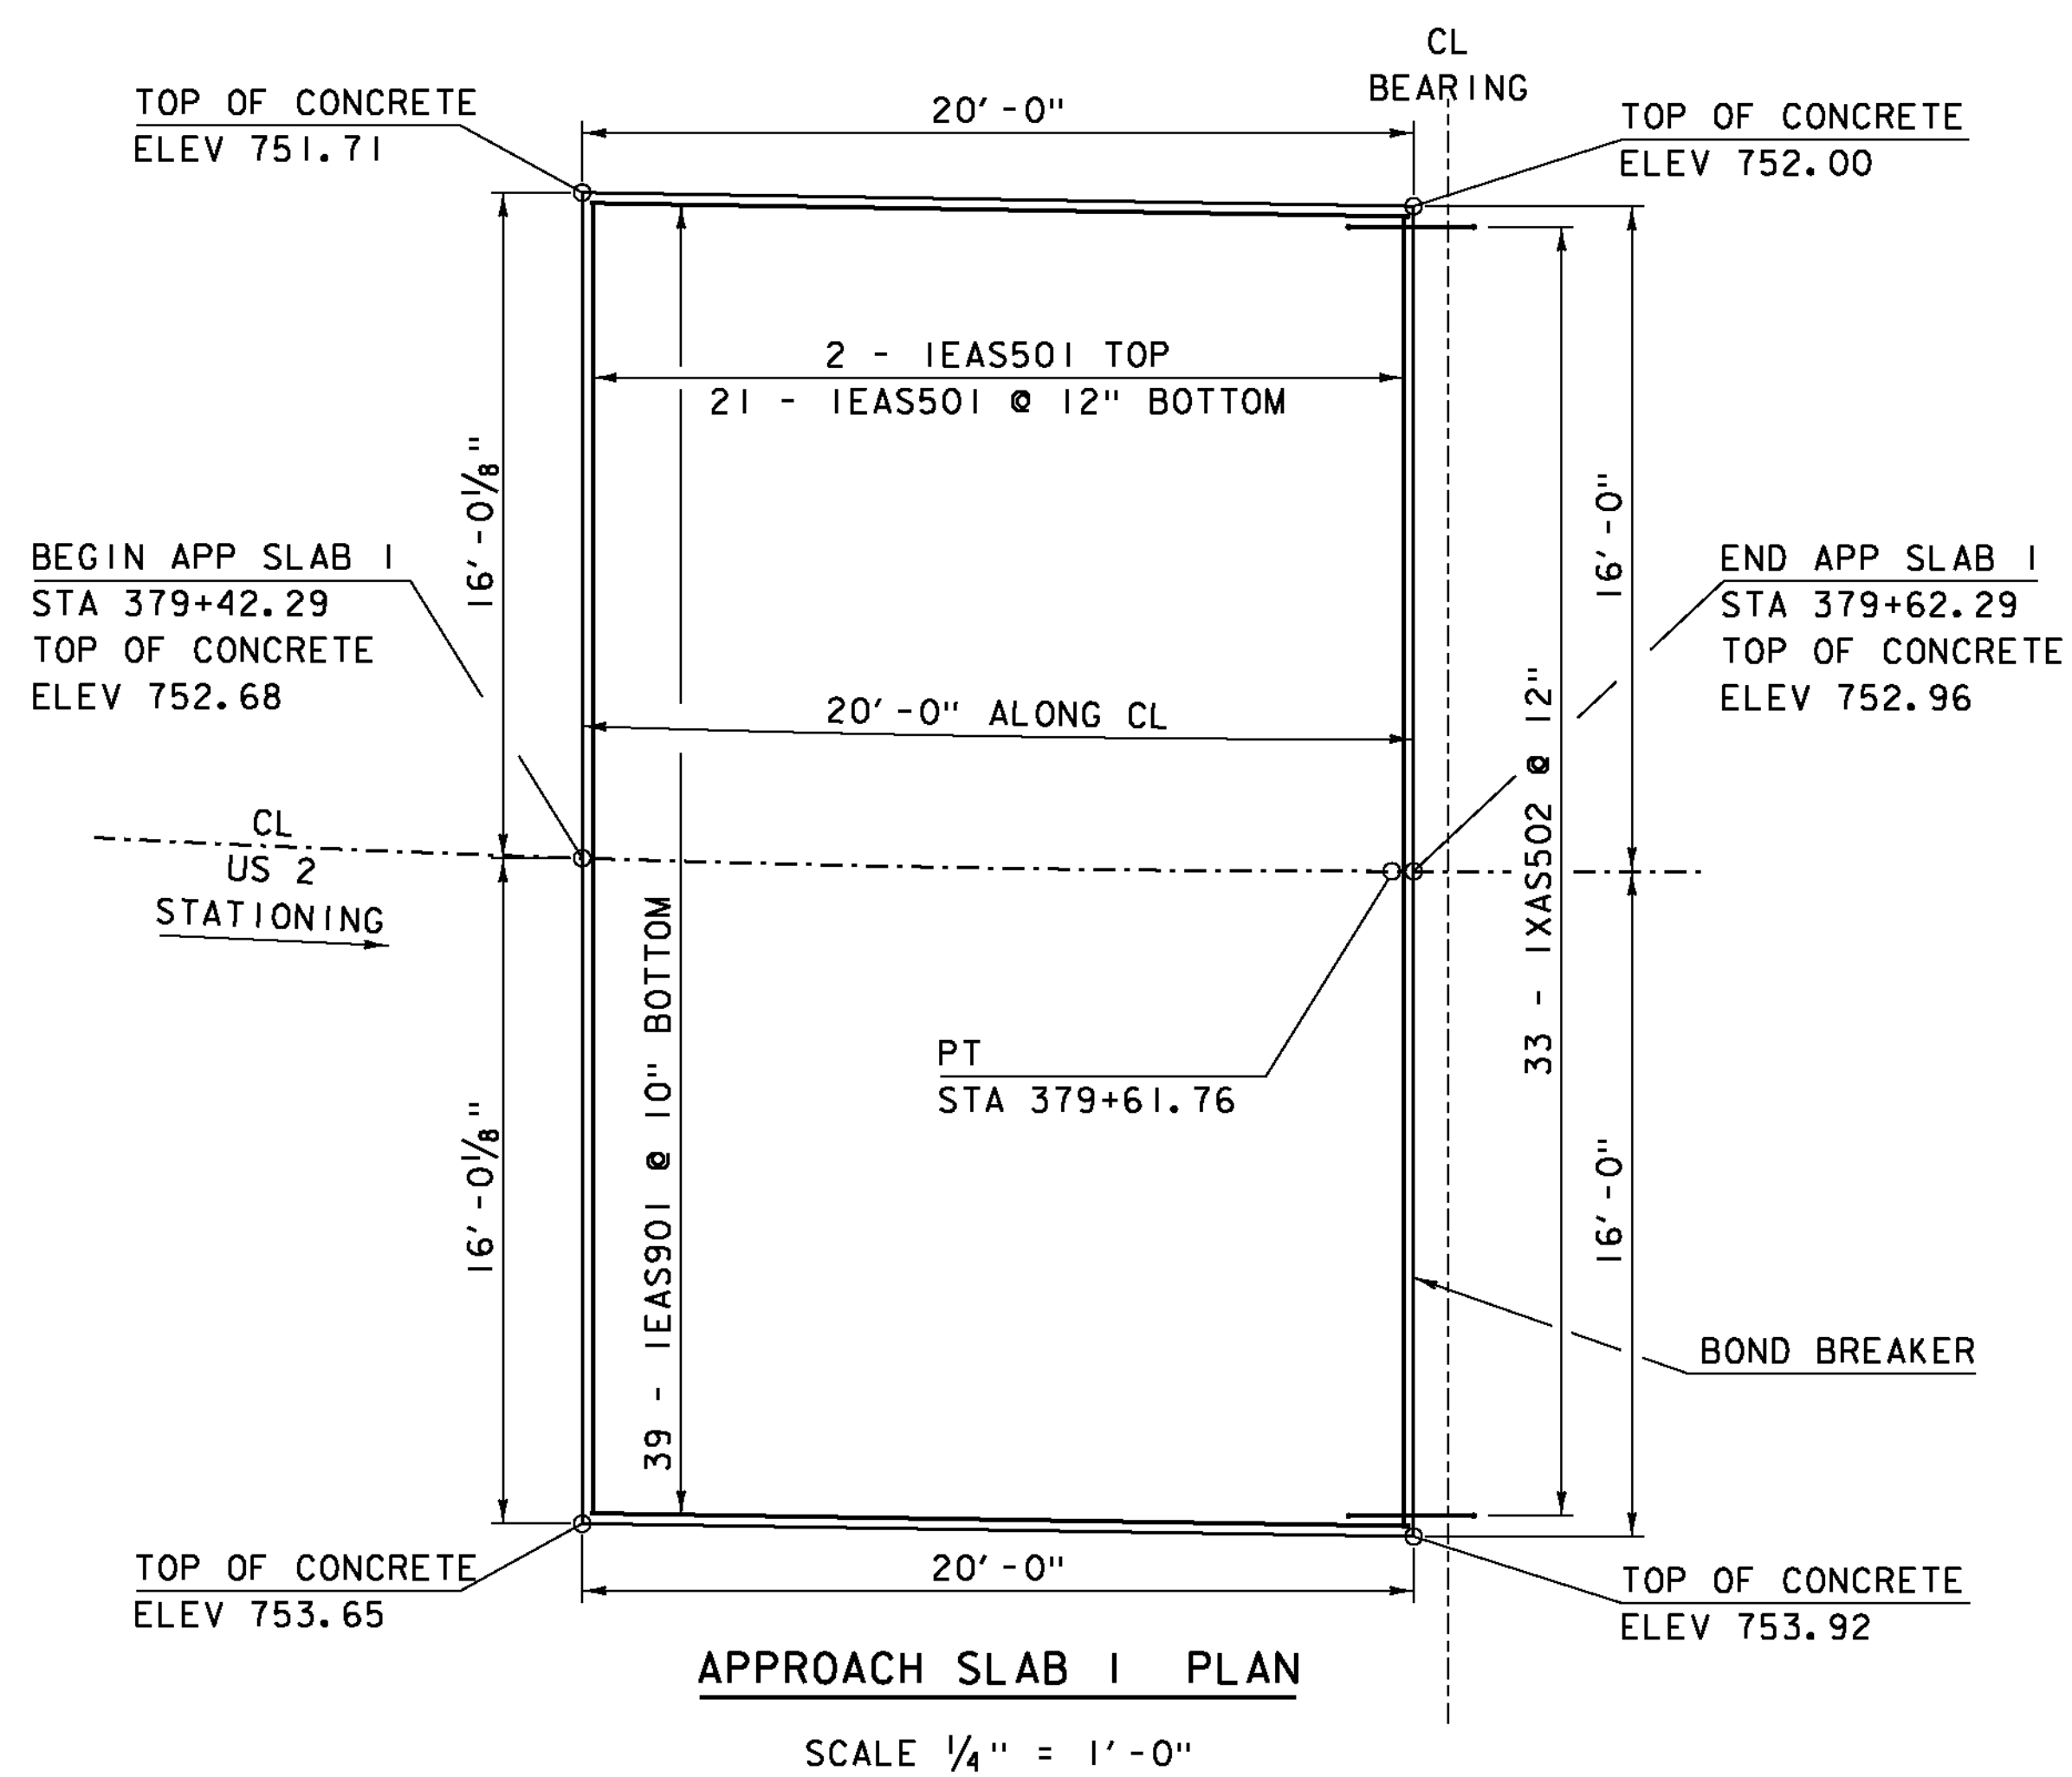


NOTES:


1. COMPACT THE SUBBASE IN THE AREA UNDER THE APPROACH SLAB TO A SMOOTH SURFACE.
2. MATERIAL FOR POLYETHYLENE SHEETING SHALL MEET THE REQUIREMENTS OF SUBSECTION 725.01 (c) OF THE STANDARD SPECIFICATIONS. THE SHEETING THICKNESS SHALL BE 12 MIL. PLACE THE SHEETING ON TOP OF THE FINISHED SUBBASE FOR THE FULL LENGTH AND WIDTH OF THE APPROACH SLAB, EXCEPT IN THE BRACKET AREA AT THE ABUTMENT. LAP SHEETING AT LEAST 2'-0". PAYMENT FOR SHEETING SHALL BE INCLUDED IN THE UNIT PRICE BID FOR ITEM 501.34 "CONCRETE, HIGH PERFORMANCE CLASS B".
3. POUR APPROACH SLAB CONCRETE IN THE EARLY MORNING BEFORE THE SUPERSTRUCTURE EXPANDS.
4. PLACE HOOKED ENDS OF BOTTOM STEEL AT ABUTMENT END OF SLAB.

* JOINT IS TO BE LOCATED ACCURATELY BY STRING LINING, OR OTHER MEANS, PRIOR TO PAVING, SO THAT THE SAW CUTS WILL BE MADE DIRECTLY OVER THE END OF CONCRETE DECK. JOINT SHALL BE CUT DRY IN A SINGLE PASS AND BE SEALED WITHIN 24 HOURS OR PRIOR TO EXPOSURE TO TRAFFIC. JOINT SHALL BE CLEANED PRIOR TO APPLYING THE JOINT SEALER.

PROJECT NAME:	ST. JOHNSBURY
PROJECT NUMBER:	BRF 028-4(25)S
FILE NAME:	s98b320sup.dgn
PROJECT LEADER:	C. CARLSON
DESIGNED BY:	H. SALLS
APPROACH SLABS	
PLOT DATE:	28-AUG-2012
DRAWN BY:	R. PELLETT
CHECKED BY:	C. CARLSON
SHEET	25 OF 62

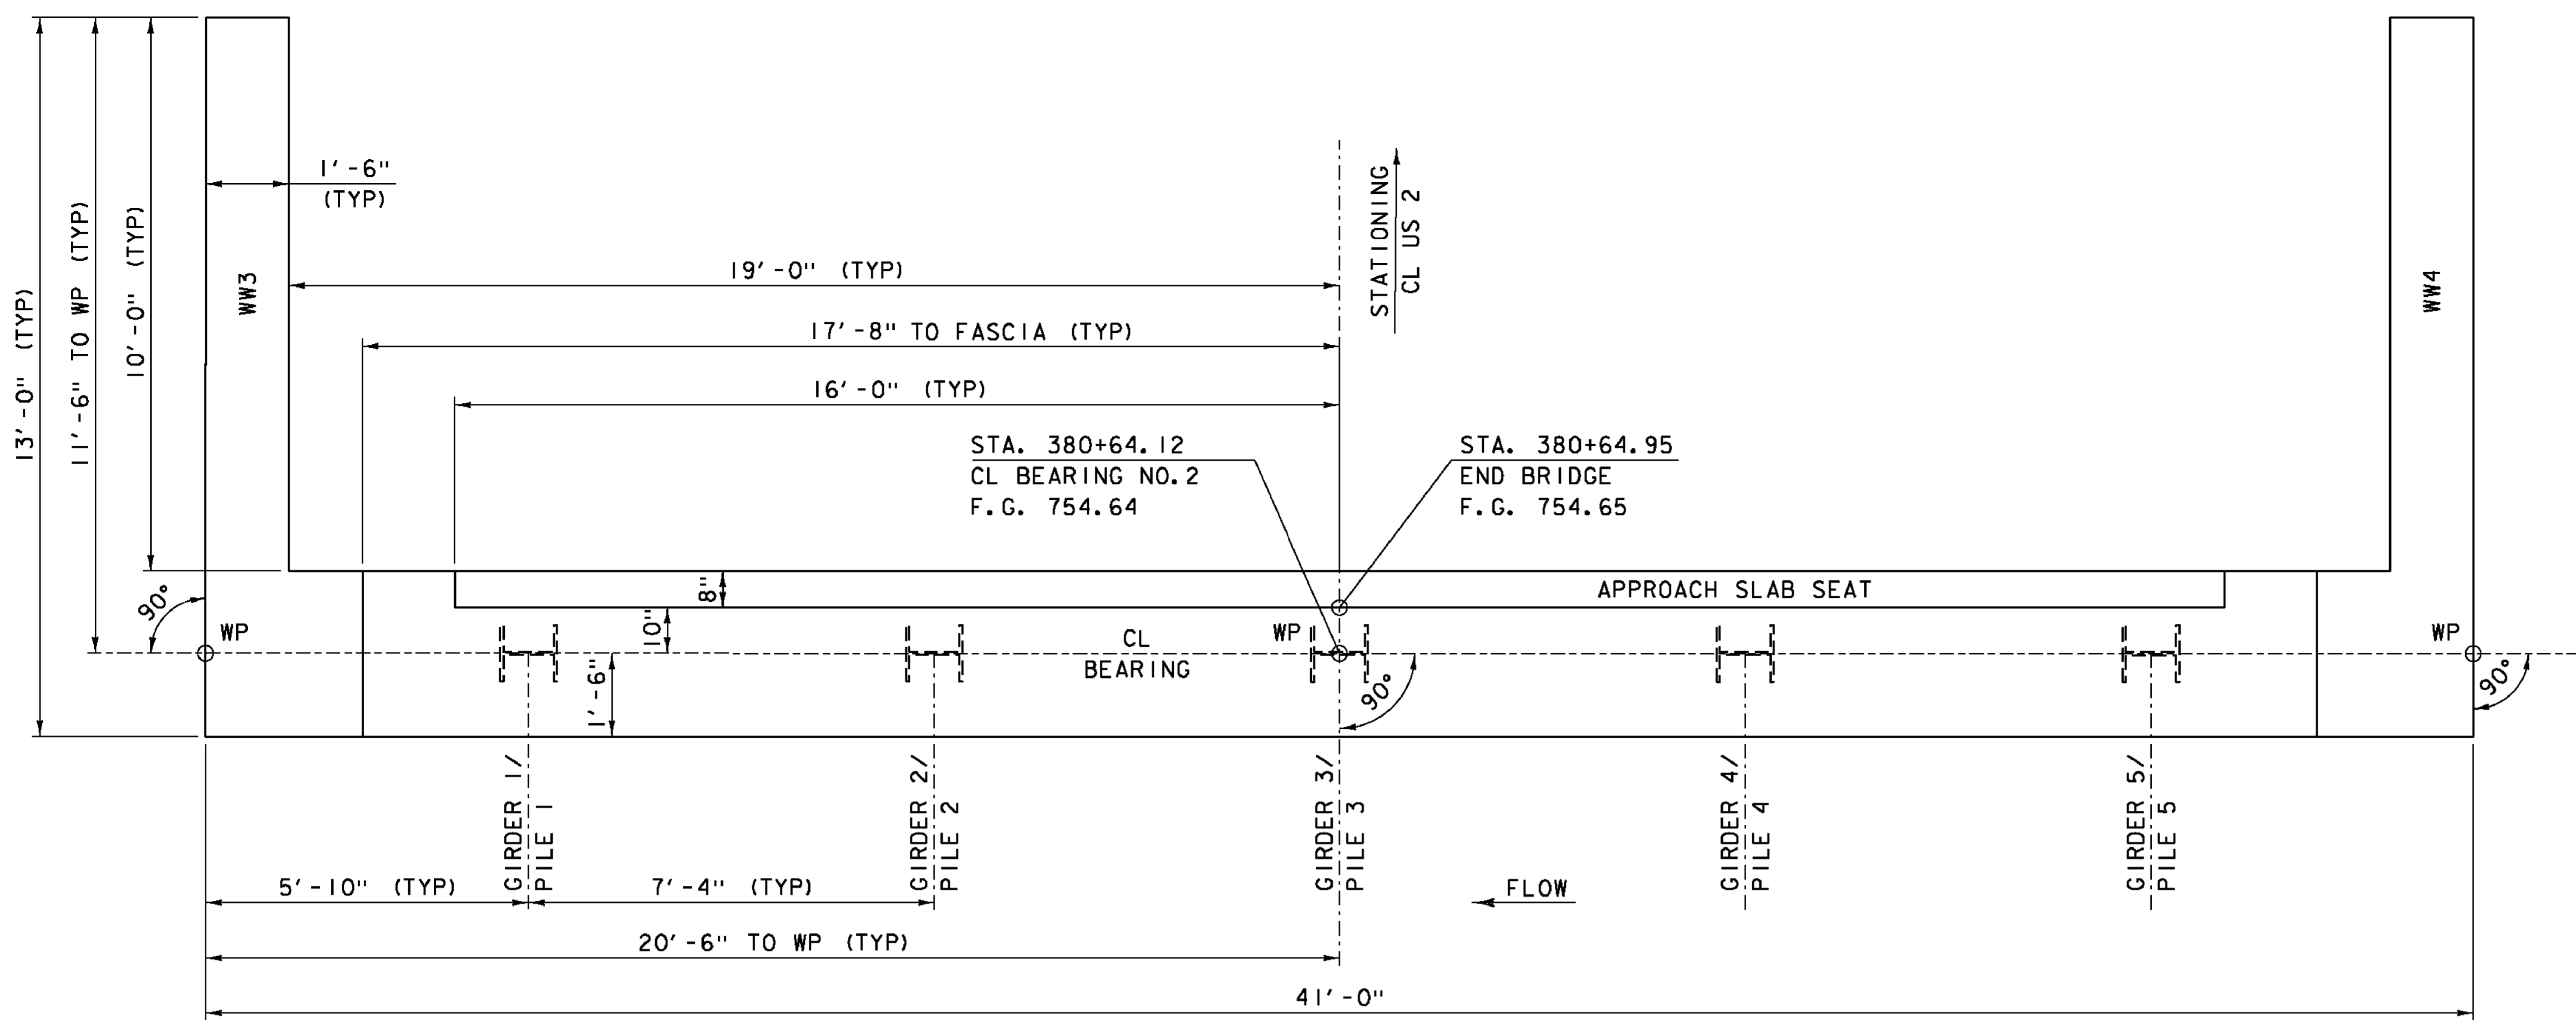

INTEGRAL ABUTMENT NO. 2 PLAN
SCALE 1/2" = 1'-0"


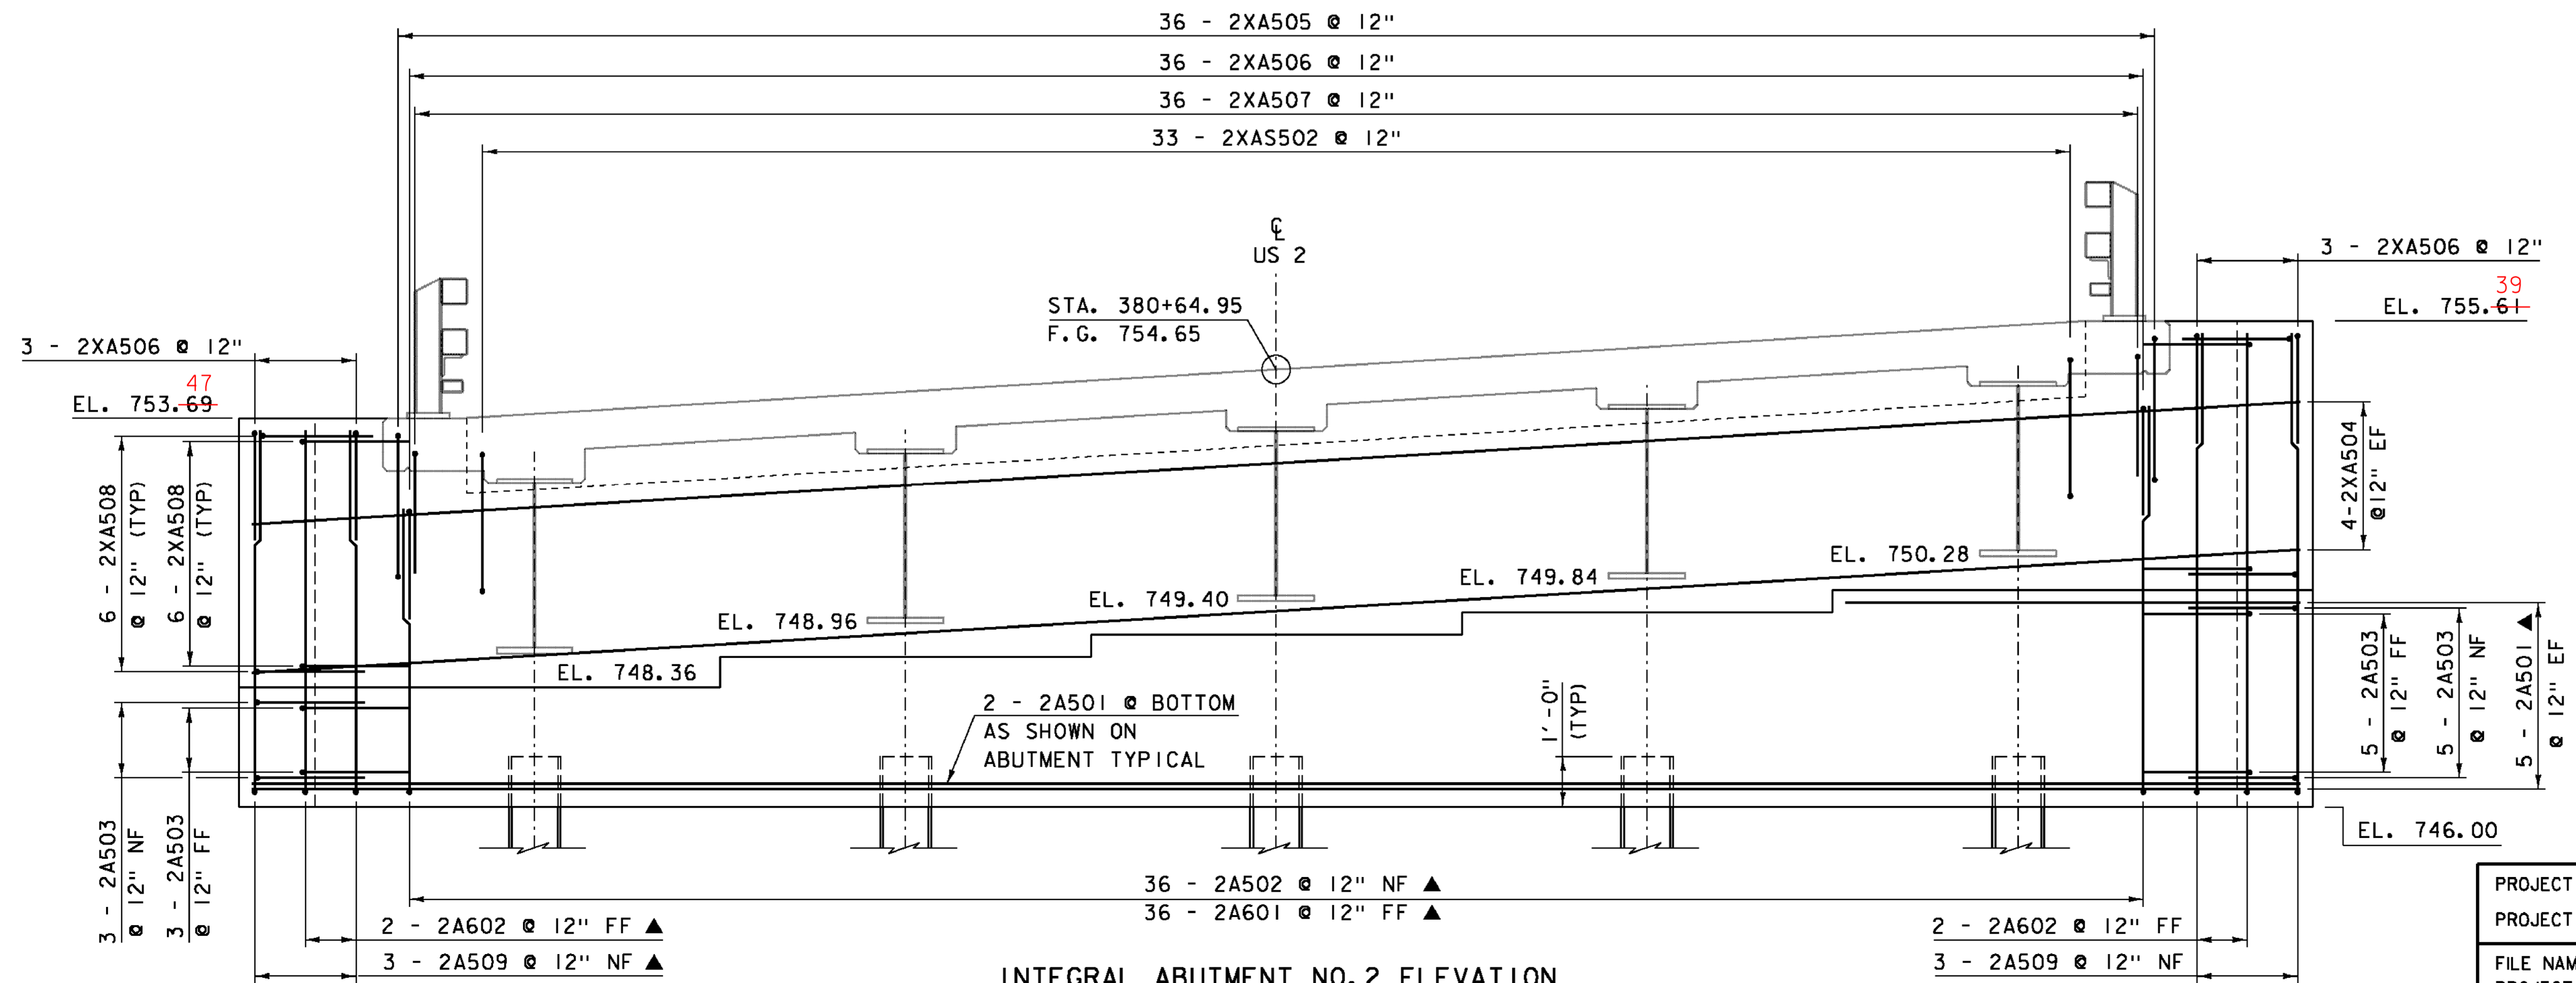


INTEGRAL ABUTMENT NO. 2 ELEVATION
SCALE 1/2" = 1'-0"



SEE ABUTMENT TYPICAL SECTIONS SHEET FOR ABUTMENT TYPICAL.

NOTE:
NF = NEAR FACE
FF = FAR FACE
EF = EACH FACE
▲ = CUT TO FIT IN FIELD
3" CLEAR, UNLESS OTHERWISE SPECIFIED ON THE PLANS.
2'-2" BAR LAP UNLESS OTHERWISE SPECIFIED ON THE PLANS.


PROJECT NAME:	ST. JOHNSBURY	FILE NAME:	s98b320sub.dgn	PLOT DATE:	28-AUG-2012
PROJECT NUMBER:	BRF 028-4(25)S	PROJECT LEADER:	C. CARLSON	DRAWN BY:	R. PELLETT
		DESIGNED BY:	H. SALLS	CHECKED BY:	C. CARLSON
		ABUTMENT NO. 2 DETAILS			SHEET 27 OF 62

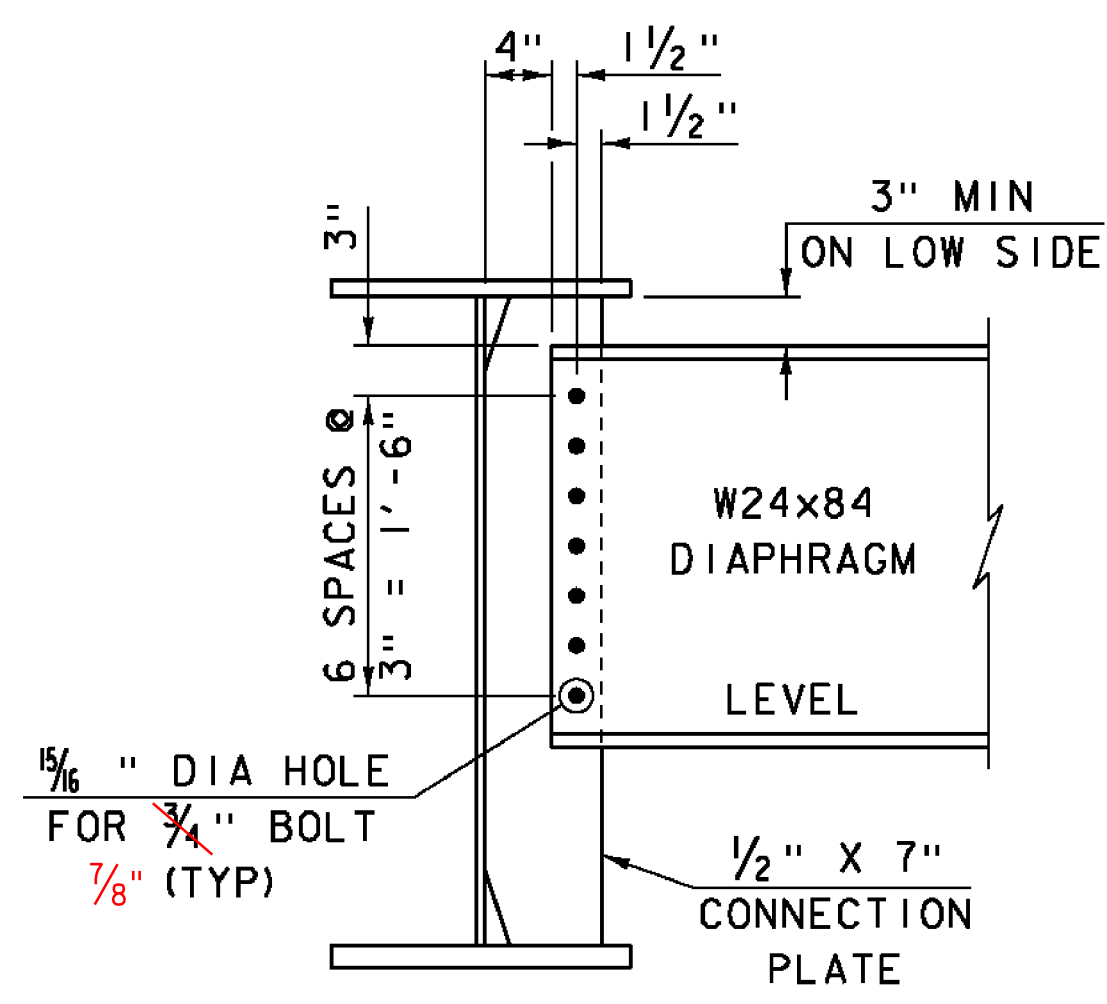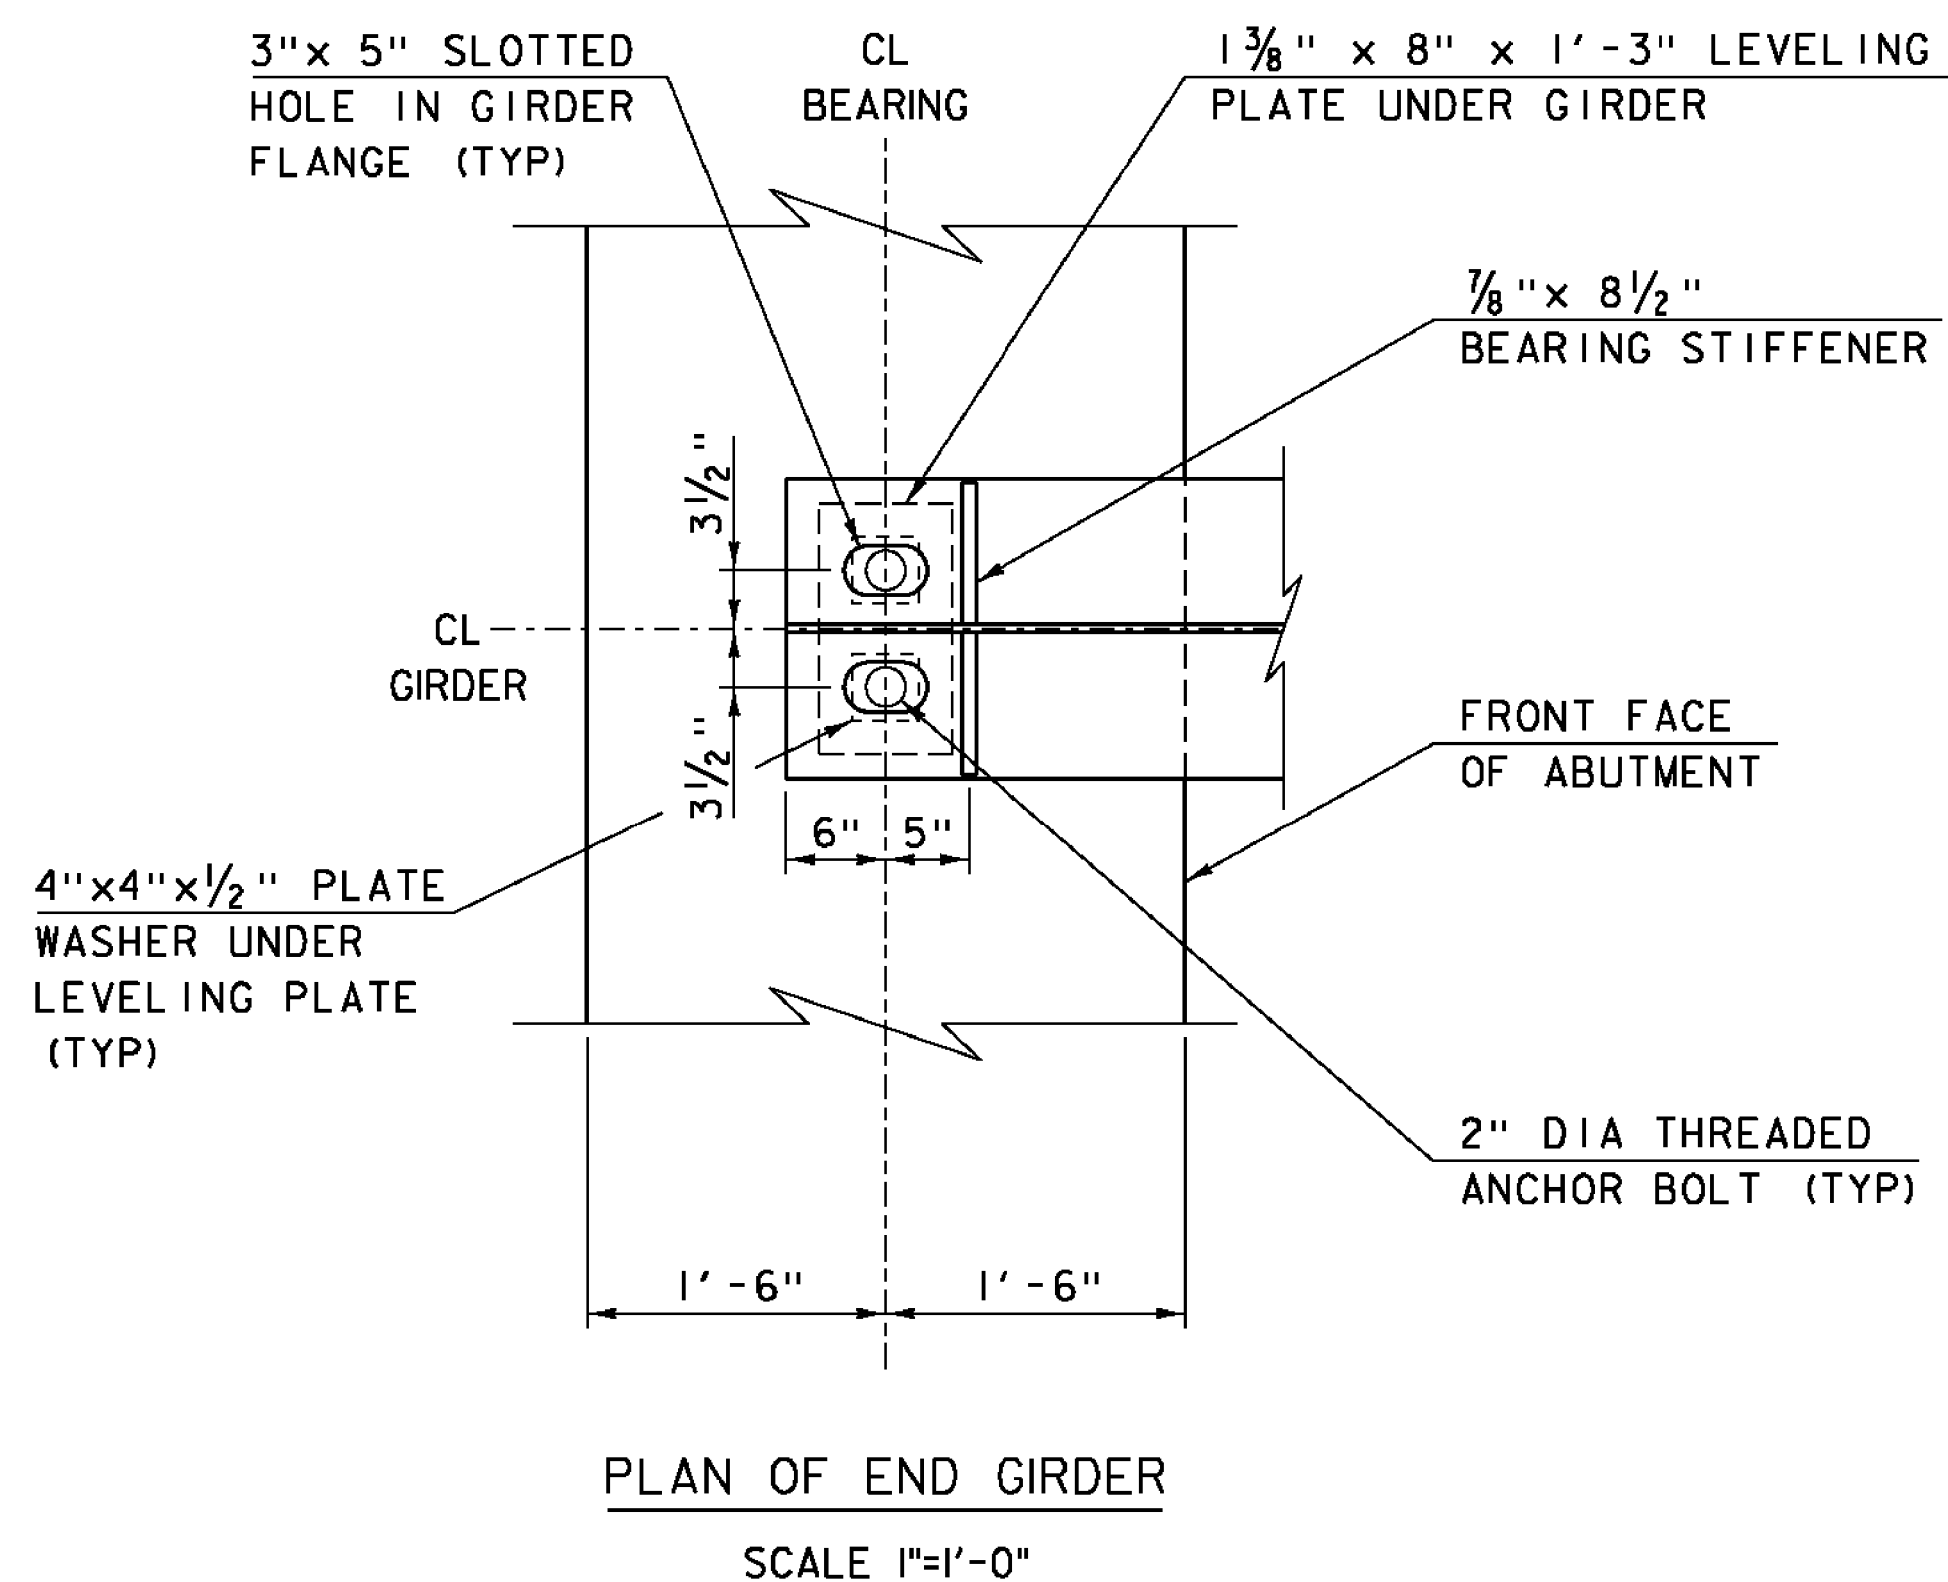

SEE STRUCTURES DETAIL SHEET SD-602.00 FOR ADDITIONAL INTERMEDIATE DIAPHRAGM DETAILS

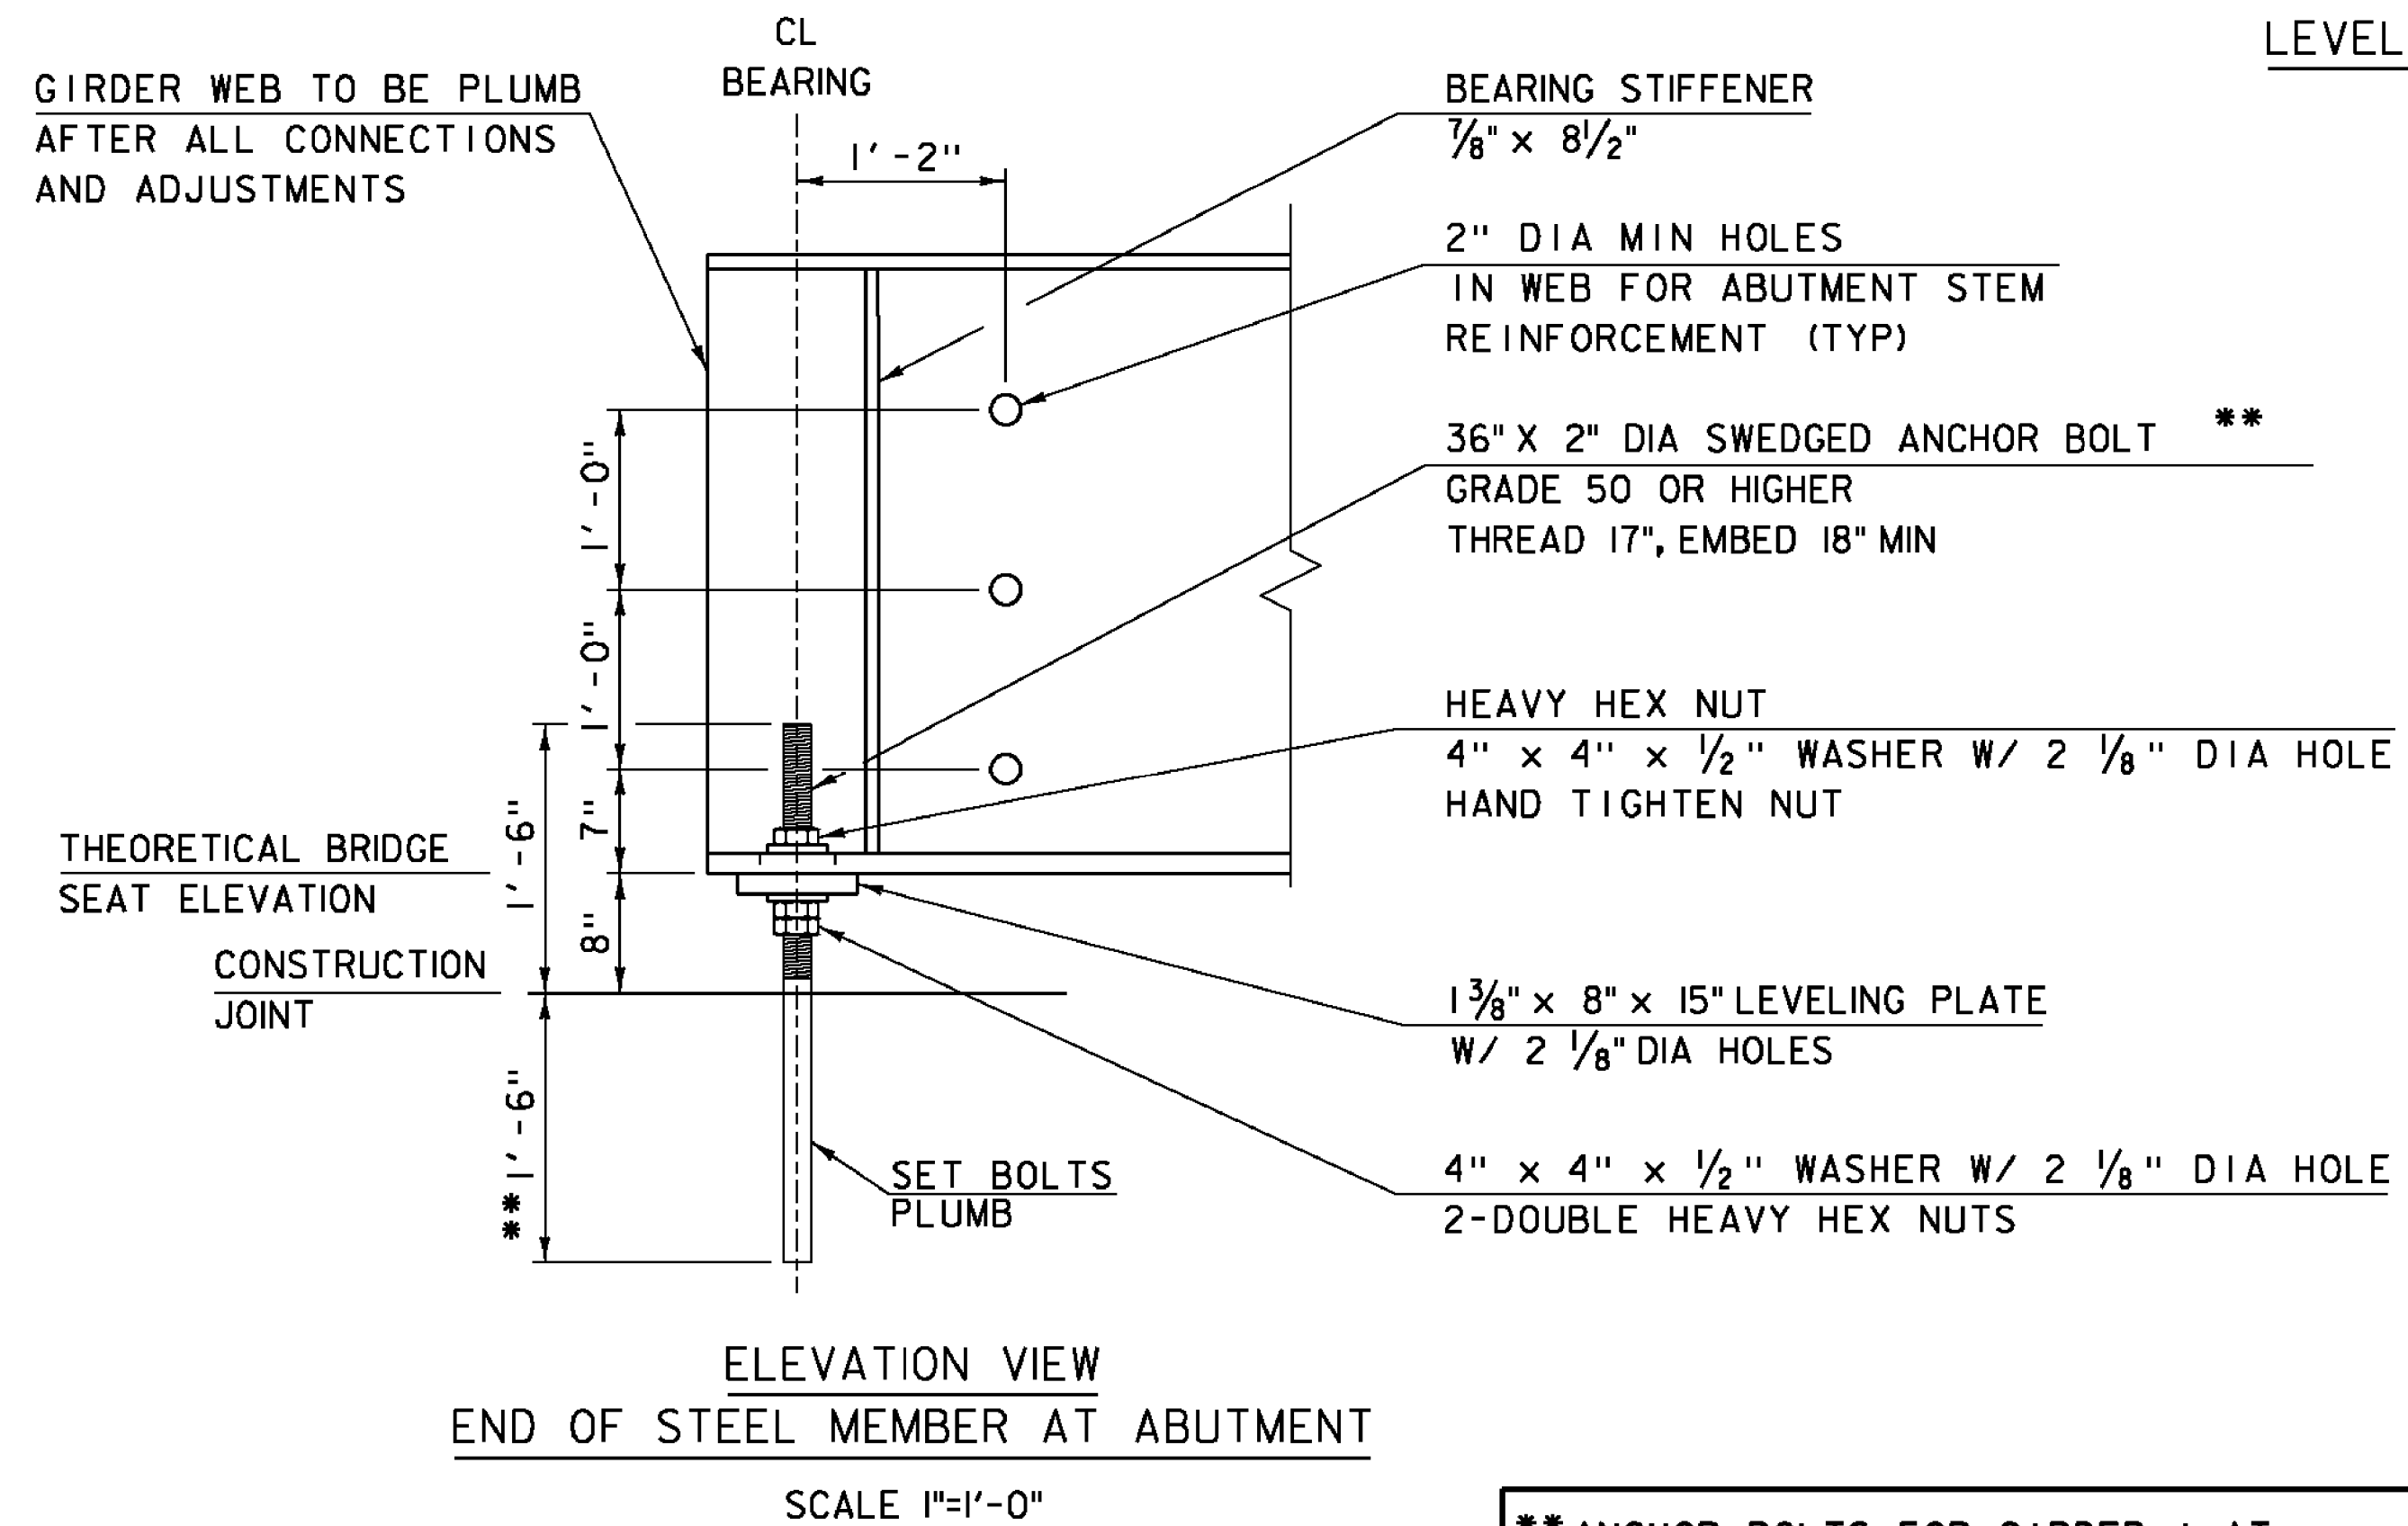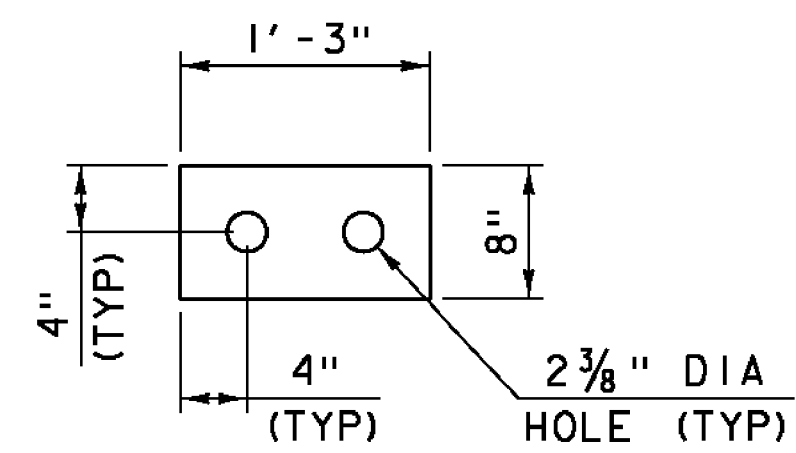

**ANCHOR BOLTS FOR GIRDER 1 AT ABUTMENT 2 SHALL ONLY BE EMBEDDED 15" TO AVOID HITTING THE PILE.

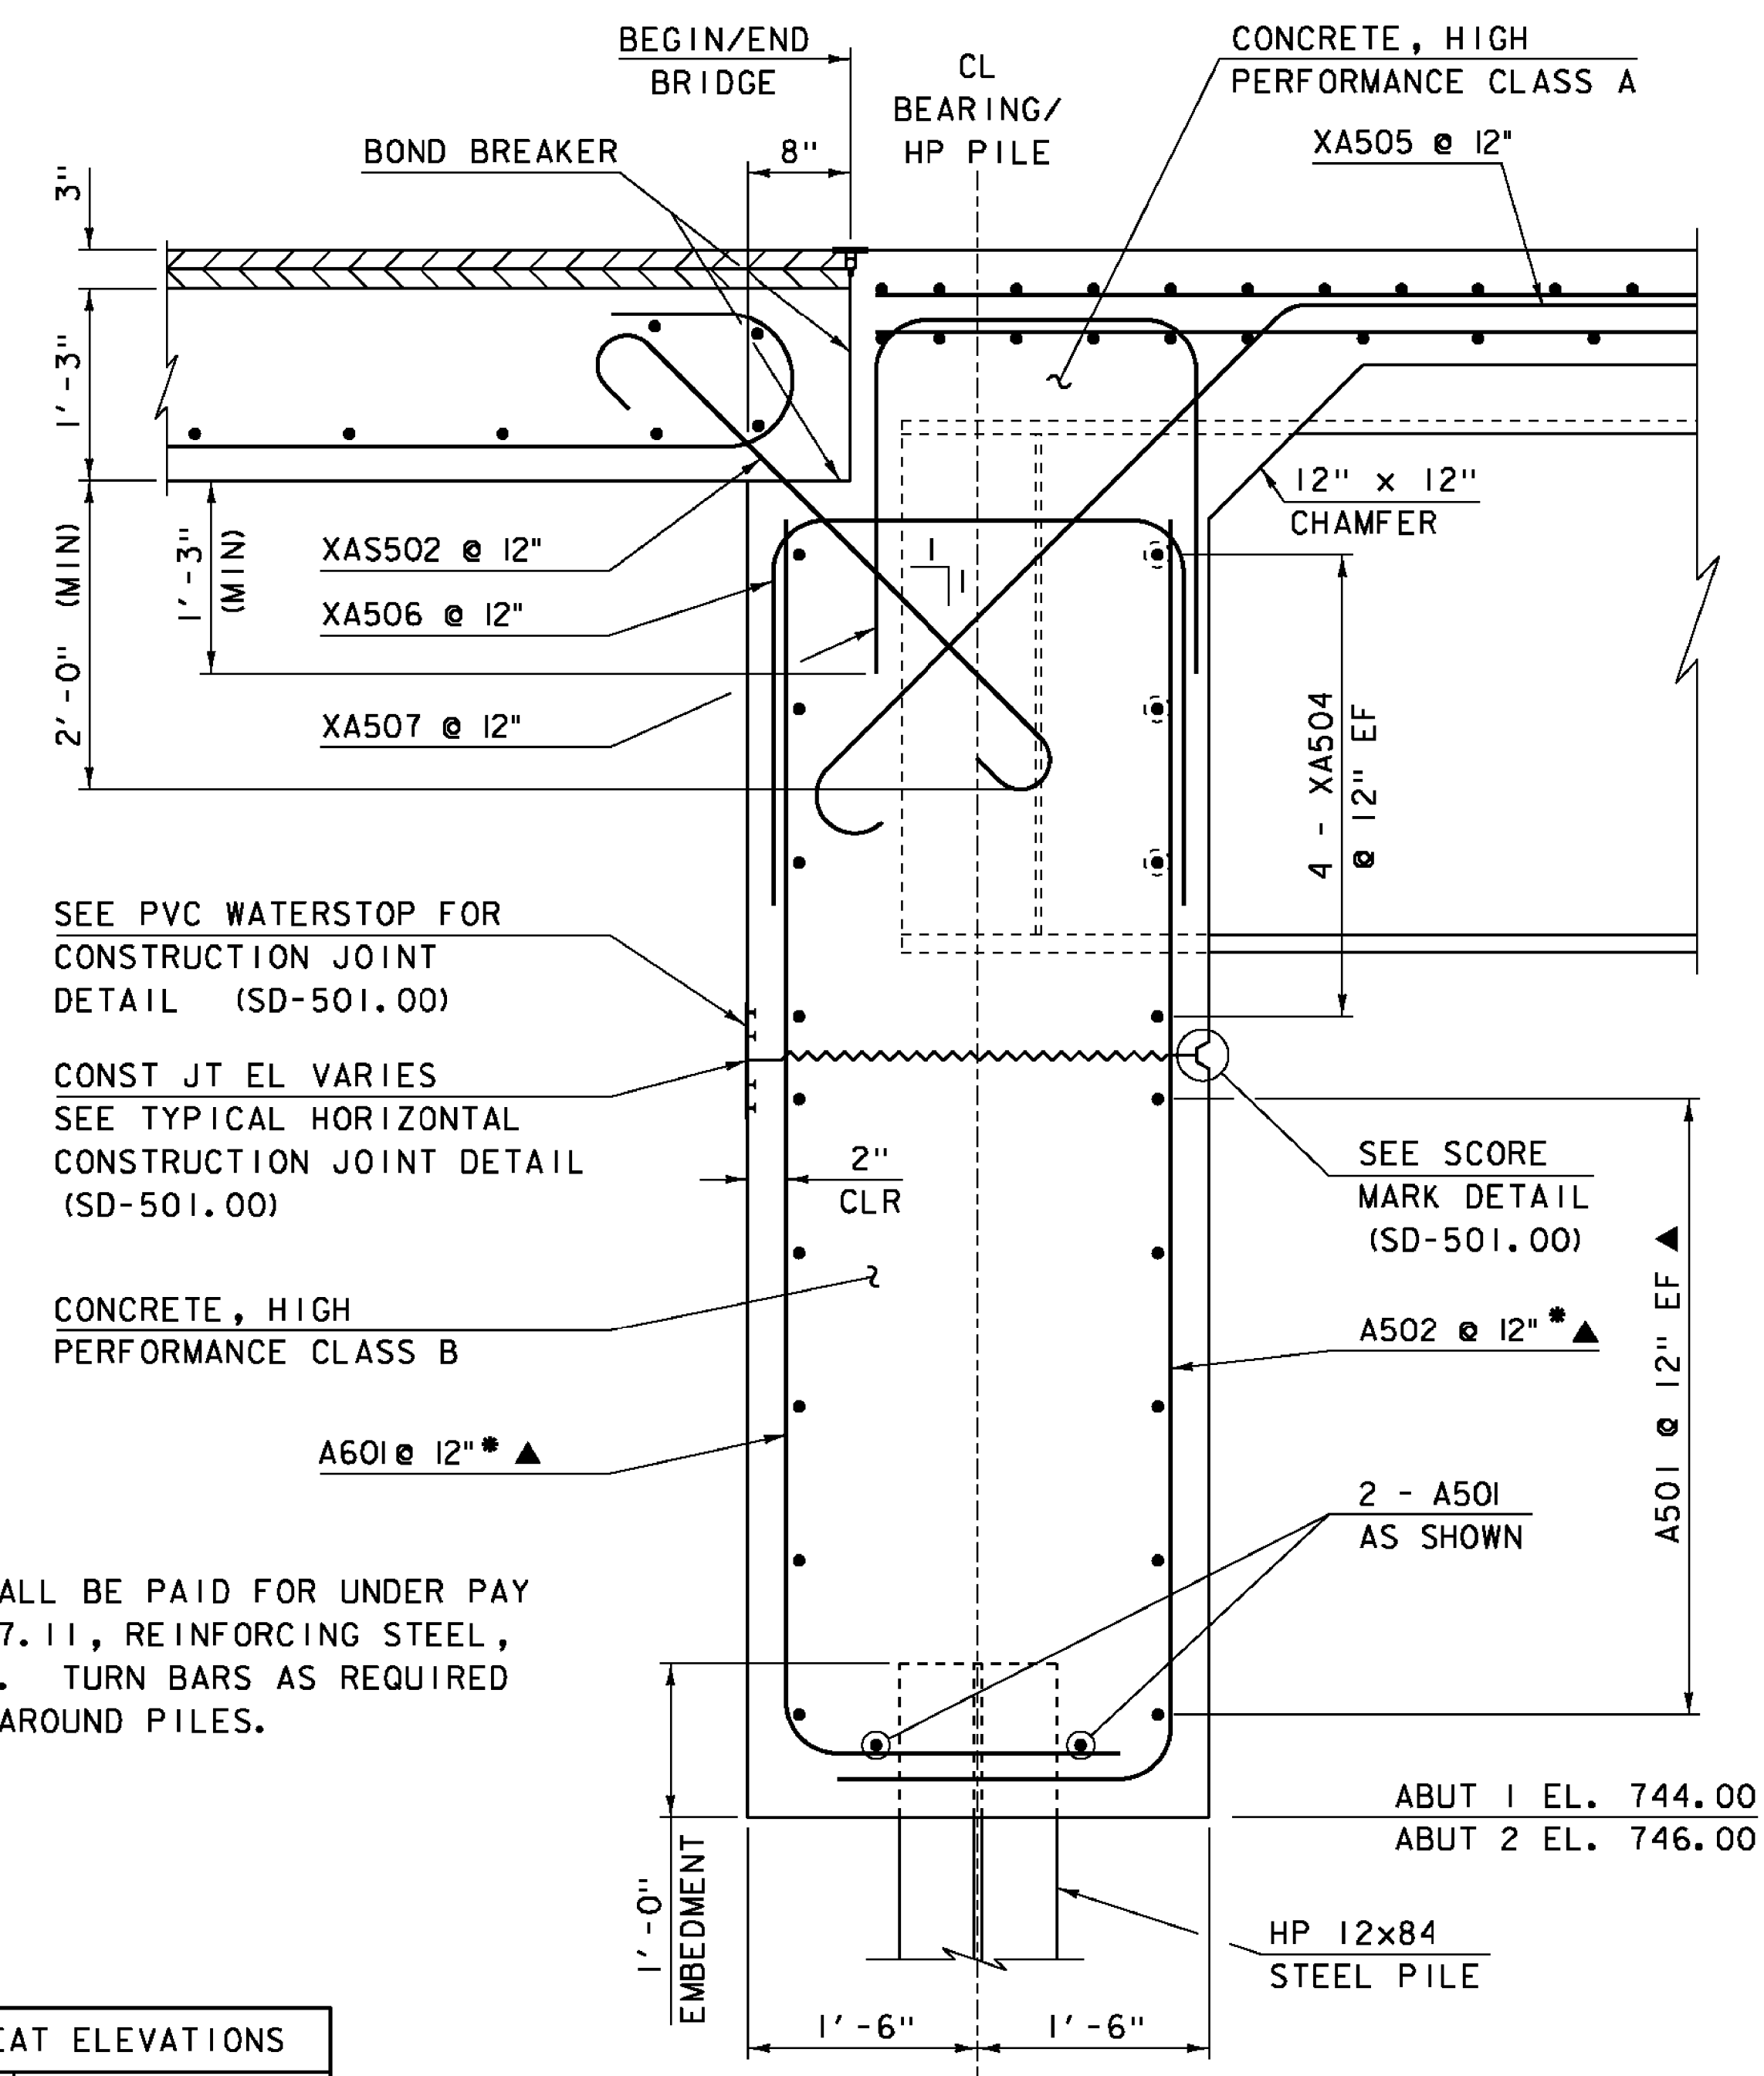

*BARS SHALL BE PAID FOR UNDER PAY ITEM 507.11, REINFORCING STEEL, LEVEL 1. TURN BARS AS REQUIRED TO FIT AROUND PILES.

THEORETICAL BRIDGE SEAT ELEVATIONS		
GIRDER	ABUTMENT NO. 1	ABUTMENT NO. 2
1	747.61	749.03
2	748.21	749.63
3	748.65	750.07
4	749.09	750.51
5	749.53	750.95

- BEARING ASSEMBLY NOTES:
- ALL COMPONENTS OF BEARING ASSEMBLY, INCLUDING ANCHOR BOLTS, NUTS, WASHERS, AND LEVELING PLATES, SHALL BE PAID FOR UNDER ITEM 506.55 "STRUCTURAL STEEL, PLATE GIRDER".
 - ANCHOR BOLTS, NUTS, AND WASHERS SHALL CONFORM TO SUBSECTION 714.08.
 - COMPONENTS DO NOT HAVE TO BE GALVANIZED OR METALIZED.
 - SEE SUBSECTION 531.05 (a) FOR INSTALLATION OF ANCHOR BOLTS.


NOTE:

NF = NEAR FACE
FF = FAR FACE
EF = EACH FACE
▲ = CUT TO FIT IN FIELD 3" CLEAR, UNLESS OTHERWISE SPECIFIED ON THE PLANS.
2'-2" BAR LAP UNLESS OTHERWISE SPECIFIED ON THE PLANS.


PROJECT NAME: ST. JOHNSBURY
PROJECT NUMBER: BRF 028-4(25)S

FILE NAME: s98b320sub.dgn
PROJECT LEADER: C. CARLSON
DESIGNED BY: H. SALLS
ABUTMENT TYPICAL SECTIONS


PLOT DATE: 28-AUG-2012
DRAWN BY: R. PELLETT
CHECKED BY: C. CARLSON
SHEET 28 OF 62

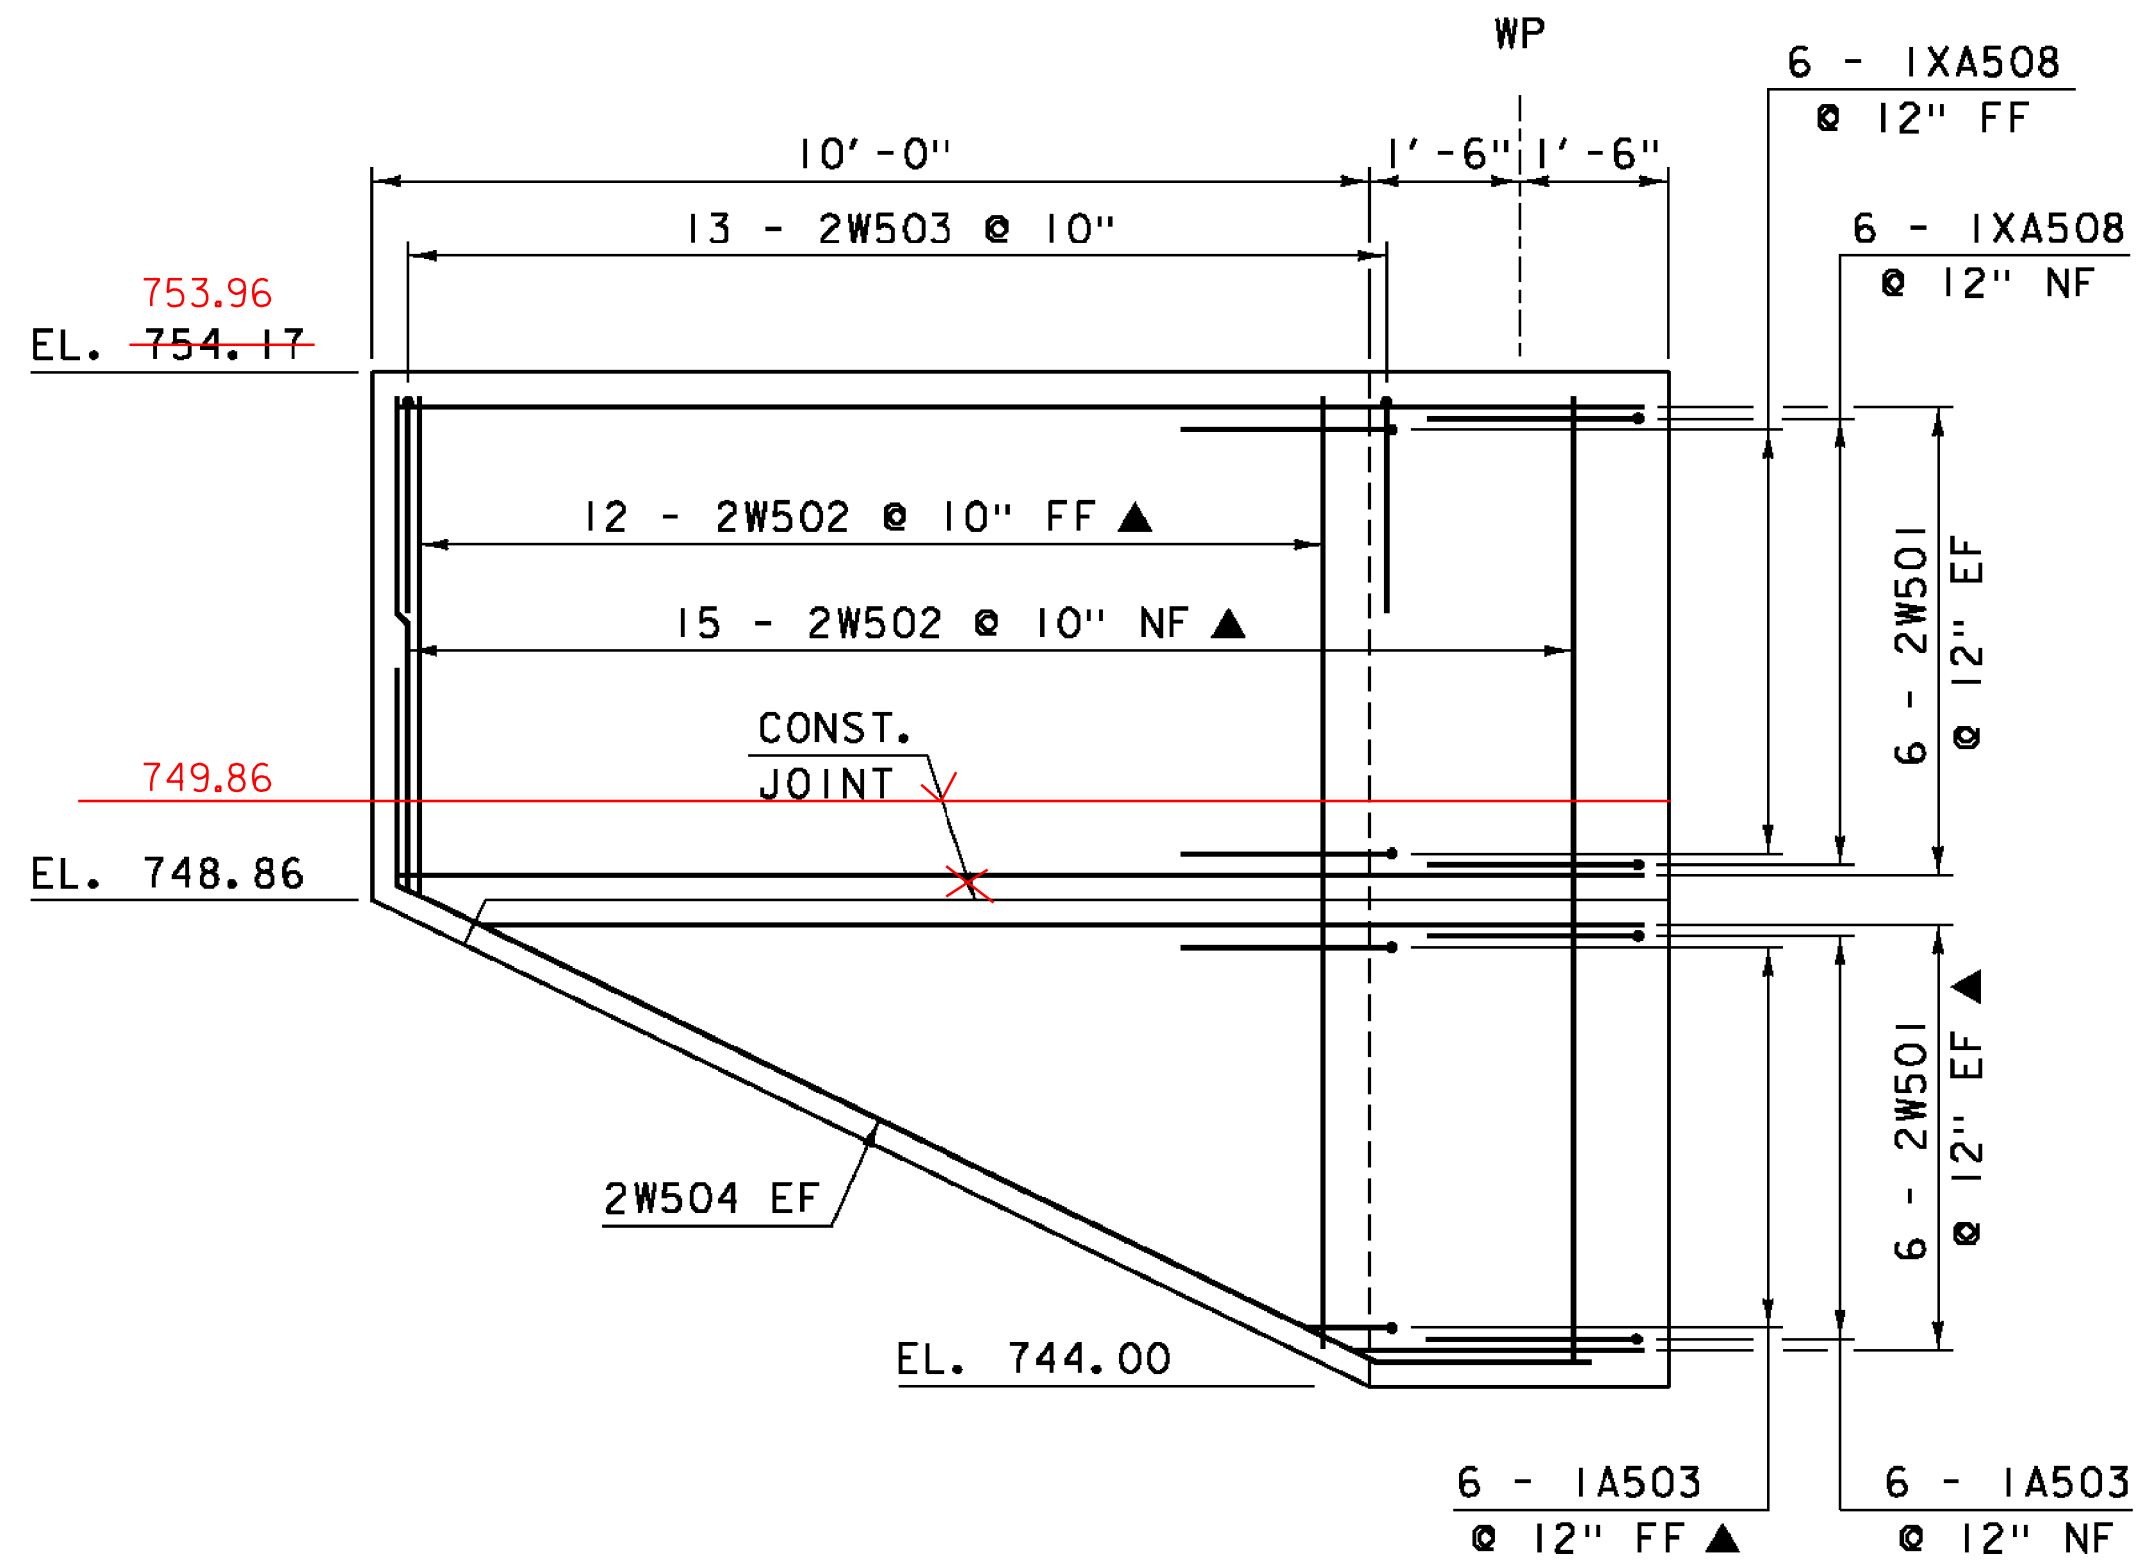


WINGWALL 2 ELEVATION
SCALE 1/2" = 1'-0"

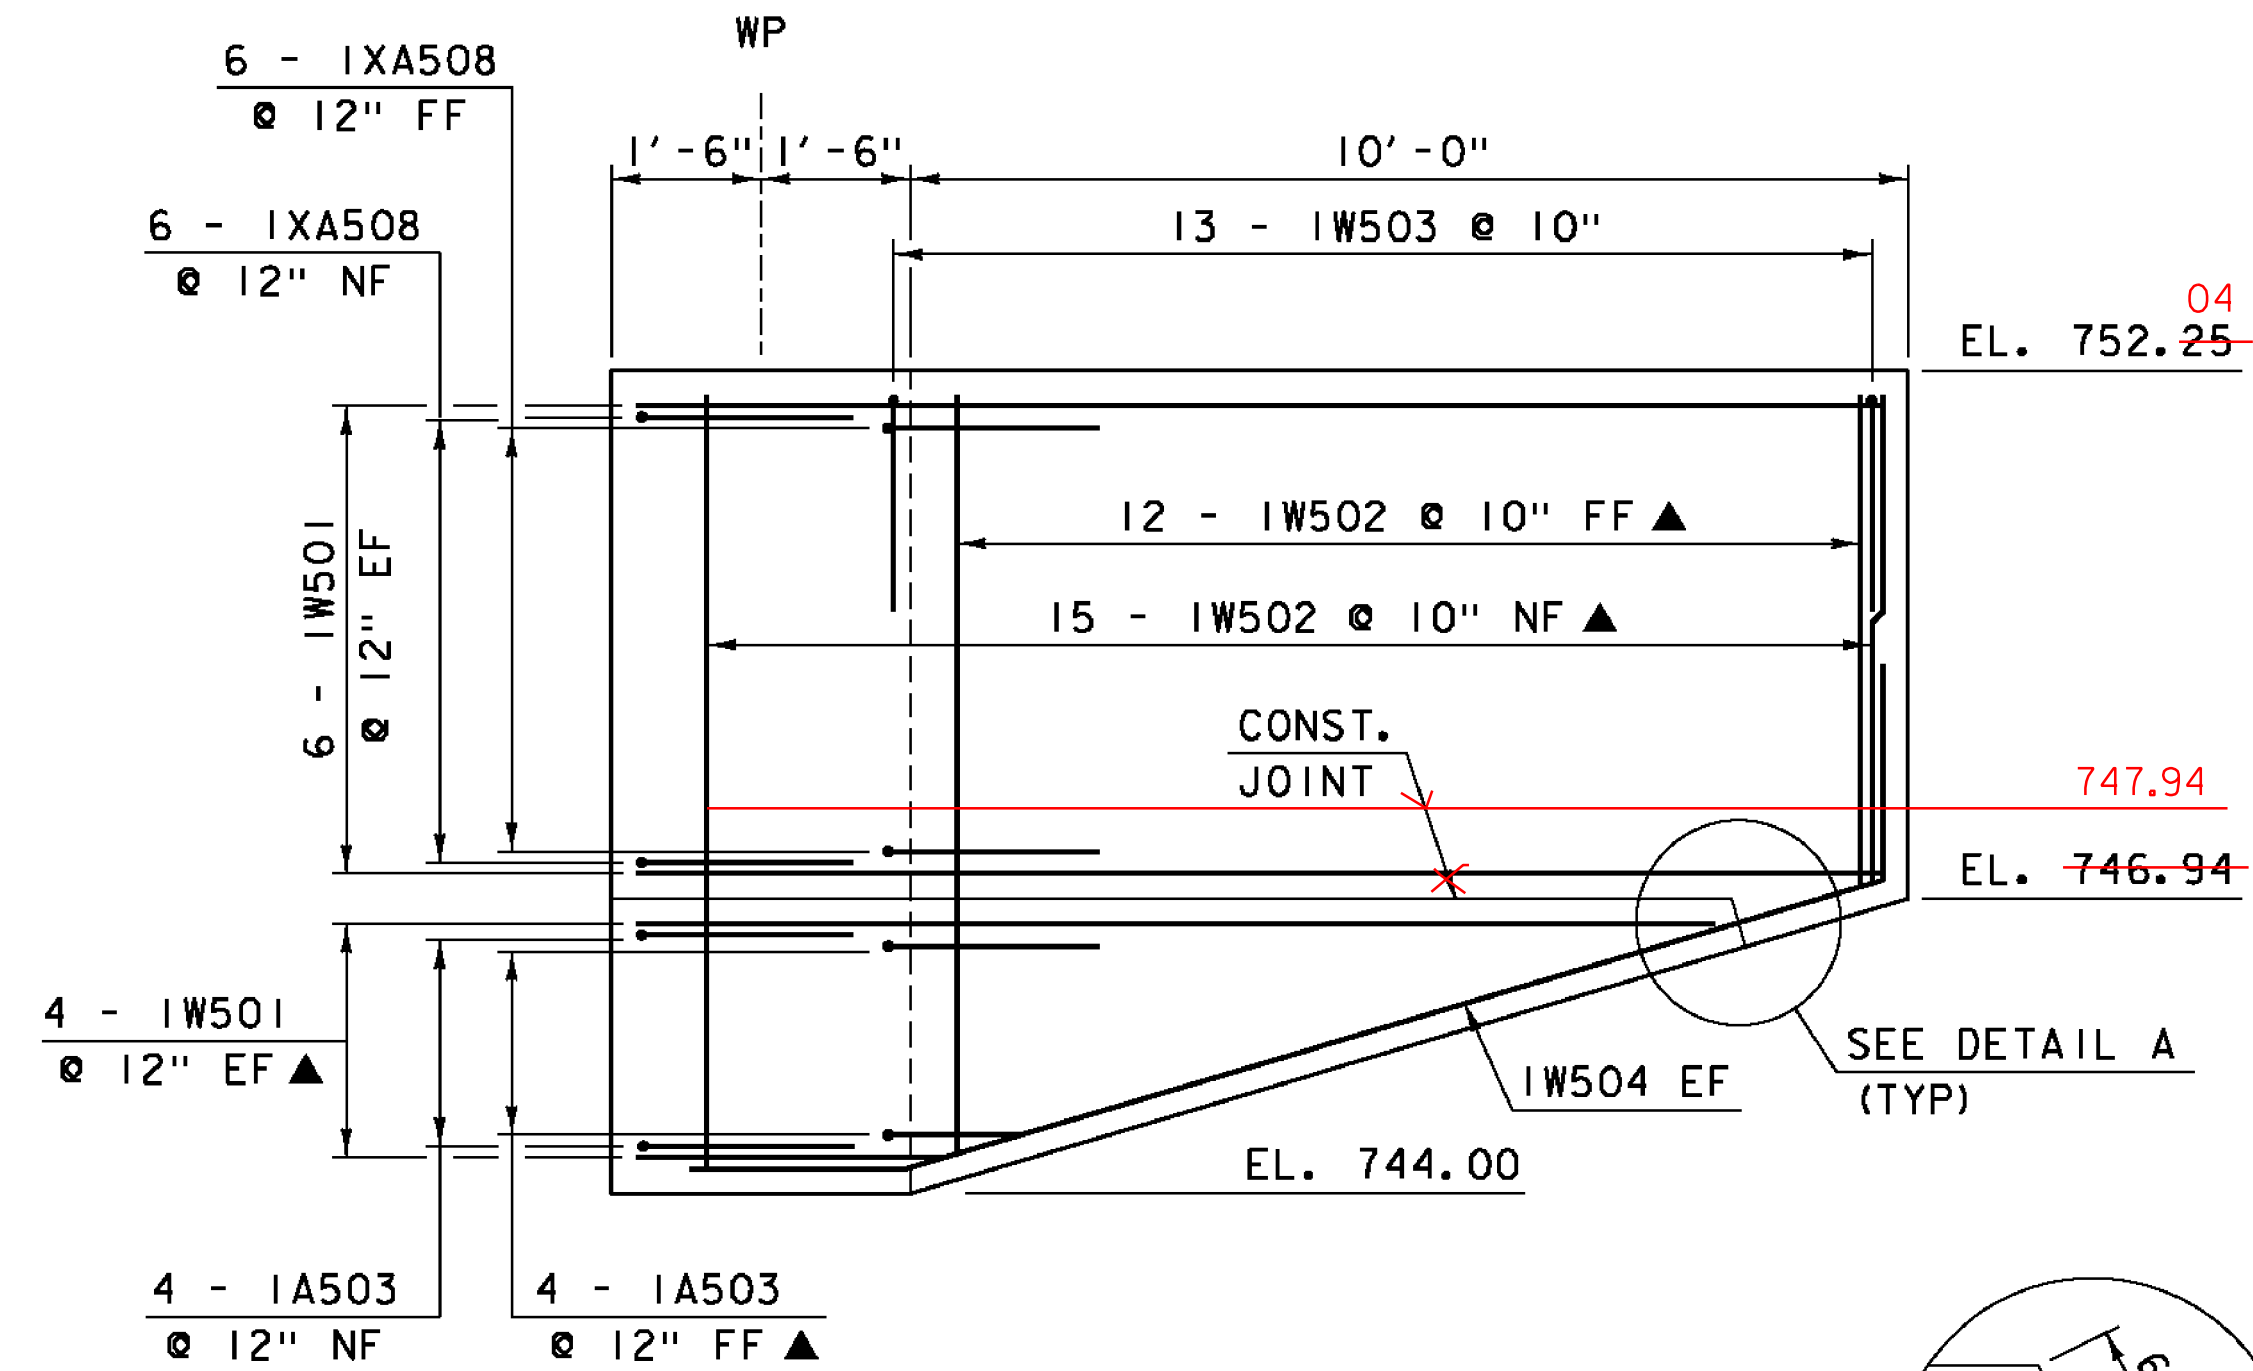


WINGWALL 1 ELEVATION
SCALE 1/2" = 1'-0"

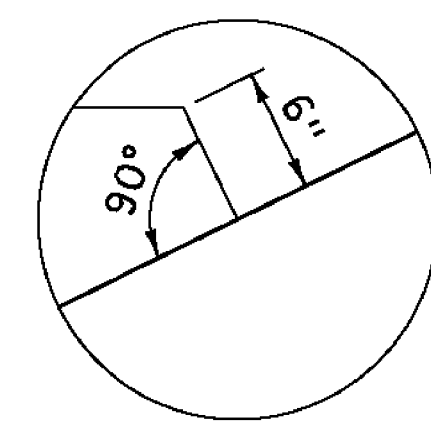


DETAIL A
NTS

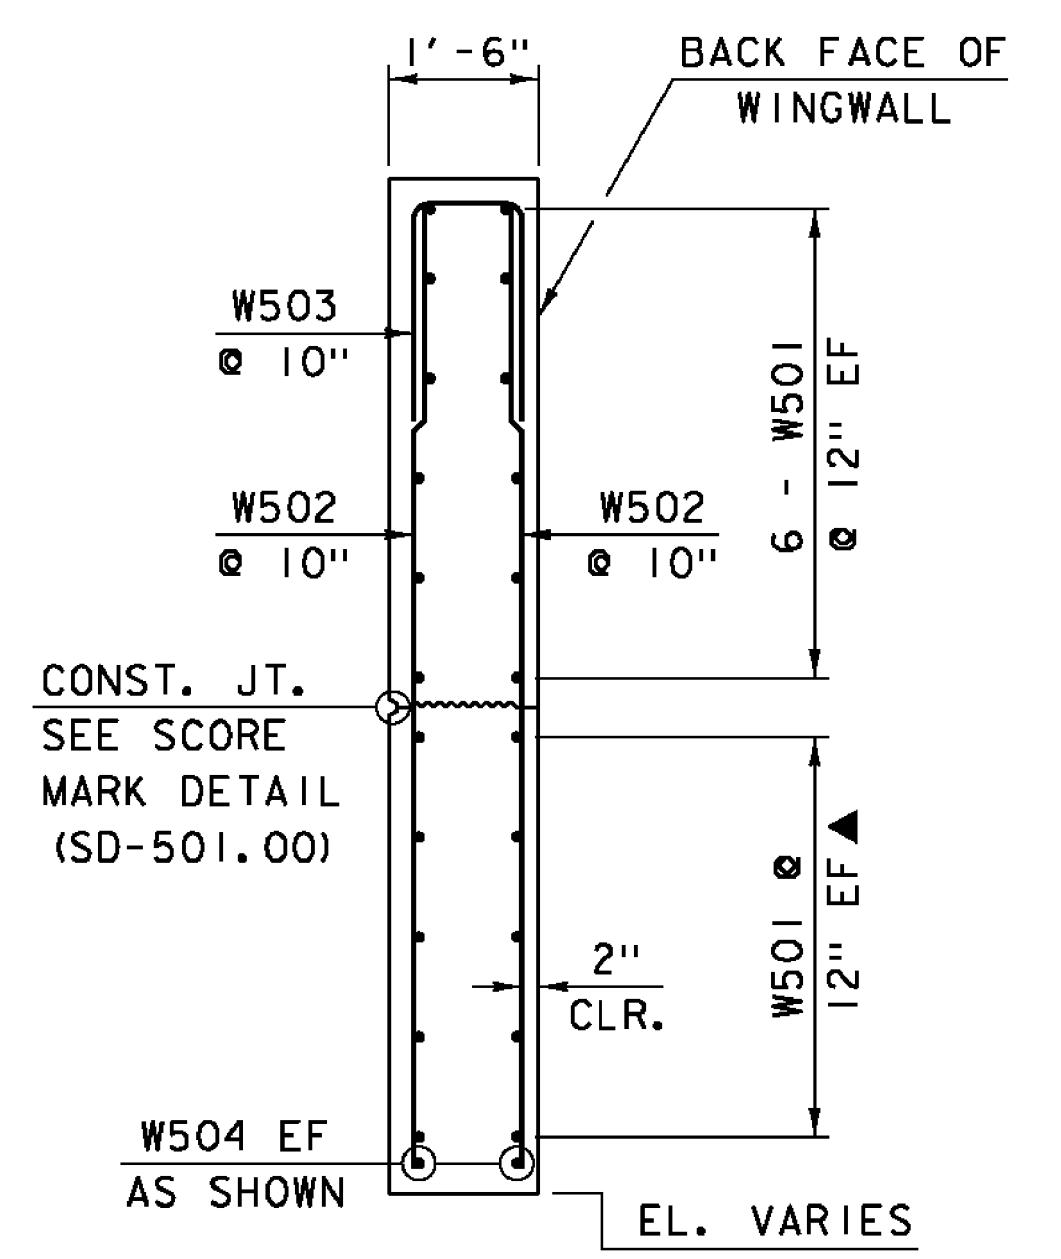


WINGWALL TYPICAL SECTION
SCALE 1/2" = 1'-0"

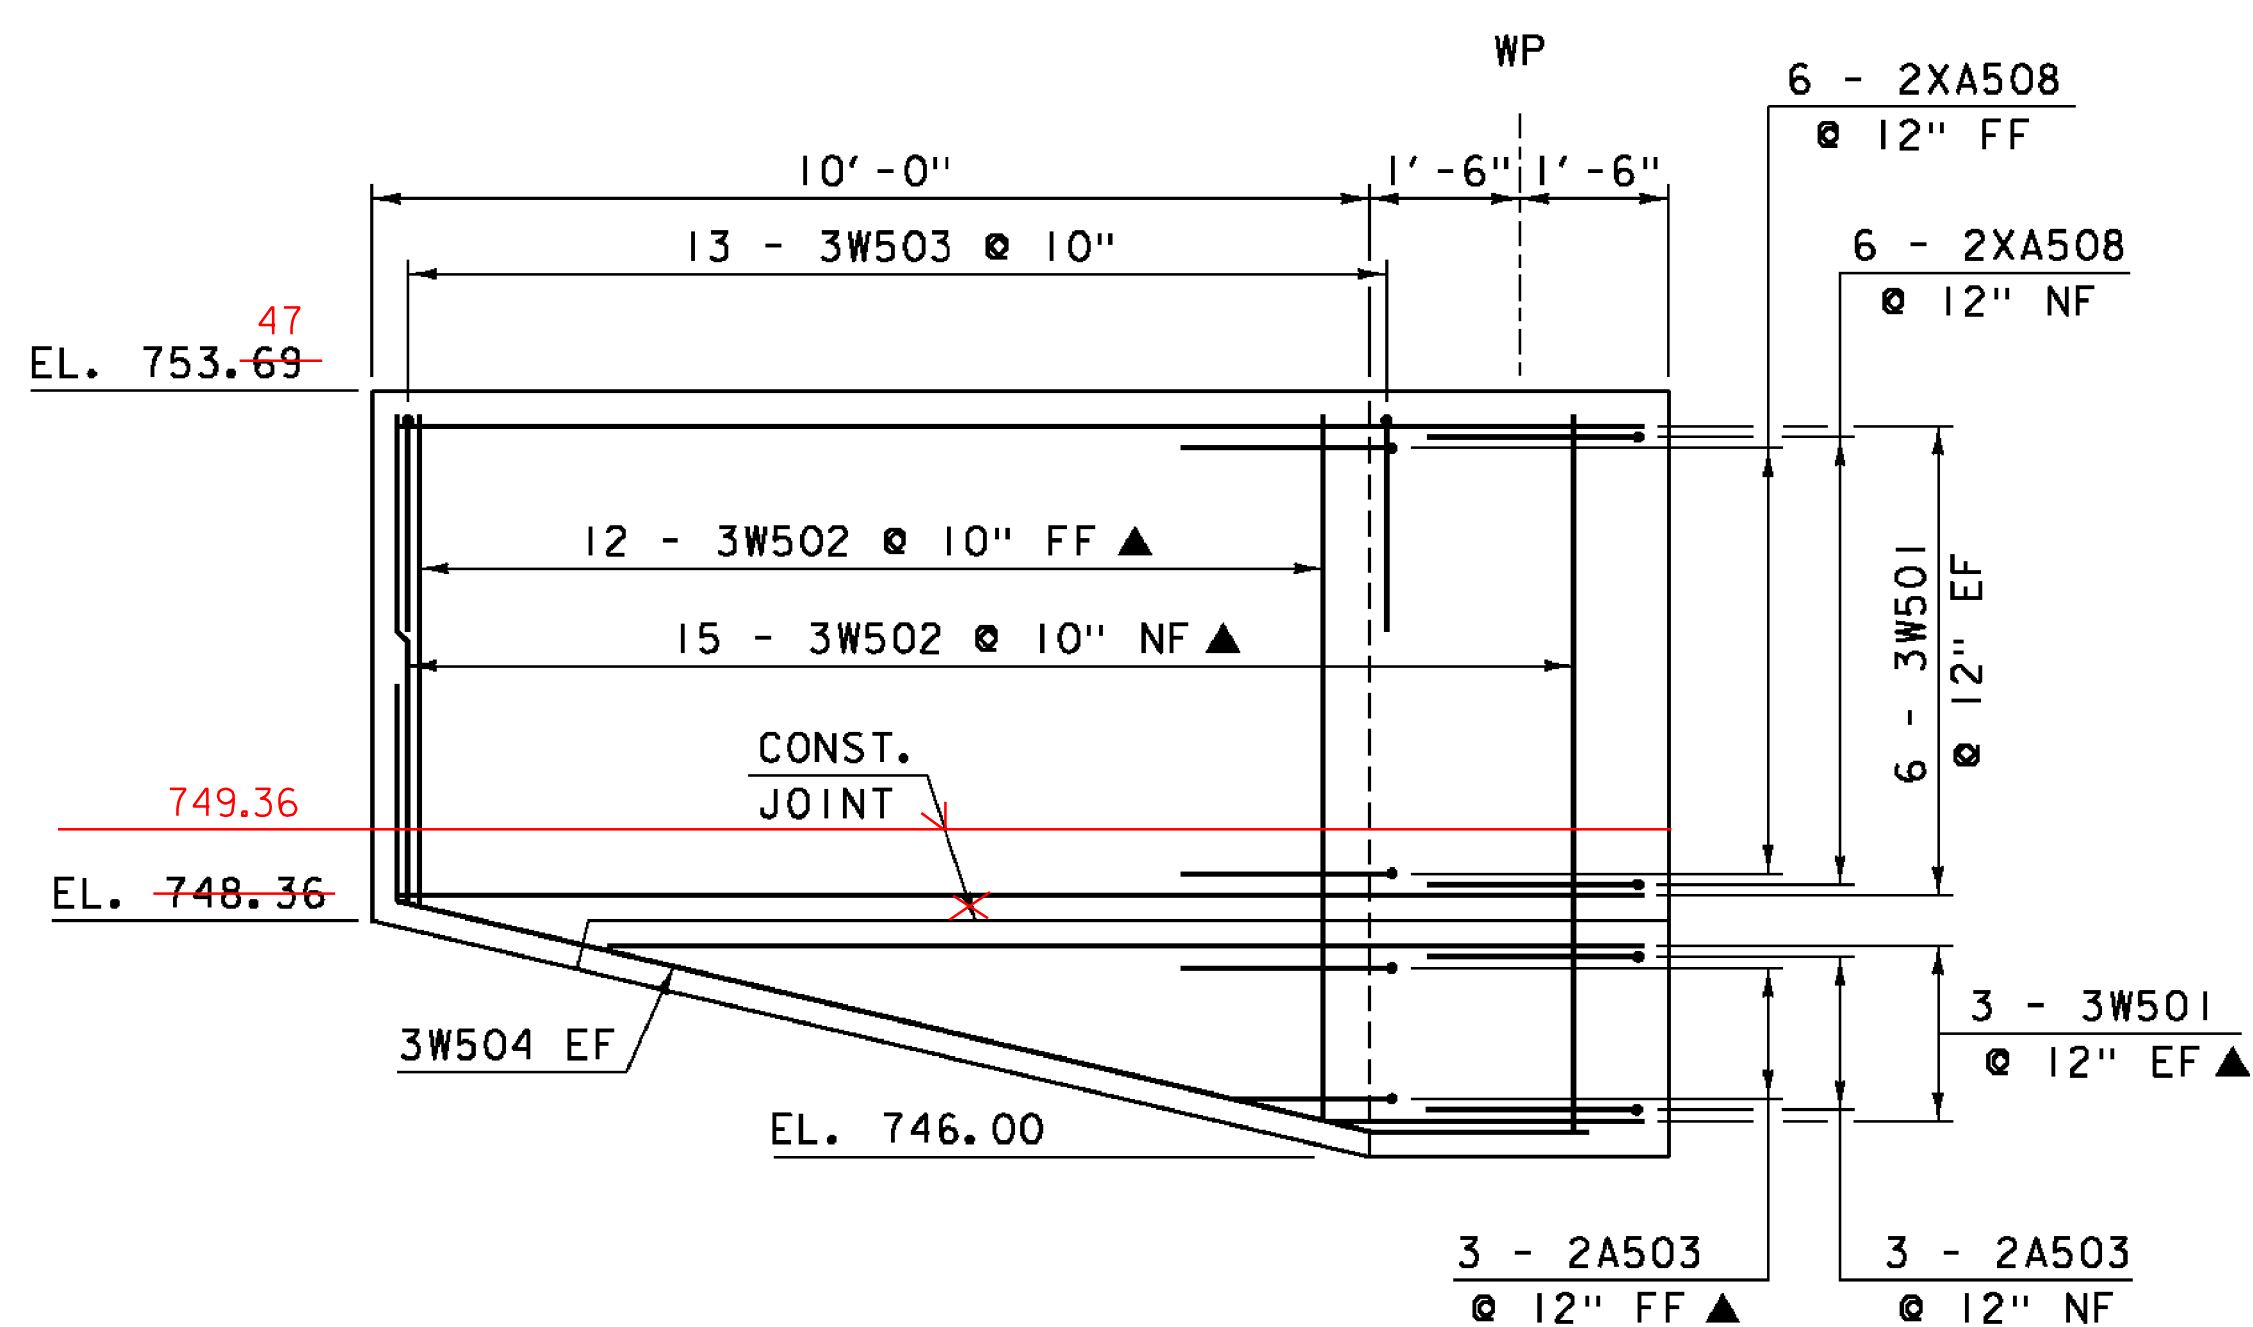

WINGWALL 3 ELEVATION
SCALE 1/2" = 1'-0"

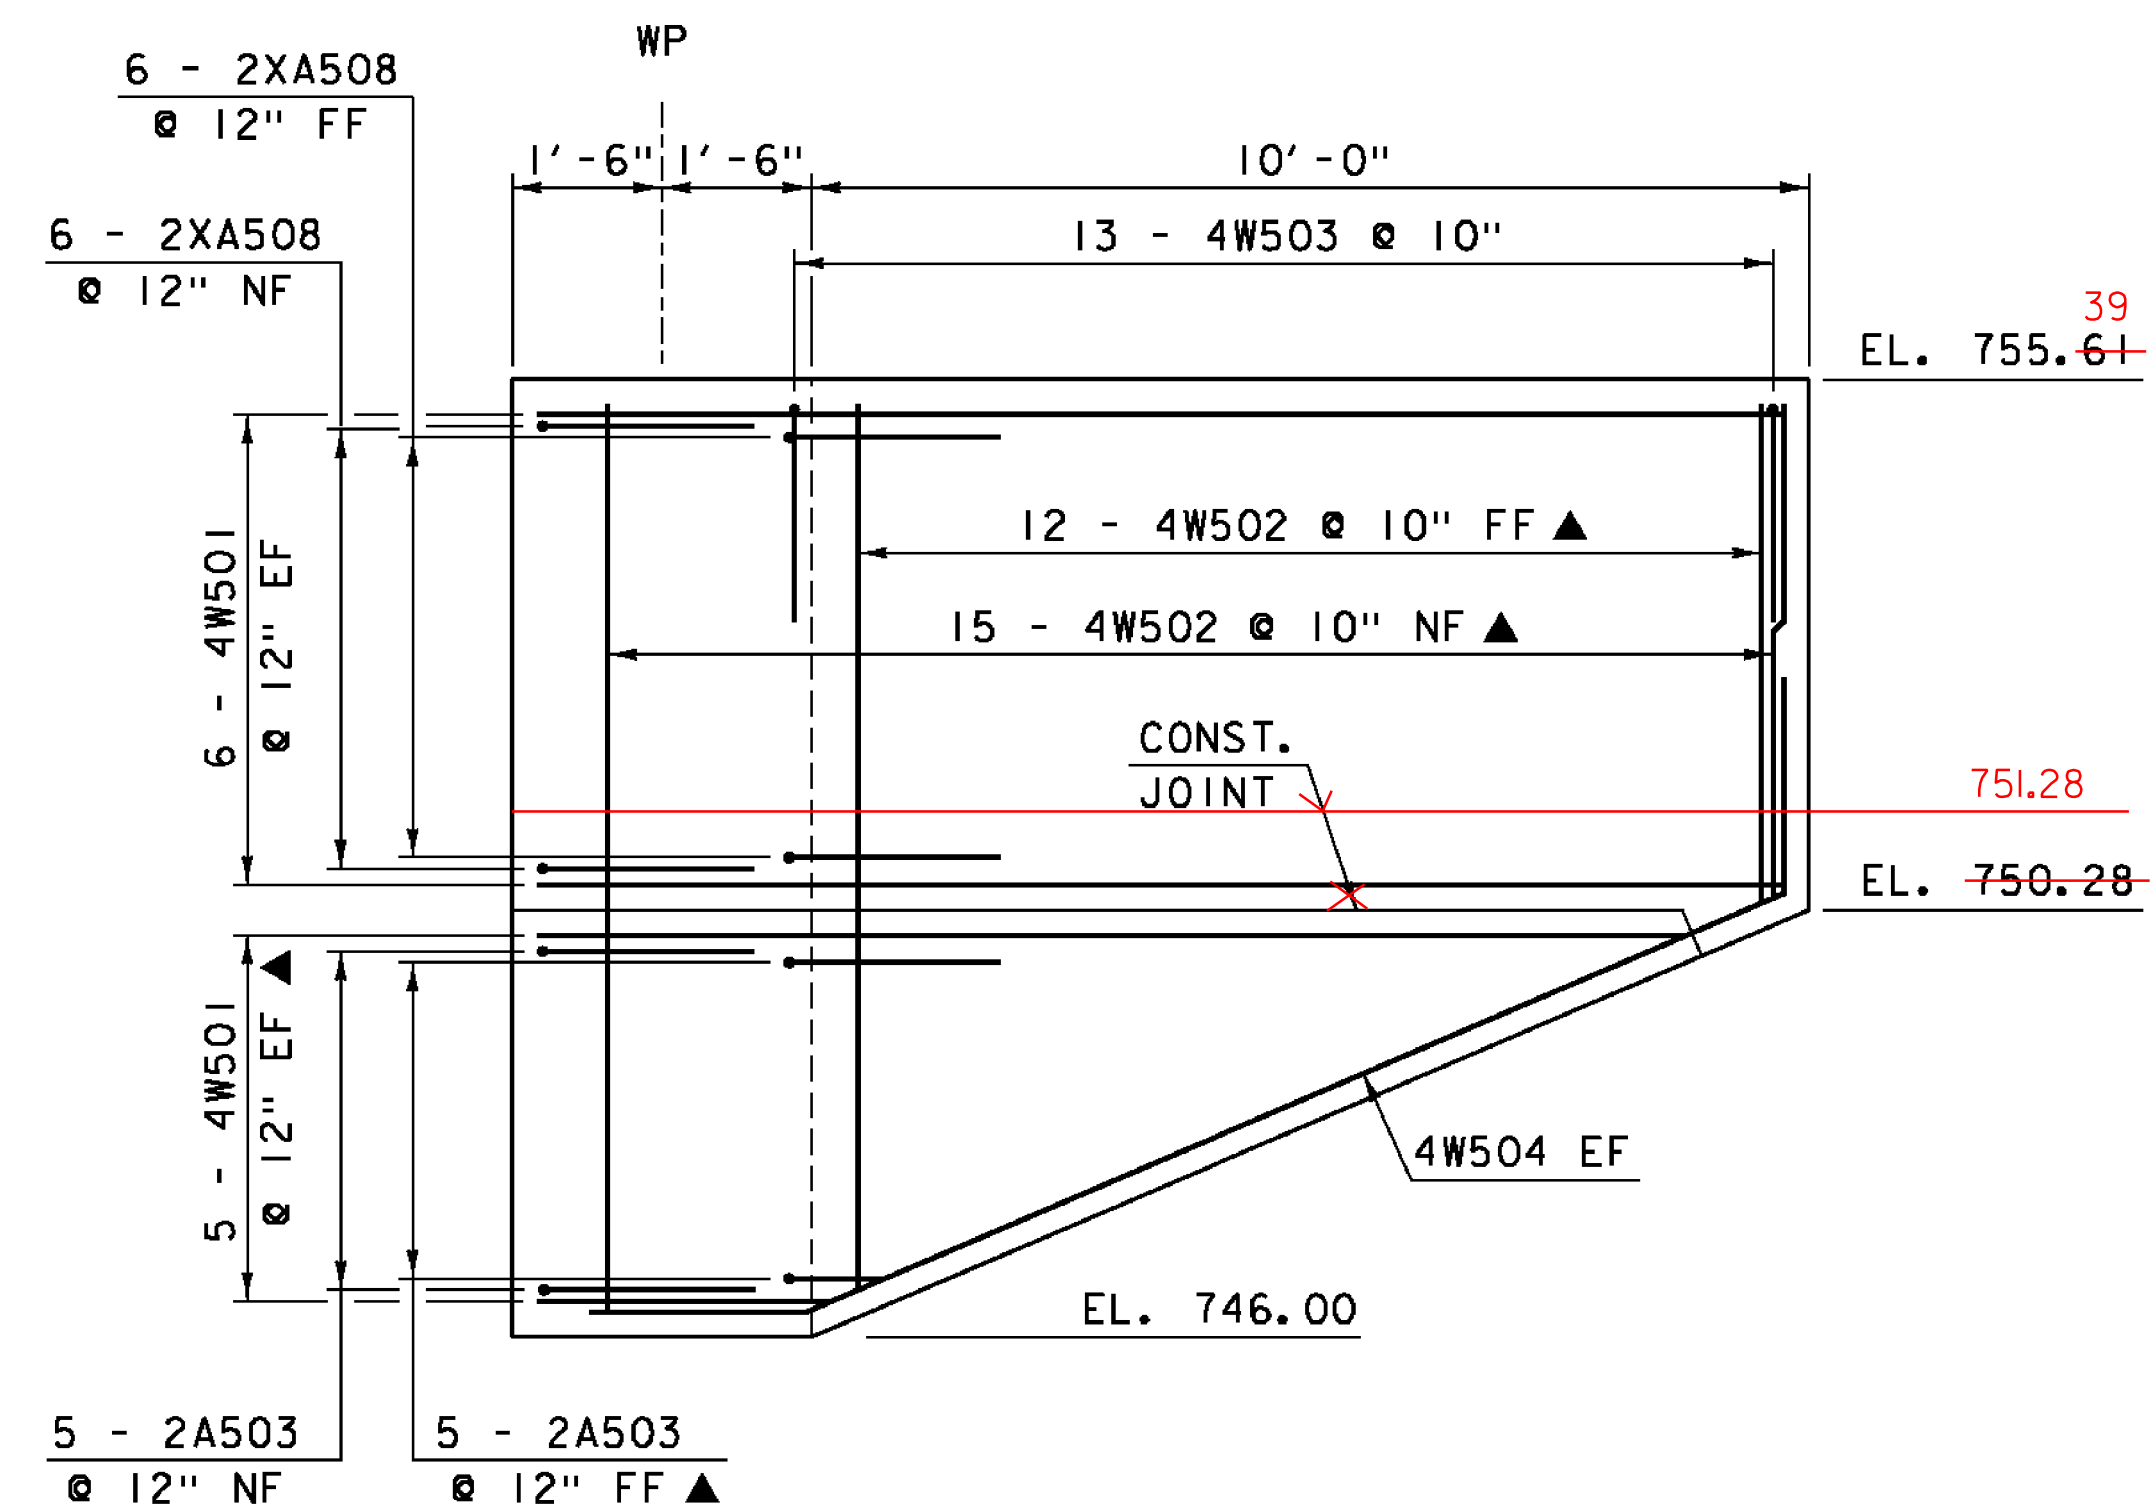


WINGWALL 4 ELEVATION
SCALE 1/2" = 1'-0"

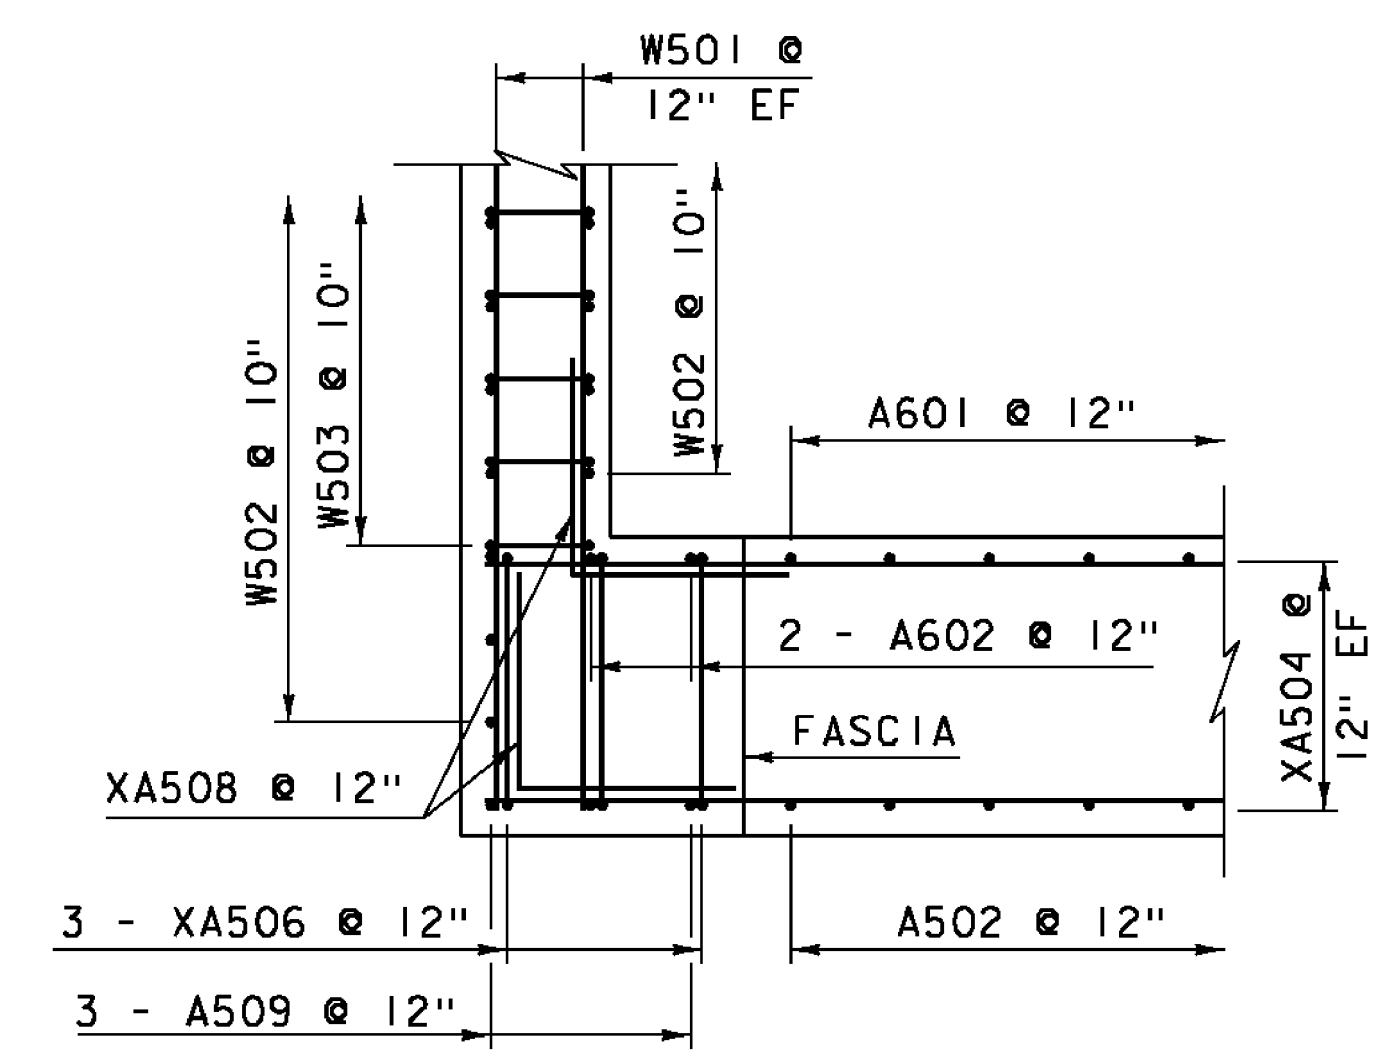


TYPICAL CORNER DETAIL
SCALE 1/2" = 1'-0"


PROJECT NAME: ST. JOHNSBURY	PLOT DATE: 28-AUG-2012
PROJECT NUMBER: BRF 028-4(25)S	DRAWN BY: R. PELLETT
FILE NAME: s98b320sub.dgn	CHECKED BY: C. CARLSON
PROJECT LEADER: C. CARLSON	SHEET 29 OF 62
DESIGNED BY: H. SALLS	
WINGWALL DETAILS	

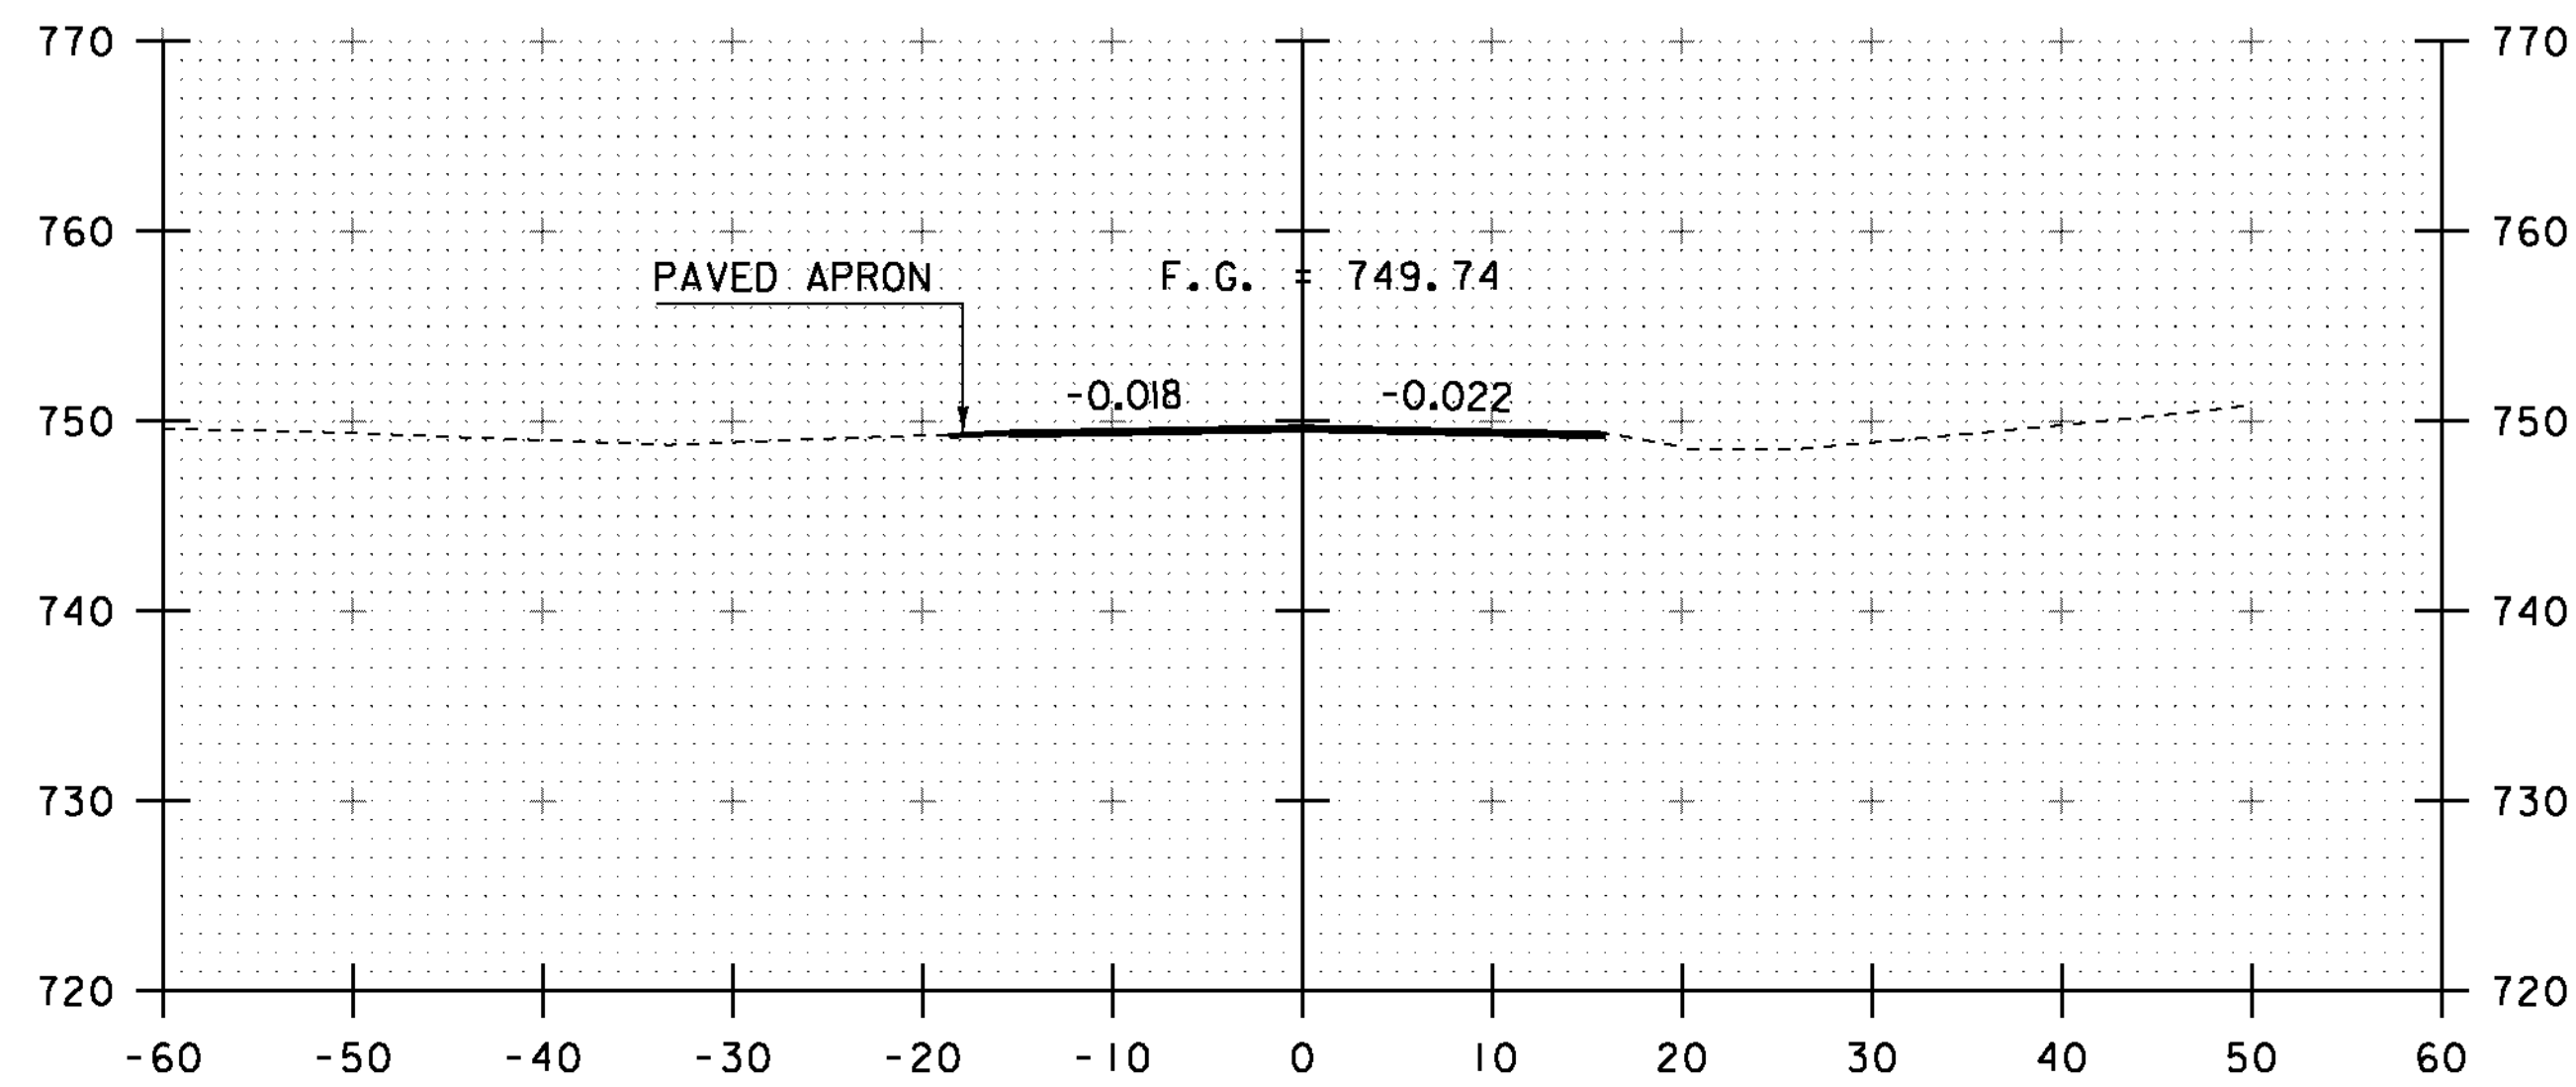


376+50

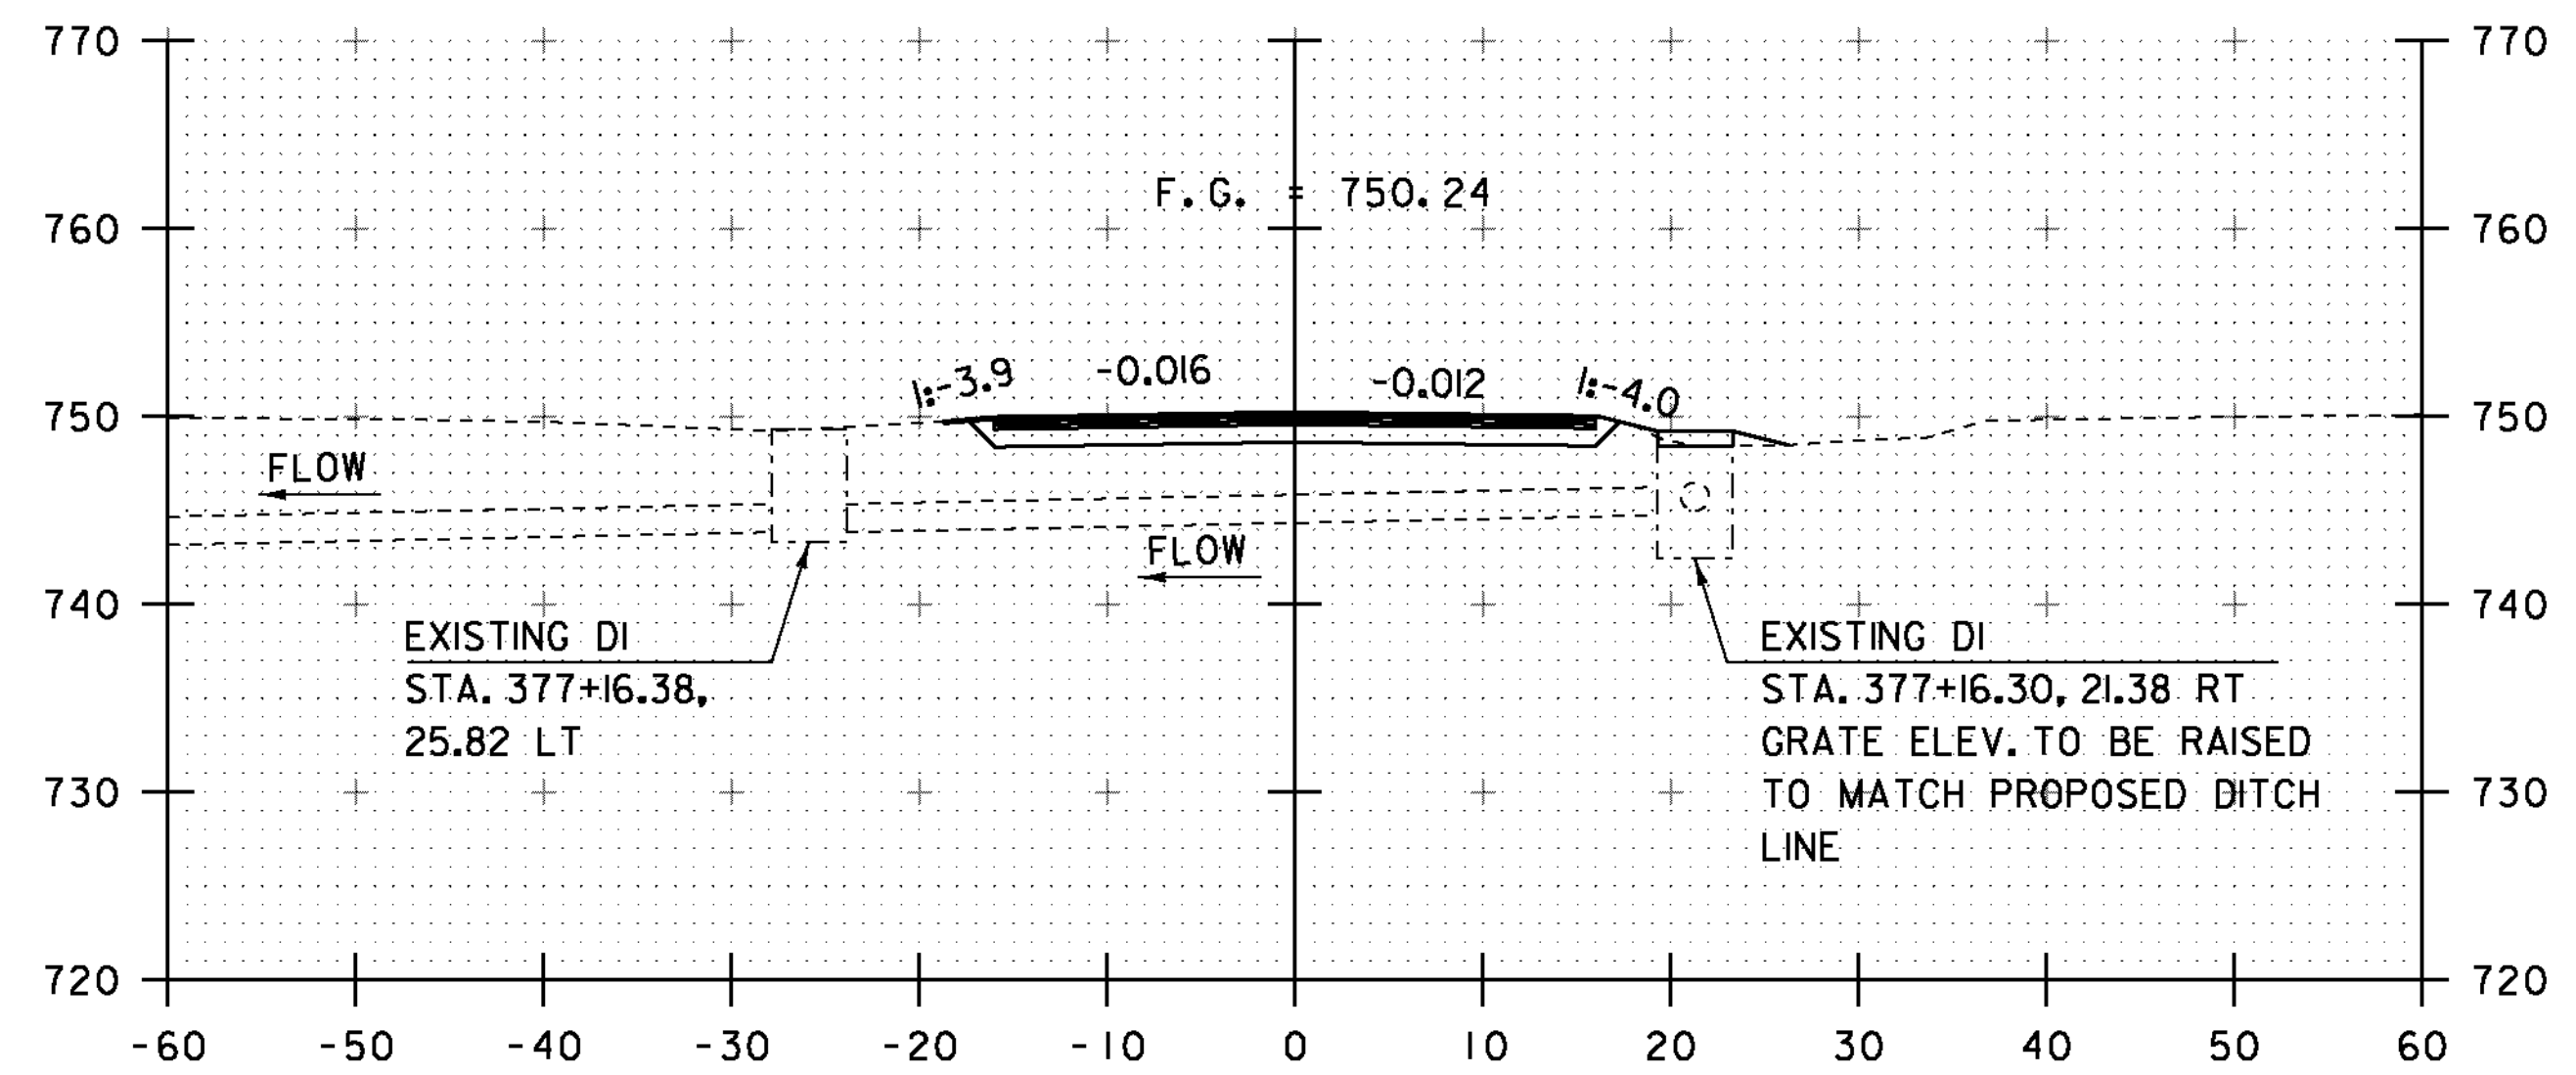

377+00

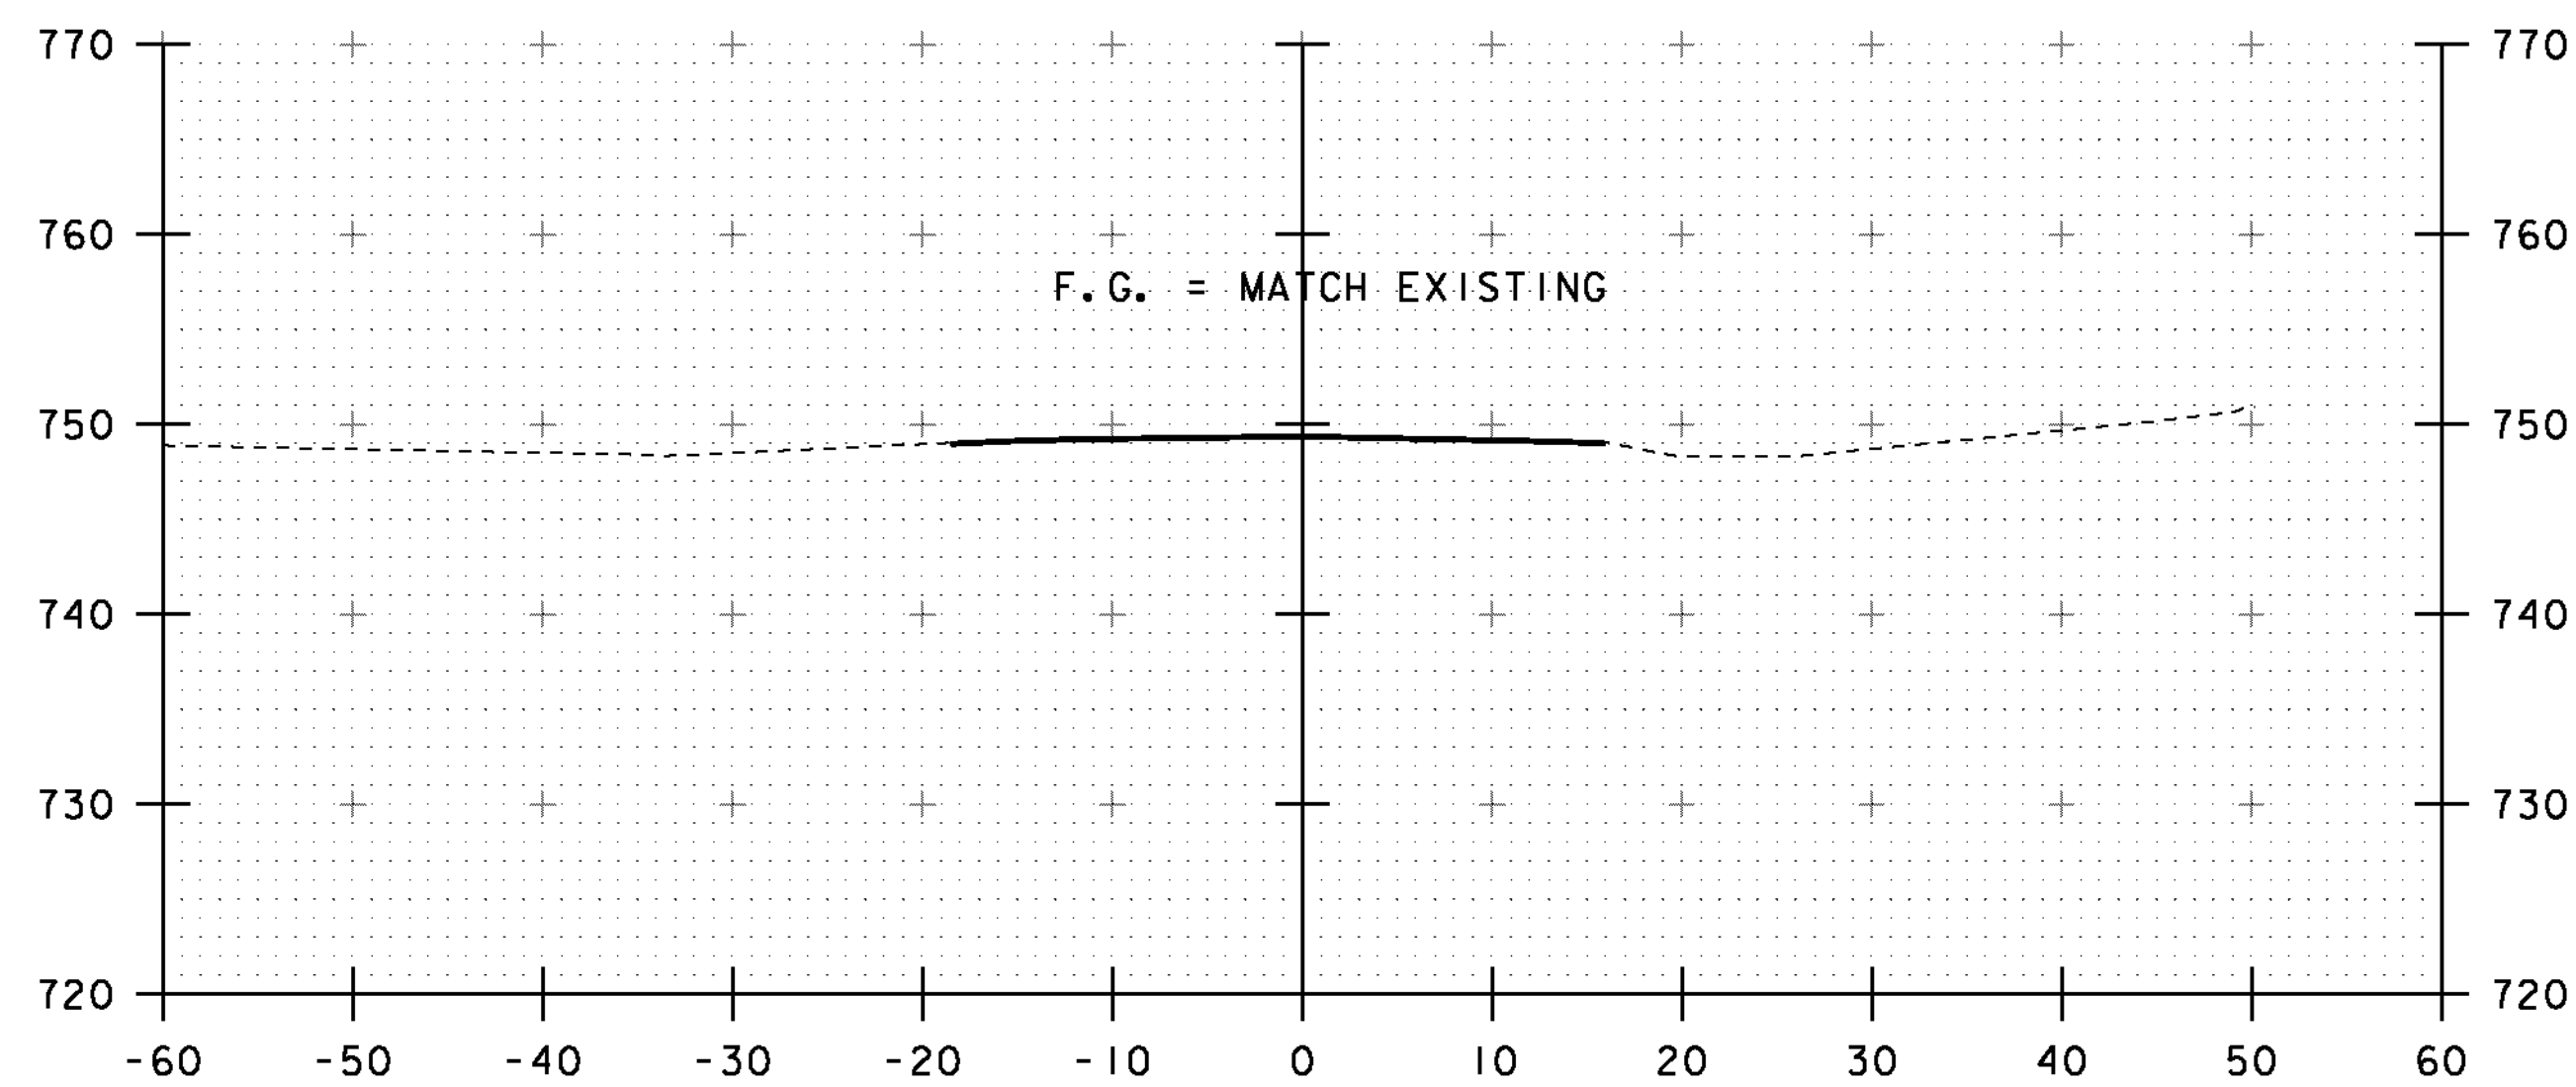

376+25

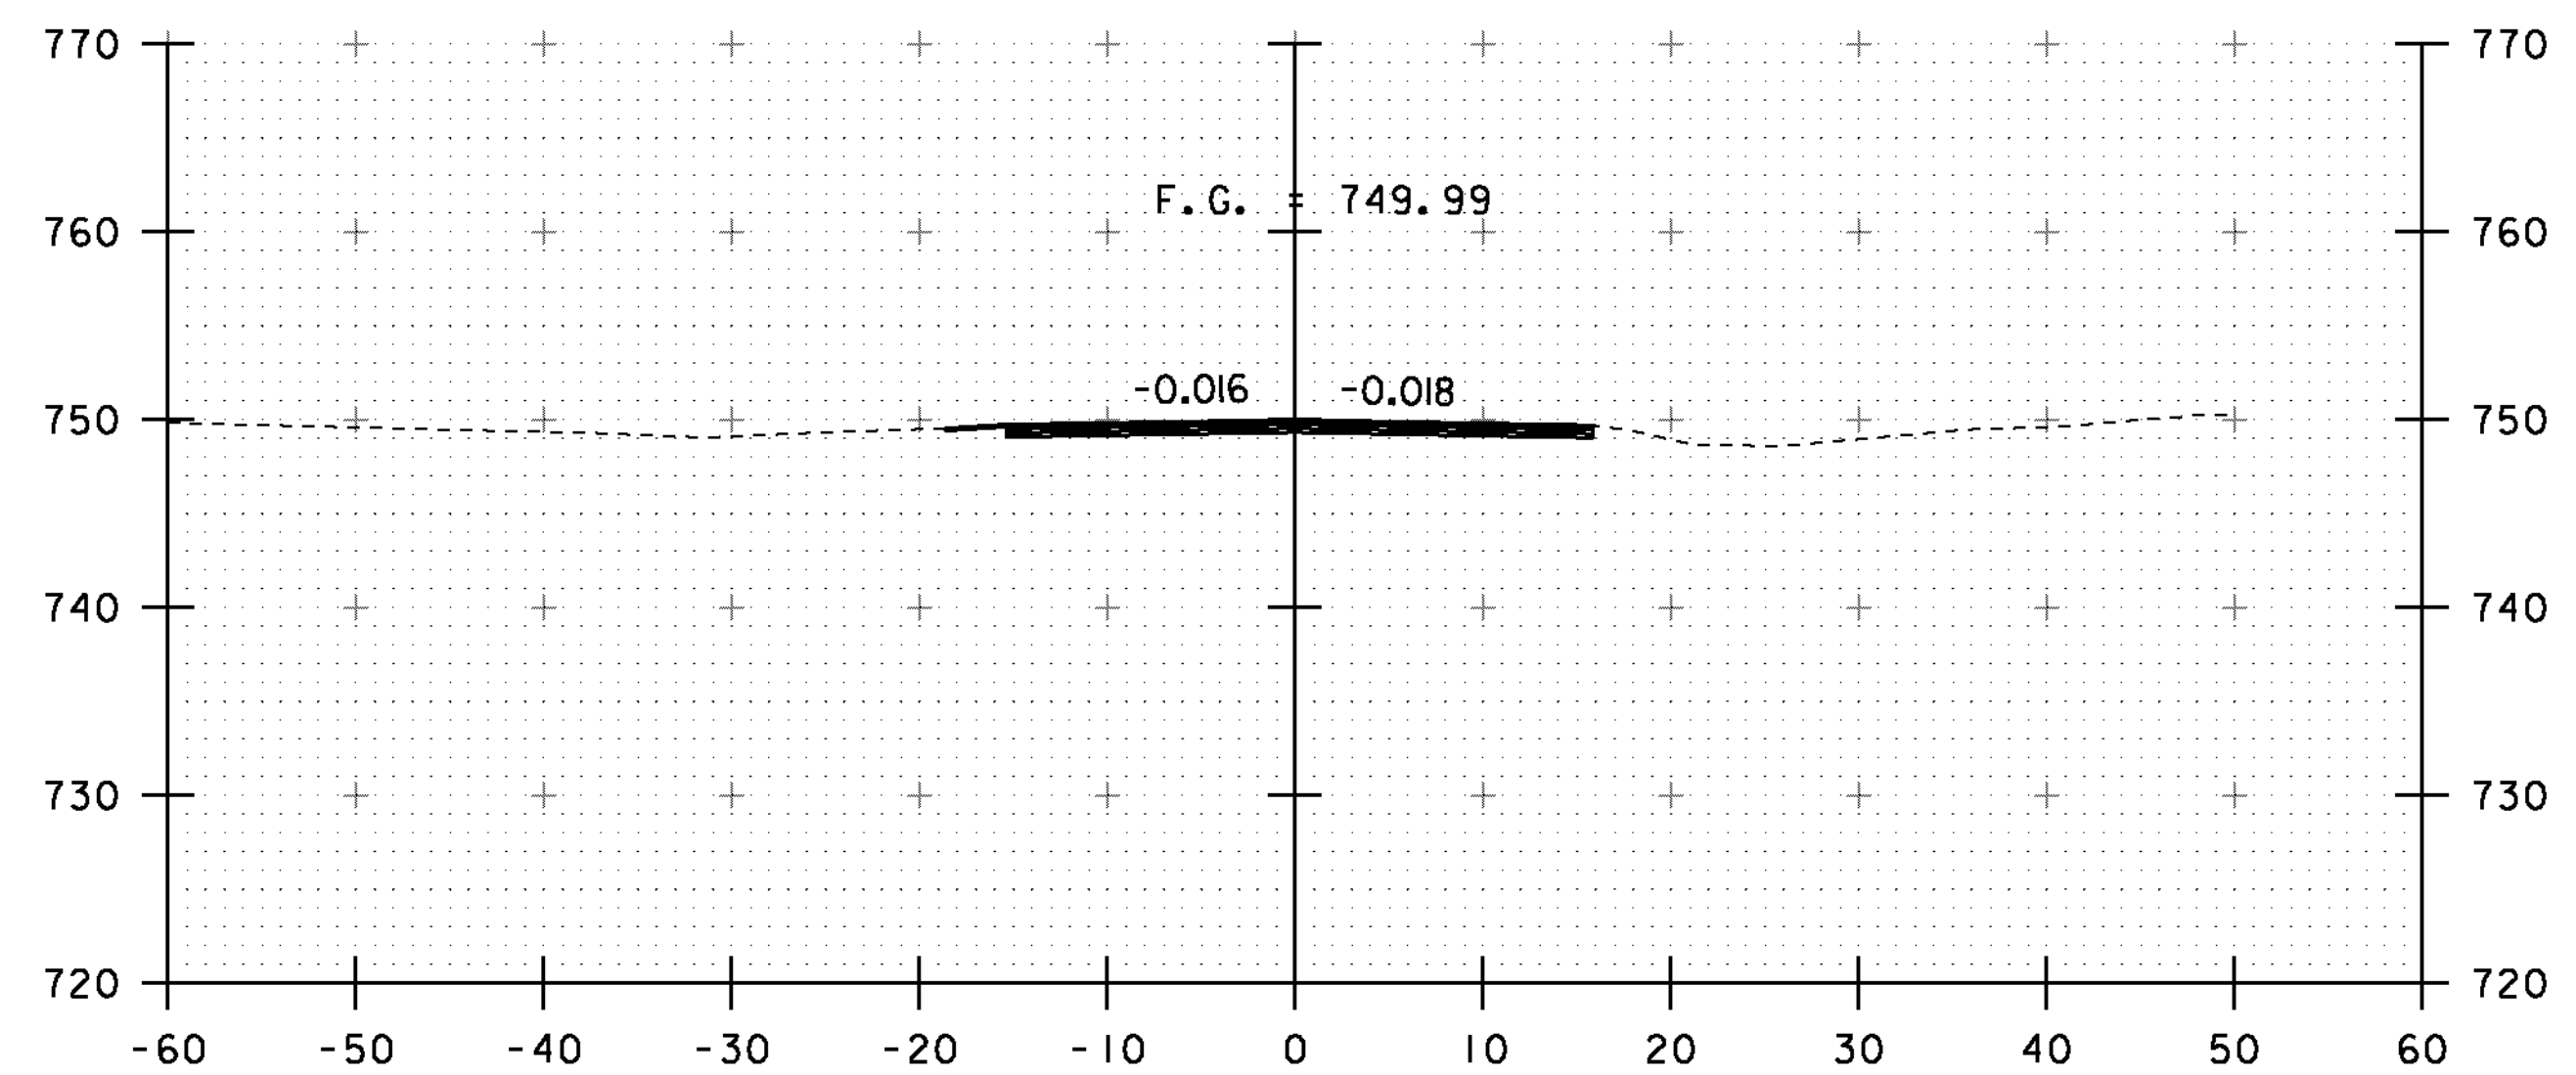

376+75


STA. 376+25.00
BEGIN APPROACH
STA. 376+25 TO STA. 377+18 LT
CONSTRUCT 3'-0" PAVED APRON

10 0 10
SCALE: 1" = 10'-0"
STA. 376+25 TO STA. 377+00


PROJECT NAME: ST. JOHNSBURY
PROJECT NUMBER: BRF 028-4(25)S

FILE NAME: s98b320xsl.dgn
PROJECT LEADER: C. CARLSON
DESIGNED BY: H. SALLS
ROADWAY CROSS SECTIONS I


PLOT DATE: 28-AUG-2012
DRAWN BY: C. MOONEY
CHECKED BY: C. CARLSON
SHEET 31 OF 62

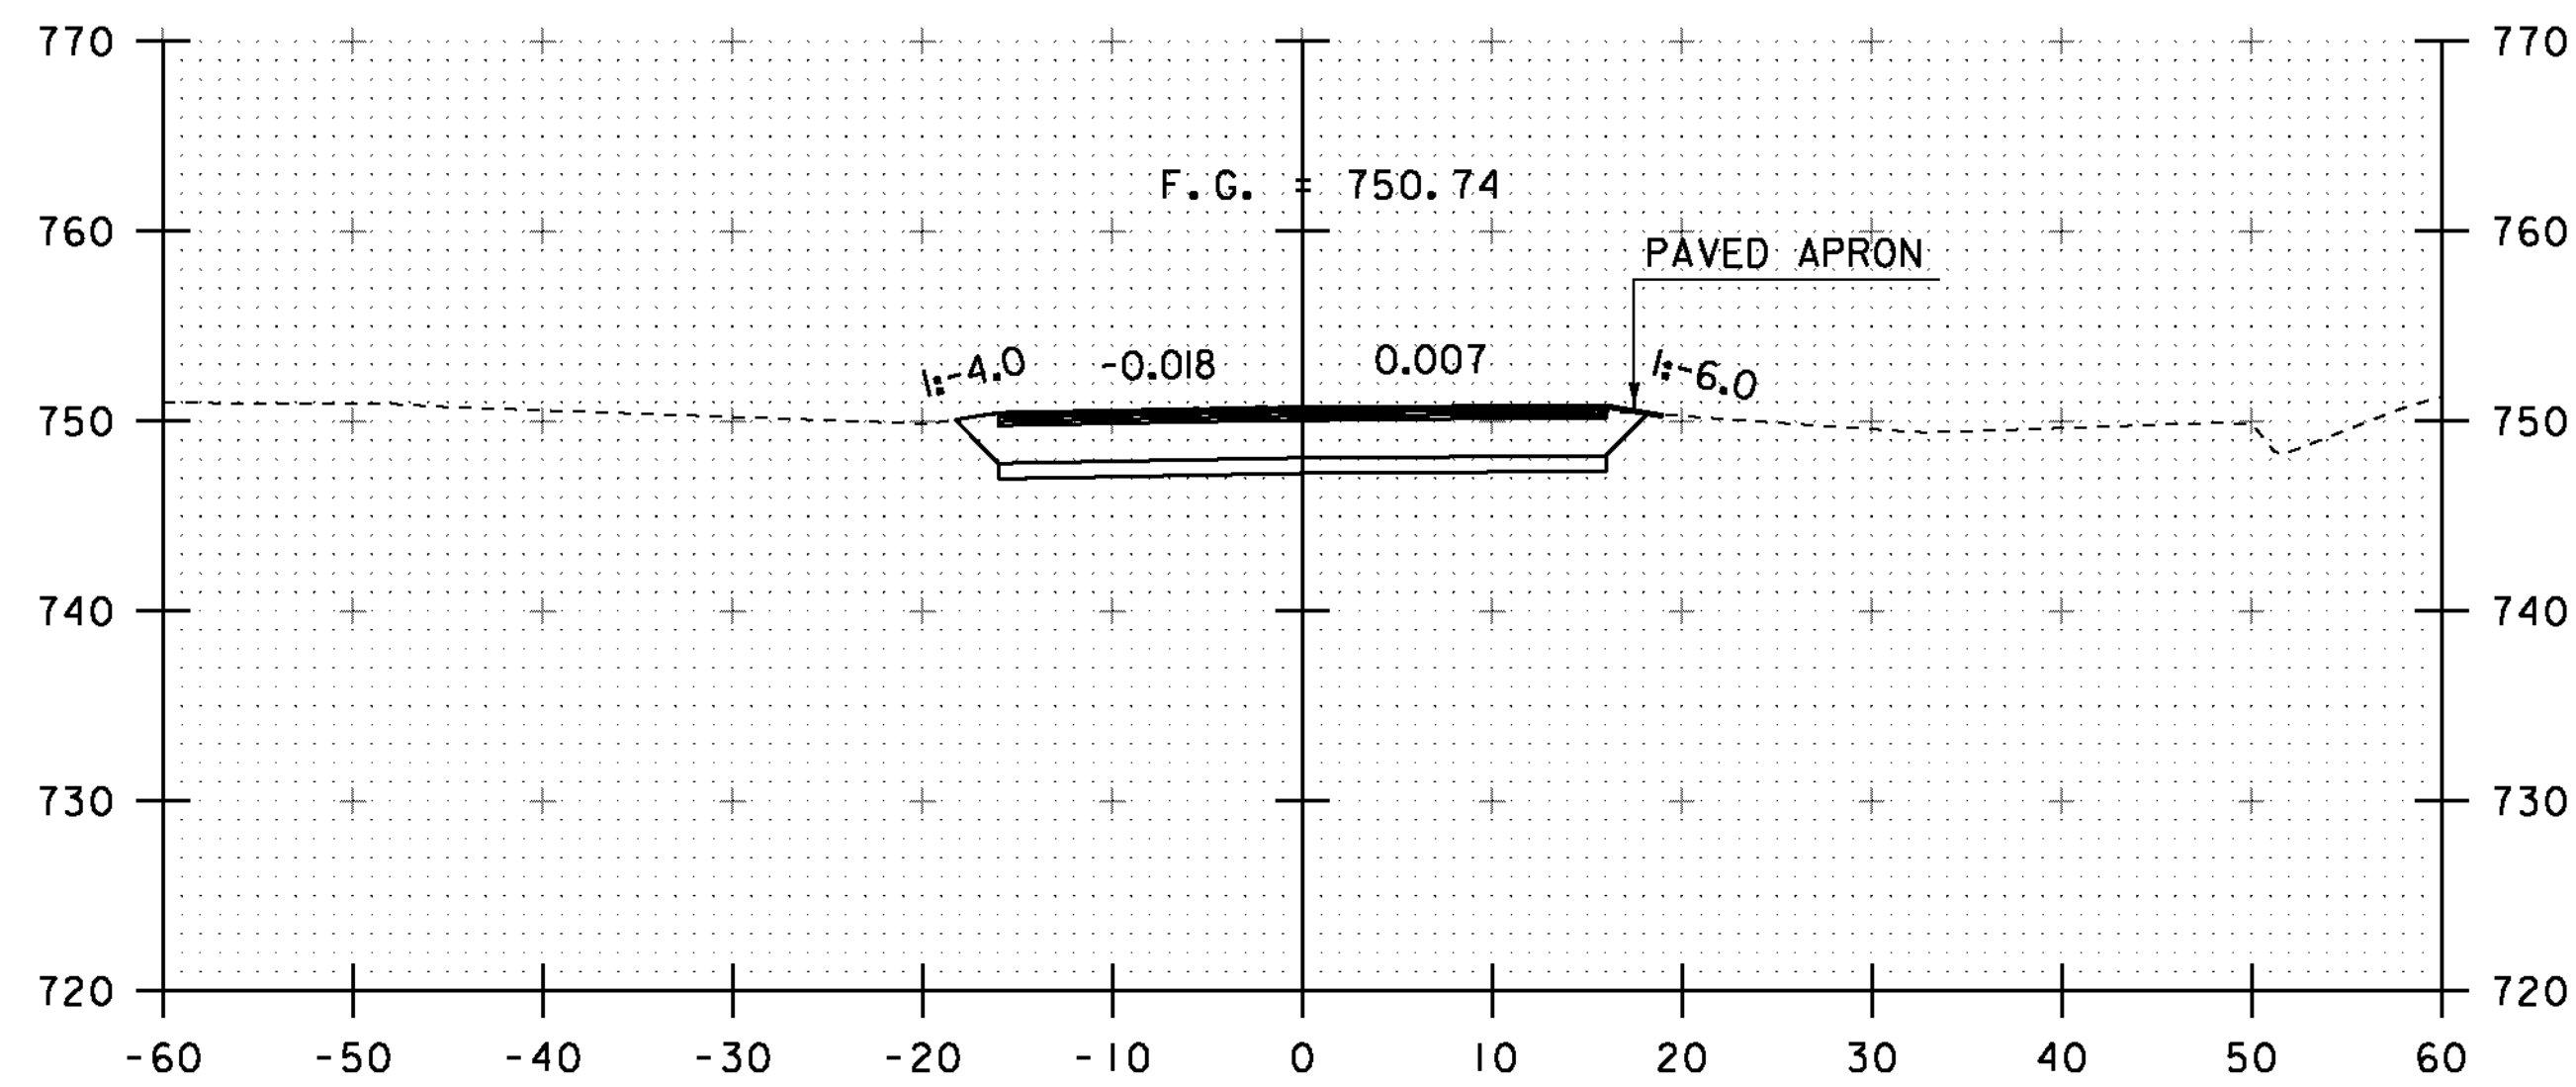


377+50

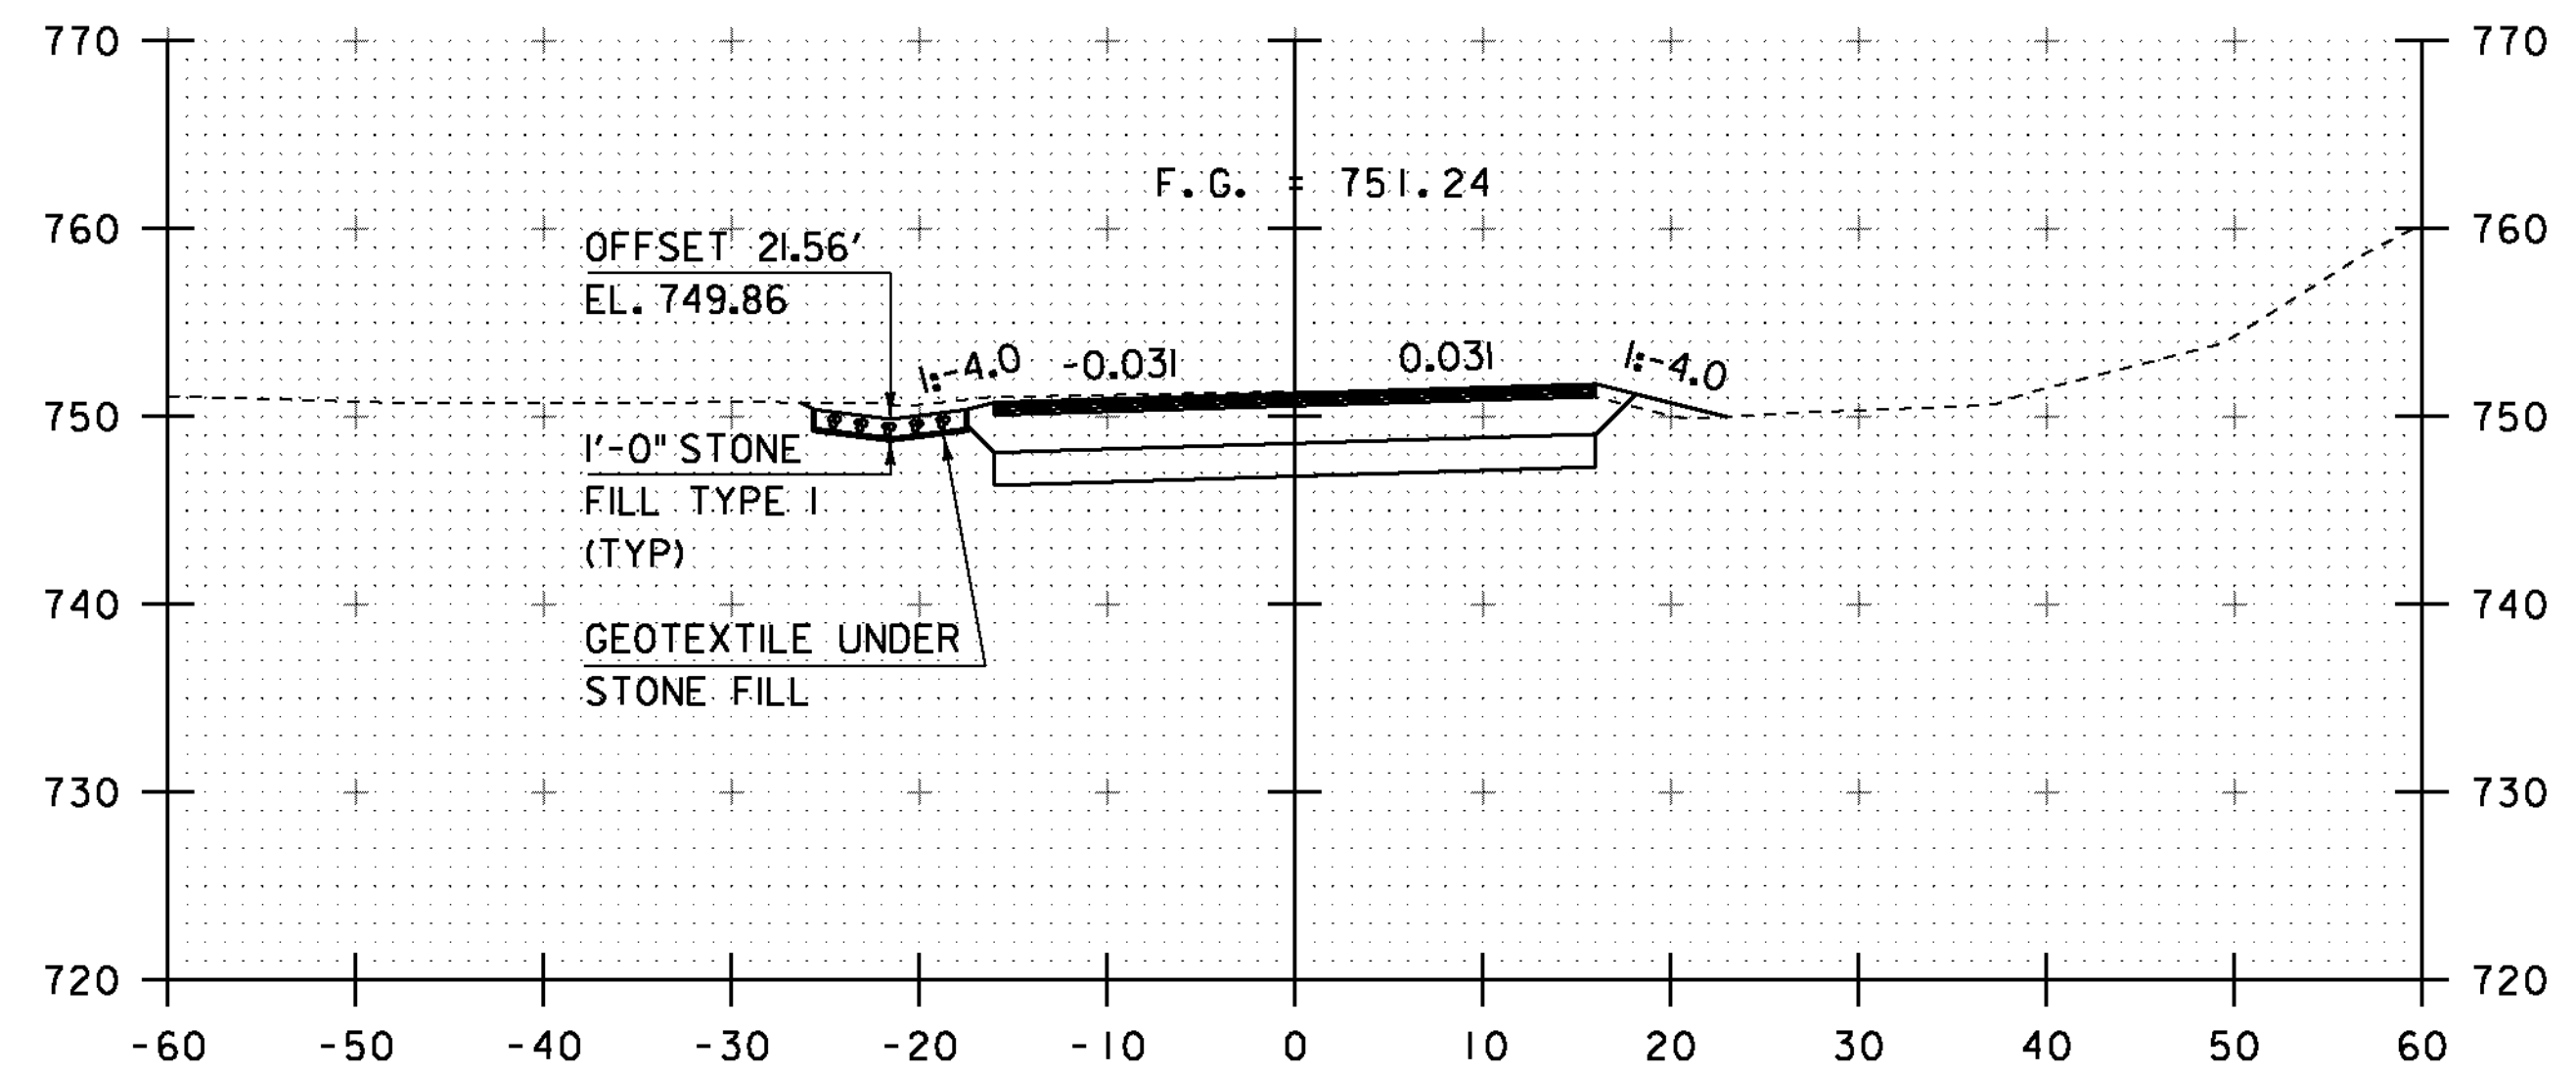

378+00

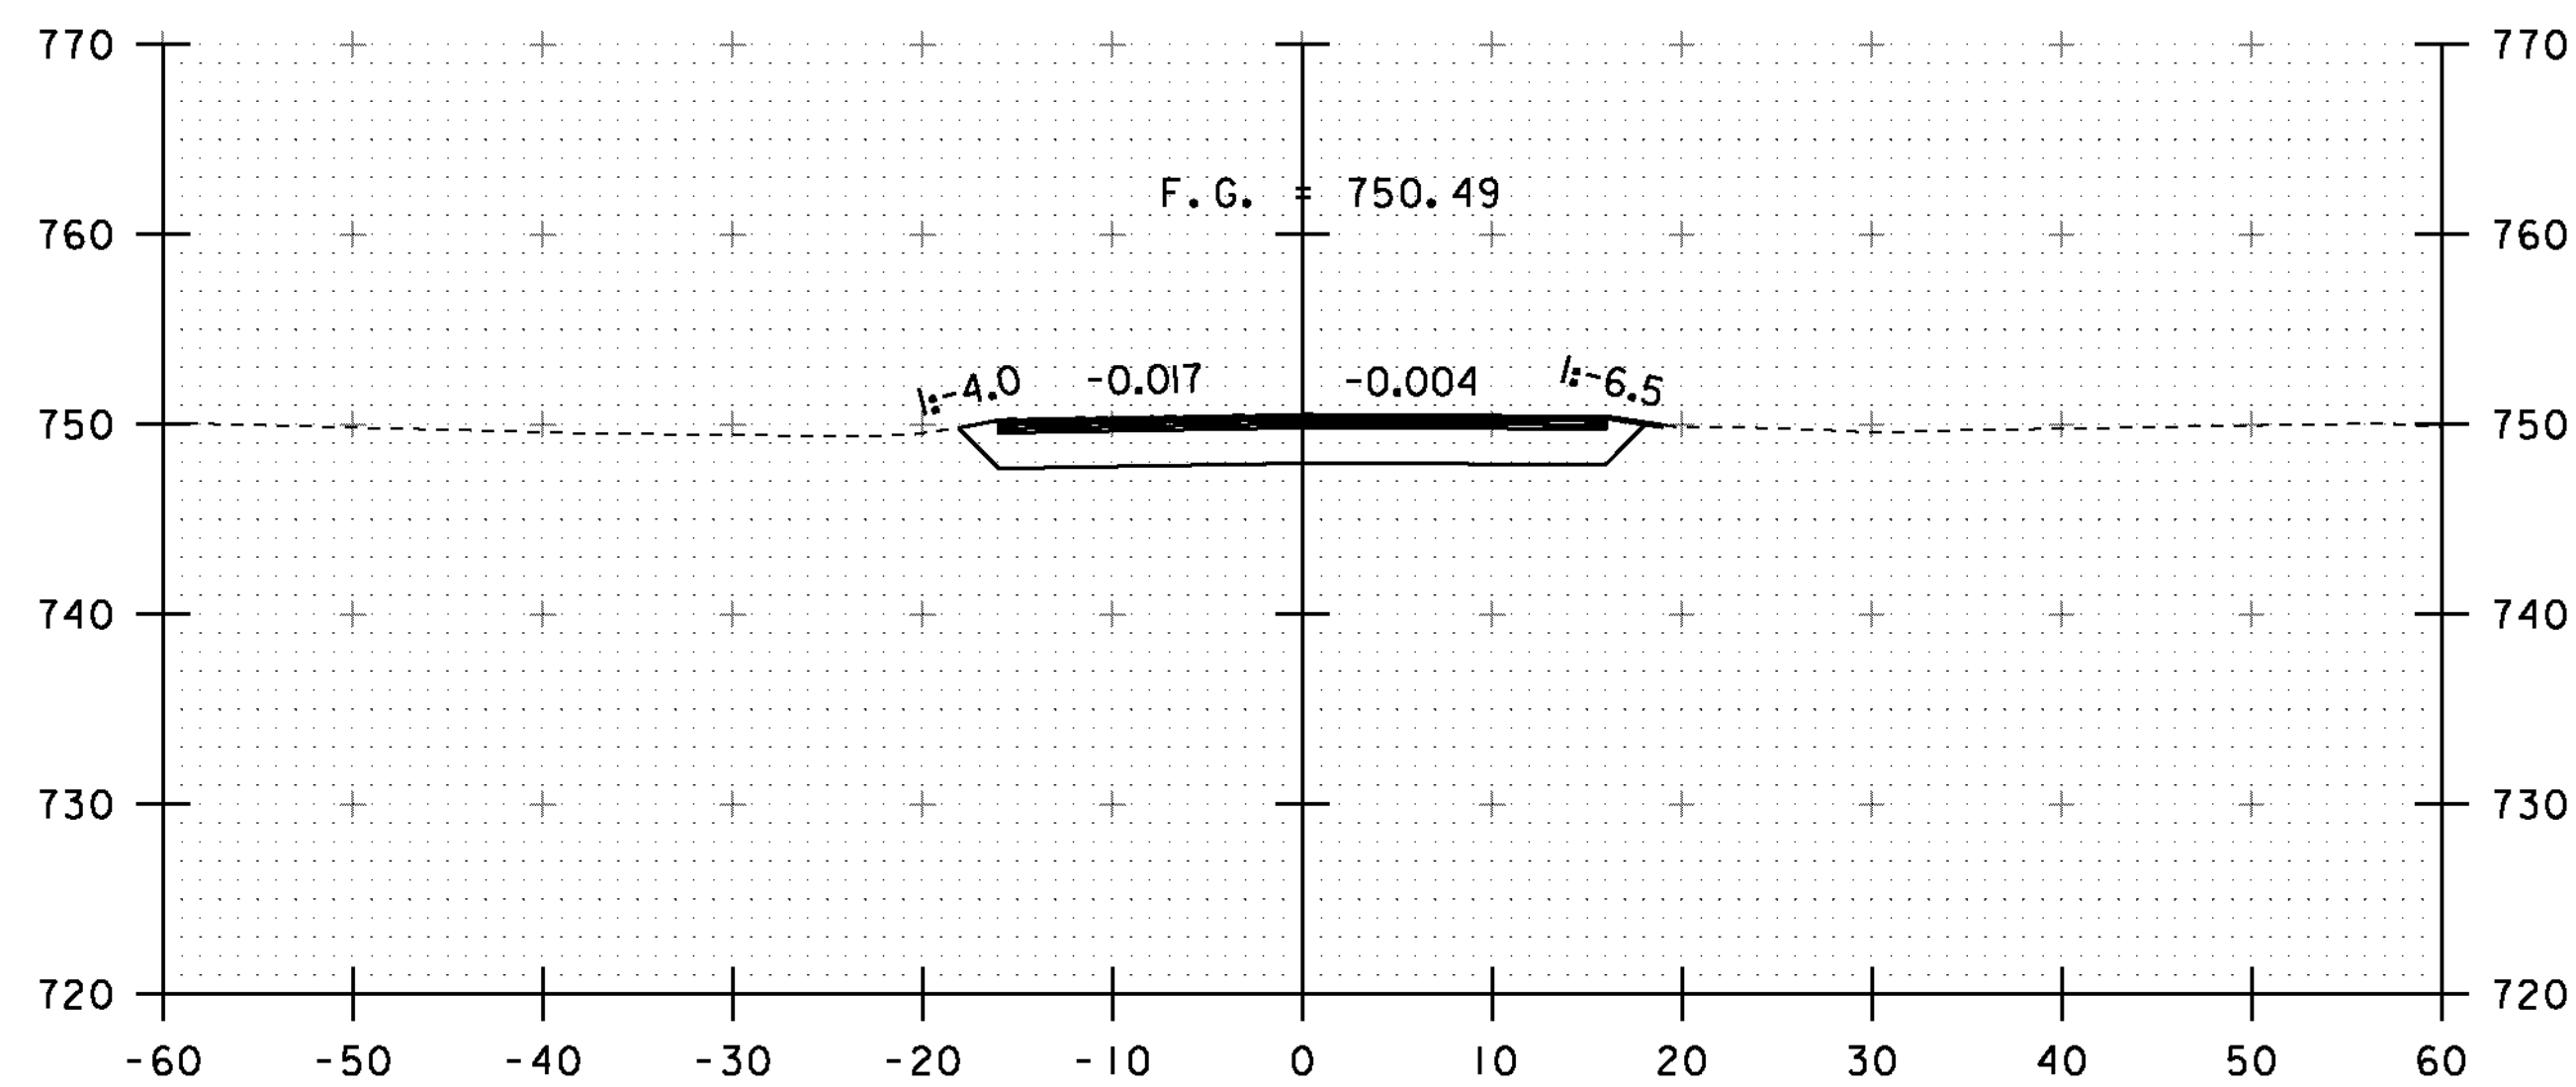

377+25

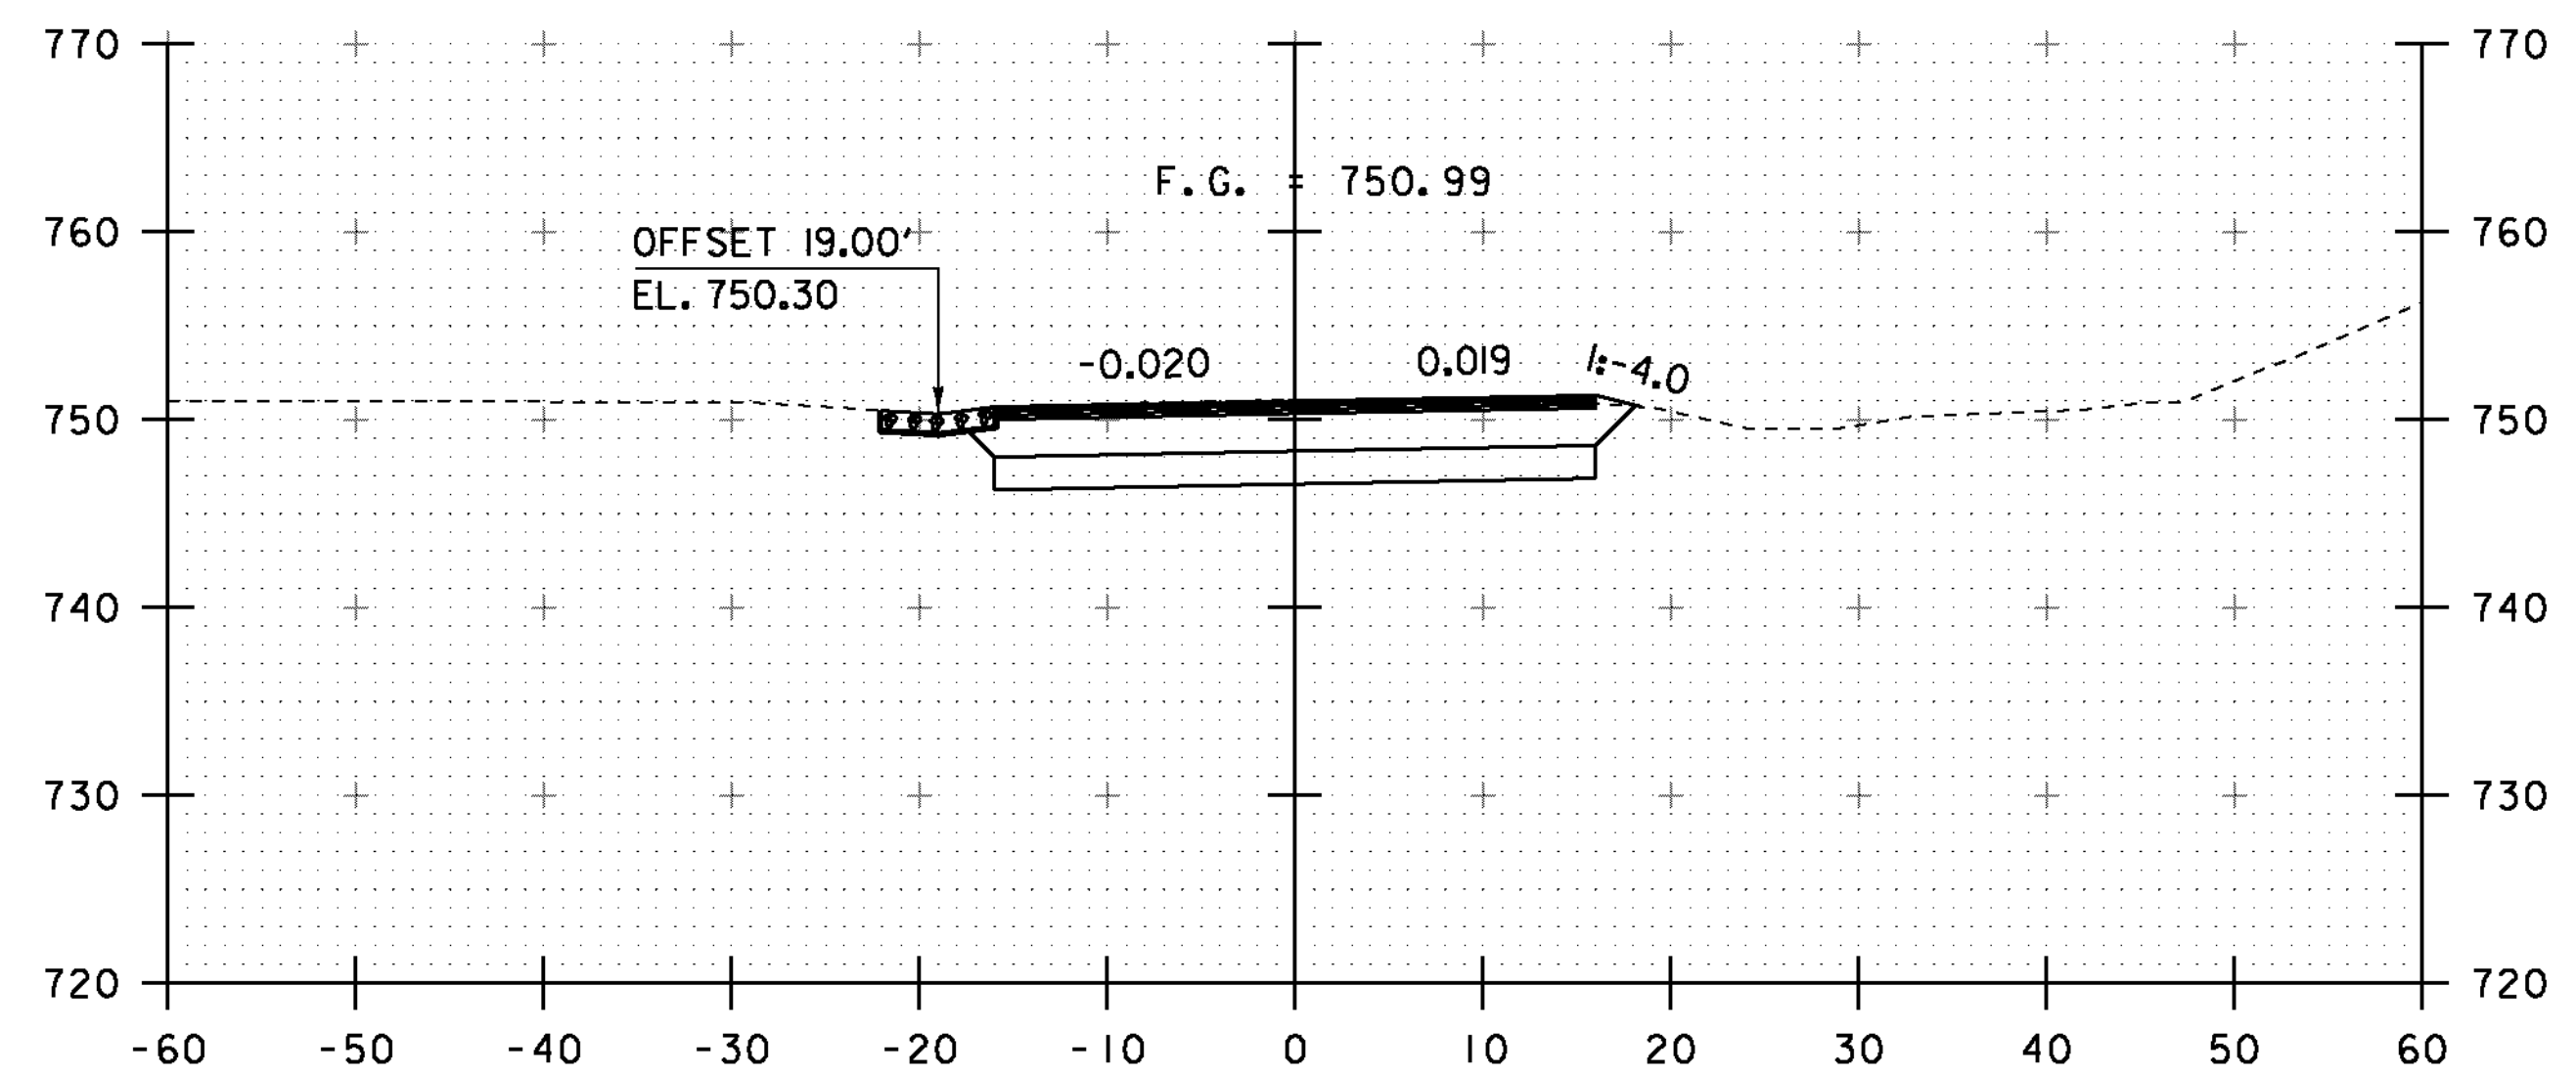

377+75

STA. 377+20 TO STA. 377+60 RT
CONSTRUCT 3'-0" PAVED APRON

STA. 377+75
END APPROACH
BEGIN PROJECT

STA. 377+75 TO STA. 379+42 LT
CONSTRUCT STONE-LINED DITCH, TYPE I


10 0 10
SCALE: 1" = 10'-0"

STA. 377+25 TO STA. 378+00


PROJECT NAME: ST. JOHNSBURY
PROJECT NUMBER: BRF 028-4(25)S

FILE NAME: s98b320xsl.dgn
PROJECT LEADER: C. CARLSON
DESIGNED BY: H. SALLS
ROADWAY CROSS SECTIONS 2

PLOT DATE: 28-AUG-2012
DRAWN BY: C. MOONEY
CHECKED BY: C. CARLSON
SHEET 32 OF 62

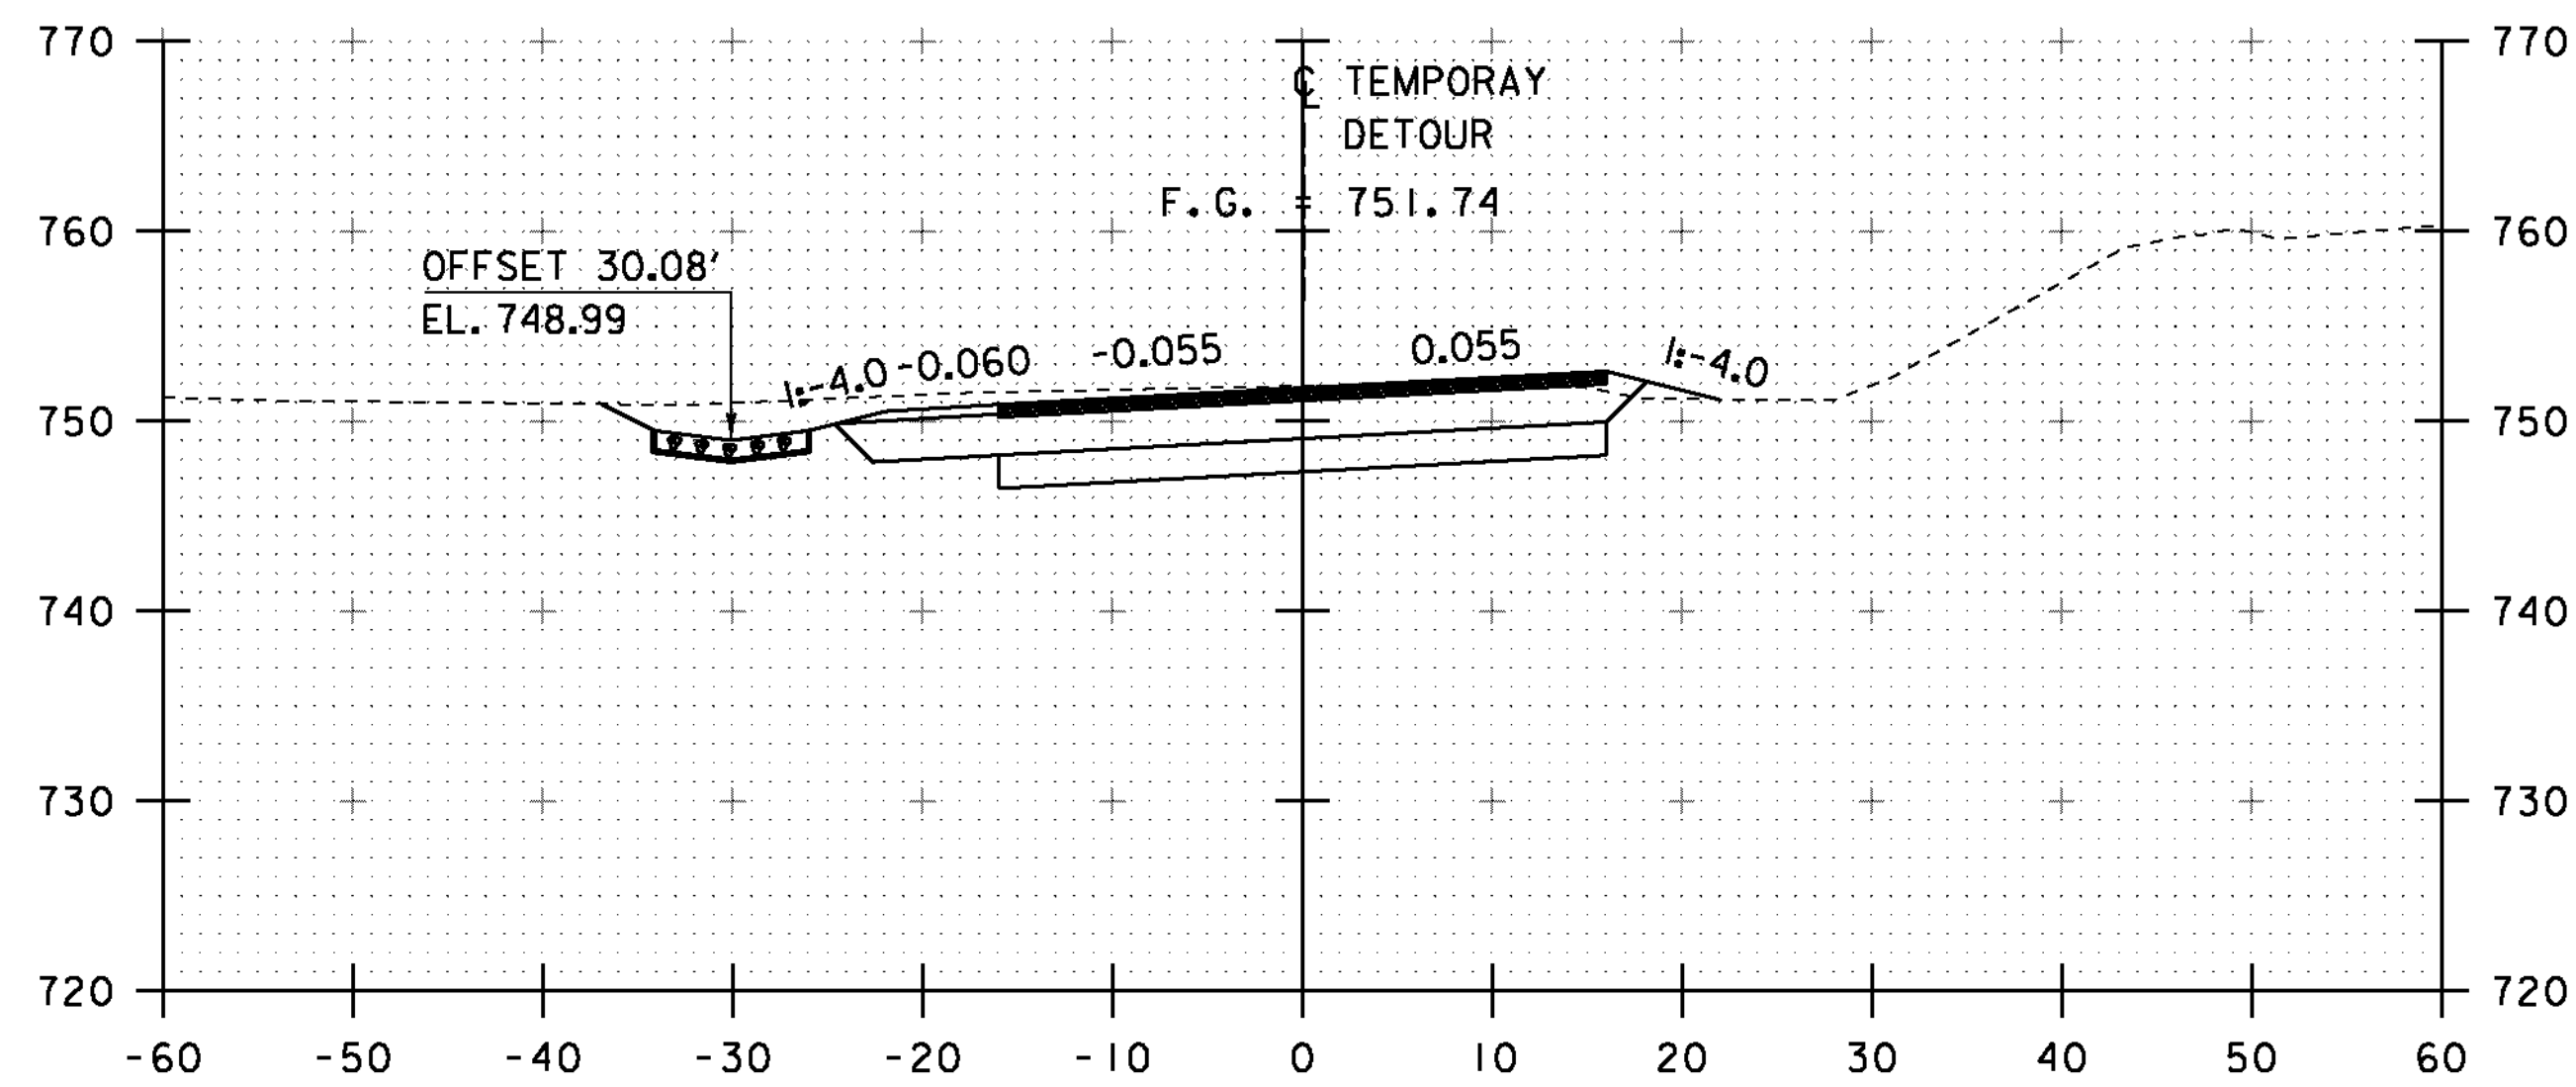


378+50

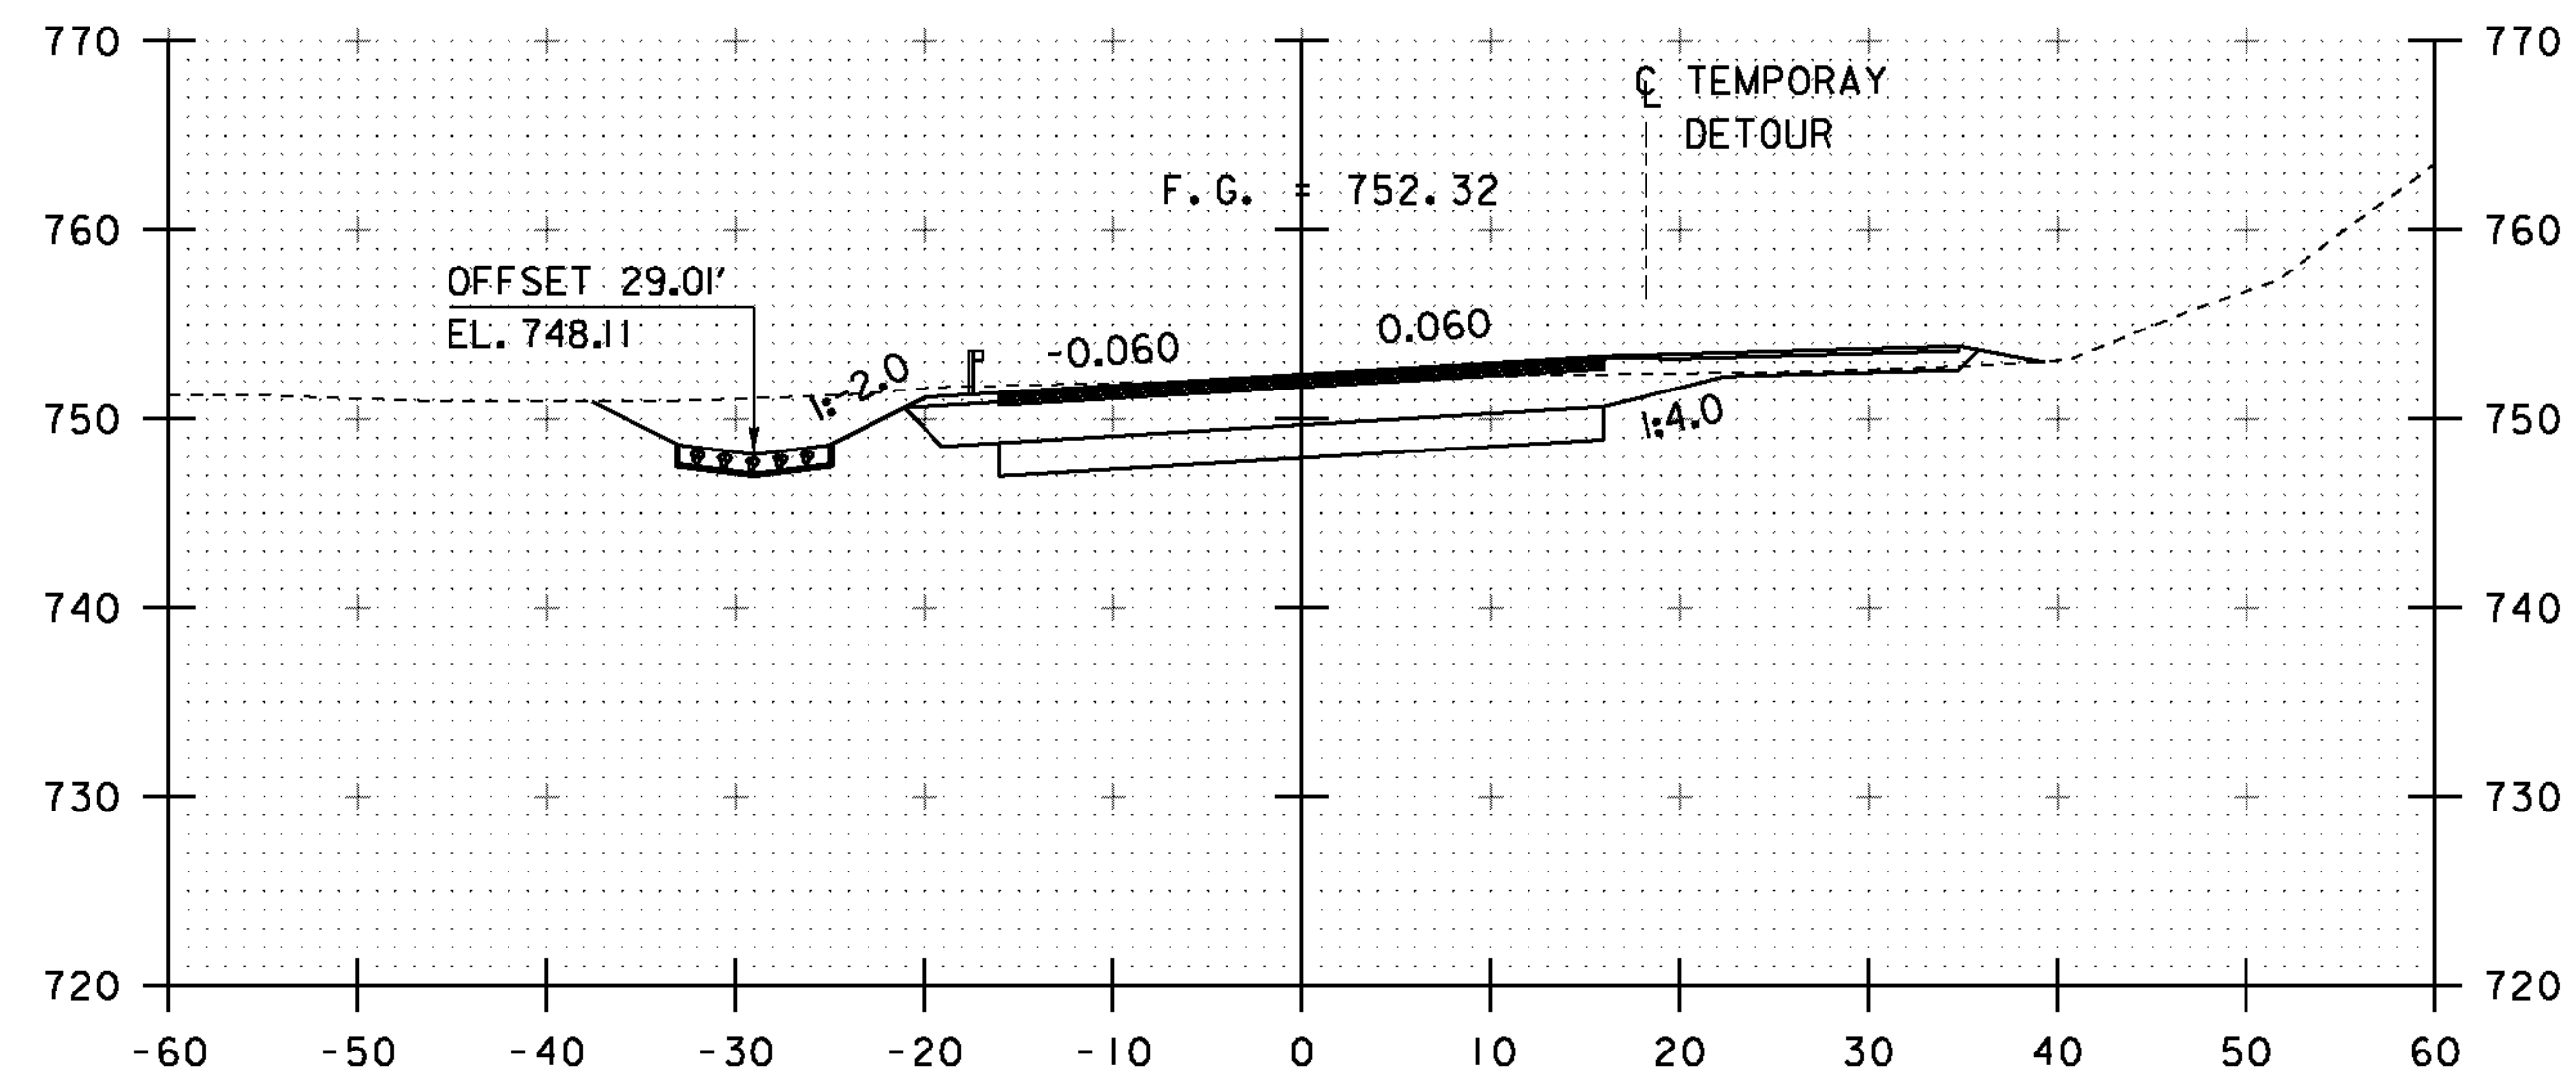


379+00


STA. 378+88 TO 379+20 RT
CONSTRUCT 3'-0" PAVED APRON

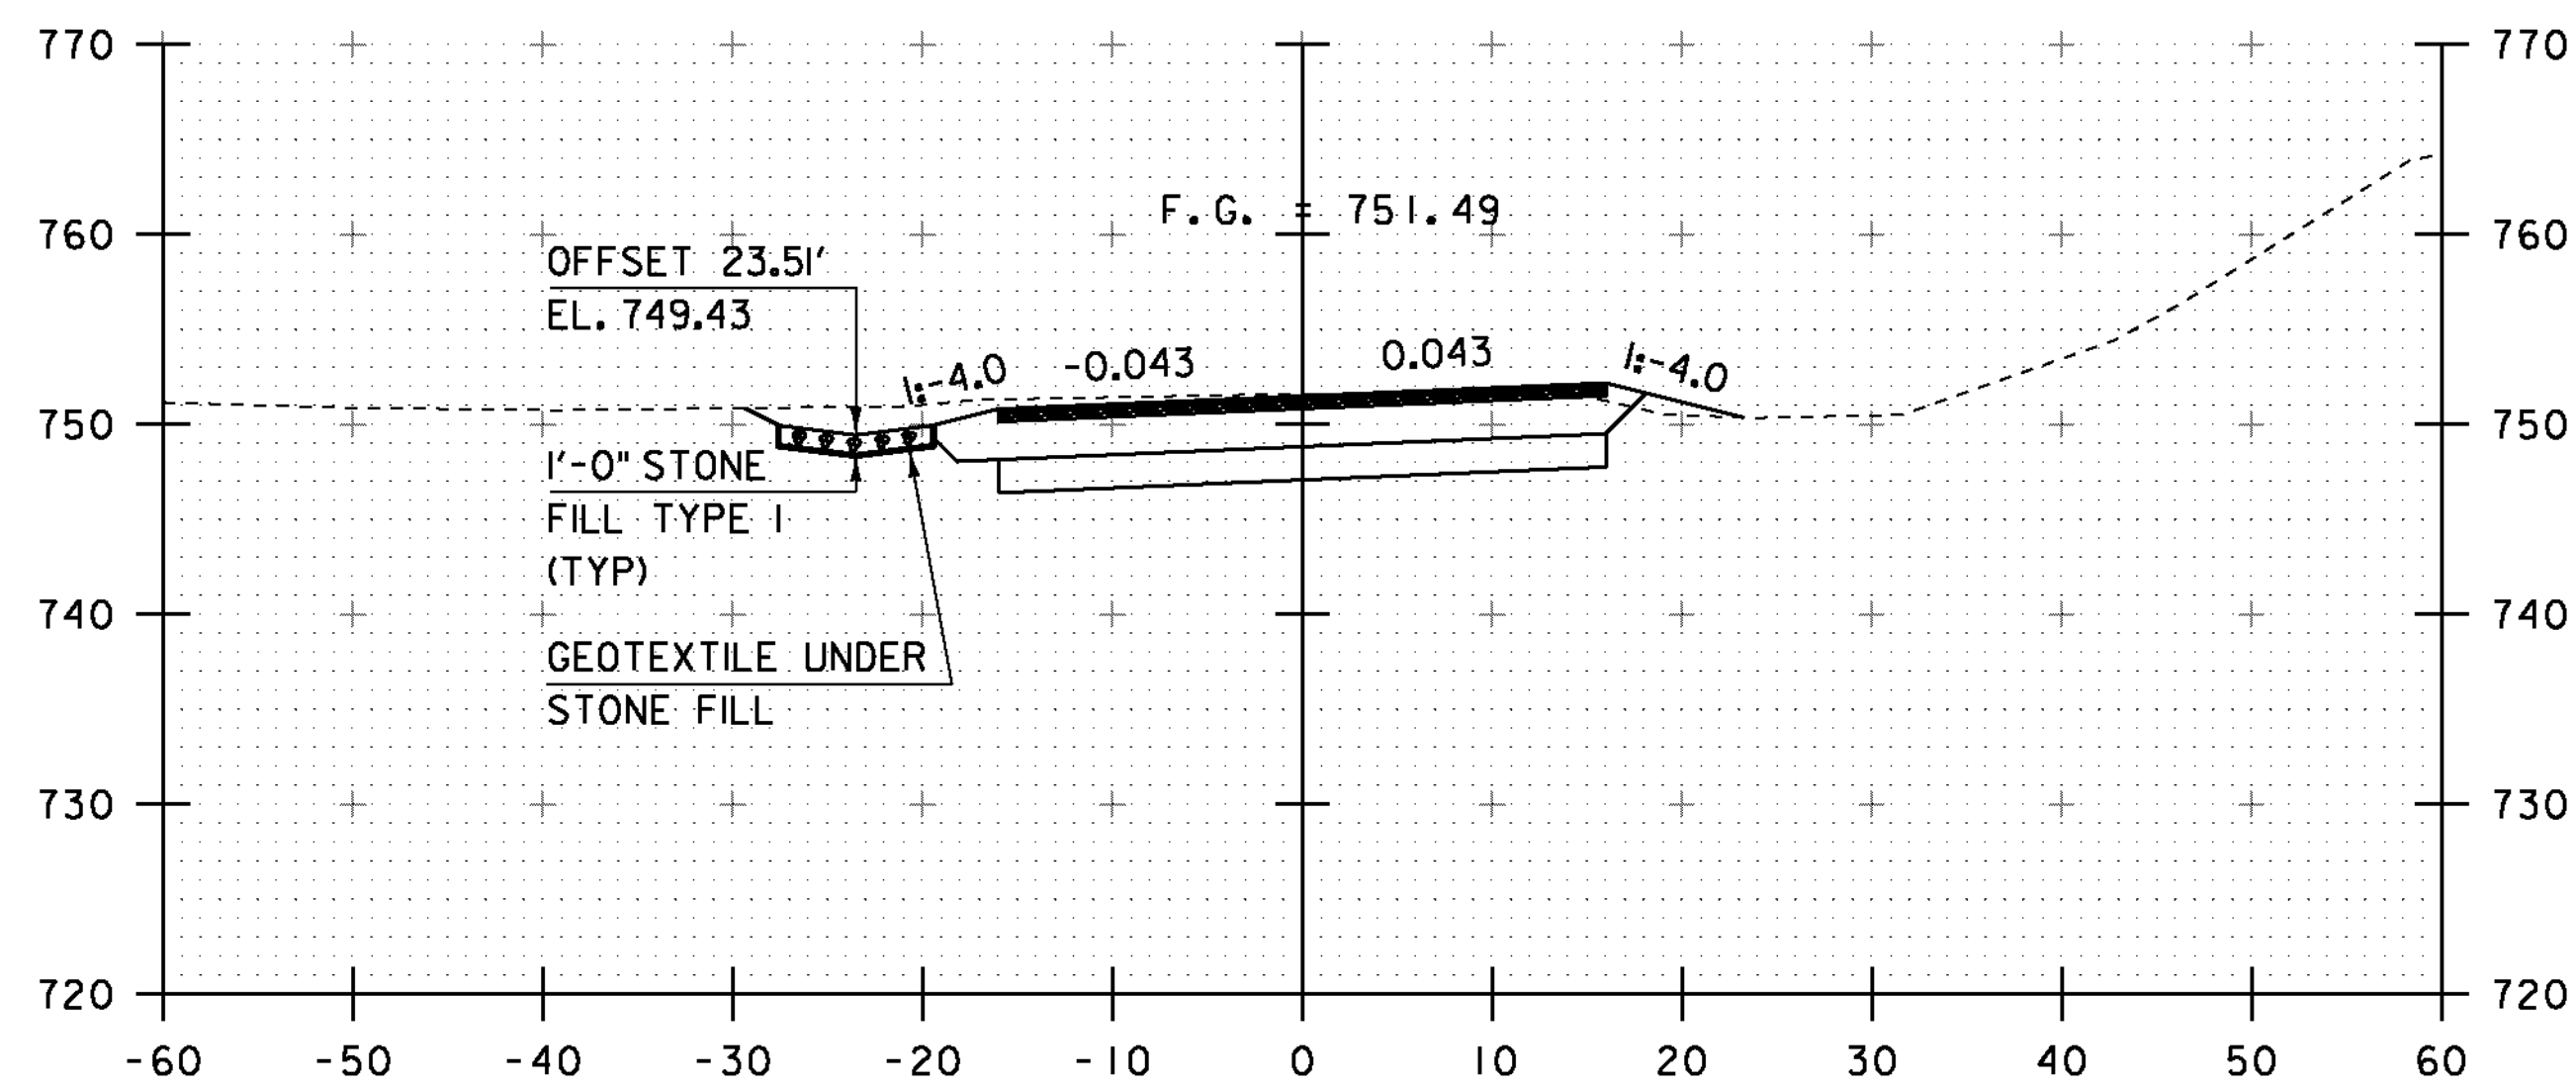


378+25

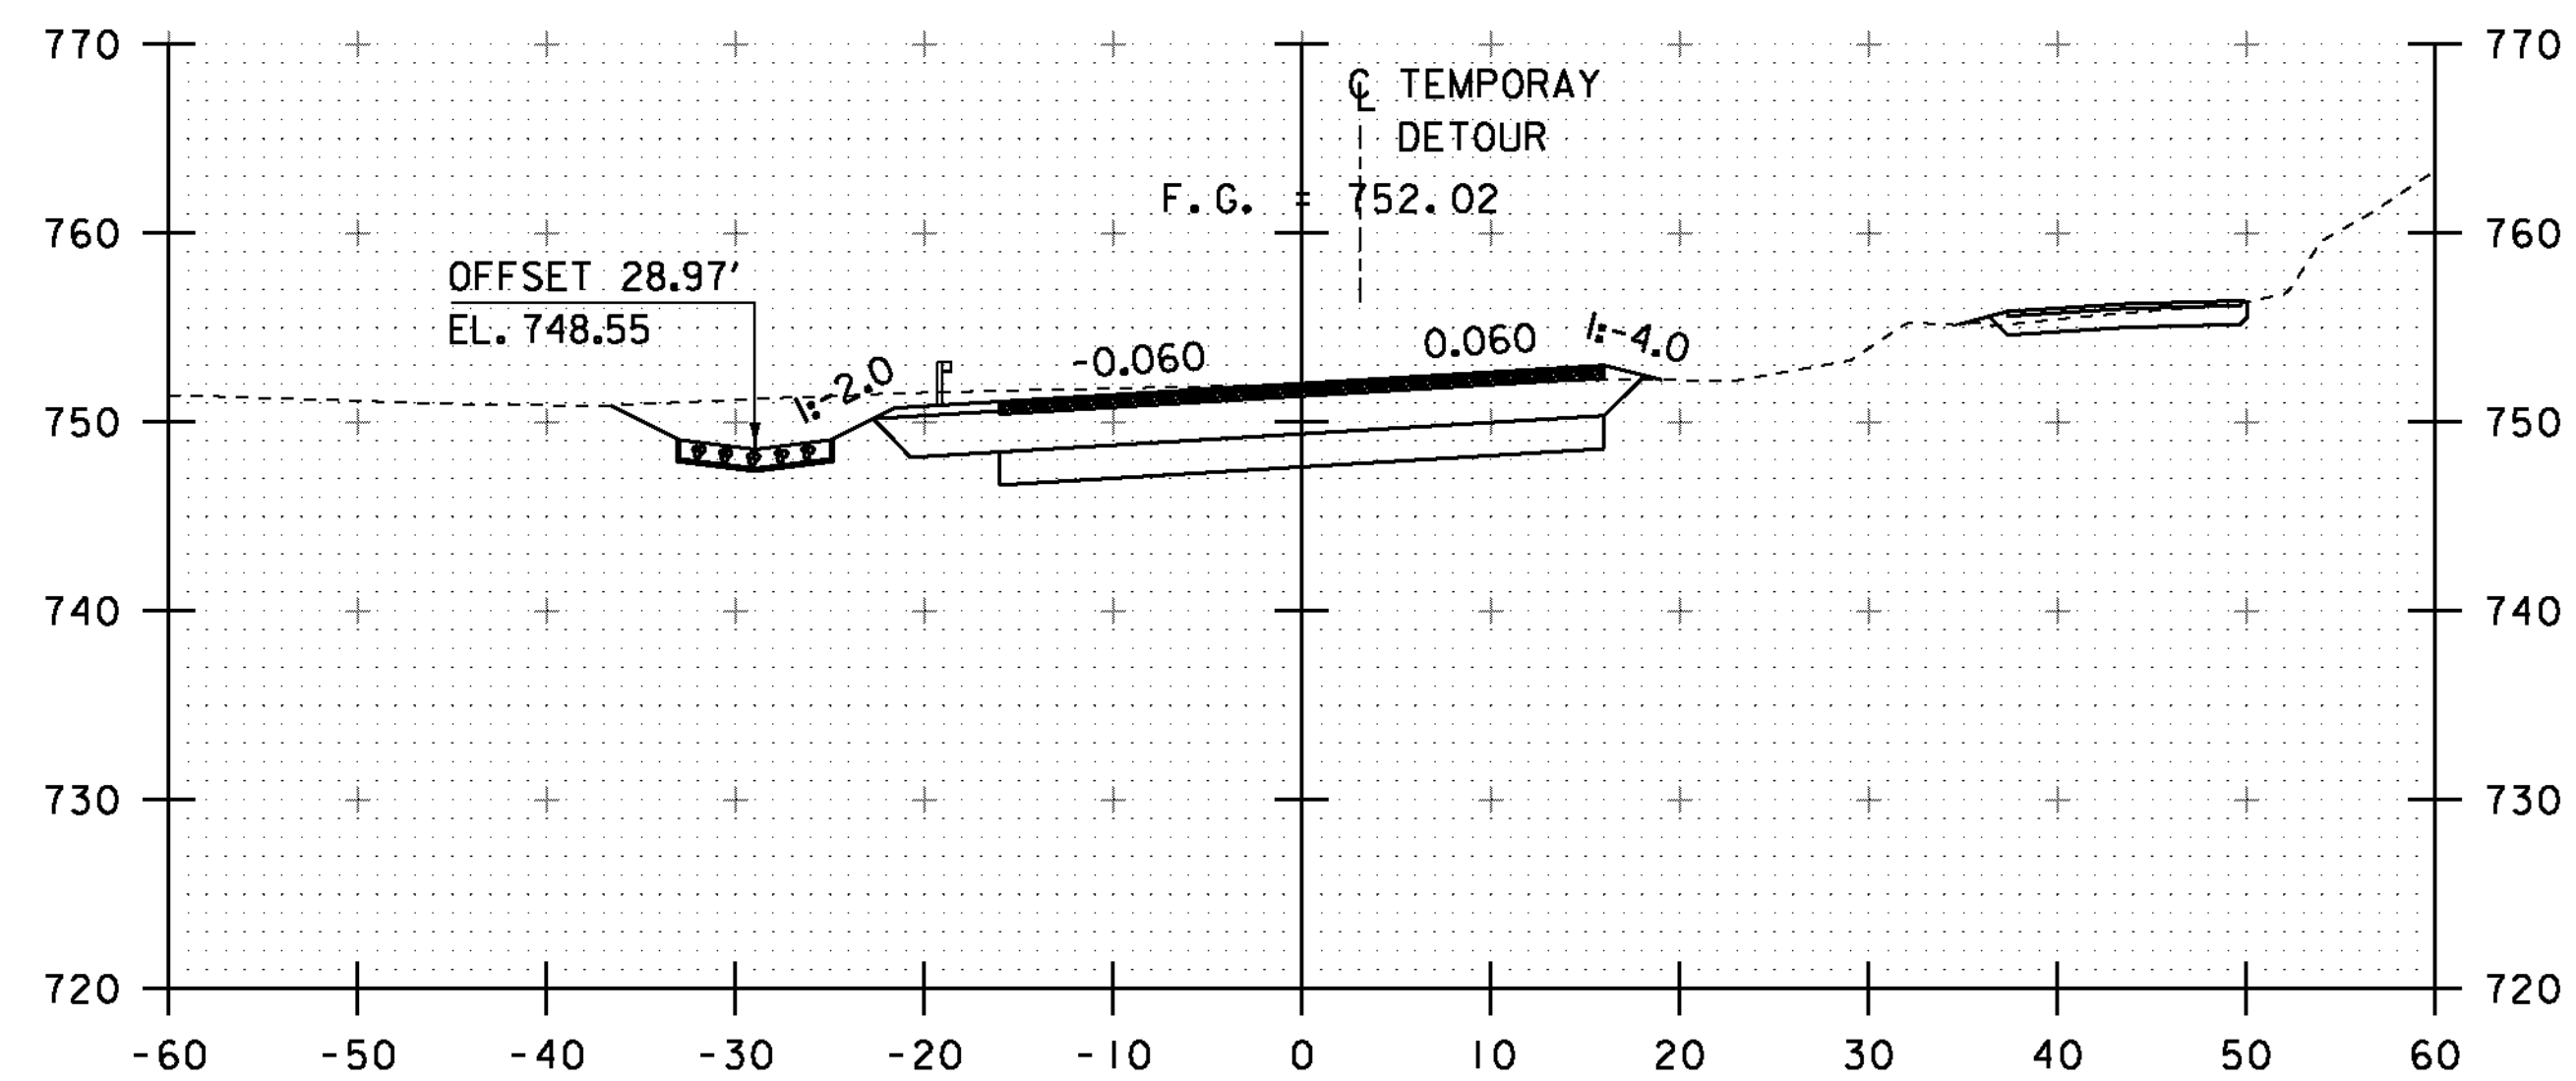


378+75

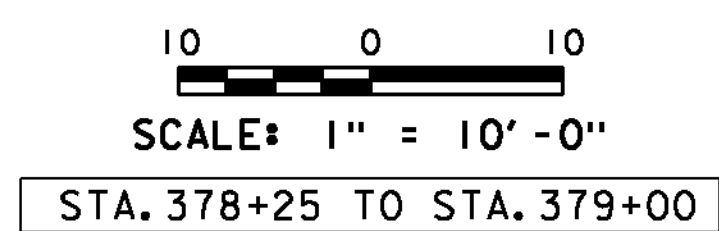


PROJECT NAME:	ST. JOHNSBURY	PLOT DATE:	28-AUG-2012
PROJECT NUMBER:	BRF 028-4(25)S	DRAWN BY:	C. MOONEY
FILE NAME:	s98b320xsl.dgn	CHECKED BY:	C. CARLSON
PROJECT LEADER:	C. CARLSON	ROADWAY CROSS SECTIONS	3
DESIGNED BY:	H. SALLS	SHEET	33 OF 62

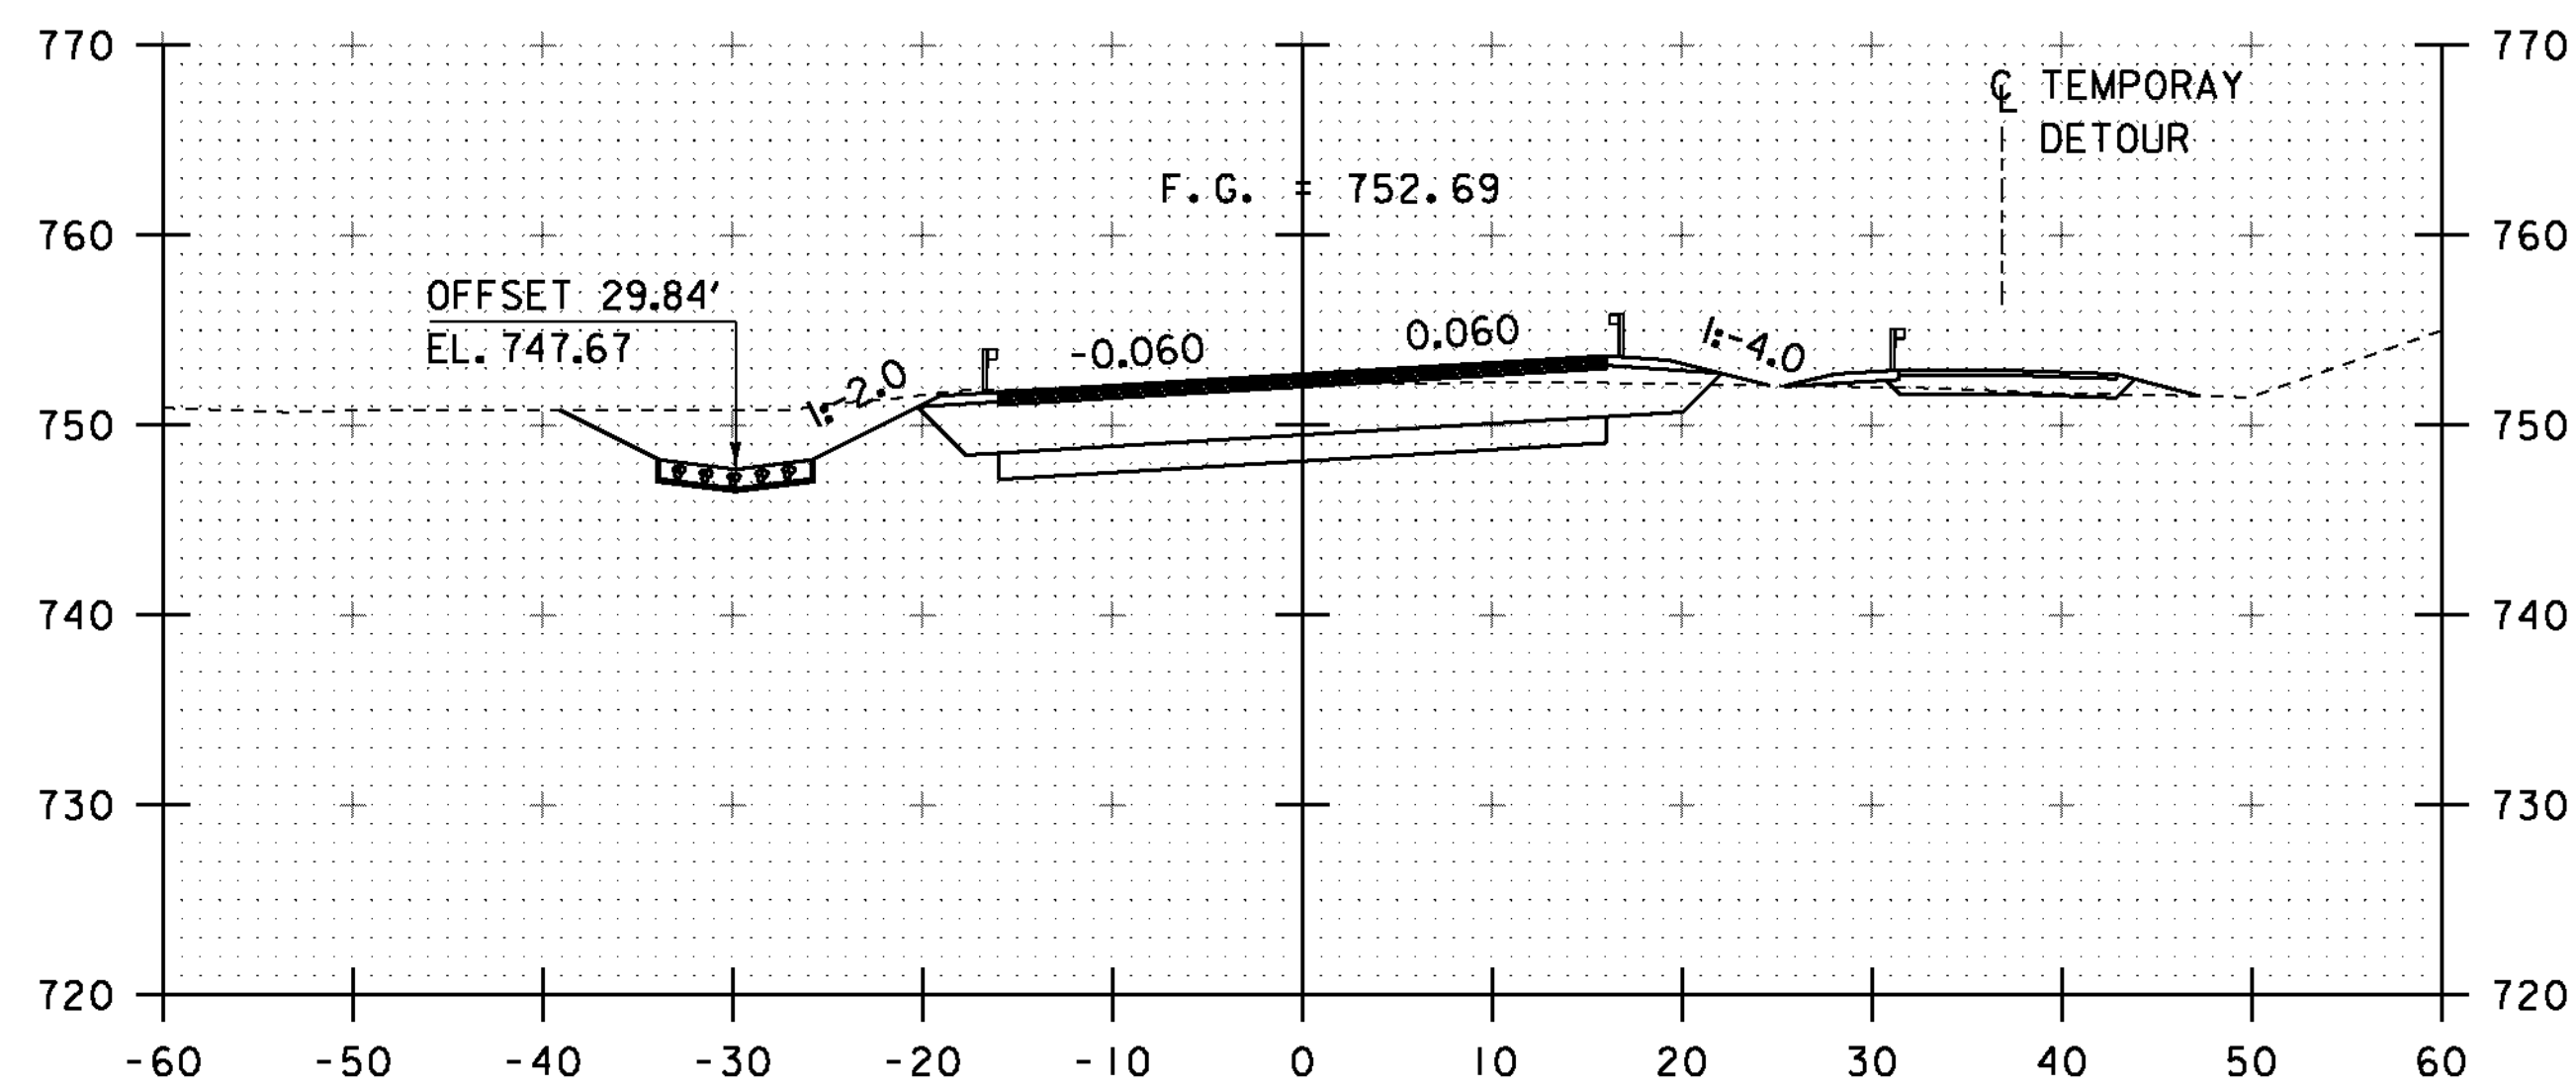


379+25

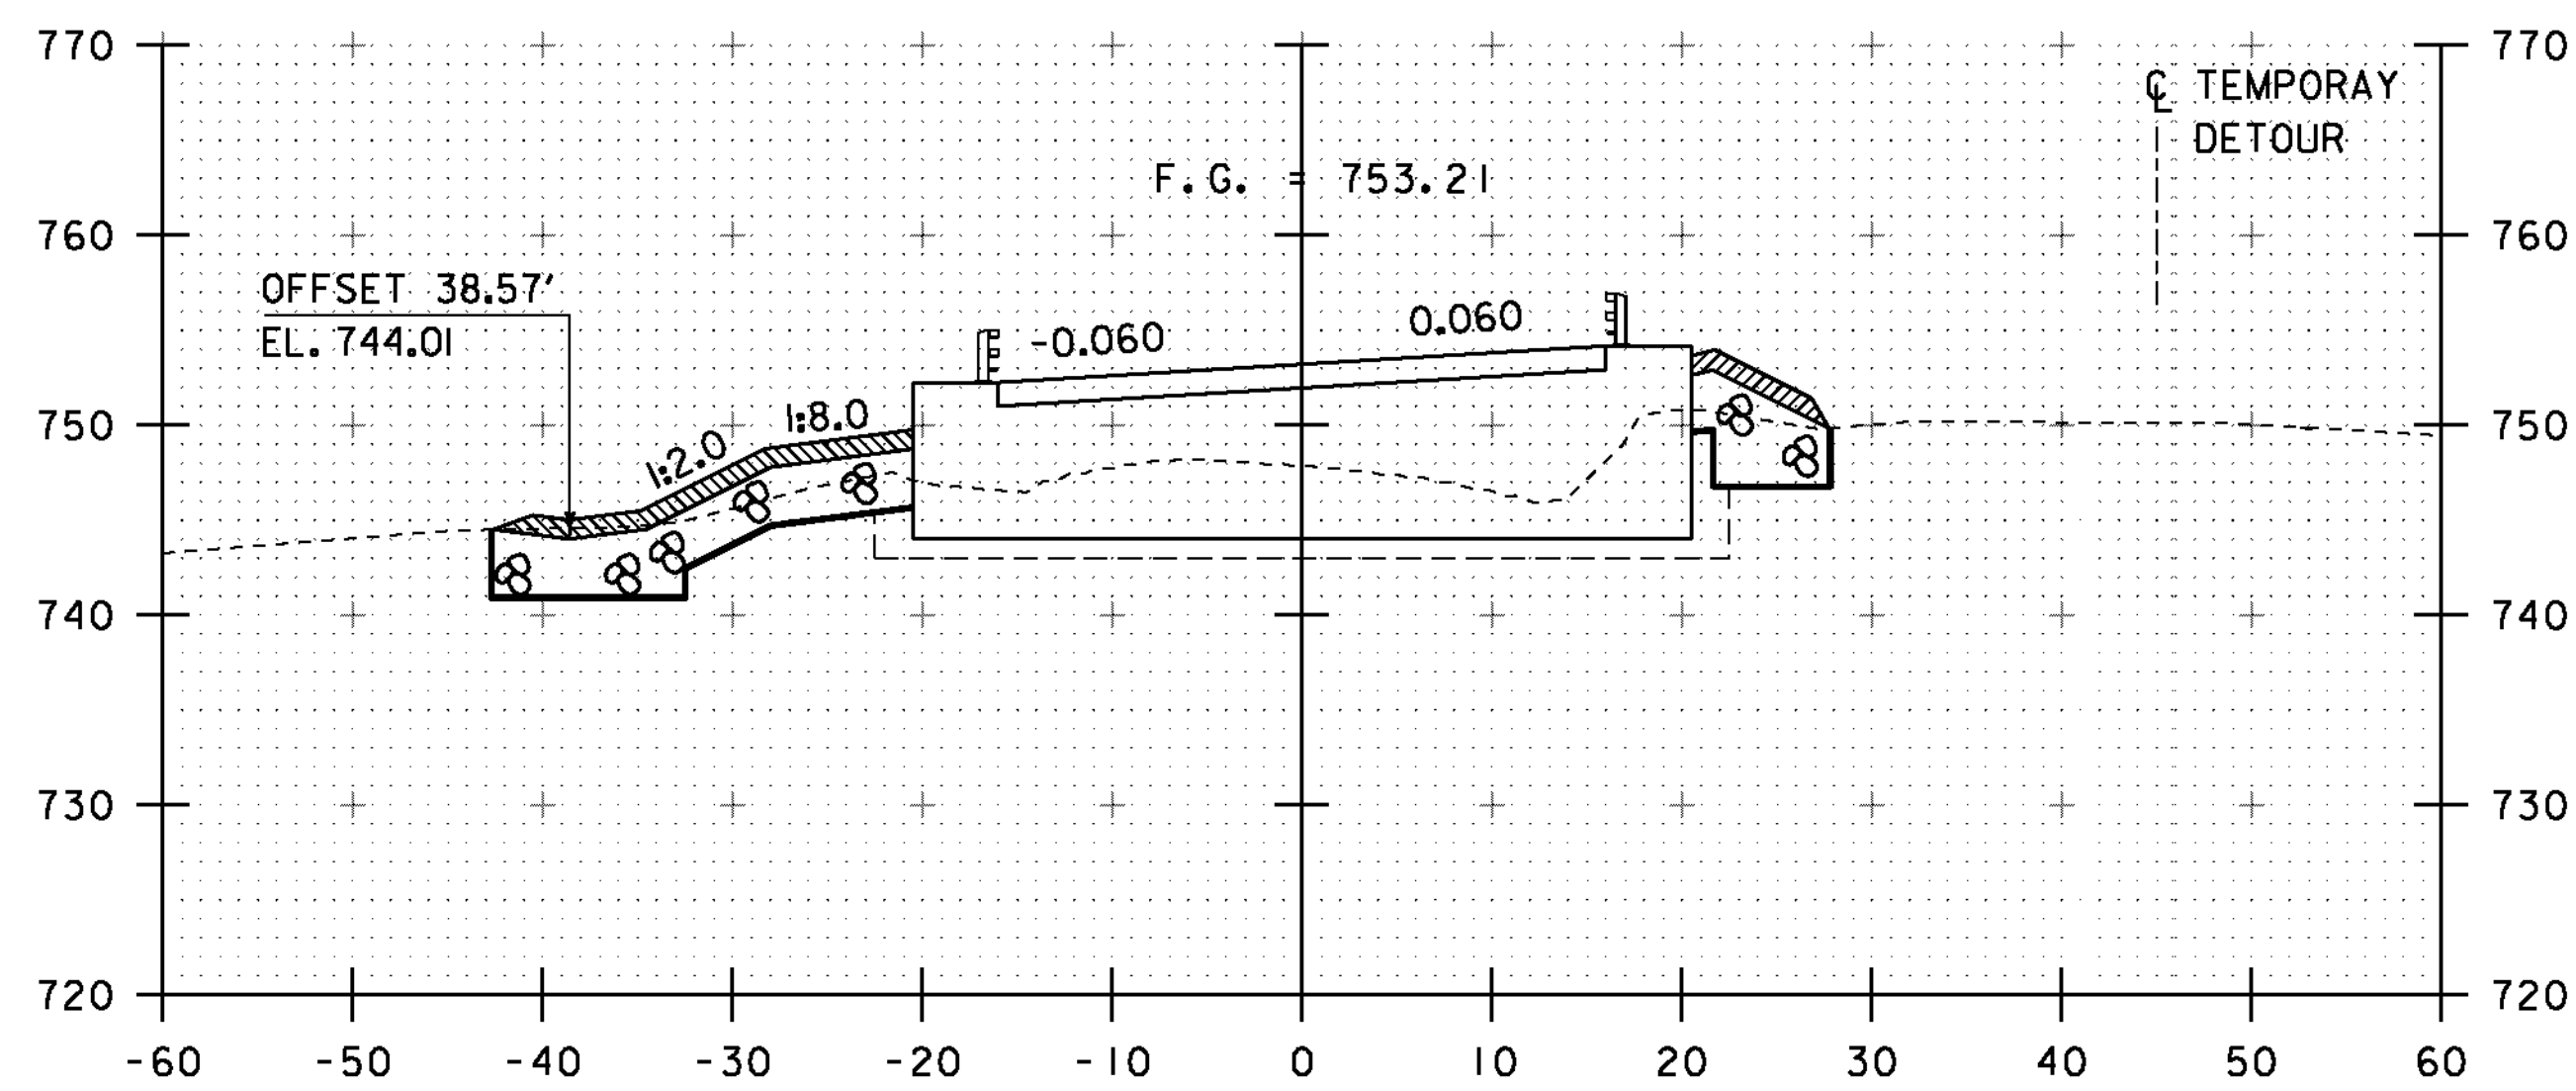


379+62

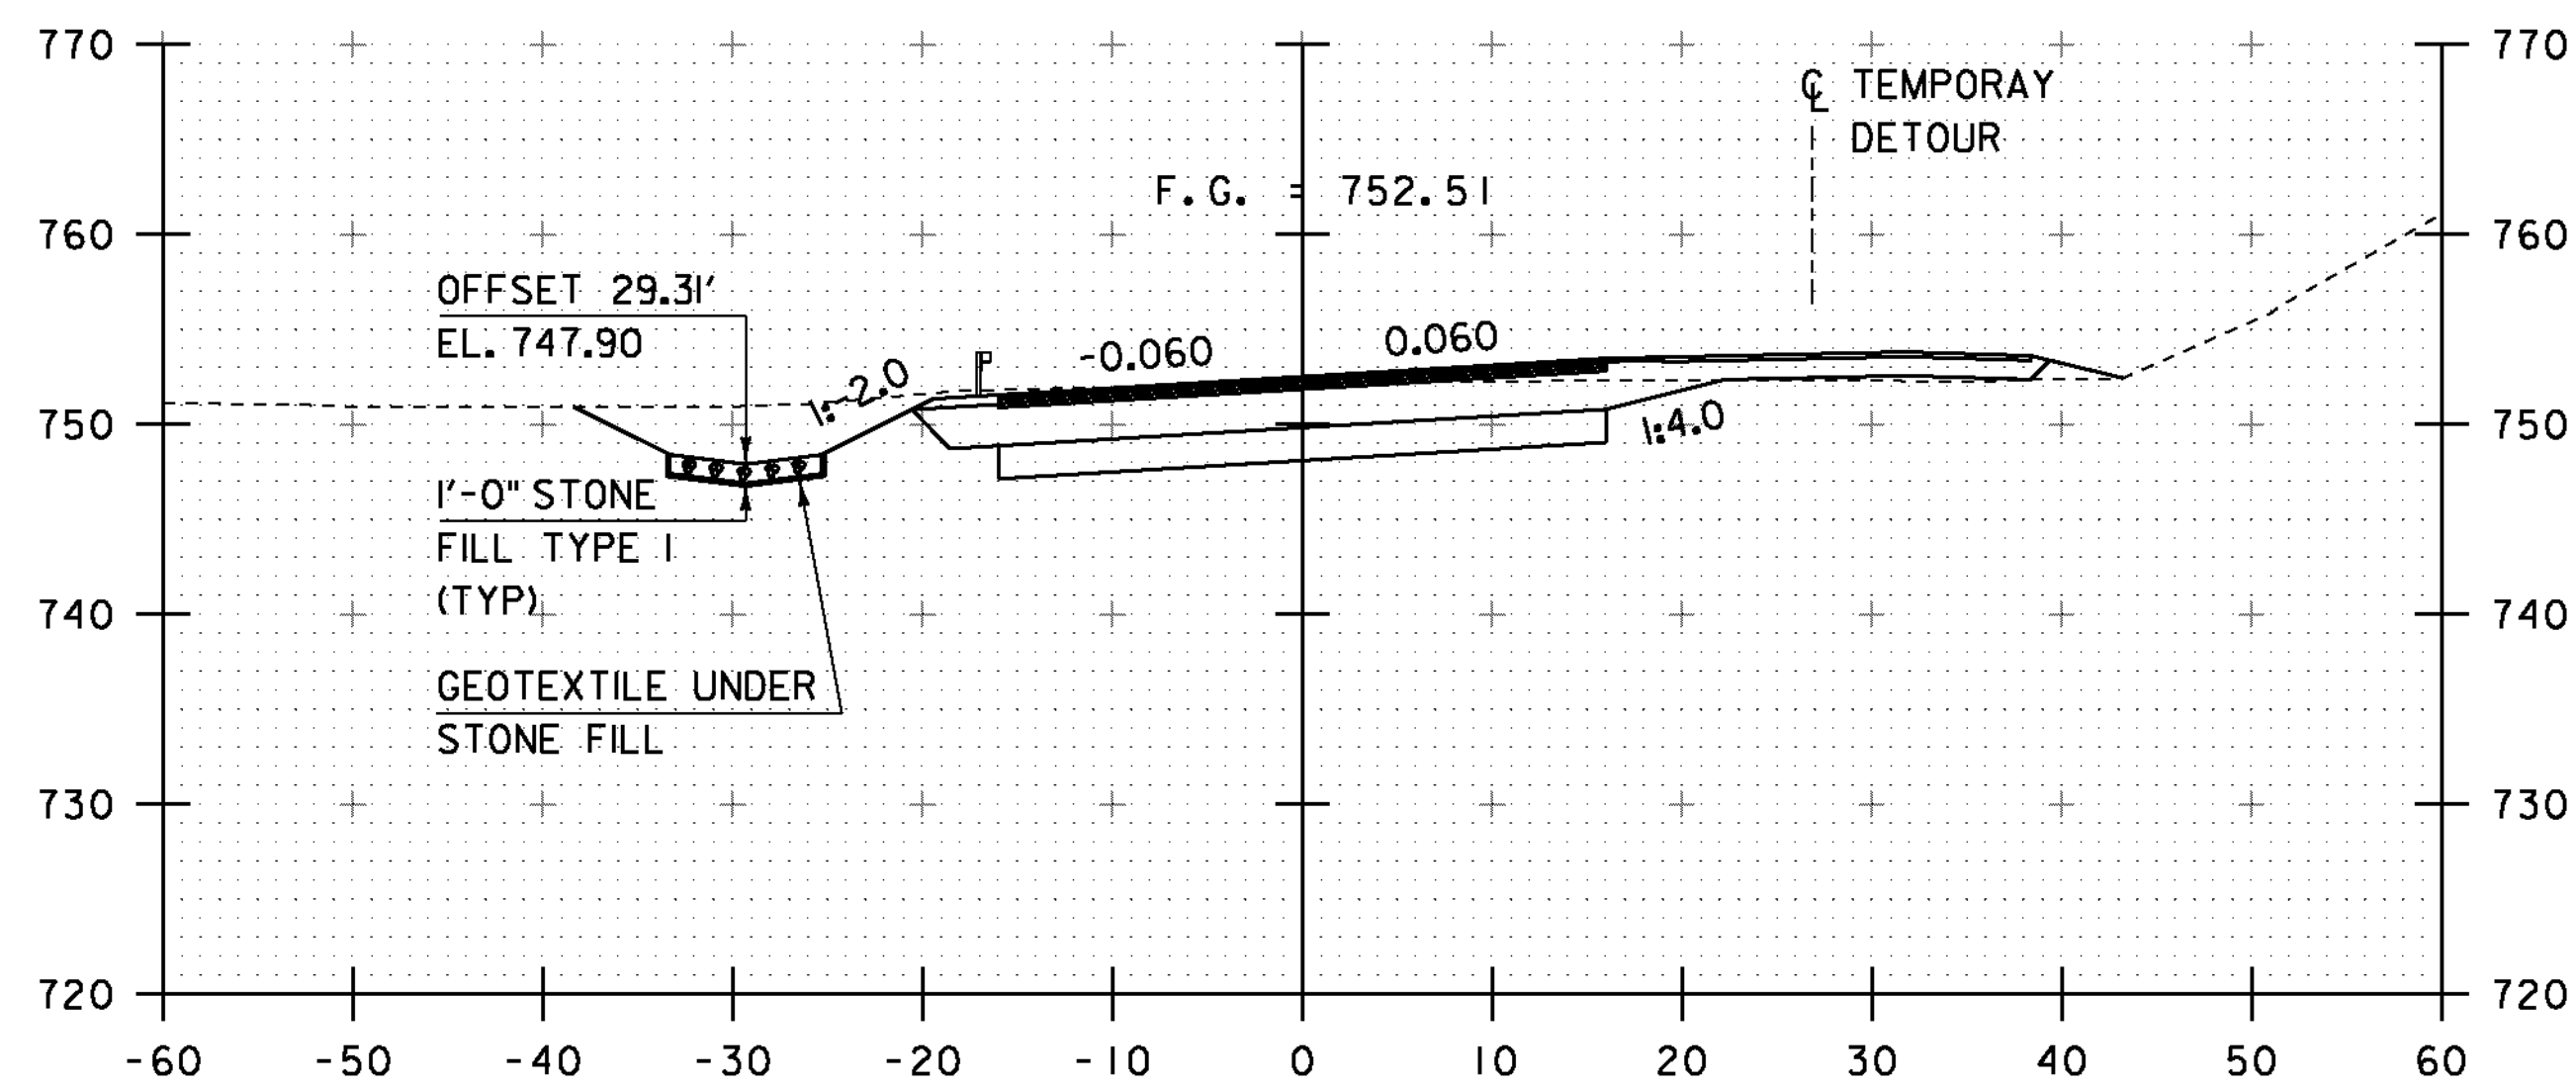


379+12

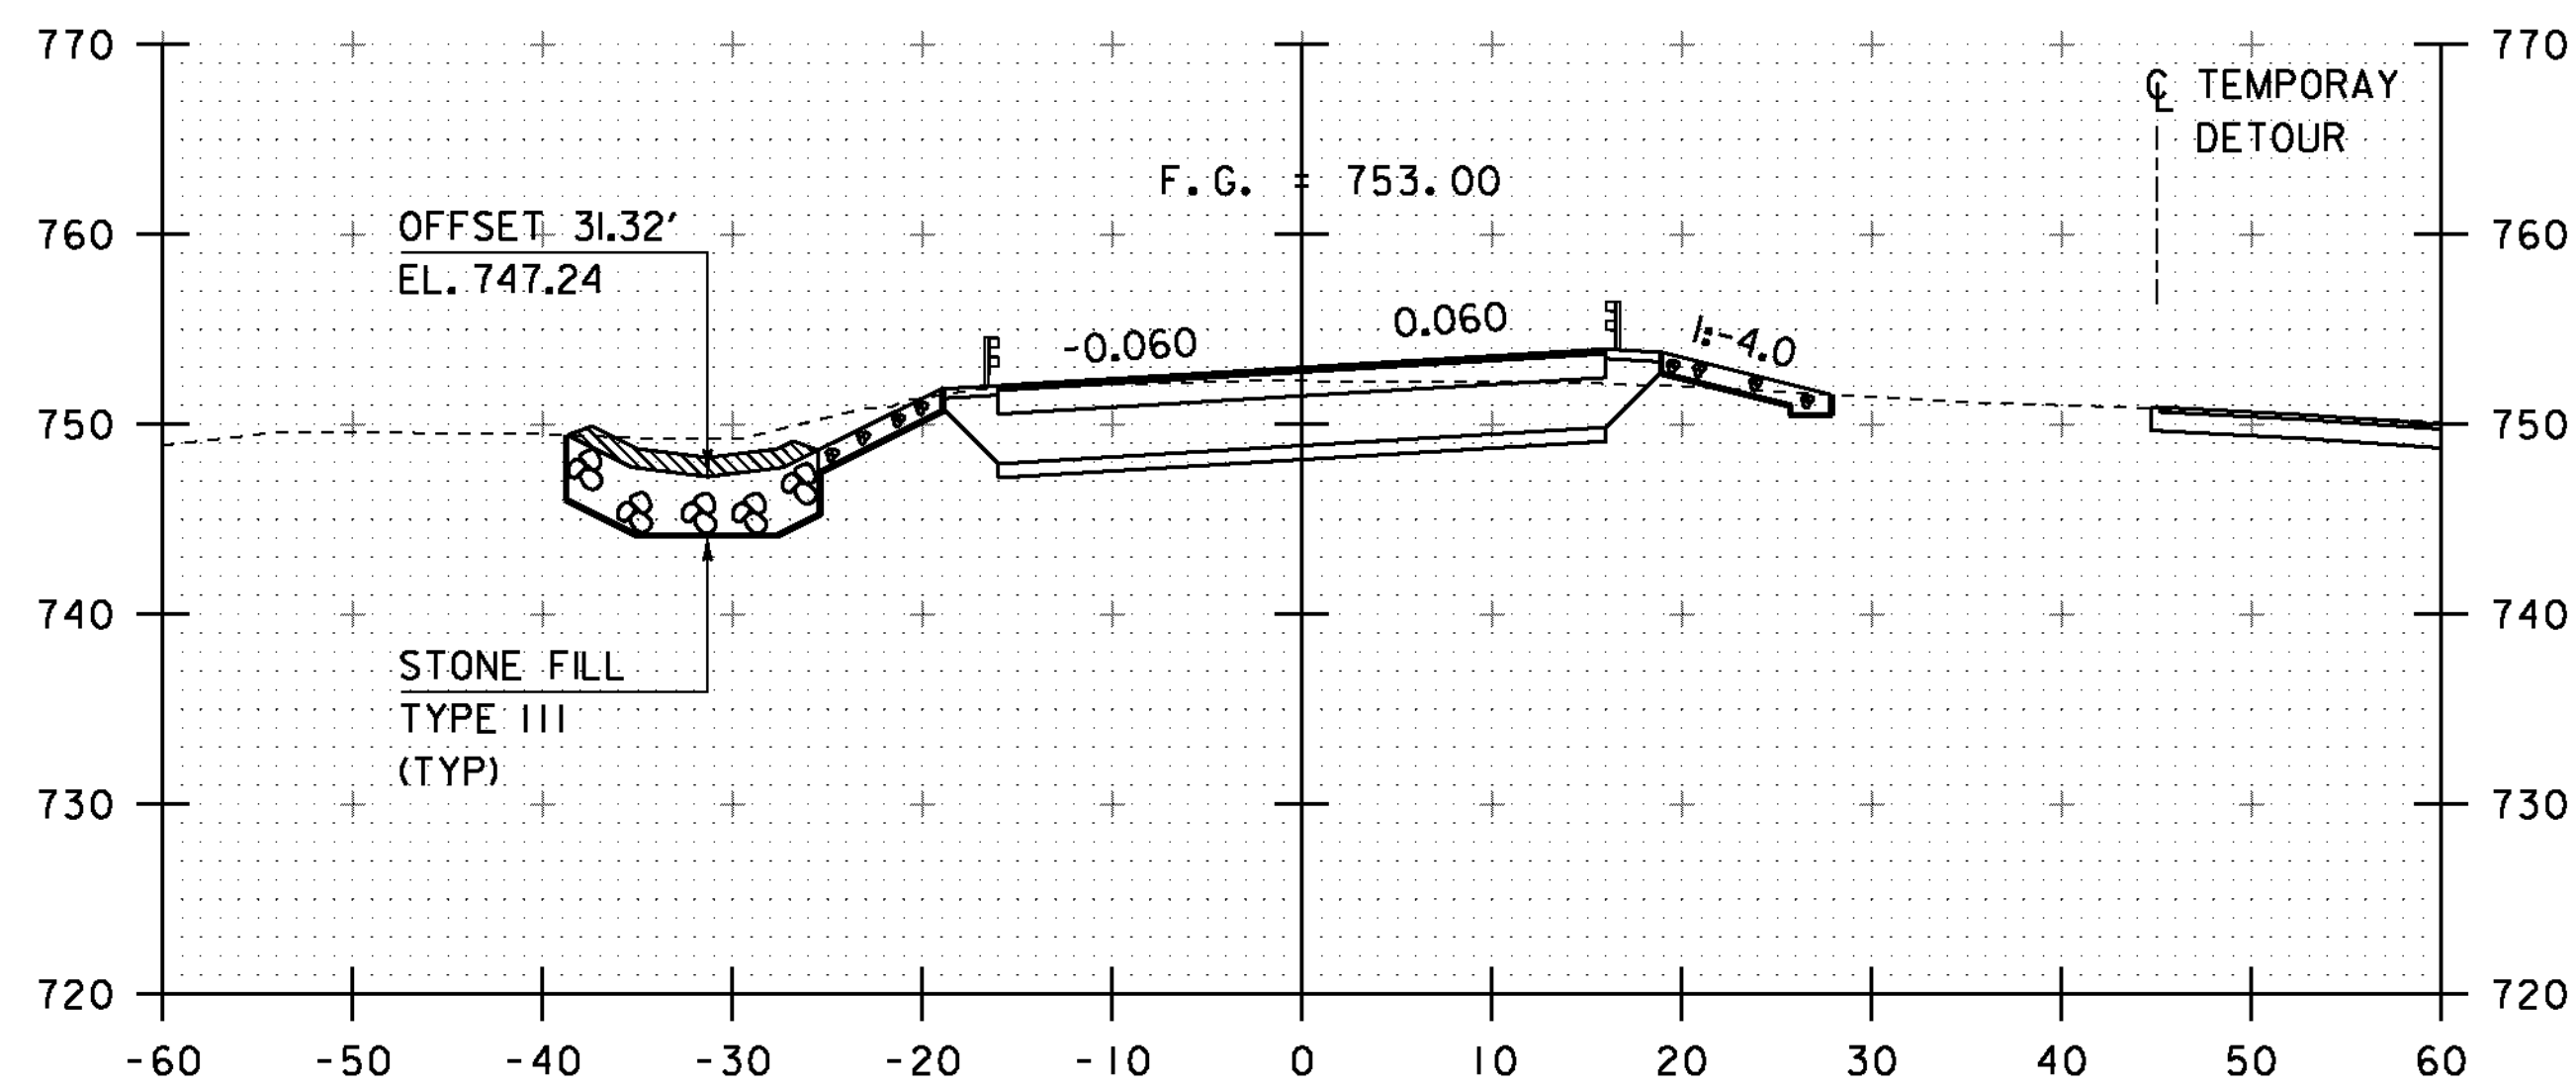


379+50

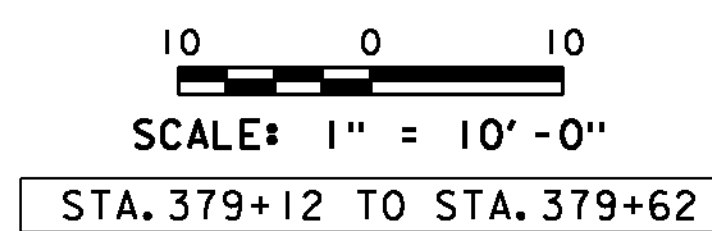


PROJECT NAME:	ST. JOHNSBURY	PLOT DATE:	28-AUG-2012
PROJECT NUMBER:	BRF 028-4(25)S	DRAWN BY:	C. MOONEY
FILE NAME:	s98b320xsl.dgn	CHECKED BY:	C. CARLSON
PROJECT LEADER:	C. CARLSON	ROADWAY CROSS SECTIONS 4	SHEET 34 OF 62
DESIGNED BY:	H. SALLS		

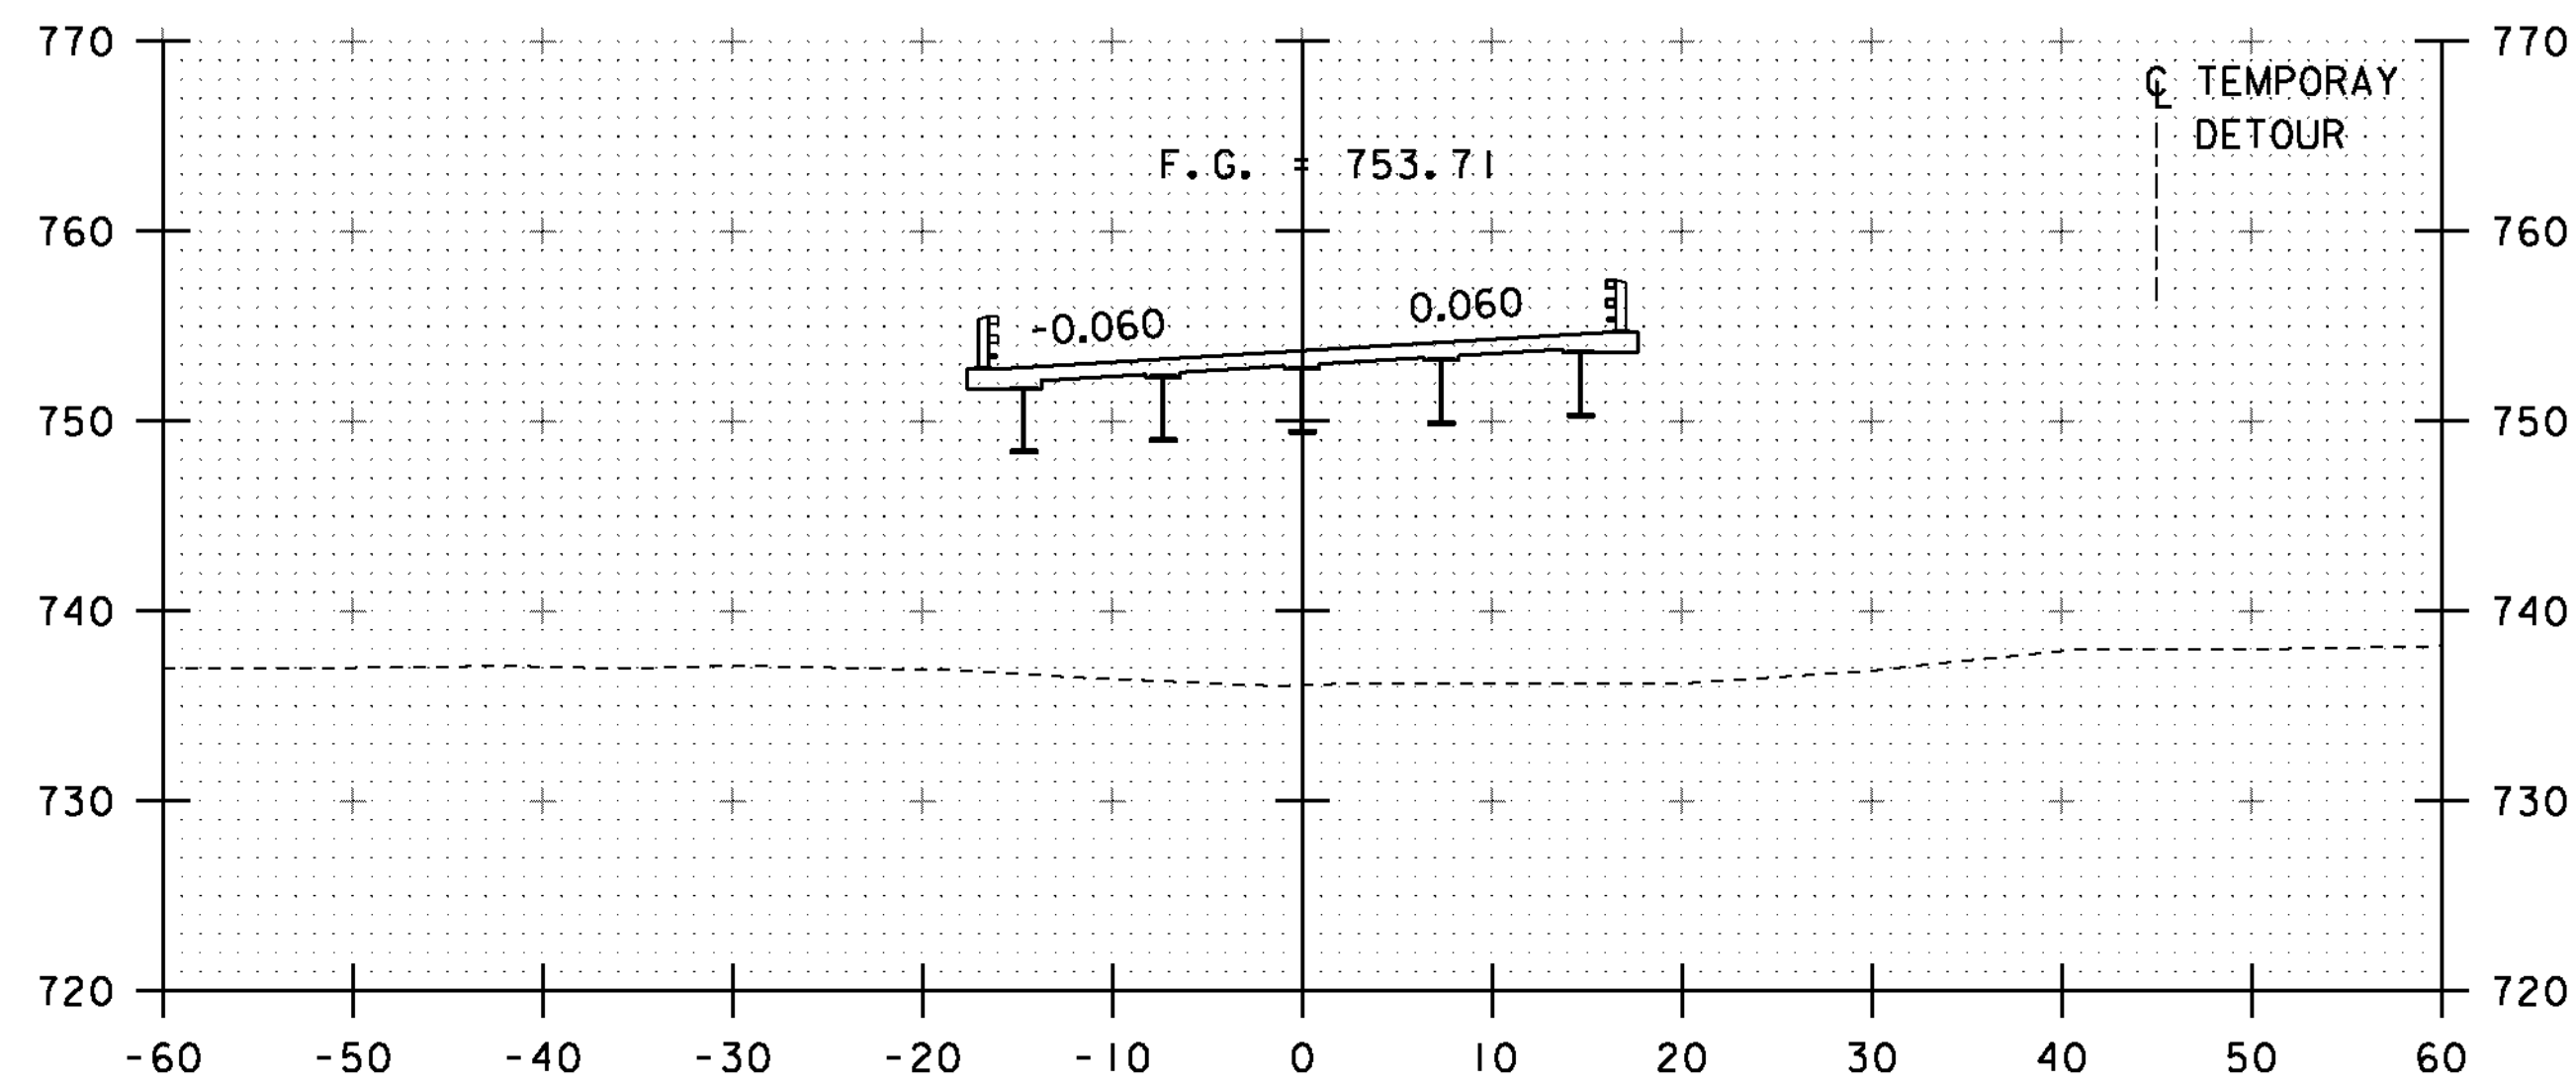


380+00

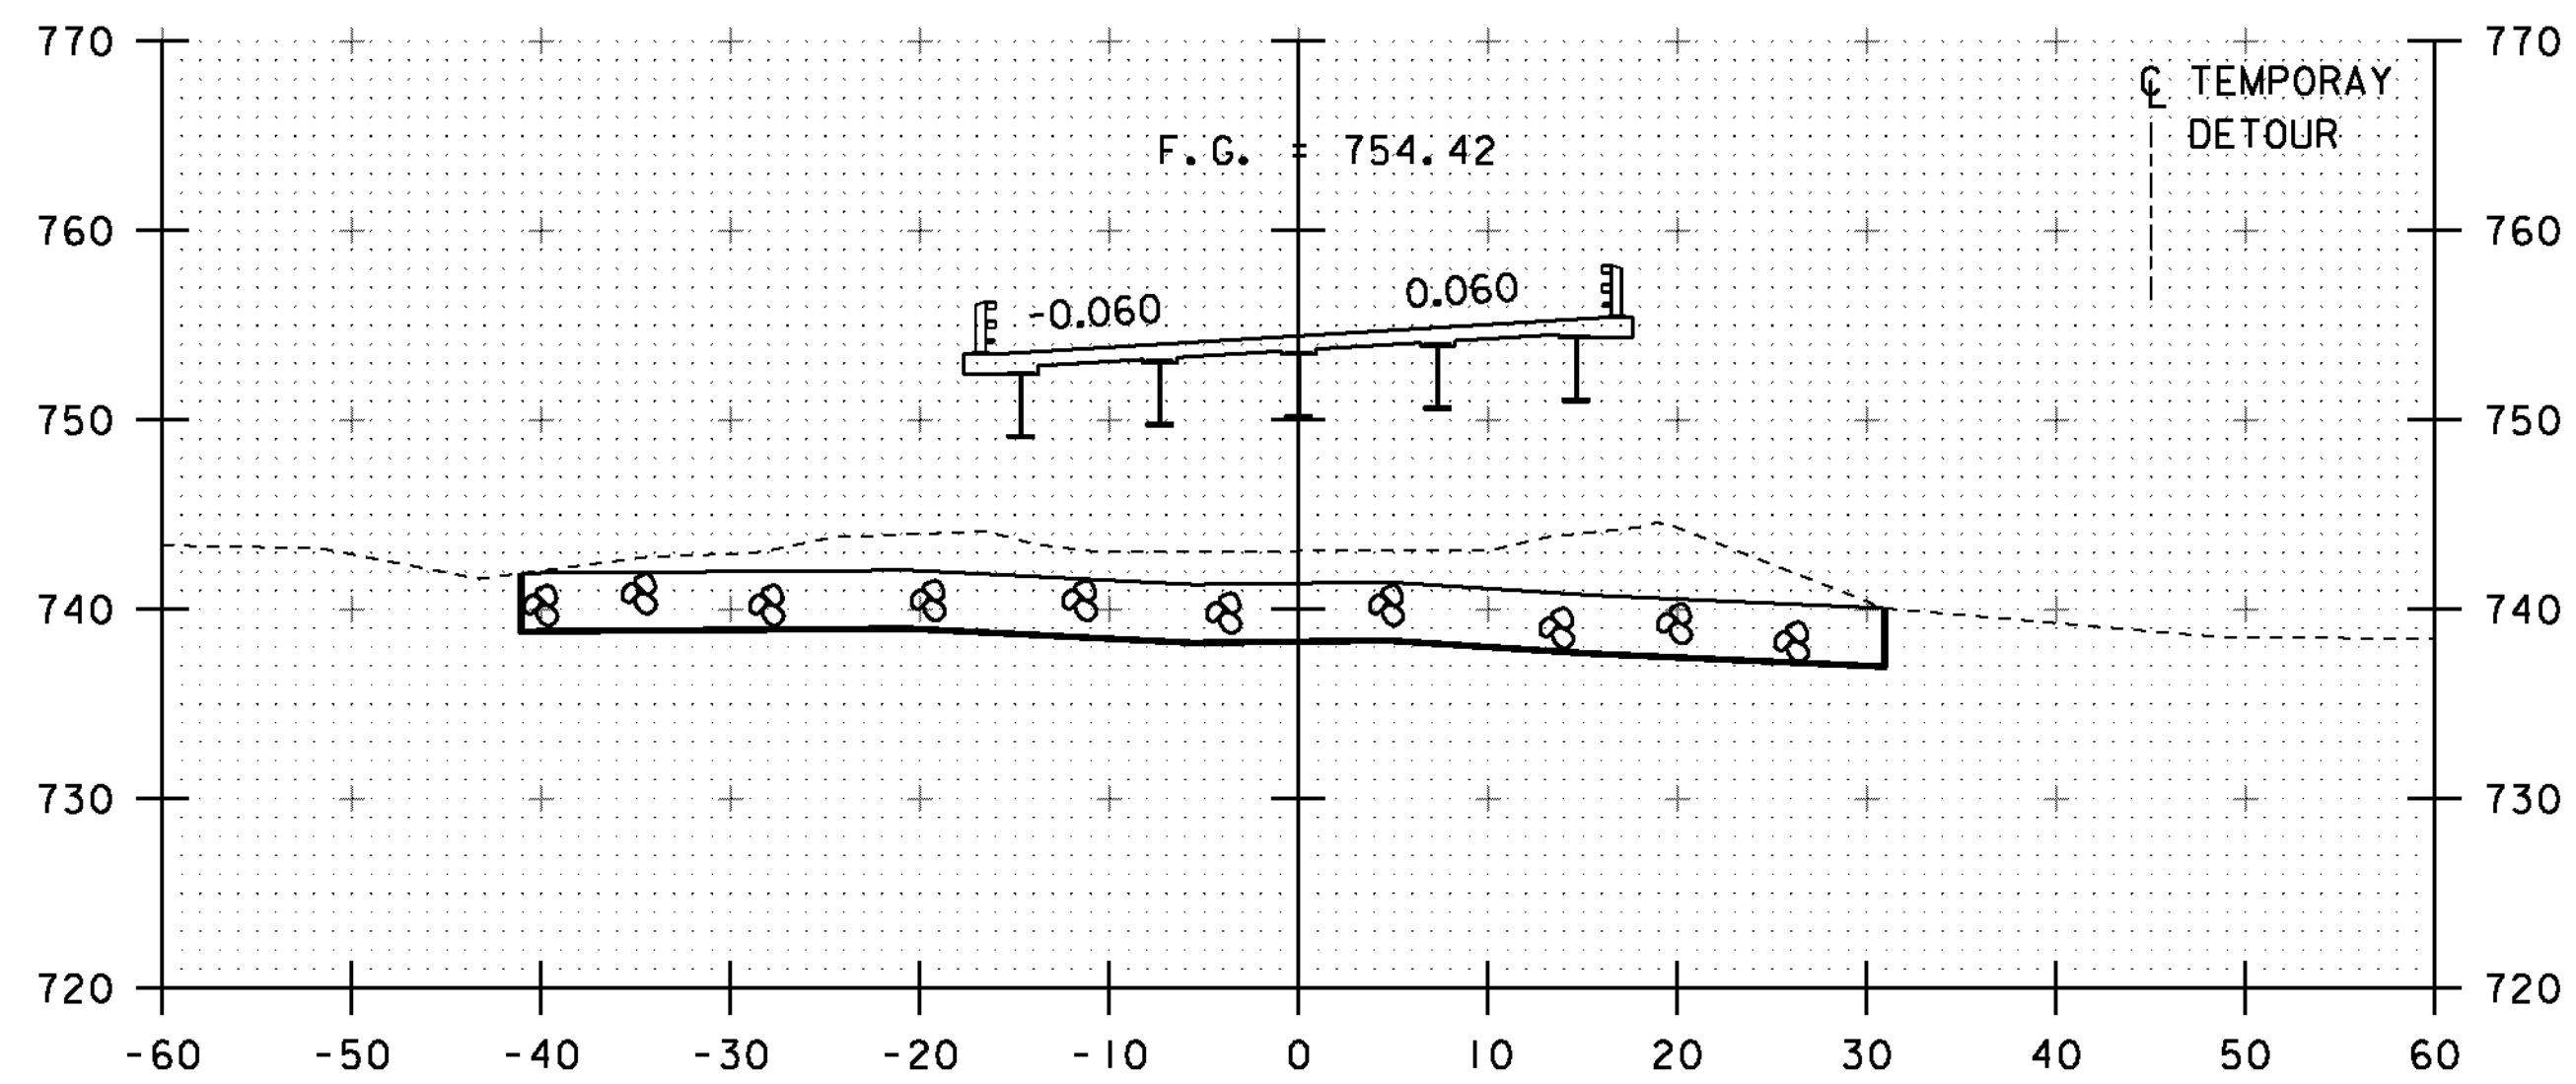

380+50

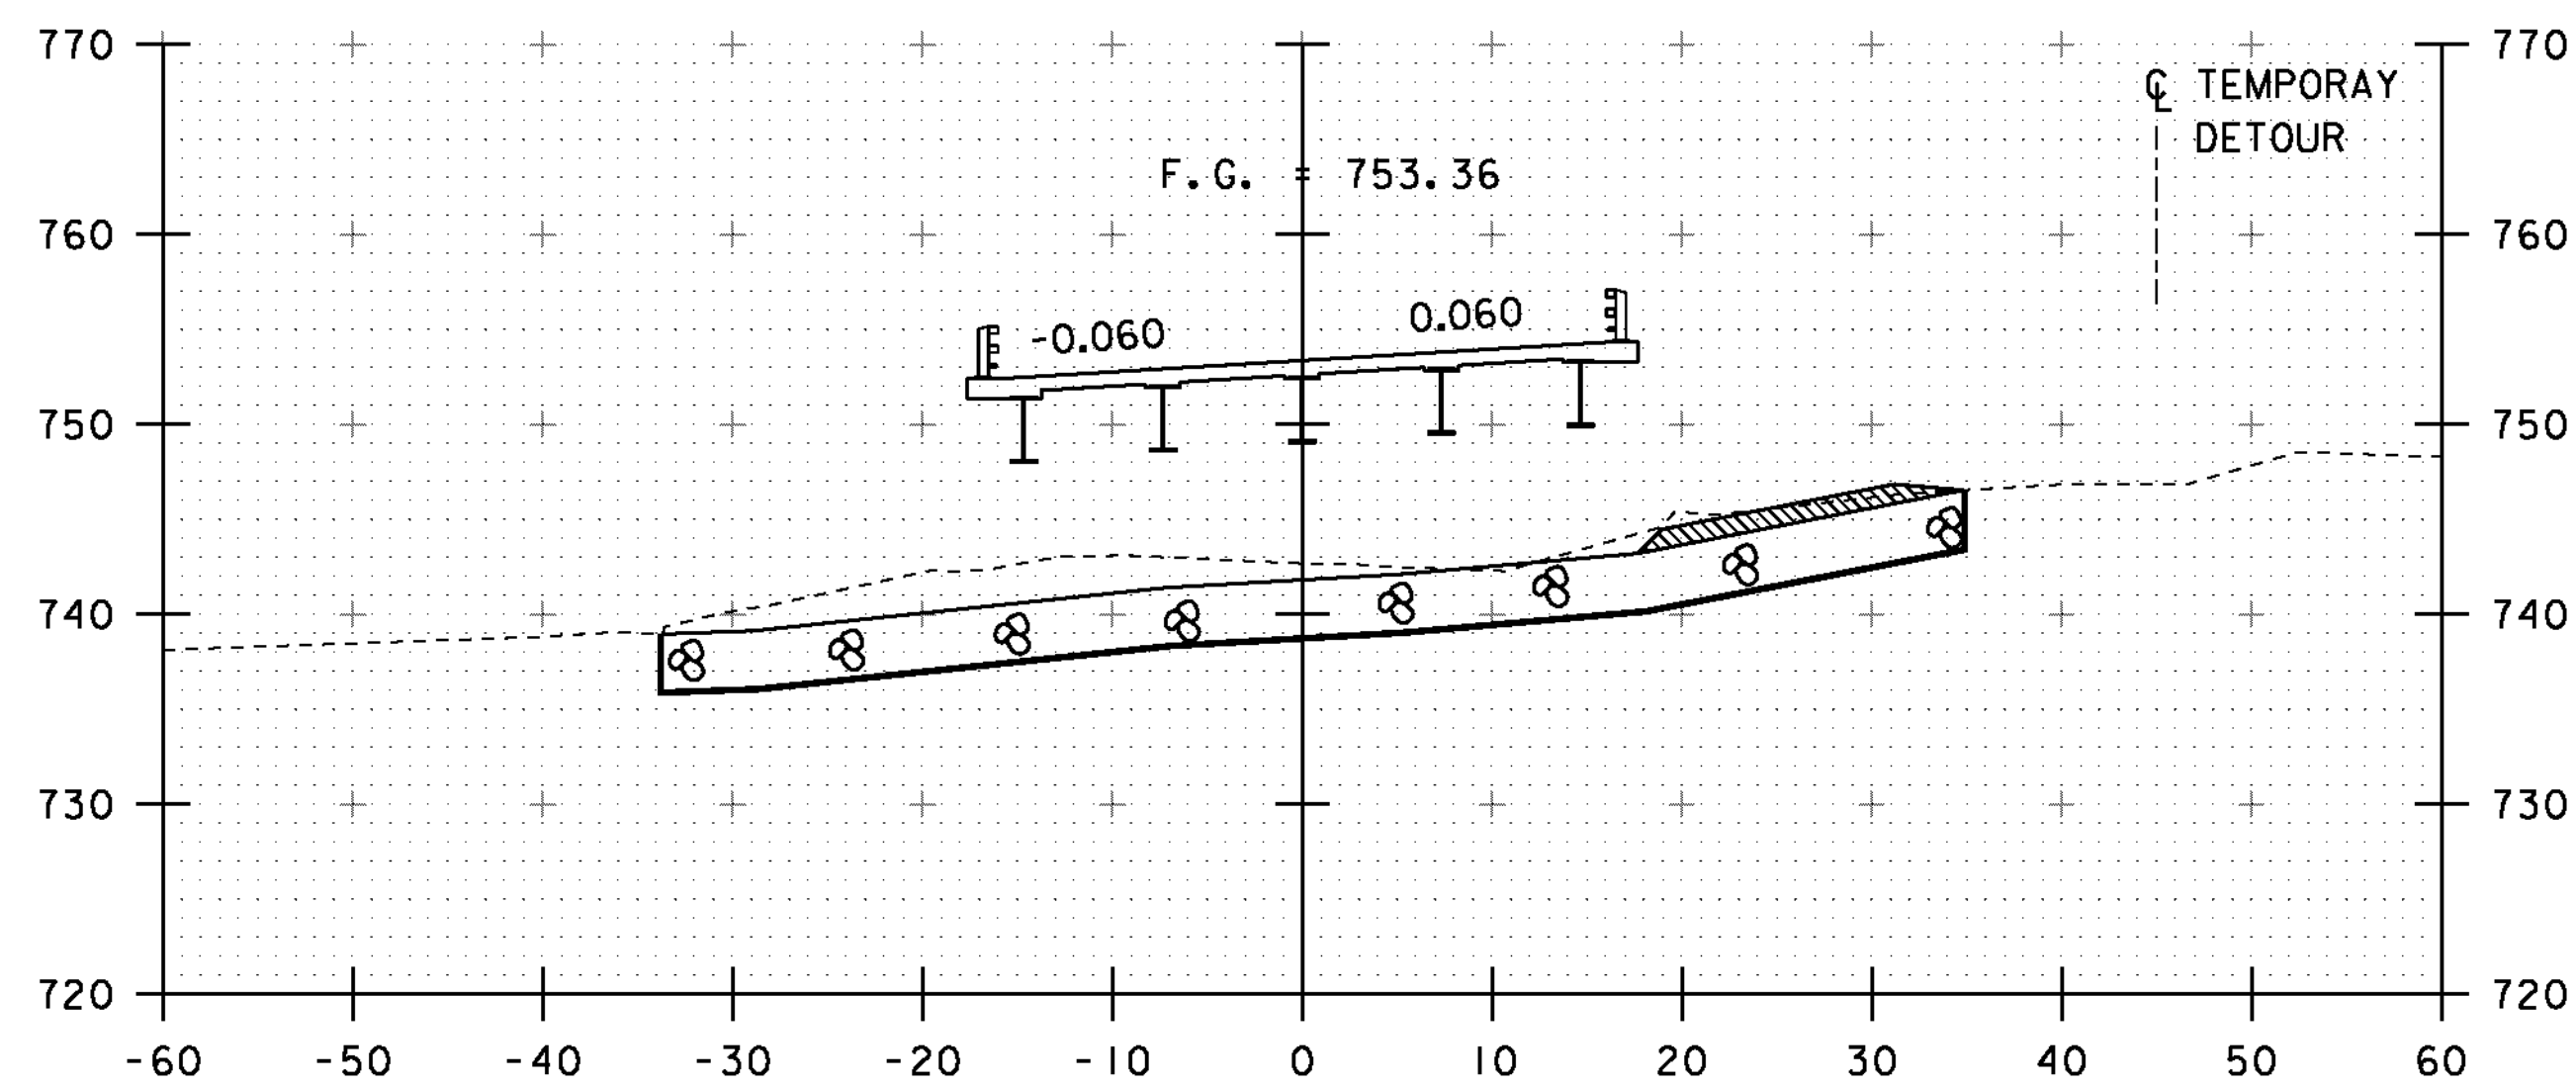

379+75

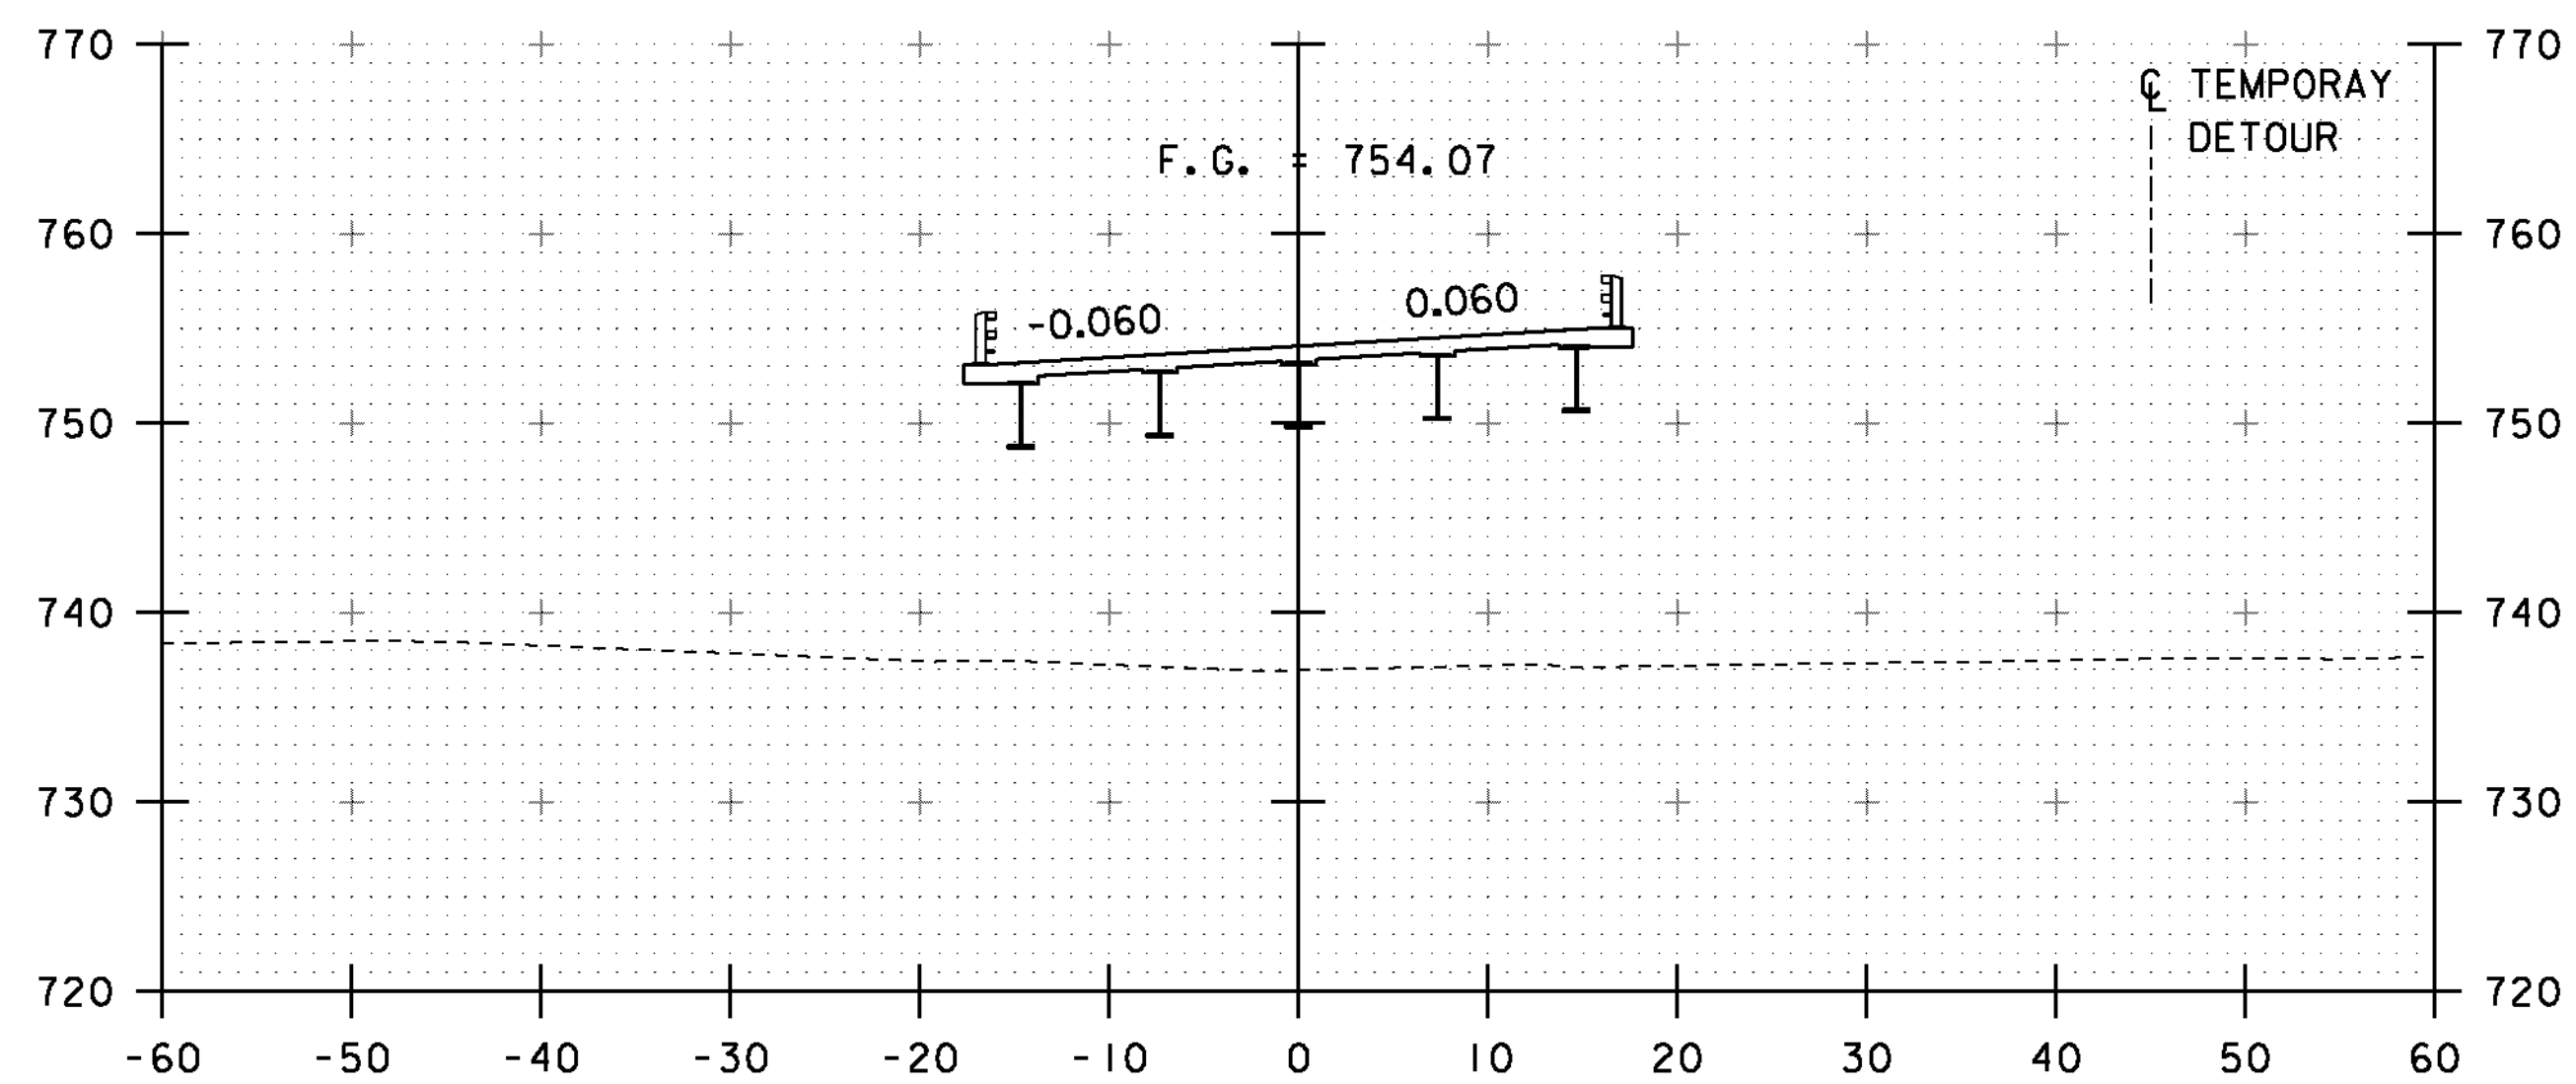


380+25

10 0 10
SCALE: 1" = 10'-0"
STA. 379+75 TO STA. 380+50


PROJECT NAME: ST. JOHNSBURY
PROJECT NUMBER: BRF 028-4(25)S

FILE NAME: s98b320xsl.dgn
PROJECT LEADER: C. CARLSON
DESIGNED BY: H. SALLS
ROADWAY CROSS SECTIONS 5


PLOT DATE: 28-AUG-2012
DRAWN BY: C. MOONEY
CHECKED BY: C. CARLSON
SHEET 35 OF 62

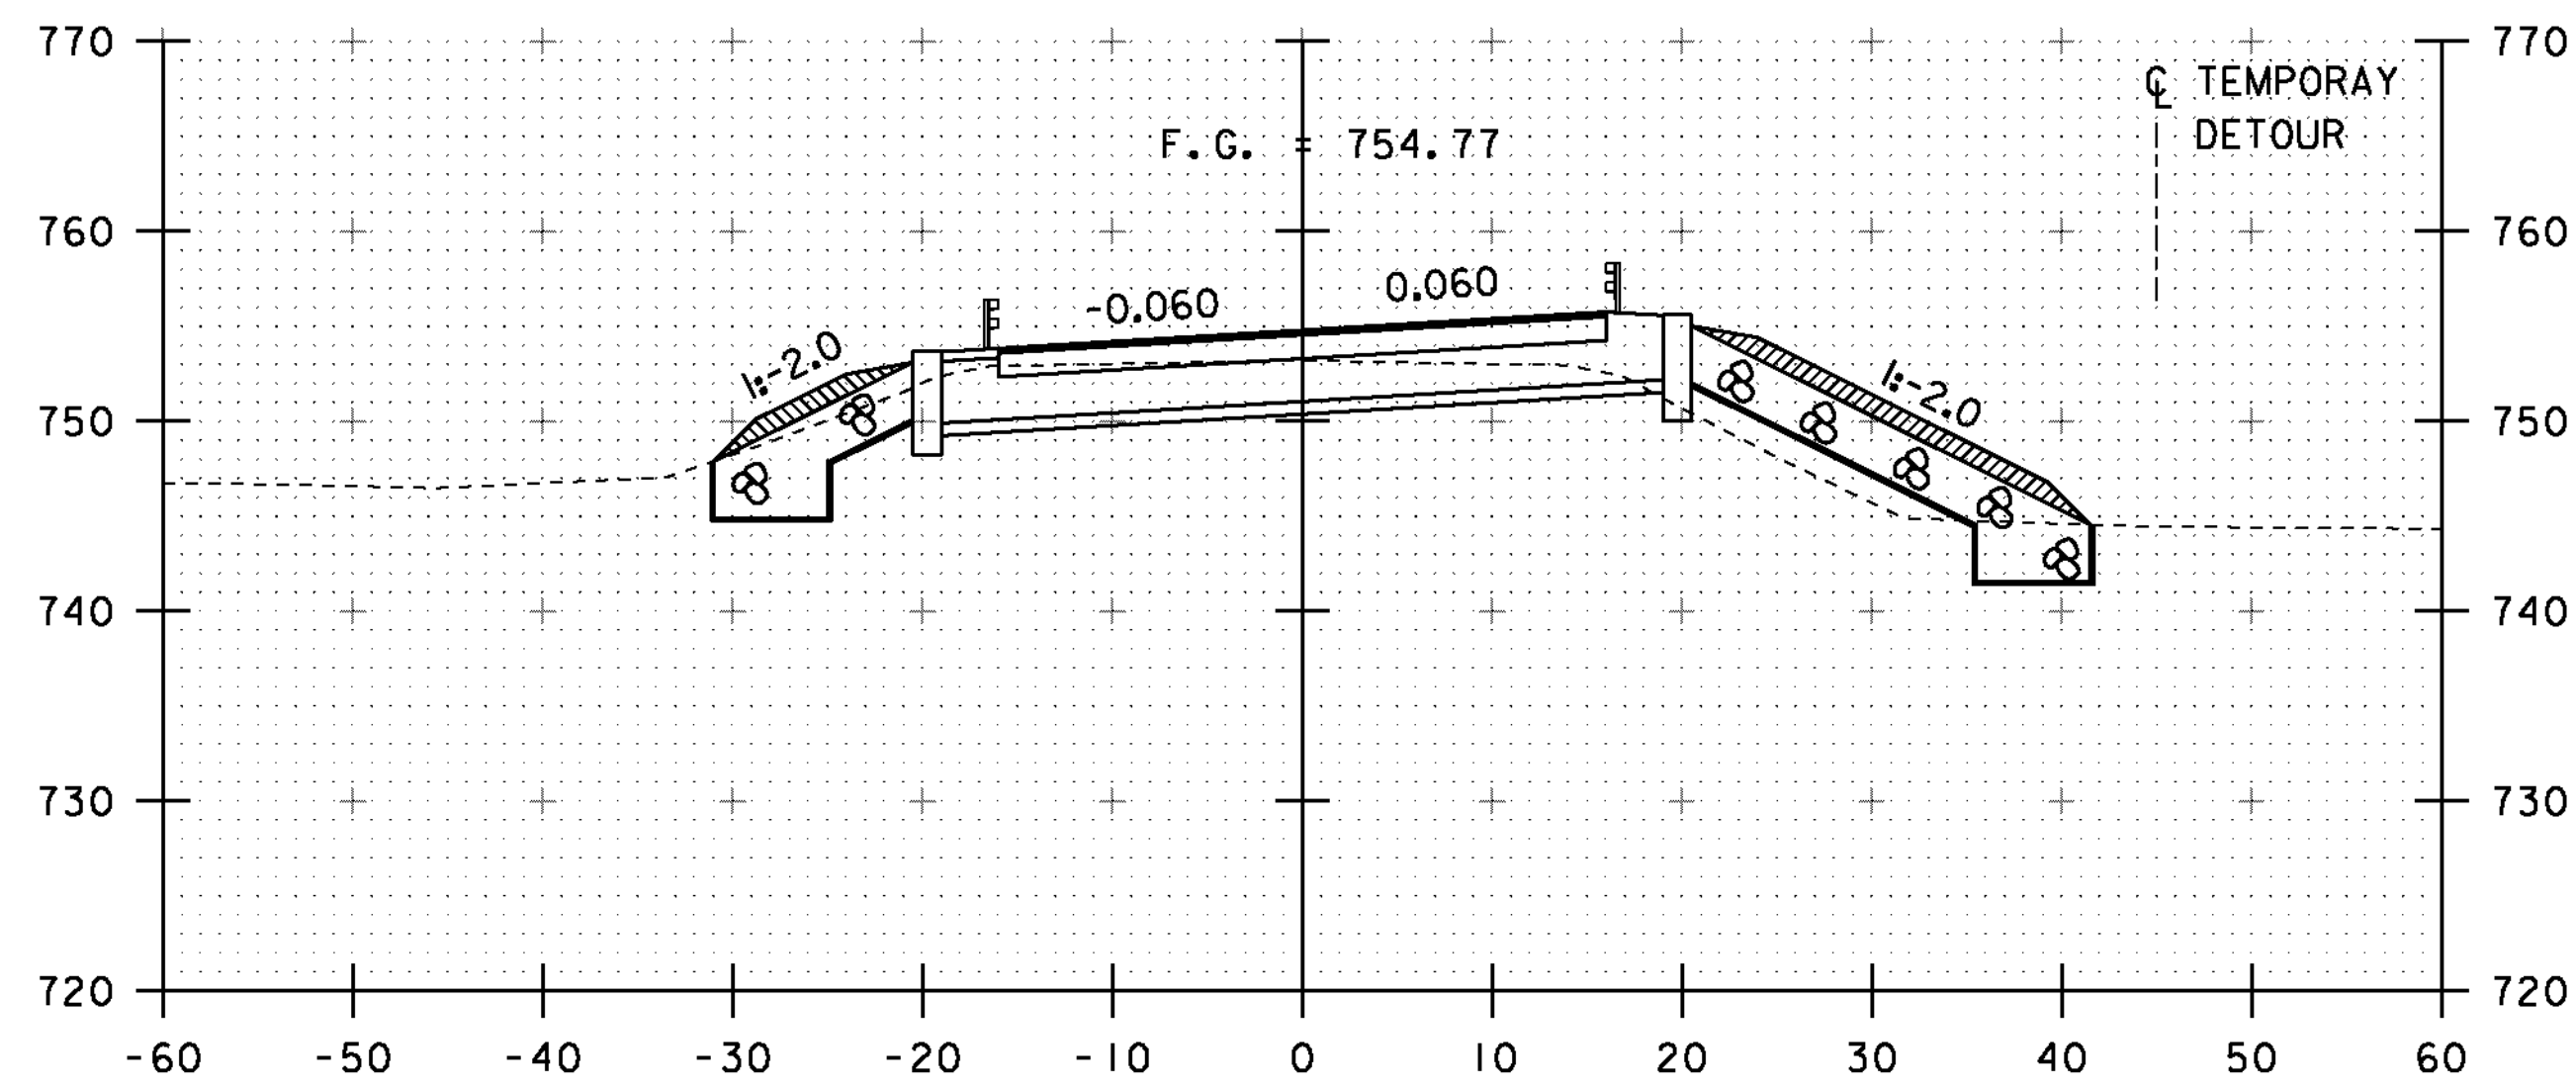


380+75

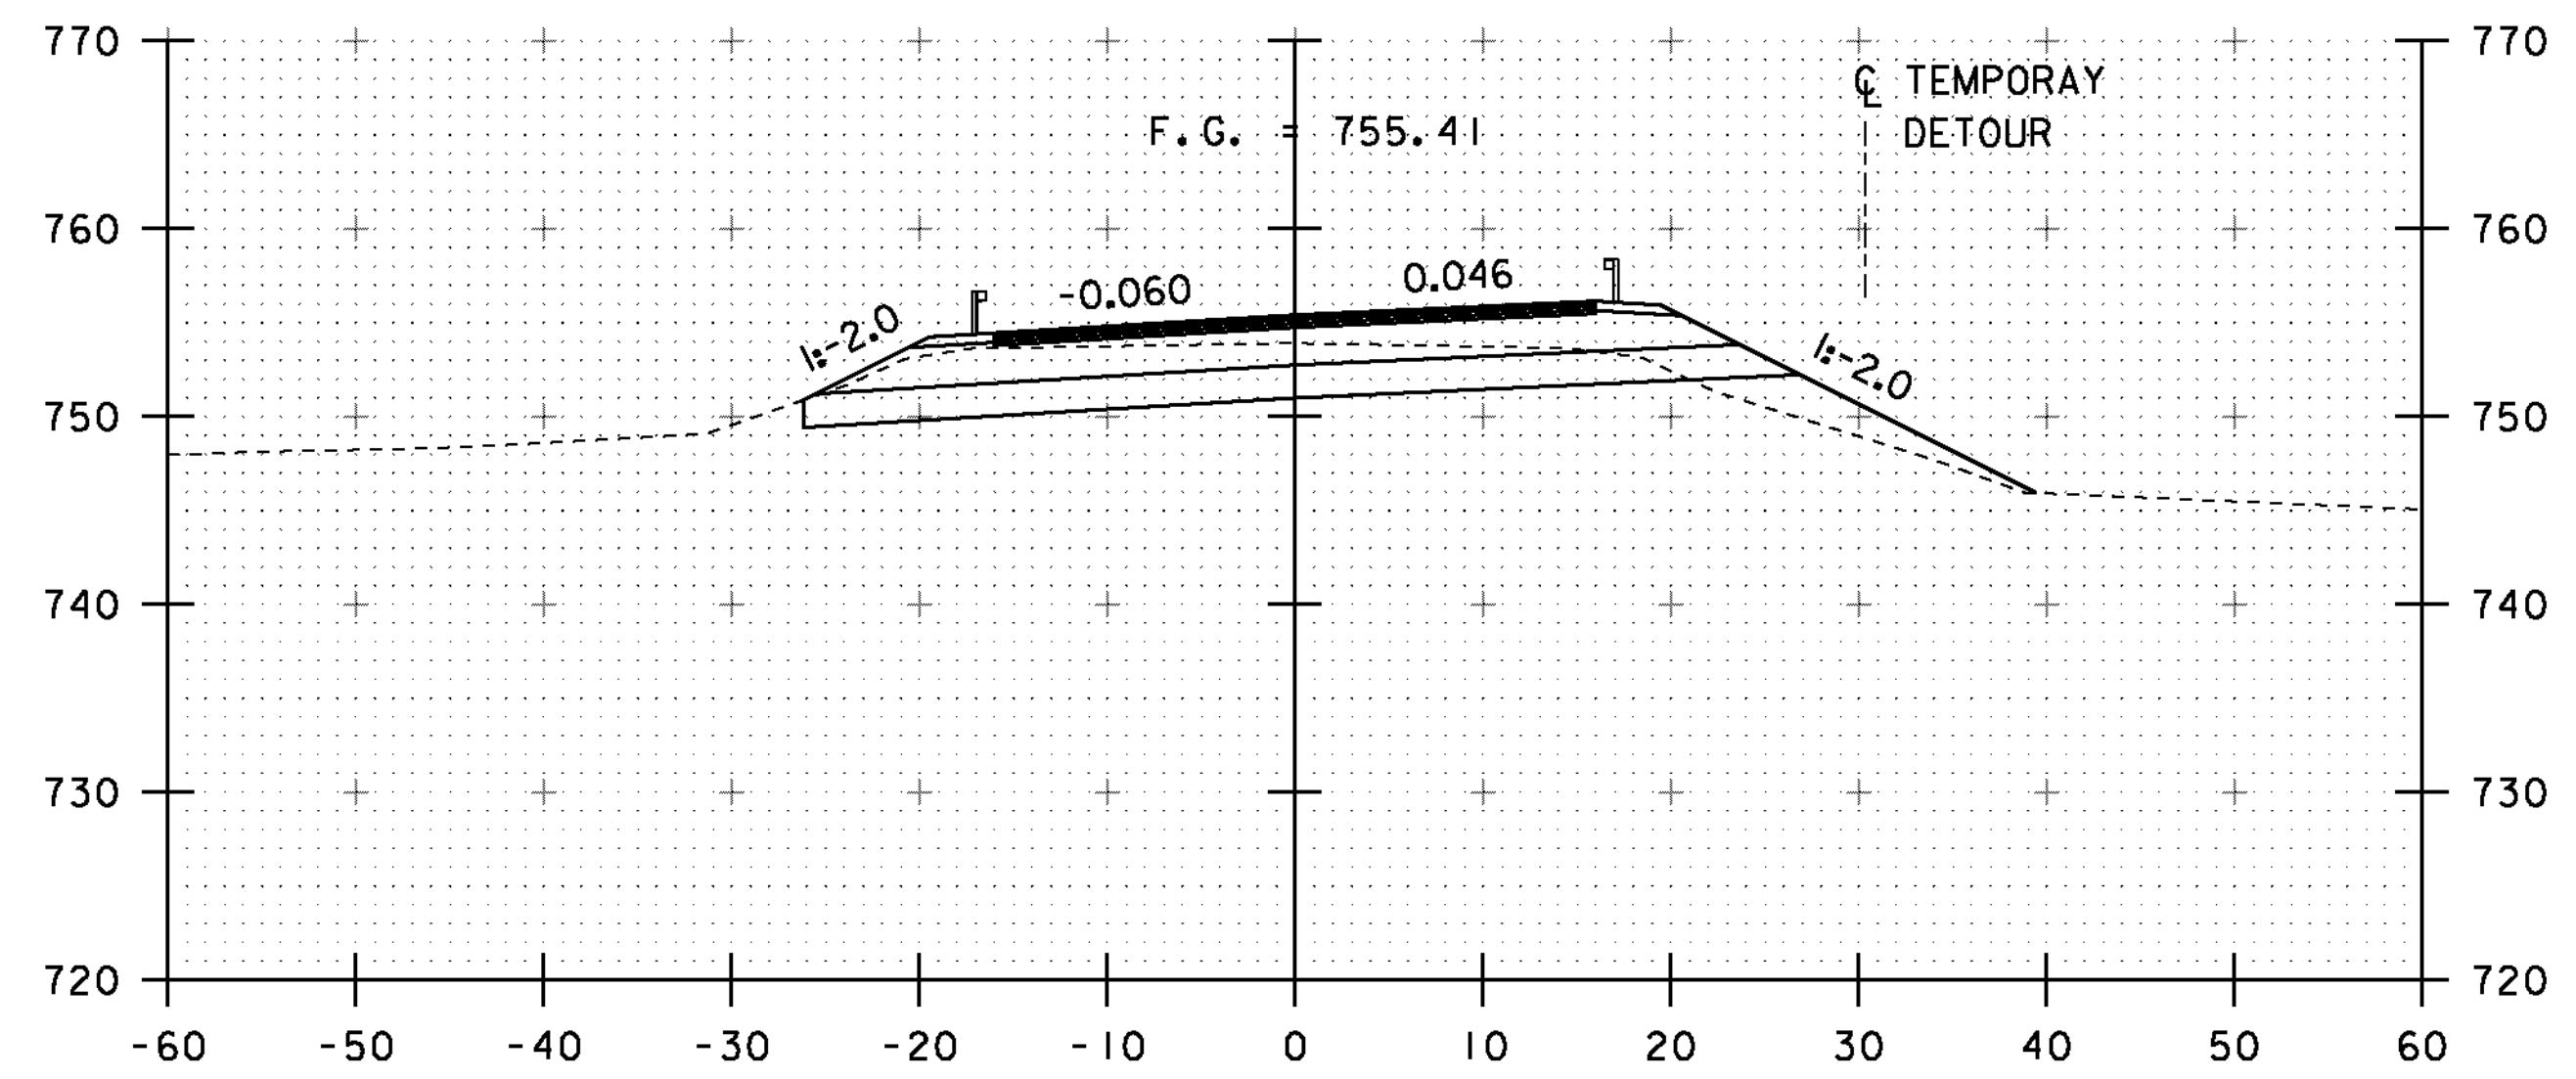

381+15

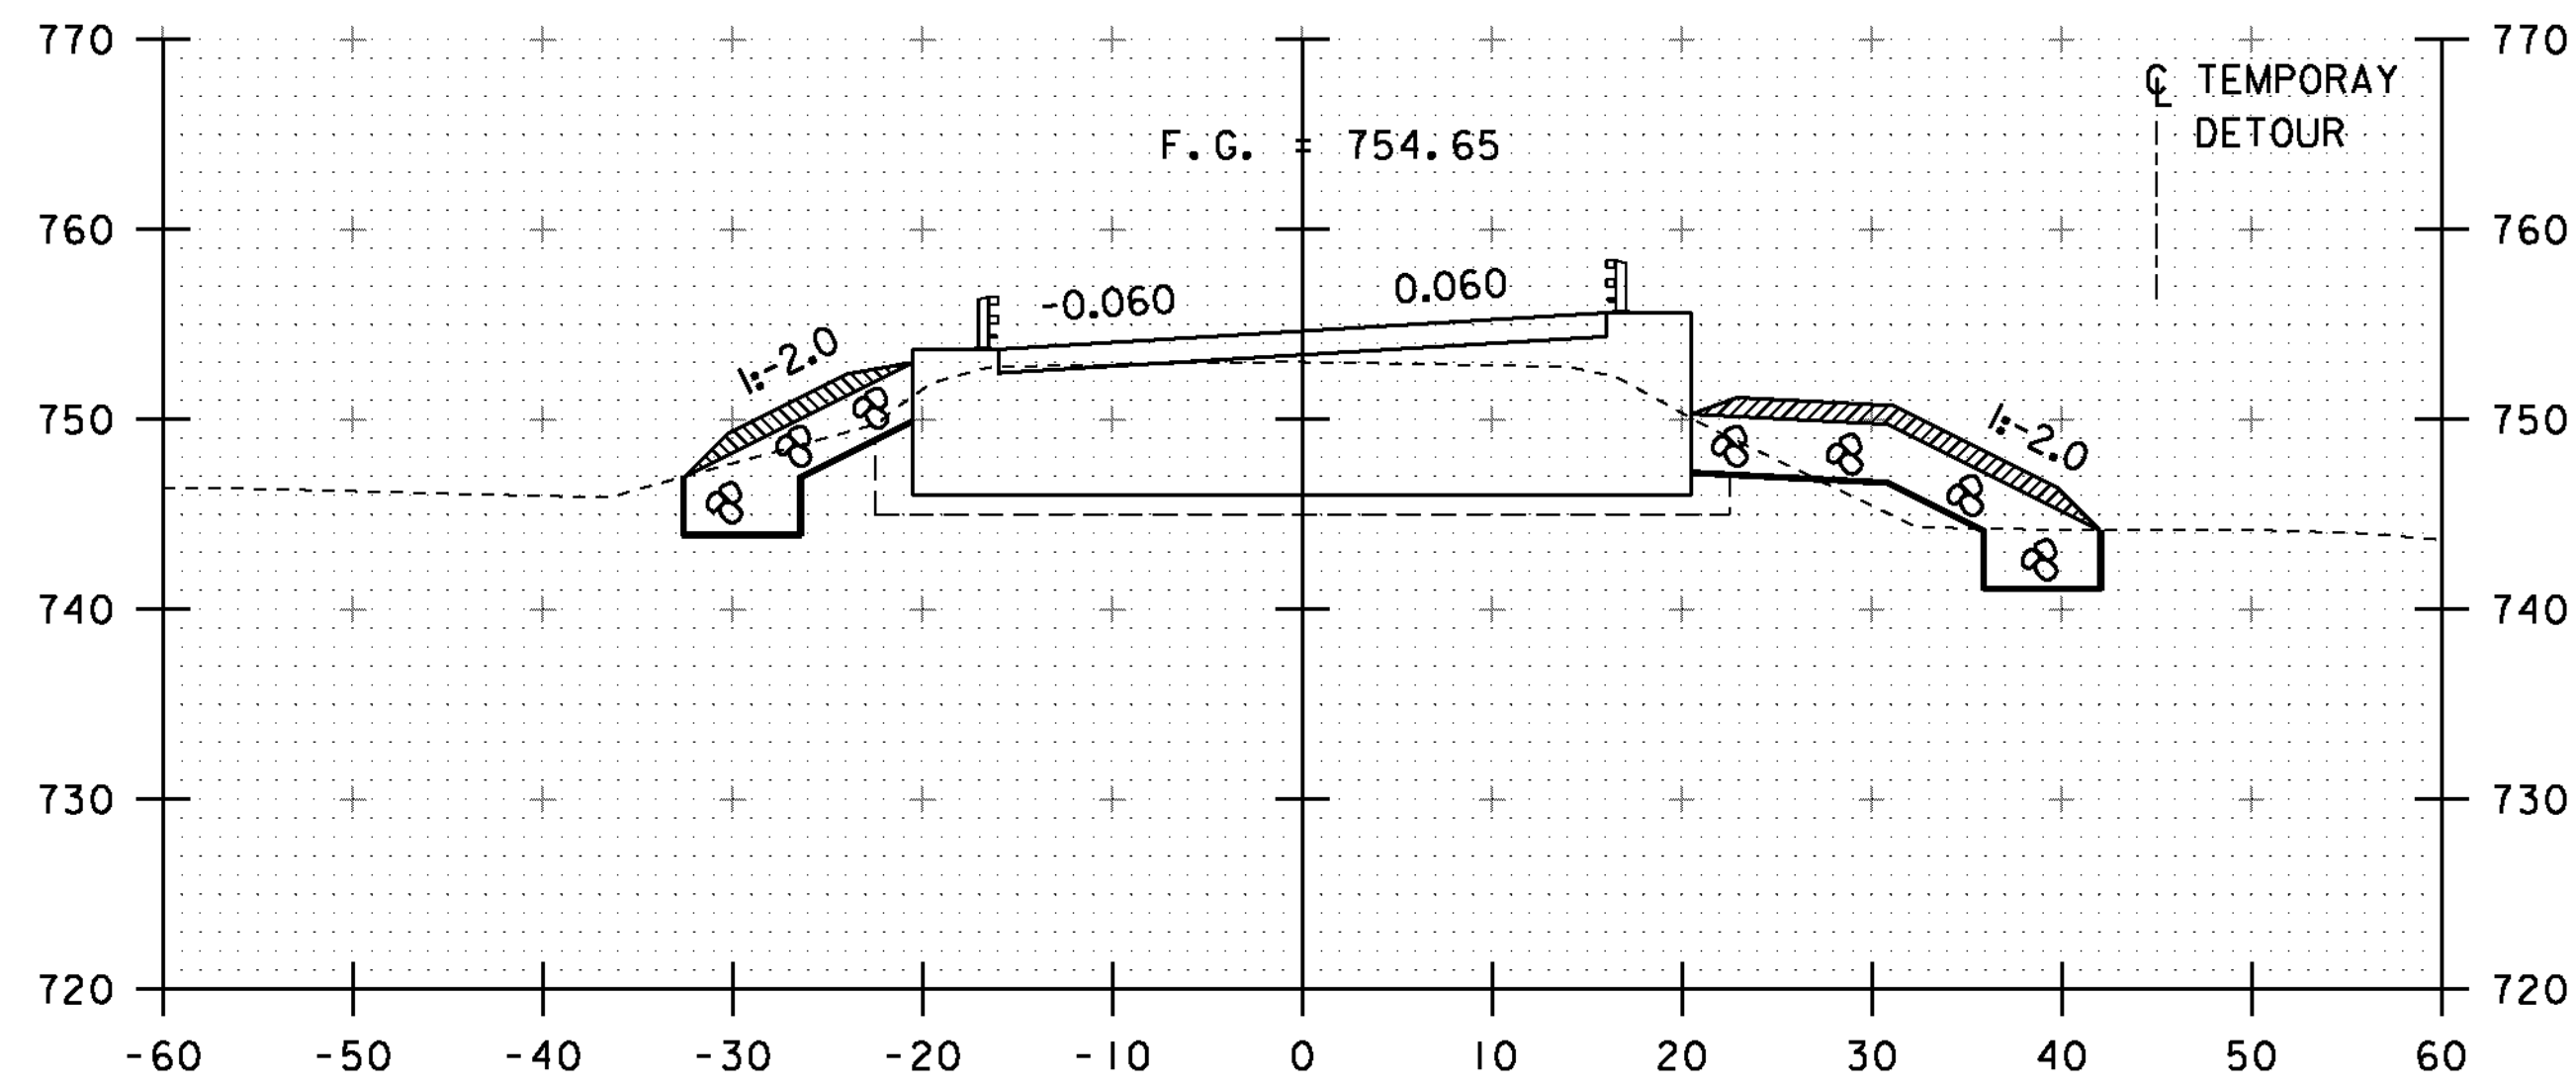


380+65

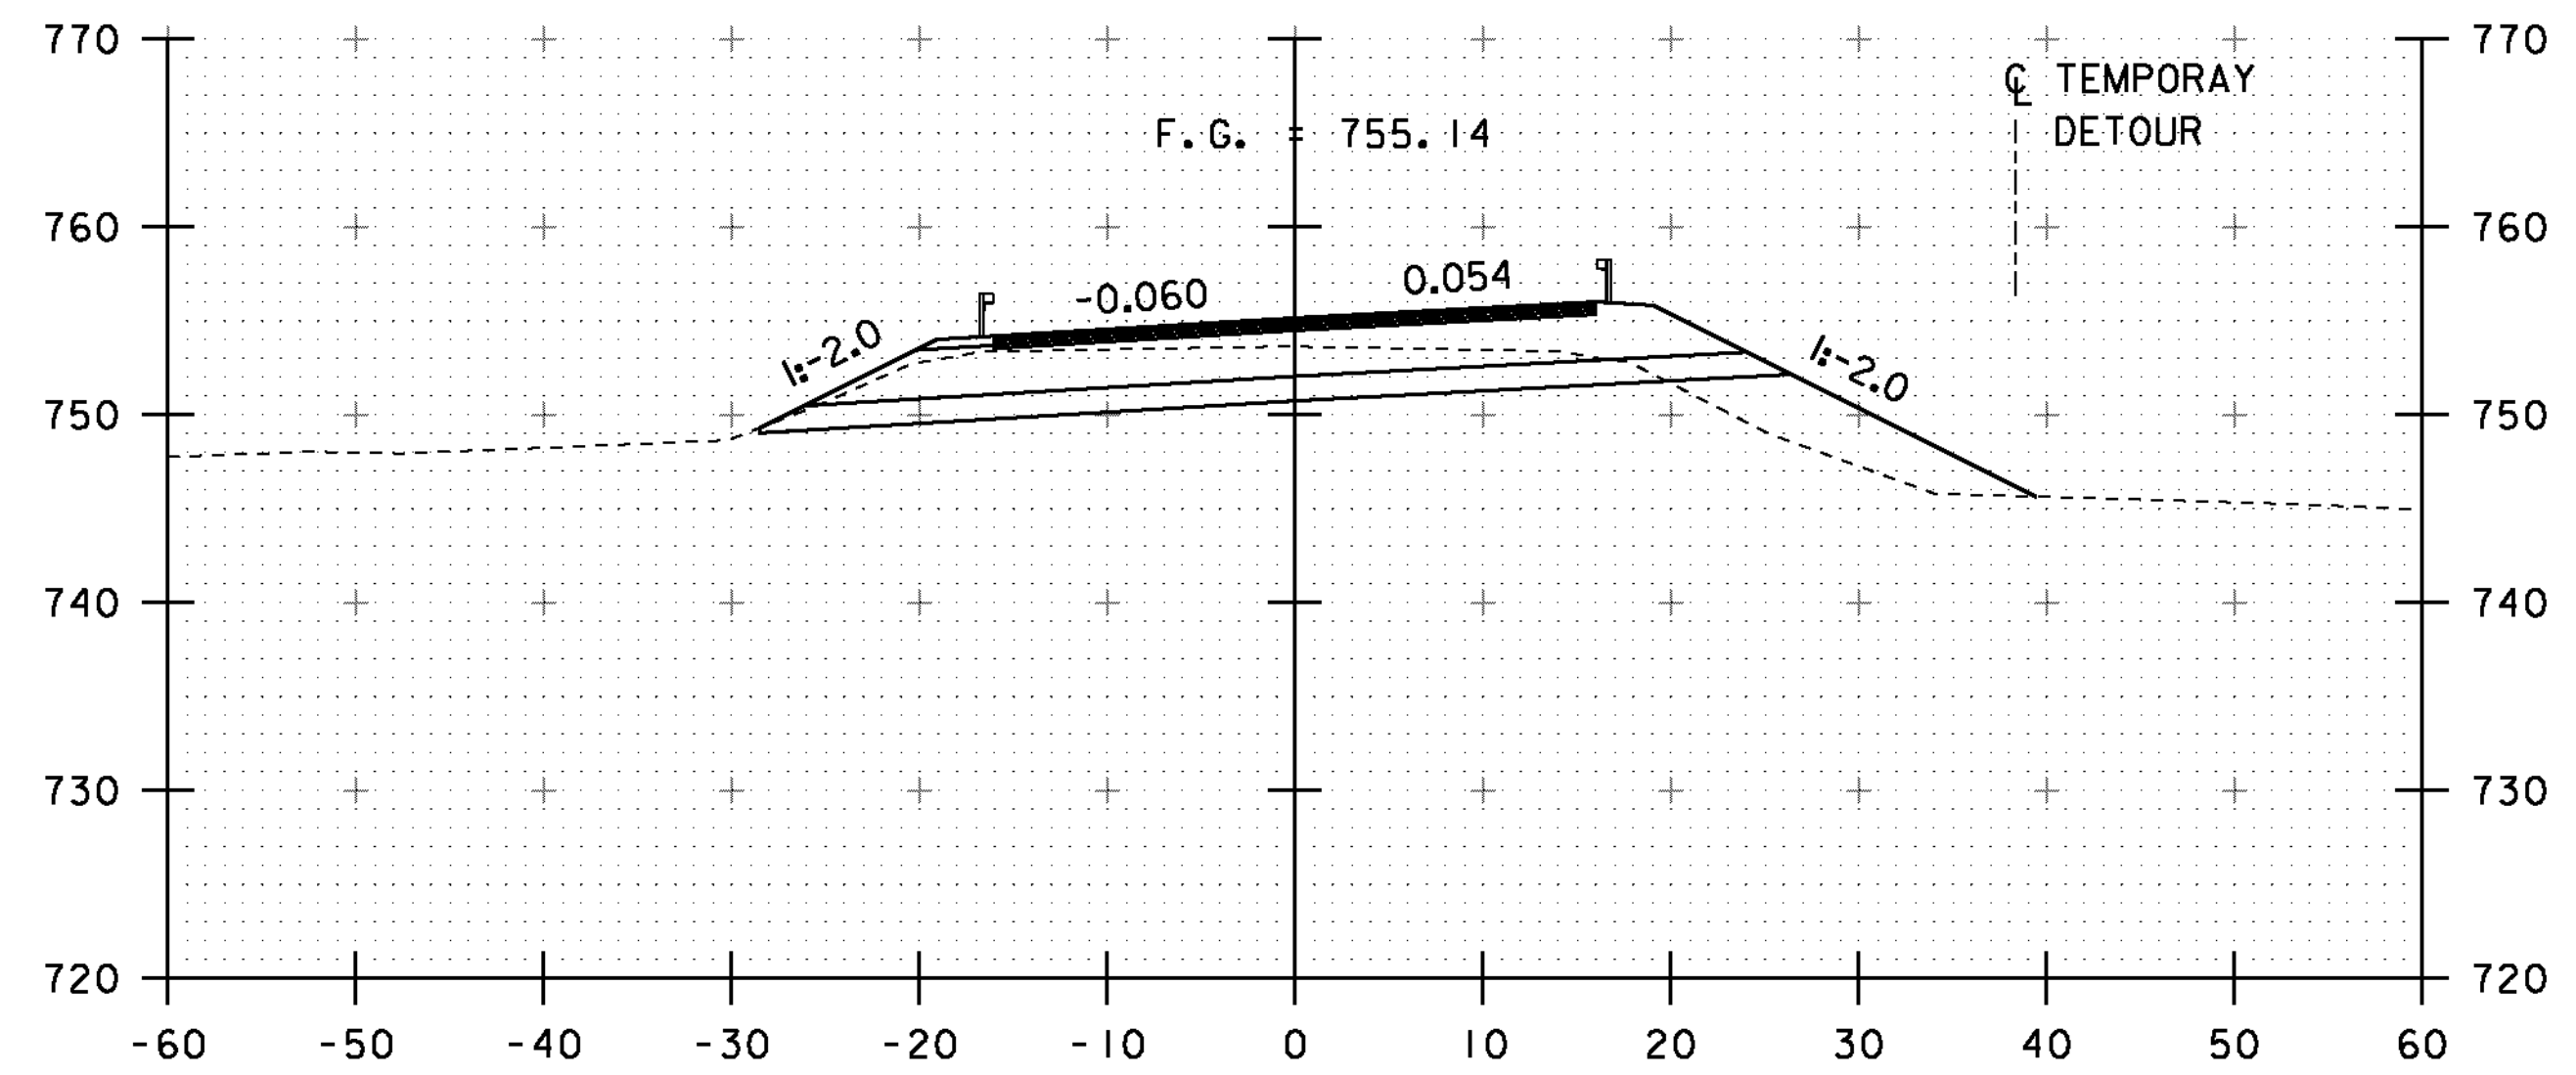


381+00


STA. 380+64.95
END BRIDGE

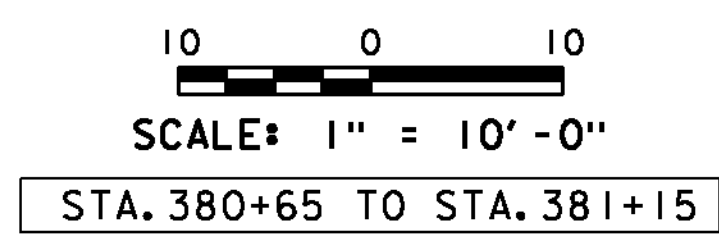


PROJECT NAME:	ST. JOHNSBURY	PLOT DATE:	28-AUG-2012
PROJECT NUMBER:	BRF 028-4(25)S	DRAWN BY:	C. MOONEY
FILE NAME:	s98b320xsl.dgn	CHECKED BY:	C. CARLSON
PROJECT LEADER:	C. CARLSON	ROADWAY CROSS SECTIONS	6
DESIGNED BY:	H. SALLS	SHEET	36 OF 62

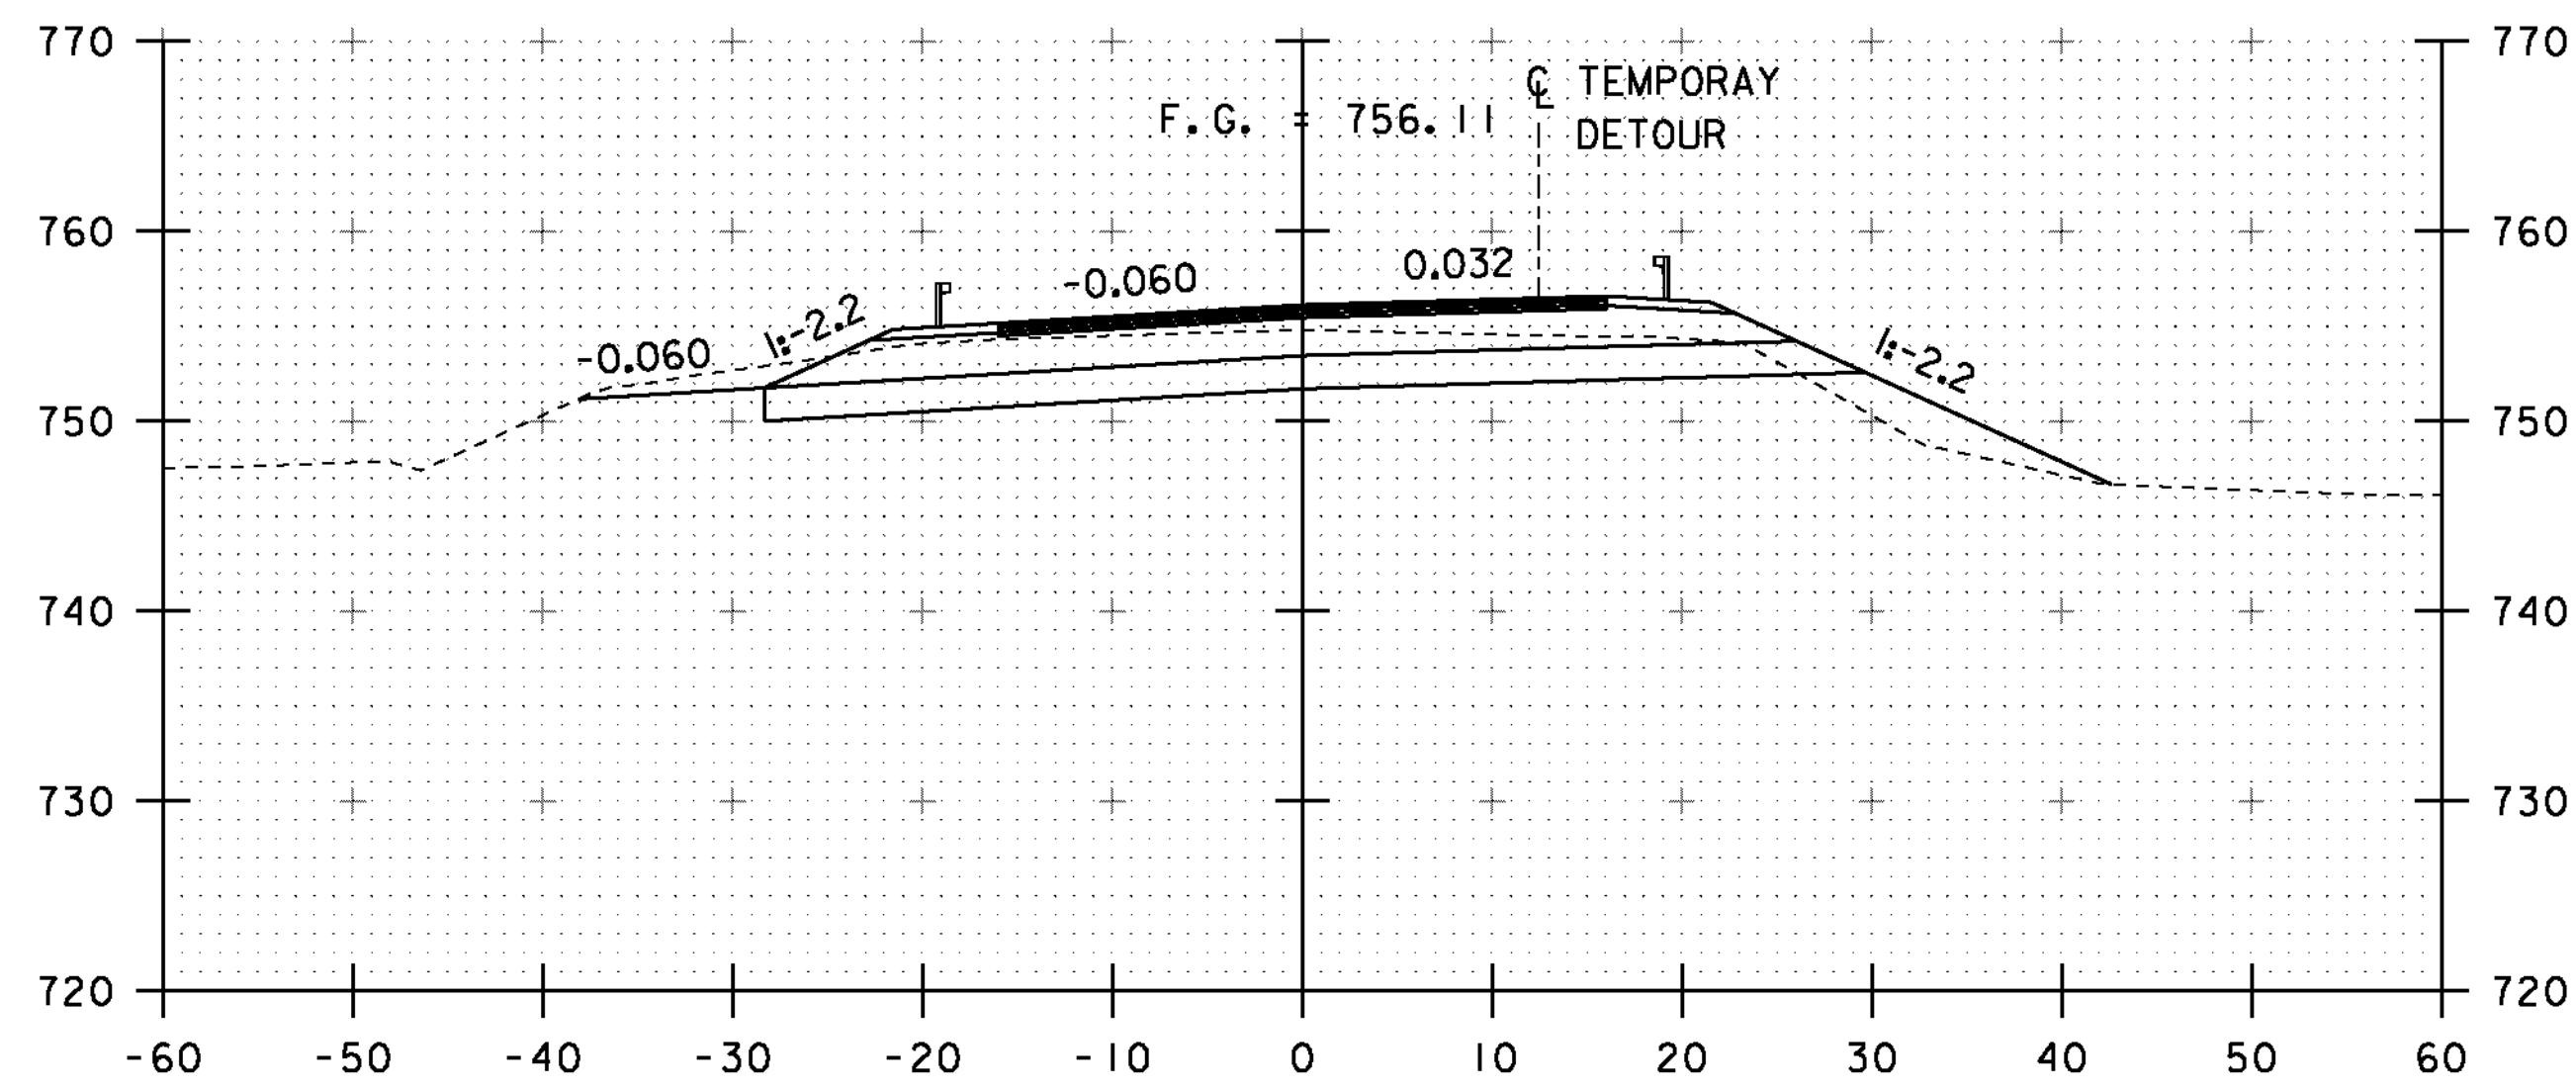


381+50

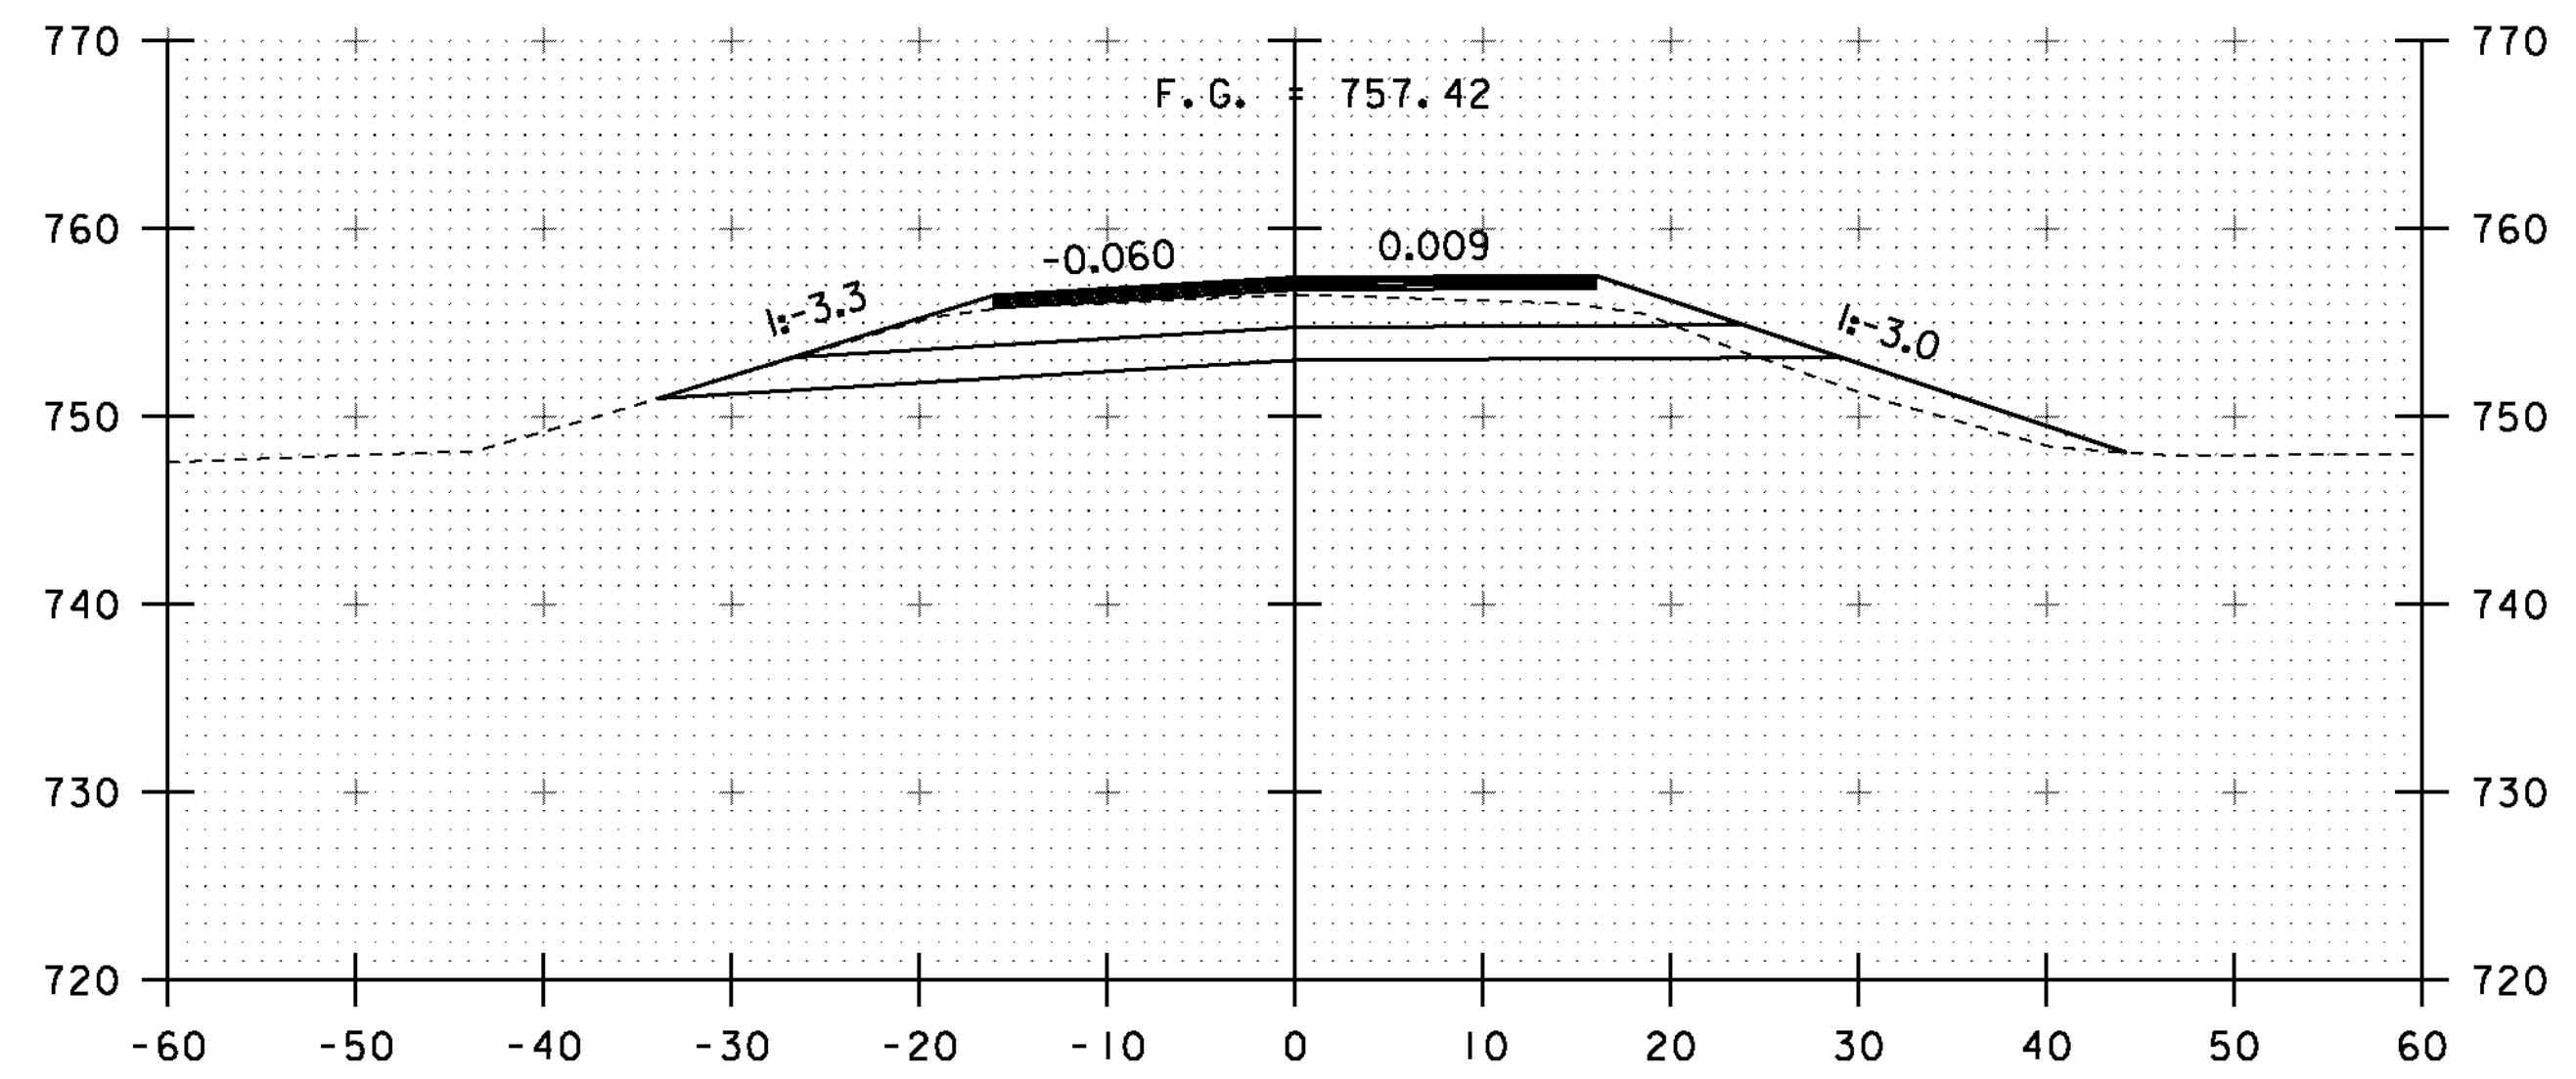


382+00

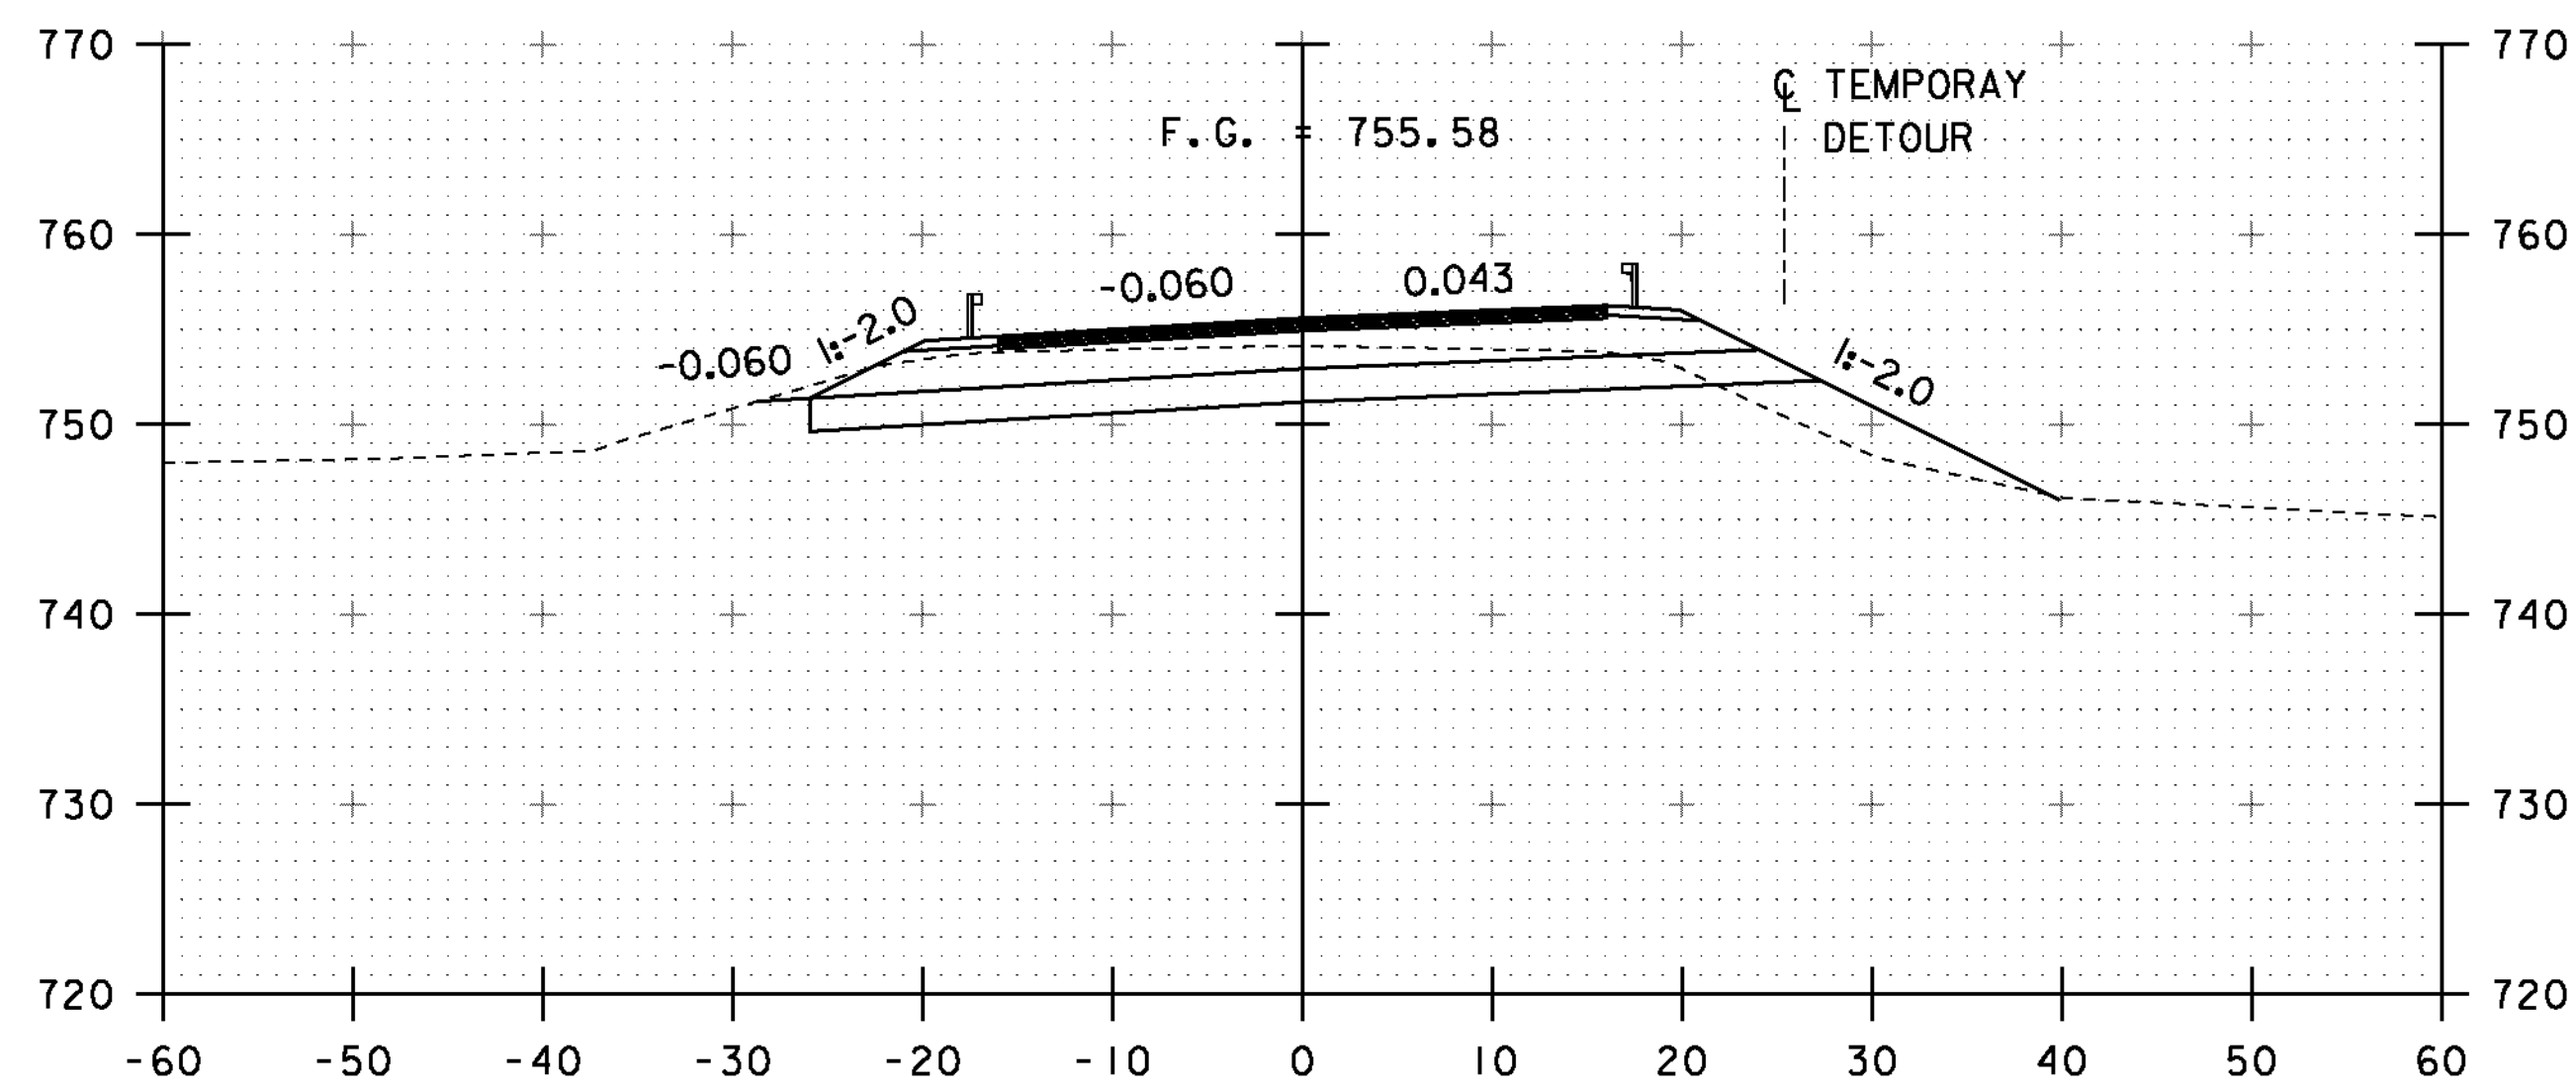


381+25

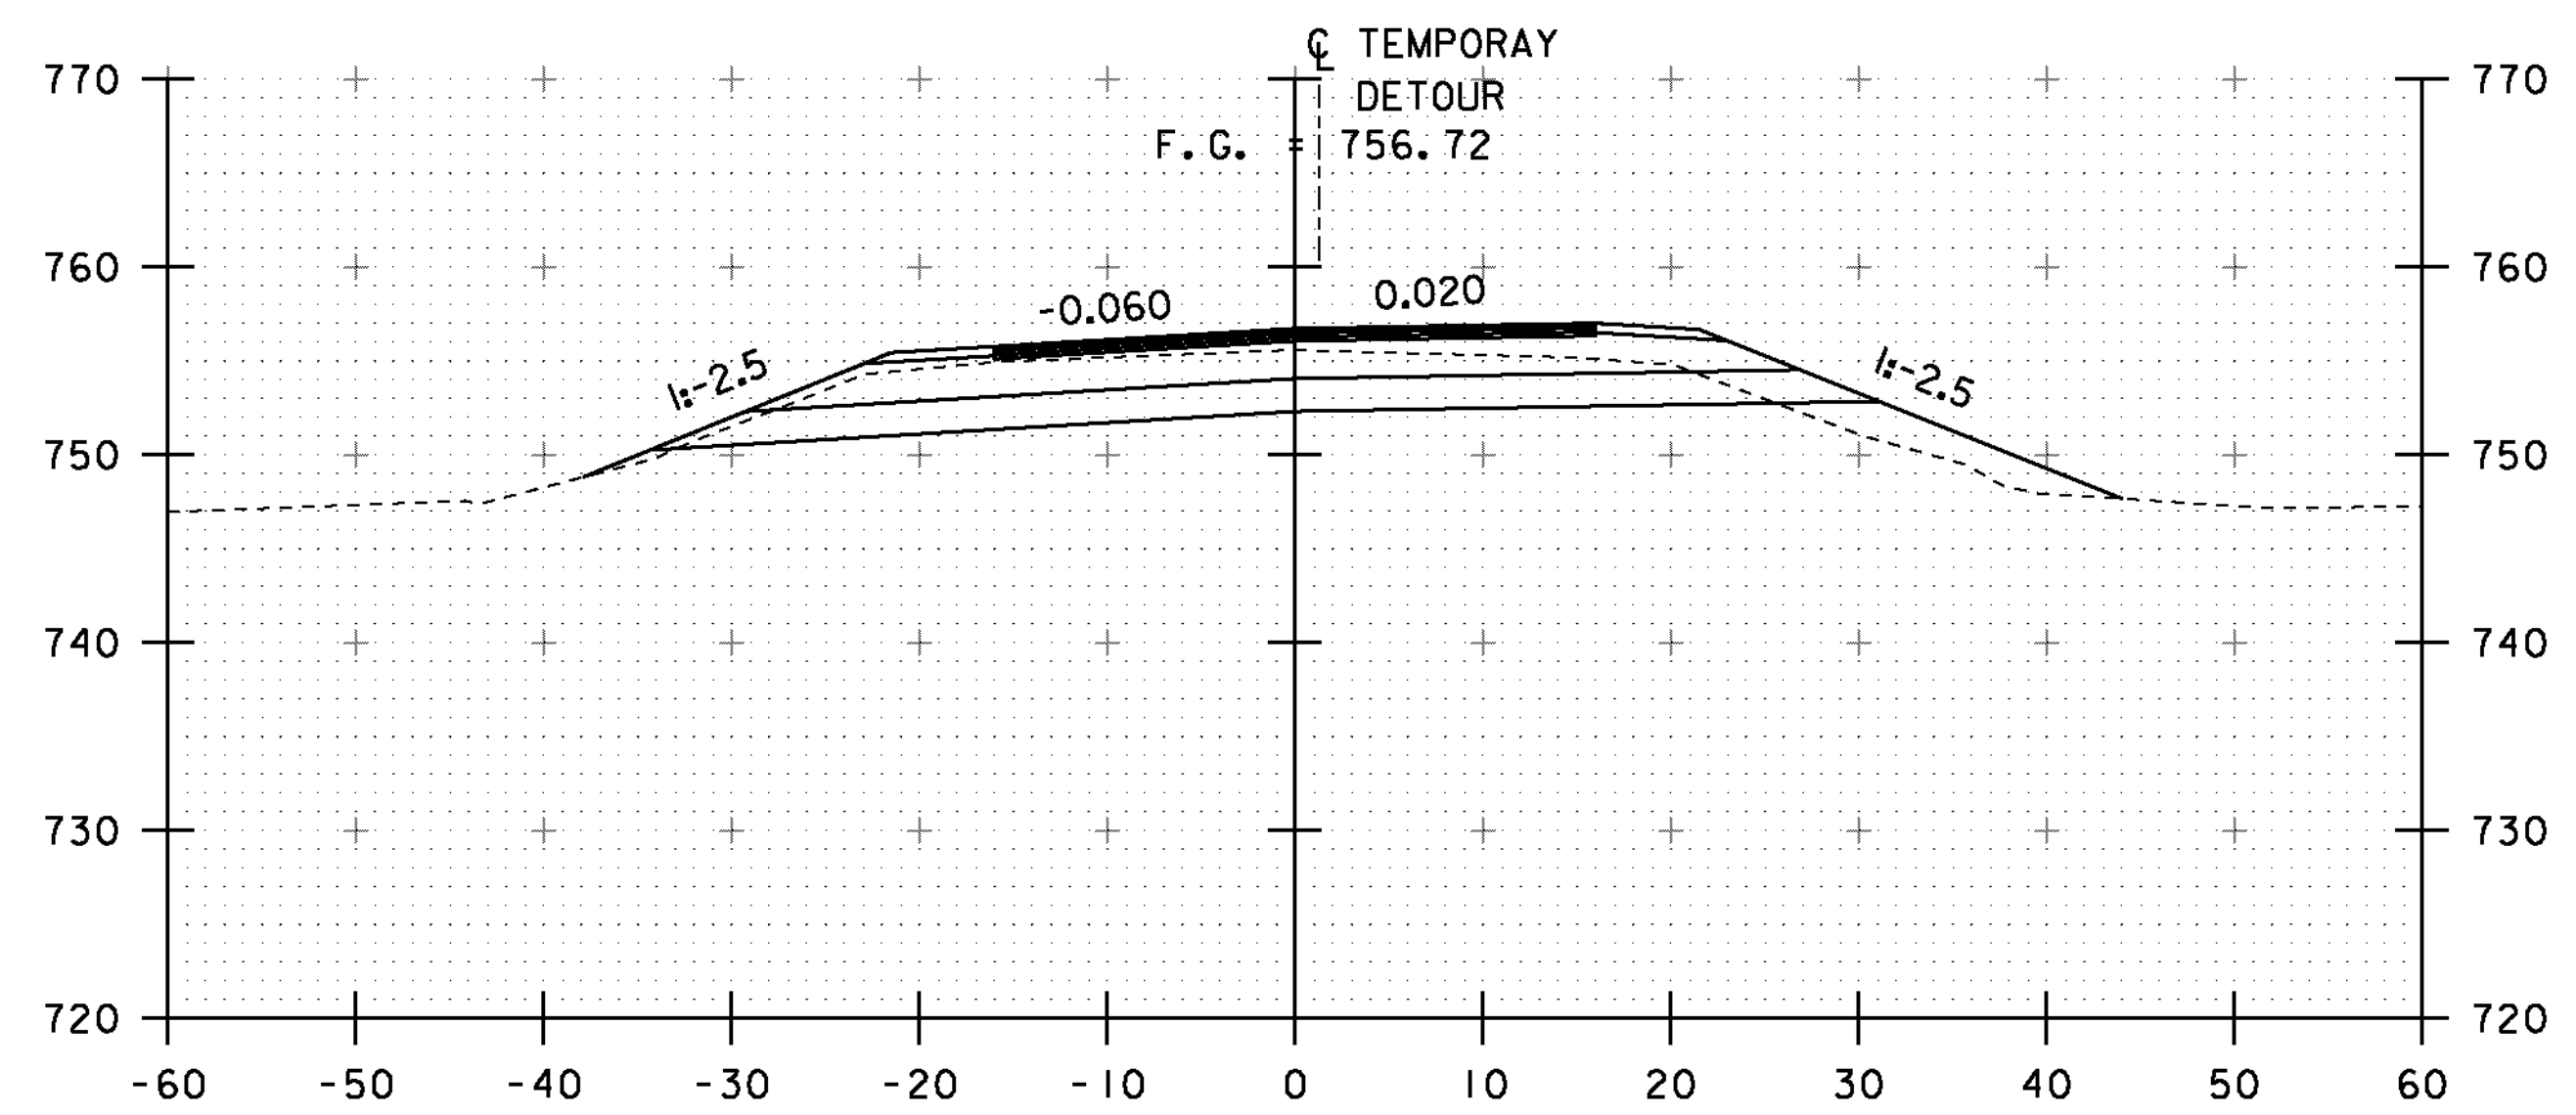


381+75

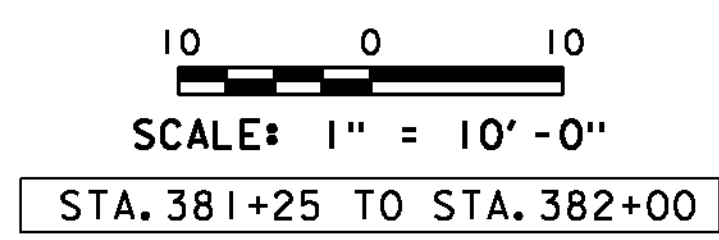

PROJECT NAME:	ST. JOHNSBURY	PLOT DATE:	28-AUG-2012
PROJECT NUMBER:	BRF 028-4(25)S	DRAWN BY:	C. MOONEY
FILE NAME:	s98b320xsl.dgn	CHECKED BY:	C. CARLSON
PROJECT LEADER:	C. CARLSON	ROADWAY CROSS SECTIONS	7
DESIGNED BY:	H. SALLS	SHEET	37 OF 62

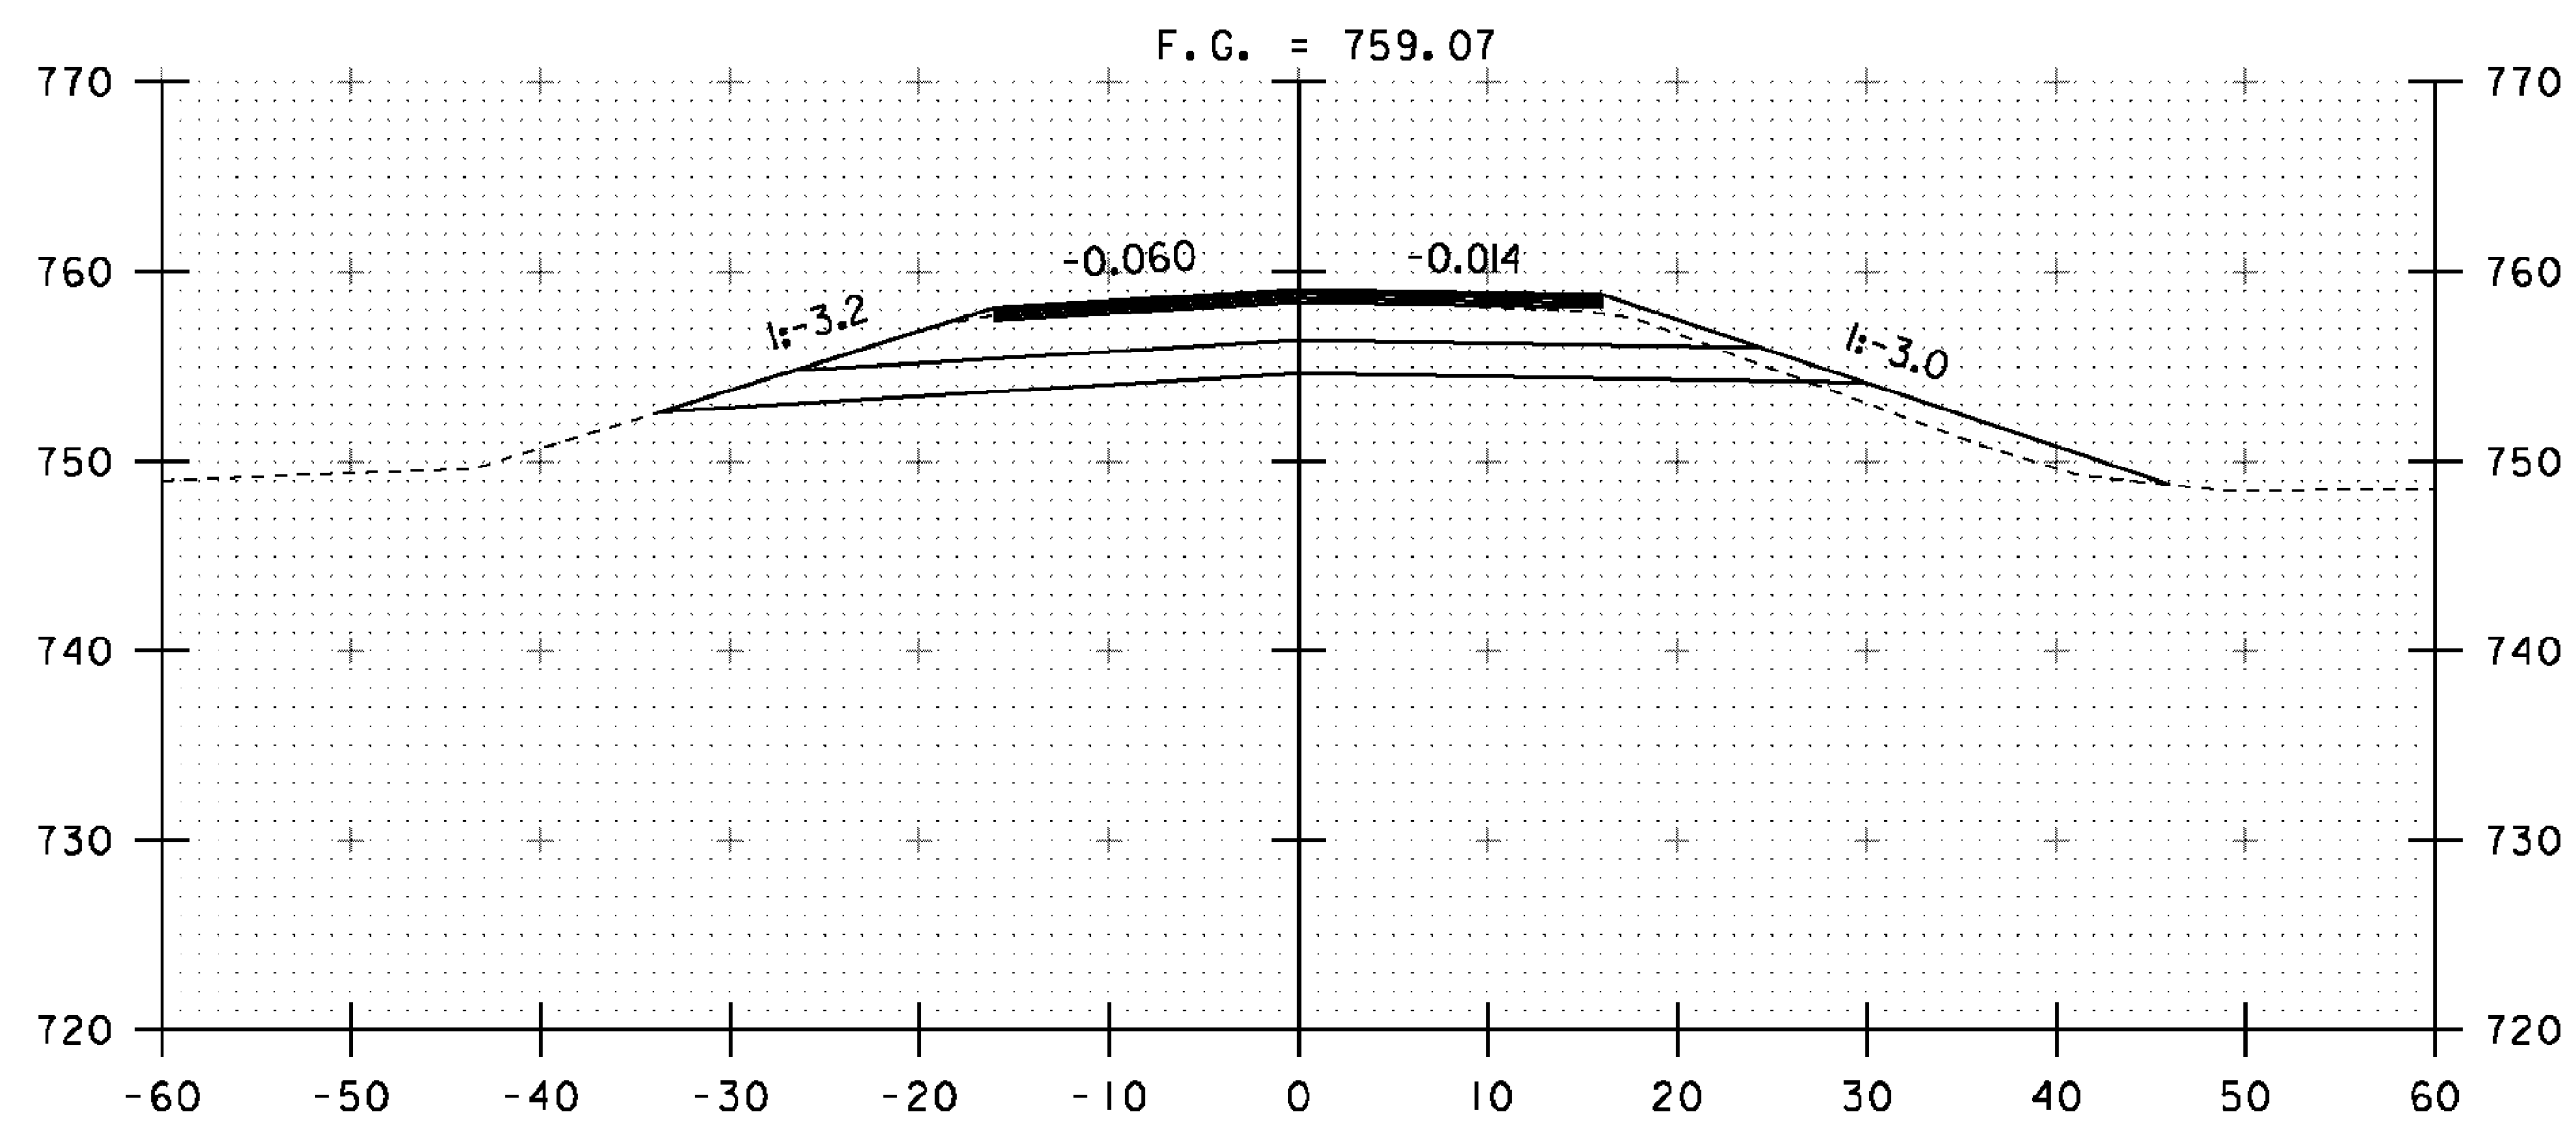


382+50

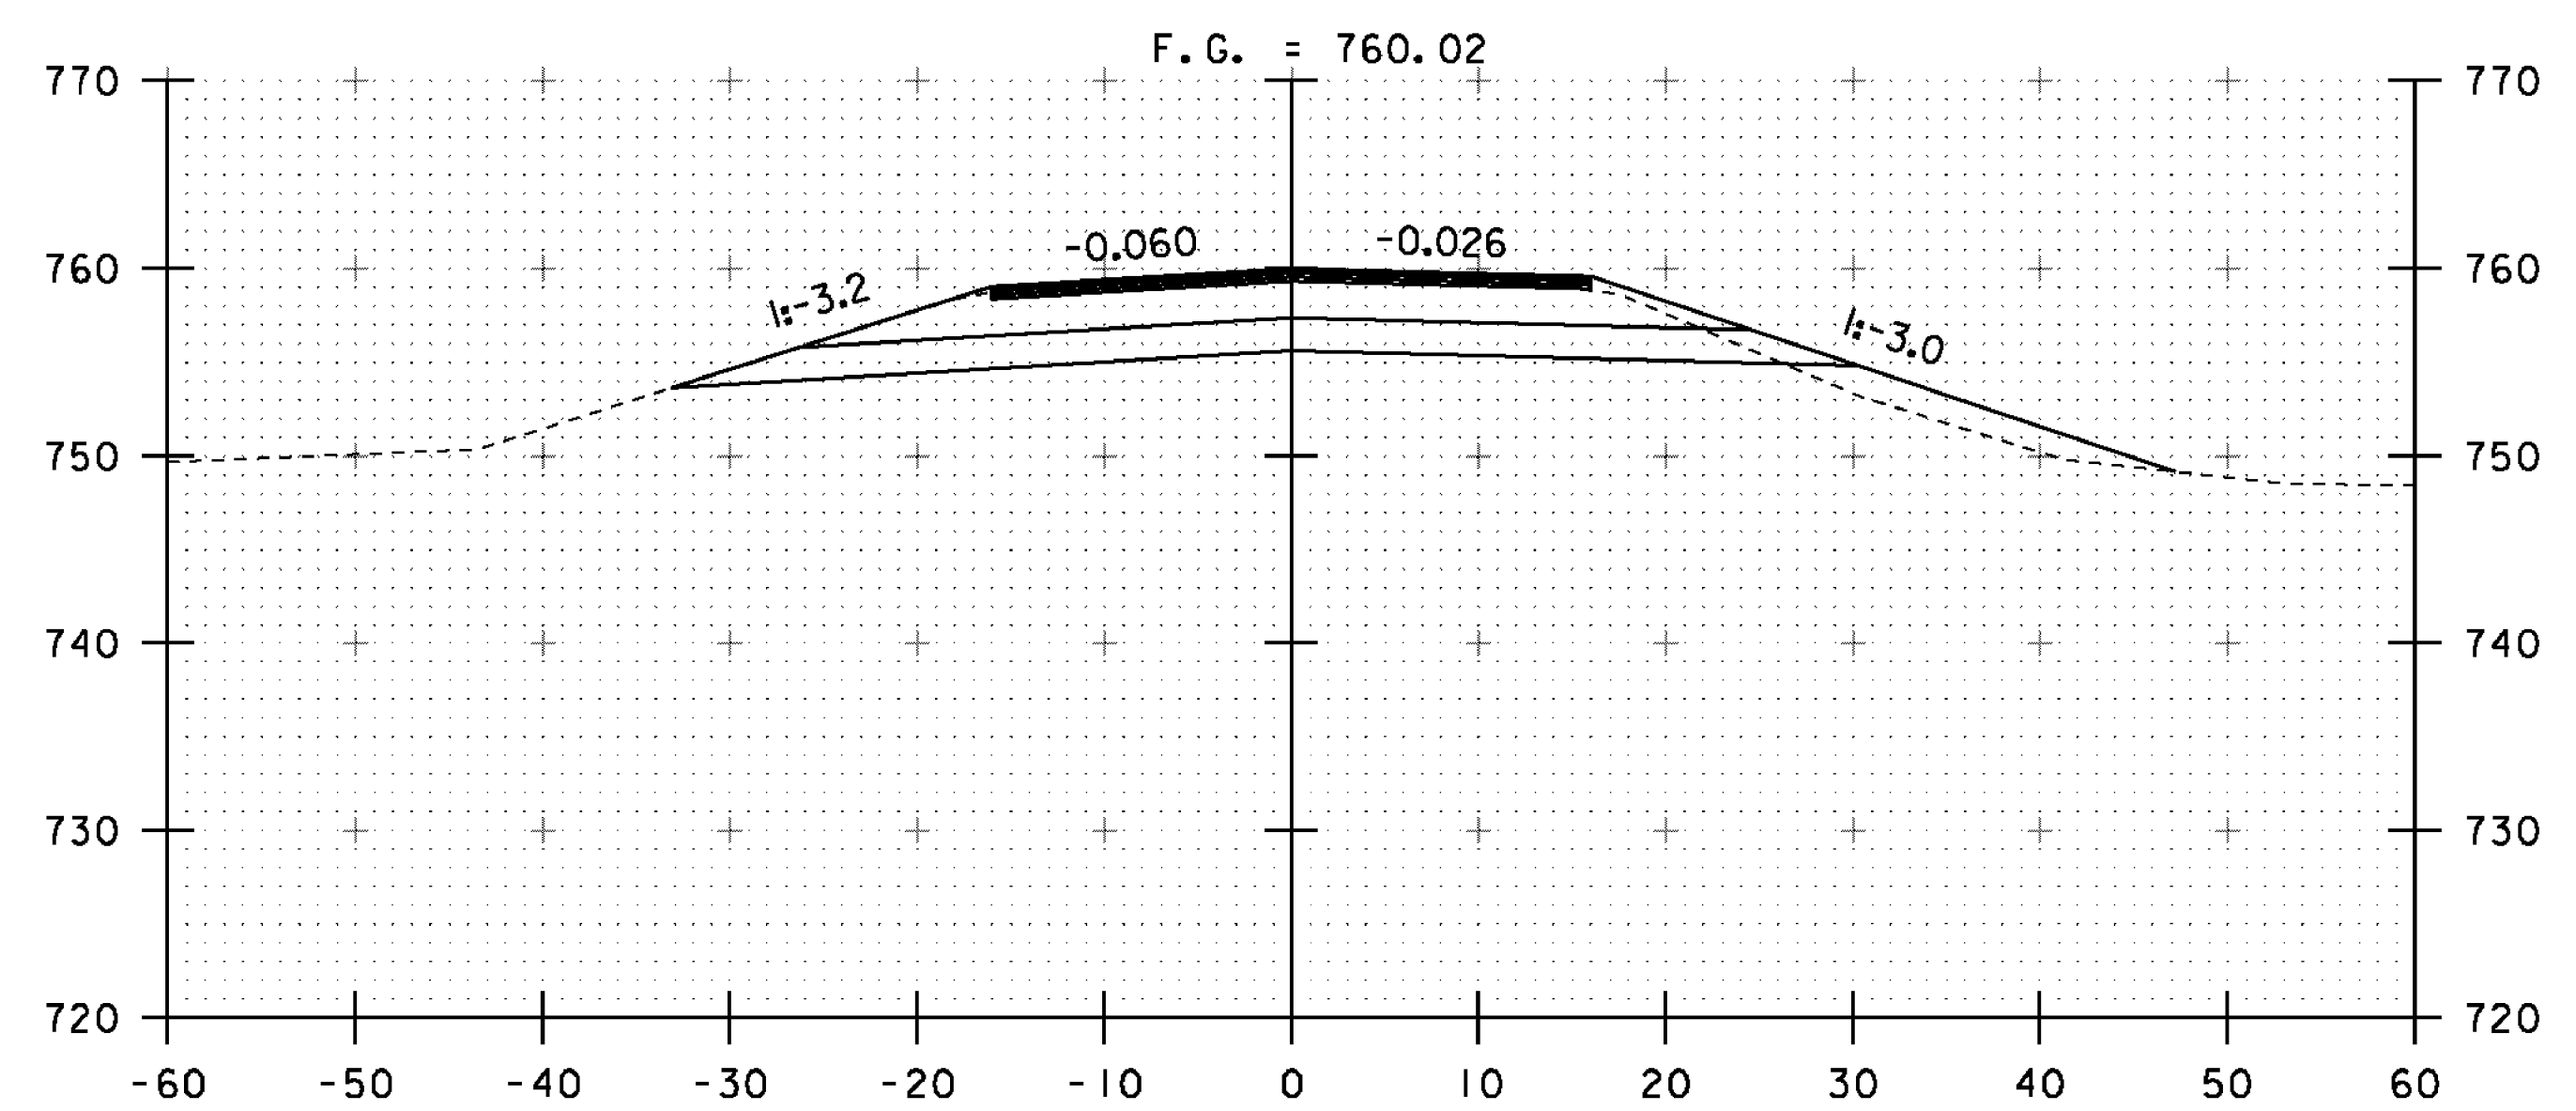


STA. 382+75.00
END PROJECT


382+75

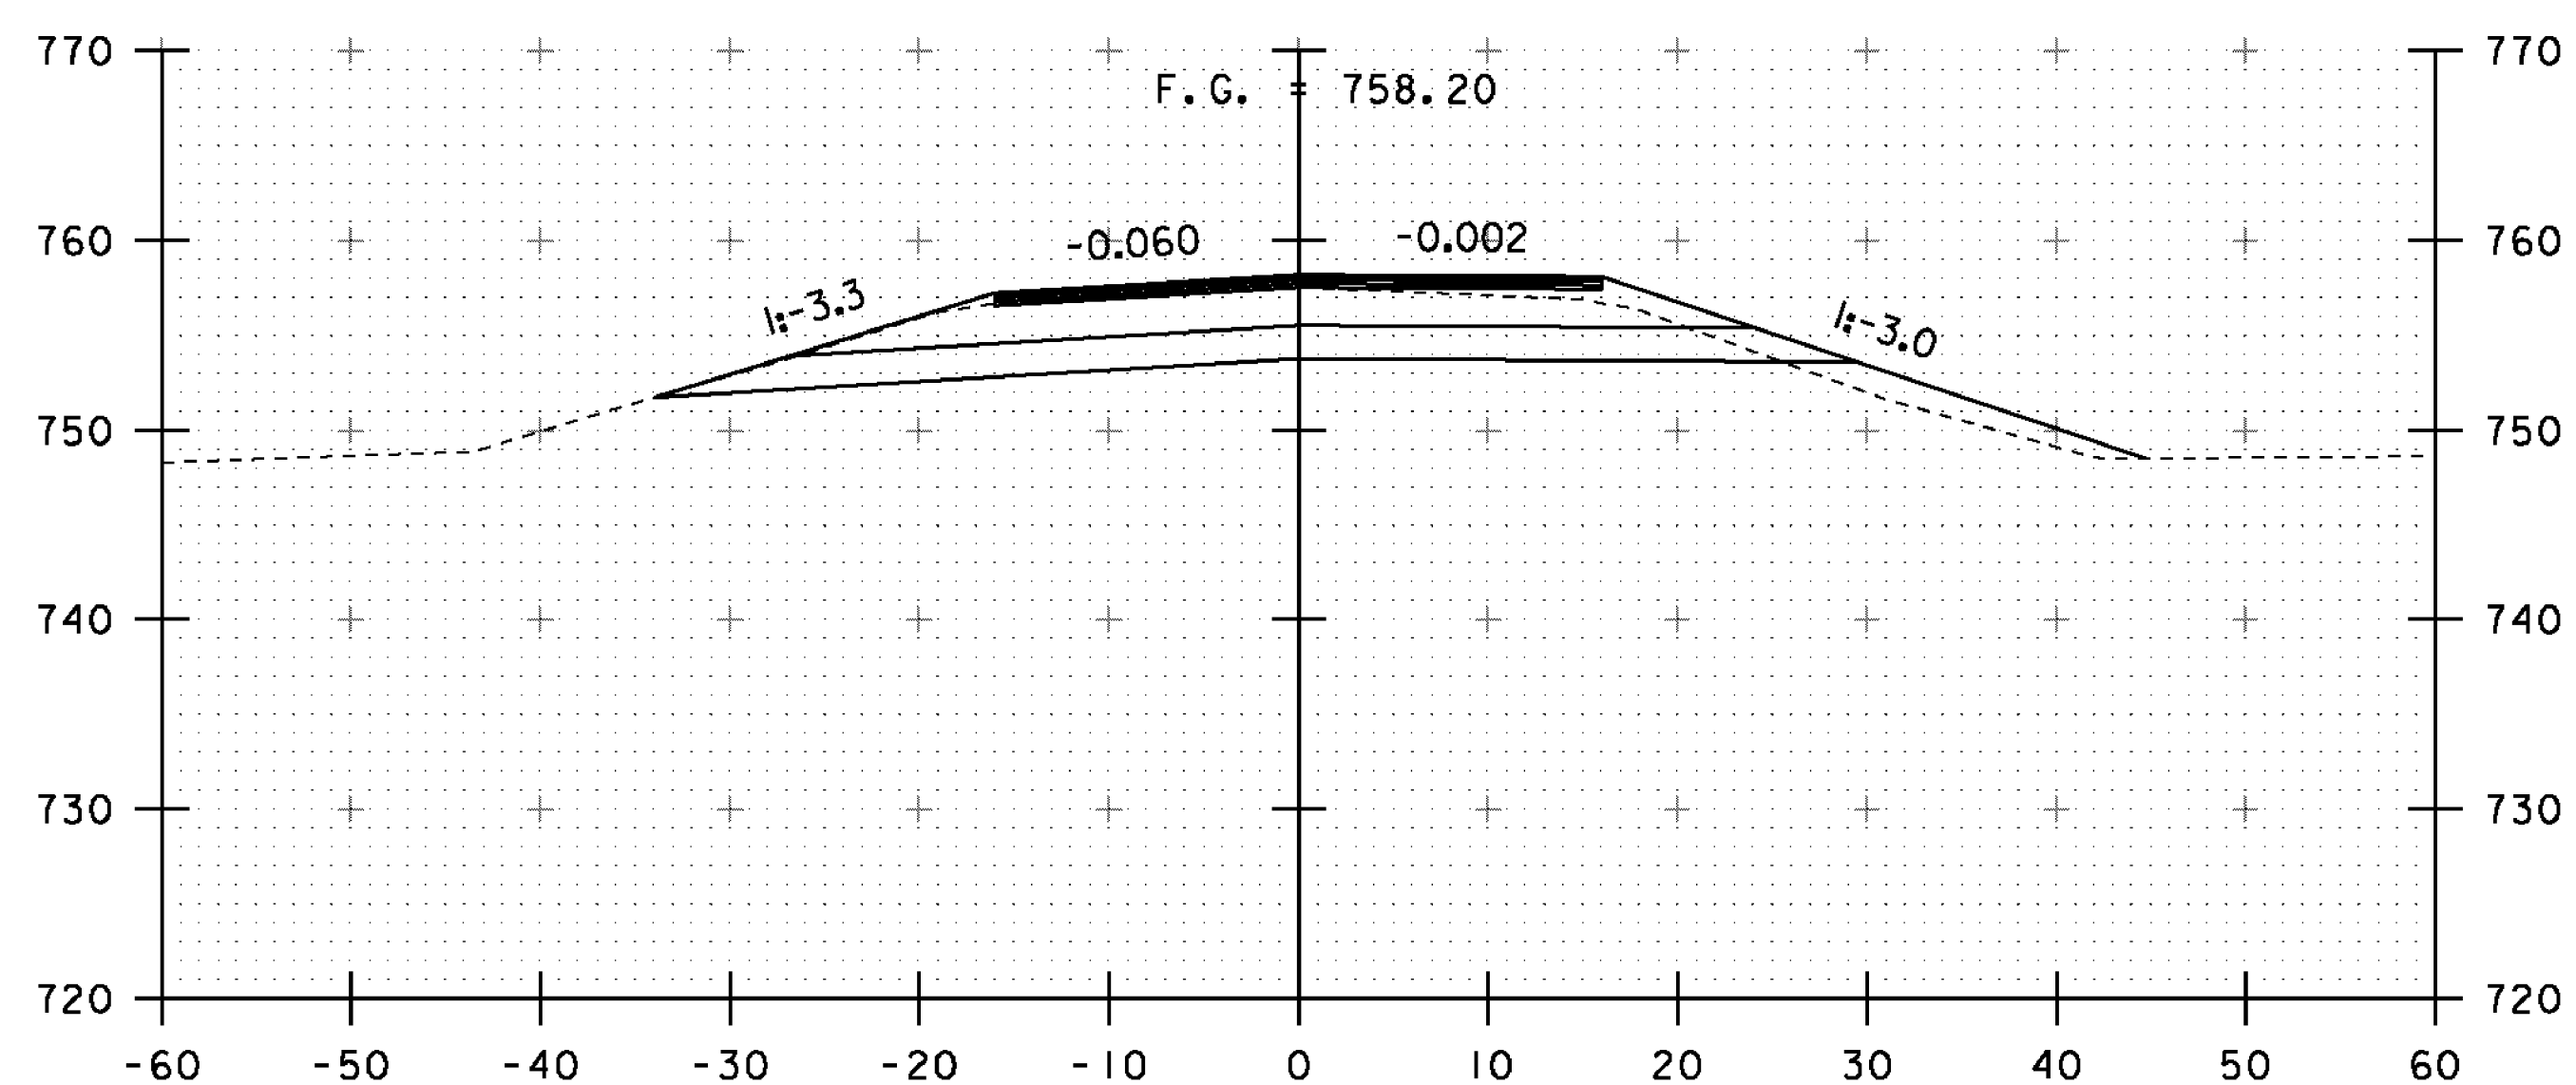





382+25

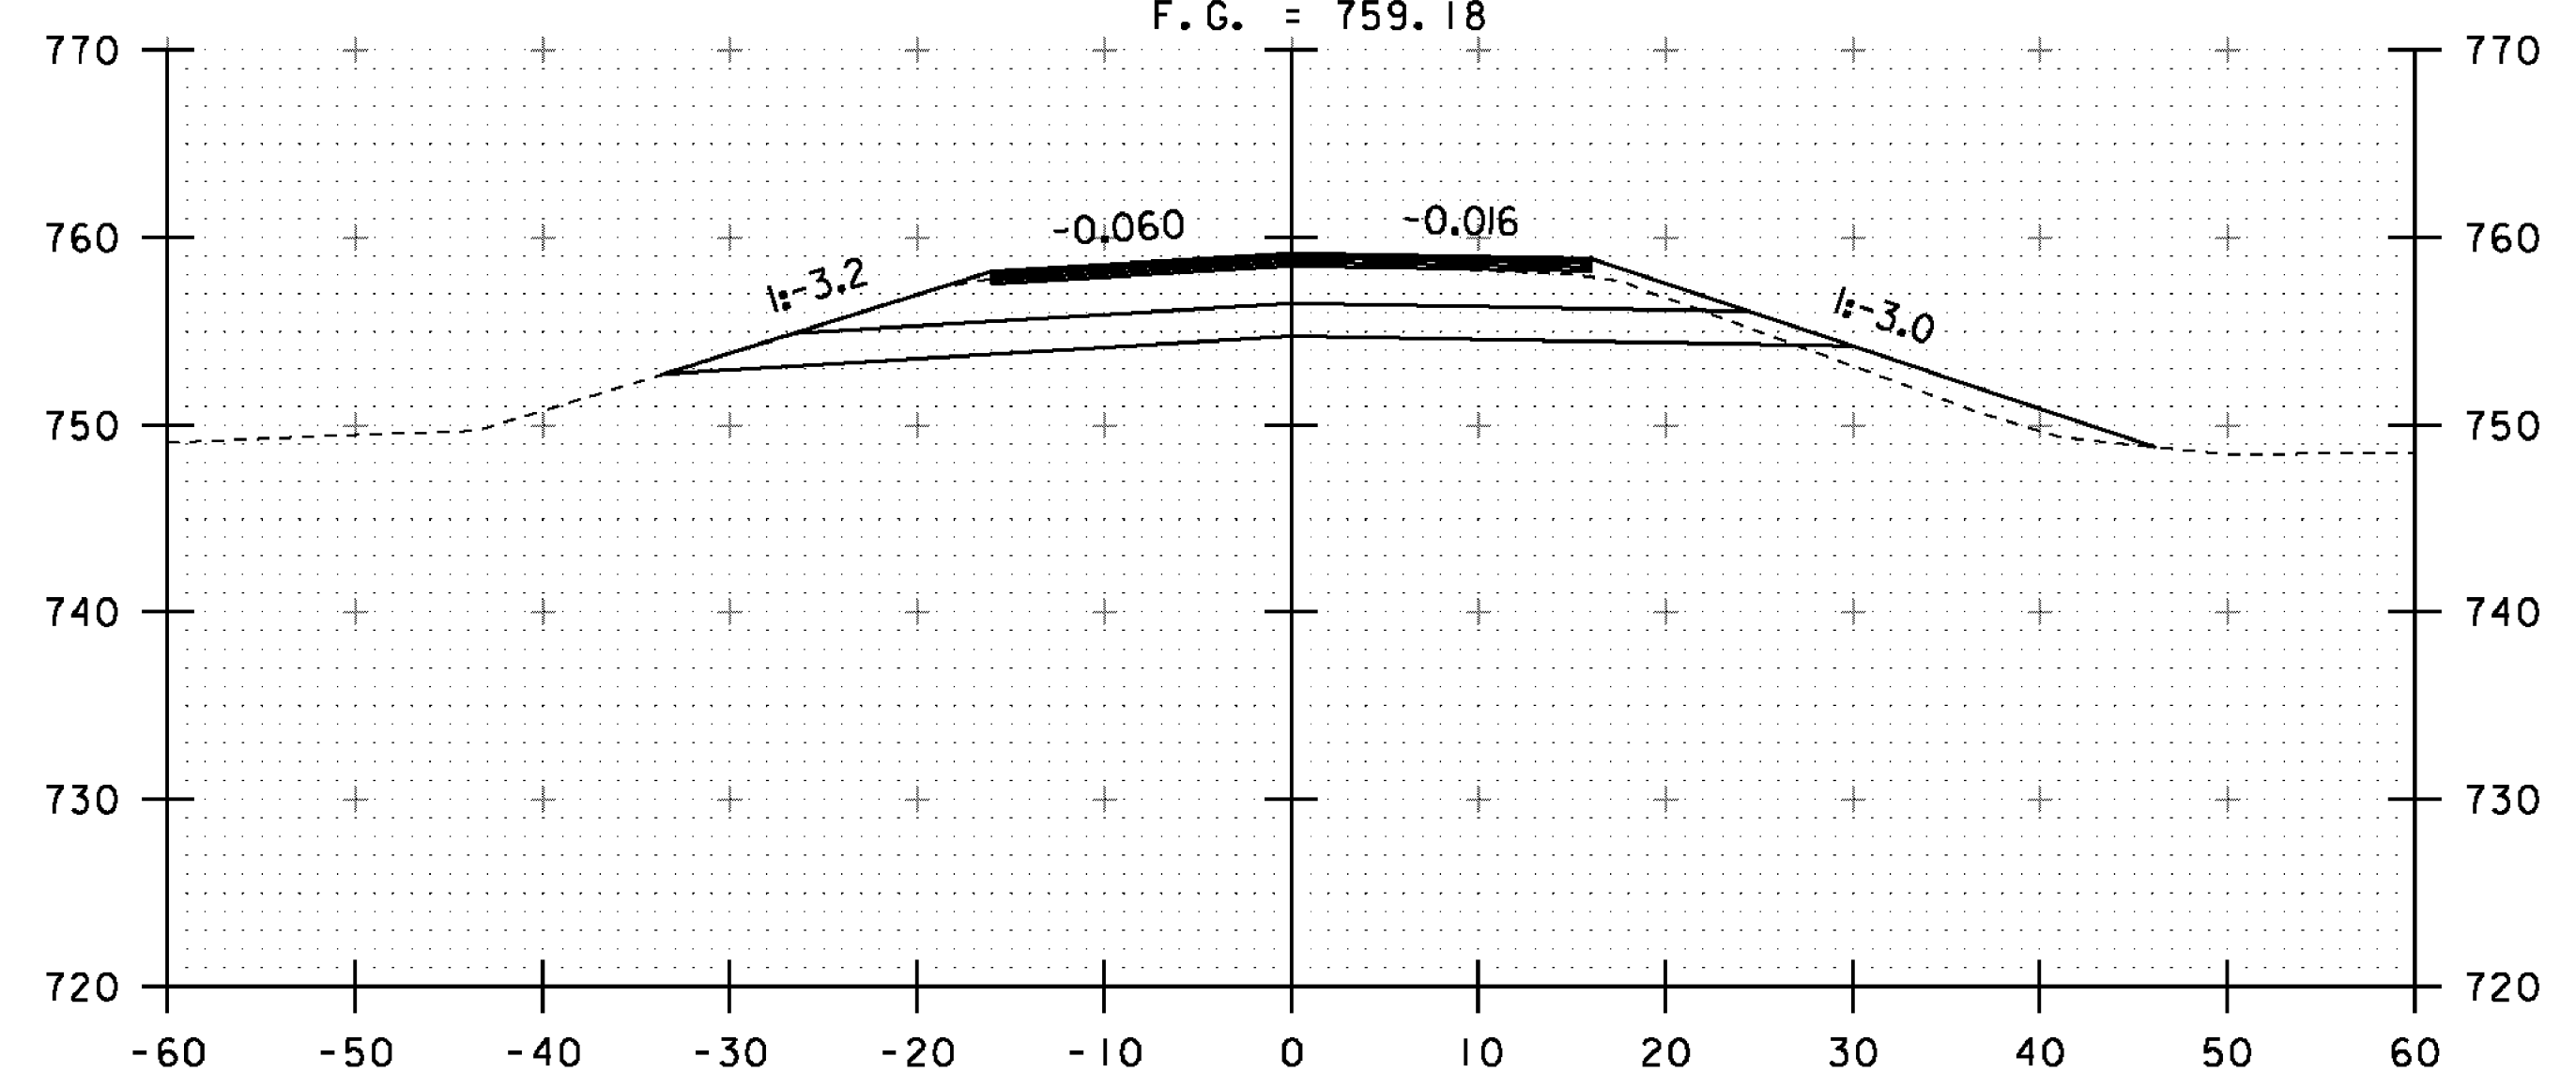

382+53

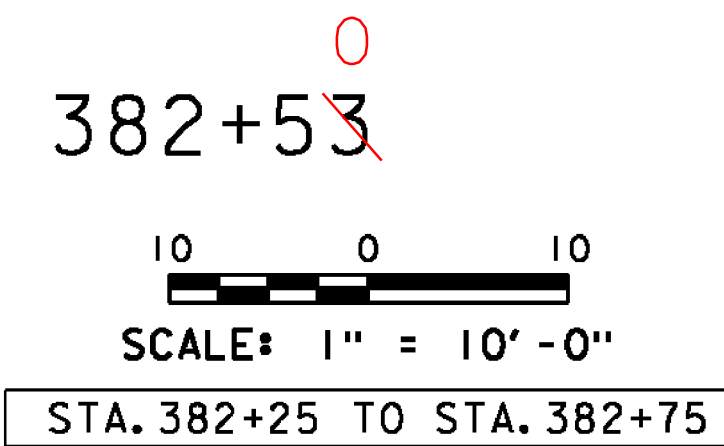


PROJECT NAME:	ST. JOHNSBURY	PLOT DATE:	28-AUG-2012
PROJECT NUMBER:	BRF 028-4(25)S	DRAWN BY:	C. MOONEY
FILE NAME:	s98b320xsl.dgn	DESIGNED BY:	H. SALLS
PROJECT LEADER:	C. CARLSON	CHECKED BY:	C. CARLSON
ROADWAY CROSS SECTIONS 8		SHEET	38 OF 62

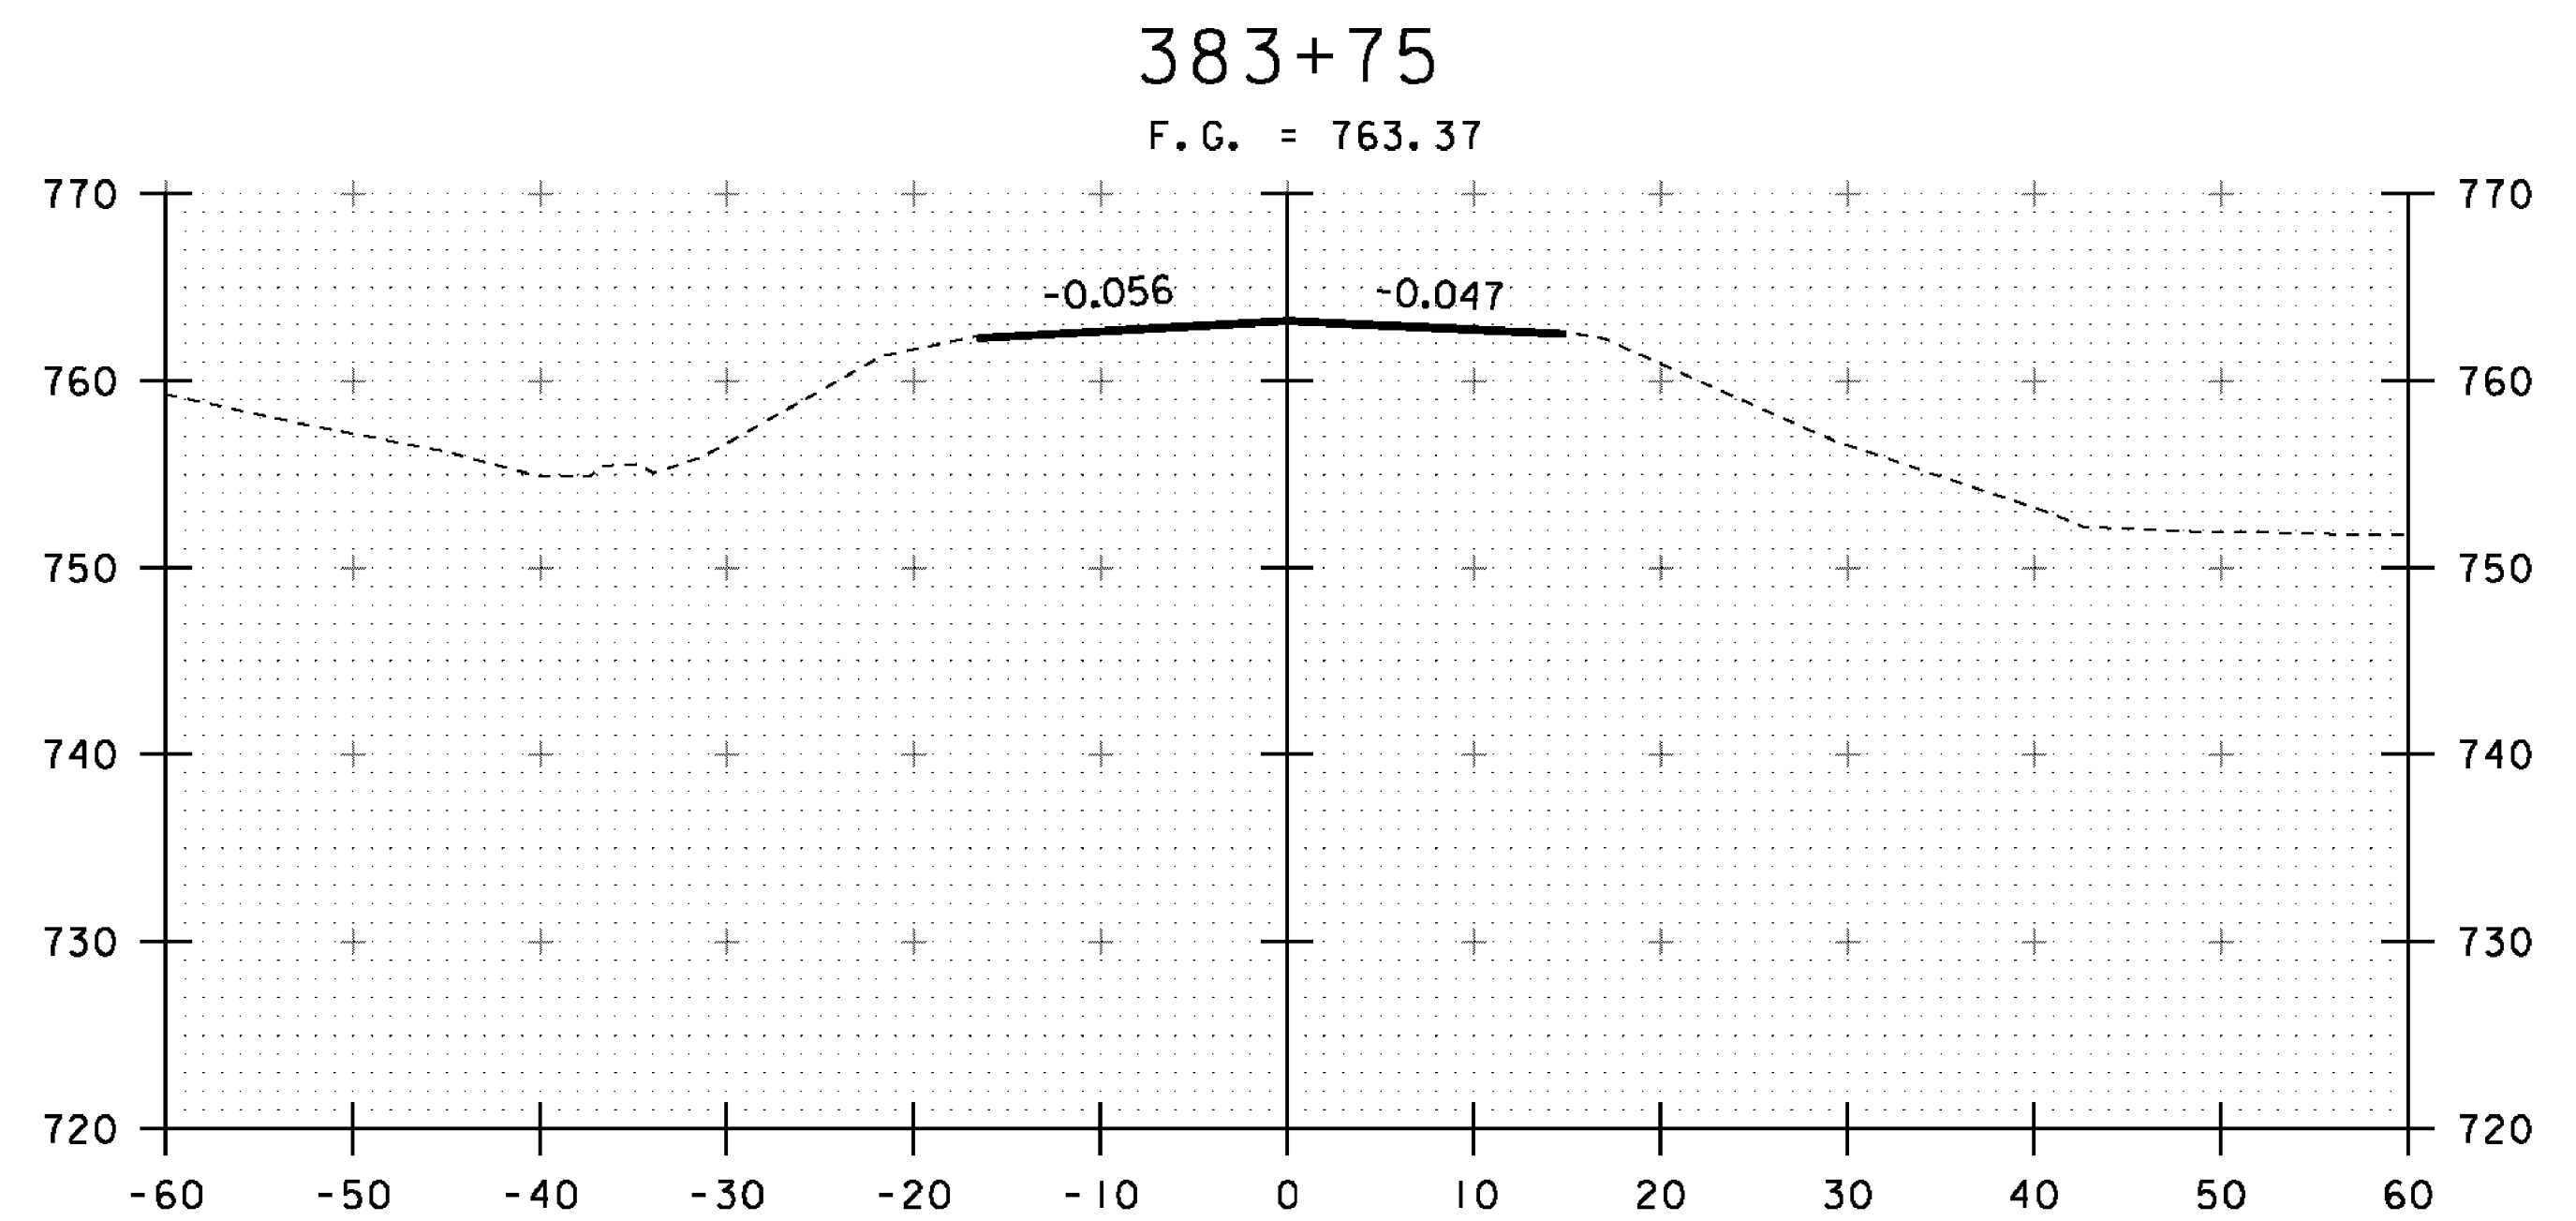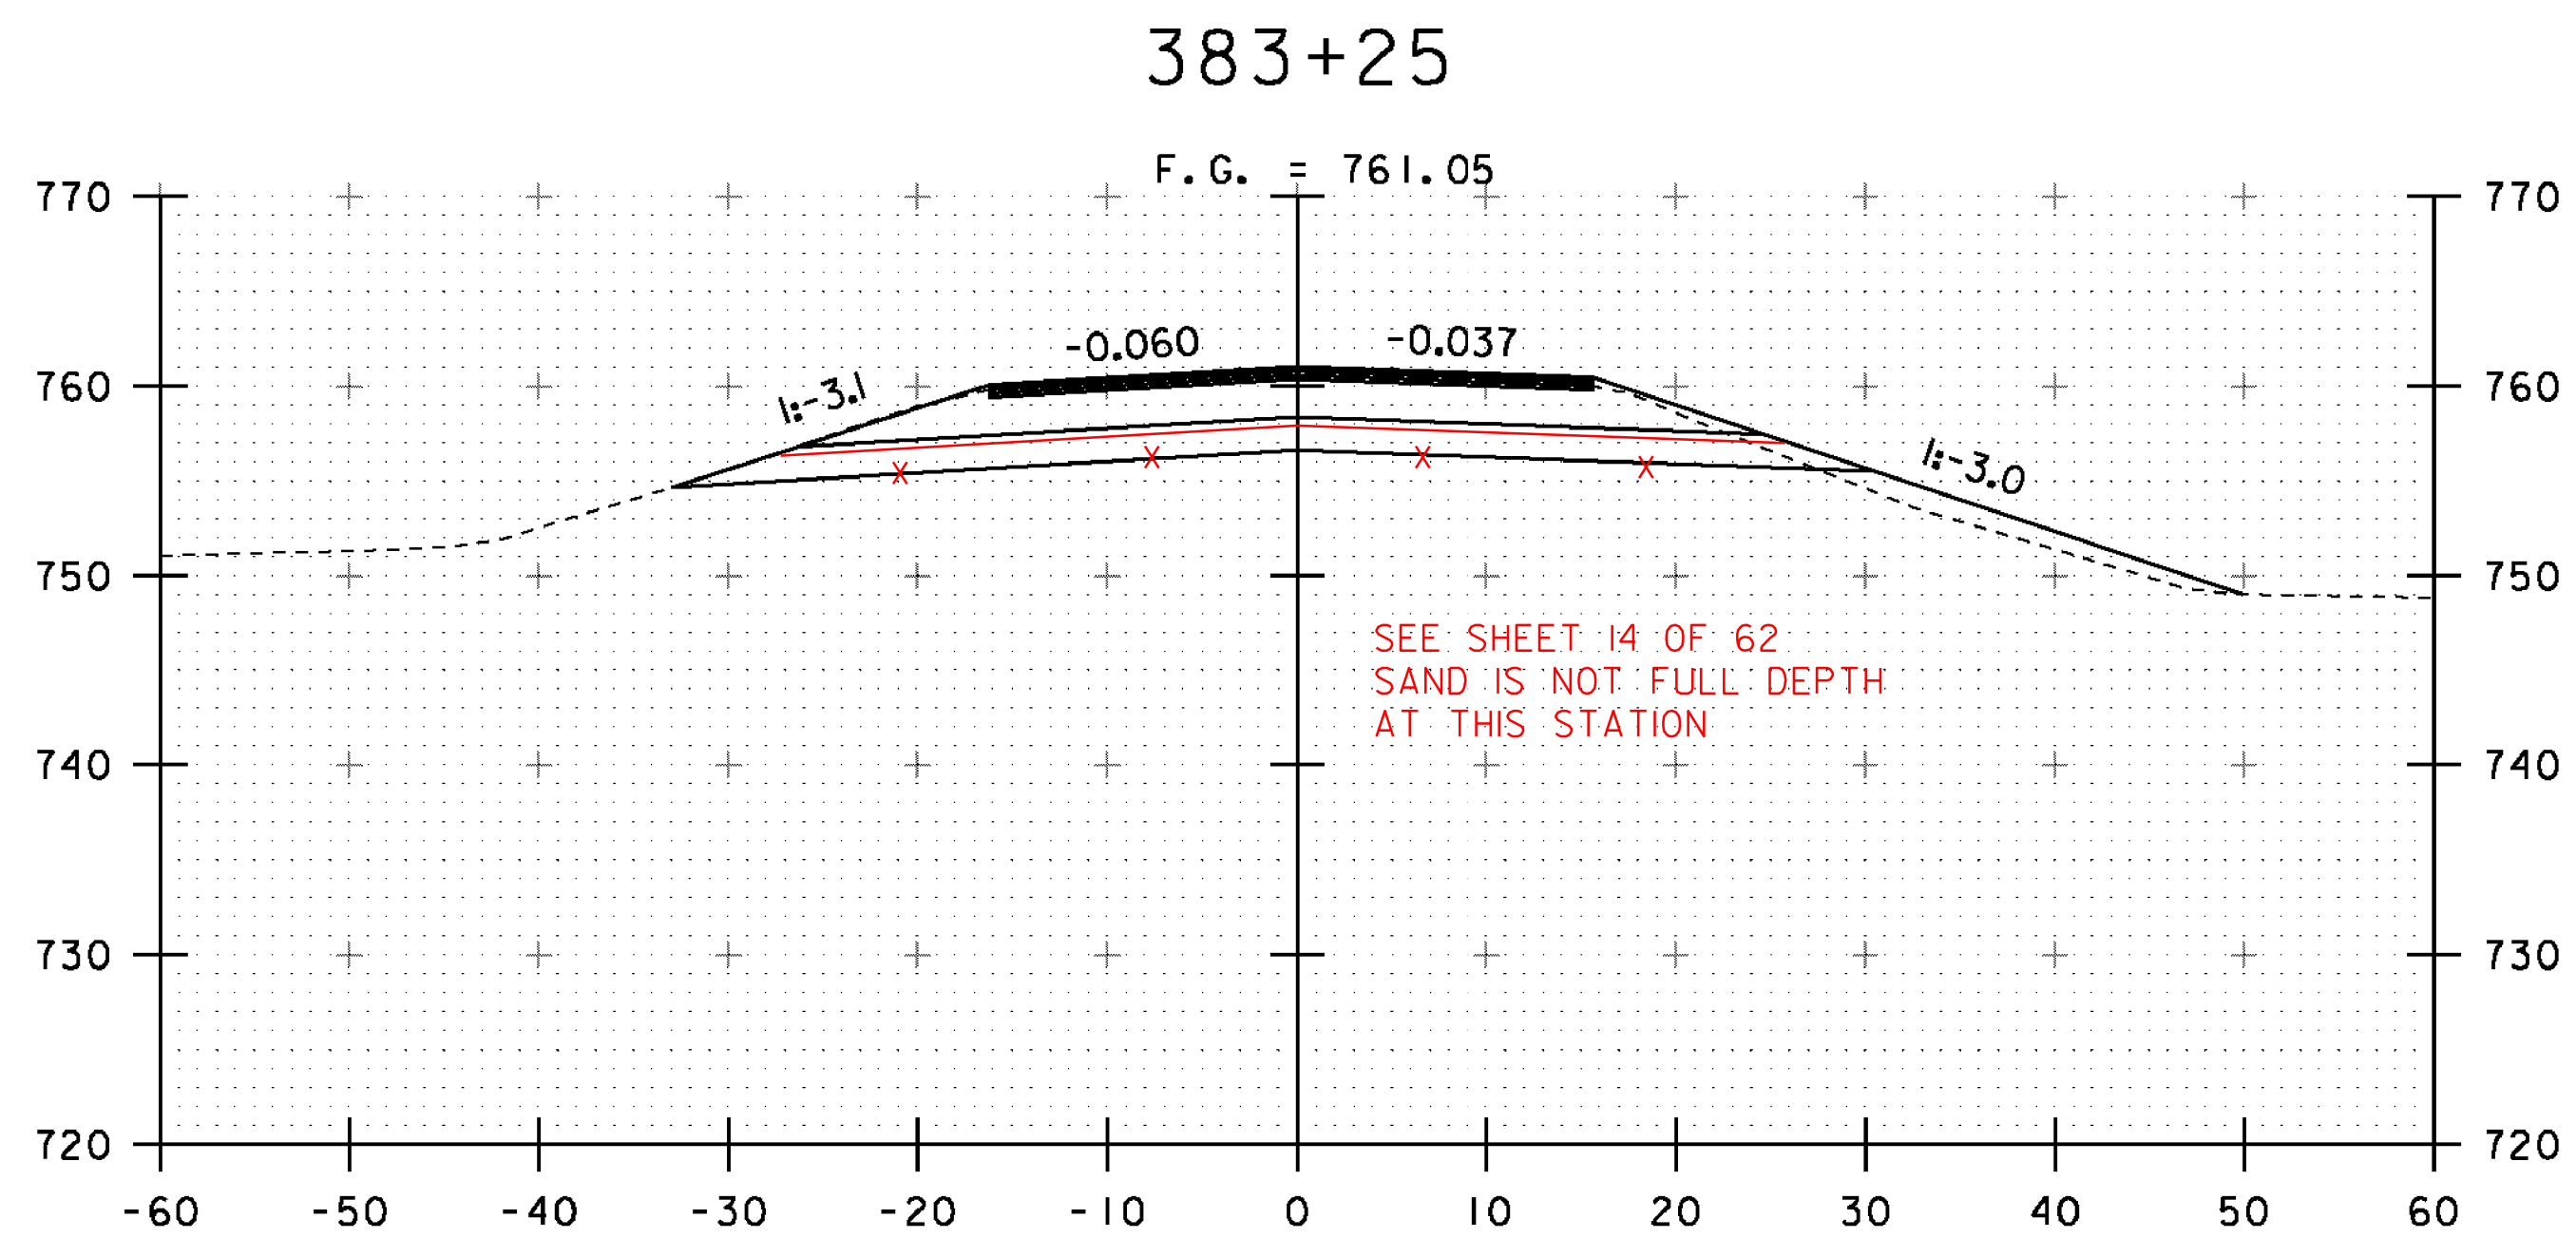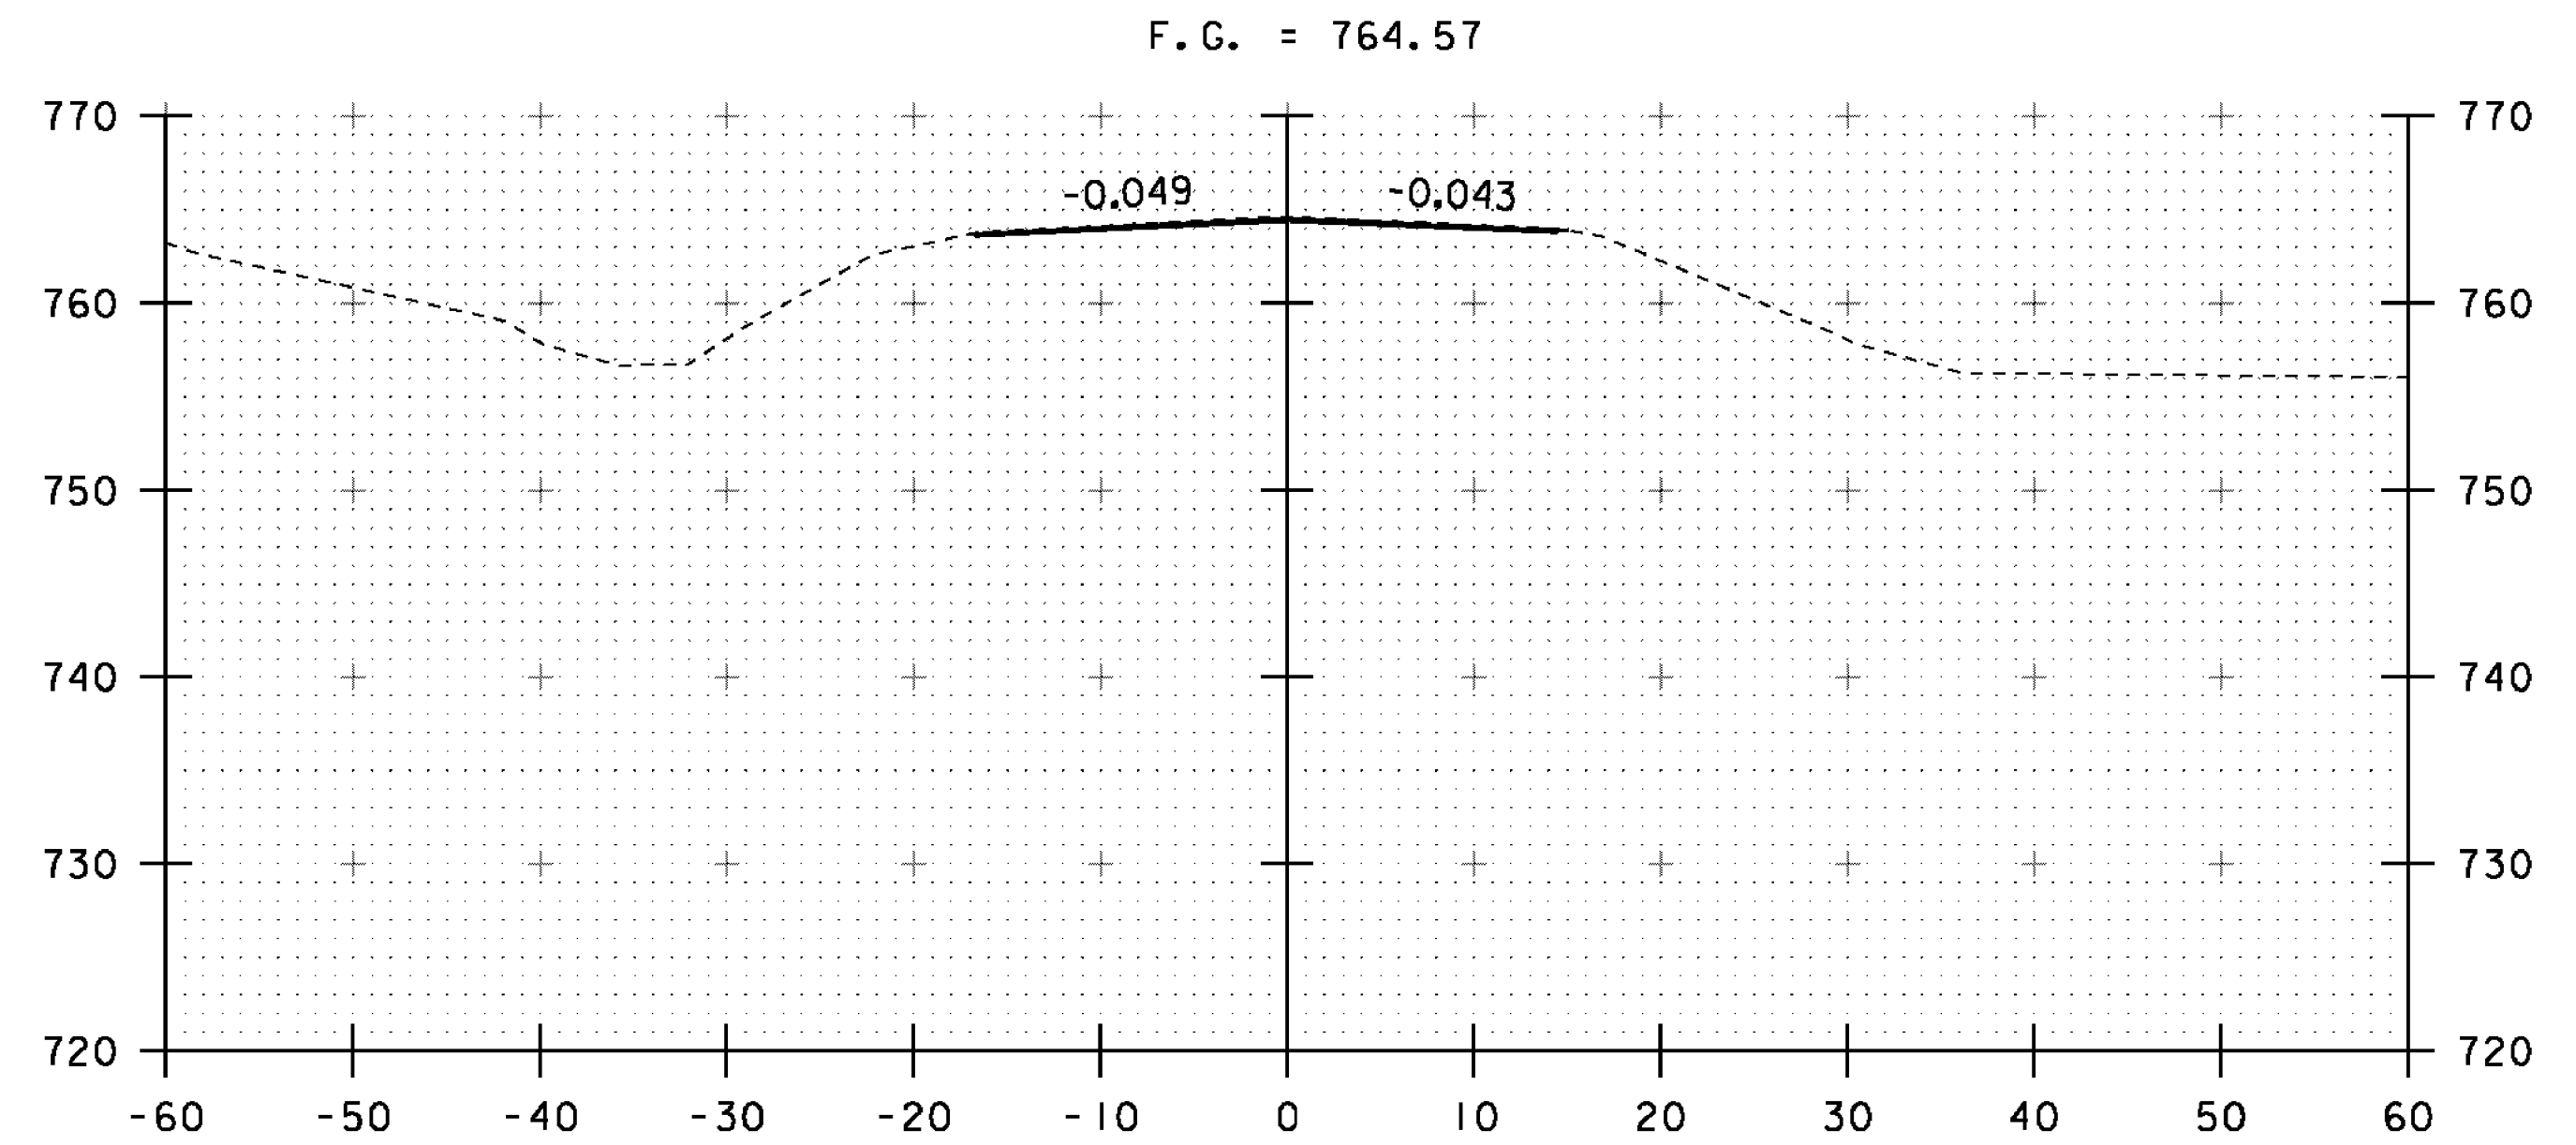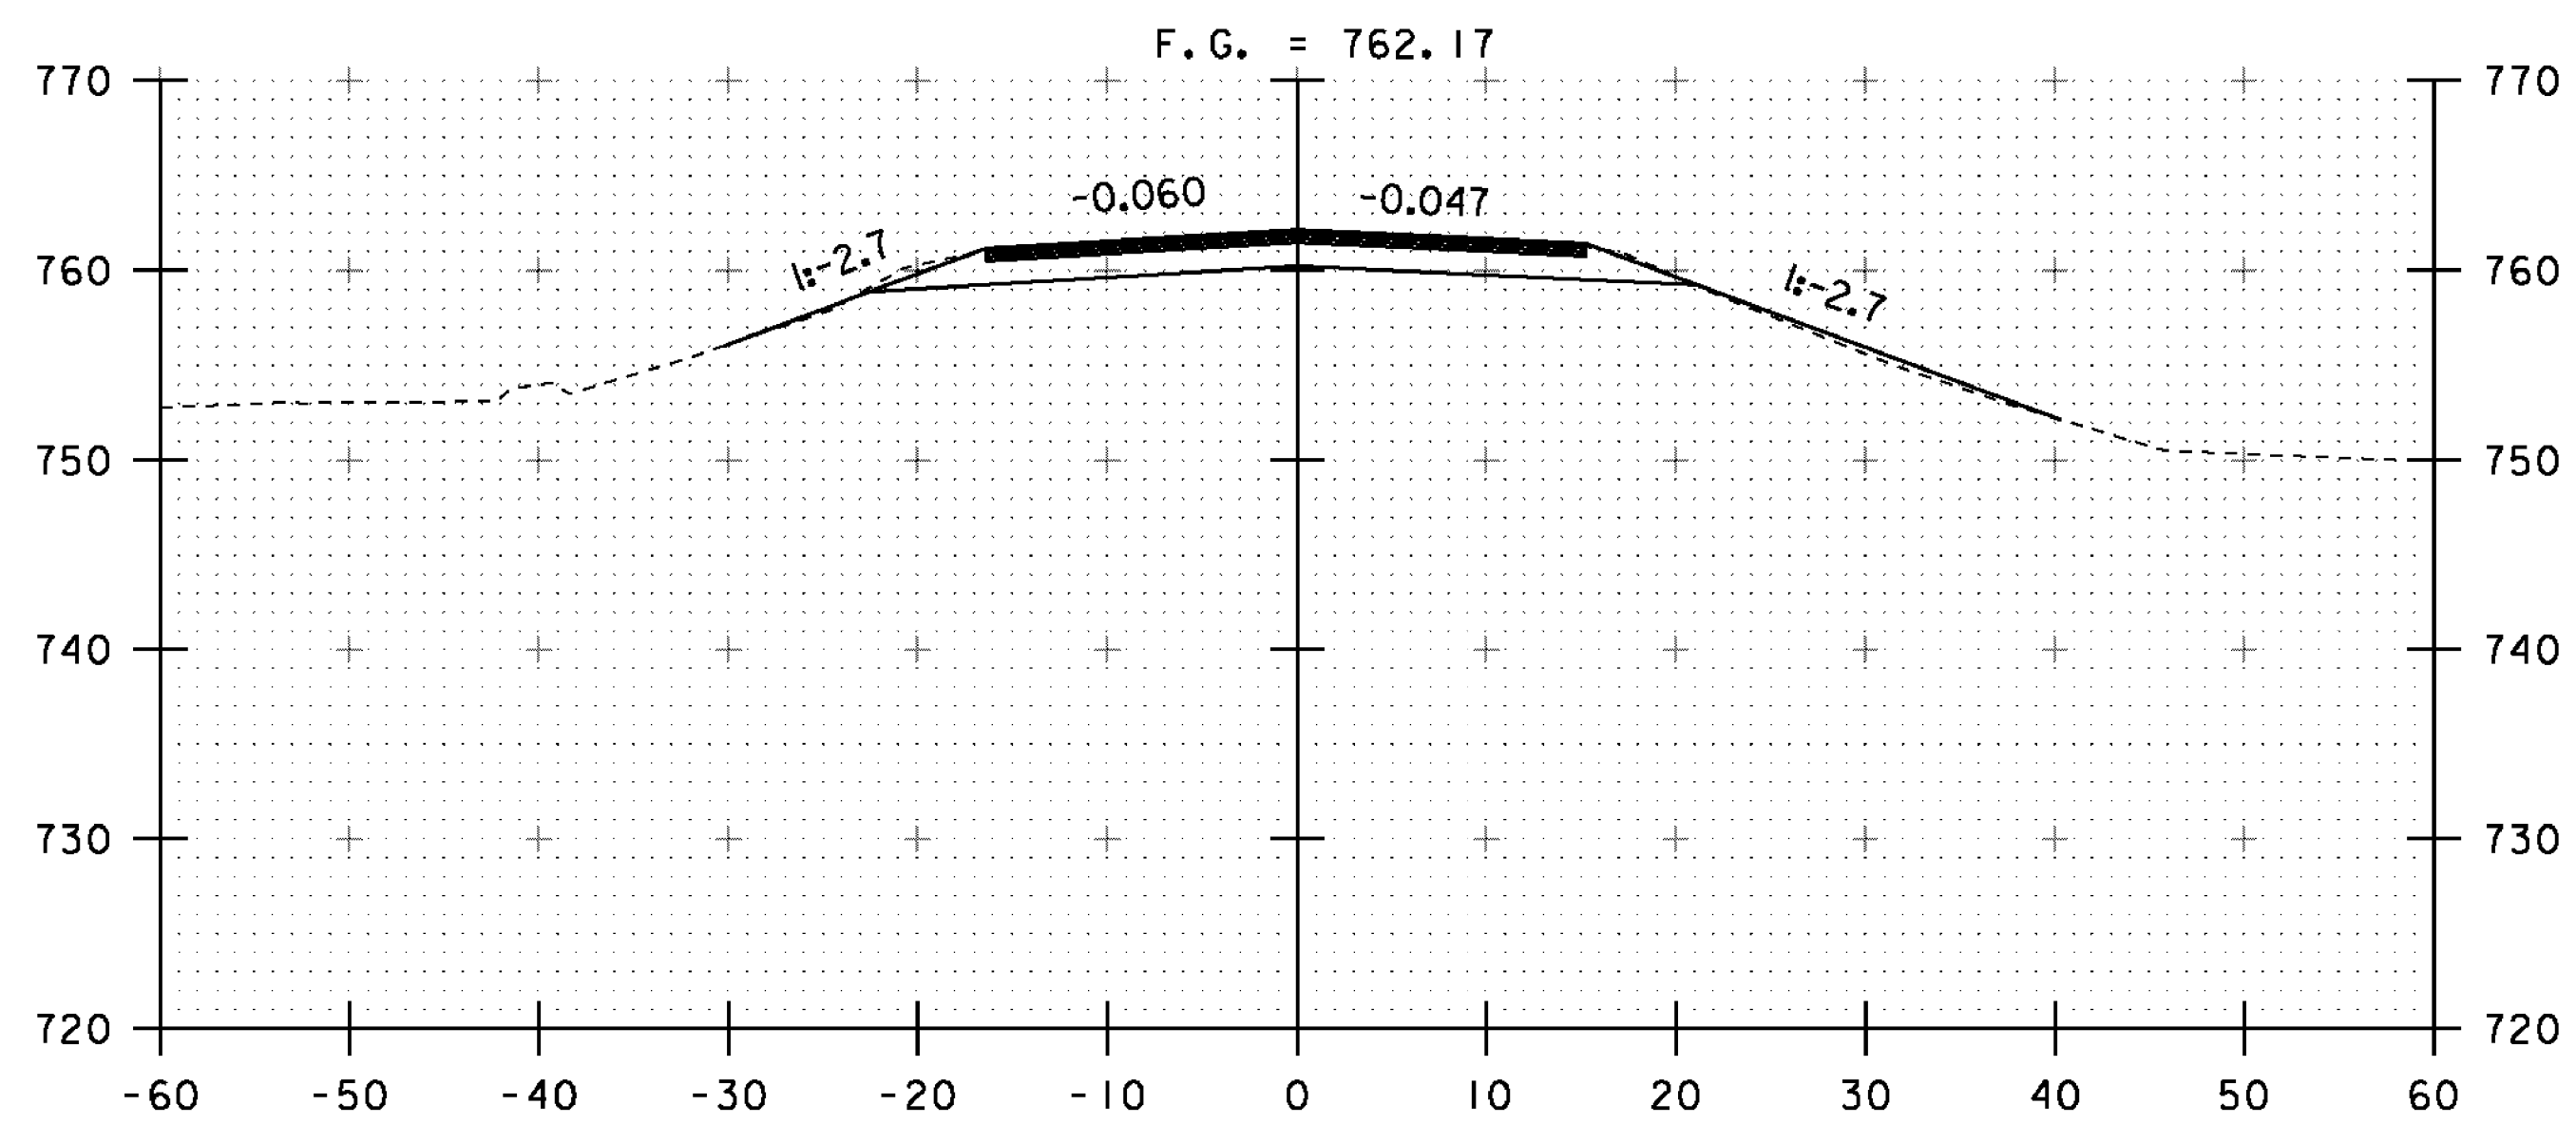

383+00


383+50

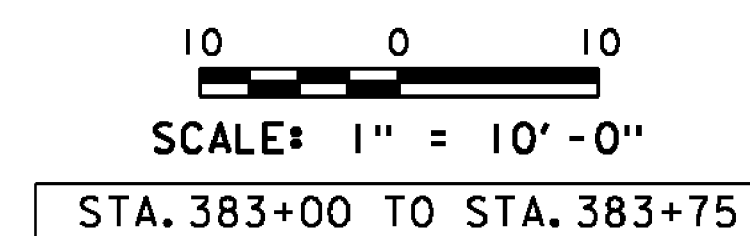

PROJECT NAME: ST. JOHNSBURY
PROJECT NUMBER: BRF 028-4(25)S

FILE NAME: s98b320xsl.dgn
PROJECT LEADER: C. CARLSON
DESIGNED BY: H. SALLS
ROADWAY CROSS SECTIONS 9

PLOT DATE: 28-AUG-2012
DRAWN BY: C. MOONEY
CHECKED BY: C. CARLSON
SHEET 39 OF 62

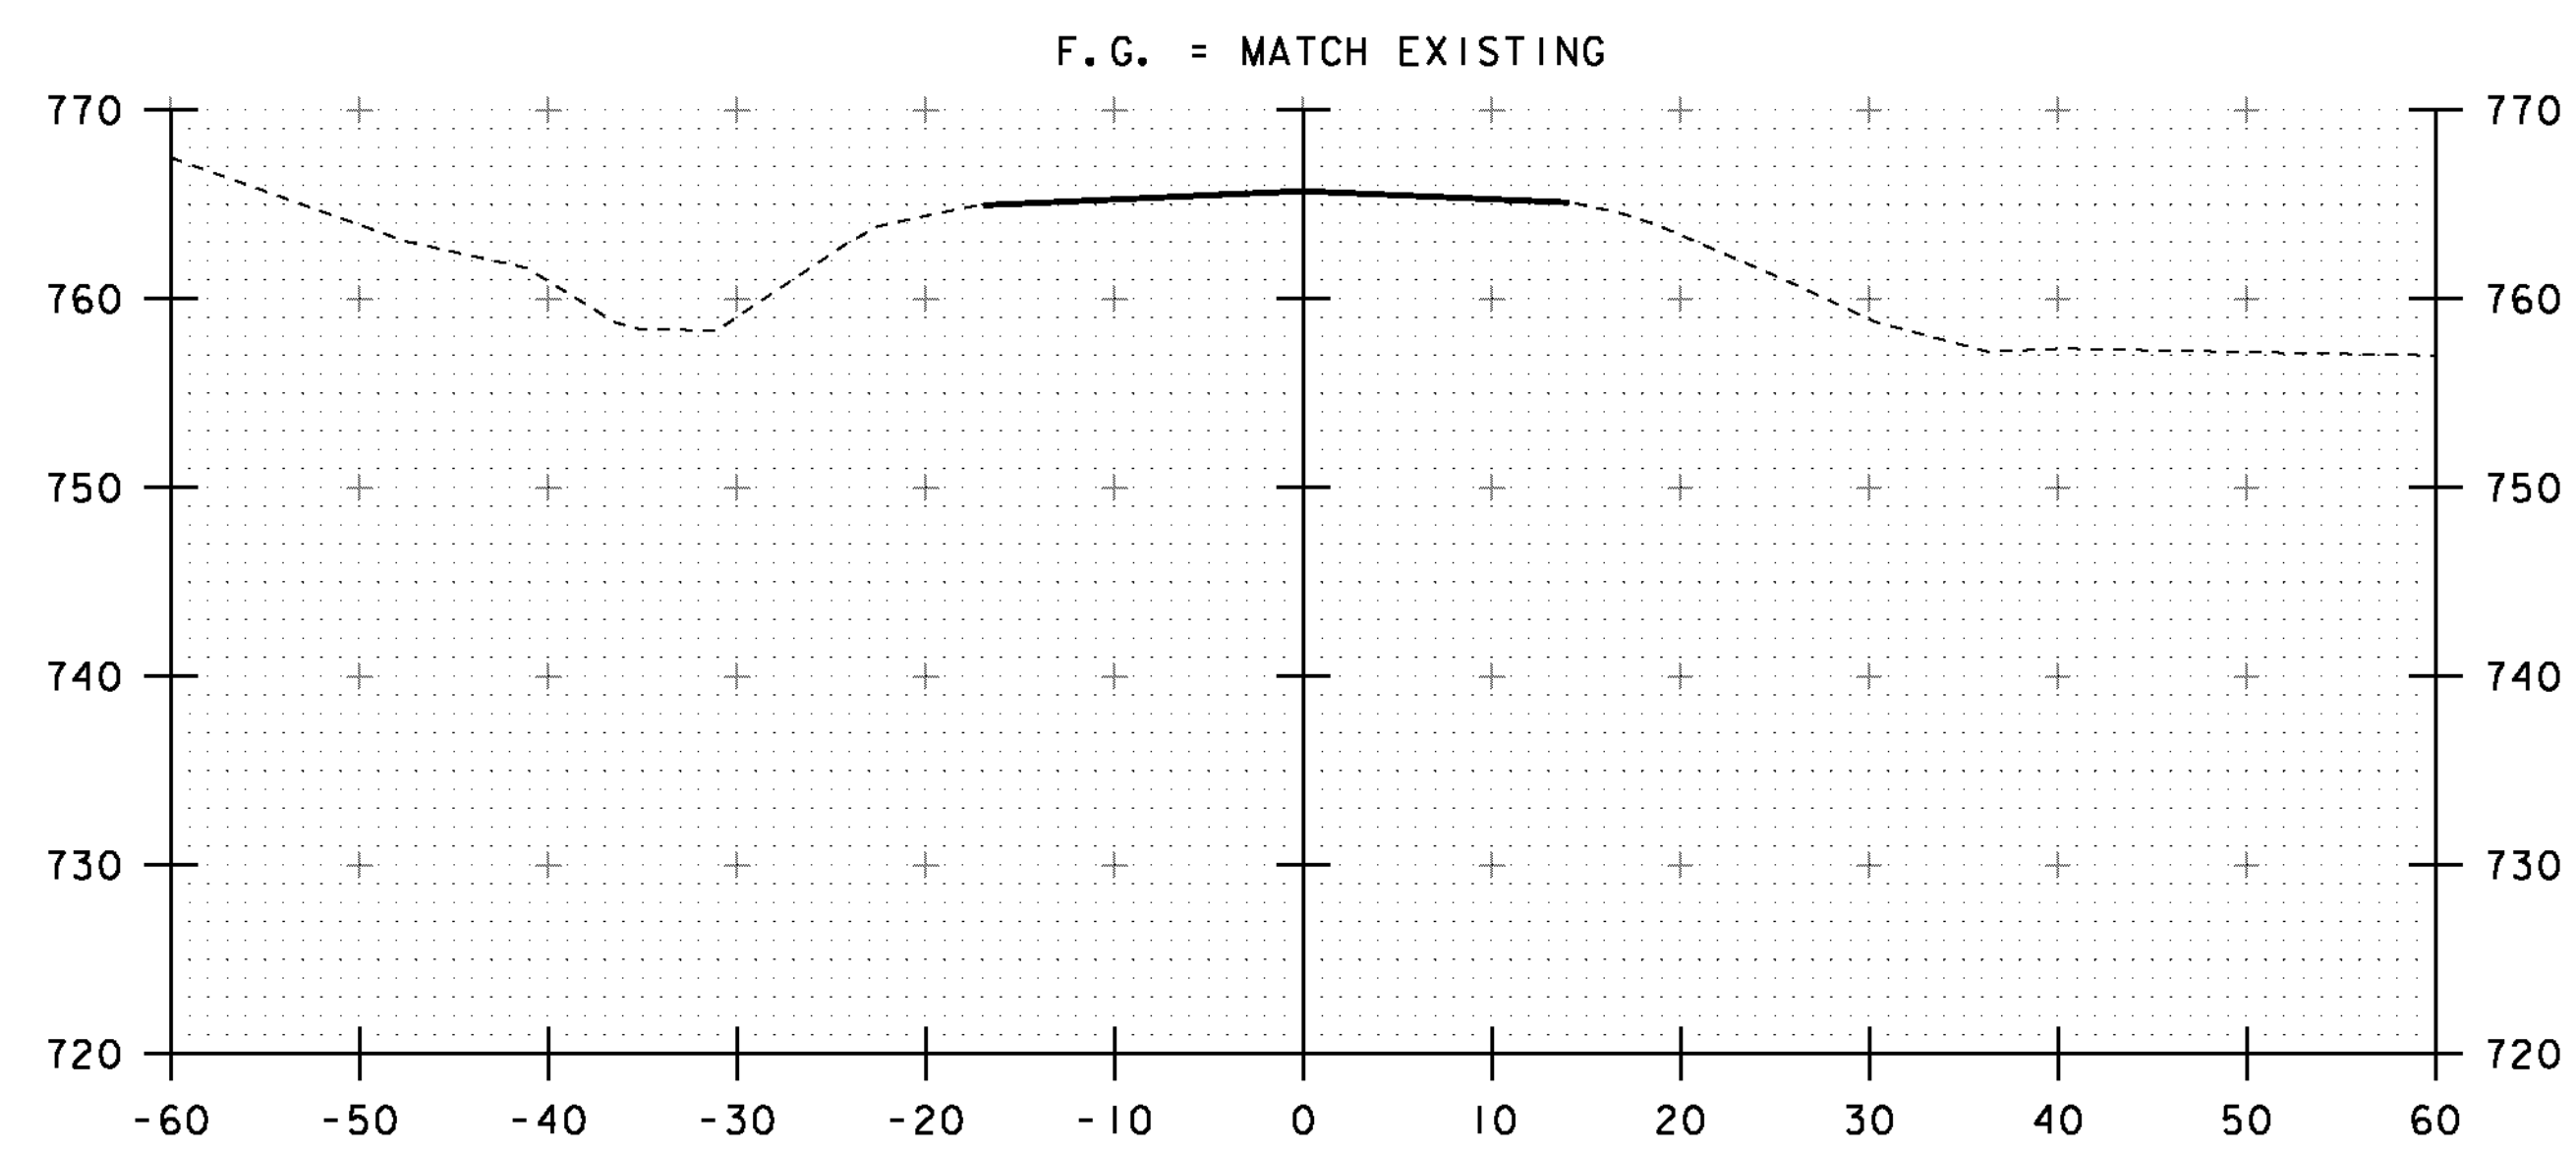






STA. 384+00.00
END APPROACH

384+00


10 0 10
SCALE: 1" = 10'-0"

STA. 384+00


PROJECT NAME: ST. JOHNSBURY	PLOT DATE: 28-AUG-2012
PROJECT NUMBER: BRF 028-4(25)S	DRAWN BY: C. MOONEY
FILE NAME: s98b320xsl.dgn	CHECKED BY: C. CARLSON
PROJECT LEADER: C. CARLSON	SHEET 40 OF 62
DESIGNED BY: H. SALLS	
ROADWAY CROSS SECTIONS 10	

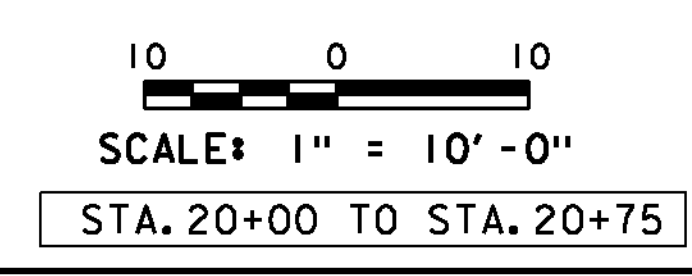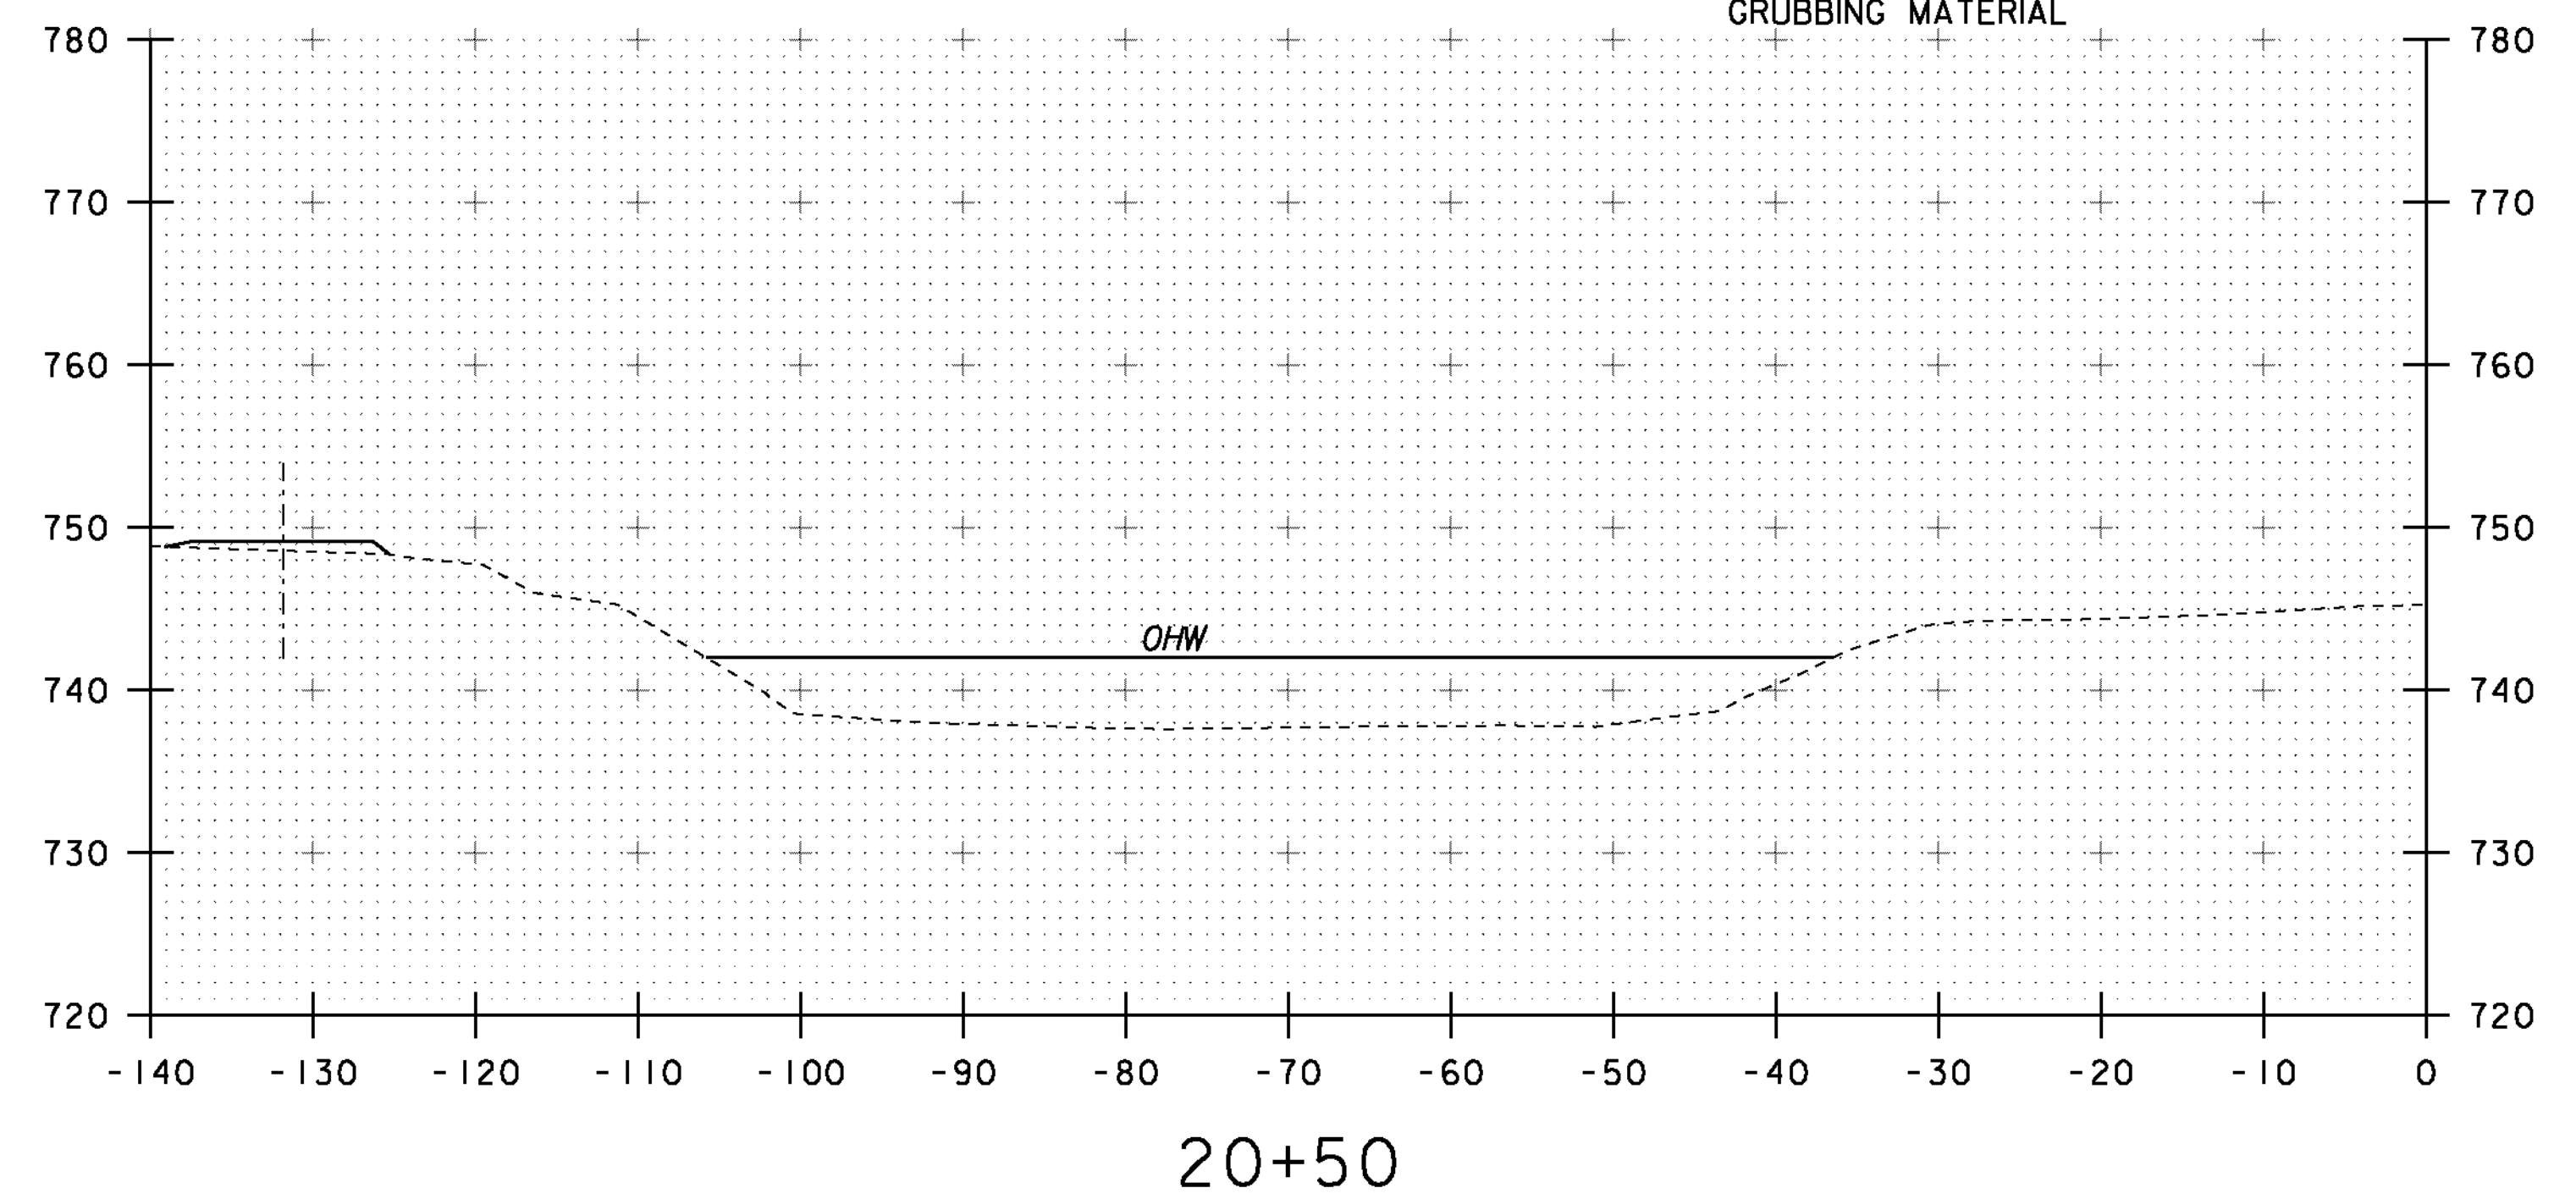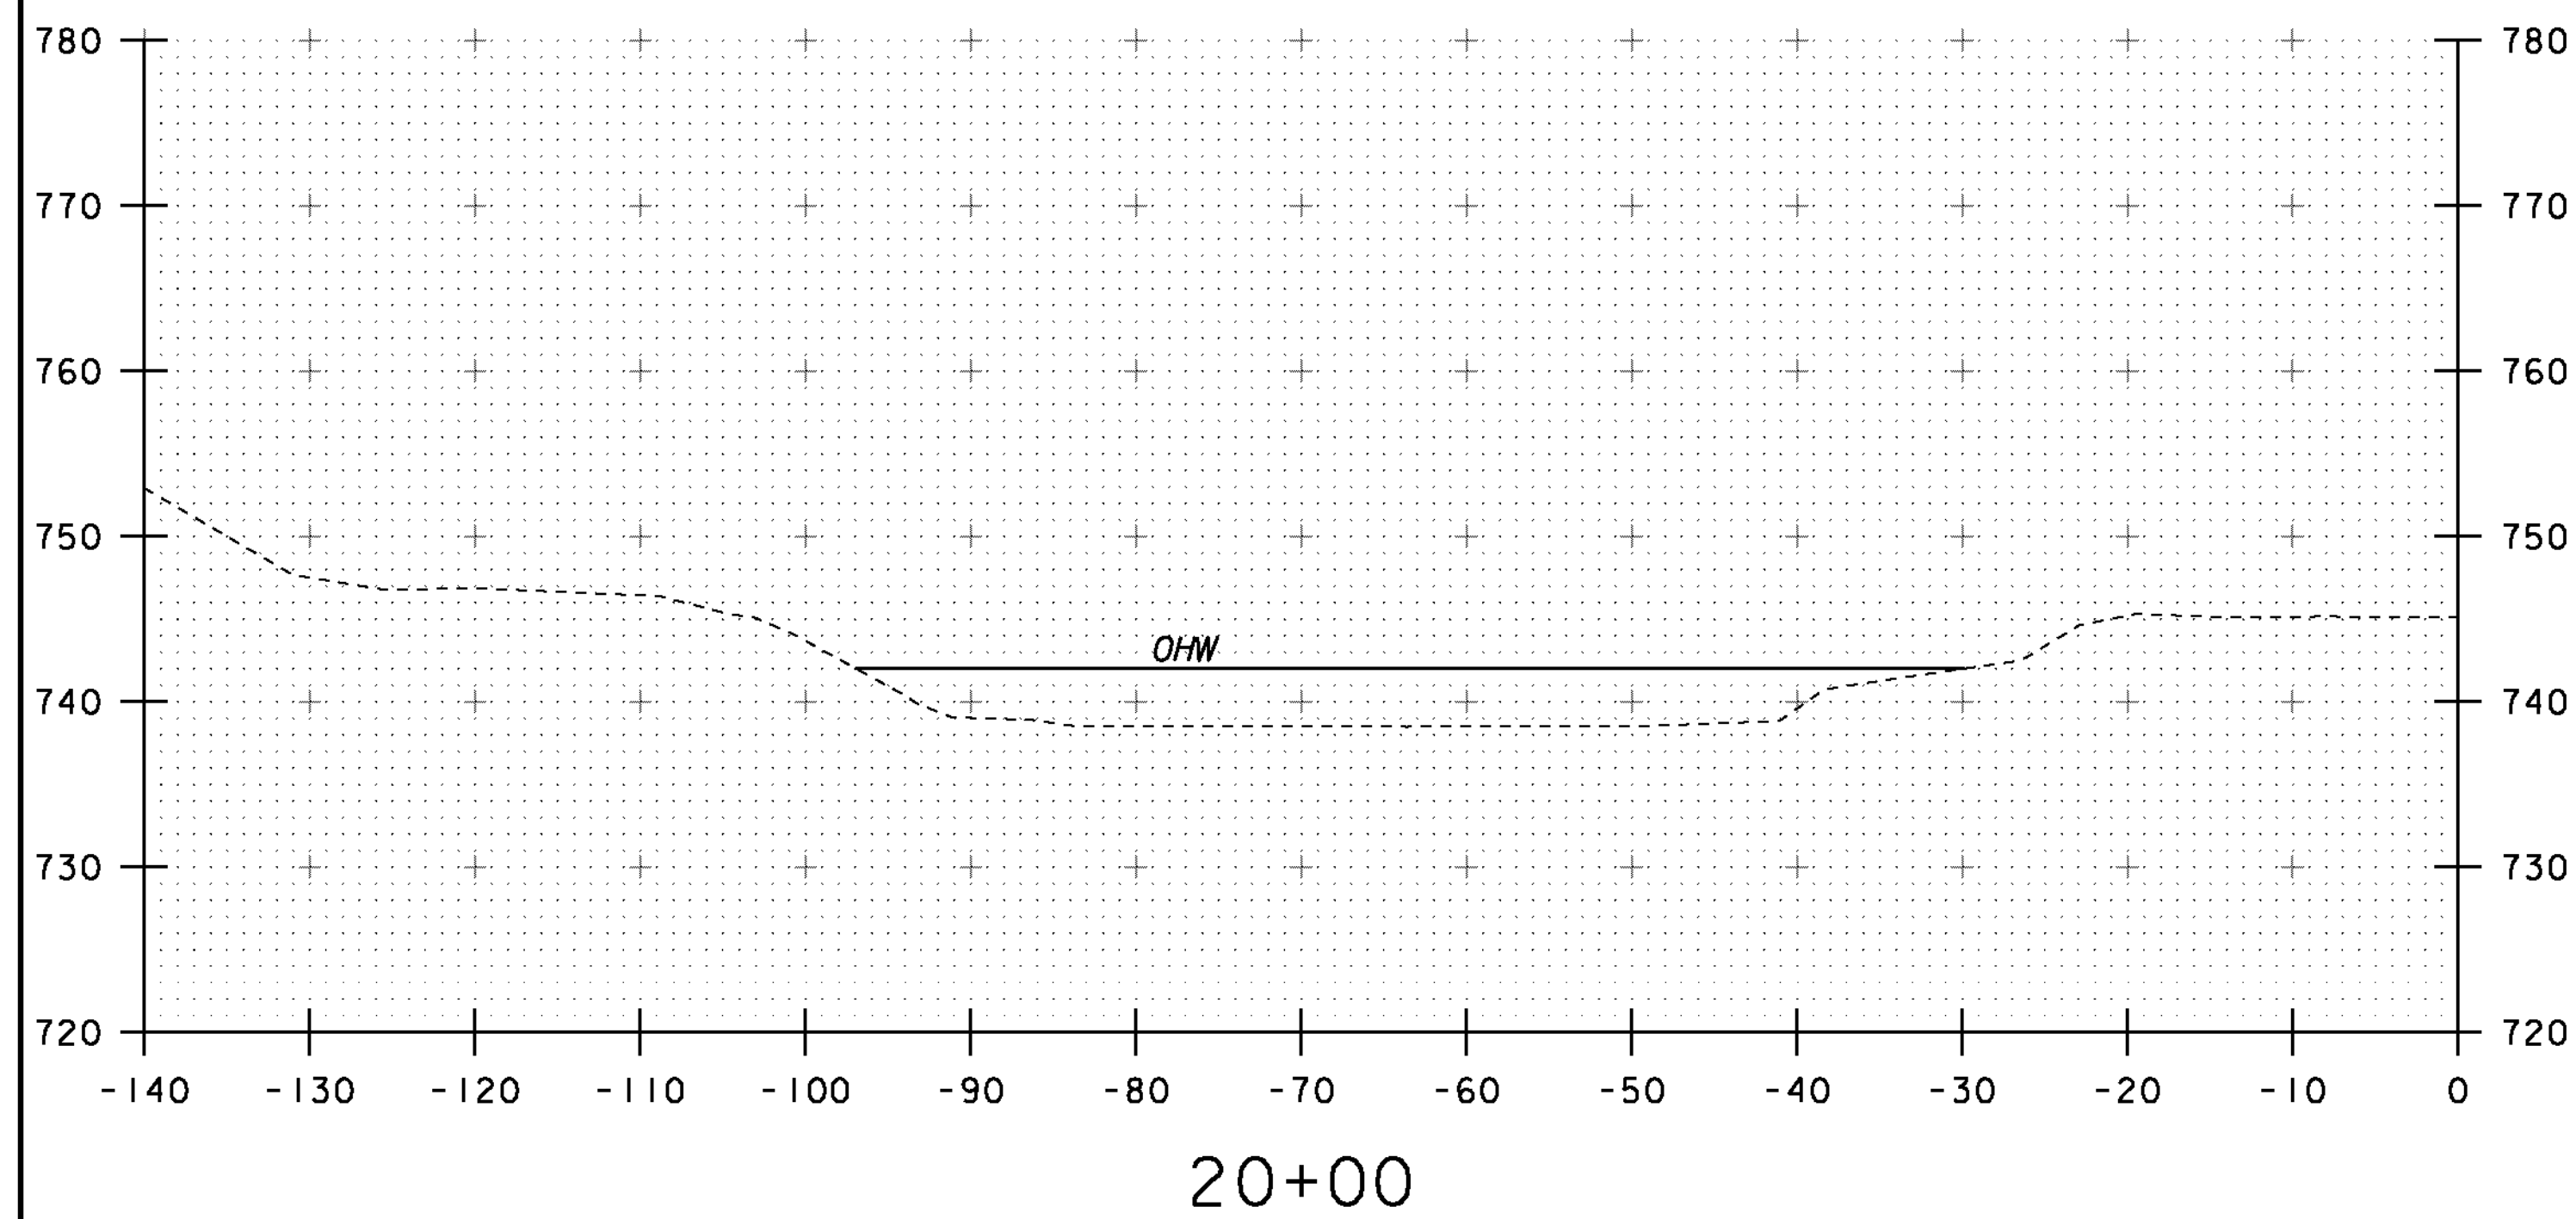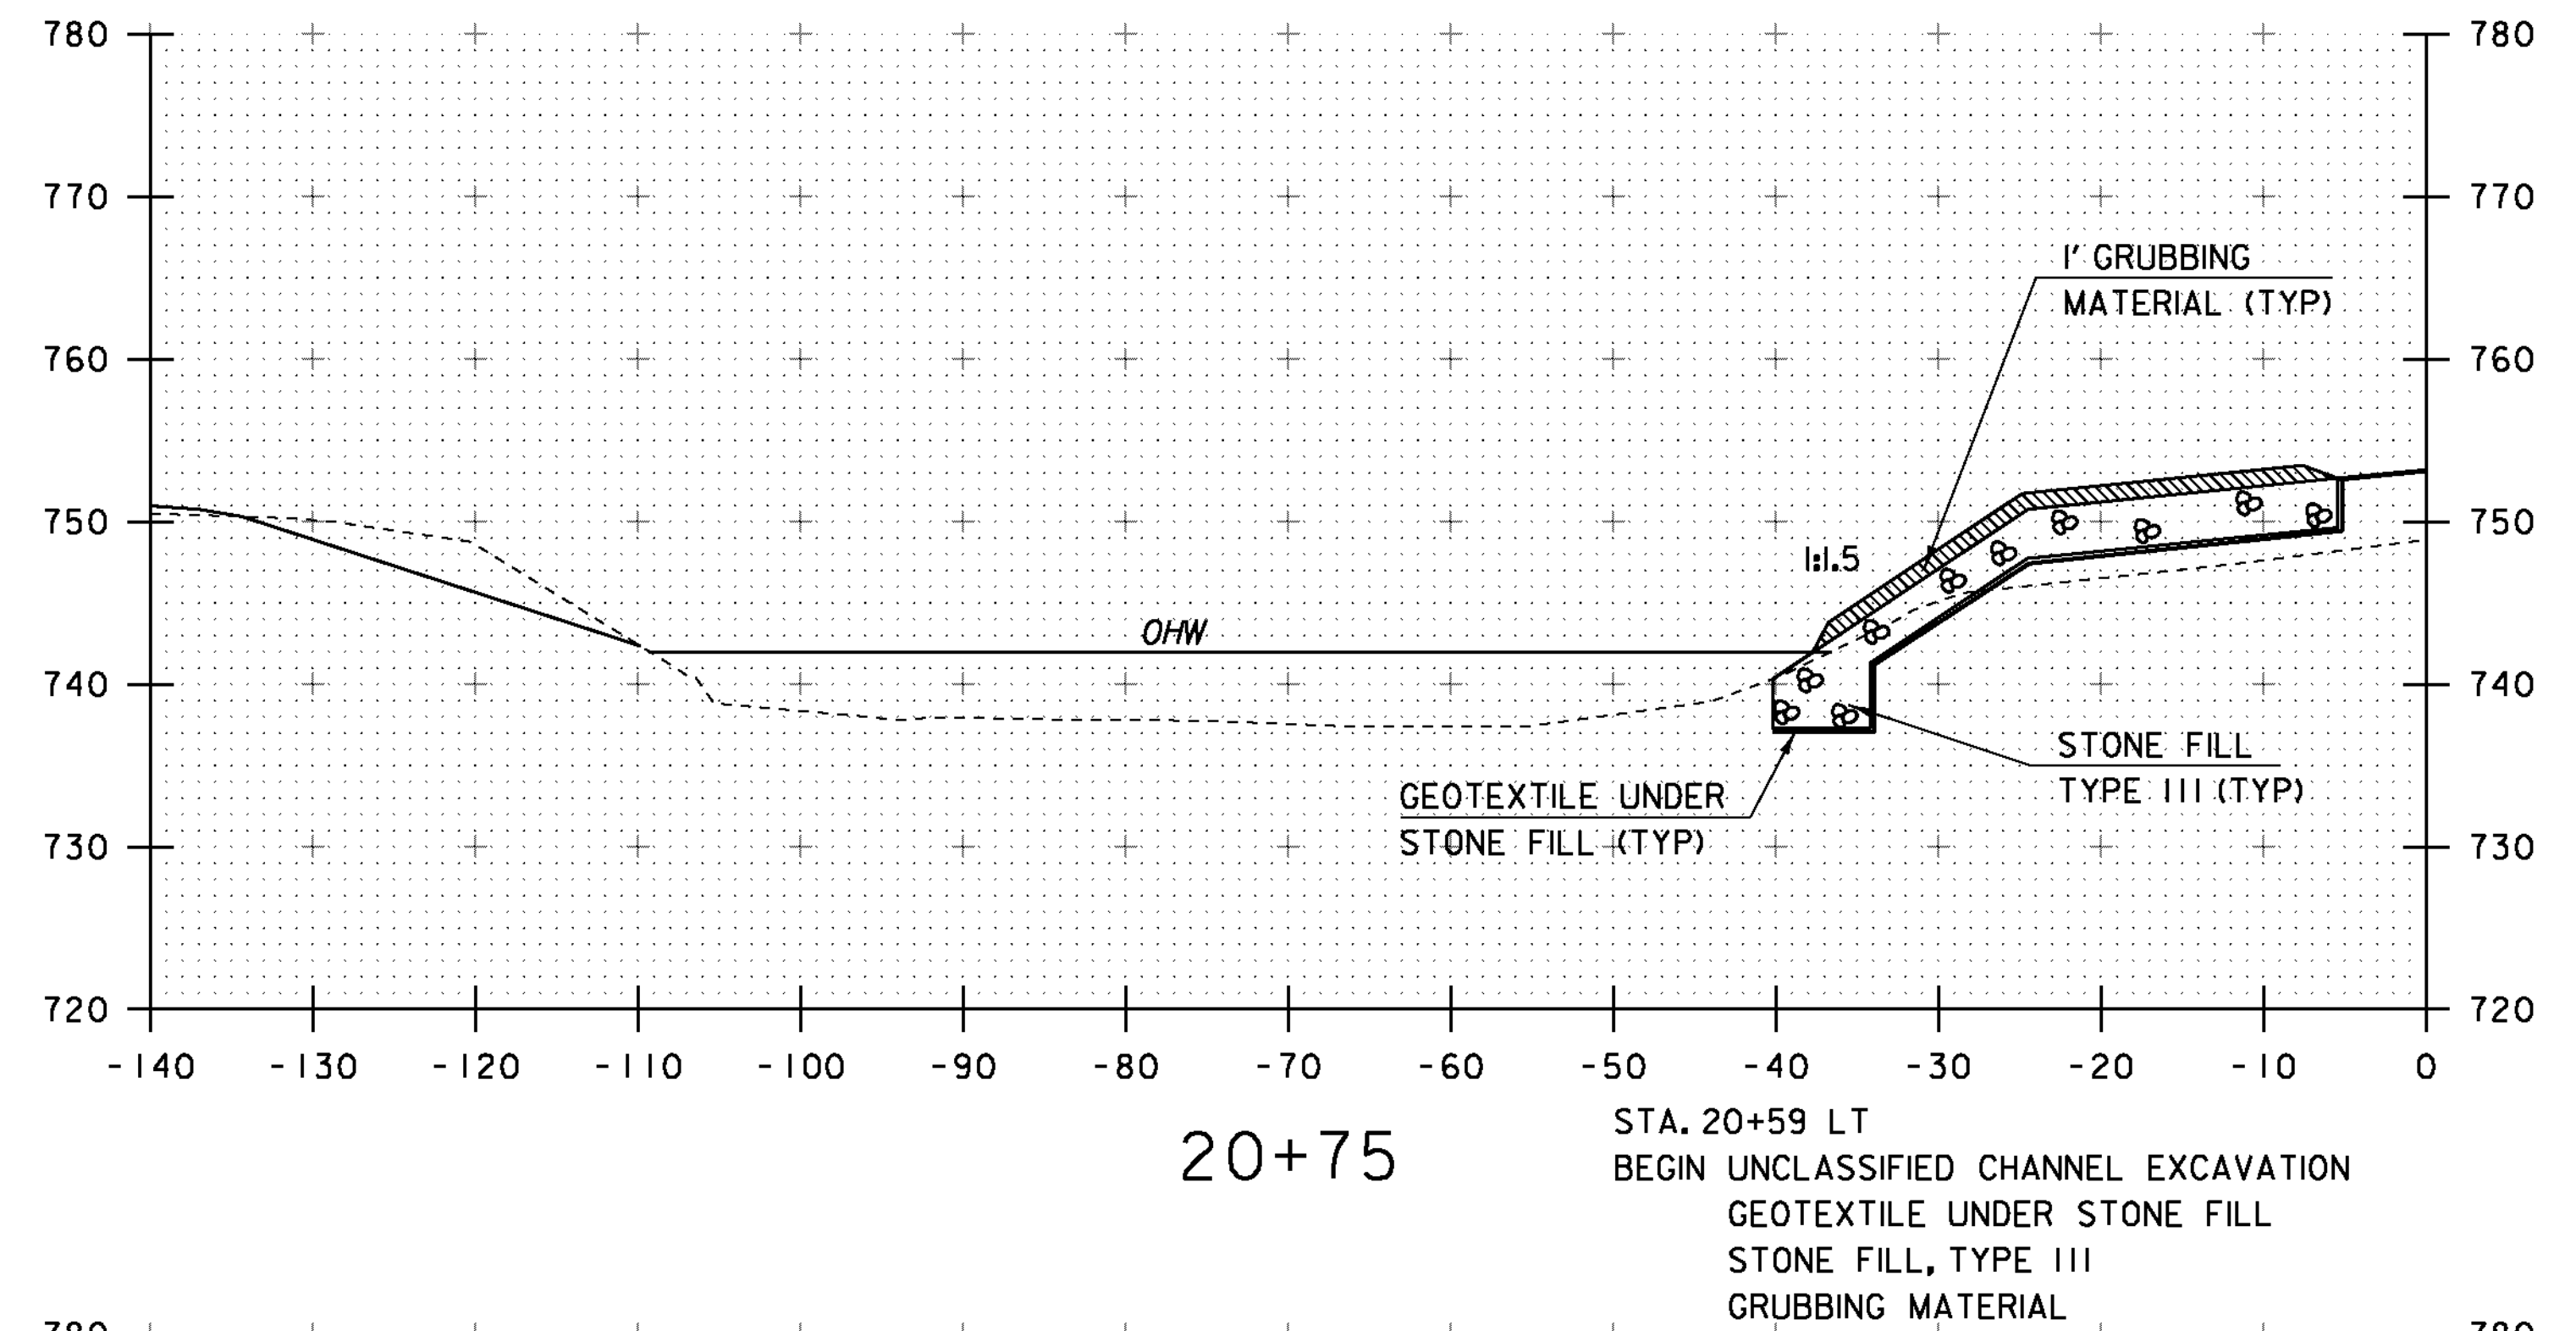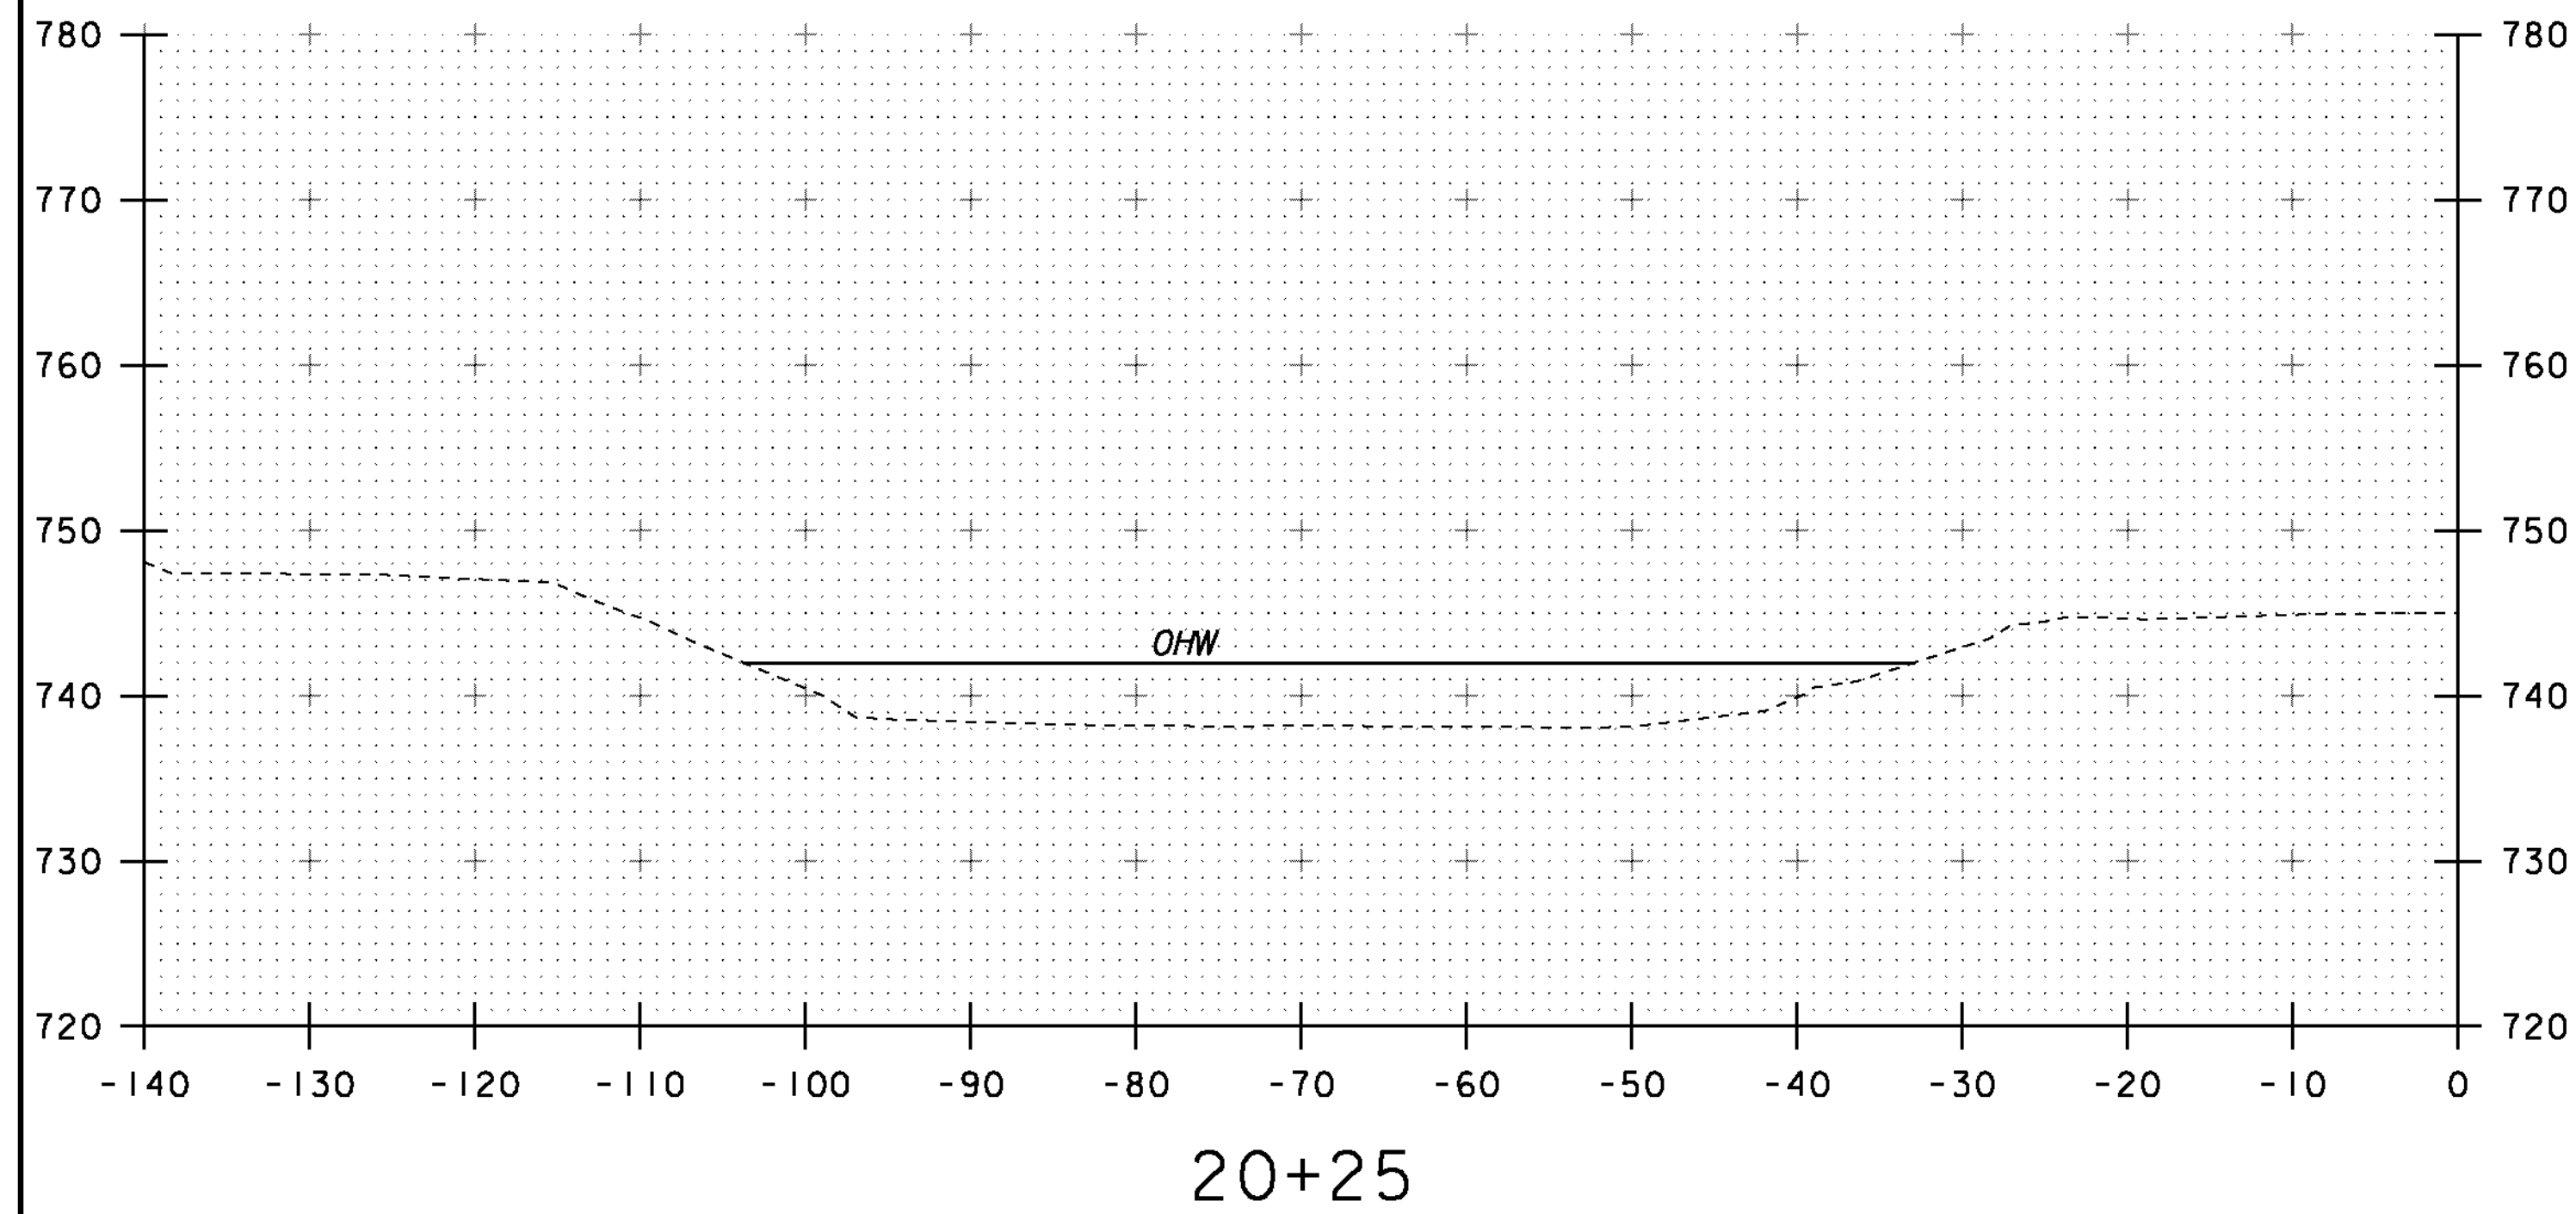


PROJECT NAME:	ST. JOHNSBURY	PLOT DATE:	28-AUG-2012
PROJECT NUMBER:	BRF 028-4(25)S	DRAWN BY:	C. MOONEY
FILE NAME:	s98b320xsl.dgn	CHECKED BY:	C. CARLSON
PROJECT LEADER:	C. CARLSON	SHEET	41 OF 62
DESIGNED BY:	H. SALLS	CHANNEL CROSS SECTIONS I	

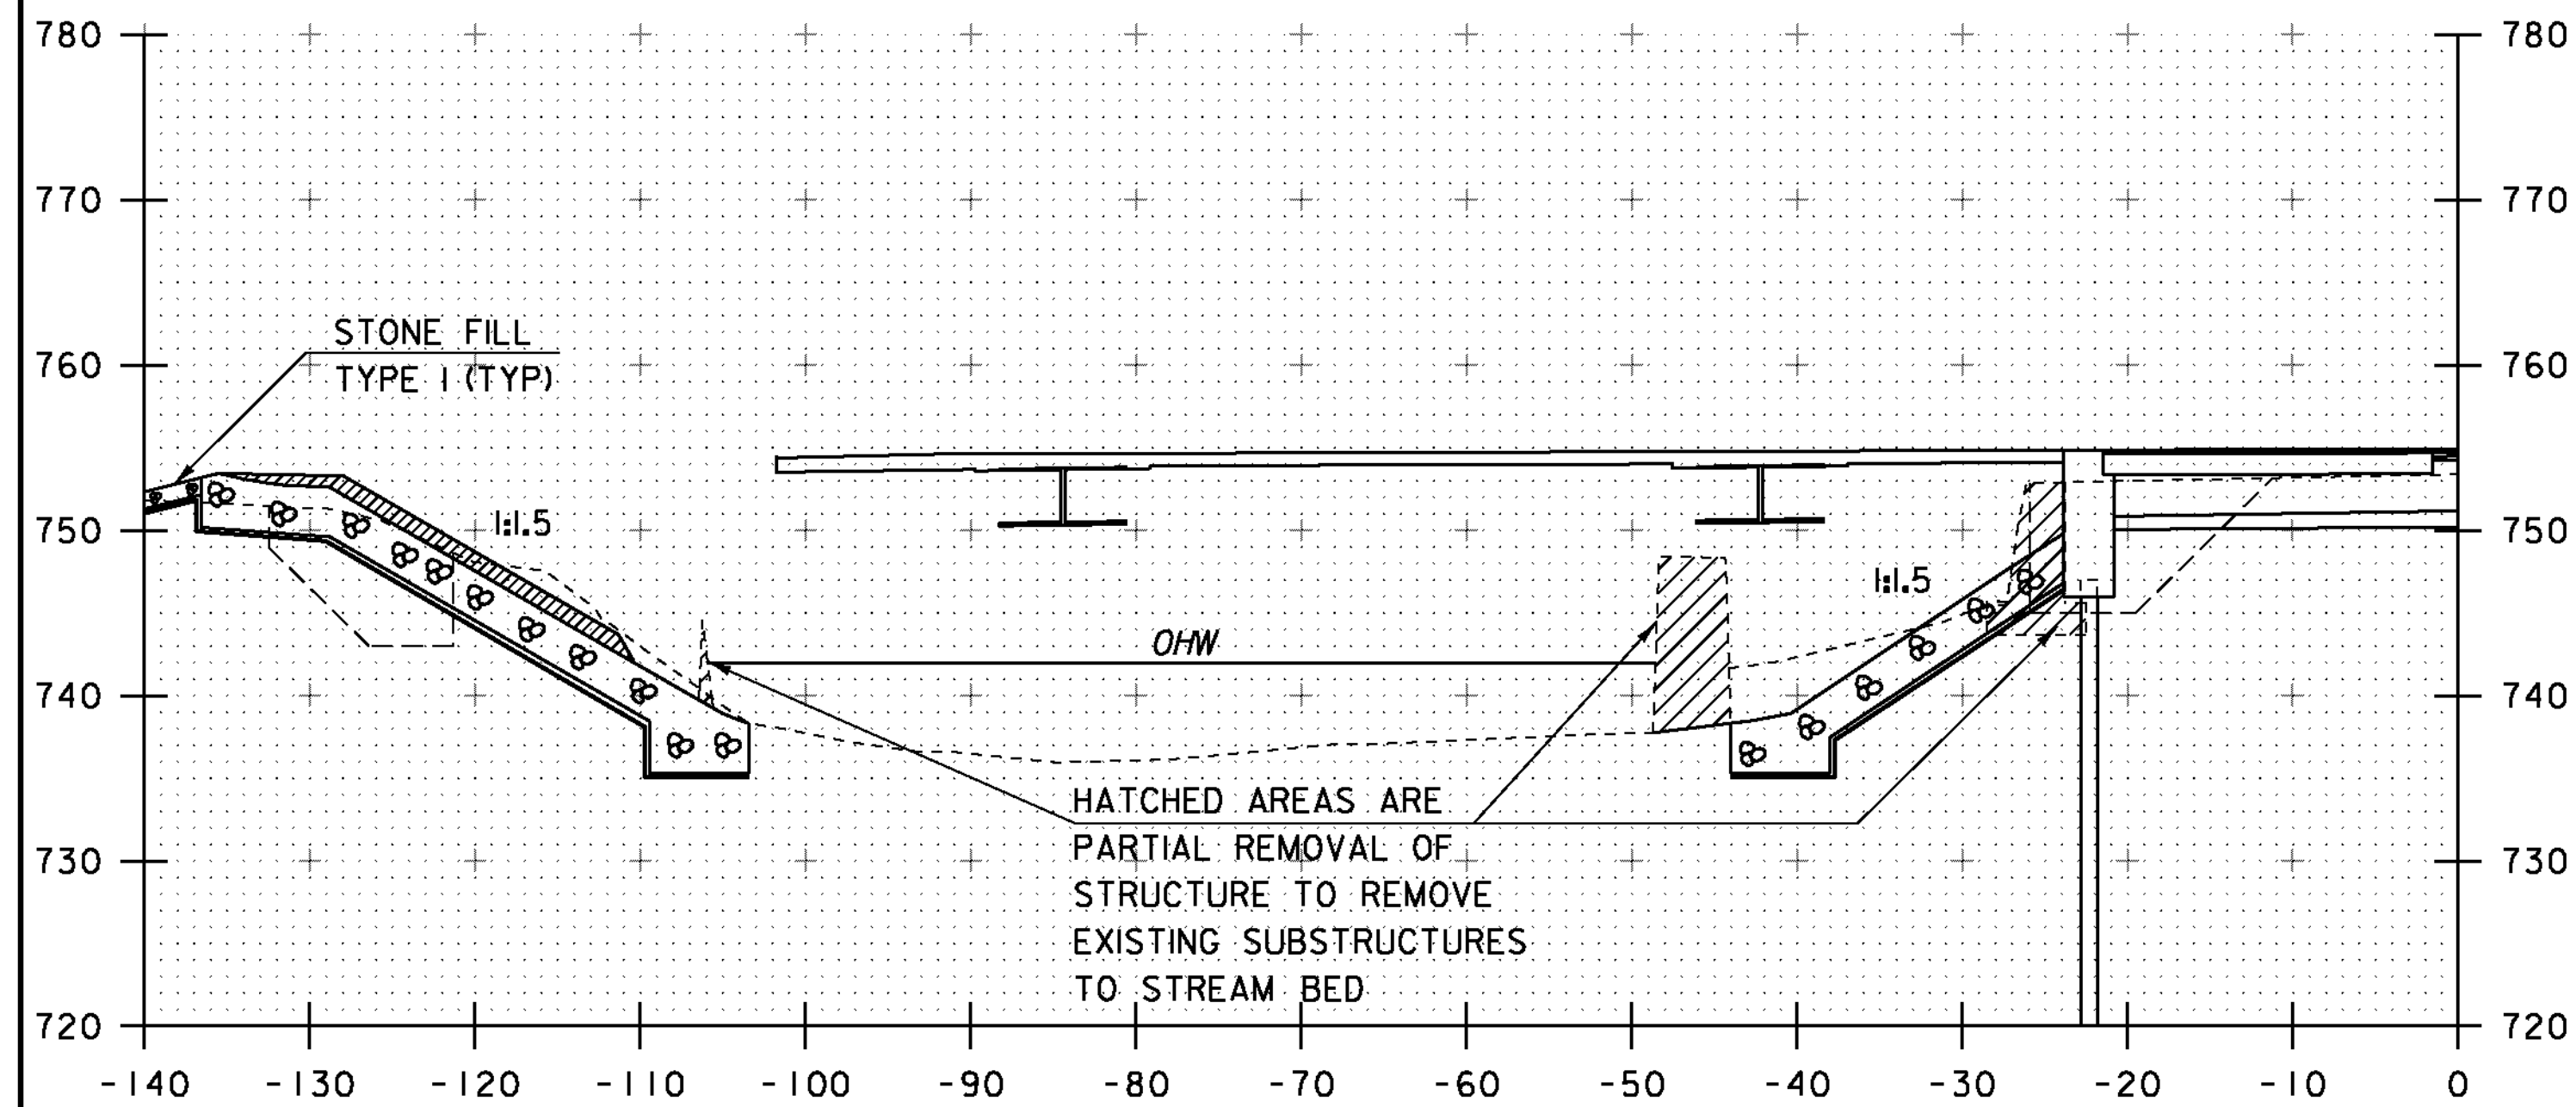


21+00

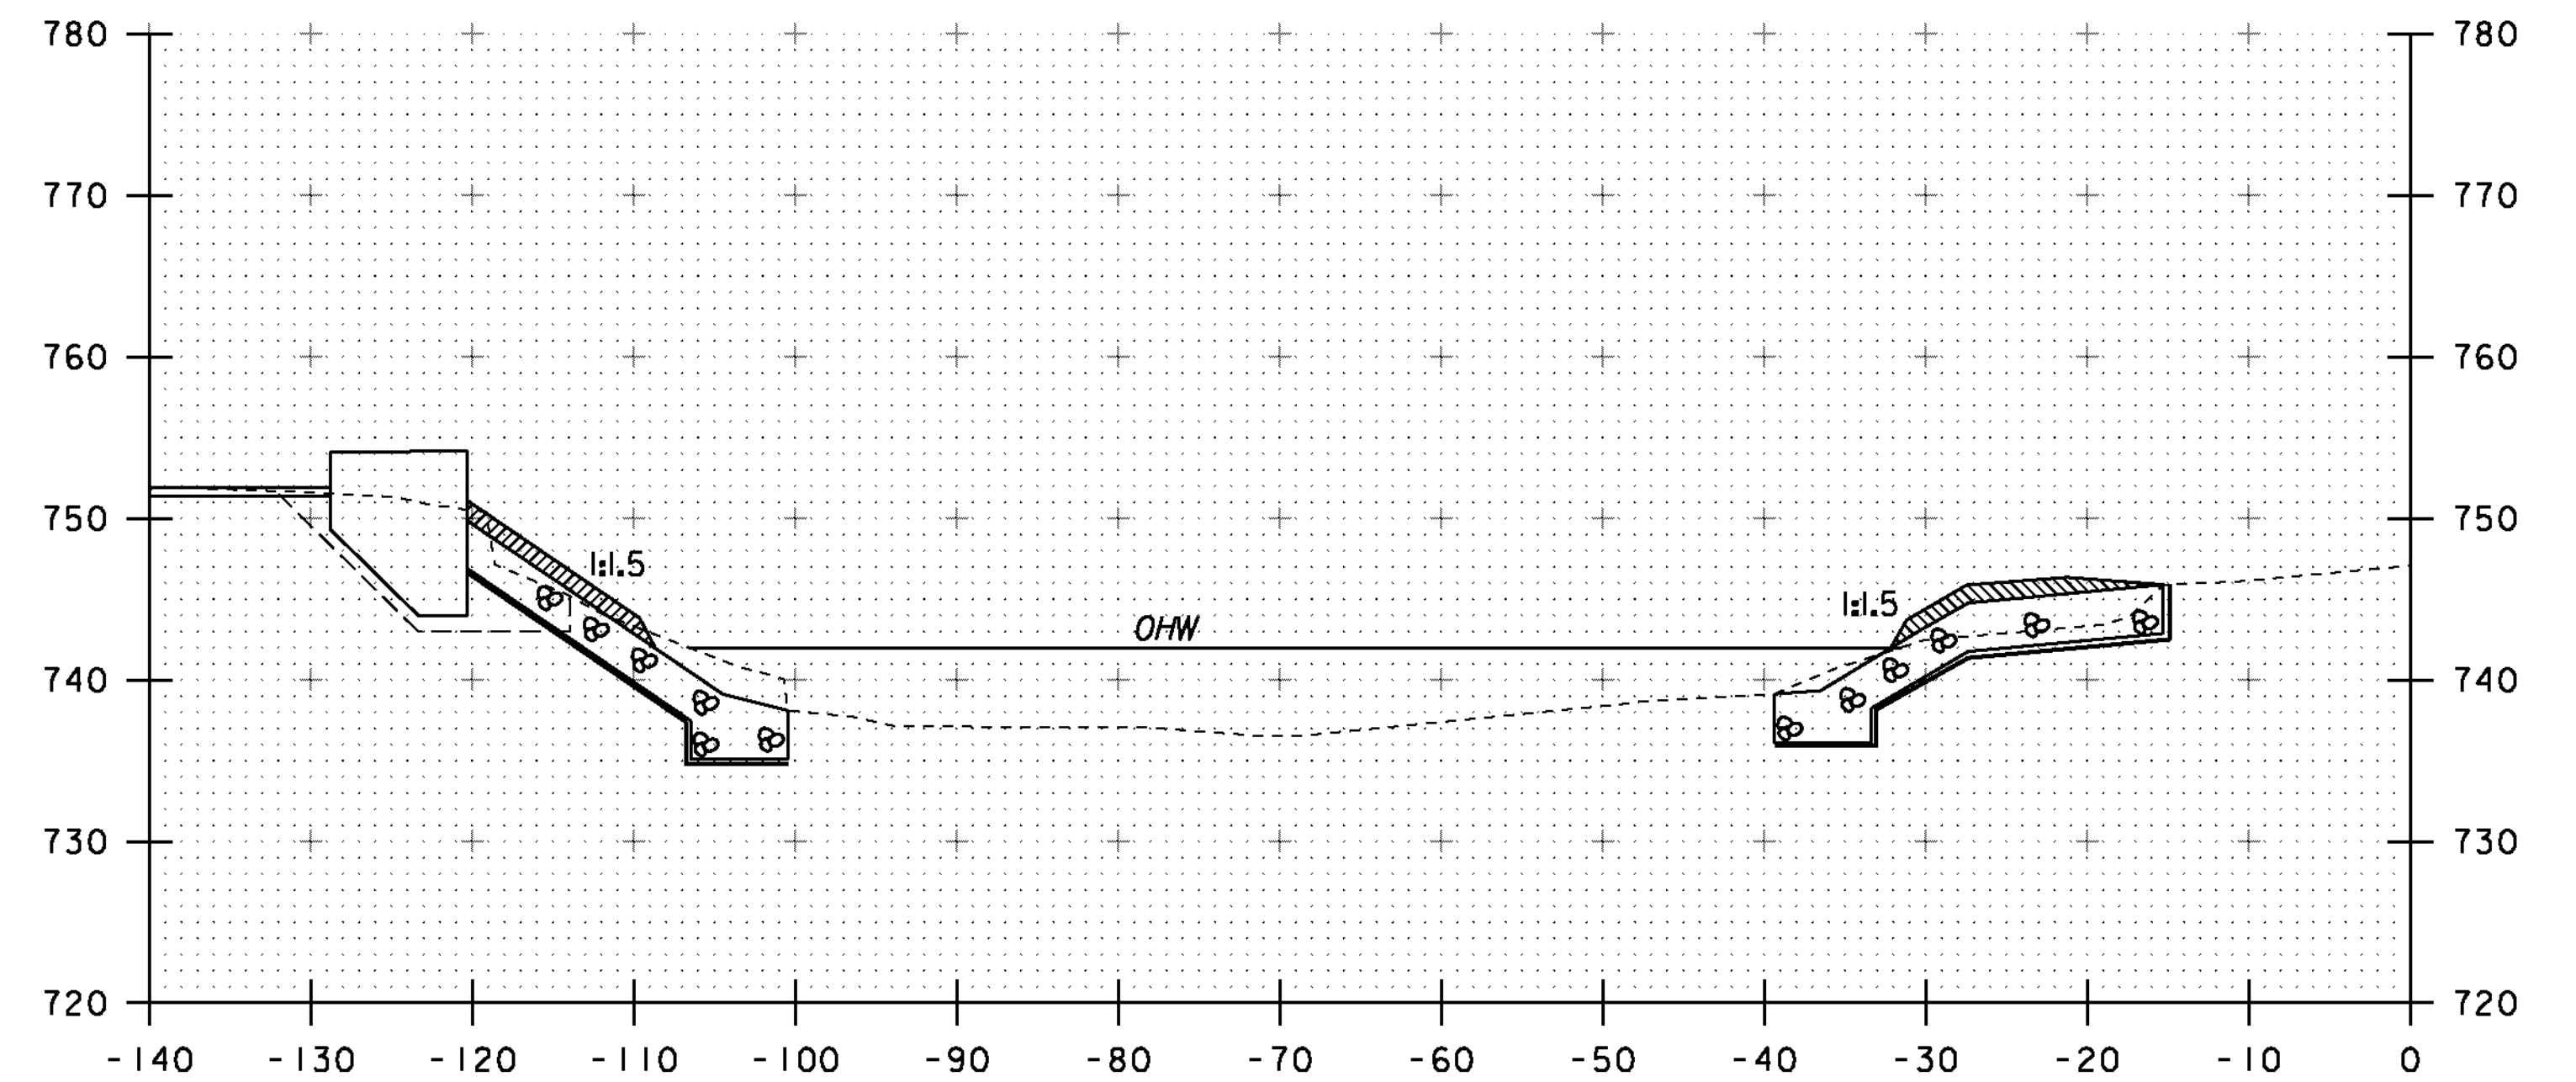

21+42

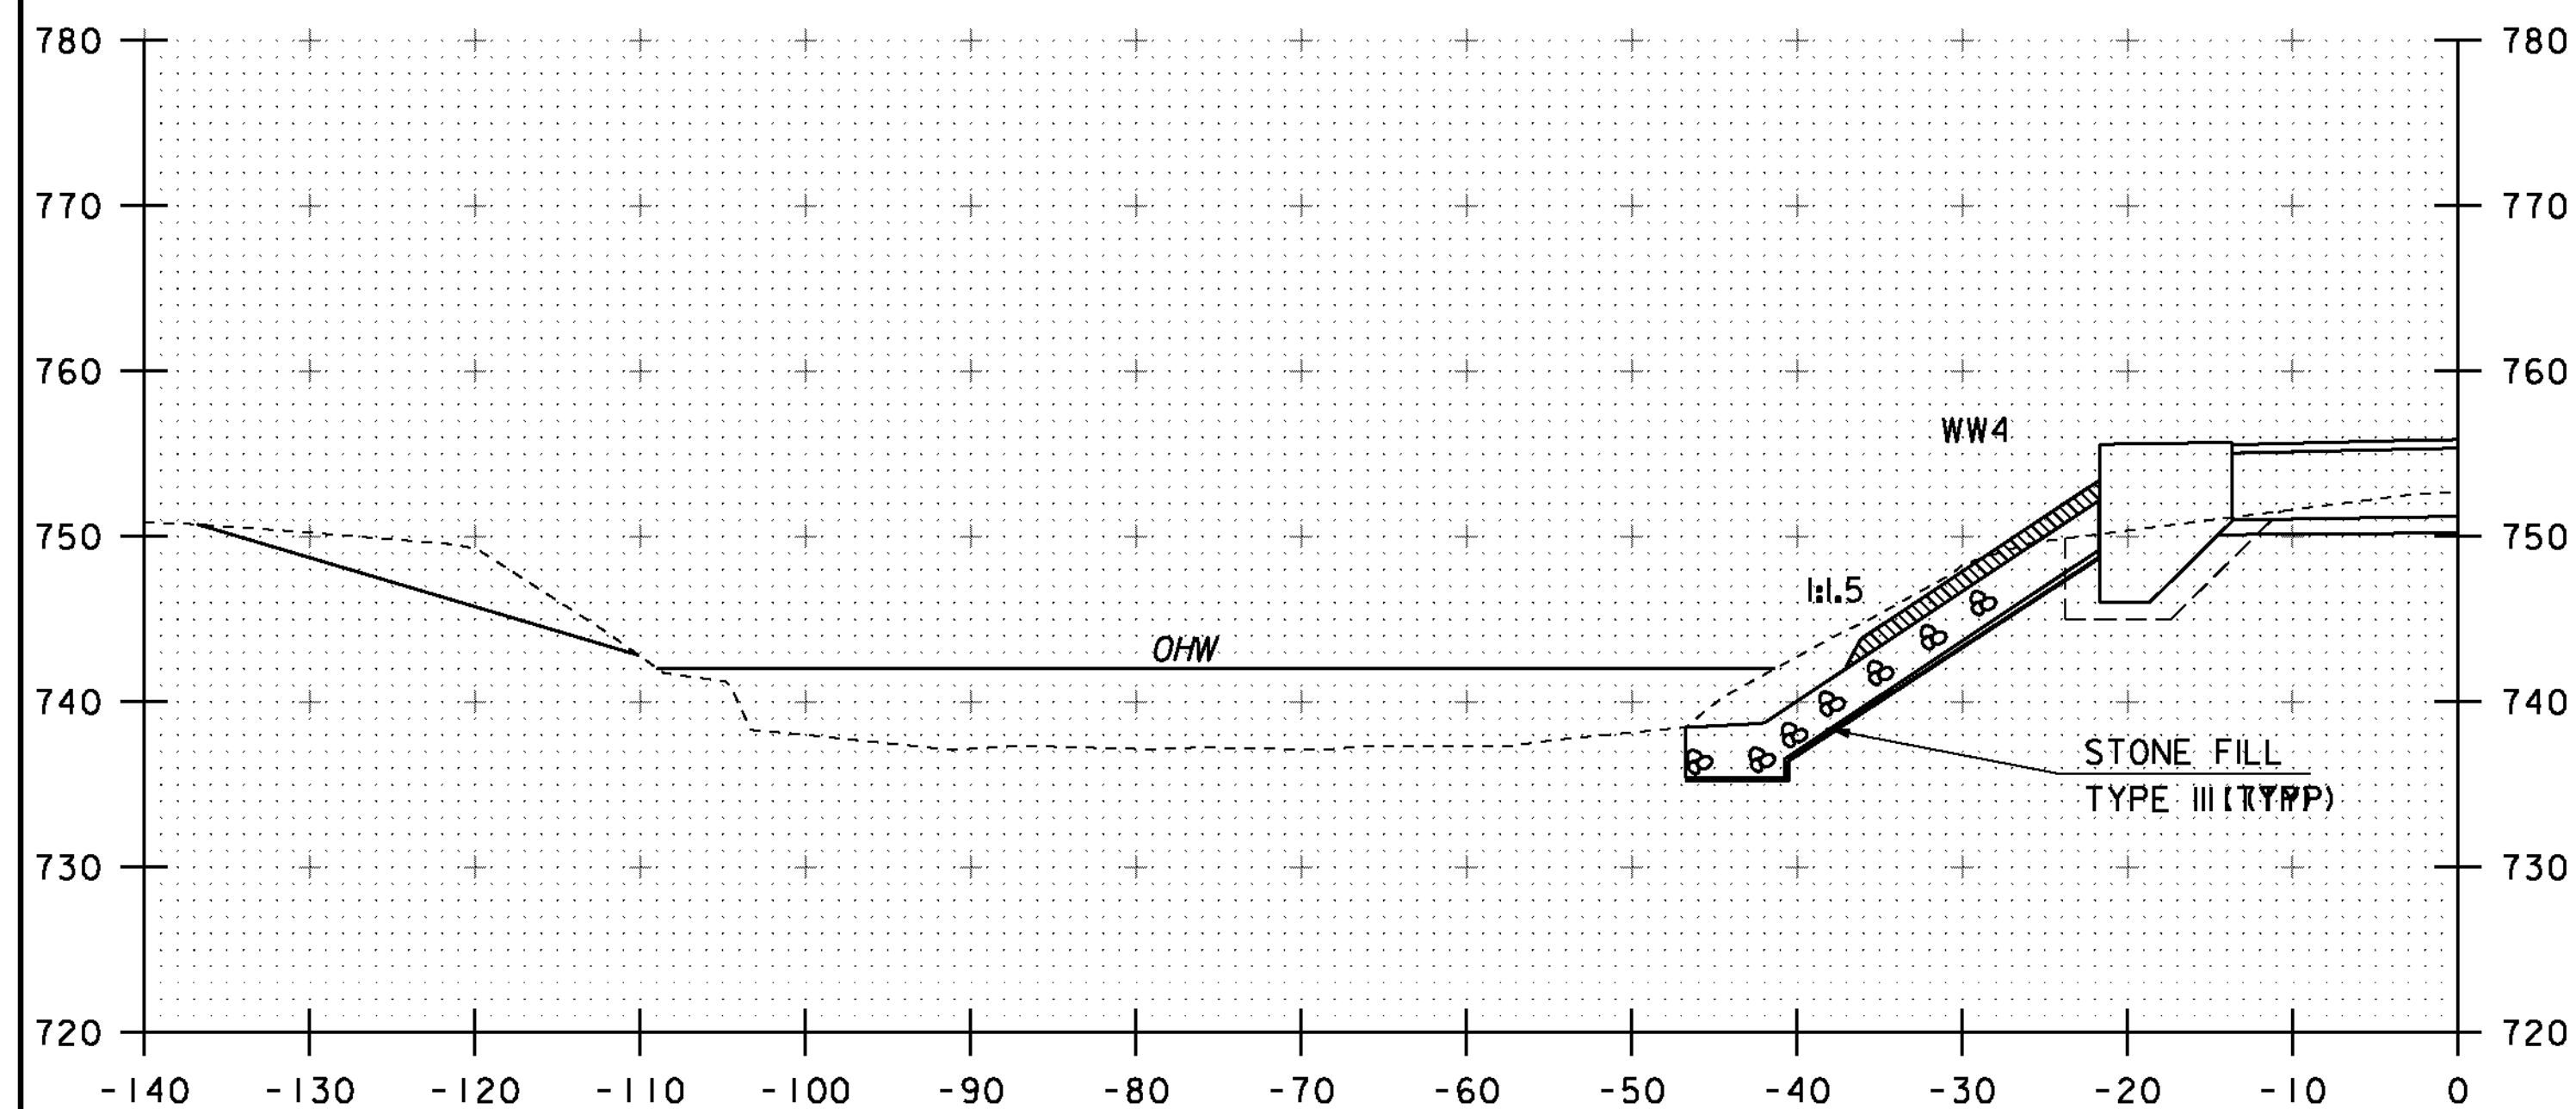


20+83

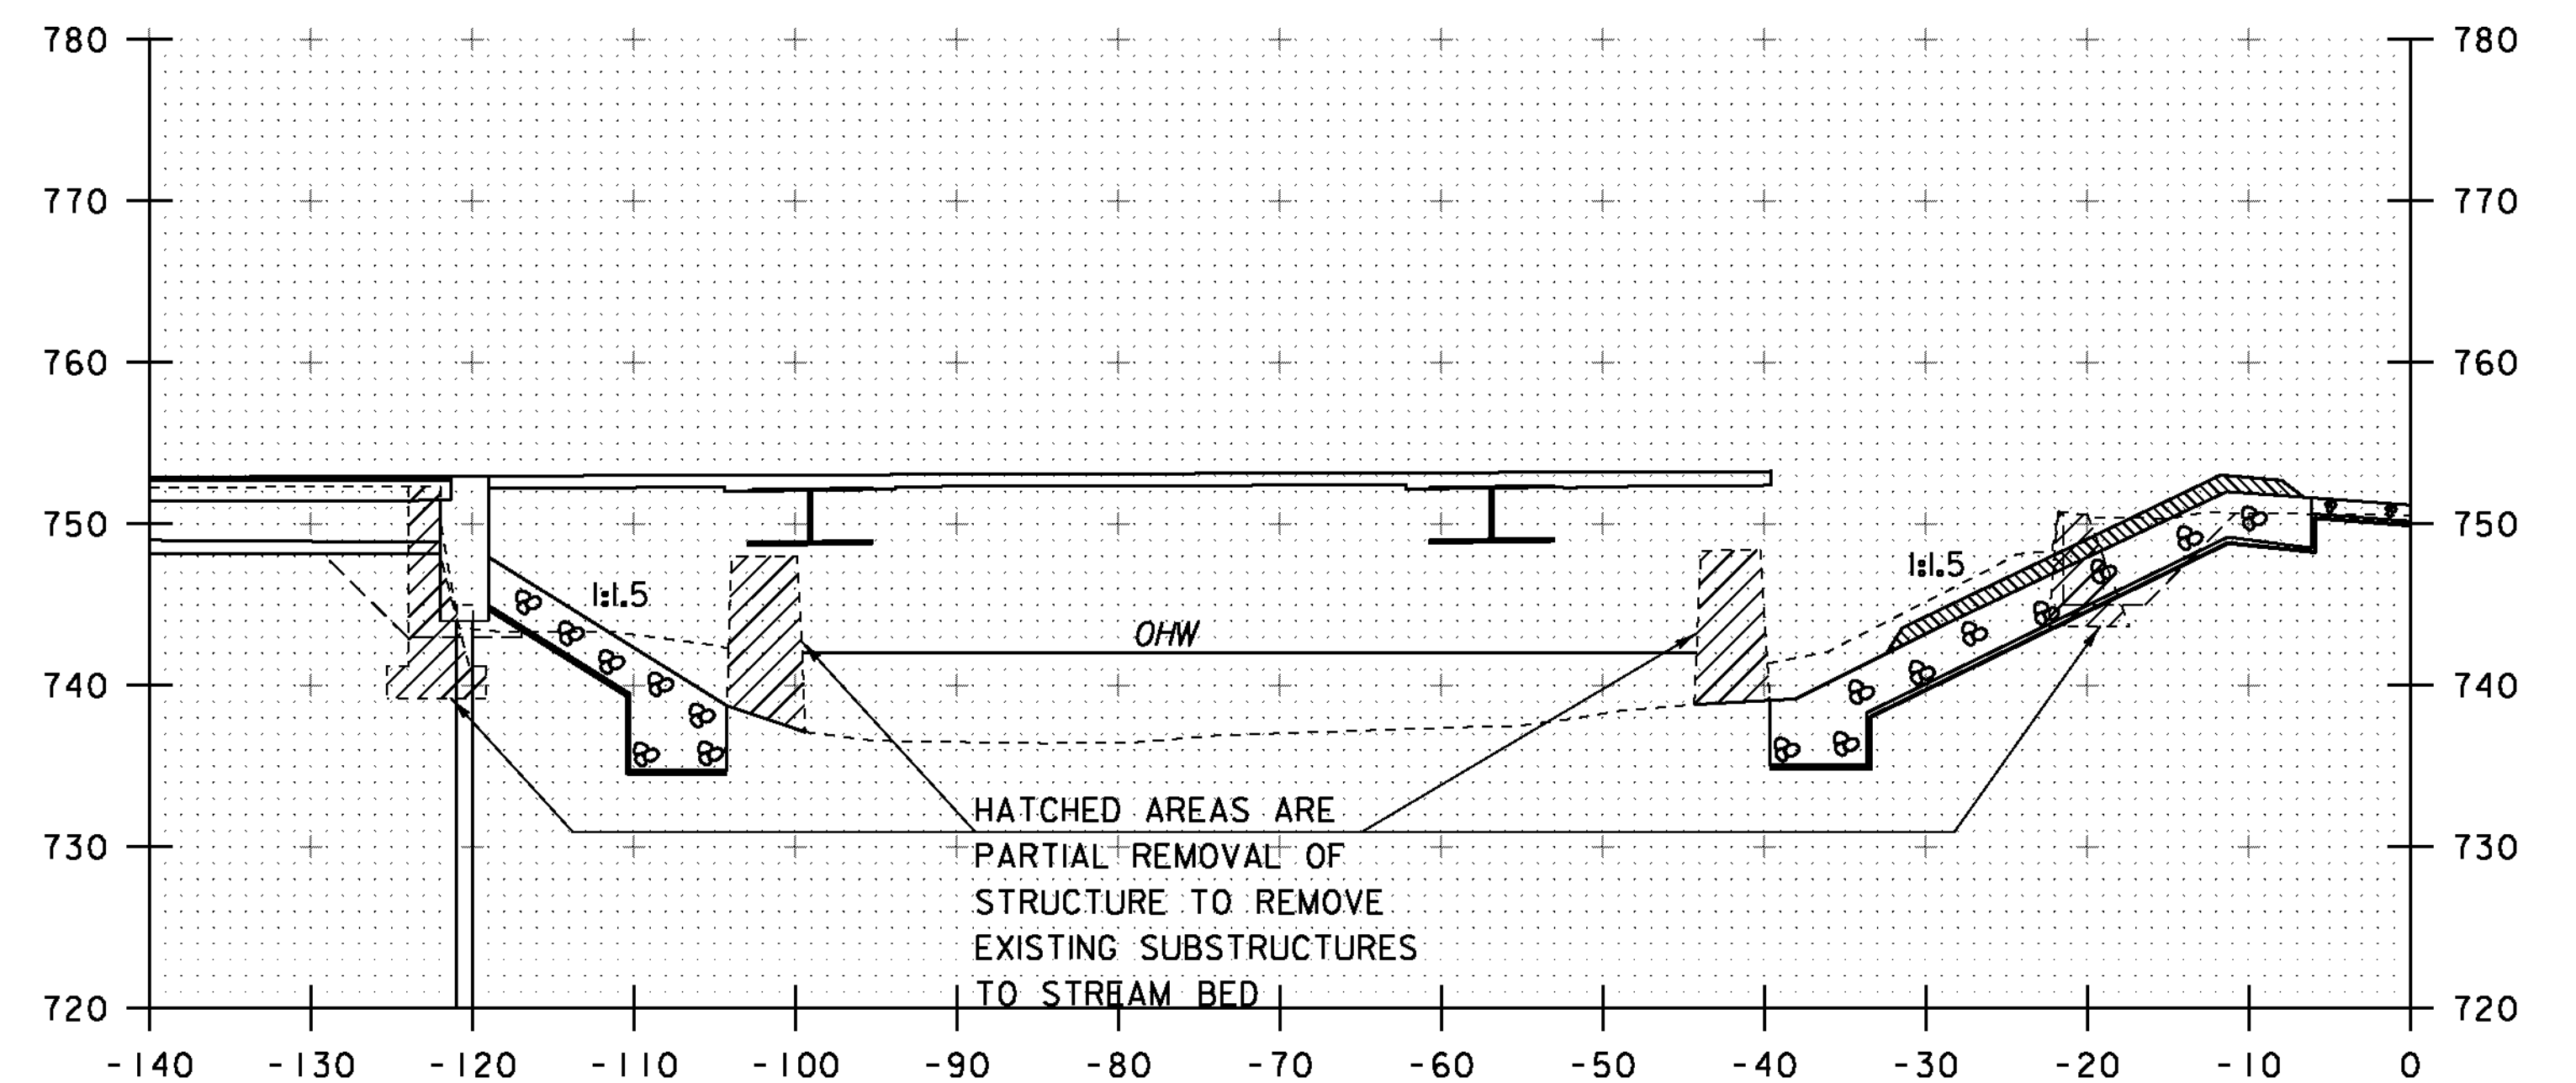


21+25

STA. 20+85.00 FAR LT
 BEGIN UNCLASSIFIED CHANNEL EXCAVATION
 GEOTEXTILE UNDER STONE FILL
 STONE FILL, TYPE III
 GRUBBING MATERIAL

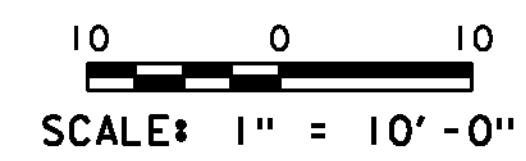


STA. 20+83 TO STA. 21+42


PROJECT NAME:	ST. JOHNSBURY	PLOT DATE:	28-AUG-2012
PROJECT NUMBER:	BRF 028-4(25)S	DRAWN BY:	C. MOONEY
FILE NAME:	s98b320xsl.dgn	CHECKED BY:	C. CARLSON
PROJECT LEADER:	C. CARLSON	SHEET	42 OF 62
DESIGNED BY:	H. SALLS	CHANNEL CROSS SECTIONS 2	

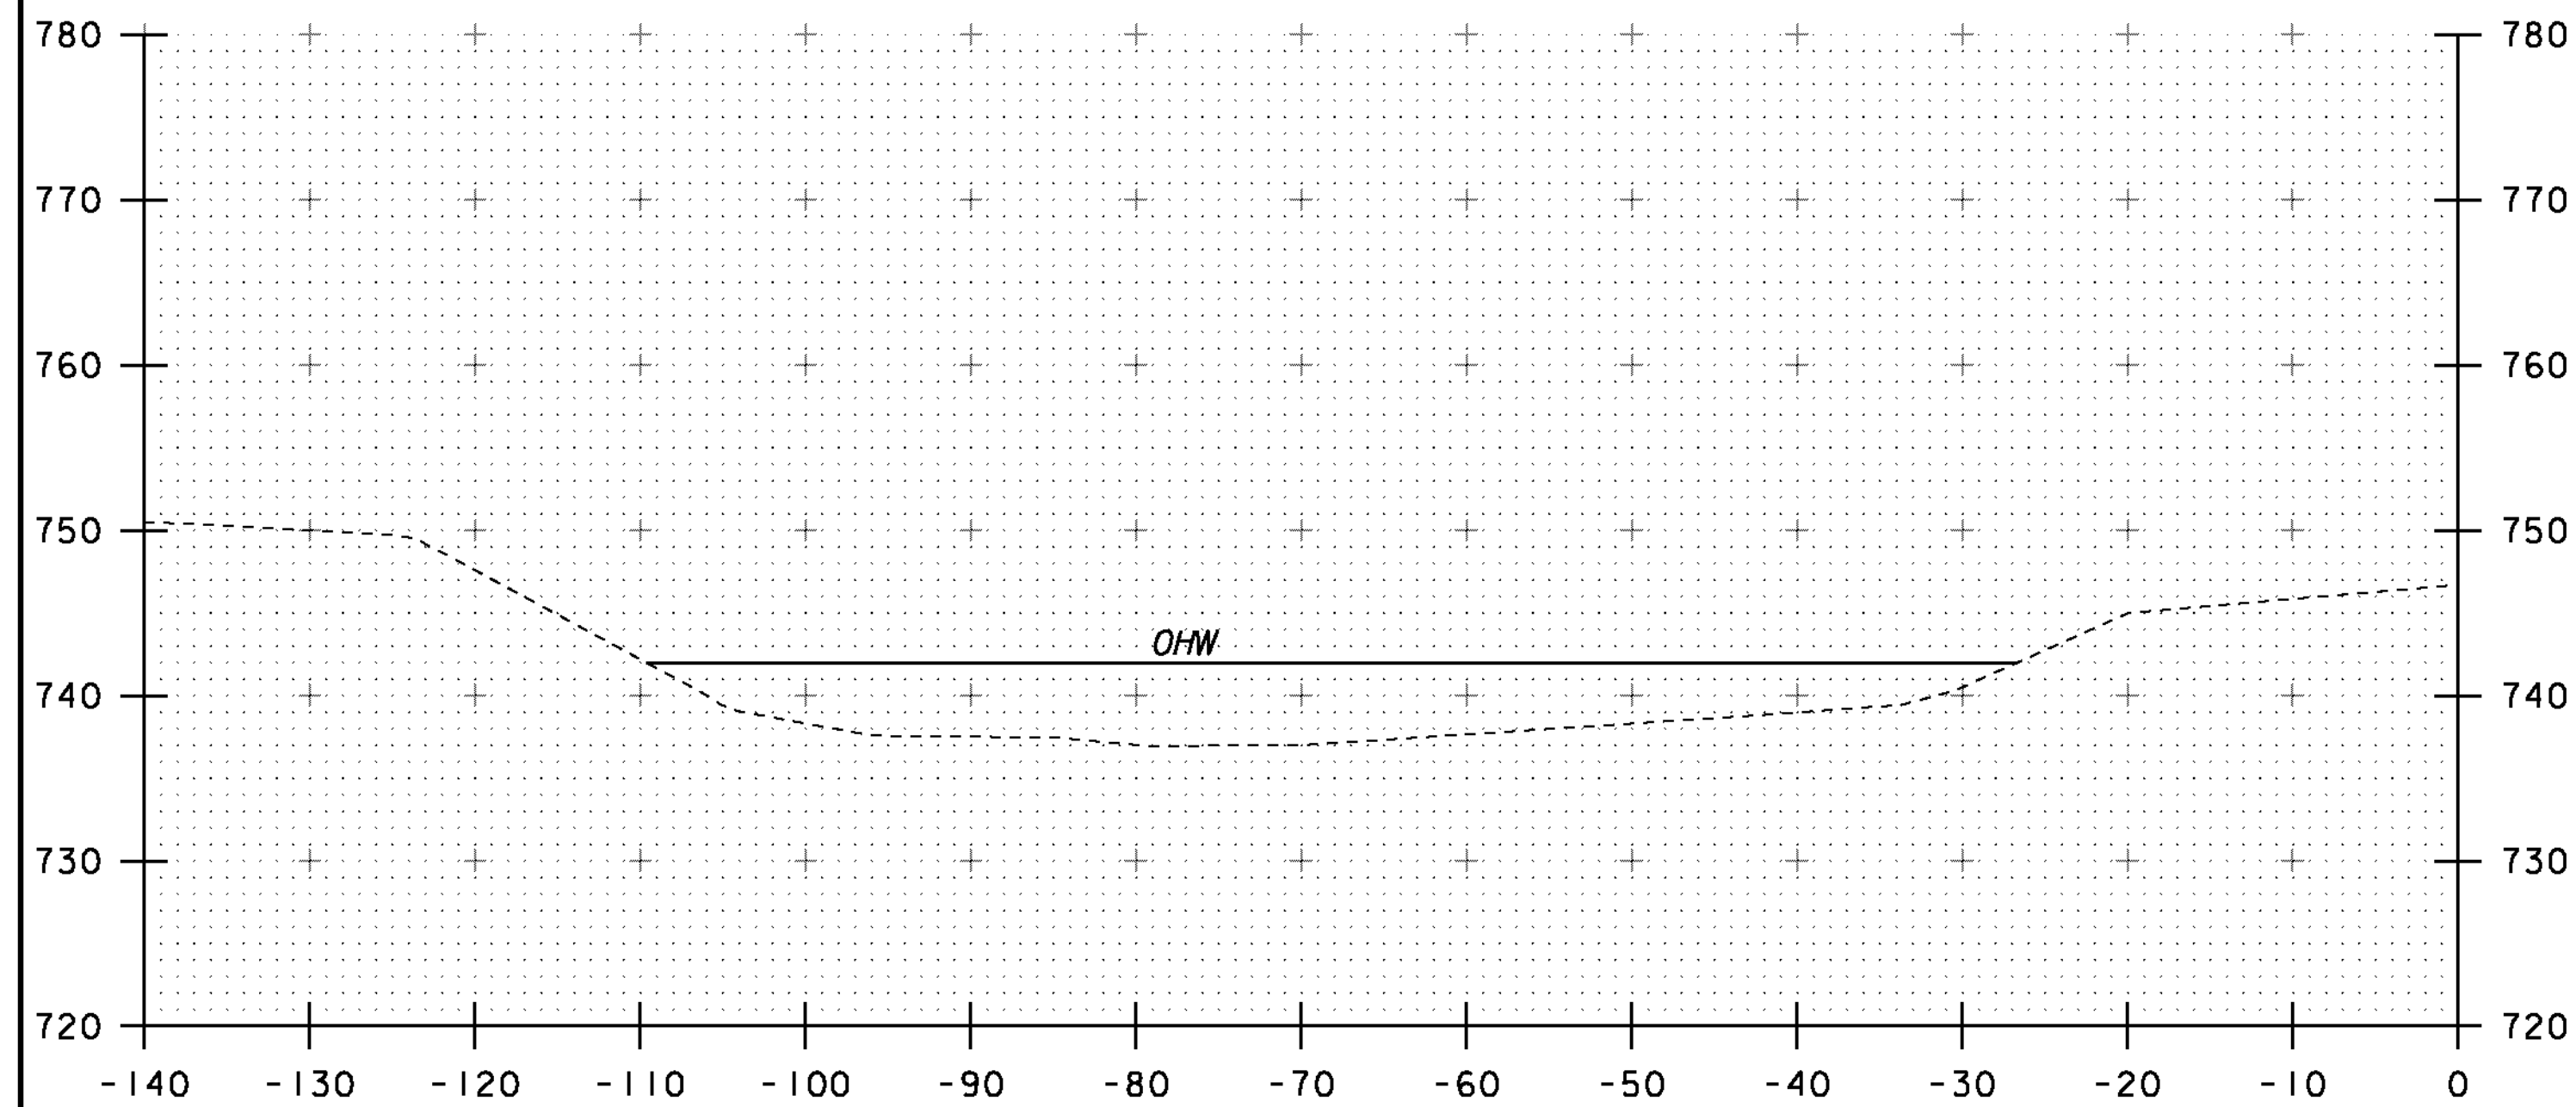


21+75

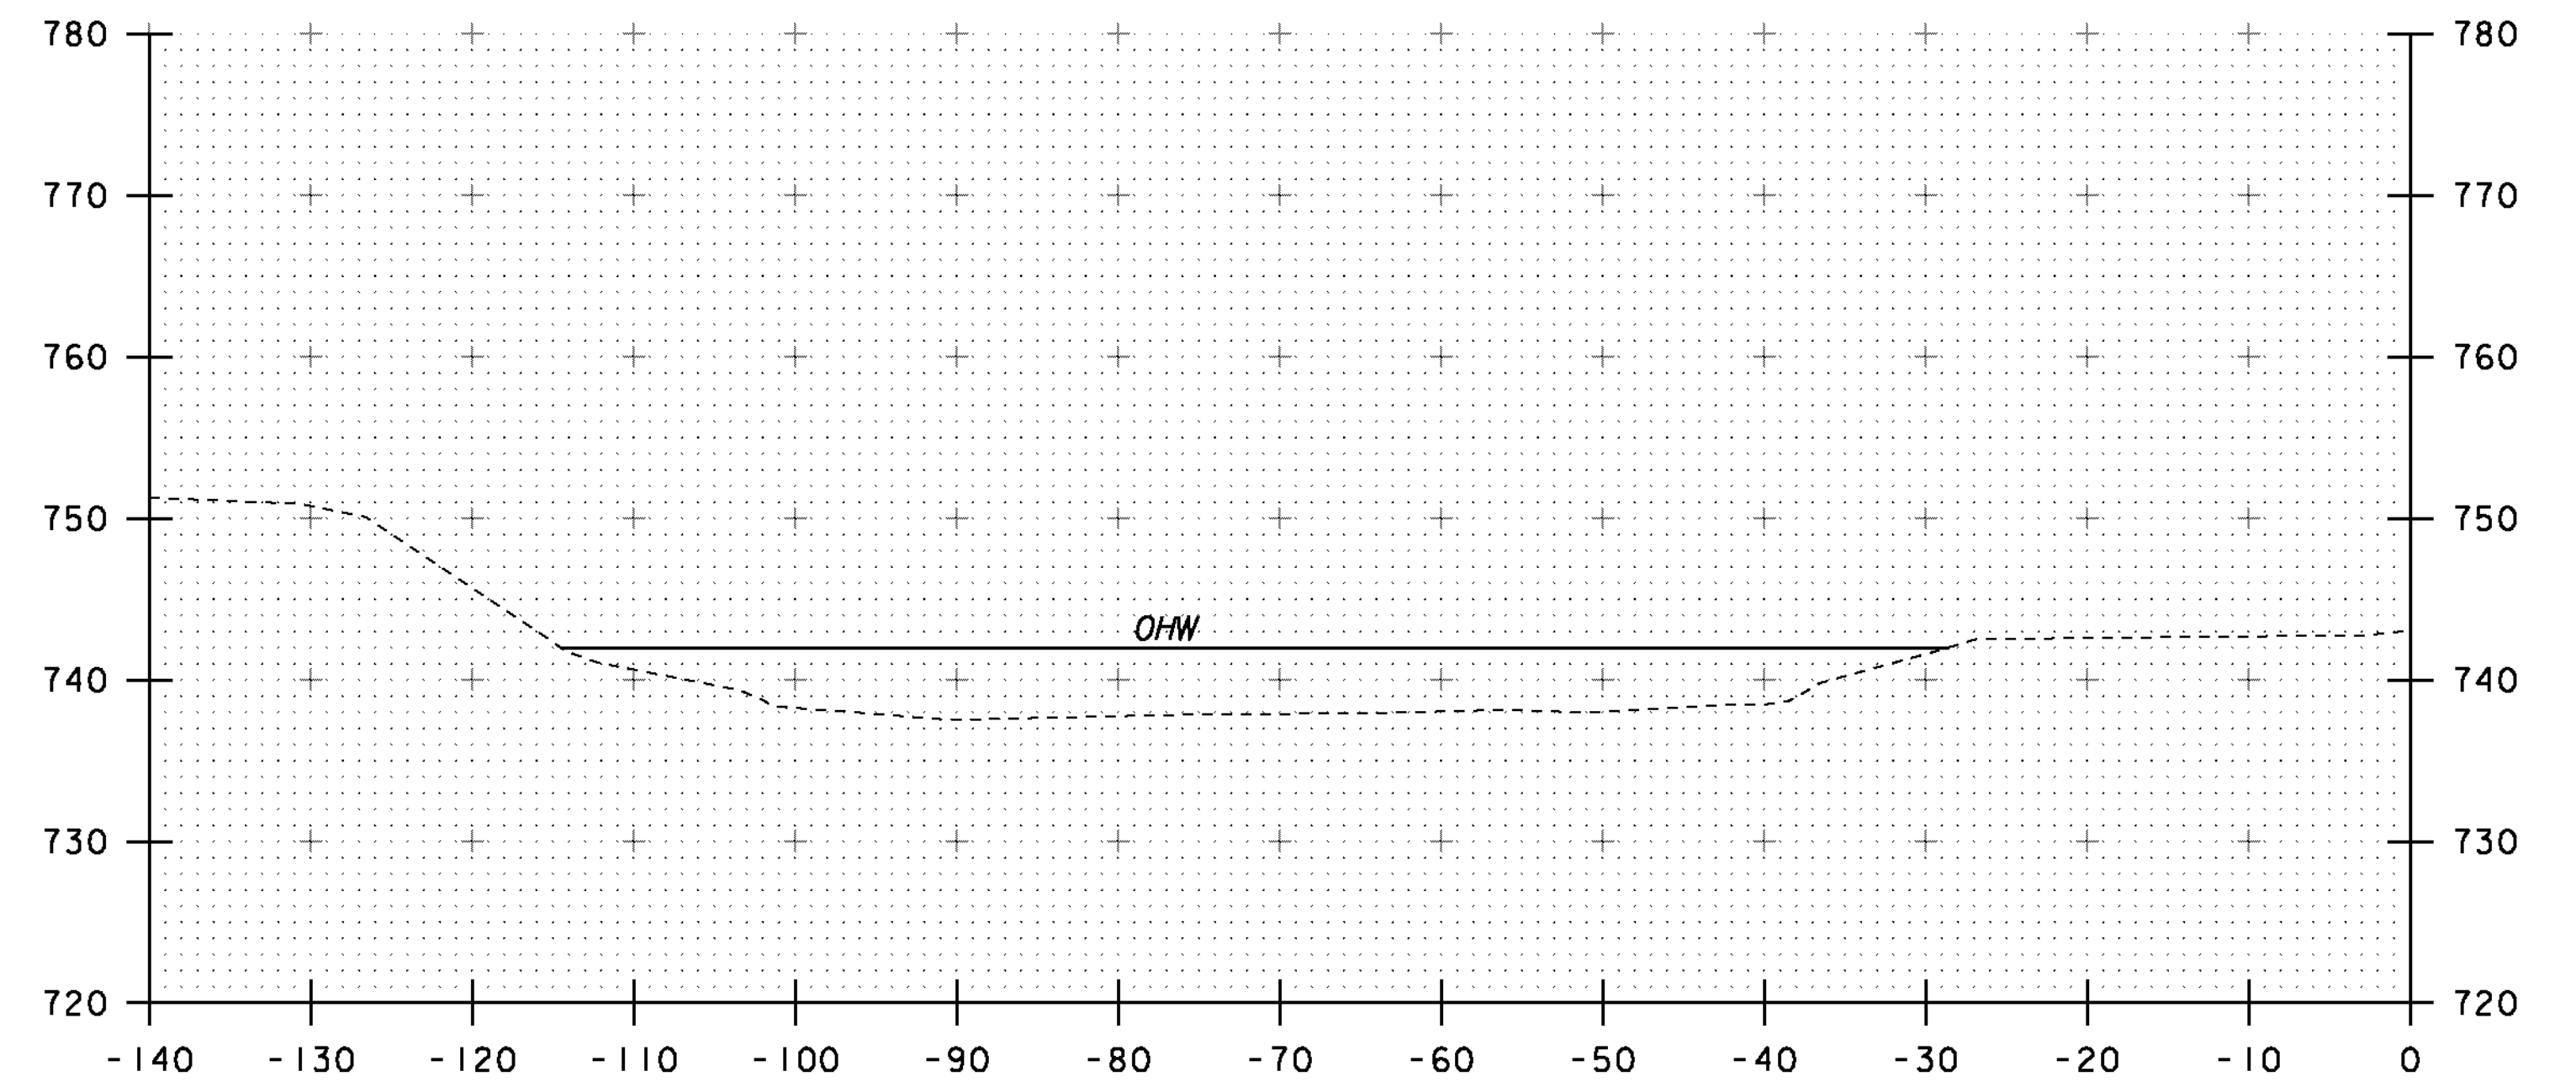

22+25

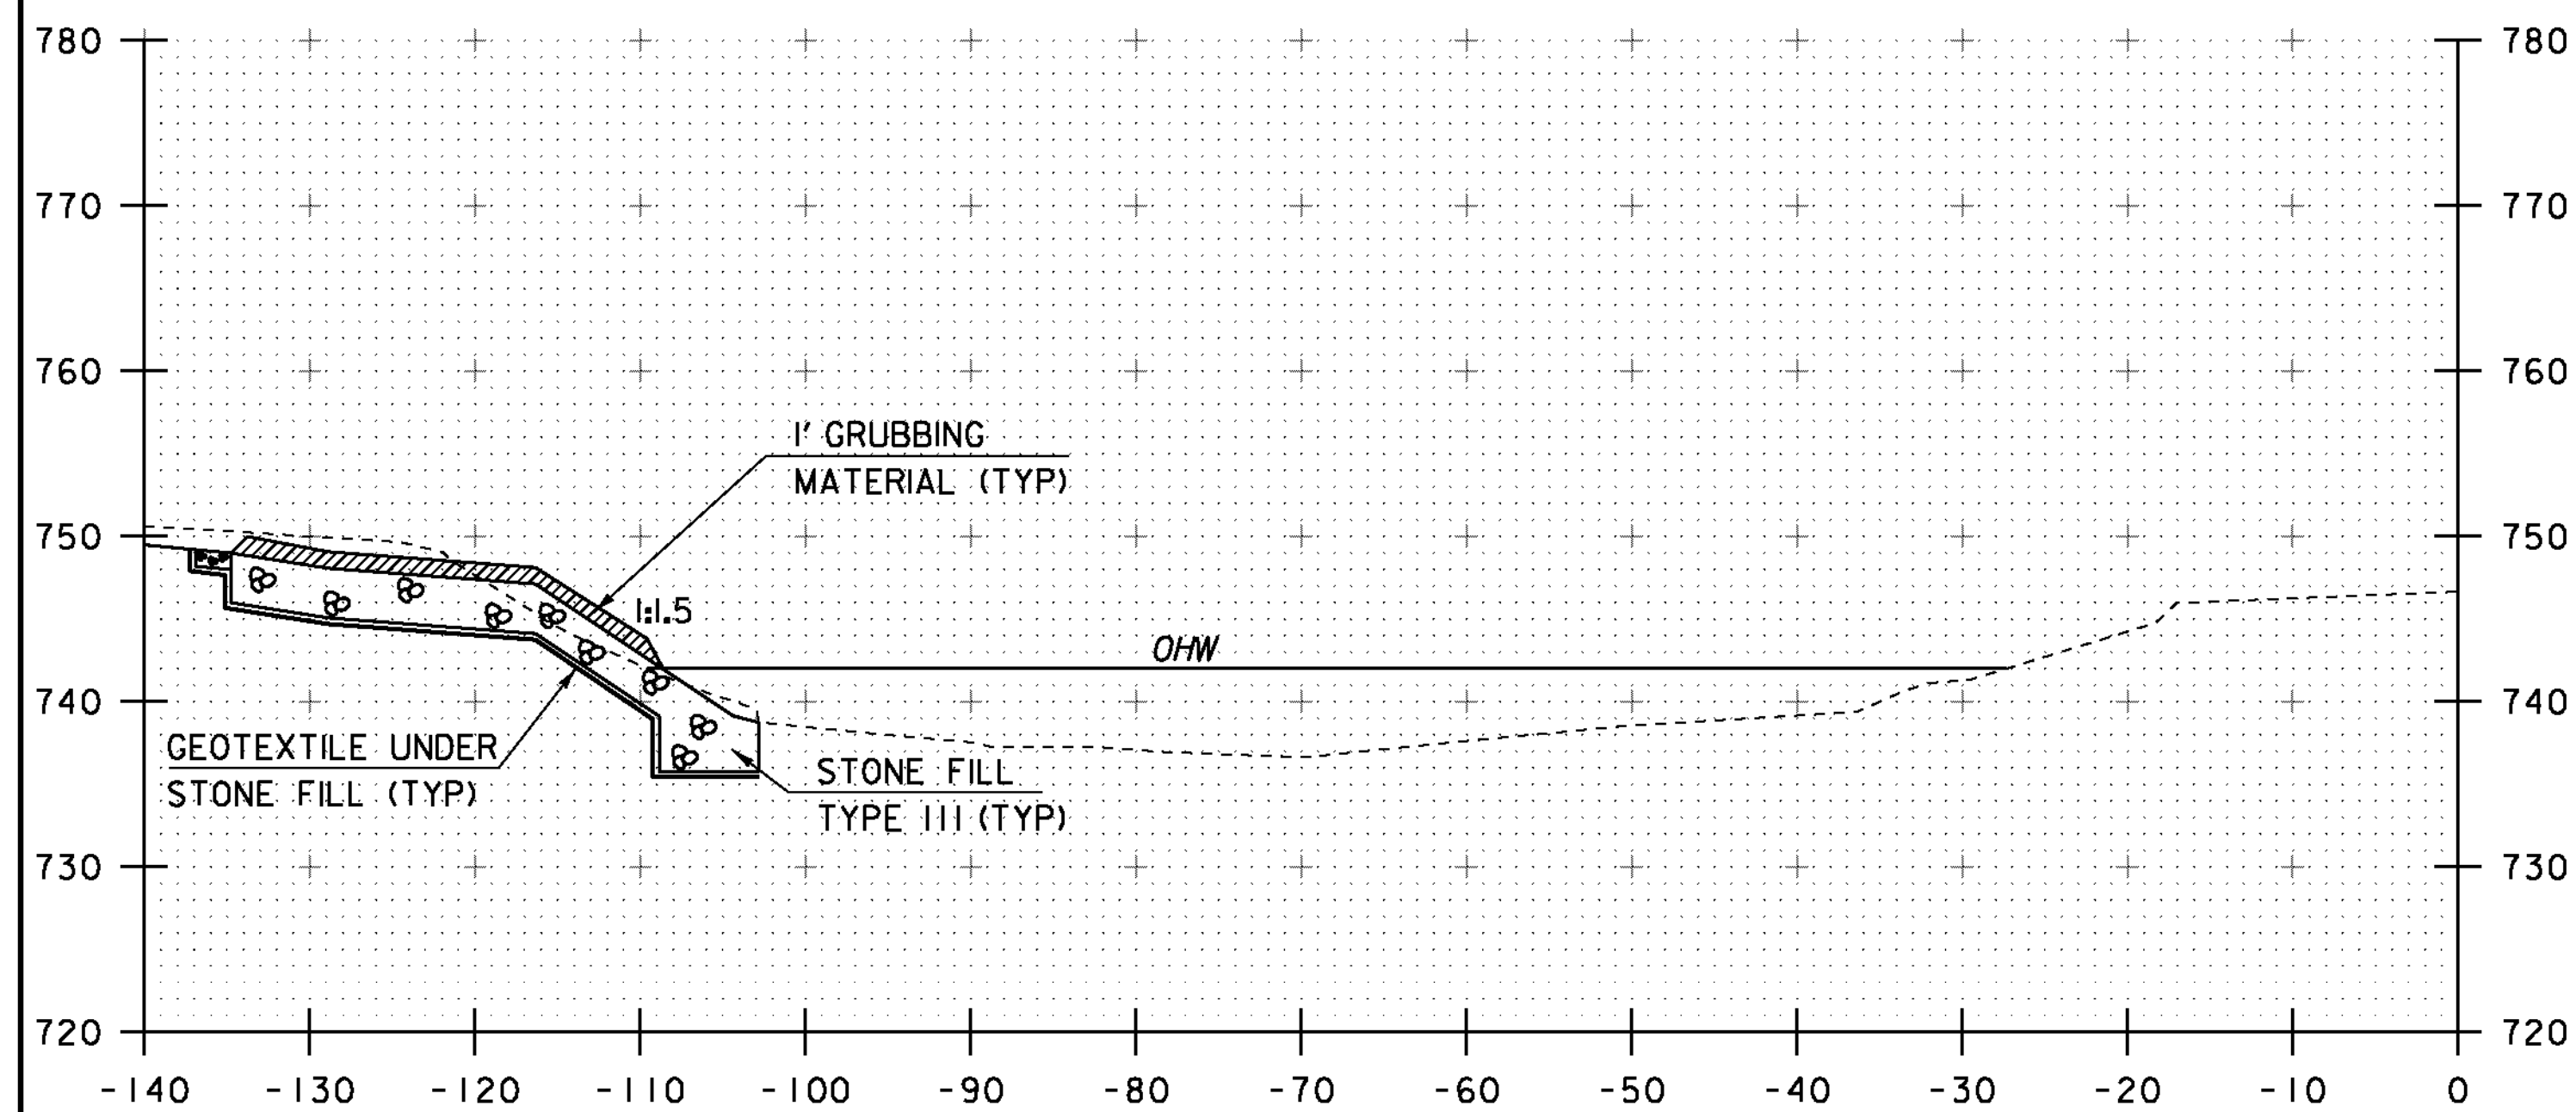


21+50

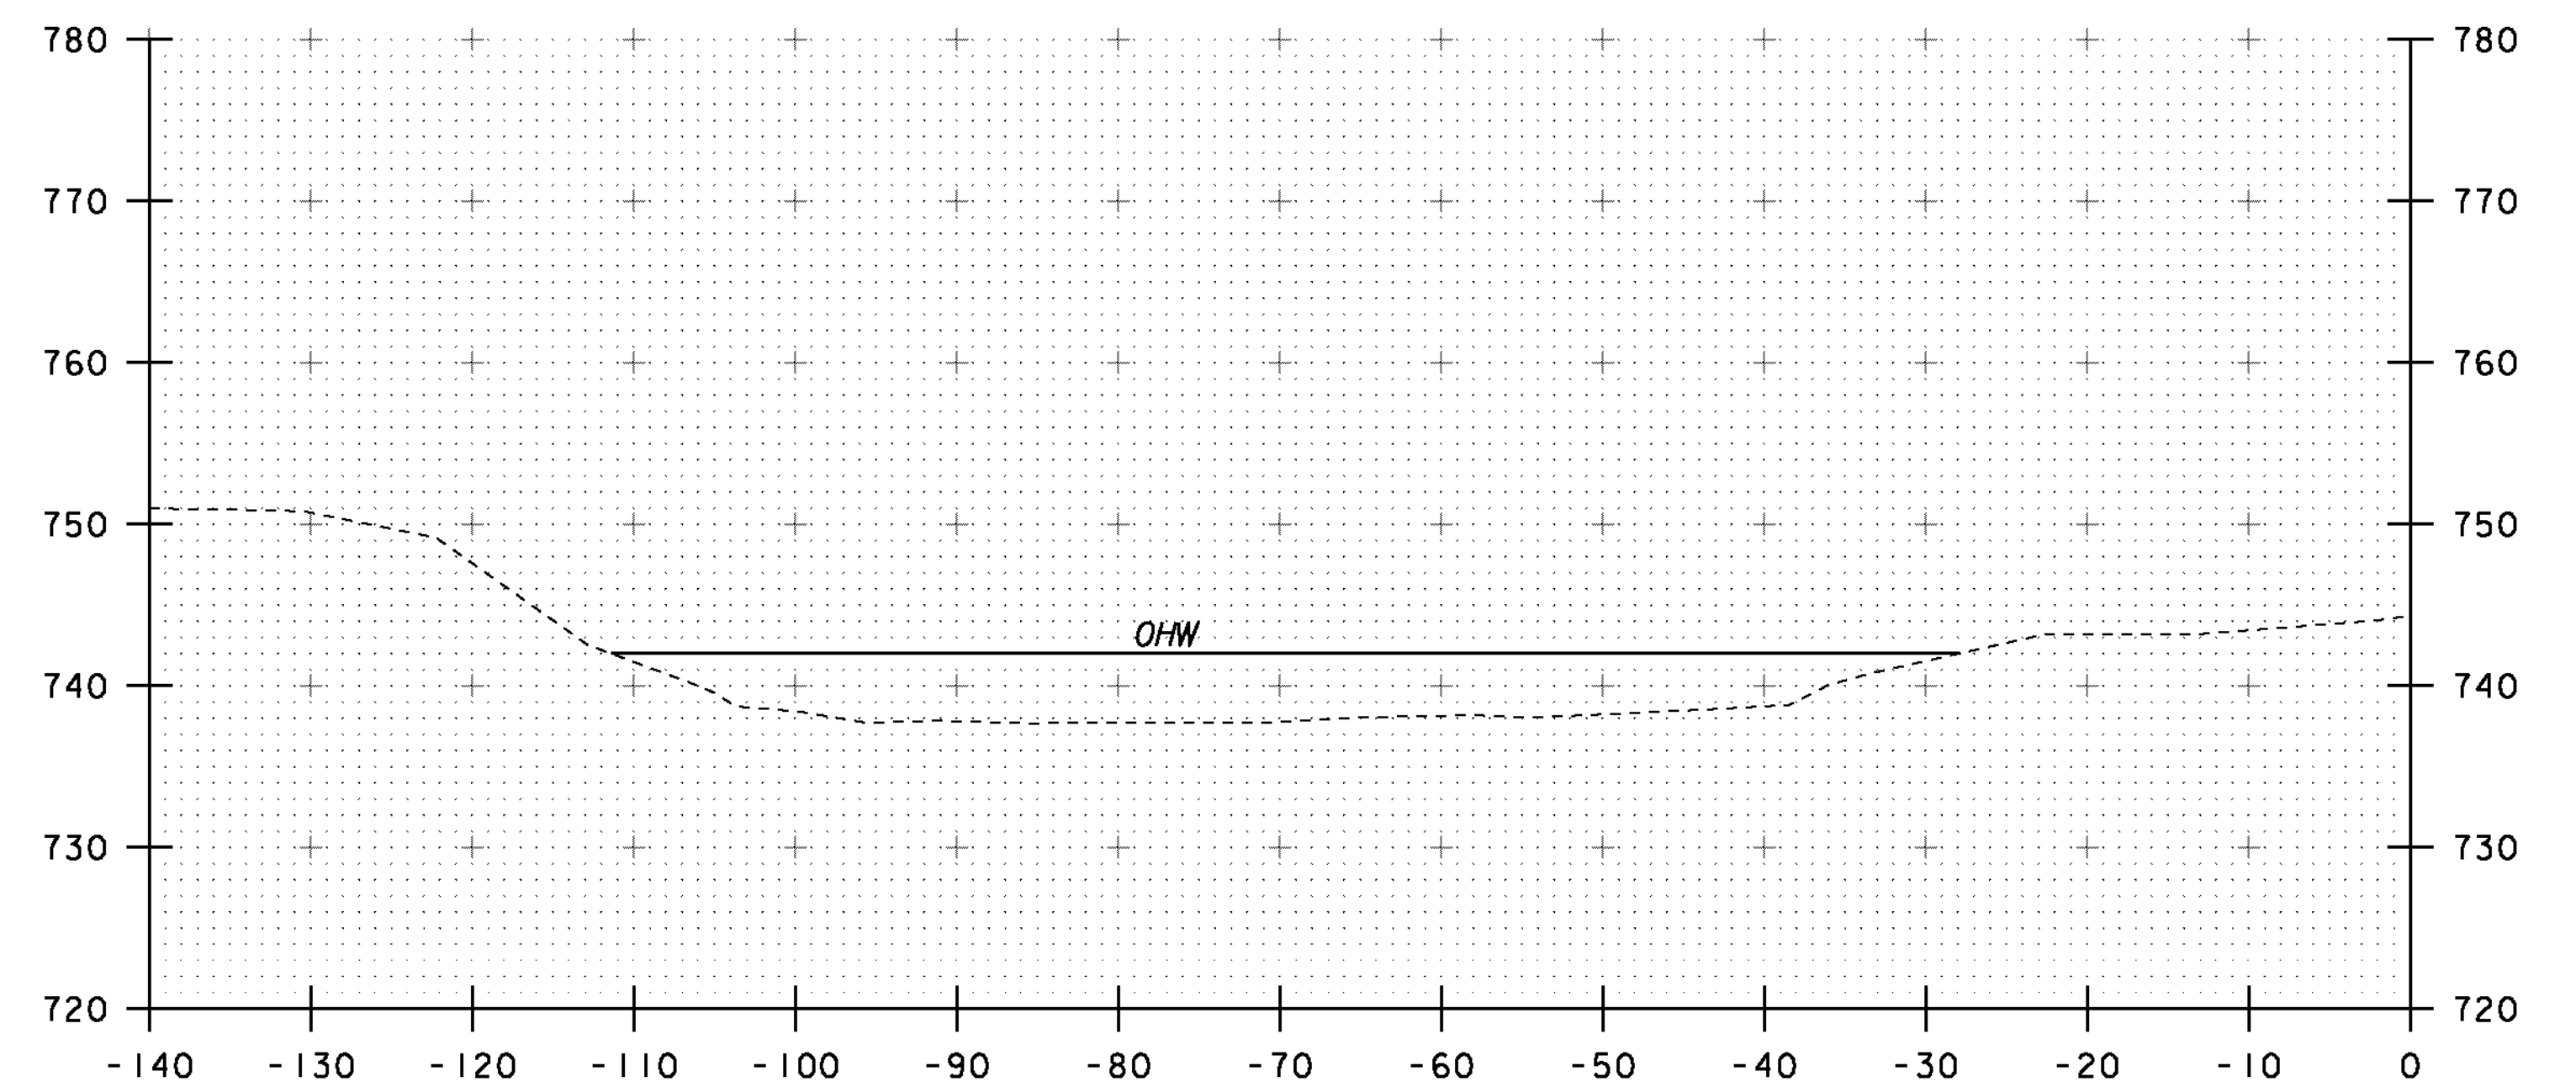

22+00


STA. 21+67 FAR LT
 END UNCLASSIFIED CHANNEL EXCAVATION
 GEOTEXTILE UNDER STONE FILL
 STONE FILL TYPE III
 GRUBBING MATERIAL

STA. 21+52 LT
 END UNCLASSIFIED CHANNEL EXCAVATION
 GEOTEXTILE UNDER STONE FILL
 STONE FILL TYPE III
 GRUBBING MATERIAL

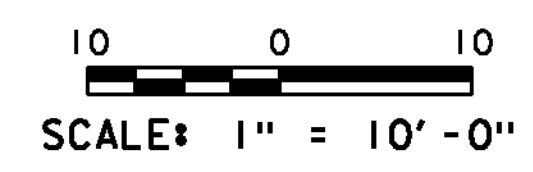

STA. 21+50 TO STA. 22+25



PROJECT NAME: ST. JOHNSBURY	PLOT DATE: 28-AUG-2012
PROJECT NUMBER: BRF 028-4(25)S	DRAWN BY: C. MOONEY
FILE NAME: s98b320xsl.dgn	CHECKED BY: C. CARLSON
PROJECT LEADER: C. CARLSON	SHEET 43 OF 62
DESIGNED BY: H. SALLS	
CHANNEL CROSS SECTIONS 3	

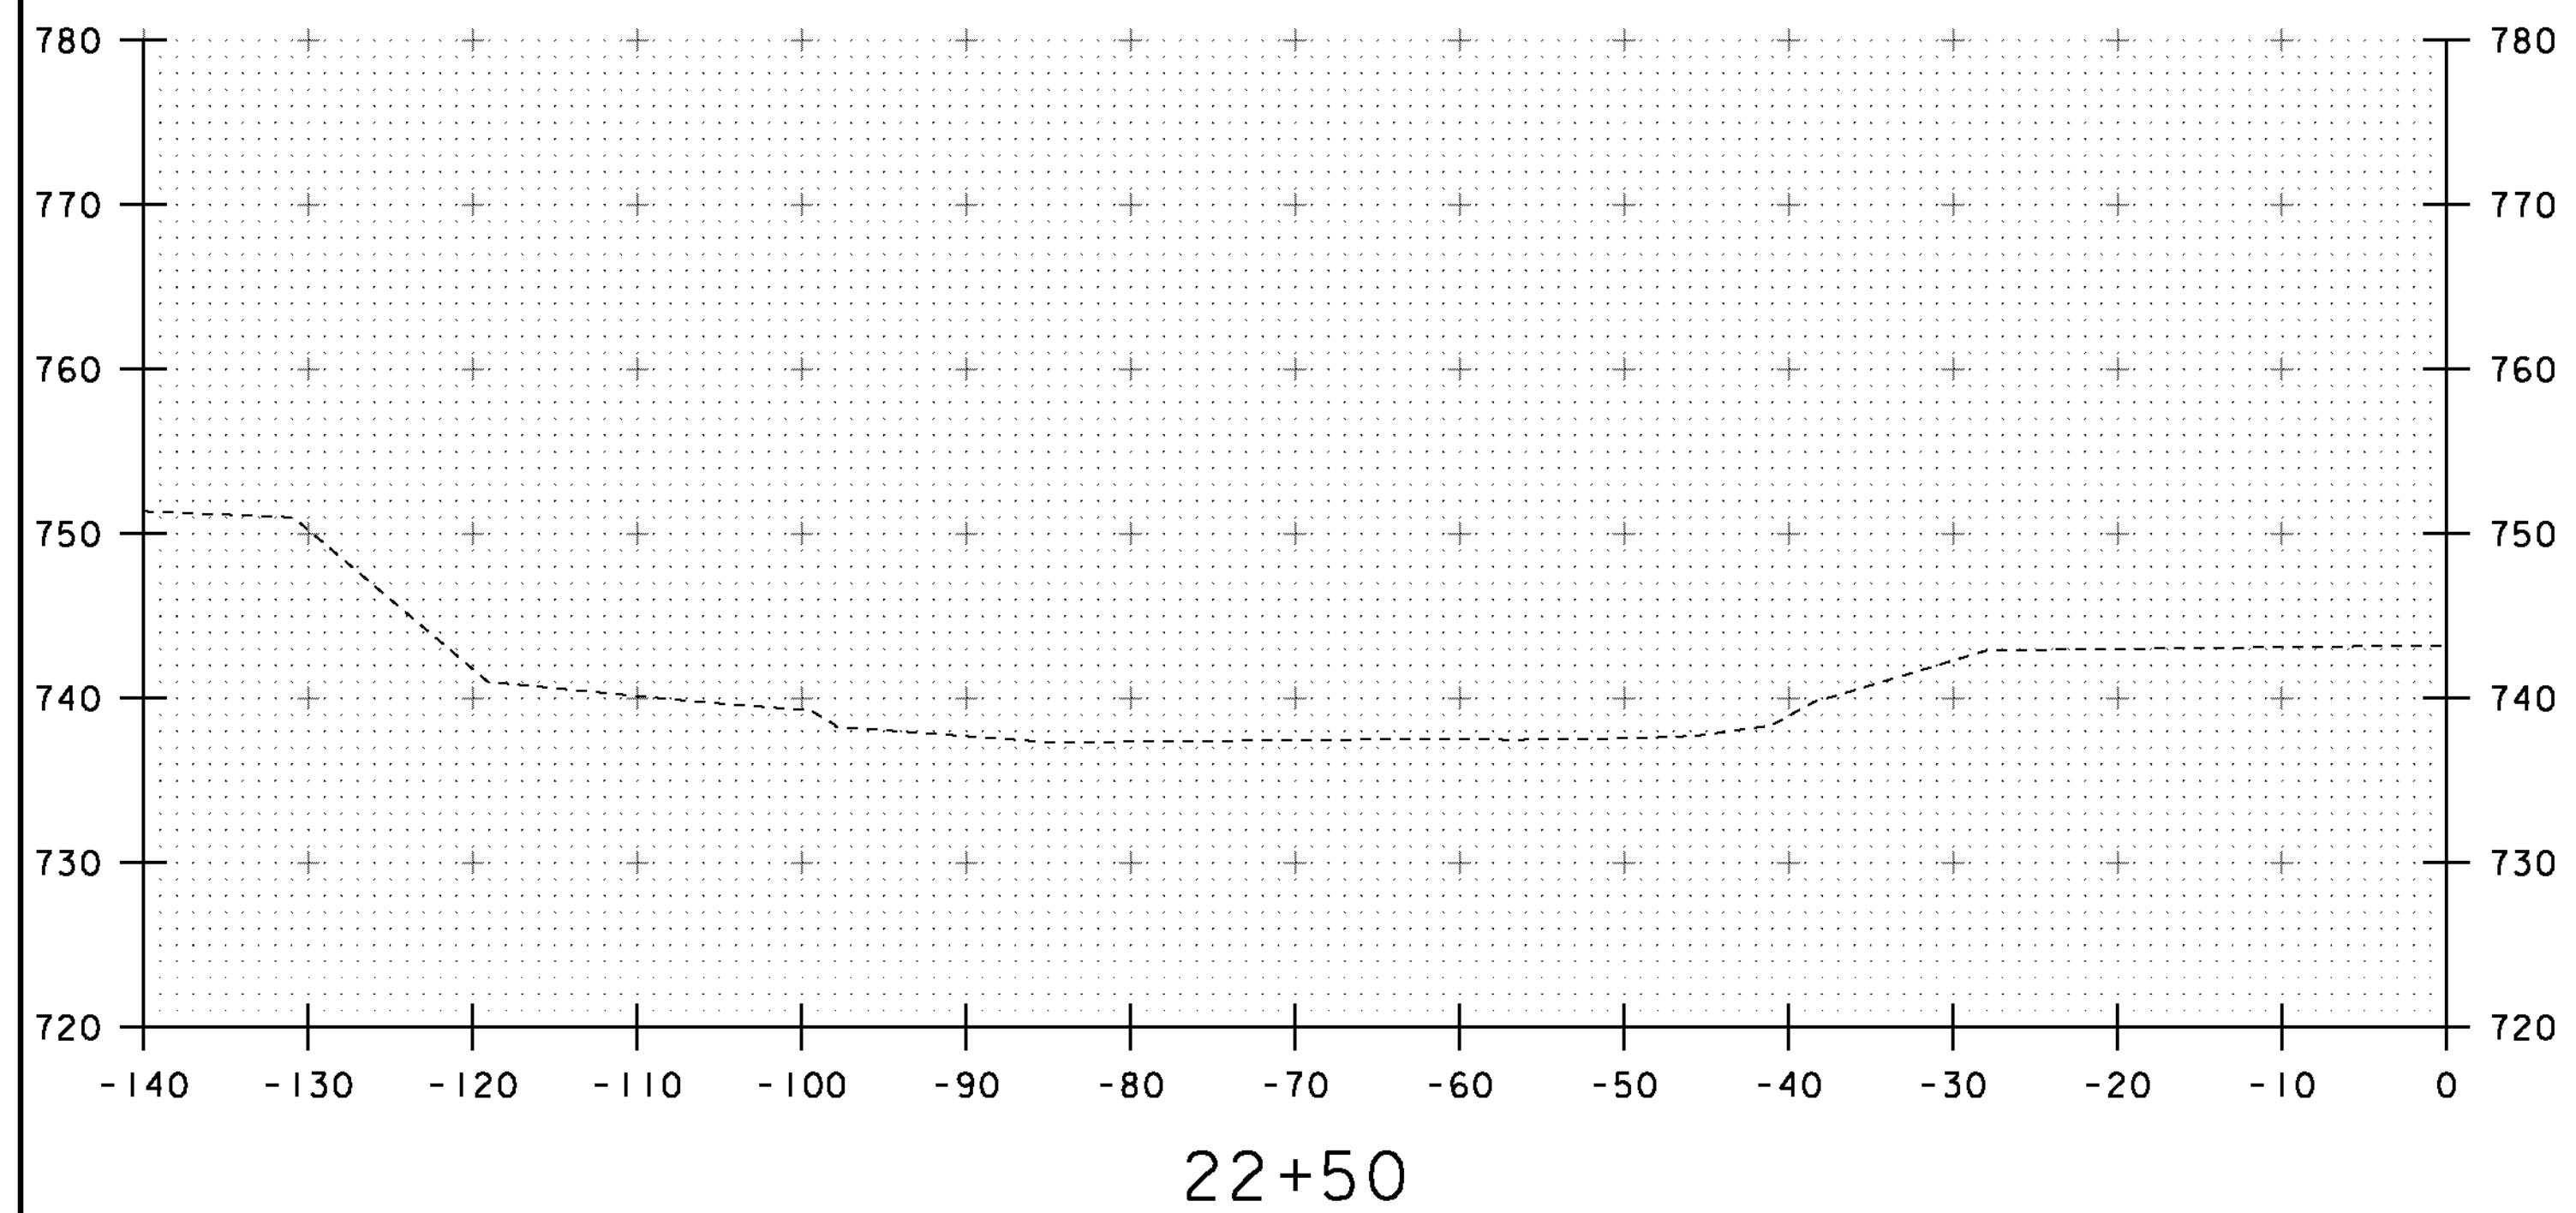

10 0 10
 SCALE: 1" = 10'-0"

STA. 22+50



PROJECT NAME: ST. JOHNSBURY	PLOT DATE: 28-AUG-2012
PROJECT NUMBER: BRF 028-4(25)S	DRAWN BY: C. MOONEY
FILE NAME: s98b320xsl.dgn	CHECKED BY: C. CARLSON
PROJECT LEADER: C. CARLSON	SHEET 44 OF 62
DESIGNED BY: H. SALLS	
CHANNEL CROSS SECTIONS 4	

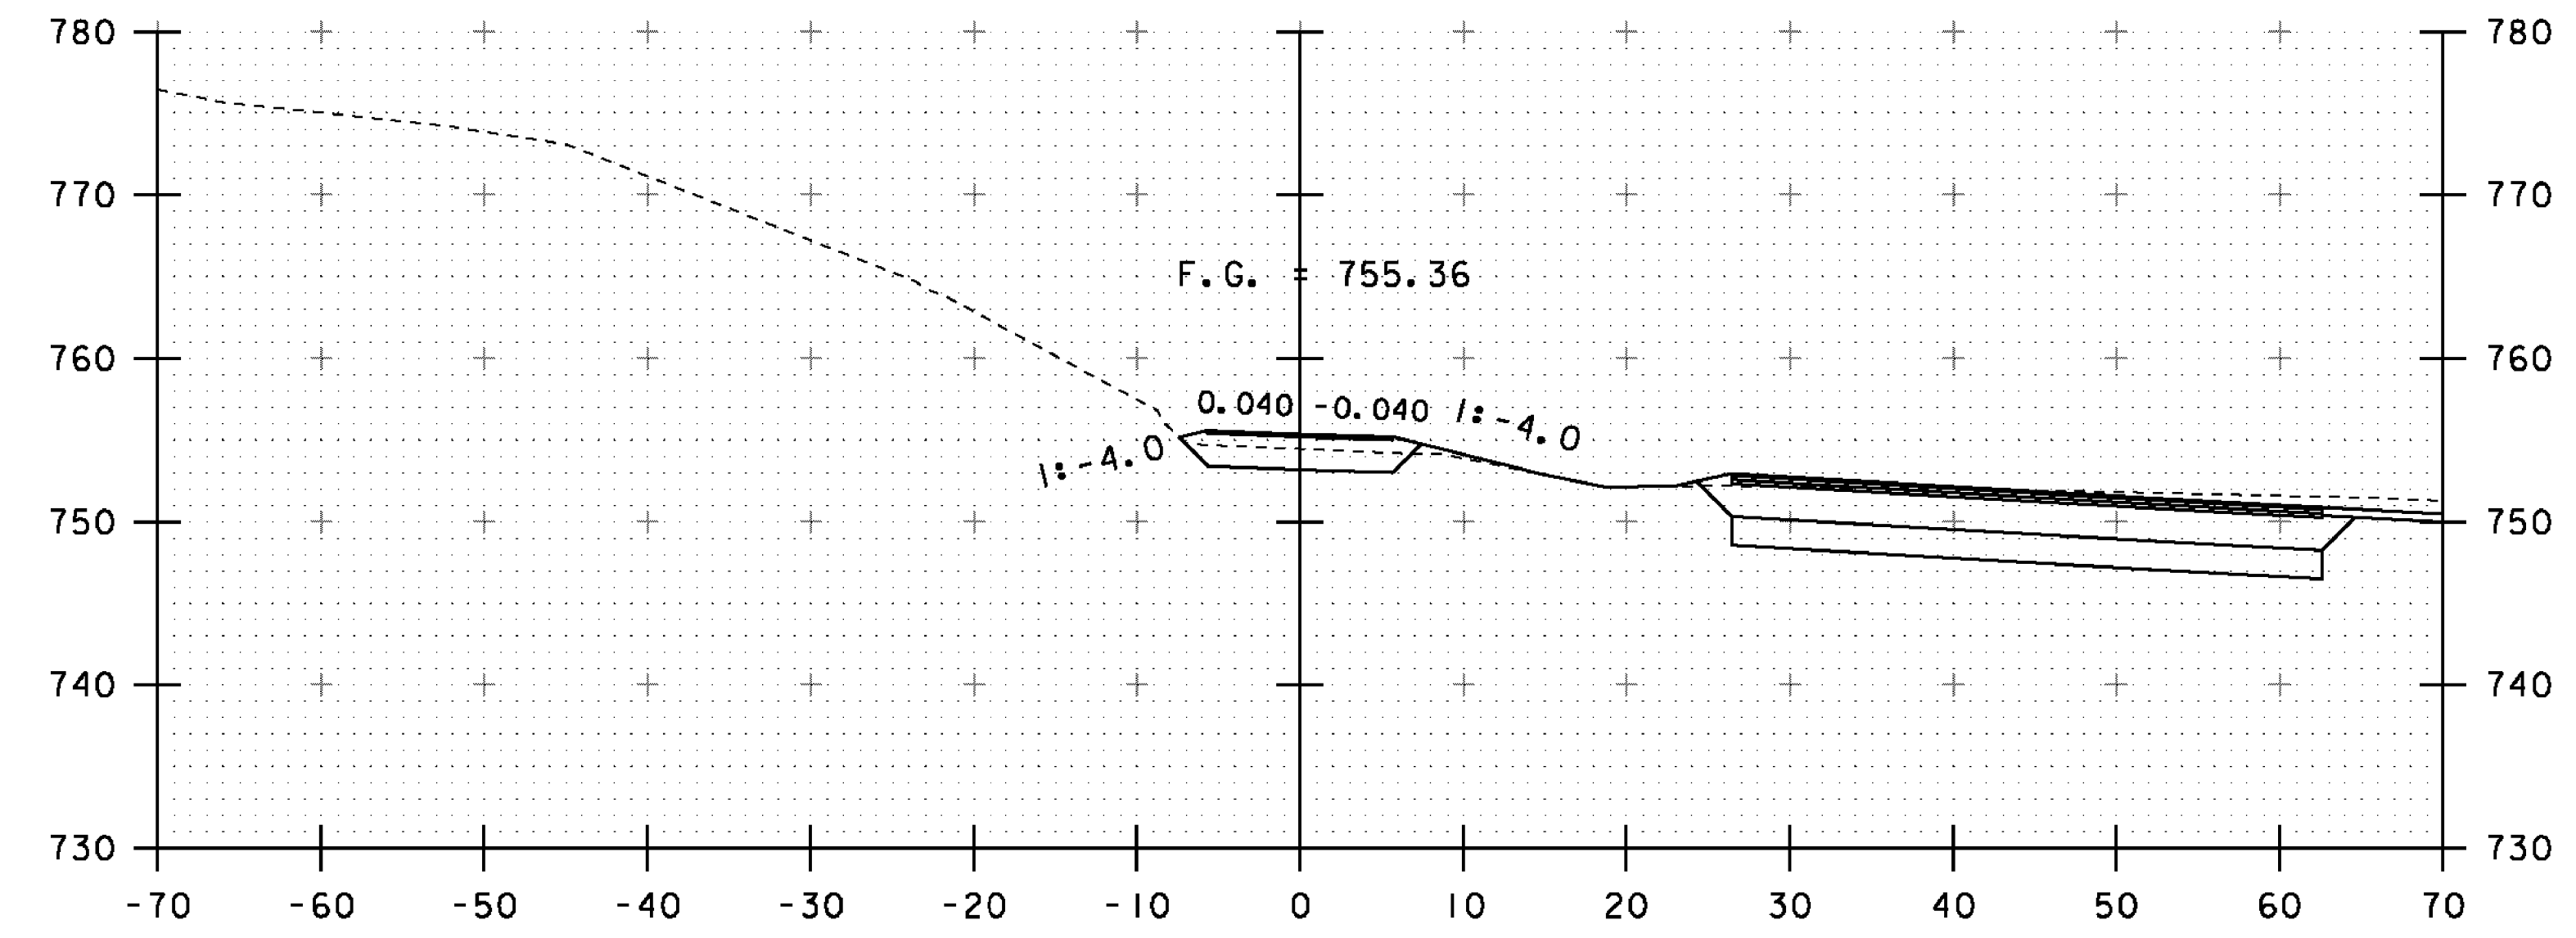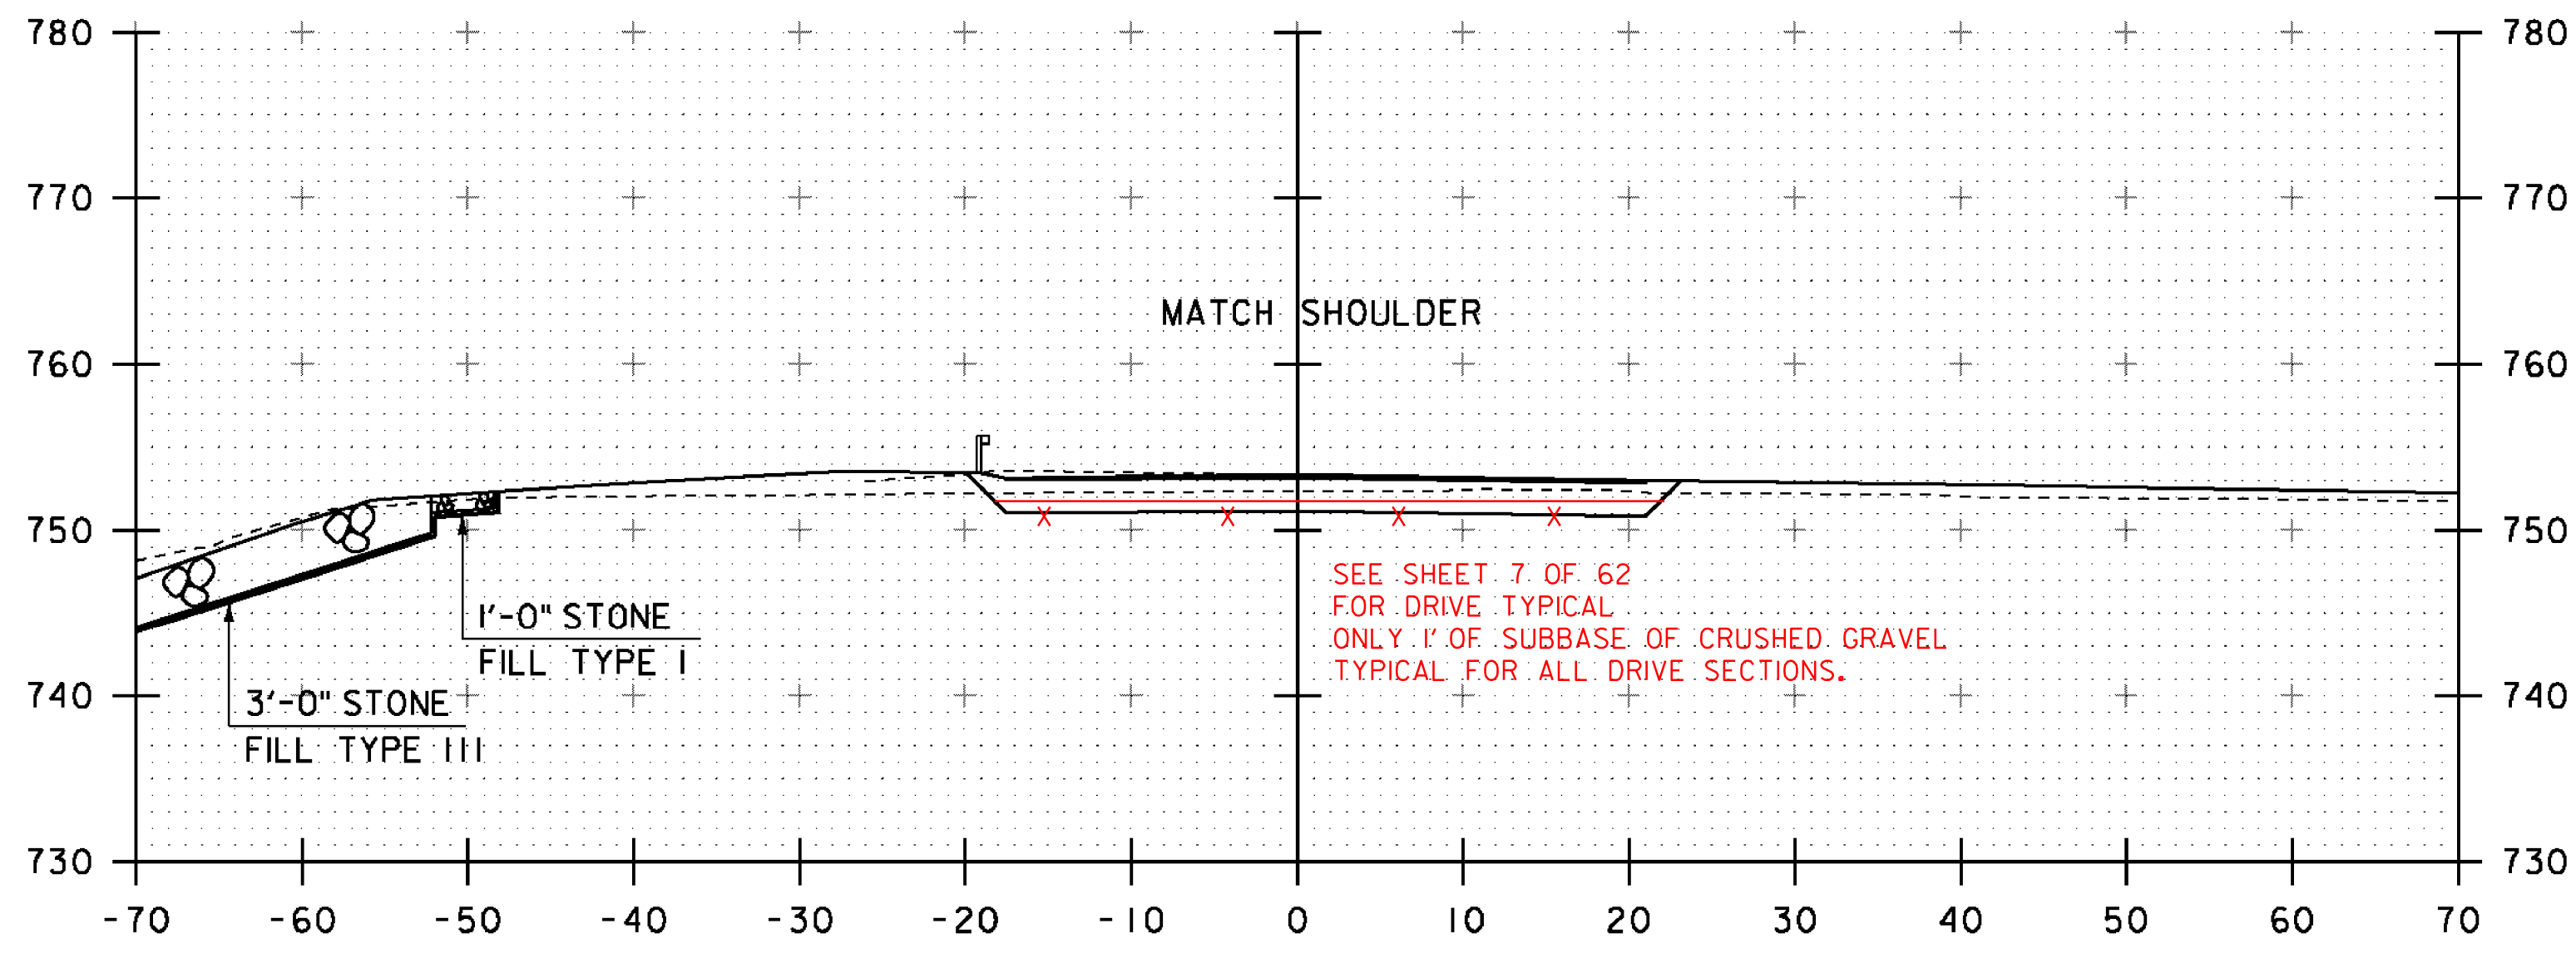

STA. 30+15.96
BEGIN DRIVE 1


30+16

30+50

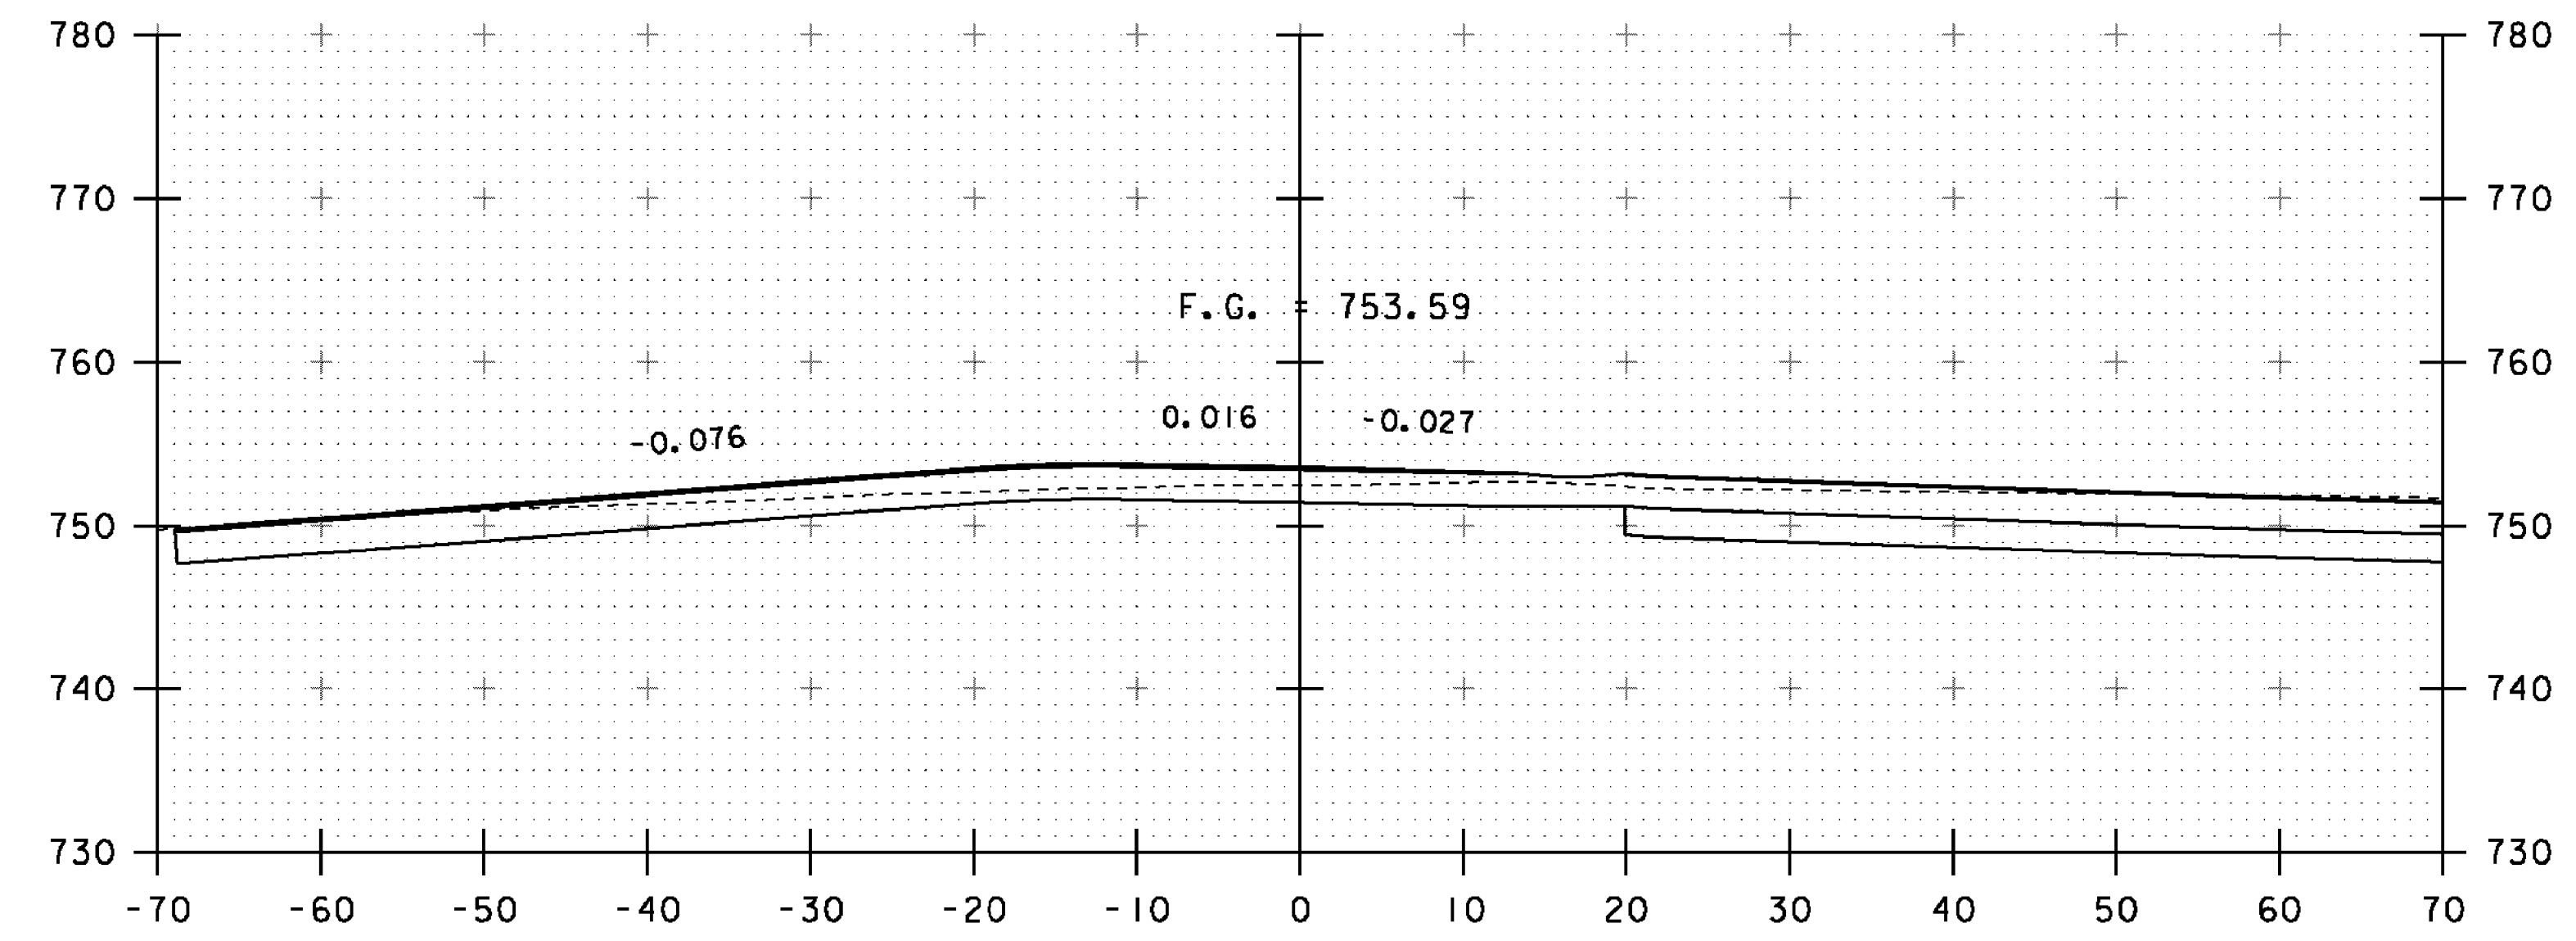
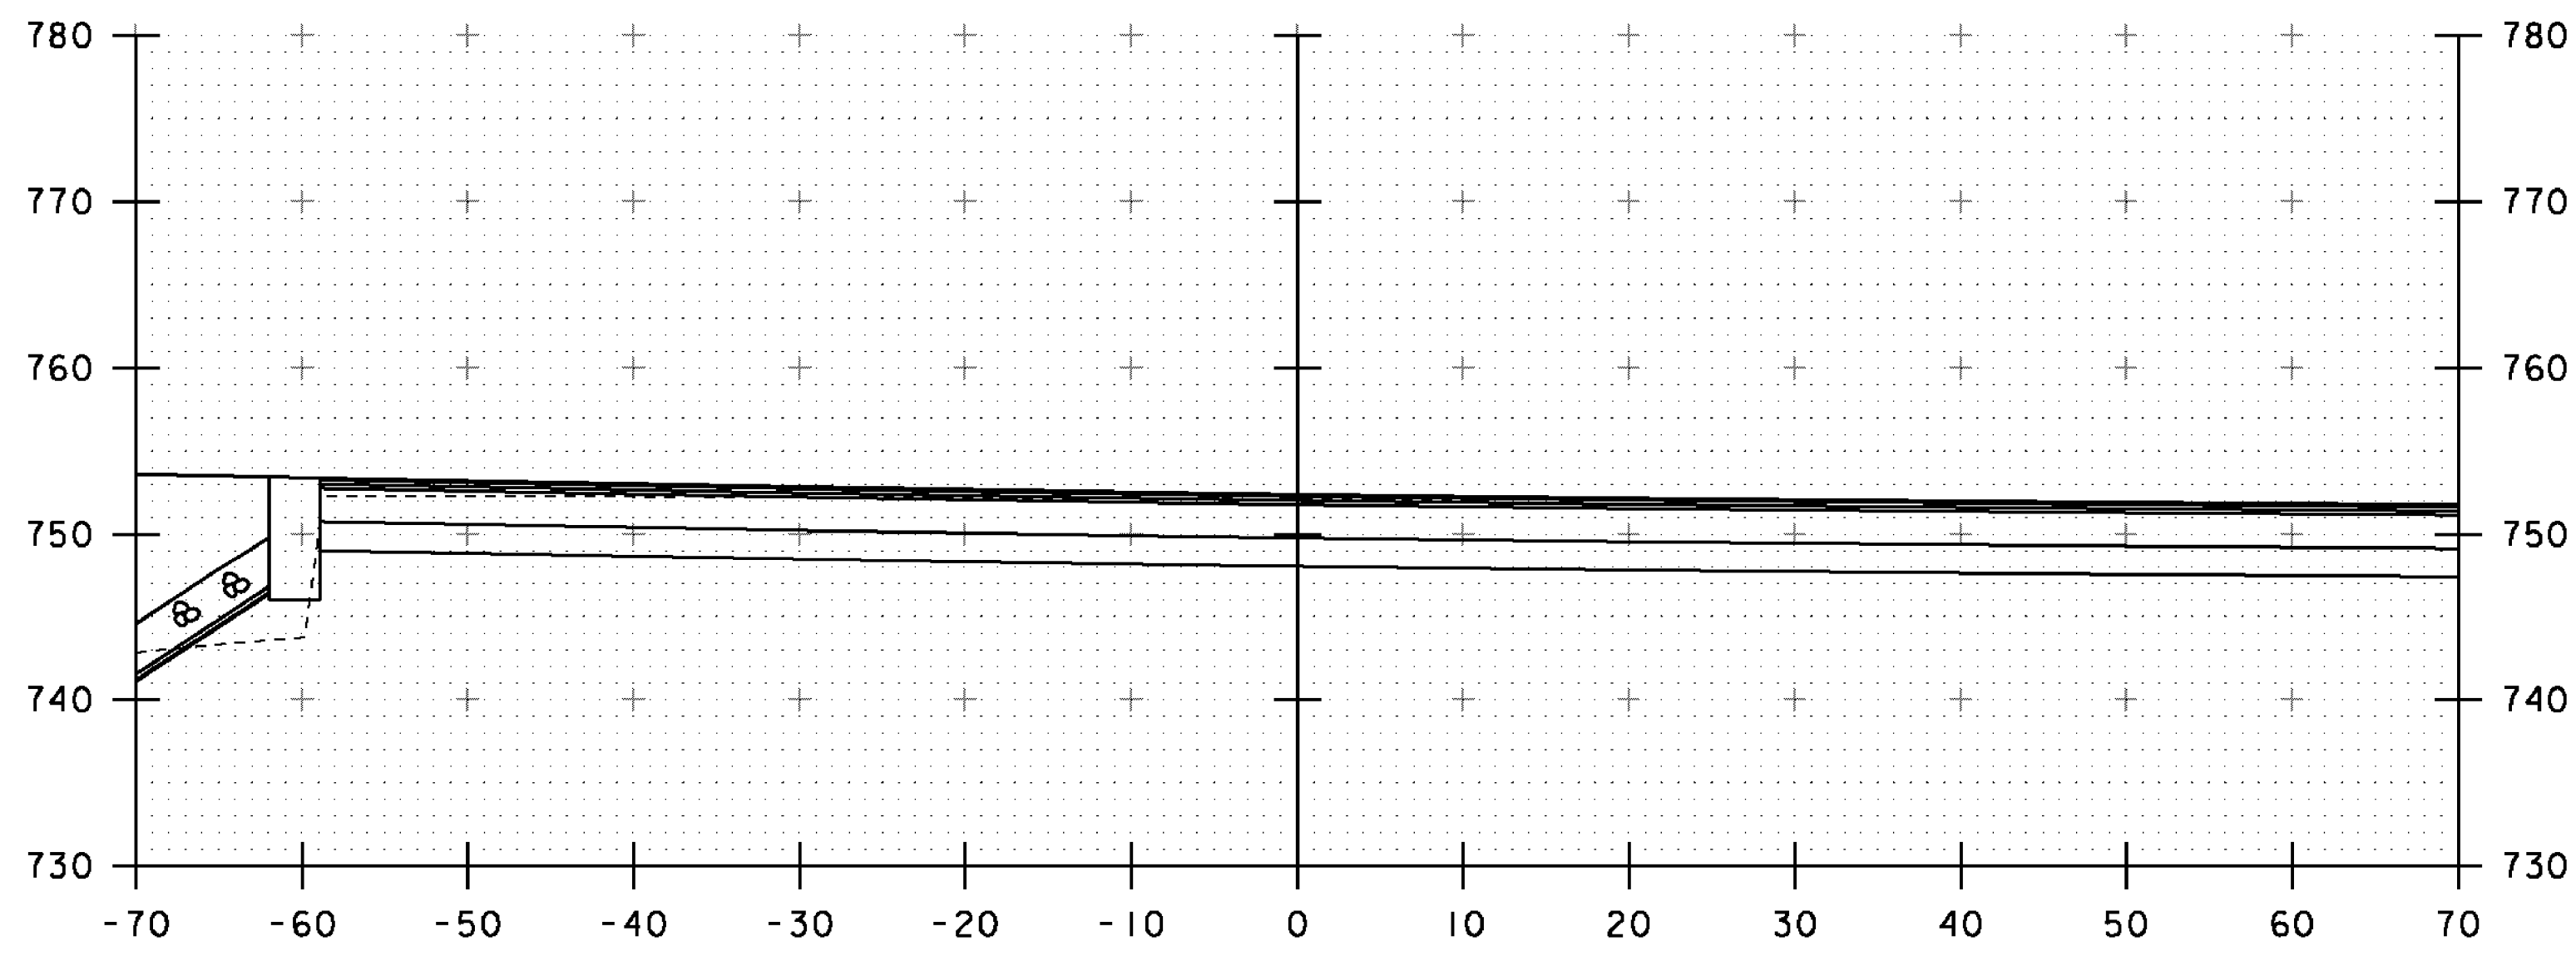


30+00


30+25

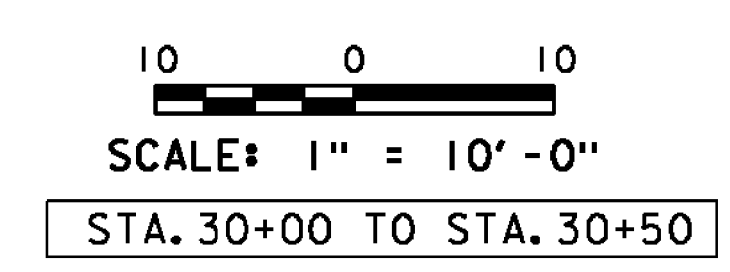

PROJECT NAME: ST. JOHNSBURY	
PROJECT NUMBER: BRF 028-4(25)S	
FILE NAME: s98b320xsl.dgn	PLOT DATE: 28-AUG-2012
PROJECT LEADER: C. CARLSON	DRAWN BY: C. MOONEY
DESIGNED BY: H. SALLS	CHECKED BY: C. CARLSON
DRIVE 1 CROSS SECTIONS 1	SHEET 45 OF 62

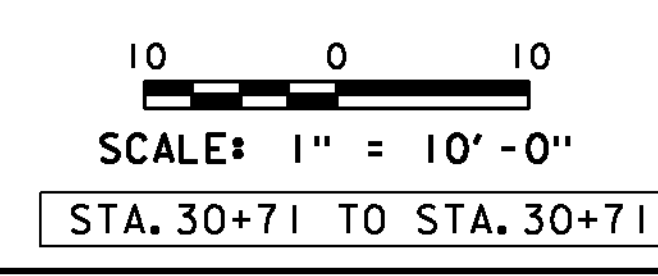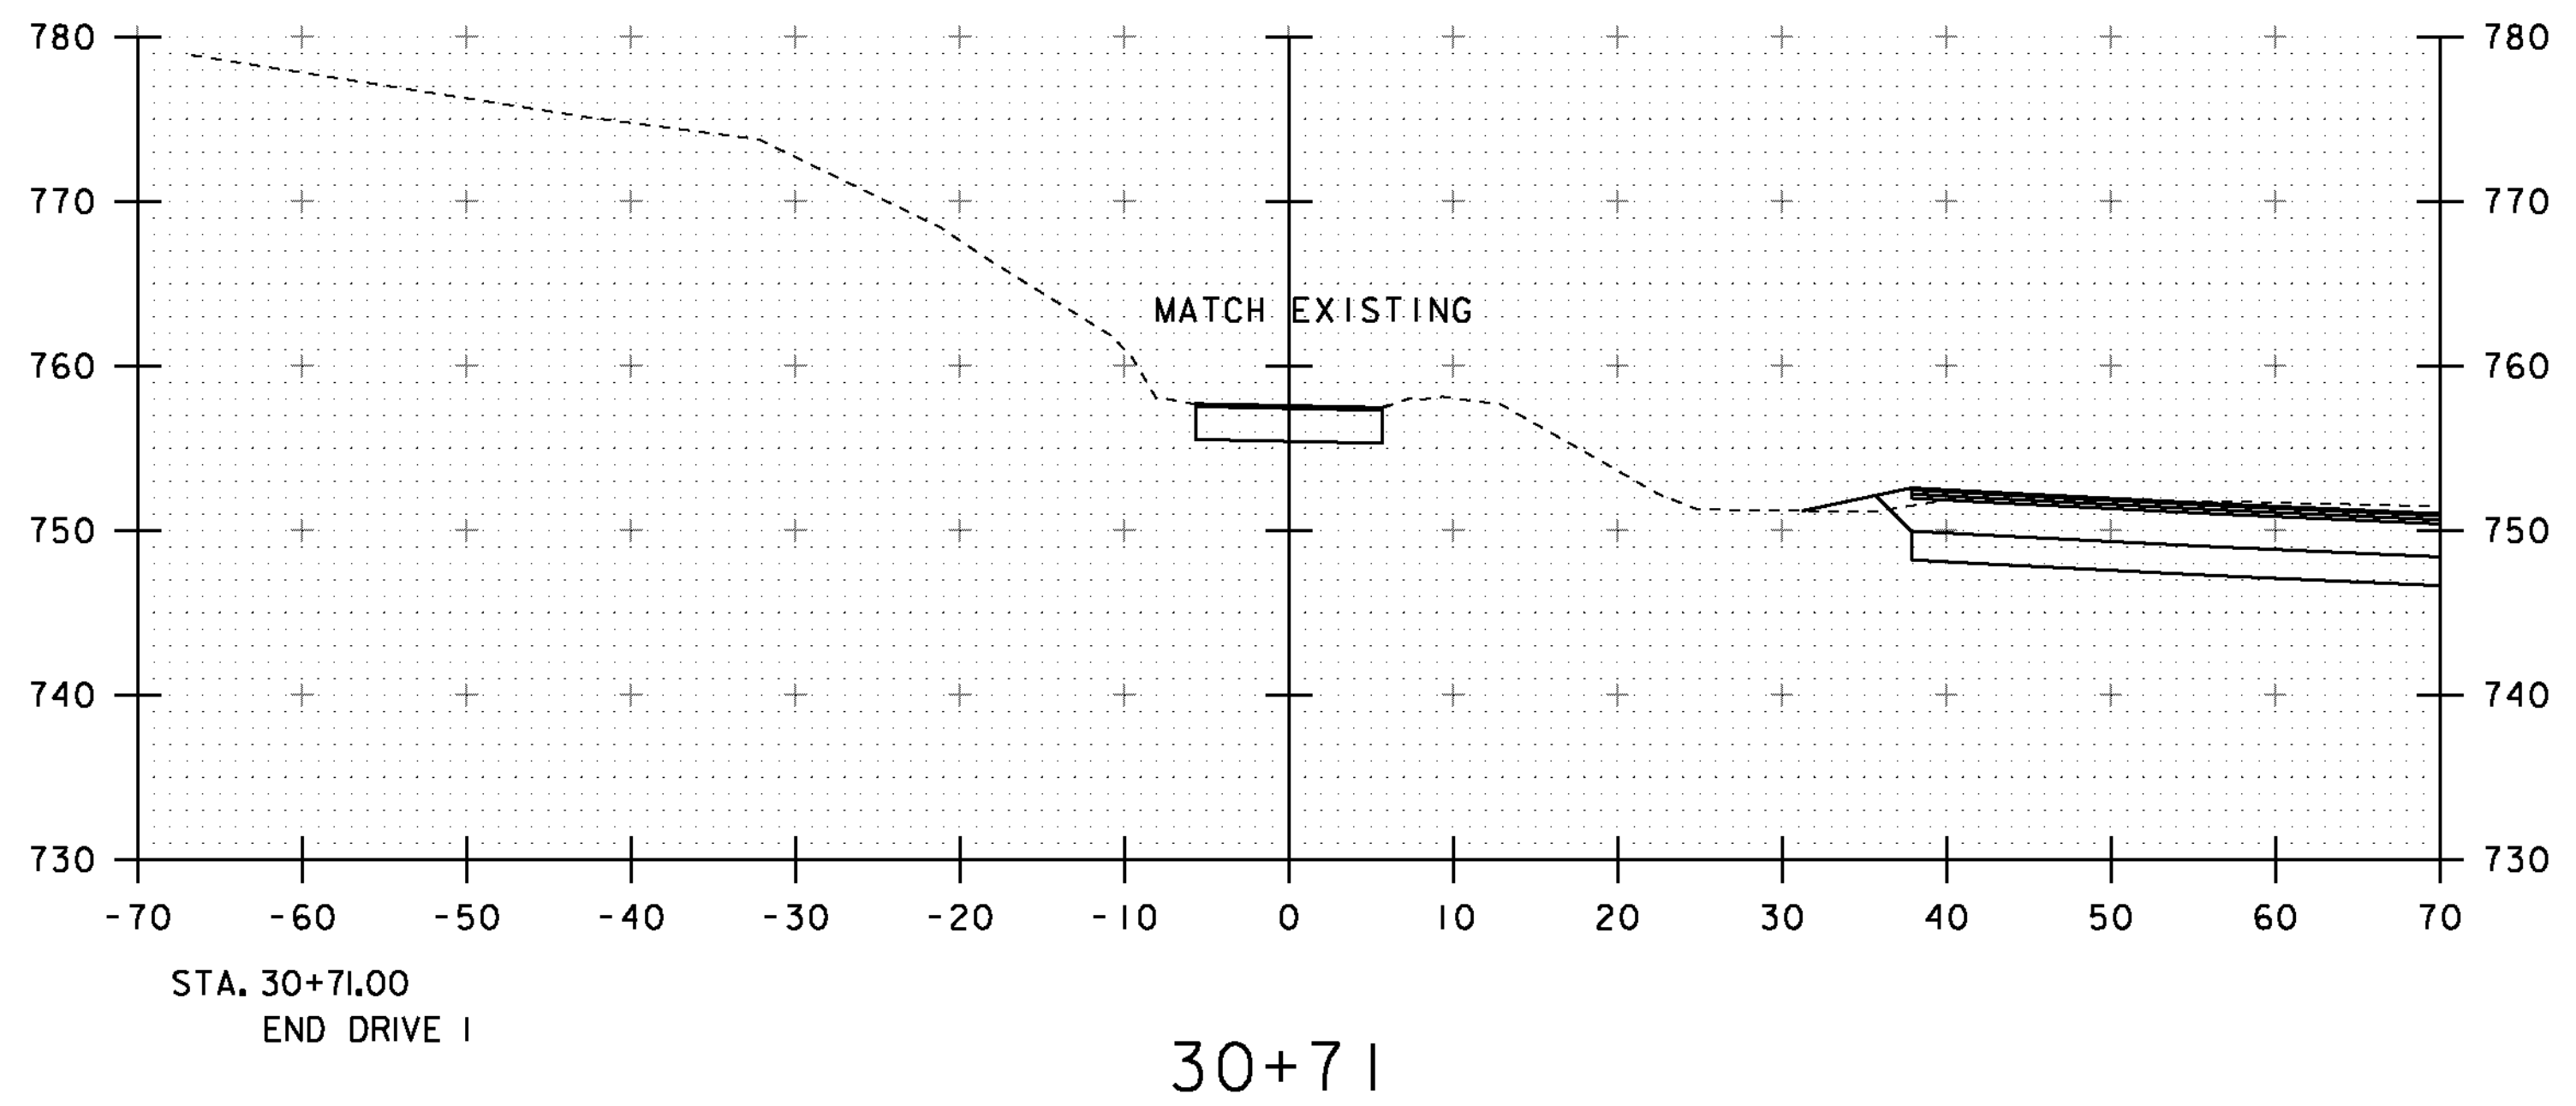


PROJECT NAME: ST. JOHNSBURY	
PROJECT NUMBER: BRF 028-4(25)S	
FILE NAME: s98b320xsl.dgn	PLOT DATE: 28-AUG-2012
PROJECT LEADER: C. CARLSON	DRAWN BY: C. MOONEY
DESIGNED BY: H. SALLS	CHECKED BY: C. CARLSON
DRIVE I CROSS SECTIONS 2	SHEET 46 OF 62

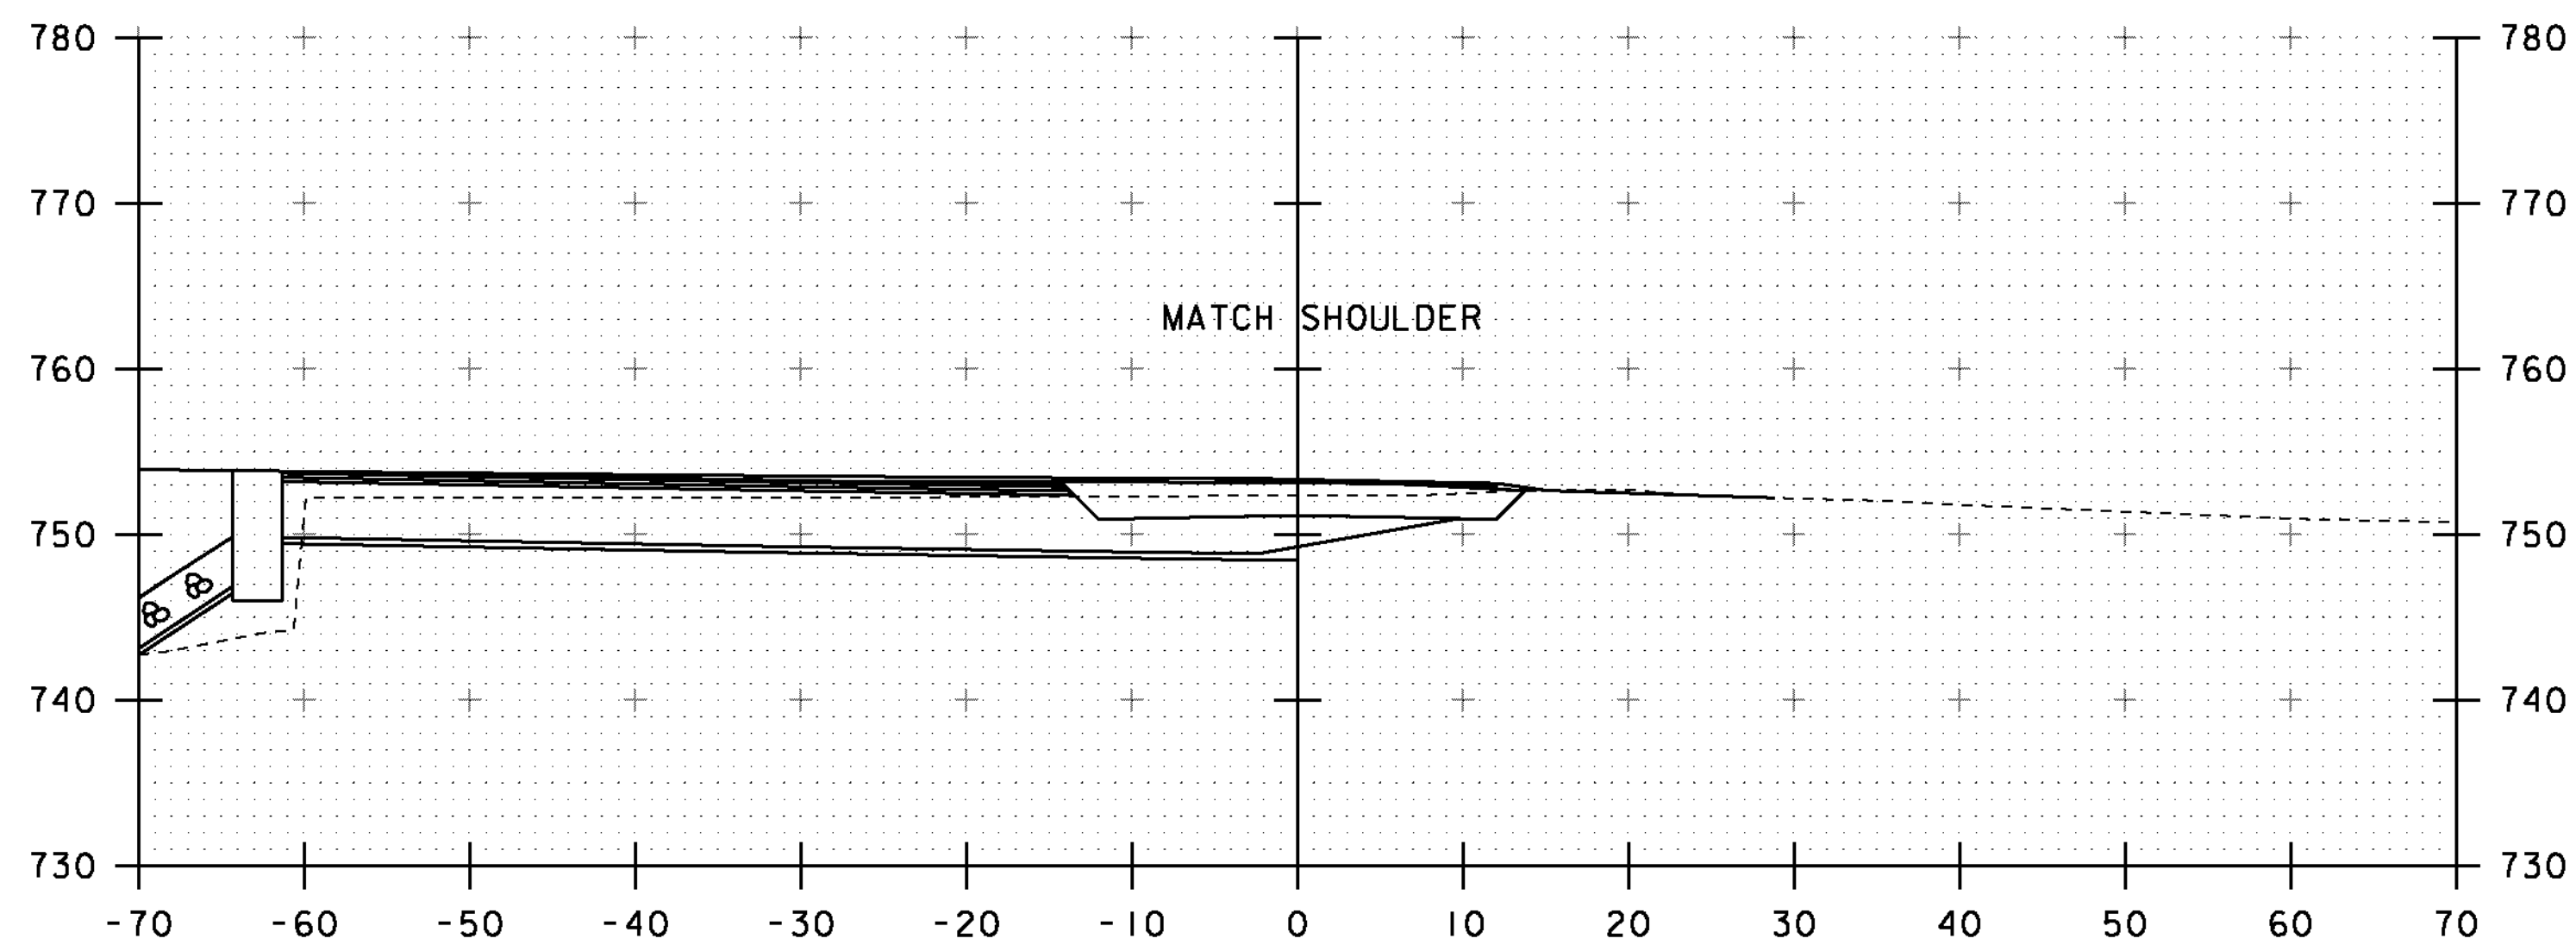


STA. 40+16.01
BEGIN DRIVE 2


40+16

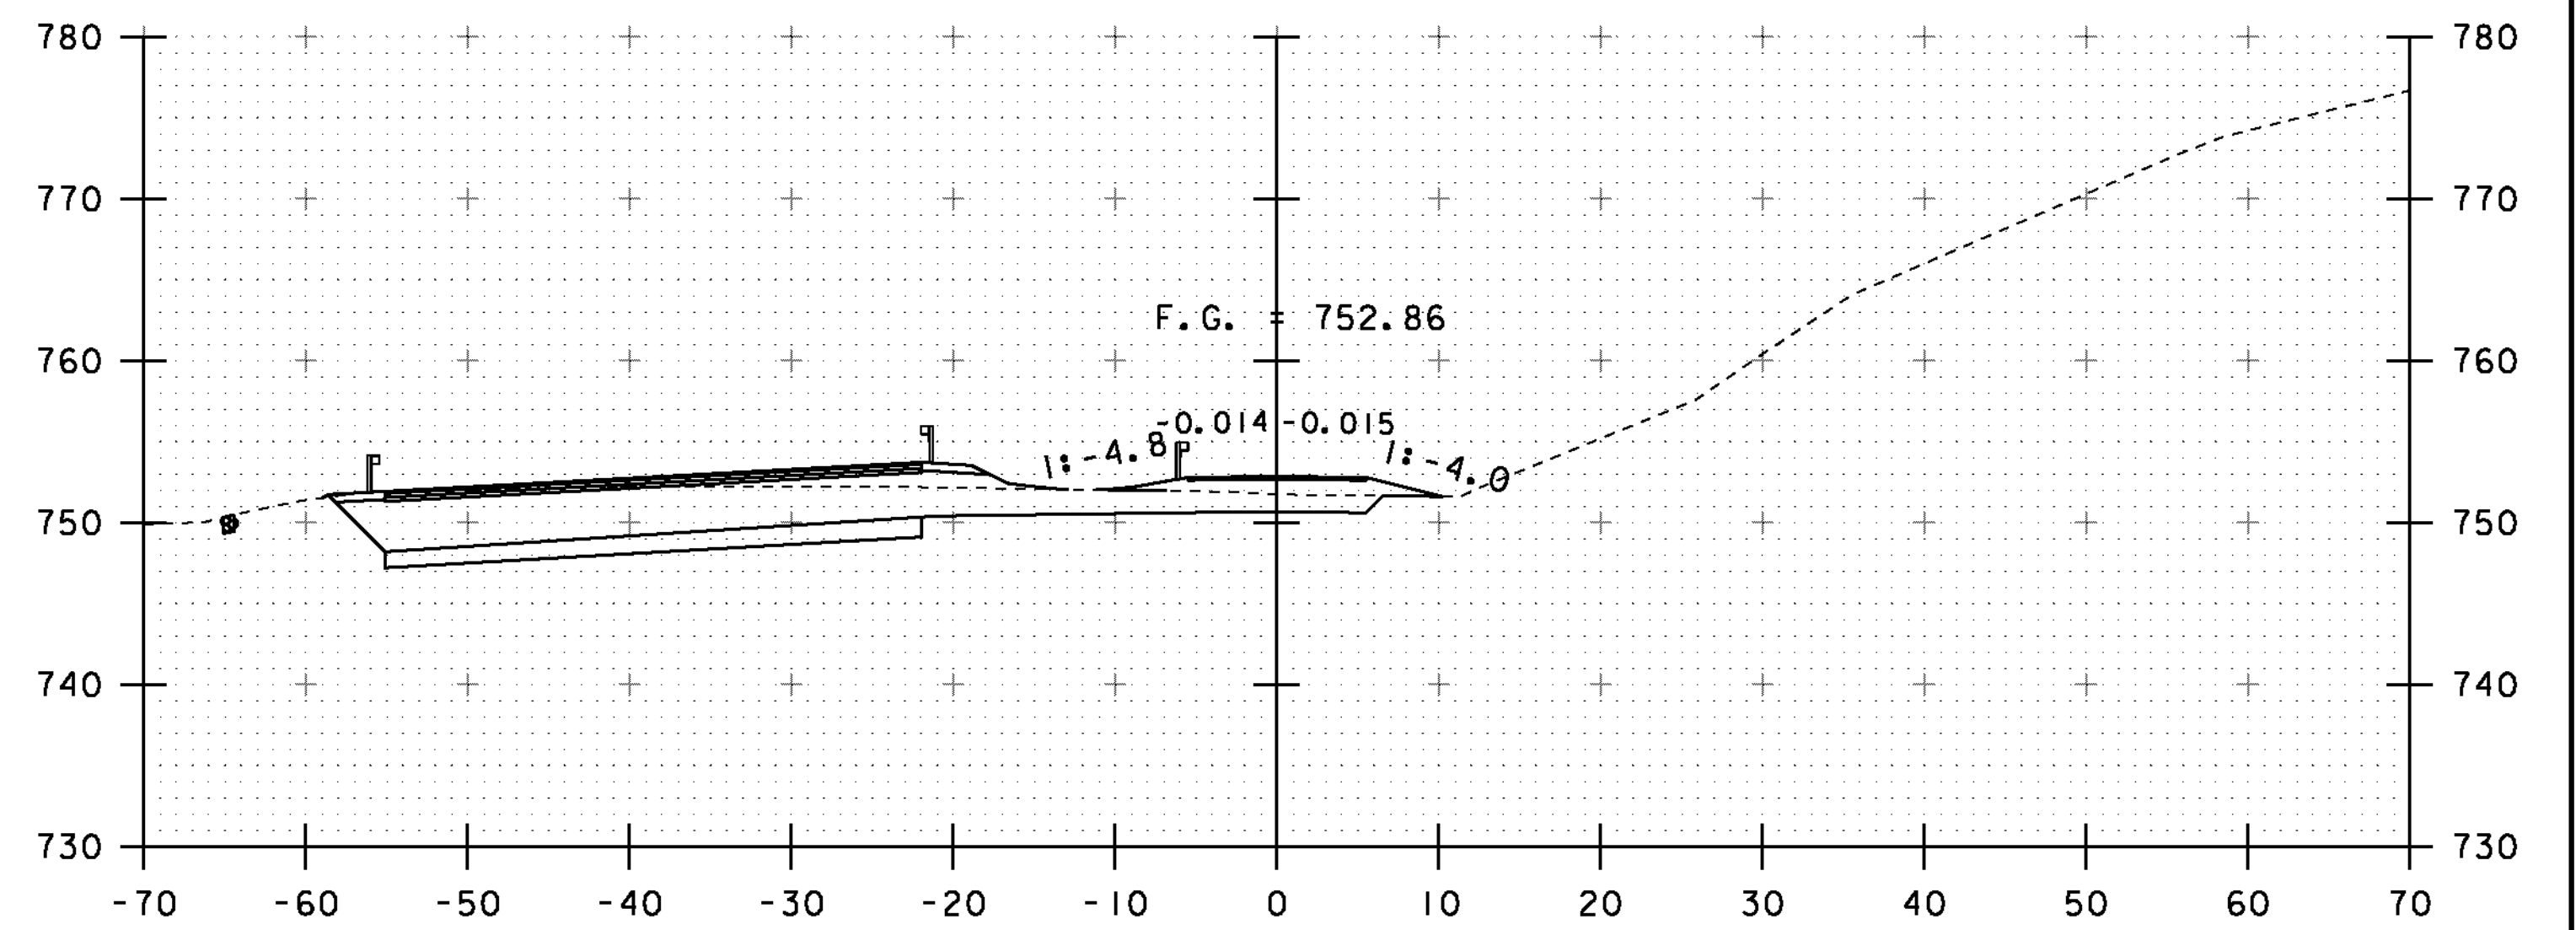


40+50

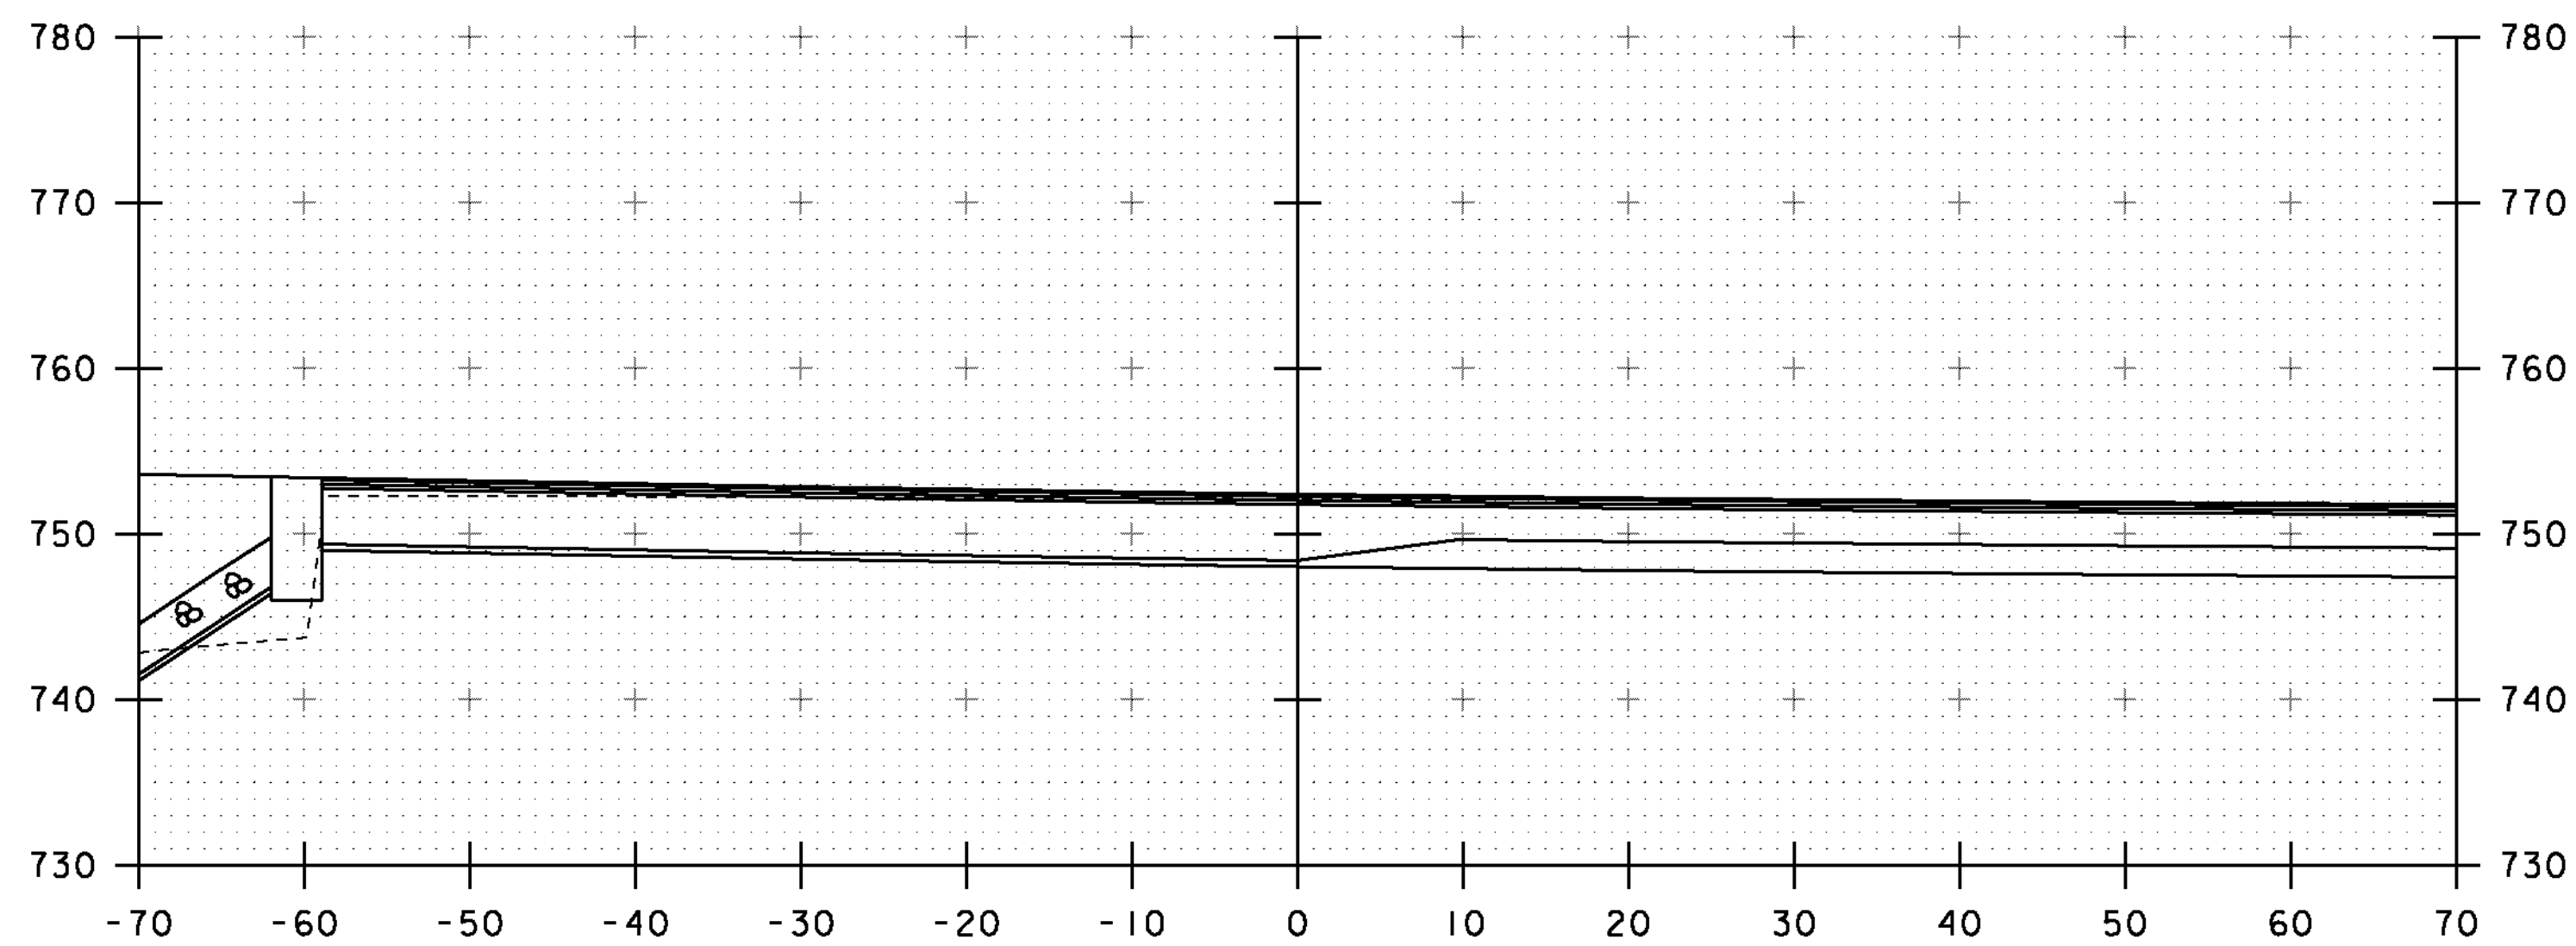

40+00

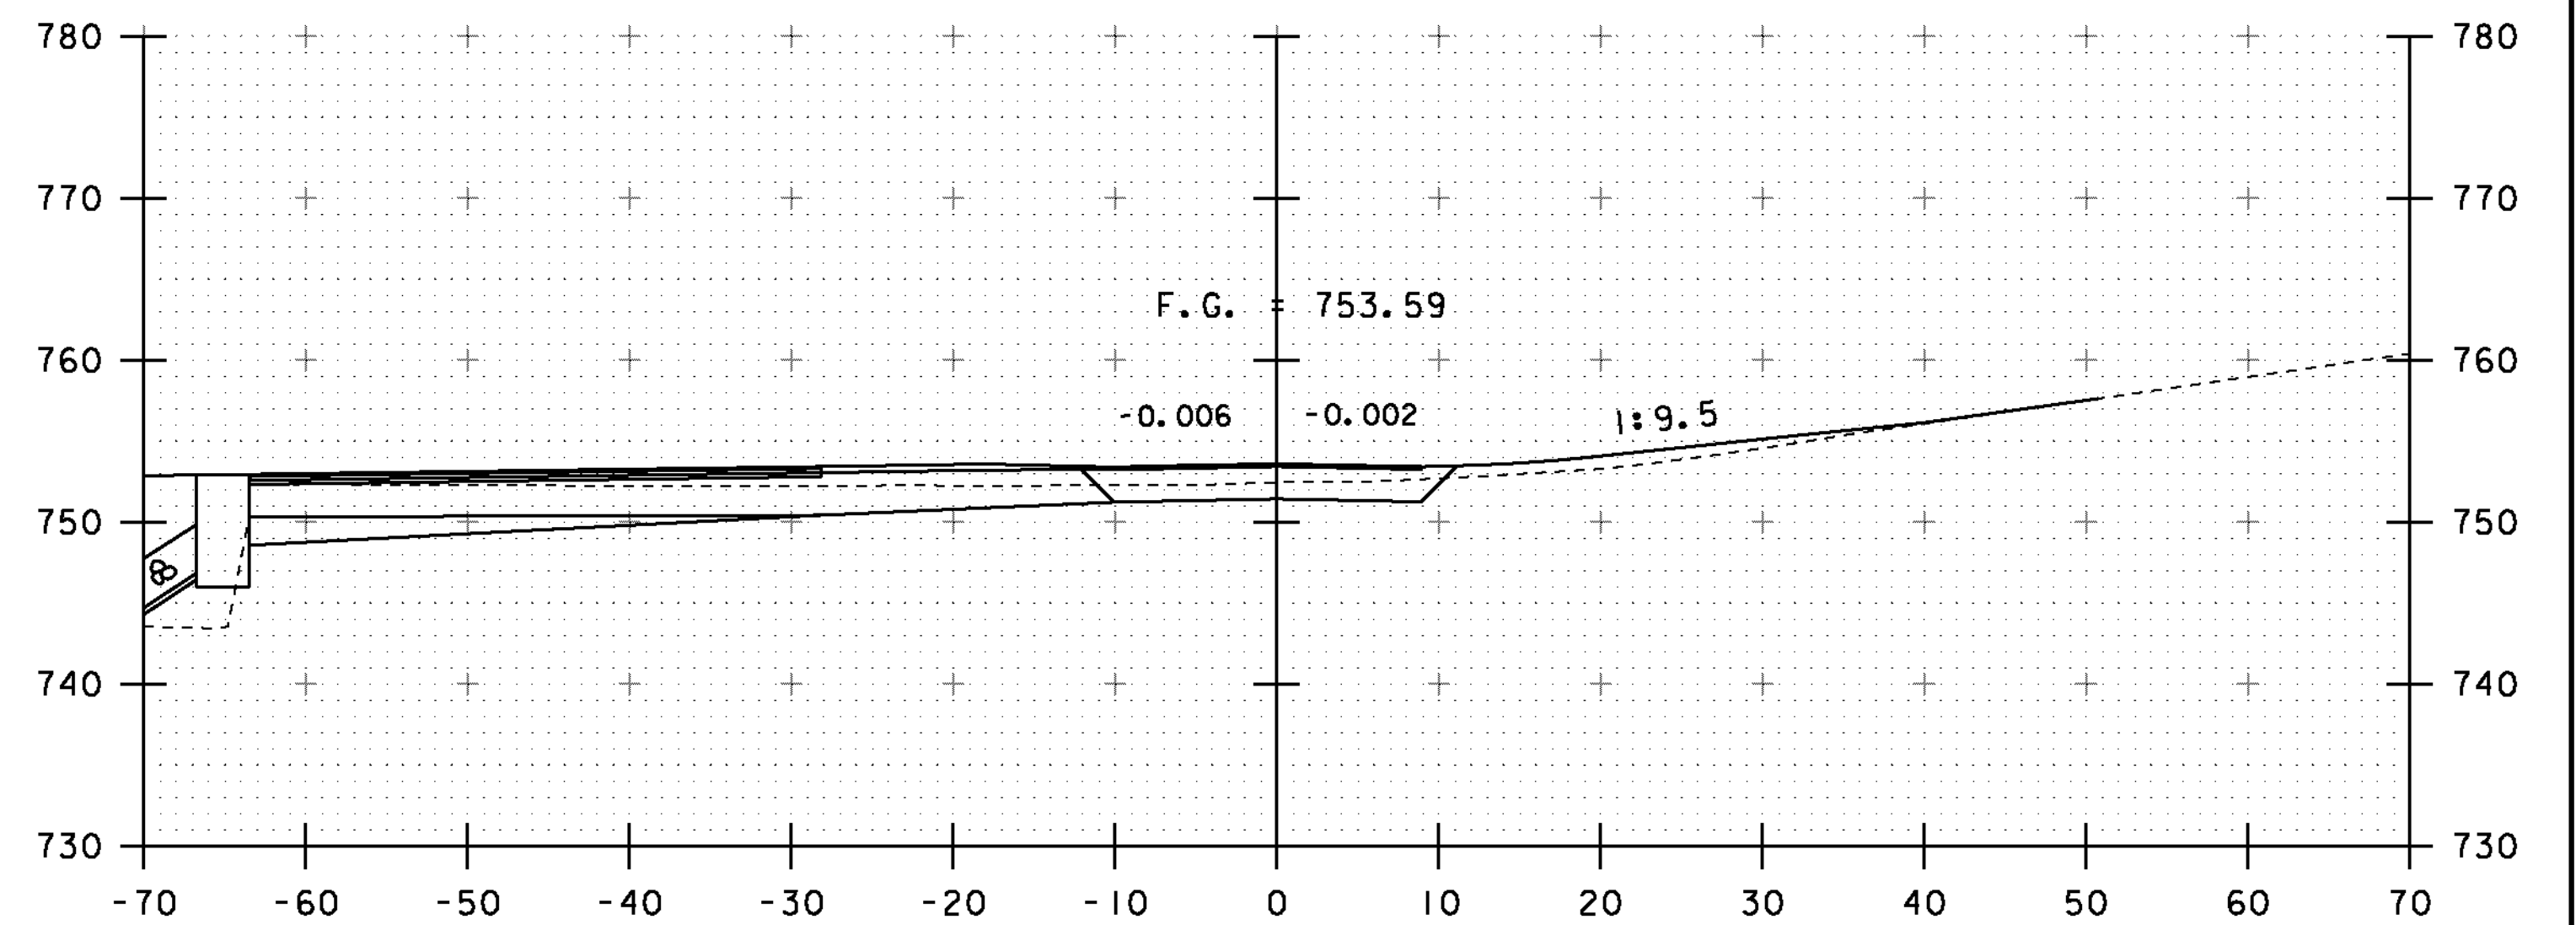


40+25

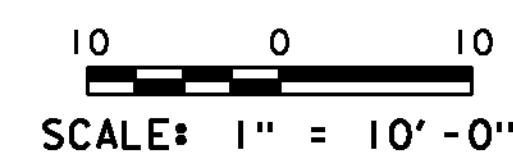


STA. 40+00 TO STA. 40+50


PROJECT NAME: ST. JOHNSBURY	PLOT DATE: 28-AUG-2012
PROJECT NUMBER: BRF 028-4(25)S	DRAWN BY: C. MOONEY
FILE NAME: s98b320xsl.dgn	CHECKED BY: C. CARLSON
PROJECT LEADER: C. CARLSON	SHEET 47 OF 62
DESIGNED BY: H. SALLS	
DRIVE 2 CROSS SECTIONS 1	

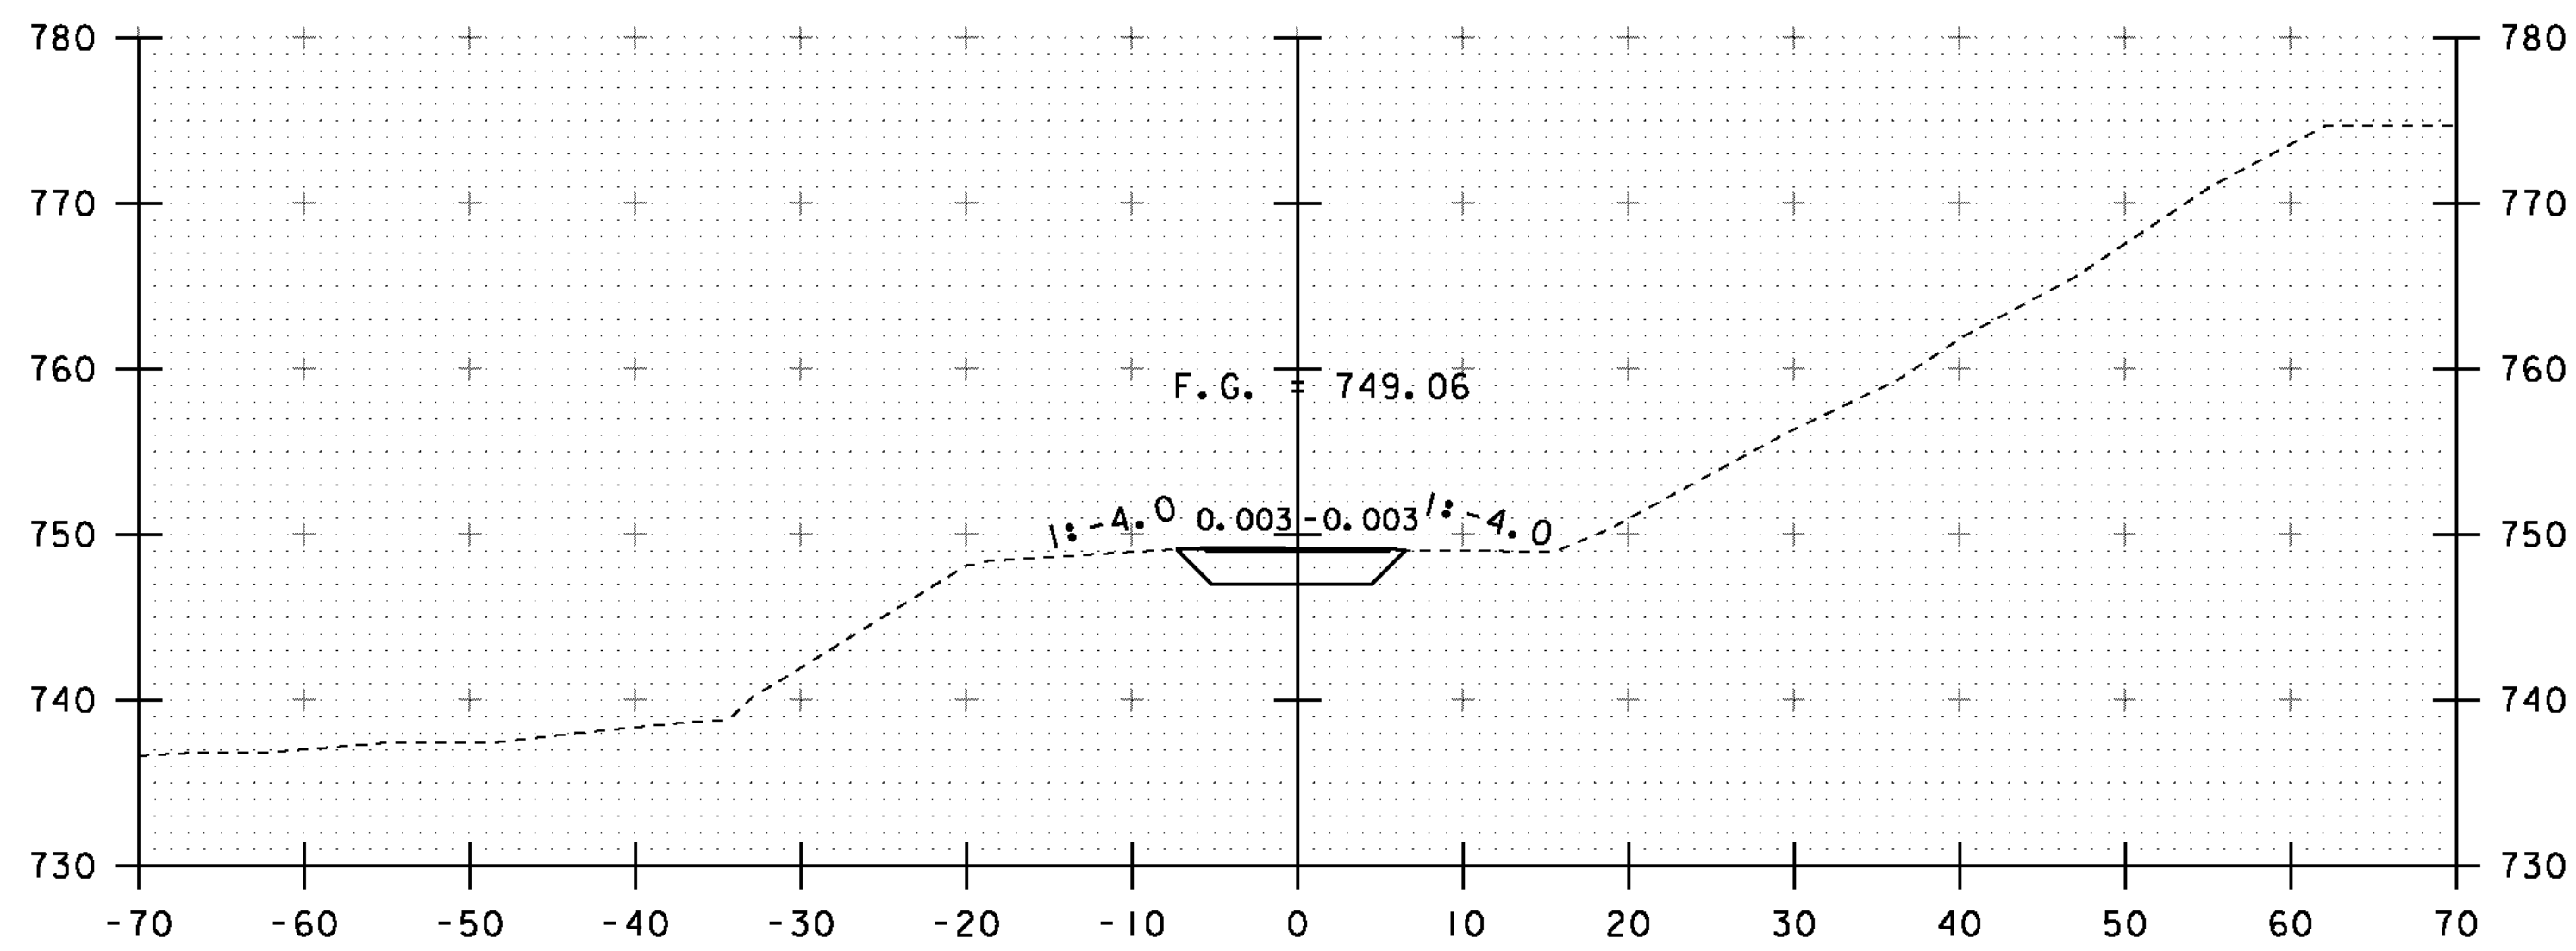

41+00

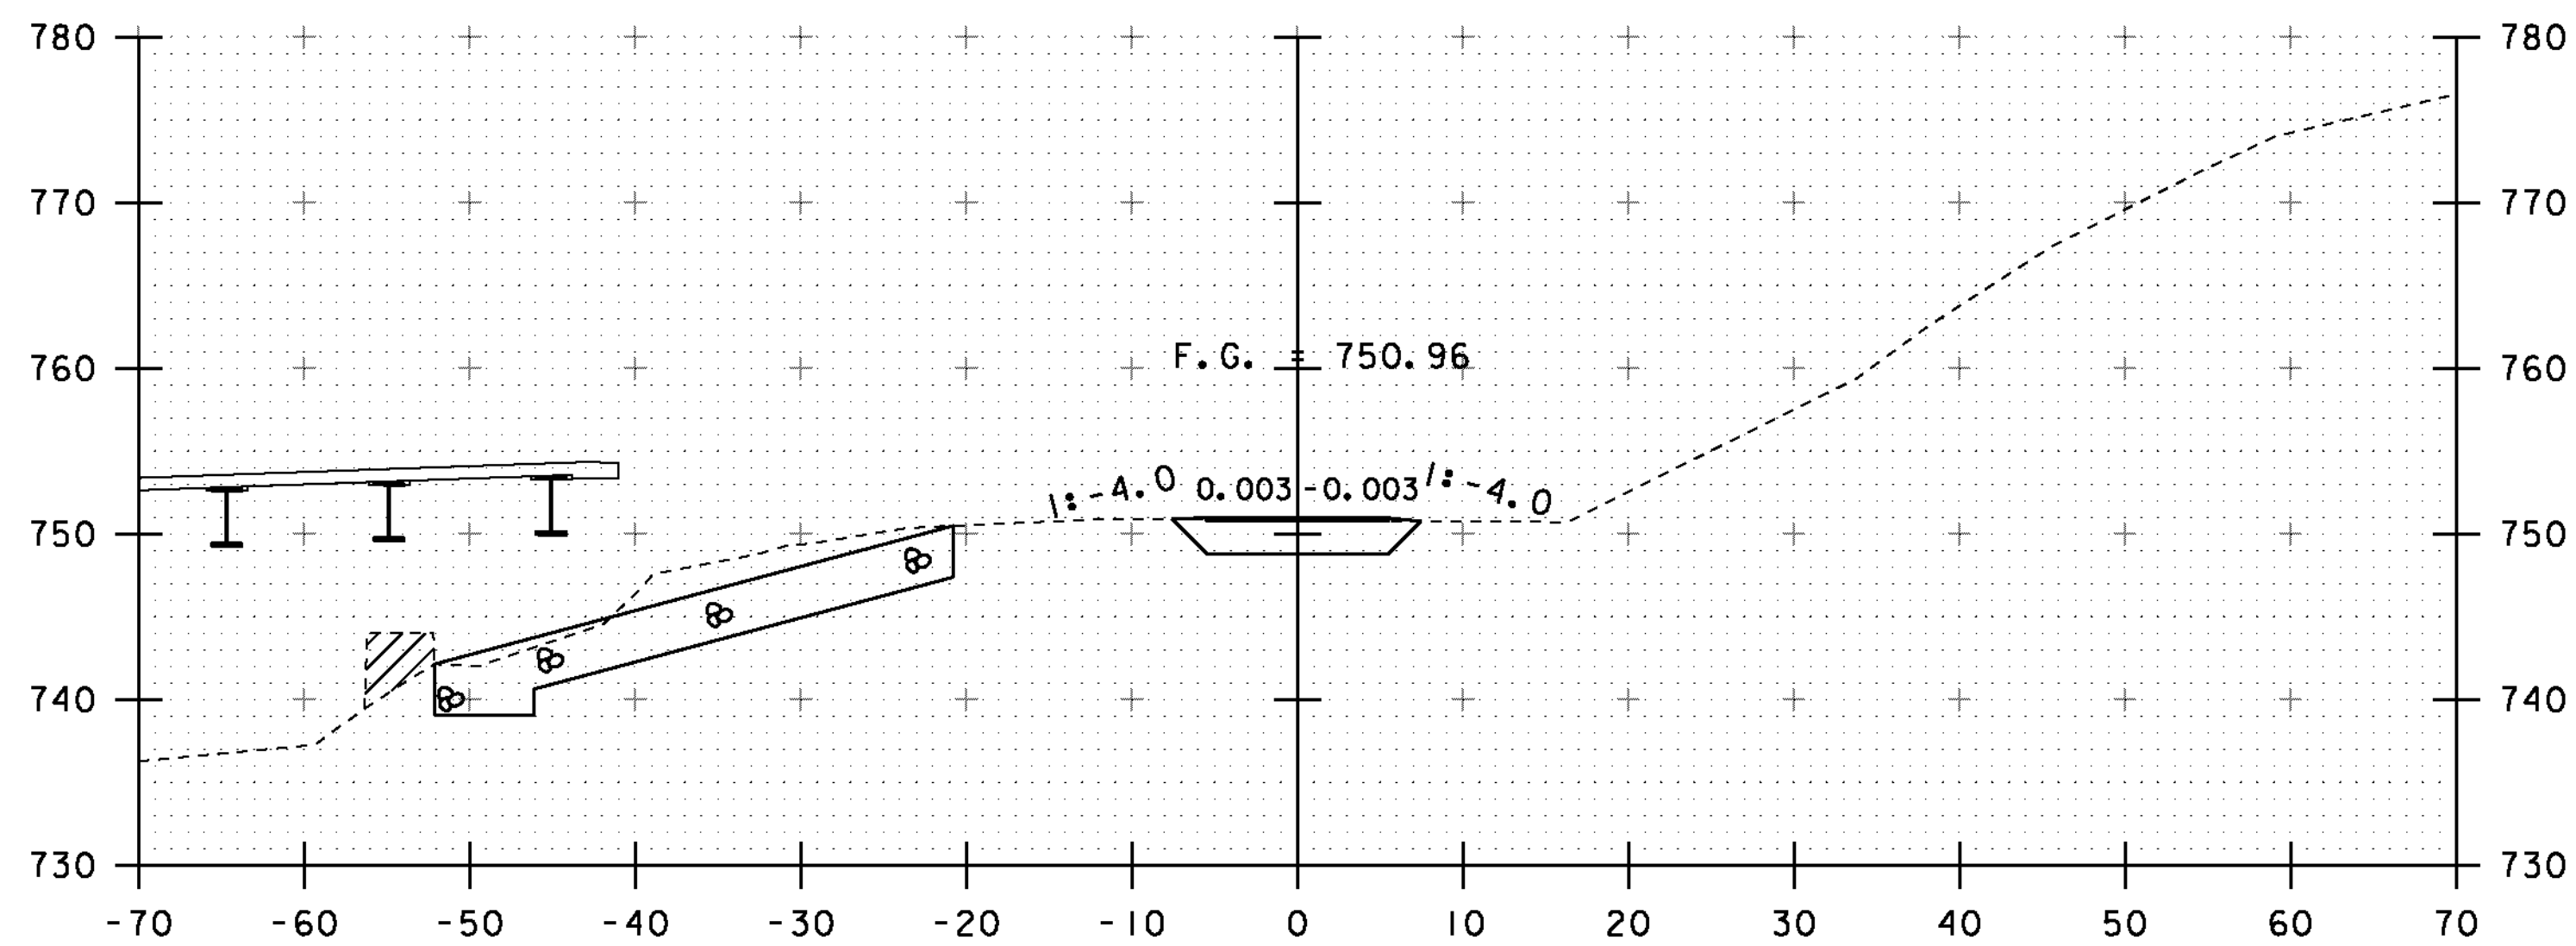


40+75

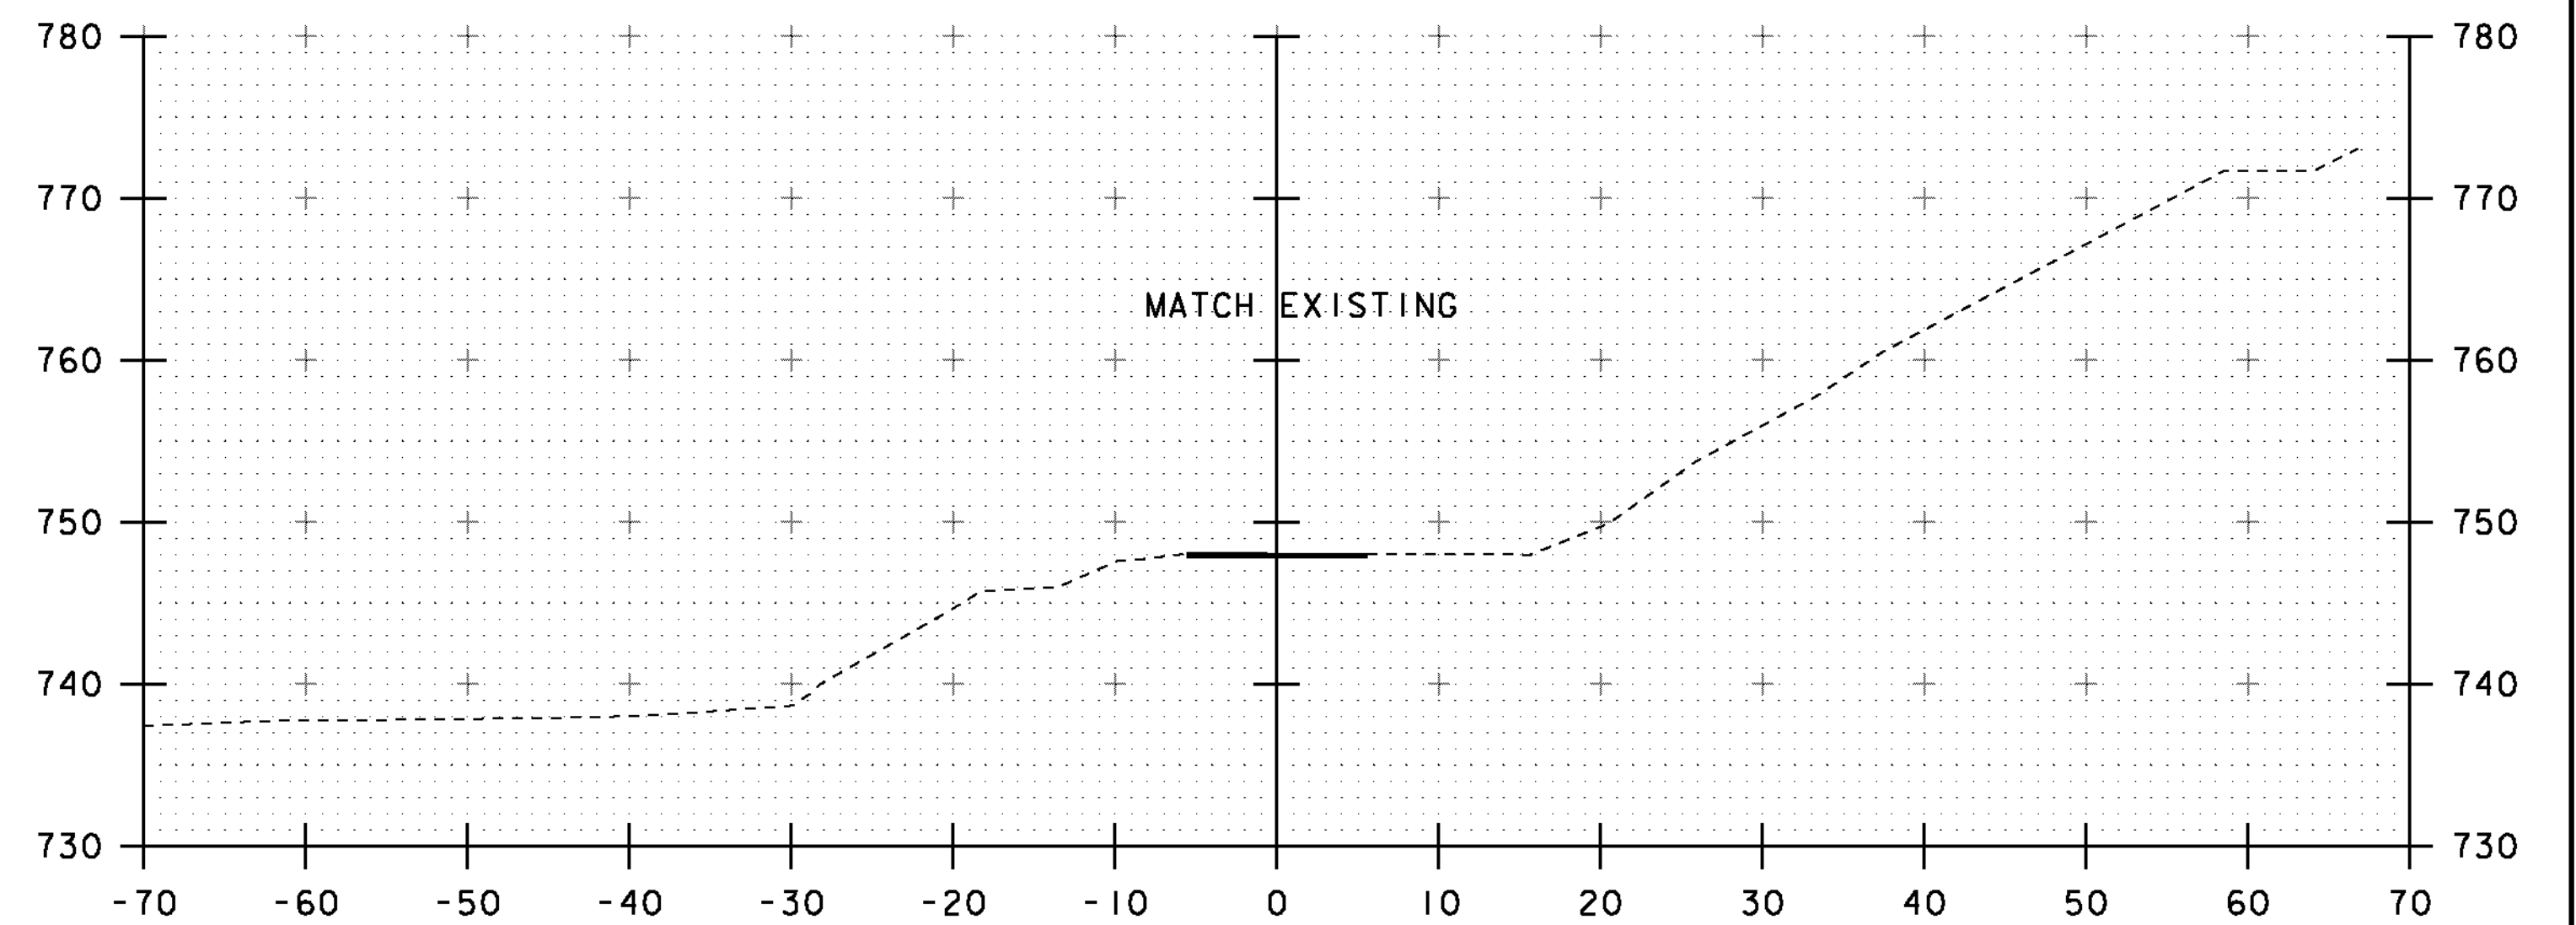

STA. 41+14.00
END DRIVE 2

41+14

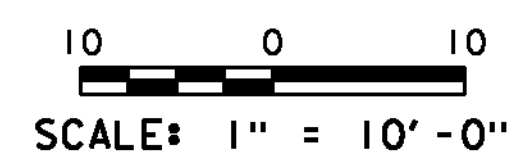

STA. 40+75 TO STA. 41+14

PROJECT NAME: ST. JOHNSBURY
PROJECT NUMBER: BRF 028-4(25)S

FILE NAME: s98b320xsl.dgn
PROJECT LEADER: C. CARLSON
DESIGNED BY: H. SALLS
DRIVE 2 CROSS SECTIONS 2

PLOT DATE: 28-AUG-2012
DRAWN BY: C. MOONEY
CHECKED BY: C. CARLSON
SHEET 48 OF 62

EPSC PLAN NARRATIVE

1.1 PROJECT DESCRIPTION

THIS PROJECT INVOLVES THE REPLACEMENT OF THE EXISTING BRIDGE. A NEW STEEL GIRDER BRIDGE WILL BE CONSTRUCTED ALONG THE SAME ALIGNMENT AS THE EXISTING ON NEW INTEGRAL PILE ABUTMENTS. THE SPAN OF THE NEW BRIDGE WILL BE 103 FT. THE PROJECT SITE IS LOCATED IN THE TOWN OF ST. JOHNSBURY, ON US ROUTE 2, APPROXIMATELY 0.6 MILES EAST OF THE INTERSECTION OF US ROUTE 2 AND VT ROUTE 18.

TOTAL AREA OF DISTURBANCE AS SHOWN ON THE ATTACHED EPSC PLAN IS APPROXIMATELY 1.49 ACRES.

AREA OF DISTURBANCE INCLUDES LIMITS OF EARTH DISTURBANCE WITHIN THE PROJECT AREA, AS WELL AS WASTE, BORROW AND STAGING AREAS, AND OTHER EARTH DISTURBING ACTIVITIES WITHIN OR DIRECTLY ADJACENT TO THE PROJECT LIMITS AS SHOWN ON THE ATTACHED EPSC PLAN.

IT IS ANTICIPATED THAT THIS PROJECT WILL LAST ONE CONSTRUCTION SEASON.

1.2 SITE INVENTORY

1.2.1 TOPOGRAPHY

THE TOPOGRAPHY OF THE AREA IS HILLY TO MOUNTAINOUS, MOSTLY FORESTED WITH SOME OPEN AREAS SURROUNDING THE PROJECT SITE. THERE ARE AREAS OF VEGETATION ALONG THE BANKS OF THE MOOSE RIVER. US ROUTE 2 IS THE ONLY ROAD WITHIN THE SITE. THERE IS A COMMERCIAL BUSINESS IMMEDIATELY NORTHEAST OF THE PROJECT SITE.

1.2.2 DRAINAGE, WATERWAYS, BODIES OF WATER, AND PROXIMITY TO NATURAL OR MAN-MADE WATER FEATURES

THE MOOSE RIVER IS THE ONLY WATER SOURCE ON THE PROJECT SITE. THIS WATERWAY IS CLASSIFIED AS SINUOUS TO MEANDERING, INCISED AND STABLE. THE NATURE OF THE STREAM BED IS CHARACTERIZED AS MOSTLY COBBLES WITH SOME GRAVEL, SAND, AND A FEW BOULDERS. THE TRIBUTARY AREA AT THE PROJECT SITE IS 116.9 MILES². A CLASS II WETLAND EXISTS TO THE NORTHEAST OF THE EXISTING STRUCTURE.

THERE ARE SEVERAL DROP INLETS NEAR THE PROJECT THAT DRAIN INTO THE MOOSE RIVER. DISTURBANCE IN THE VICINITY OF THESE DRAINS IS EXPECTED TO BE MINIMAL AND DOWNSLOPE.

1.2.3 VEGETATION

THE VEGETATION IN THE IMMEDIATE PROJECT AREA CONSISTS OF SMALL HARDWOOD TREES AND UNDERGROWTH. THERE ARE OPEN FIELDS USED FOR HAY PRODUCTION IN AREAS AWAY FROM THE PROJECT AREA.

THE IMPACT TO VEGETATION WILL BE LIMITED TO THAT WHICH IS DIRECTLY AFFECTED BY THE CONSTRUCTION PROJECT. UPON PROJECT COMPLETION, THE CHANNEL WILL BE ARMORED WITH STONE FILL TYPE III AS SPECIFIED ON THE PLANS. DISTURBED VEGETATION WILL BE REESTABLISHED WITH STANDARD SEED AND MULCH PRACTICES.

1.2.4 SOILS

ALL SOIL DATA CAME FROM THE U.S. DEPARTMENT OF AGRICULTURE SOIL CONSERVATION SERVICE FOR THE COUNTY OF CALEDONIA, VERMONT. SOILS ON THE SITE ARE PODUNK AND BUCKLAND, FINE SANDY LOAM. AT THE PROJECT SITE, NEAR THE RIVER, PODUNK SOILS SLOPE AT 0% TO 2%, WITH A "K FACTOR" = 0.24. THE BUCKLAND SOILS OCCUR SLIGHTLY FURTHER AWAY FROM THE RIVER AND CAN SLOPE FROM 8% TO 35%, WITH "K FACTOR" = 0.32. ATTENTION TO EROSION POTENTIAL MAY BE A BIGGER CONSIDERATION IN THE VICINITY OF THE TEMPORARY BRIDGE.

NOTE: K-VALUES GENERALLY INDICATE THE FOLLOWING:
0.0-0.23 = LOW EROSION POTENTIAL
0.24-0.36 = MODERATE EROSION POTENTIAL
0.37 AND HIGHER = HIGH EROSION POTENTIAL

1.2.5 SENSITIVE RESOURCE AREAS

CRITICAL HABITATS: ALTHOUGH THERE ARE NO PROTECTED HABITATS IN THE PROJECT AREA, THE MOOSE RIVER CONTAINS COLD WATER FISHERIES.

HISTORICAL OR ARCHAEOLOGICAL AREAS: ARCHAEOLOGICALLY SENSITIVE AREAS HAVE BEEN DELINEATED ON THE PLANS.

PRIME AGRICULTURAL LAND: THE AREA TO THE SOUTHEAST OF THE PROJECT IS CURRENTLY USED FOR HAY PRODUCTION.

THREATENED AND ENDANGERED SPECIES: A STATE-LISTED THREATENED SPECIES (EASTERN PEARLSHELL MUSSEL) IS KNOWN TO INHABIT THE RIVER NEAR THE PROJECT SITE.

WATER RESOURCE: MOOSE RIVER

WETLANDS: A CLASS II WETLAND EXISTS TO THE NORTHEAST OF THE EXISTING STRUCTURE.

1.3 RISK EVALUATION

THIS PROJECT FALLS UNDER THE JURISDICTION OF GENERAL PERMIT 3-9020 FOR STORMWATER RUNOFF FROM CONSTRUCTION SITES FOR LOW RISK PROJECTS. ANY MODIFICATIONS TO THE PROJECT THAT INCREASE THE RISK TO ENVIRONMENTAL RESOURCES SHALL BE EVALUATED IN ACCORDANCE WITH THE PERMIT REQUIREMENTS. THE CONTRACTOR WILL BE RESPONSIBLE FOR ANY ADDITIONAL PERMITTING.

1.4 EROSION PREVENTION AND SEDIMENT CONTROL

THE EROSION CONTROL PLANS ARE MEANT AS A GUIDELINE FOR PREVENTING EROSION AND CONTROLLING SEDIMENT TRANSPORT. THE PRINCIPLES OUTLINED IN THIS NARRATIVE CONSIST OF APPLYING MEASURES THROUGHOUT CONSTRUCTION OF THE PROJECT IN ORDER TO MINIMIZE SEDIMENT TRANSPORT TO THE RECEIVING WATERS. THE MEASURES INCLUDE STABILIZATION AND STRUCTURAL PRACTICES, STORM WATER CONTROLS AND OTHER POLLUTION PREVENTION PRACTICES. THEY HAVE BEEN PROPOSED BY THE DESIGNER AS A BASIS FOR PROTECTING RESOURCES AND WILL NEED TO BE BUILT UPON BASED ON THE SPECIFIC MEANS AND METHODS OF THE CONTRACTOR. REFER TO THE LOW RISK SITE HANDBOOK AND APPROPRIATE DETAIL SHEETS FOR SPECIFIC GUIDANCE AND CONSTRUCTION DETAILING.

ALL MEASURES SHALL BE REGULARLY MAINTAINED AND SHALL BE CHECKED FOR SEDIMENT BUILD-UP. SEDIMENT SHALL BE DISPOSED OF AT AN APPROVED SITE WHERE IT WILL NOT BE SUBJECT TO EROSION.

1.4.1 MARK SITE BOUNDARIES

SITE BOUNDARIES AND AREAS THAT CONSTRUCTION EQUIPMENT CAN ACCESS SHALL BE DELINEATED.

PROJECT DEMARCATION FENCING (PDF) SHALL BE USED TO PHYSICALLY MARK SITE BOUNDARIES.

BECAUSE THIS PROJECT FALLS UNDER THE CGP 3-9020, BARRIER FENCE SHALL BE USED INSTEAD OF PROJECT DEMARCATION FENCE WITHIN 100 FEET OF A WATER RESOURCE (STREAM, BROOK, LAKE, POND, WETLAND, ETC.)

1.4.2 LIMIT DISTURBANCE AREA

PREVENTING INITIAL SOIL EROSION BY MINIMIZING THE EXPOSED AREA IS MUCH MORE EFFECTIVE THAN TREATING ERODED SEDIMENT. EARTH DISTURBANCE CAN BE MINIMIZED THROUGH CONSTRUCTION PHASING BY ONLY OPENING UP EARTH AS NECESSARY. THIS CAN LIMIT THE AREA THAT WILL BE DISTURBED AND EXPOSED TO EROSION. EMPLOY TEMPORARY CONSTRUCTION STABILIZATION PRACTICES IN INCREMENTAL STAGES AS PHASES CHANGE. ONLY THE ACREAGE LISTED ON THE PERMIT AUTHORIZATION MAY BE EXPOSED AT ANY GIVEN TIME.

MAINTAINING VEGETATED BUFFERS ALONG STREAM BANKS, WETLANDS OR OTHER SENSITIVE AREAS IS A CRUCIAL EROSION AND SEDIMENT CONTROL MEASURE THAT SHOULD BE ESTABLISHED WHEREVER POSSIBLE.

1.4.3 SITE ENTRANCE/EXIT STABILIZATION

TRACKING OF SEDIMENT ONTO PUBLIC HIGHWAYS SHALL BE MINIMIZED TO REDUCE THE POTENTIAL FOR RUNOFF ENTERING RECEIVING WATERS. INSTALLATION SHALL COINCIDE WITH THE CONTRACTOR'S PROGRESS SCHEDULE.

STABILIZED CONSTRUCTION ENTRANCES SHALL BE INSTALLED AS PROPOSED ON THE EPSC PLAN AND ANYWHERE EQUIPMENT WILL BE GOING FROM AREAS OF EXPOSED SOILS TO PAVED SURFACES.

1.4.4 INSTALL SEDIMENT BARRIERS

SEDIMENT BARRIERS SHALL BE UTILIZED TO INTERCEPT RUNOFF AND ALLOW SUSPENDED SEDIMENT TO SETTLE OUT. THEY SHALL BE INSTALLED PRIOR TO ANY UP SLOPE WORK.

SILT FENCE WILL BE INSTALLED AS PROPOSED ON THE EPSC PLAN.

BECAUSE THIS PROJECT FALLS UNDER THE CGP 3-9020, WOVEN WIRE REINFORCED SILT FENCE SHALL BE USED INSTEAD OF SILT FENCE WITHIN 100 FEET UPSLOPE OF RECEIVING WATERS.

FILTER FABRIC DROP INLET PROTECTION SHALL BE INSTALLED AS INDICATED.

FILTER CURTAIN SHALL BE INSTALLED TO MINIMIZE SEDIMENT TRANSPORT IN THE MOOSE RIVER.

1.4.5 DIVERT UPLAND RUNOFF

DIVERSIONARY MEASURES SHALL BE USED TO INTERCEPT RUNOFF FROM ABOVE THE CONSTRUCTION AND DIRECT IT AROUND THE DISTURBED AREA SO THAT CLEAN WATER DOES NOT BECOME MUDDIED WHILE TRAVELING OVER EXPOSED SOILS ON THE CONSTRUCTION SITE.

RUNOFF FROM ABOVE THE DISTURBED AREAS IS NOT EXPECTED TO ENTER THE PROJECT SITE; THEREFORE, DIVERSION OF UPLAND RUNOFF IS NOT EXPECTED TO BE NEEDED.

1.4.6 SLOW DOWN CHANNELIZED RUNOFF

CHECK STRUCTURES SHALL BE UTILIZED TO REDUCE THE VELOCITY, AND THUS THE EROSION POTENTIAL, OF CONCENTRATED FLOW IN CHANNELS.

CHANNELIZED RUNOFF MAY OR MAY NOT OCCUR. METHODS OF STABILIZATION OF CHANNELS INCLUDE STONE CHECK DAMS, FIBER ROLLS, AND SAND BAGS.

1.4.7 CONSTRUCT PERMANENT CONTROLS

PERMANENT STORMWATER TREATMENT DEVICES SHALL BE INSTALLED AS SHOWN ON THE PLANS AND IN ACCORDANCE WITH PERMIT CONDITIONS.

1.4.8 STABILIZE EXPOSED SOILS DURING CONSTRUCTION

ALL AREAS OF DISTURBANCE MUST HAVE TEMPORARY STABILIZATION IN PLACE WITHIN 48 HOURS OF DISTURBANCE OR IN ACCORDANCE WITH THE CONSTRUCTION GENERAL PERMIT 3-9020 AUTHORIZATION.

SURFACE ROUGHENING OF ALL EXPOSED SLOPES, COMBINED WITH TEMPORARY MULCHING, SHALL BE UTILIZED ON A REGULAR BASIS. BIODEGRADABLE EROSION CONTROL MATTING OR AN EQUIVALENT SHALL BE USED TO STABILIZE ALL SLOPES STEEPER THAN 1:3.

THE FORECAST OF RAINFALL EVENTS SHALL TRIGGER IMMEDIATE PROTECTION OF EXPOSED SOILS.

1.4.9 WINTER STABILIZATION

VARIOUS MEASURES SPECIFIC TO WINTER MAY BE NECESSARY SHOULD THE PROJECT EXTEND INTO WINTER (OCTOBER 15 THROUGH APRIL 15). REFER TO THE LOW RISK SITE HANDBOOK FOR GUIDANCE.

1.4.10 STABILIZE SOIL AT FINAL GRADE

EXPOSED SOIL MUST BE STABILIZED WITHIN 48 HOURS OF REACHING FINAL GRADE.

SEED, MULCH, FERTILIZER AND LIME SHALL BE USED TO ESTABLISH PERMANENT VEGETATION. FOR SLOPES STEEPER THAN 1:3, BIODEGRADABLE EROSION CONTROL MATTING OR AN EQUIVALENT SHALL BE USED INSTEAD OF MULCH.

1.4.11 DE-WATERING ACTIVITIES

DISCHARGE FROM DEWATERING ACTIVITIES THAT FLOWS OFF OF THE CONSTRUCTION SITE MUST NOT CAUSE OR CONTRIBUTE TO A VIOLATION OF THE VERMONT WATER QUALITY STANDARDS.

DEWATERING ACTIVITIES ARE NOT ANTICIPATED.

1.4.12 INSPECT YOUR SITE

INSPECT THE PROJECT SITE BASED ON SPECIAL PROVISION REQUIREMENTS OR CONSTRUCTION GENERAL PERMIT AUTHORIZATION STIPULATIONS.

1.5 SEQUENCE AND STAGING

THIS SECTION WILL BE DEVELOPED BY THE CONTRACTOR USING THE GUIDANCE OUTLINED IN THE VTRANS EPSC PLAN CONTRACTOR CHECKLIST.

1.5.1 CONSTRUCTION SEQUENCE


1.5.2 OFF-SITE ACTIVITIES

IN ADDITION TO THE CONTRACTOR CHECKLIST ANY ACTIVITIES OUTSIDE THE CONSTRUCTION LIMITS SHALL FOLLOW SUBSECTIONS 105.25- 105.29 OF THE STANDARD SPECIFICATIONS FOR CONSTRUCTION.

PROJECT NAME: ST. JOHNSBURY
PROJECT NUMBER: BRF 028-4(25)S

FILE NAME: s98b320epscNar.dgn
PROJECT LEADER: C. CARLSON
DESIGNED BY: H. SALLS
EPSC NARRATIVE

PLOT DATE: 28-AUG-2012
DRAWN BY: R. PELLETT
CHECKED BY: C. CARLSON
SHEET 49 OF 62

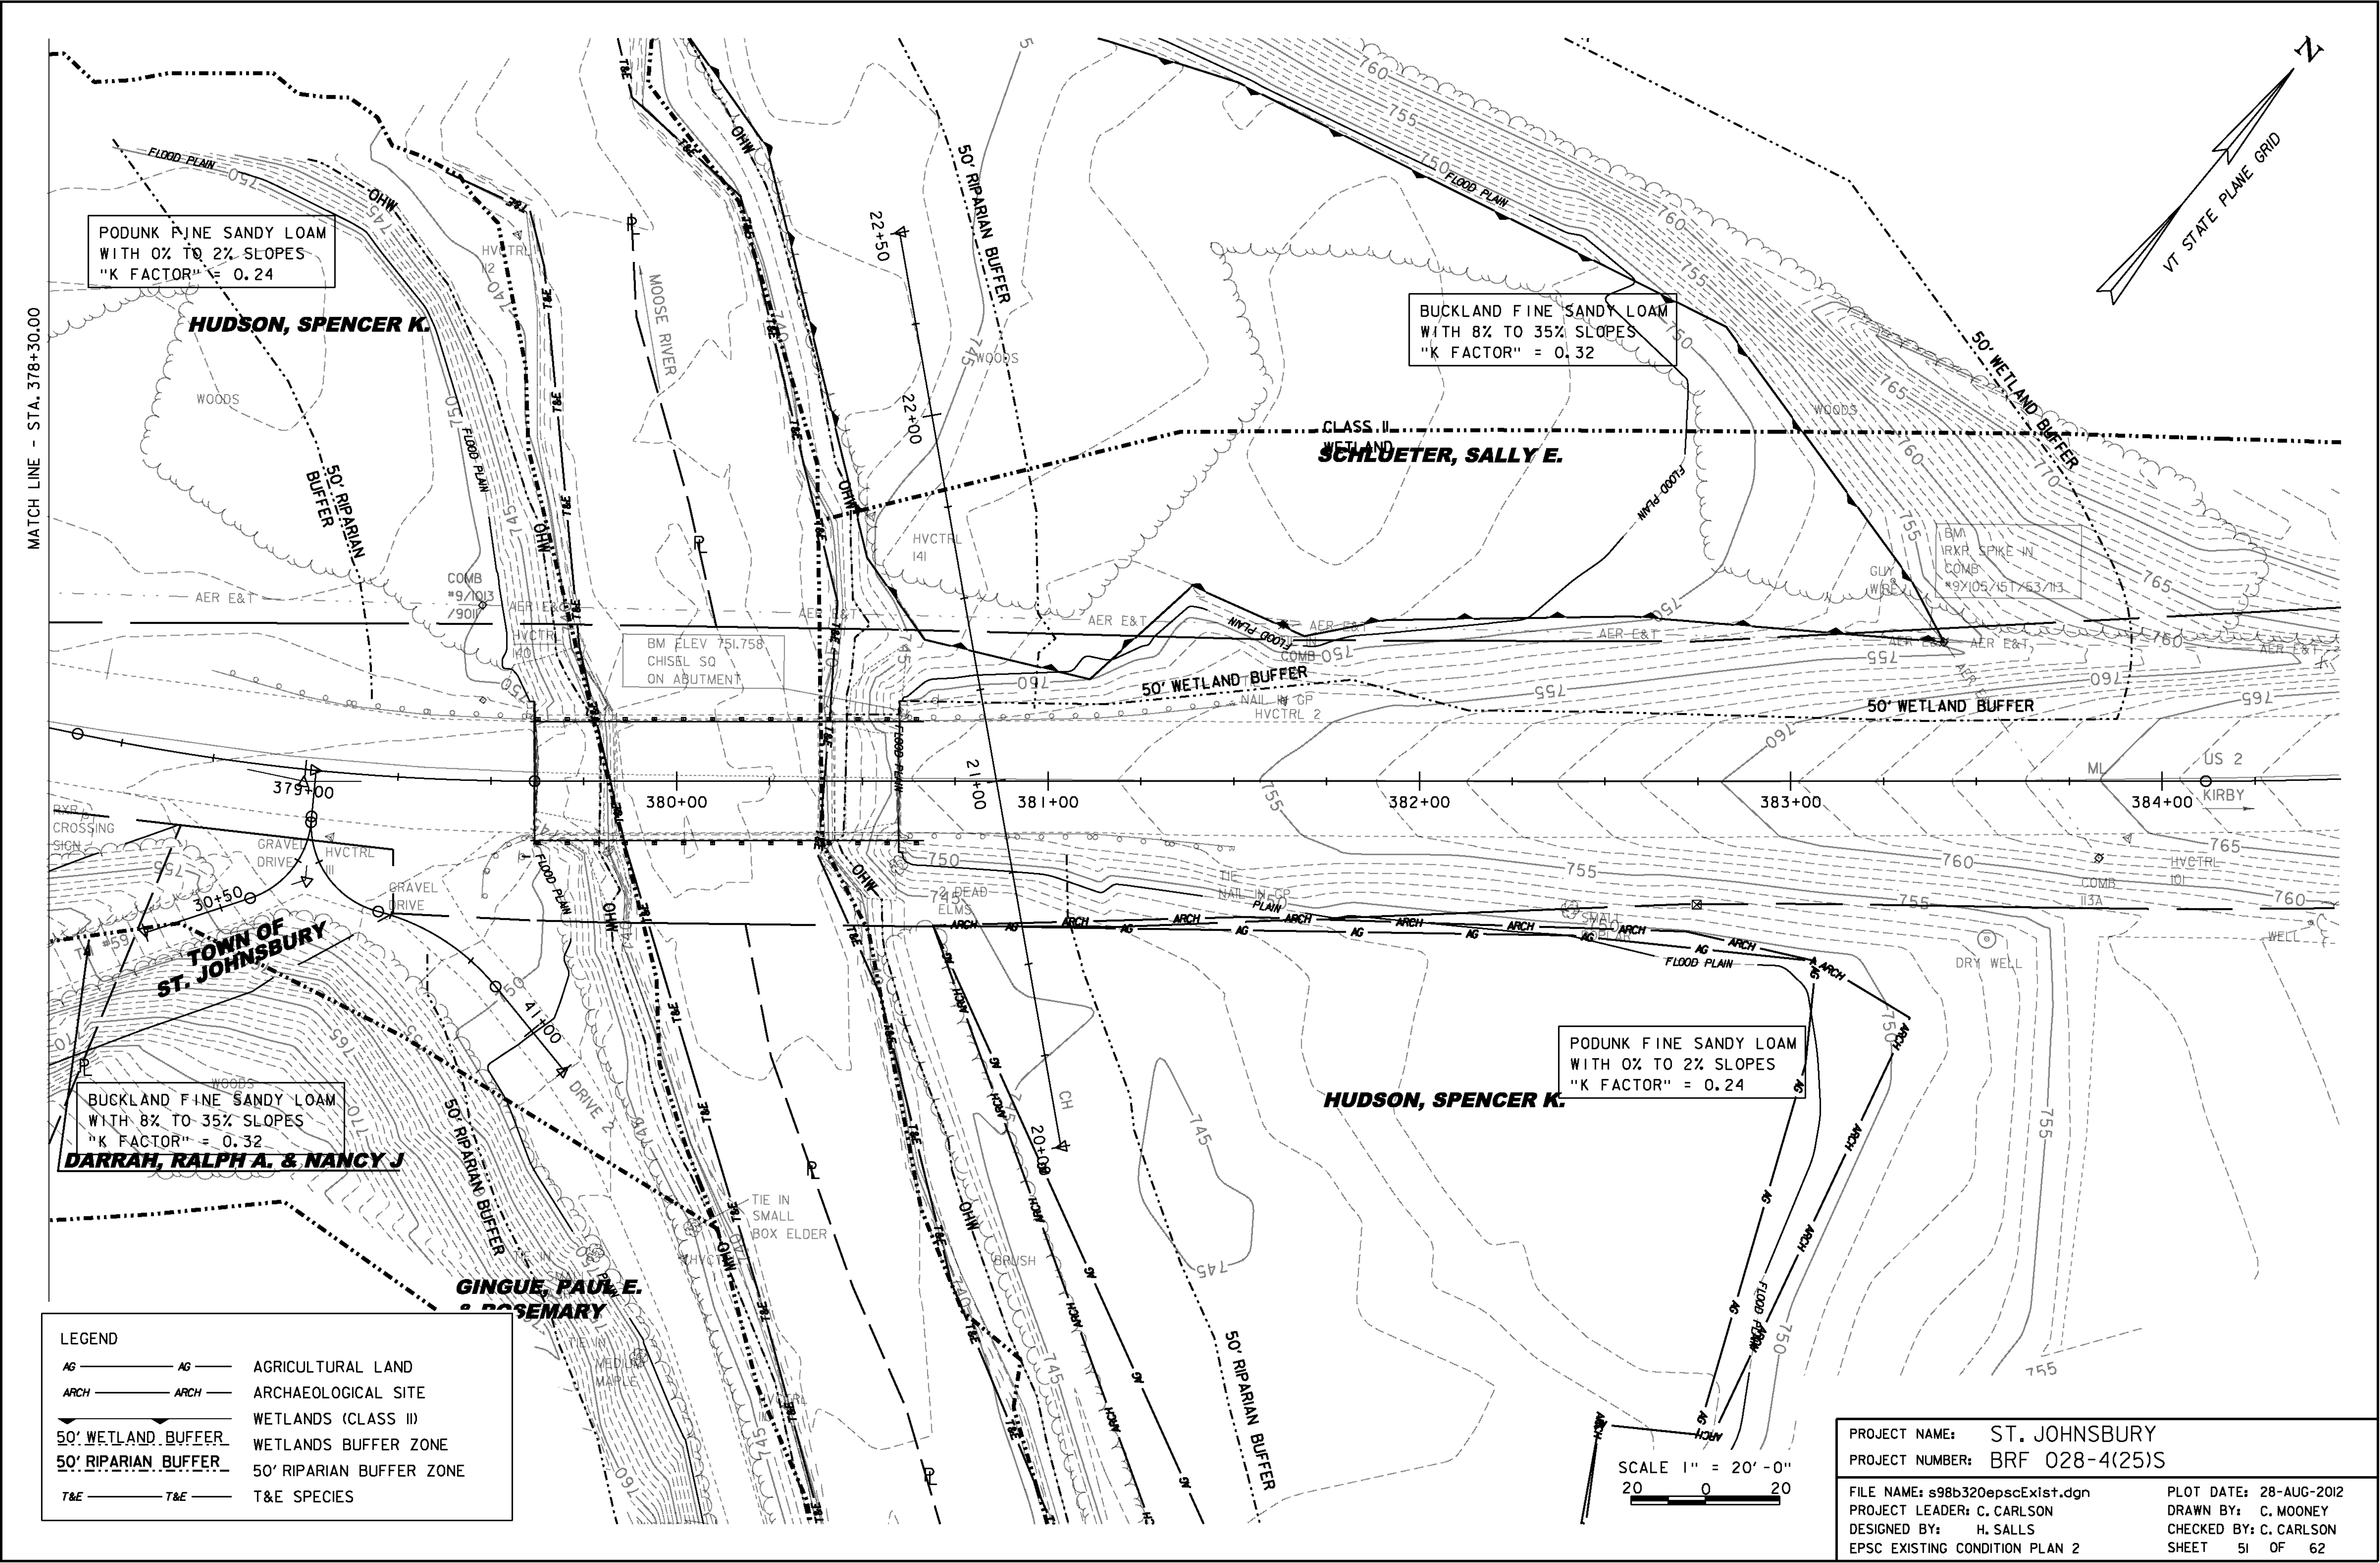

PODUNK FINE SANDY LOAM
WITH 0% TO 2% SLOPES
"K FACTOR" = 0.24

BUCKLAND FINE SANDY LOAM
WITH 8% TO 35% SLOPES
"K FACTOR" = 0.32

BUCKLAND FINE SANDY LOAM
WITH 8% TO 35% SLOPES
"K FACTOR" = 0.32



PODUNK FINE SANDY LOAM
WITH 0% TO 2% SLOPES
"K FACTOR" = 0.24

LEGEND	
AG	AGRICULTURAL LAND
ARCH	ARCHAEOLOGICAL SITE
50' WETLAND BUFFER	WETLANDS (CLASS II)
50' RIPARIAN BUFFER	WETLANDS BUFFER ZONE
T&E	50' RIPARIAN BUFFER ZONE
T&E	T&E SPECIES

PROJECT NAME: ST. JOHNSBURY
 PROJECT NUMBER: BRF 028-4(25)S
 FILE NAME: s98b320epscExt.dgn
 PROJECT LEADER: C. CARLSON
 DESIGNED BY: H. SALLS
 EPSC EXISTING CONDITION PLAN 2
 PLOT DATE: 28-AUG-2012
 DRAWN BY: C. MOONEY
 CHECKED BY: C. CARLSON
 SHEET 51 OF 62

SCALE 1" = 20'-0"
 20 0 20


LEGEND	
	TURBIDITY CURTAIN
	SILT FENCE (WOVEN WIRE)
	SILT FENCE
	CHECK DAMS
	LIMITS OF SOIL DISTURBANCE
	PROJECT DEMARCATION FENCE
	BARRIER FENCE
	50' RIPARIAN BUFFER RIPARIAN BUFFER ZONE
	50' WETLAND BUFFER WETLAND BUFFER ZONE
	INLET PROTECTION DEVICE
	STABILIZED CONST ENTRANCE

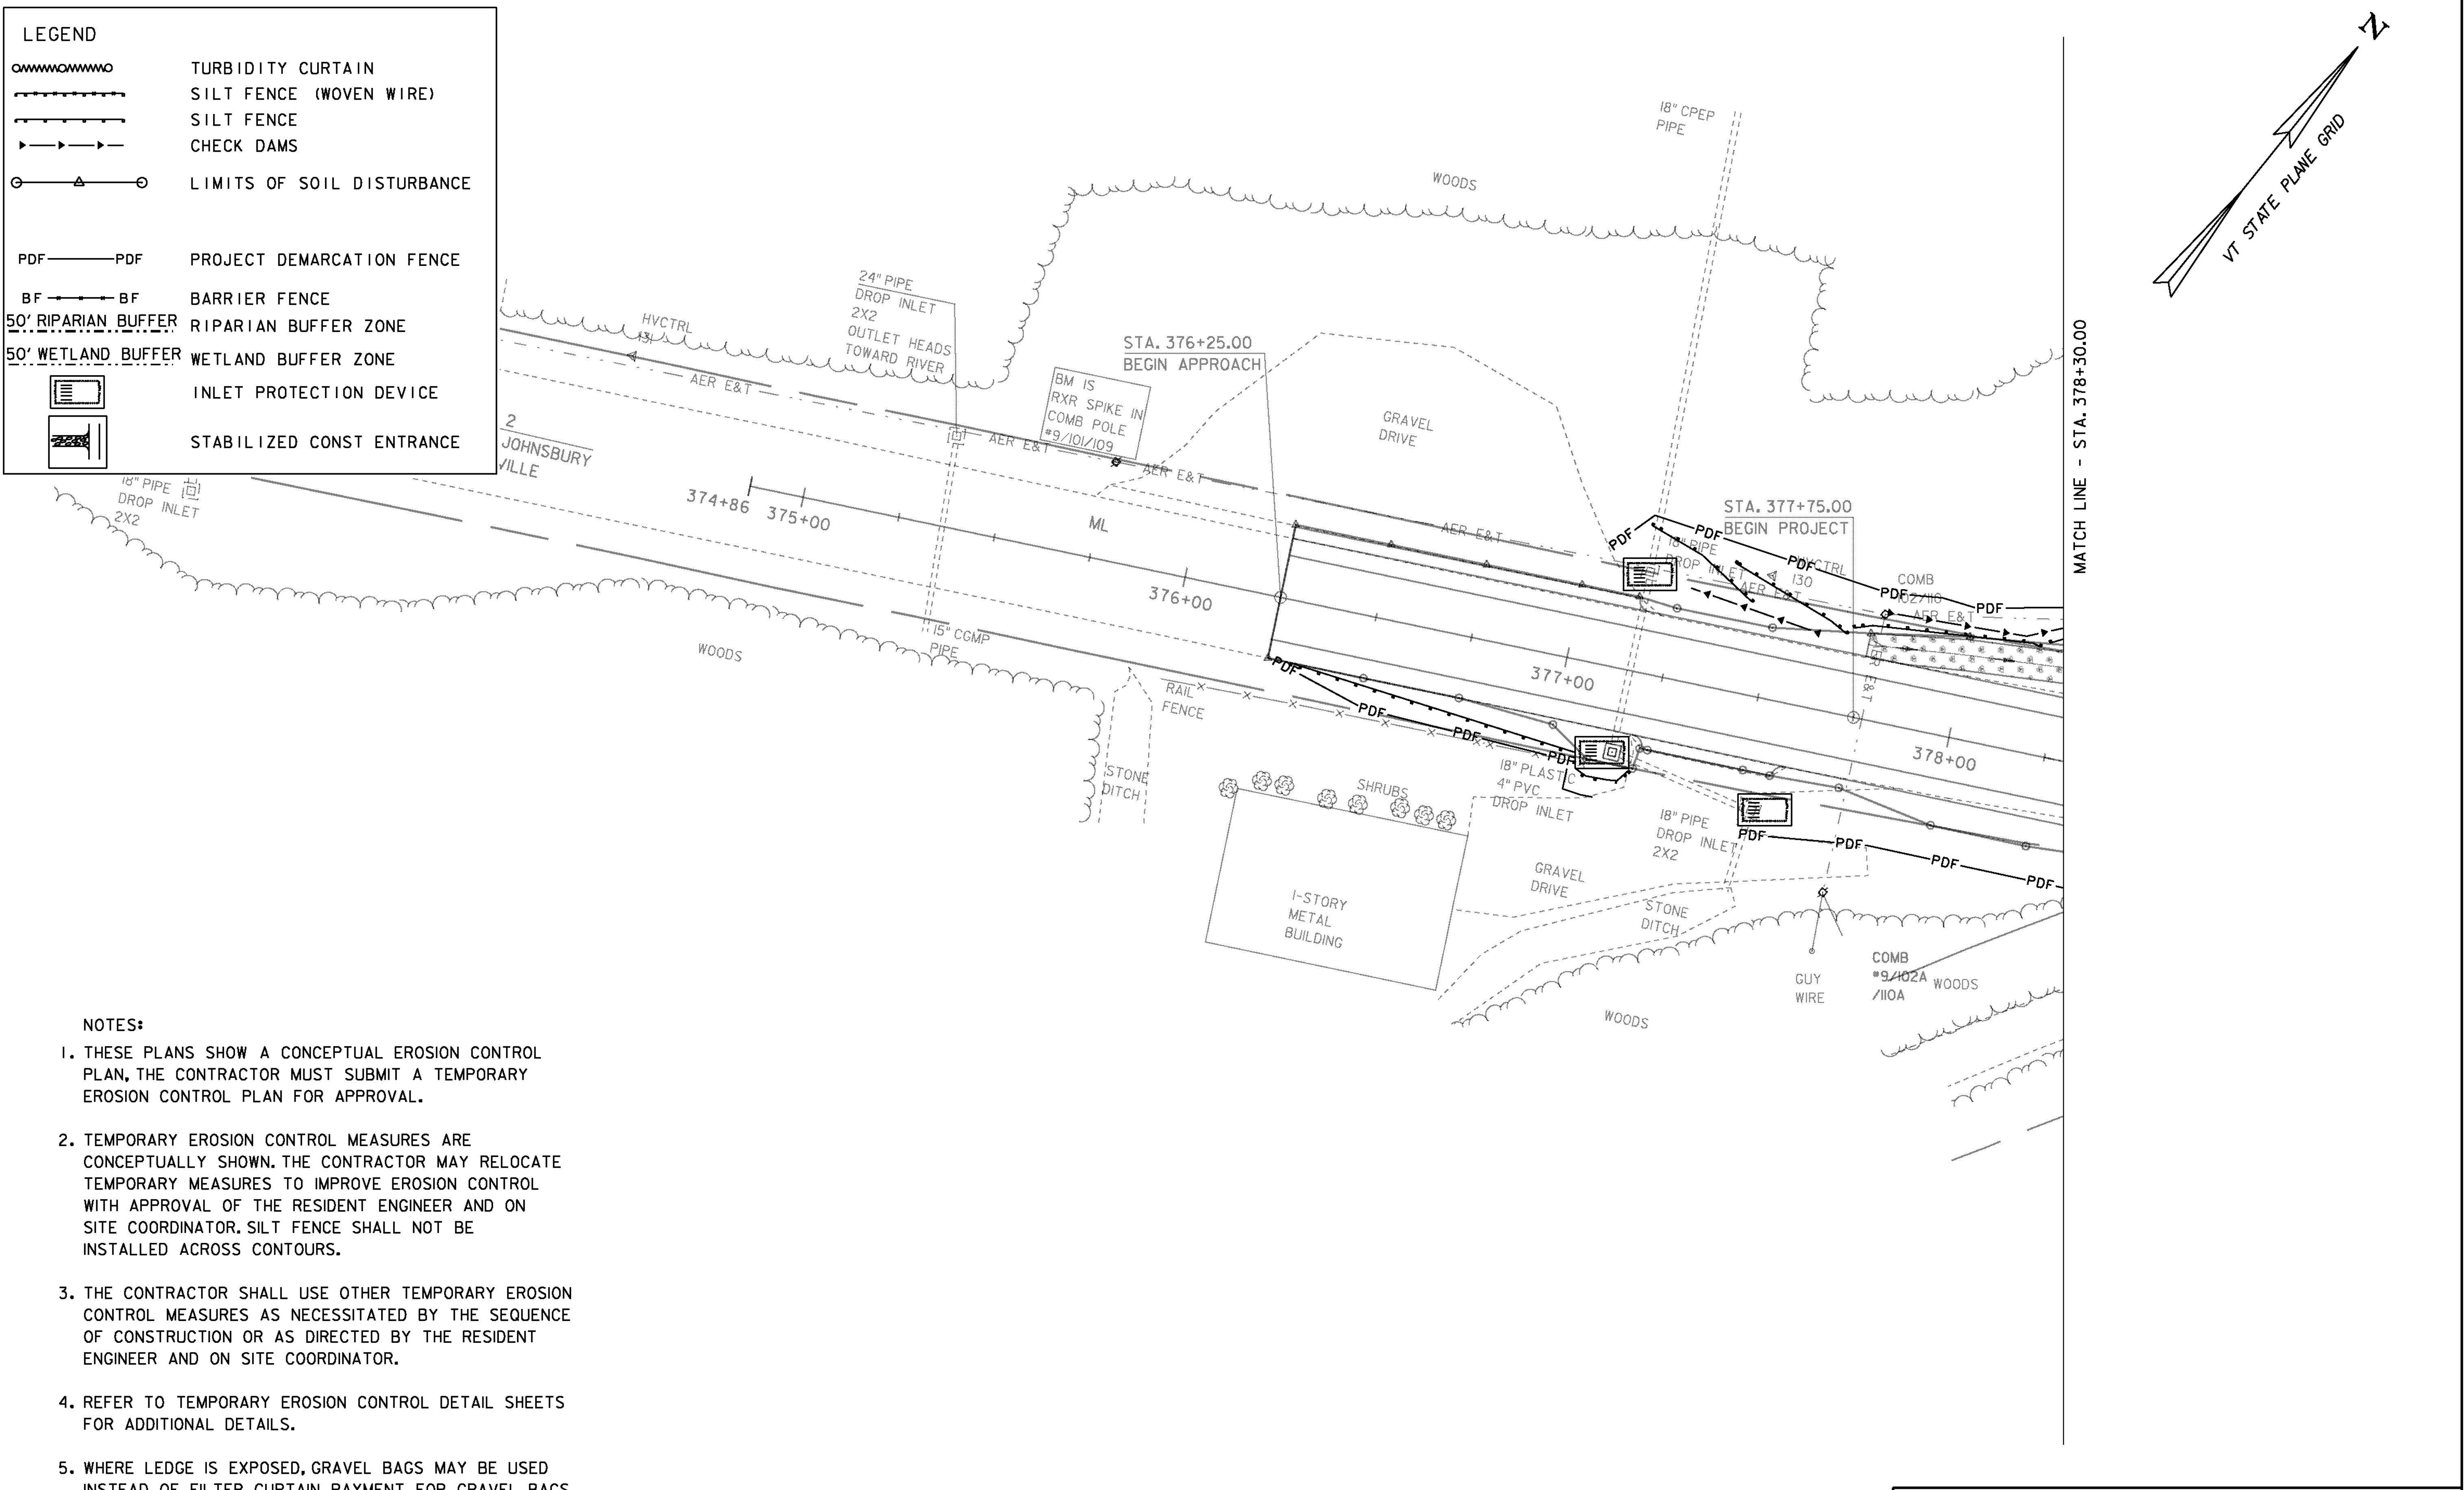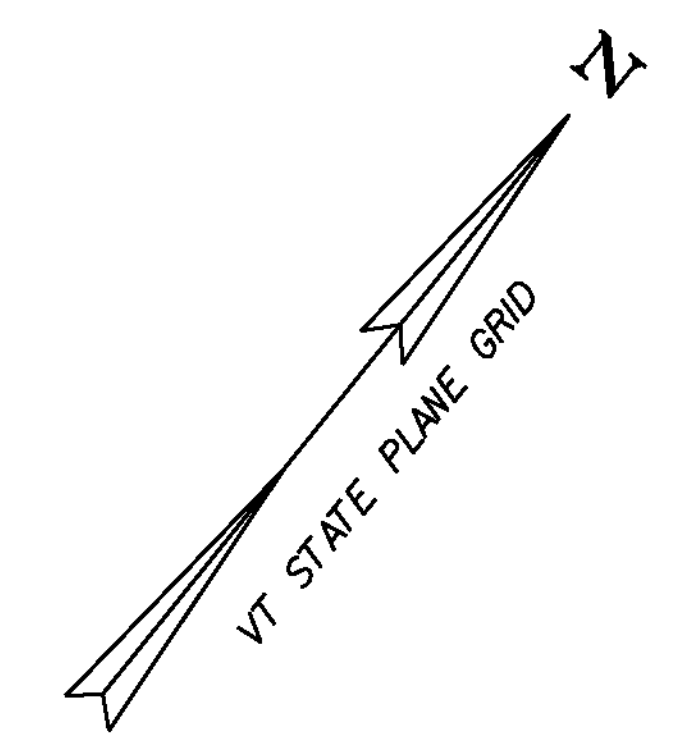

MATCH LINE - STA. 378+30.00

NOTES:


1. THESE PLANS SHOW A CONCEPTUAL EROSION CONTROL PLAN, THE CONTRACTOR MUST SUBMIT A TEMPORARY EROSION CONTROL PLAN FOR APPROVAL.
2. TEMPORARY EROSION CONTROL MEASURES ARE CONCEPTUALLY SHOWN. THE CONTRACTOR MAY RELOCATE TEMPORARY MEASURES TO IMPROVE EROSION CONTROL WITH APPROVAL OF THE RESIDENT ENGINEER AND ON SITE COORDINATOR. SILT FENCE SHALL NOT BE INSTALLED ACROSS CONTOURS.
3. THE CONTRACTOR SHALL USE OTHER TEMPORARY EROSION CONTROL MEASURES AS NECESSITATED BY THE SEQUENCE OF CONSTRUCTION OR AS DIRECTED BY THE RESIDENT ENGINEER AND ON SITE COORDINATOR.
4. REFER TO TEMPORARY EROSION CONTROL DETAIL SHEETS FOR ADDITIONAL DETAILS.
5. WHERE LEDGE IS EXPOSED, GRAVEL BAGS MAY BE USED INSTEAD OF FILTER CURTAIN. PAYMENT FOR GRAVEL BAGS WILL BE INCLUDED IN THE UNIT PRICE BID FOR ITEM 649.61 "GEOTEXTILE FOR FILTER CURTAIN".

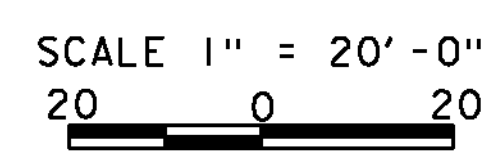


PROJECT NAME: ST. JOHNSBURY	
PROJECT NUMBER: BRF 028-4(25)S	
FILE NAME: s98b320epscCon.dgn	PLOT DATE: 28-AUG-2012
PROJECT LEADER: C. CARLSON	DRAWN BY: C. MOONEY
DESIGNED BY: H. SALLS	CHECKED BY: C. CARLSON
EPSC CONSTRUCTION CONDITION PLAN I	SHEET 52 OF 62

LEGEND	
	TURBIDITY CURTAIN
	SILT FENCE (WOVEN WIRE)
	SILT FENCE
	CHECK DAMS
	LIMITS OF SOIL DISTURBANCE
	PROJECT DEMARCATION FENCE
	BARRIER FENCE
	50' RIPARIAN BUFFER
	50' WETLAND BUFFER
	WETLAND BOUNDARY
	INLET PROTECTION DEVICE
	STABILIZED CONST ENTRANCE

MATCH LINE - STA. 378+30.00

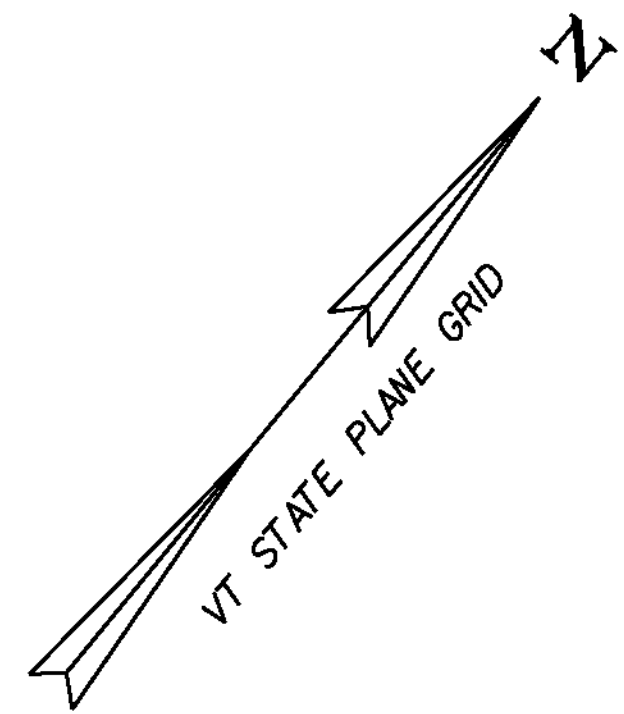


PLACE BARRIER FENCE ON ROW
STA. 381+25LT TO STA. 383+25LT.
PLACE SILT FENCE JUST INSIDE TO
ALLOW FOR SLOPE CONSTRUCTION.

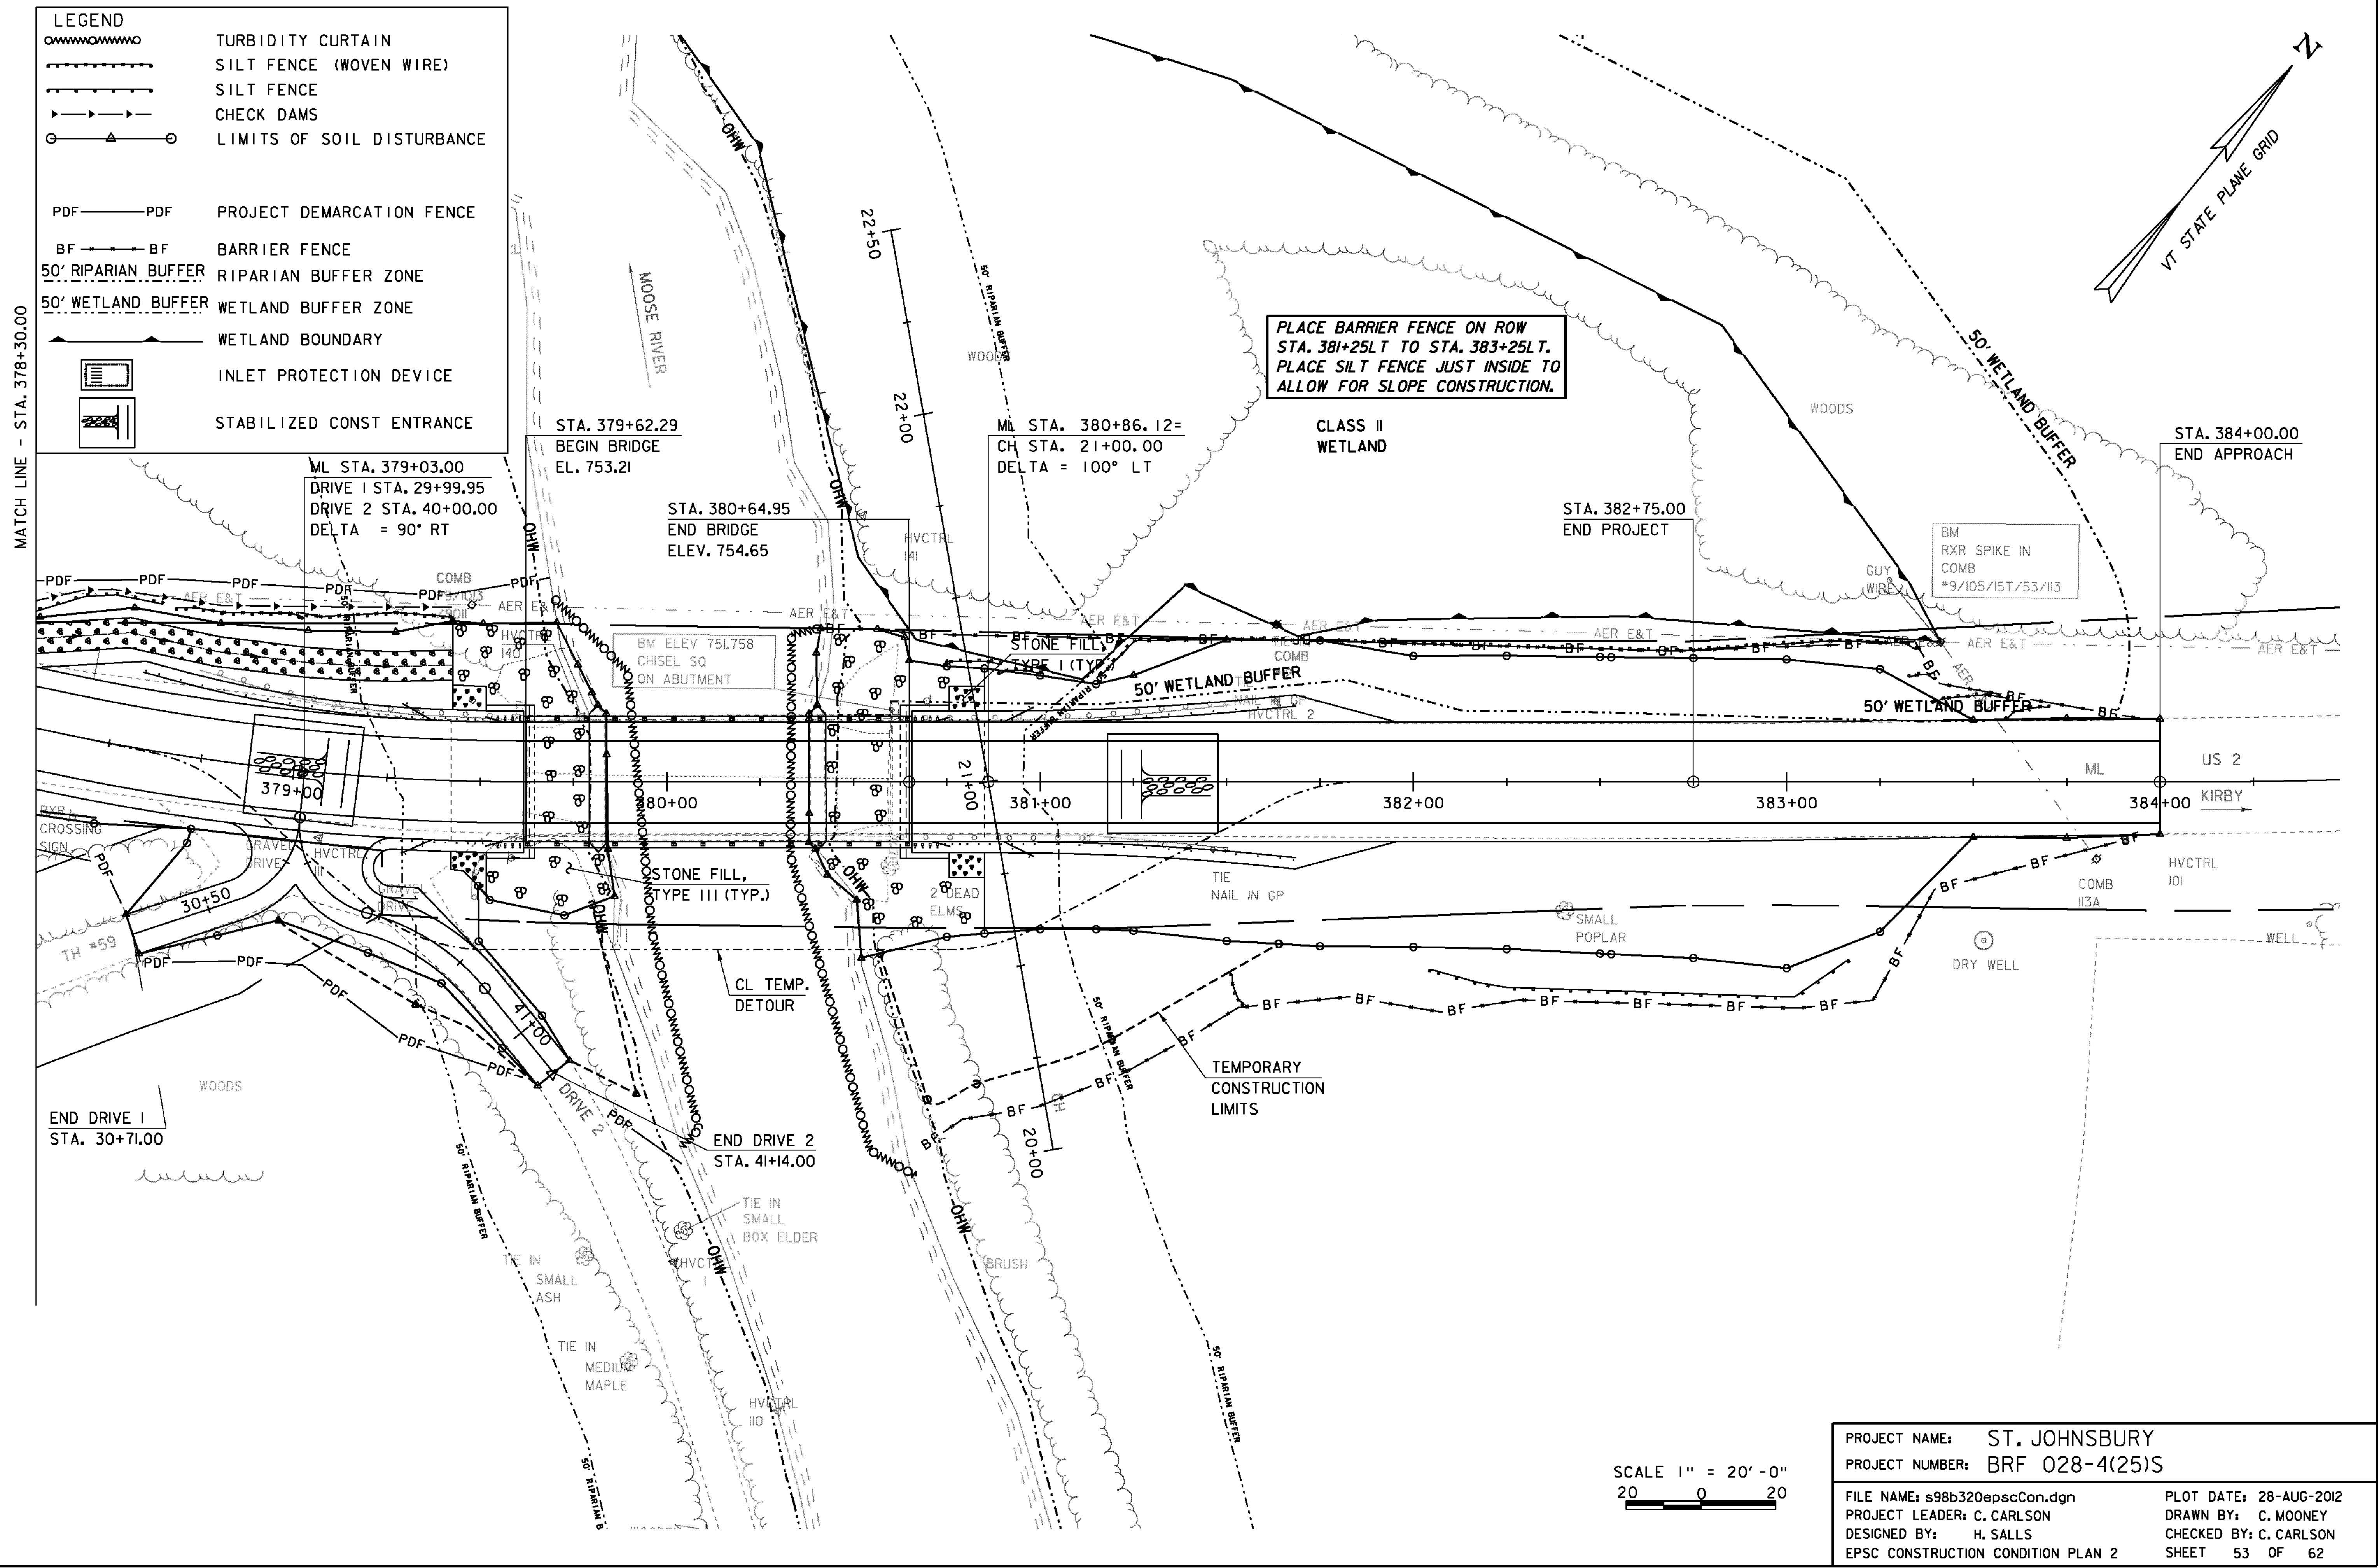


SCALE 1" = 20' - 0"
20 0 20

PROJECT NAME: ST. JOHNSBURY	PLOT DATE: 28-AUG-2012
PROJECT NUMBER: BRF 028-4(25)S	DRAWN BY: C. MOONEY
FILE NAME: s98b320epscCon.dgn	CHECKED BY: C. CARLSON
PROJECT LEADER: C. CARLSON	SHEET 53 OF 62
DESIGNED BY: H. SALLS	
EPSC CONSTRUCTION CONDITION PLAN 2	

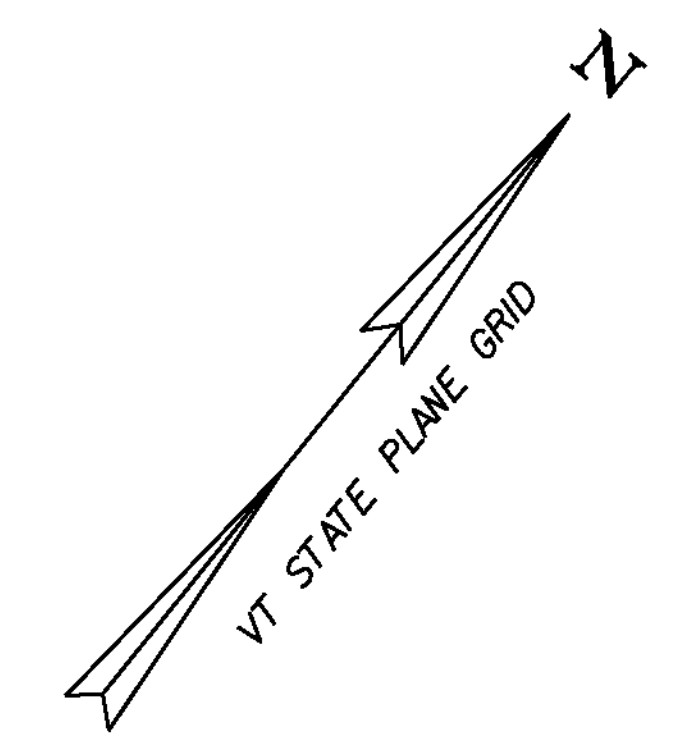

LAYOUT PLAN 2


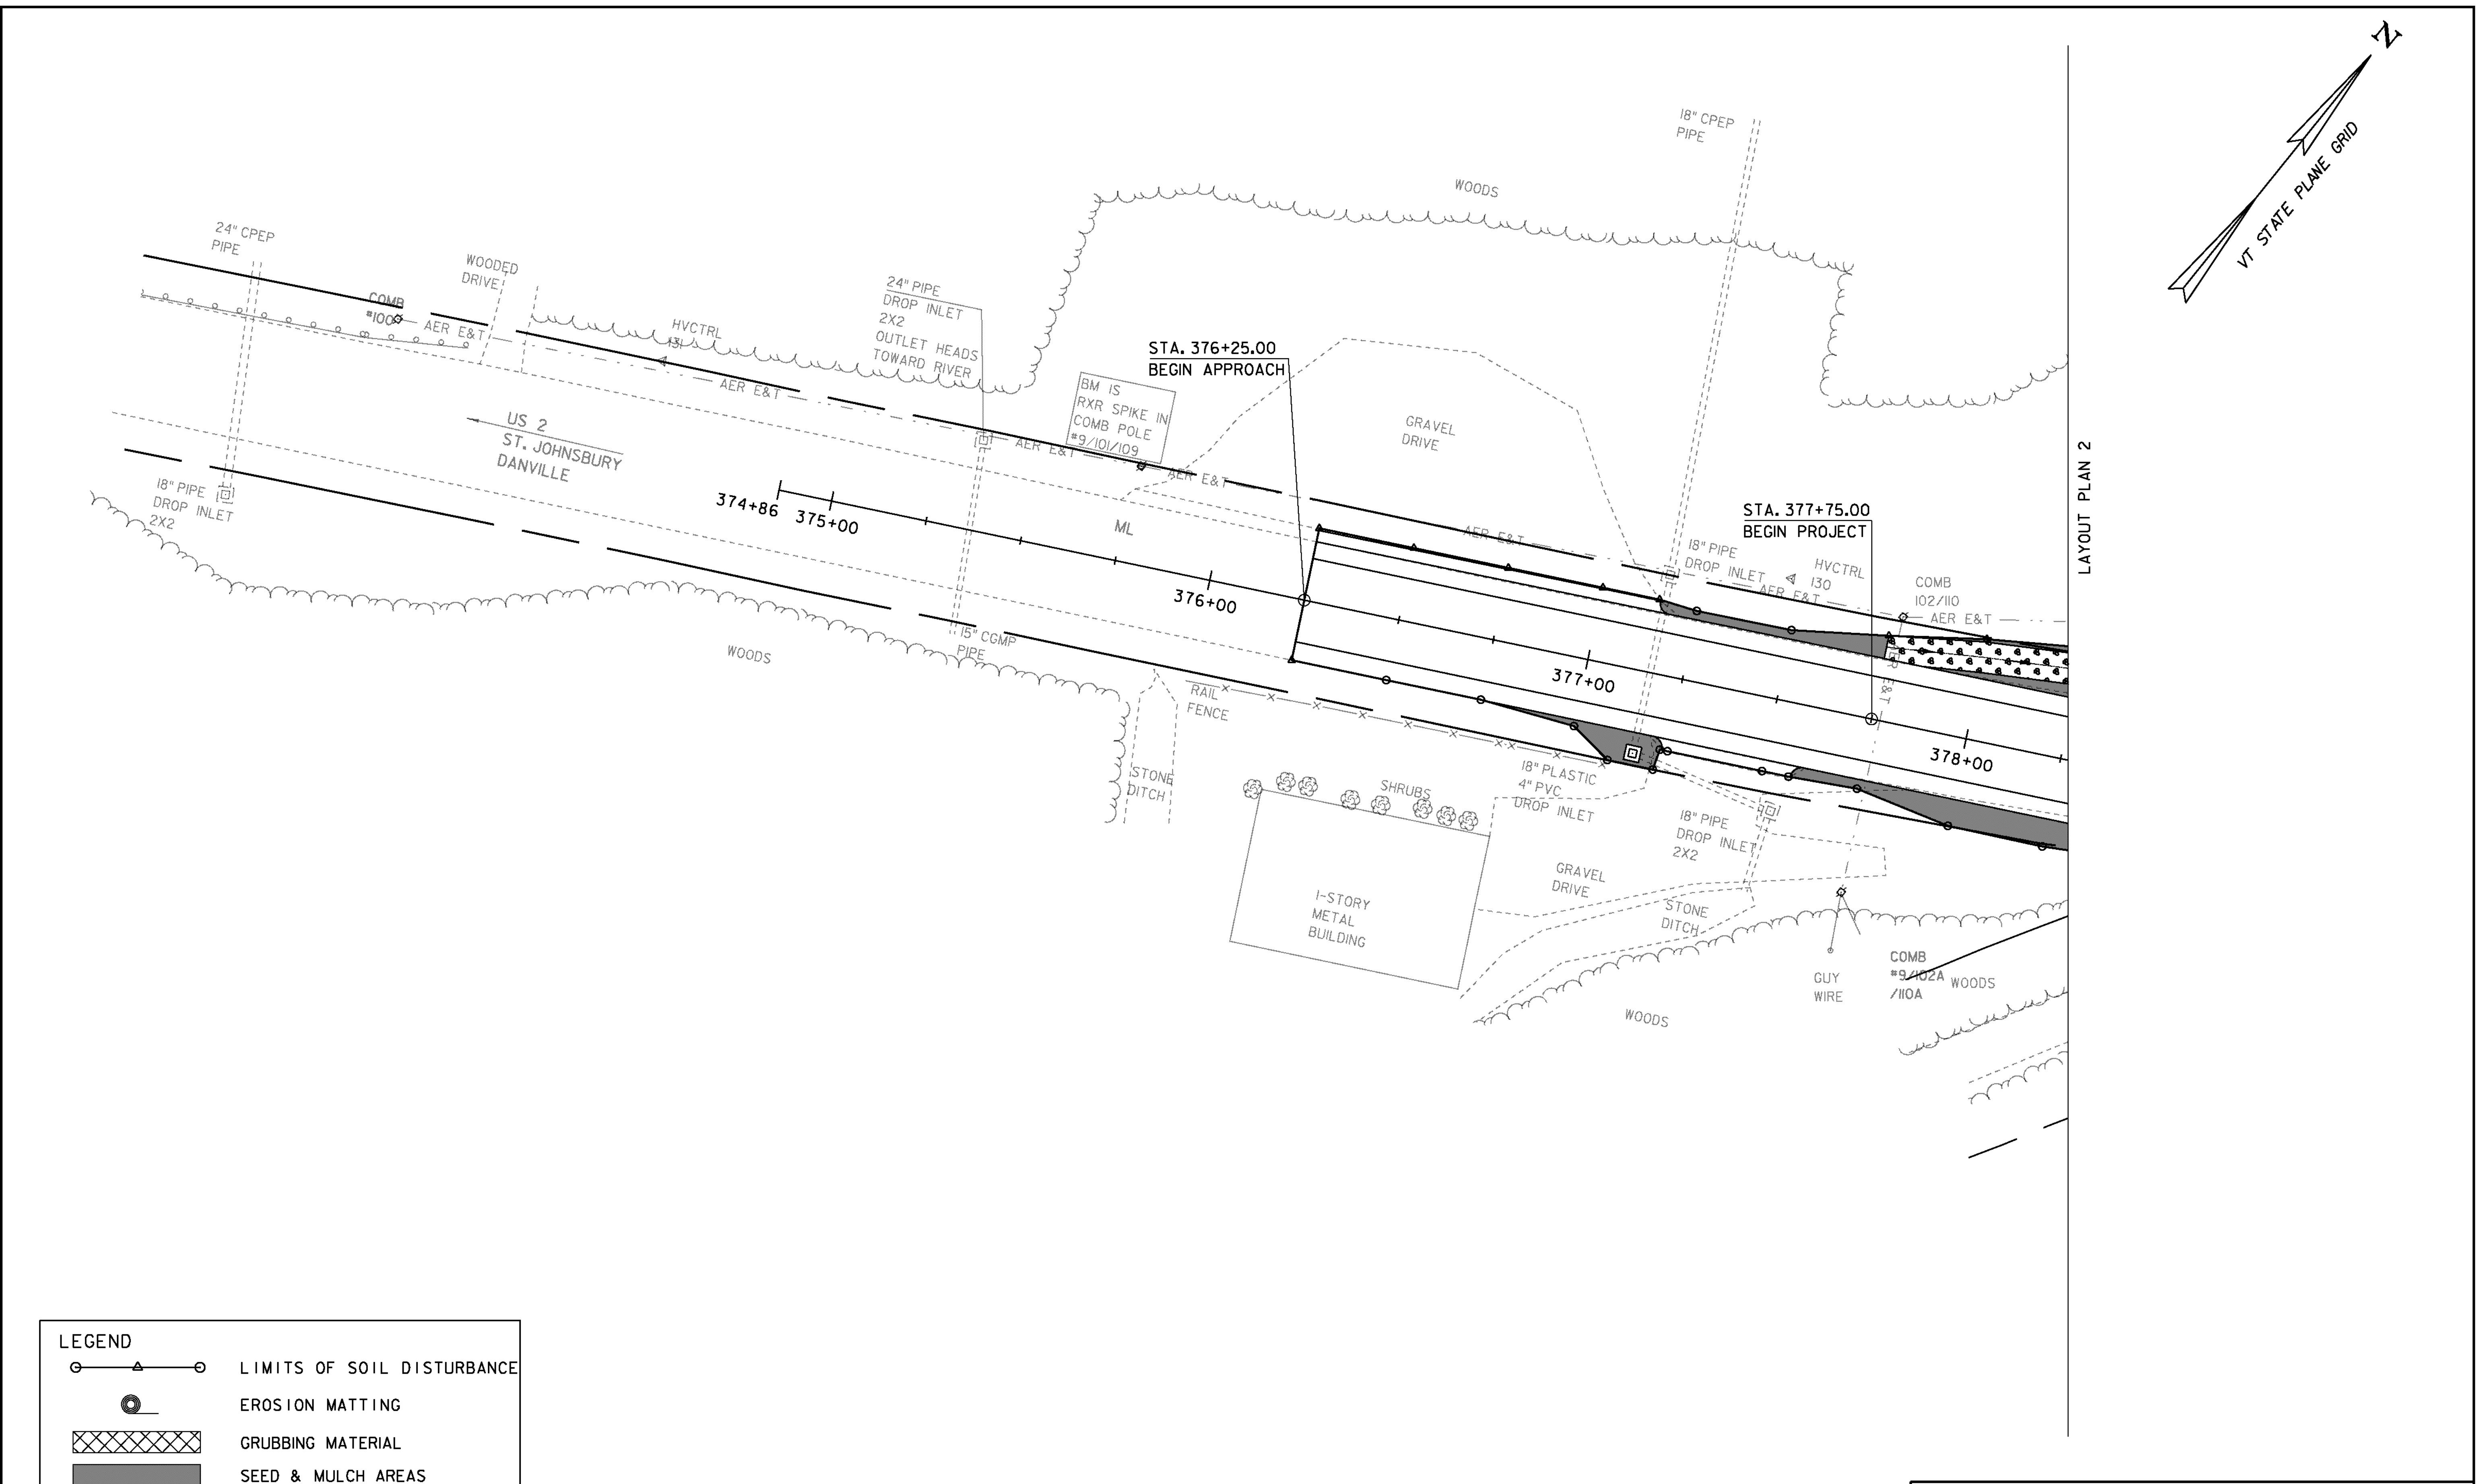


LEGEND	
	LIMITS OF SOIL DISTURBANCE
	EROSION MATTING
	GRUBBING MATERIAL
	SEED & MULCH AREAS
	50' RIPARIAN BUFFER RIPARIAN BUFFER ZONE
	50' WETLAND BUFFER WETLAND BUFFER ZONE
	WETLAND LIMITS

SCALE 1" = 20' - 0"

PROJECT NAME: ST. JOHNSBURY	
PROJECT NUMBER: BRF 028-4(25)S	
FILE NAME: s98b320epscFinal.dgn	PLOT DATE: 28-AUG-2012
PROJECT LEADER: C. CARLSON	DRAWN BY: C. MOONEY
DESIGNED BY: H. SALLS	CHECKED BY: C. CARLSON
EPSC FINAL CONDITION PLAN 1	SHEET 54 OF 62

LAYOUT PLAN 1

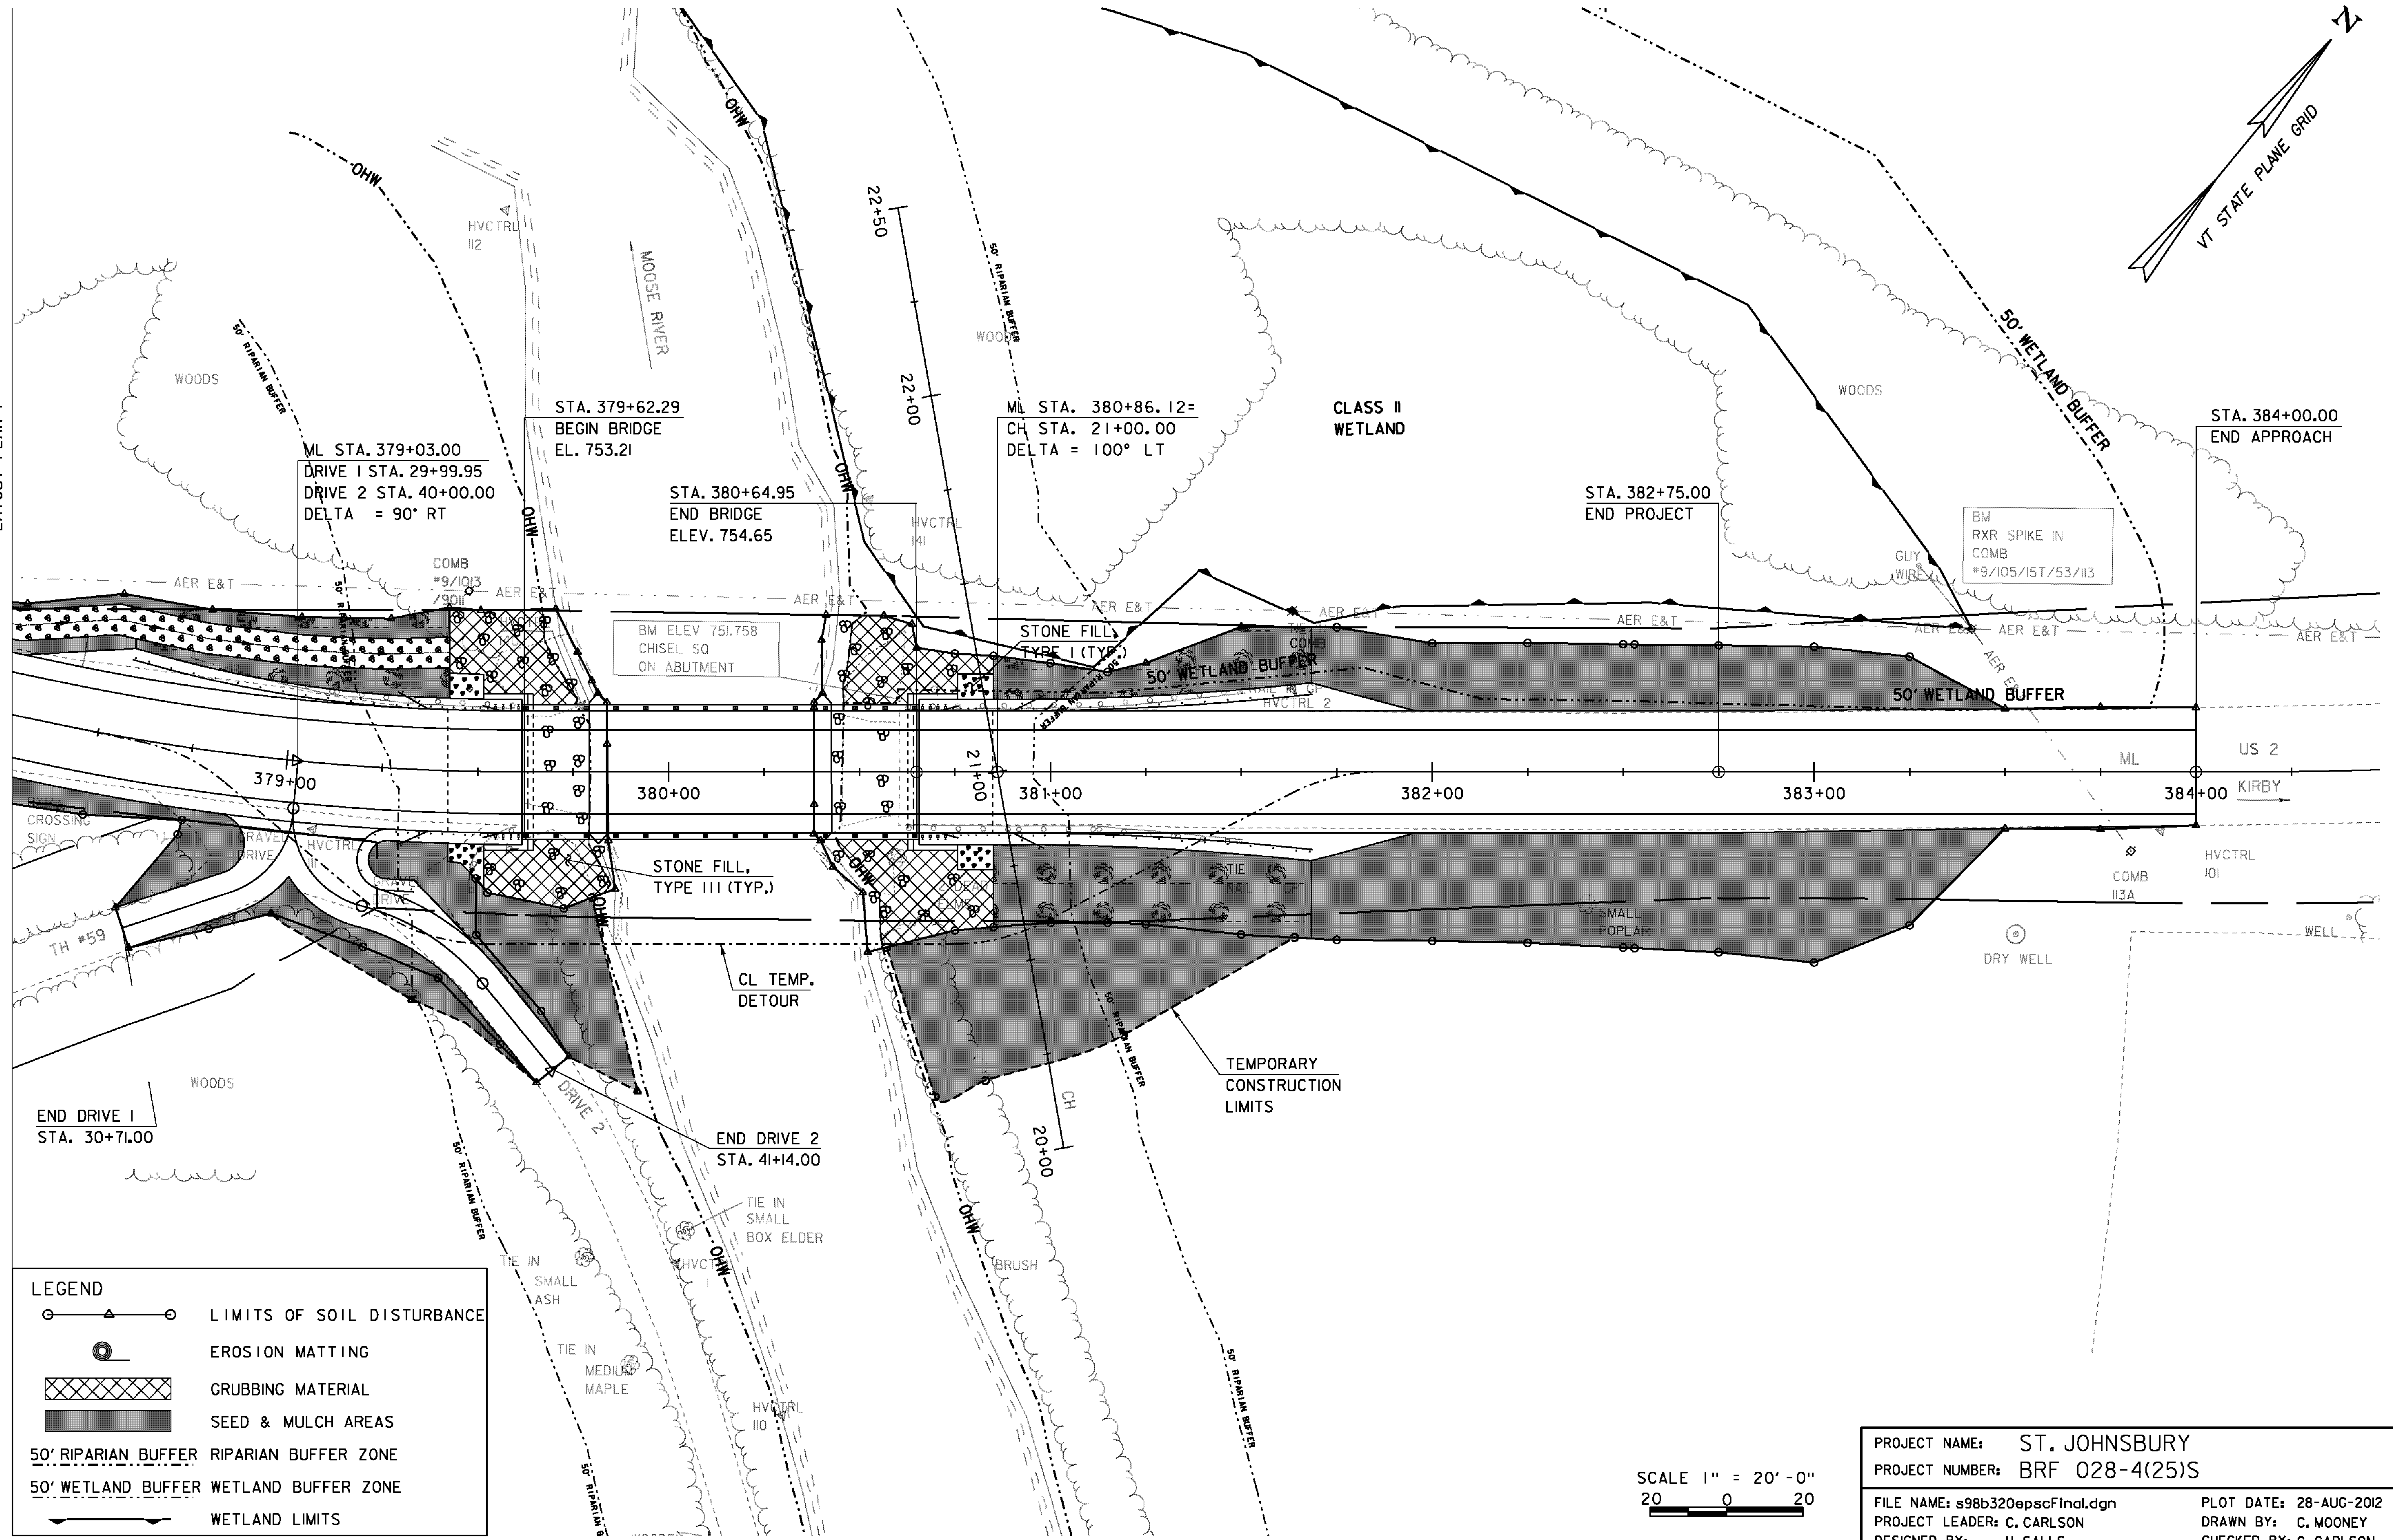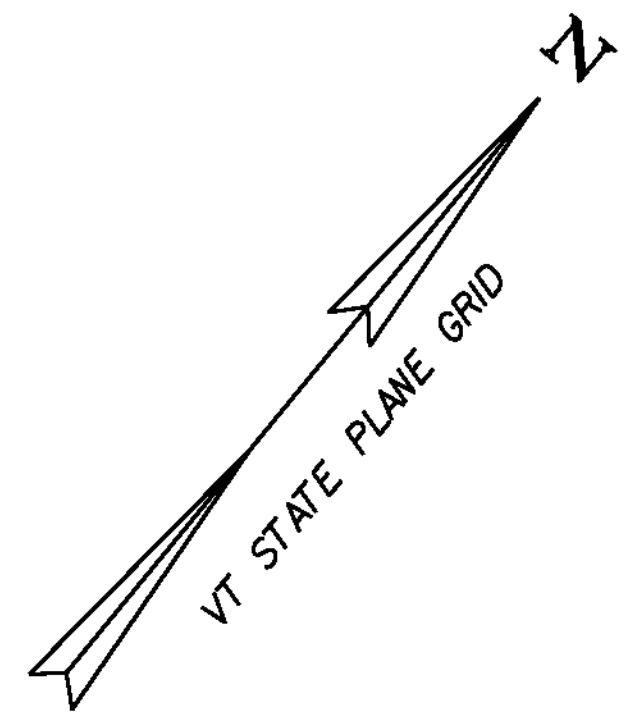


LEGEND

- LIMITS OF SOIL DISTURBANCE
- EROSION MATTING
- GRUBBING MATERIAL
- SEED & MULCH AREAS
- 50' RIPARIAN BUFFER RIPARIAN BUFFER ZONE
- 50' WETLAND BUFFER WETLAND BUFFER ZONE
- WETLAND LIMITS

SCALE 1" = 20' - 0"
20 0 20

PROJECT NAME: ST. JOHNSBURY	PLOT DATE: 28-AUG-2012
PROJECT NUMBER: BRF 028-4(25)S	DRAWN BY: C. MOONEY
FILE NAME: s98b320epscFinal.dgn	CHECKED BY: C. CARLSON
PROJECT LEADER: C. CARLSON	SHEET 55 OF 62
DESIGNED BY: H. SALLS	
EPSC FINAL CONDITION PLAN 2	

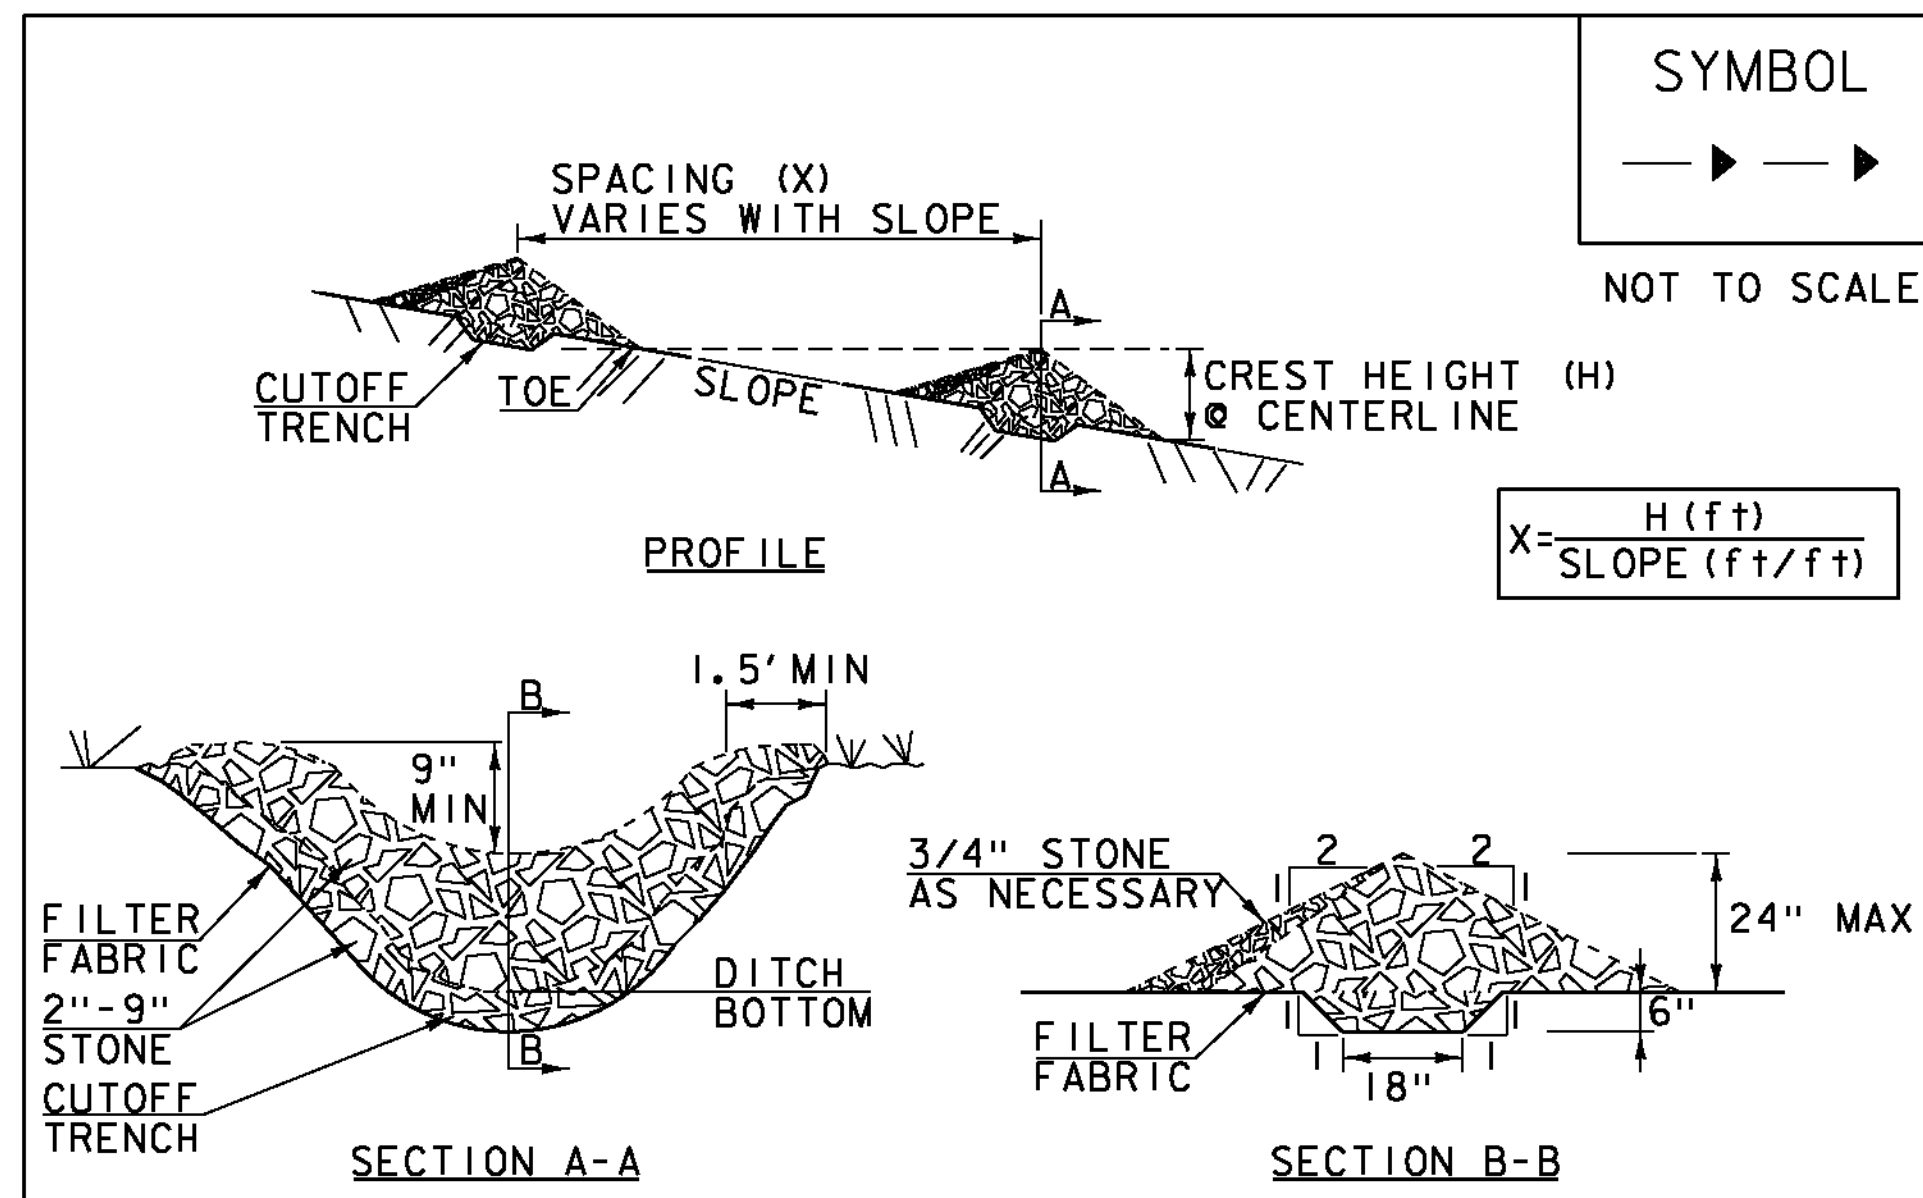

SYMBOL

 NOT TO SCALE

CONSTRUCTION SPECIFICATIONS

1. STONE WILL BE PLACED ON A FILTER FABRIC FOUNDATION.
2. CHECK DAMS SHALL BE SPACED SO THAT THE ELEVATION OF THE CREST OF THE DOWNSTREAM DAM IS AT THE SAME ELEVATION AS THE TOE OF THE UPSTREAM DAM.
3. 3/4" FILTERING STONE MAY BE ADDED TO THE FACE OF THE CHECK DAM AS NECESSARY.
4. EXTEND THE STONE A MINIMUM OF 1.5' BEYOND THE DITCH BANKS TO PREVENT CUTTING AROUND THE DAM.
5. PROTECT CHANNEL DOWNSTREAM OF THE LOWEST CHECK DAM FROM SCOUR AND EROSION WITH STONE OR LINER AS APPROPRIATE.
6. ENSURE THAT CHANNEL APPURTENANCES SUCH AS CULVERT ENTRANCES BELOW CHECK DAMS ARE NOT SUBJECT TO DAMAGE OR BLOCKAGE FROM DISPLACED STONE.
7. MAXIMUM DRAINAGE AREA 2 ACRES.


ADAPTED FROM DETAILS PROVIDED BY: NEW YORK STATE DEC
 ORIGINALLY DEVELOPED BY USDA-NRCS
 VERMONT DEPARTMENT OF ENVIRONMENTAL CONSERVATION

CHECK DAM

NOTES:
 REFER TO "THE VERMONT STANDARDS & SPECIFICATIONS FOR EROSION PREVENTION & SEDIMENT CONTROL -2006- "FROM THE VT AGENCY OF NATURAL RESOURCES FOR ADDITIONAL GUIDANCE.

THIS WORK SHALL BE PERFORMED IN ACCORDANCE WITH SECTION 653 FOR TEMPORARY STONE CHECK DAM, TYPE I (PAY ITEM 653.25)

REVISIONS	
MARCH 21, 2008	WHF
JANUARY 8, 2009	WHF

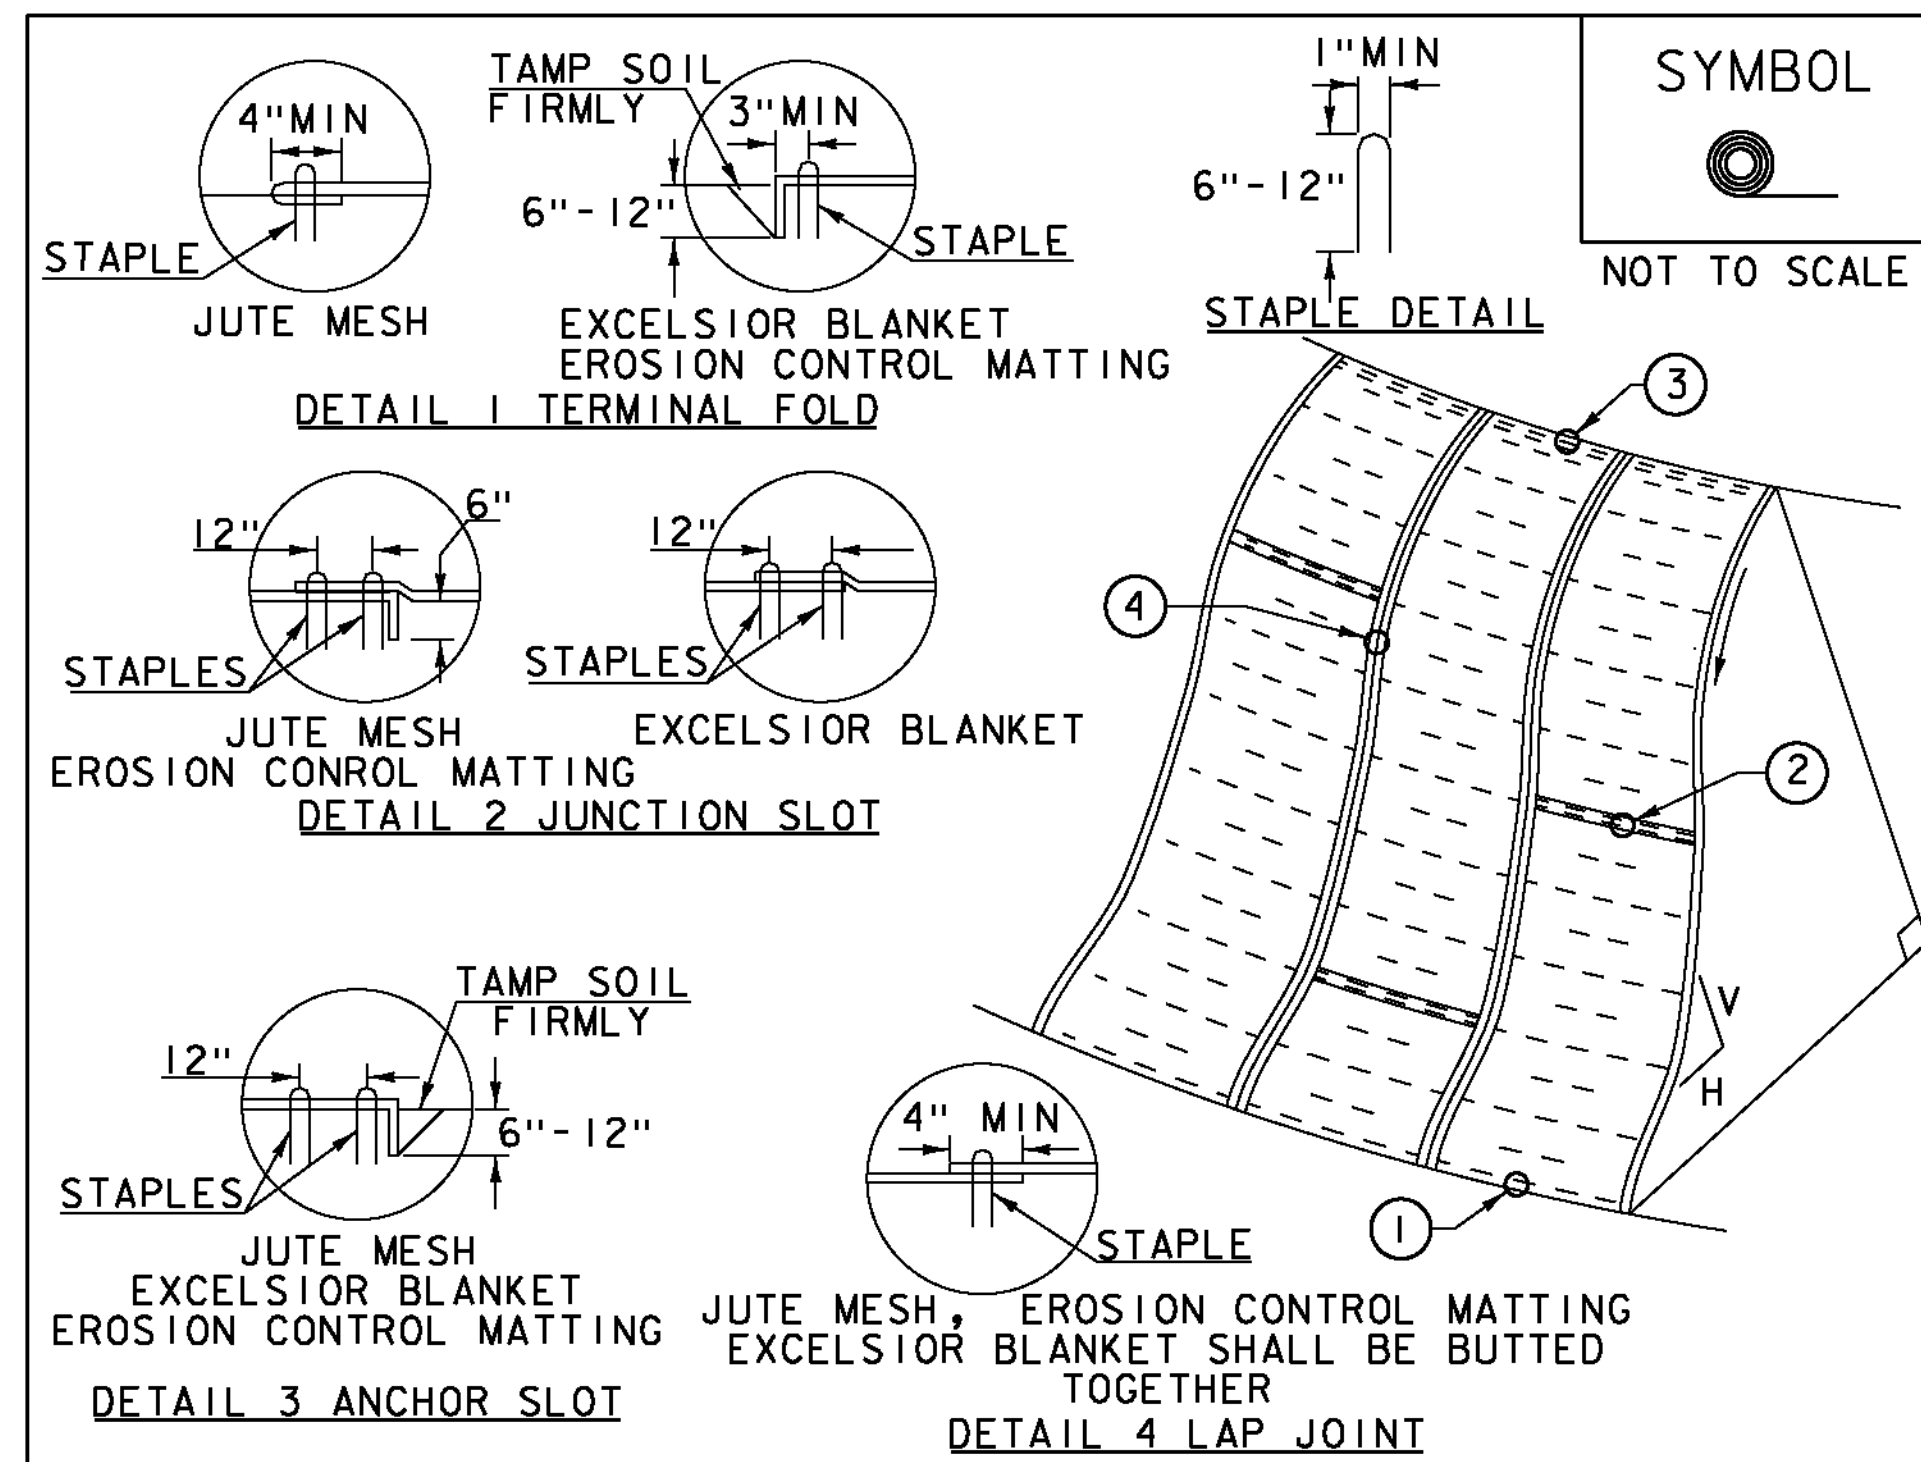

SYMBOL

 NOT TO SCALE

CONSTRUCTION SPECIFICATIONS

1. APPLY TO SLOPES GREATER THAN 3H:1V OR WHERE NECESSARY TO AID IN ESTABLISHING VEGETATION.
2. APPLY FERTILIZER, LIME SEED PRIOR TO PLACING MATTING.
3. STAPLES ARE TO BE PLACED ALTERNATELY, IN COLUMNS APPROXIMATELY 2' APART AND IN ROWS APPROXIMATELY 3' APART. APPROXIMATELY 175 STAPLES ARE REQUIRED PER 4' X 225' ROLL OF MATERIAL AND 125 STAPLES ARE REQUIRED PER 4' X 150' ROLL OF MATERIAL.
4. DISTURBED AREAS SHALL BE SMOOTHLY GRADED. EROSION CONTROL MATERIAL SHALL BE PLACED LOOSELY OVER GROUND SURFACE. DO NOT STRETCH.
5. ALL TERMINAL ENDS AND TRANSVERSE LAPS SHALL BE STAPLED AT APPROXIMATELY 12" INTERVALS.


ADAPTED FROM DETAILS PROVIDED BY: NEW YORK STATE DEC
 ORIGINALLY DEVELOPED BY USDA-NRCS
 VERMONT DEPARTMENT OF ENVIRONMENTAL CONSERVATION

ROLLED EROSION CONTROL PRODUCT (RECP) SIDE SLOPE

NOTES:
 REFER TO "THE VERMONT STANDARDS & SPECIFICATIONS FOR EROSION PREVENTION & SEDIMENT CONTROL -2006- "FROM THE VT AGENCY OF NATURAL RESOURCES FOR ADDITIONAL GUIDANCE.

THIS WORK SHALL BE PERFORMED IN ACCORDANCE WITH SECTION 653 AND AS SHOWN IN THE PLANS FOR TEMPORARY EROSION MATTING (PAY ITEM 653.20) OR PERMANENT EROSION MATTING (PAY ITEM 653.21)

REVISIONS	
APRIL 16, 2007	JMF
JANUARY 13, 2009	WHF

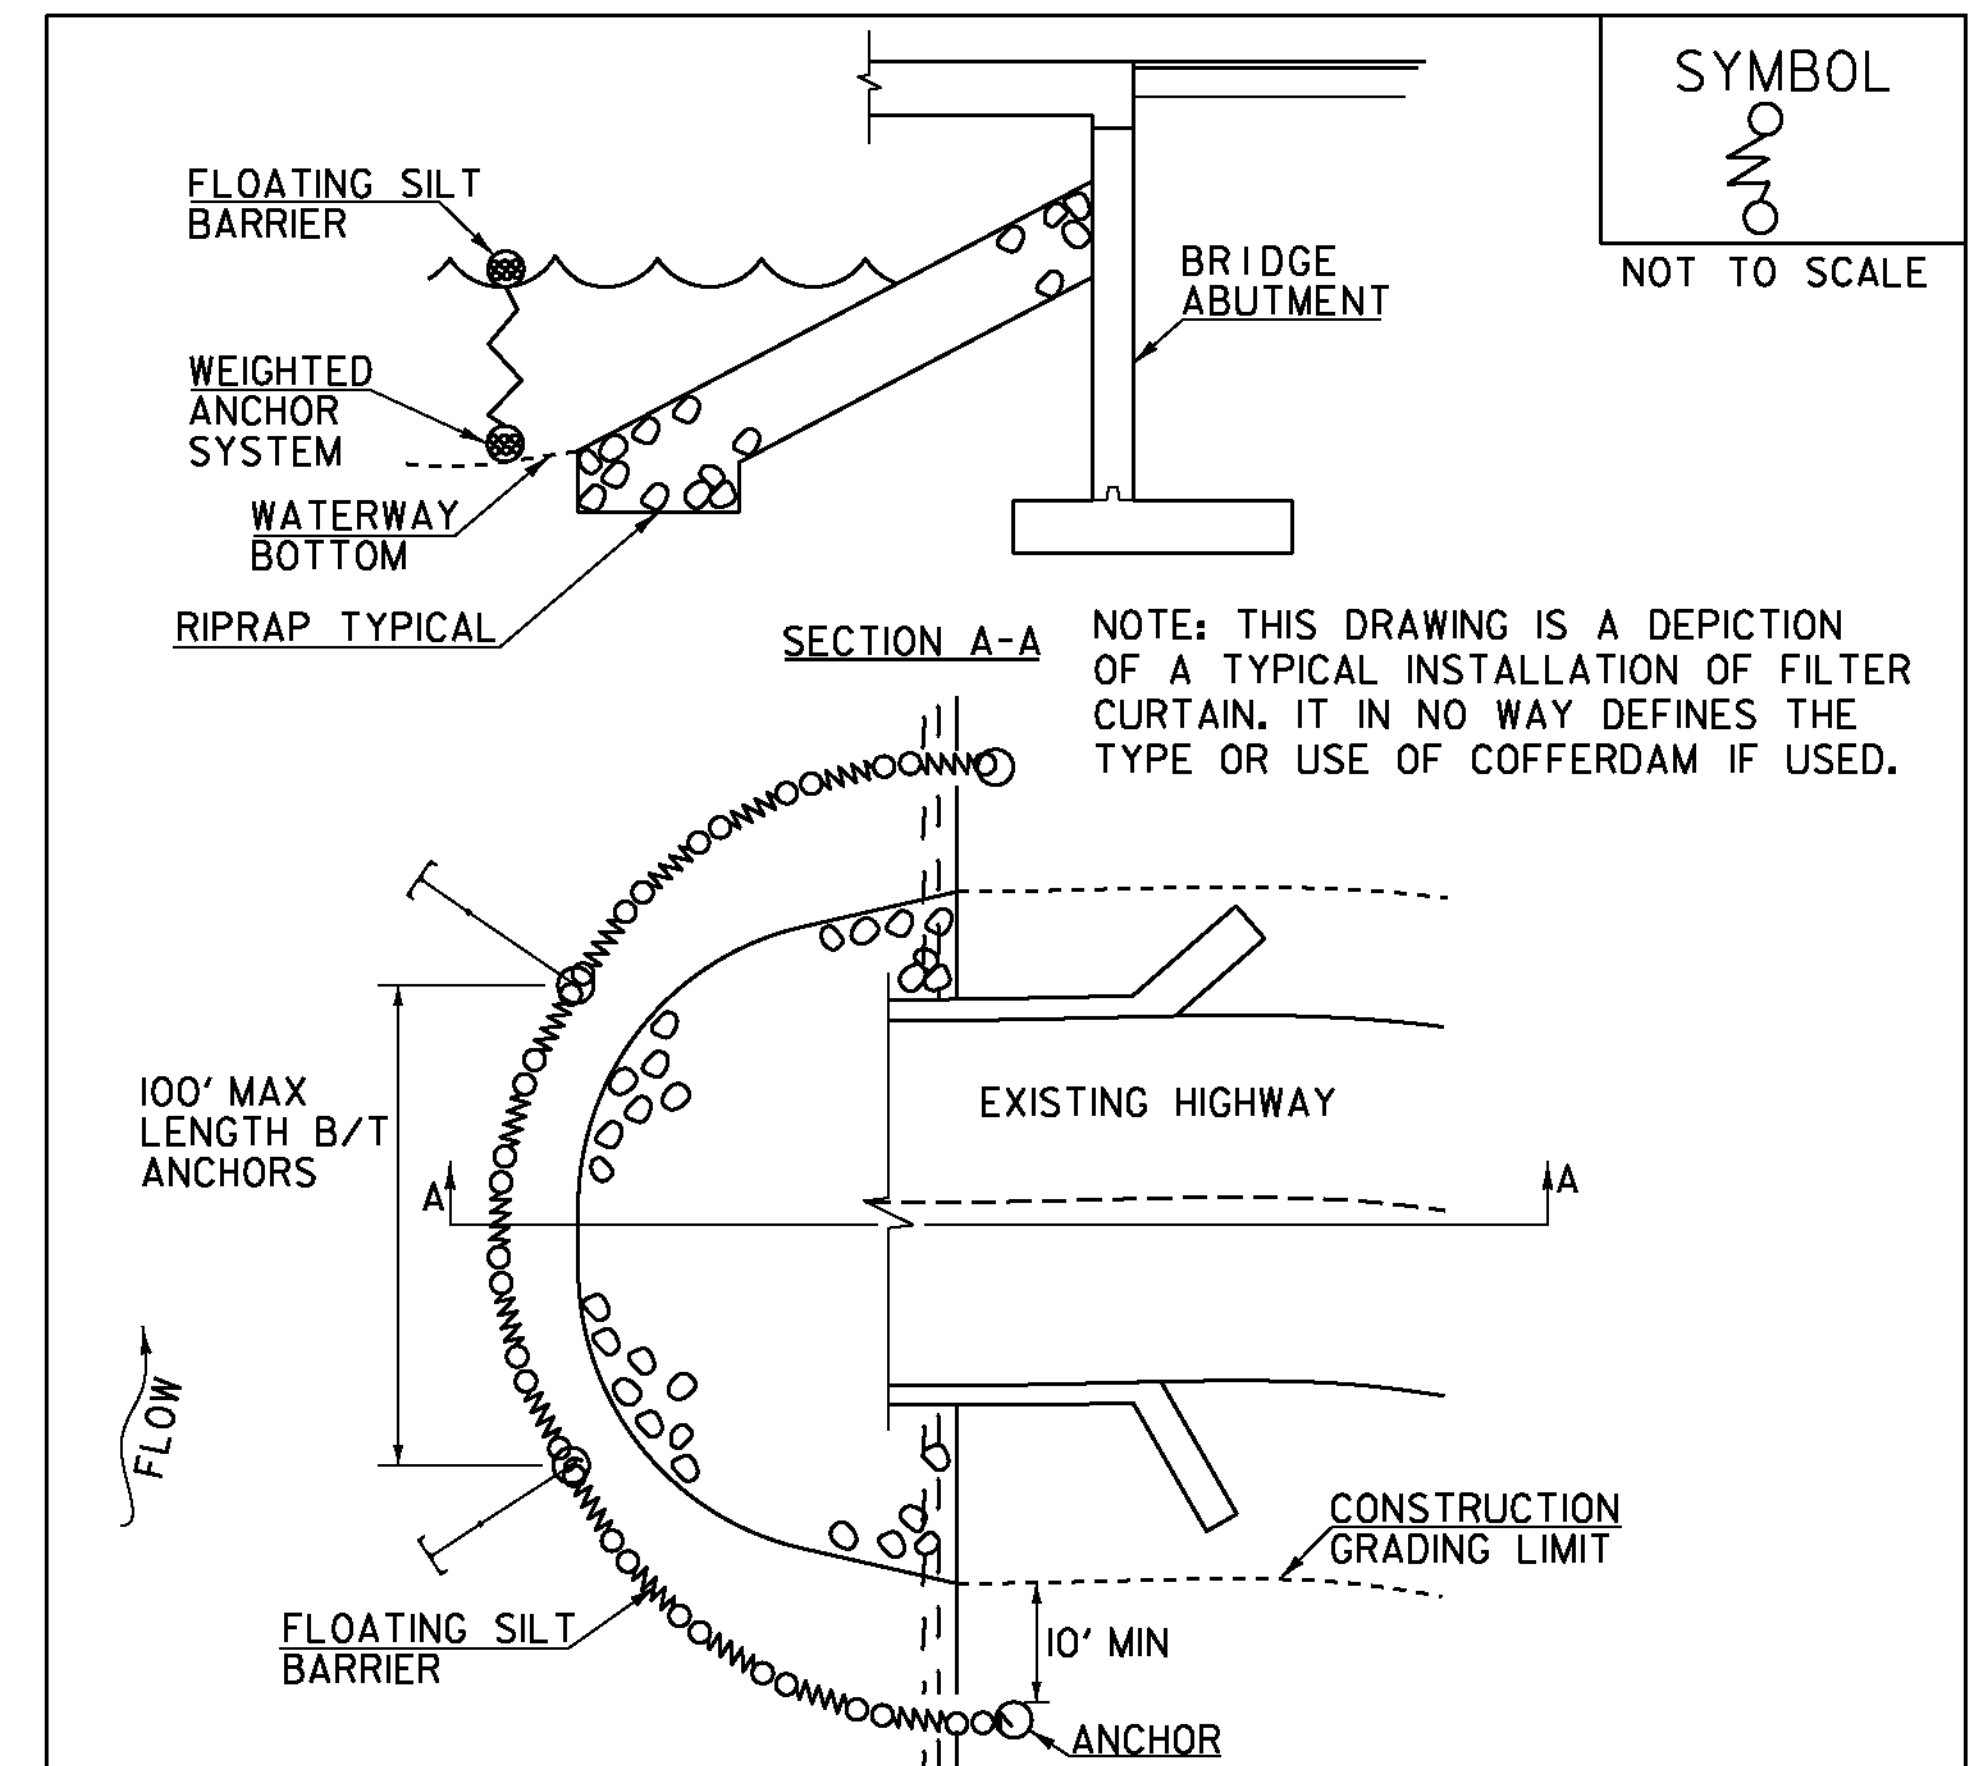

SYMBOL

 NOT TO SCALE

CONSTRUCTION SPECIFICATIONS

1. FILTER CURTAIN SHALL NOT BE PLACED ACROSS A FLOWING WATERWAY, OR IN A WATERWAY WITH STREAM VELOCITIES GREATER THAN 1.5 FEET/SECOND.
2. MAXIMUM 100' LENGTH BETWEEN ANCHORS.
3. LAST SECTION SHALL TERMINATE A MINIMUM OF 10' BEYOND LIMIT OF DISTURBANCE.
4. THE WEIGHTED ANCHOR SYSTEM SHALL BE A TYPE WHICH ALLOWS THE CURTAIN TO CONFORM TO THE BOTTOM OF THE WATERWAY.
5. THE CURTAIN SHALL BE REMOVED BY SLOWLY PULLING TOWARD THE SHORE MINIMIZING THE ESCAPE OF SEDIMENTS INTO WATERWAY.

ADAPTED FROM DETAILS PROVIDED BY: NEW YORK STATE DEC
 ORIGINALLY DEVELOPED BY USDA-NRCS
 VERMONT DEPARTMENT OF ENVIRONMENTAL CONSERVATION

FILTER CURTAIN


THIS WORK SHALL BE PERFORMED IN ACCORDANCE WITH SECTION 649 FOR GEOTEXTILE FOR FILTER CURTAIN (PAY ITEM 649.61).

REVISIONS	
APRIL 1, 2008	WHF
JANUARY 13, 2009	WHF
SEPTEMBER 4, 2009	WHF

PROJECT NAME: ST. JOHNSBURY
 PROJECT NUMBER: BRF 028-4(25)S

FILE NAME: s98b320epscDet.dgn
 PROJECT LEADER: C. CARLSON
 DESIGNED BY: H. SALLS
 EPSC DETAILS I

PLOT DATE: 28-AUG-2012
 DRAWN BY: C. MOONEY
 CHECKED BY: C. CARLSON
 SHEET 56 OF 62

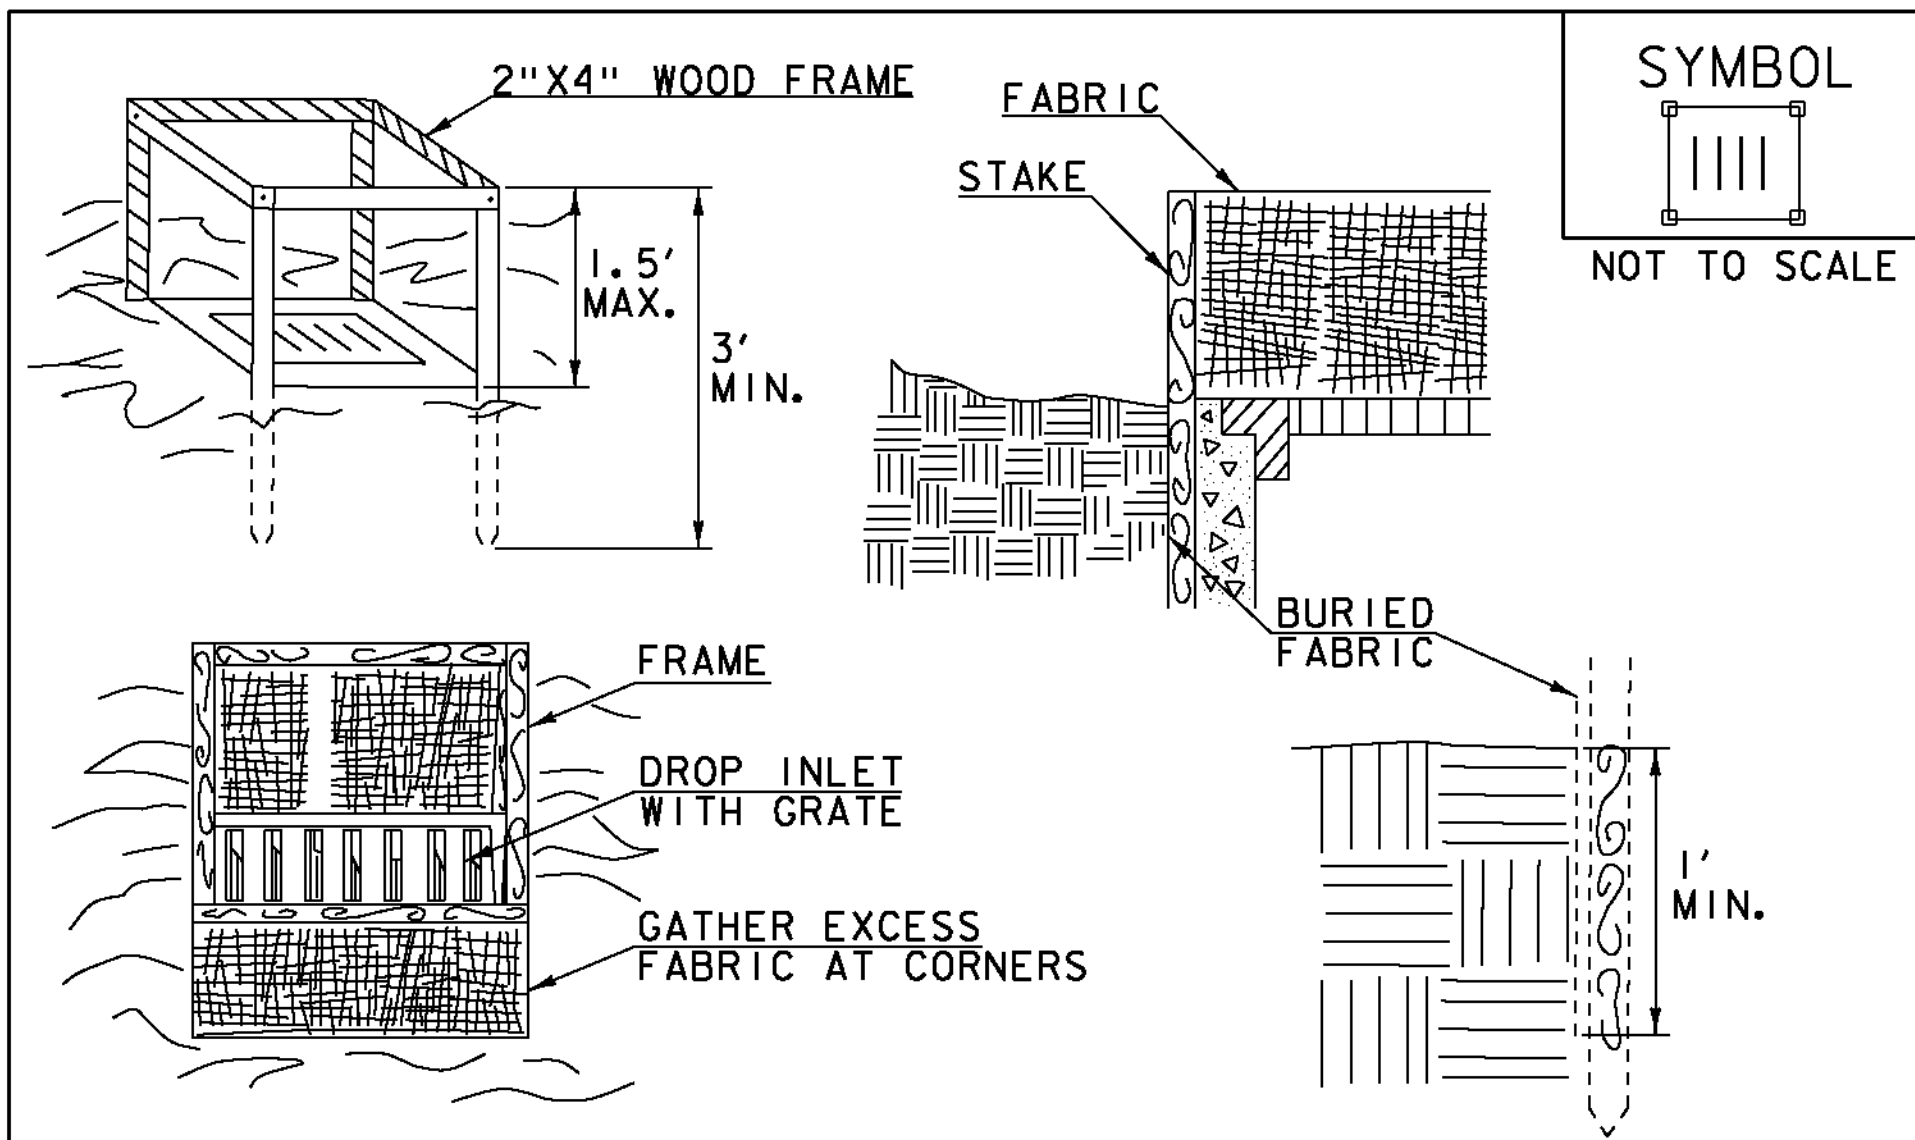

CONSTRUCTION SPECIFICATIONS

1. FILTER FABRIC SHALL HAVE AN APPARENT OPENING SIZE OF 40-85. BURLAP MAY BE USED FOR SHORT TERM APPLICATIONS.
2. CUT FABRIC FROM A CONTINUOUS ROLL TO ELIMINATE JOINTS. IF JOINTS ARE NEEDED THEY WILL BE OVERLAPPED TO THE NEXT STAKE.
3. STAKE MATERIALS WILL BE STANDARD 2"x 4" WOOD OR EQUIVALENT METAL WITH A MINIMUM LENGTH OF 3'.
4. SPACE STAKES EVENLY AROUND INLET 3' APART AND DRIVE A MINIMUM 18" DEEP. SPANS GREATER THAN 3' MAY BE BRIDGED WITH THE USE OF WIRE MESH BEHIND THE FILTER FABRIC FOR SUPPORT.
5. FABRIC SHALL BE EMBEDDED 1' MINIMUM BELOW GROUND AND BACKFILLED. IT SHALL BE SECURELY FASTENED TO THE STAKES AND FRAME.
6. A 2" x 4" WOOD FRAME SHALL BE COMPLETED AROUND THE CREST OF THE FABRIC FOR OVER FLOW STABILITY.
7. MAXIMUM DRAINAGE AREA 1 ACRE


ADAPTED FROM DETAILS PROVIDED BY: NEW YORK STATE DEC
ORIGINALLY DEVELOPED BY USDA-NRCS
VERMONT DEPARTMENT OF ENVIRONMENTAL CONSERVATION

**FILTER FABRIC
DROP INLET
PROTECTION**

NOTES:
REFER TO "THE VERMONT STANDARDS & SPECIFICATIONS FOR
EROSION PREVENTION & SEDIMENT CONTROL -2006- "FROM
THE VT AGENCY OF NATURAL RESOURCES FOR ADDITIONAL
GUIDANCE.

THIS WORK SHALL BE PERFORMED IN ACCORDANCE WITH
SECTION 653 FOR INLET PROTECTION DEVICE, TYPE 1(PAY
ITEM 653.40).

REVISIONS	
MARCH 7, 2008	WHF
JANUARY 13, 2009	WHF

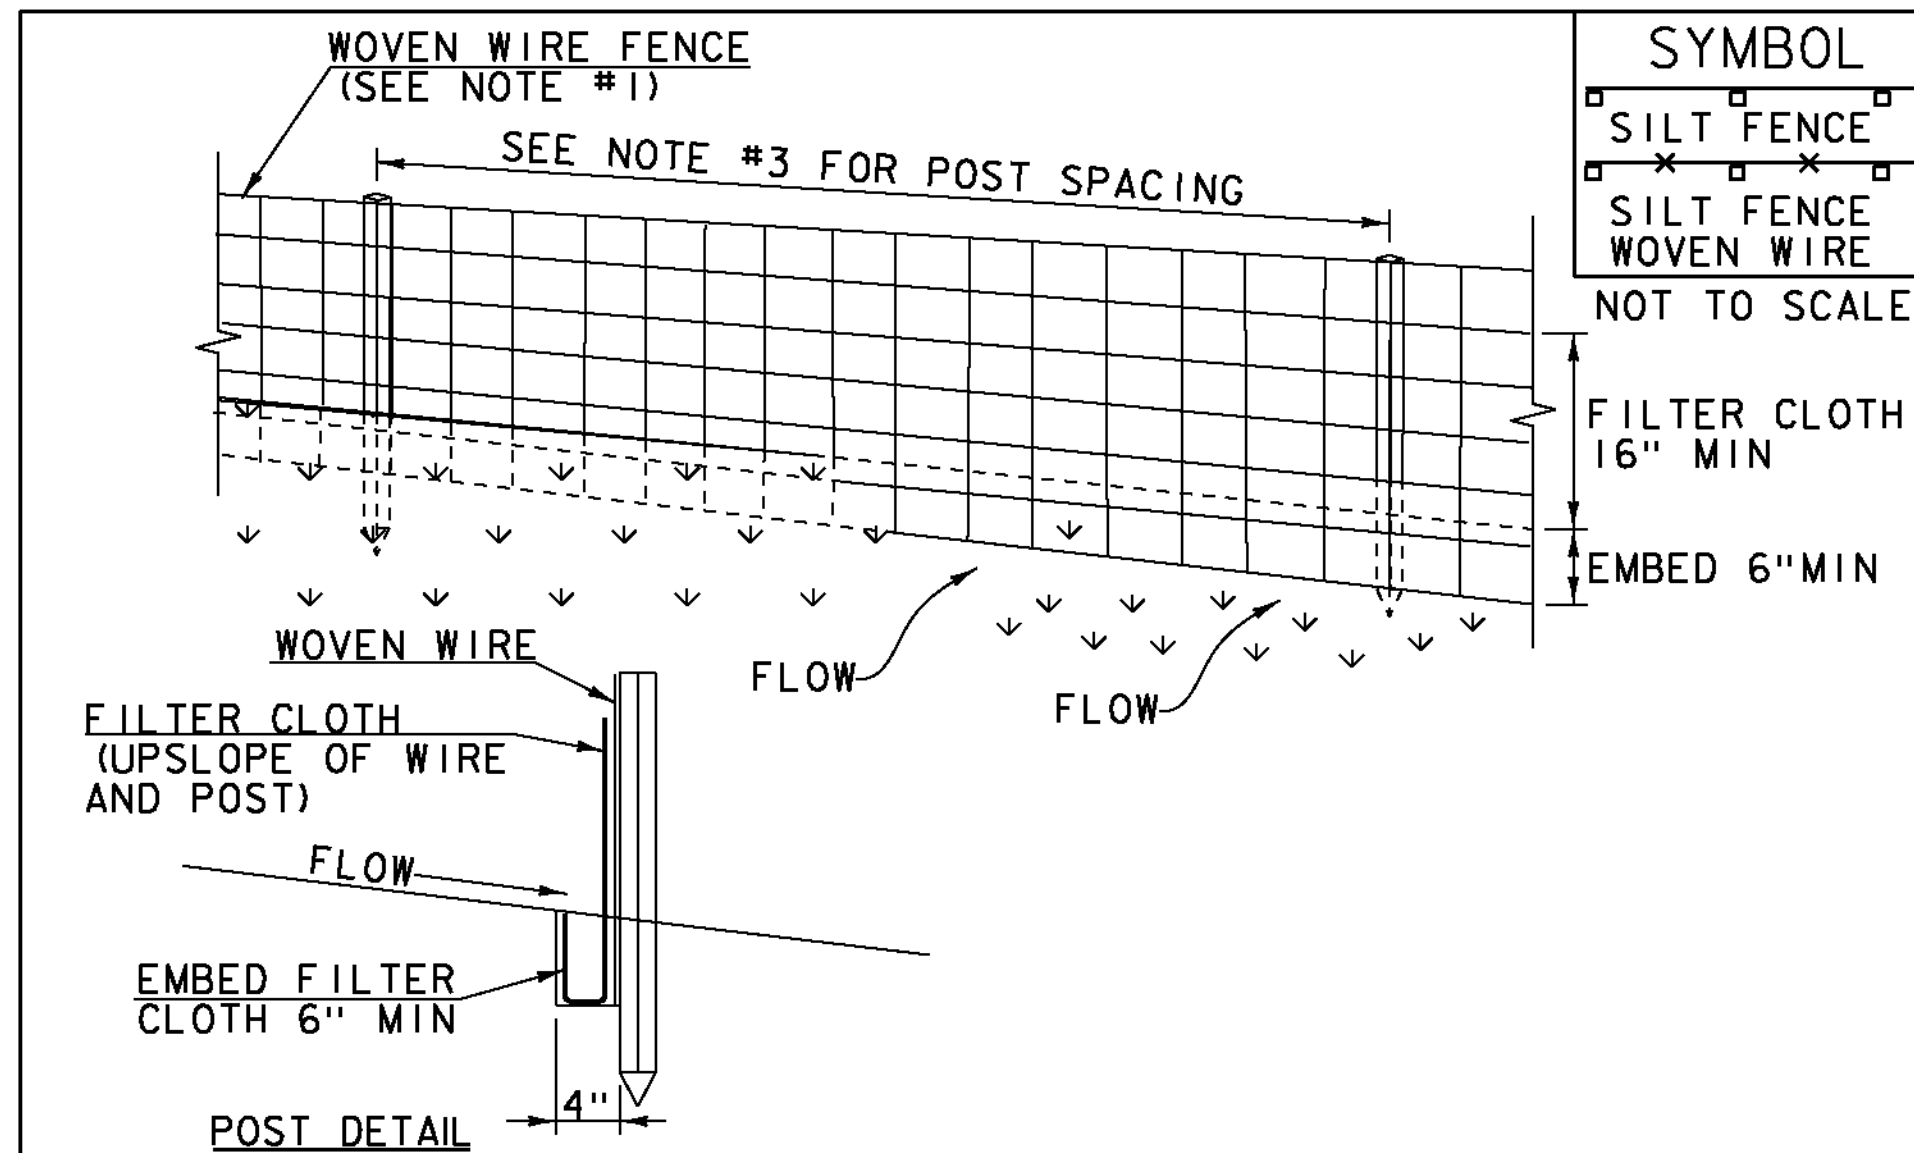

CONSTRUCTION SPECIFICATIONS

1. WOVEN WIRE REINFORCED FENCE IS REQUIRED WITHIN 100' UPSLOPE OF RECEIVING WATERS WHEN THE PROJECT FALLS UNDER A CONSTRUCTION STORMWATER PERMIT. WOVEN WIRE SHALL BE A MIN. 14 GAUGE WITH A 6" MAX. MESH OPENING.
2. FILTER CLOTH SHALL BE EITHER FILTER X, MIRAF1100X, STABILINKA T140N OR APPROVED EQUIVALENT.
3. POST SPACING FOR WIRE-BACKED FENCE SHALL BE 10' MAXIMUM. FOR FILTER-CLOTH FENCE, WHEN ELONGATION IS >50%, POST SPACING SHALL NOT EXCEED 4' AND WHEN ELONGATION IS <50%, POST SPACING SHALL NOT EXCEED 6'.
4. WOVEN WIRE FENCE IS TO BE FASTENED SECURELY TO FENCE POSTS WITH WIRE TIES. FILTER CLOTH IS TO BE FASTENED SECURELY TO WOVEN WIRE FENCE WITH TIES SPACED EVERY 24" AT TOP AND MID SECTION.
5. WHEN TWO SECTIONS OF FILTER CLOTH ADJOIN EACH OTHER THEY SHALL BE OVER-LAPPED BY 6" AND FOLDED.
6. MAINTENANCE SHALL BE PERFORMED AS NEEDED AND MATERIAL REMOVED WHEN SEDIMENT REACHES HALF OF FABRIC HEIGHT.


ADAPTED FROM DETAILS PROVIDED BY: NEW YORK STATE DEC
ORIGINALLY DEVELOPED BY USDA-NRCS
VERMONT DEPARTMENT OF ENVIRONMENTAL CONSERVATION

SILT FENCE

NOTES:
REFER TO "THE VERMONT STANDARDS & SPECIFICATIONS FOR
EROSION PREVENTION & SEDIMENT CONTROL -2006- "FROM
THE VT AGENCY OF NATURAL RESOURCES FOR ADDITIONAL
GUIDANCE.

THIS WORK SHALL BE PERFORMED IN ACCORDANCE WITH
SECTION 649 AND AS SHOWN IN THE PLANS FOR GEOTEXTILE
FOR SILT FENCE (PAY ITEM 649.51) OR GEOTEXTILE FOR
SILT FENCE, WOVEN WIRE REINFORCED (PAY ITEM 649.515).

REVISIONS	
MARCH 21, 2008	WHF
DECEMBER 11, 2008	WHF
JANUARY 13, 2009	WHF

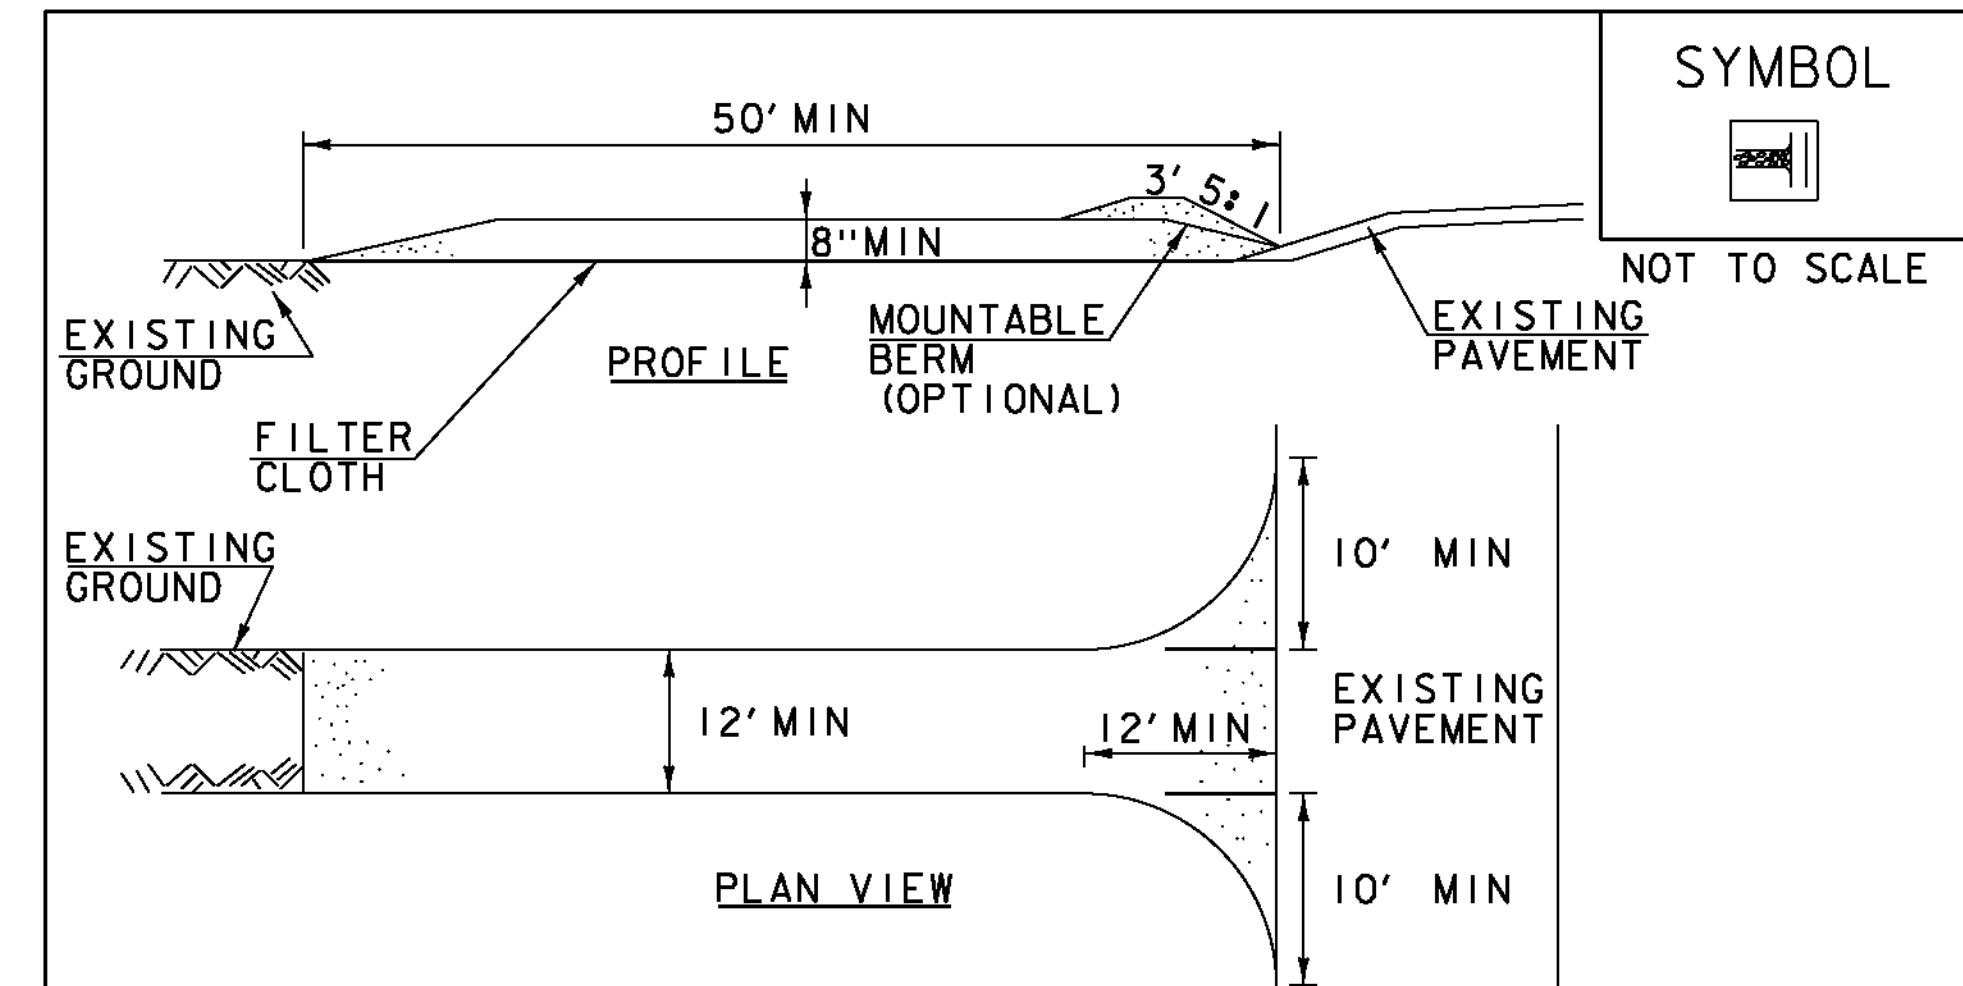

CONSTRUCTION SPECIFICATIONS

1. STONE SIZE- USE 1-4" STONE, RECLAIMED OR RECYCLED CONCRETE EQUIVALENT.
2. LENGTH- NOT LESS THAN 50' (EXCEPT ON A SINGLE RESIDENCE LOT WHERE A 30' MINIMUM LENGTH APPLIES).
3. THICKNESS- NOT LESS THAN 8".
4. WIDTH- 12' MINIMUM, BUT NOT LESS THAN THE FULL WIDTH AT POINTS WHERE INGRESS OR EGRESS OCCURS. 24' IF SINGLE ENTRANCE TO SITE.
5. GEOTEXTILE MUST BE PLACED OVER THE ENTIRE AREA PRIOR TO PLACING STONE.
6. SURFACE WATER- ALL SURFACE WATER FLOWING OR DIVERTED TOWARD CONSTRUCTION ENTRANCES SHALL BE PIPED BENEATH THE ENTRANCE. IF PIPING IS IMPRACTICAL, A MOUNTABLE BERM WITH 5:1 SLOPES WILL BE PERMITTED.
7. MAINTENANCE- THE ENTRANCE SHALL BE MAINTAINED IN A CONDITION WHICH WILL PREVENT TRACKING OR FLOWING OF SEDIMENT ONTO PUBLIC RIGHTS-OF-WAY, ALL SEDIMENT SPILLED, DROPPED, WASHED OR TRACKED ONTO PUBLIC RIGHTS-OF-WAY MUST BE REMOVED IMMEDIATELY.
8. WHEN WASHING IS REQUIRED, IT SHALL BE DONE ON AN AREA STABILIZED WITH STONE AND WHICH DRAINS INTO AN APPROVED SEDIMENT TRAPPING DEVICE.
9. PERIODIC INSPECTION AND NEEDED MAINTENANCE SHALL BE PROVIDED ACCORDING TO PERMIT REQUIREMENTS.

ADAPTED FROM DETAILS PROVIDED BY: NEW YORK STATE DEC
ORIGINALLY DEVELOPED BY USDA-NRCS
VERMONT DEPARTMENT OF ENVIRONMENTAL CONSERVATION

**STABILIZED
CONSTRUCTION
ENTRANCE**

NOTES:
REFER TO "THE VERMONT STANDARDS & SPECIFICATIONS FOR
EROSION PREVENTION & SEDIMENT CONTROL -2006- "FROM
THE VT AGENCY OF NATURAL RESOURCES FOR ADDITIONAL
GUIDANCE.


THIS WORK SHALL BE PERFORMED IN ACCORDANCE WITH
SECTION 653 FOR VEHICLE TRACKING PAD (PAY ITEM 653.35)
OR AS SPECIFIED IN THE CONTRACT.

REVISIONS	
MARCH 24, 2008	WHF
JANUARY 13, 2009	WHF

PROJECT NAME: ST. JOHNSBURY
PROJECT NUMBER: BRF 028-4(25)S

FILE NAME: s98b320epscDet.dgn
PROJECT LEADER: C. CARLSON
DESIGNED BY: H. SALLS
EPSC DETAILS 2

PLOT DATE: 28-AUG-2012
DRAWN BY: C. MOONEY
CHECKED BY: C. CARLSON
SHEET 57 OF 62

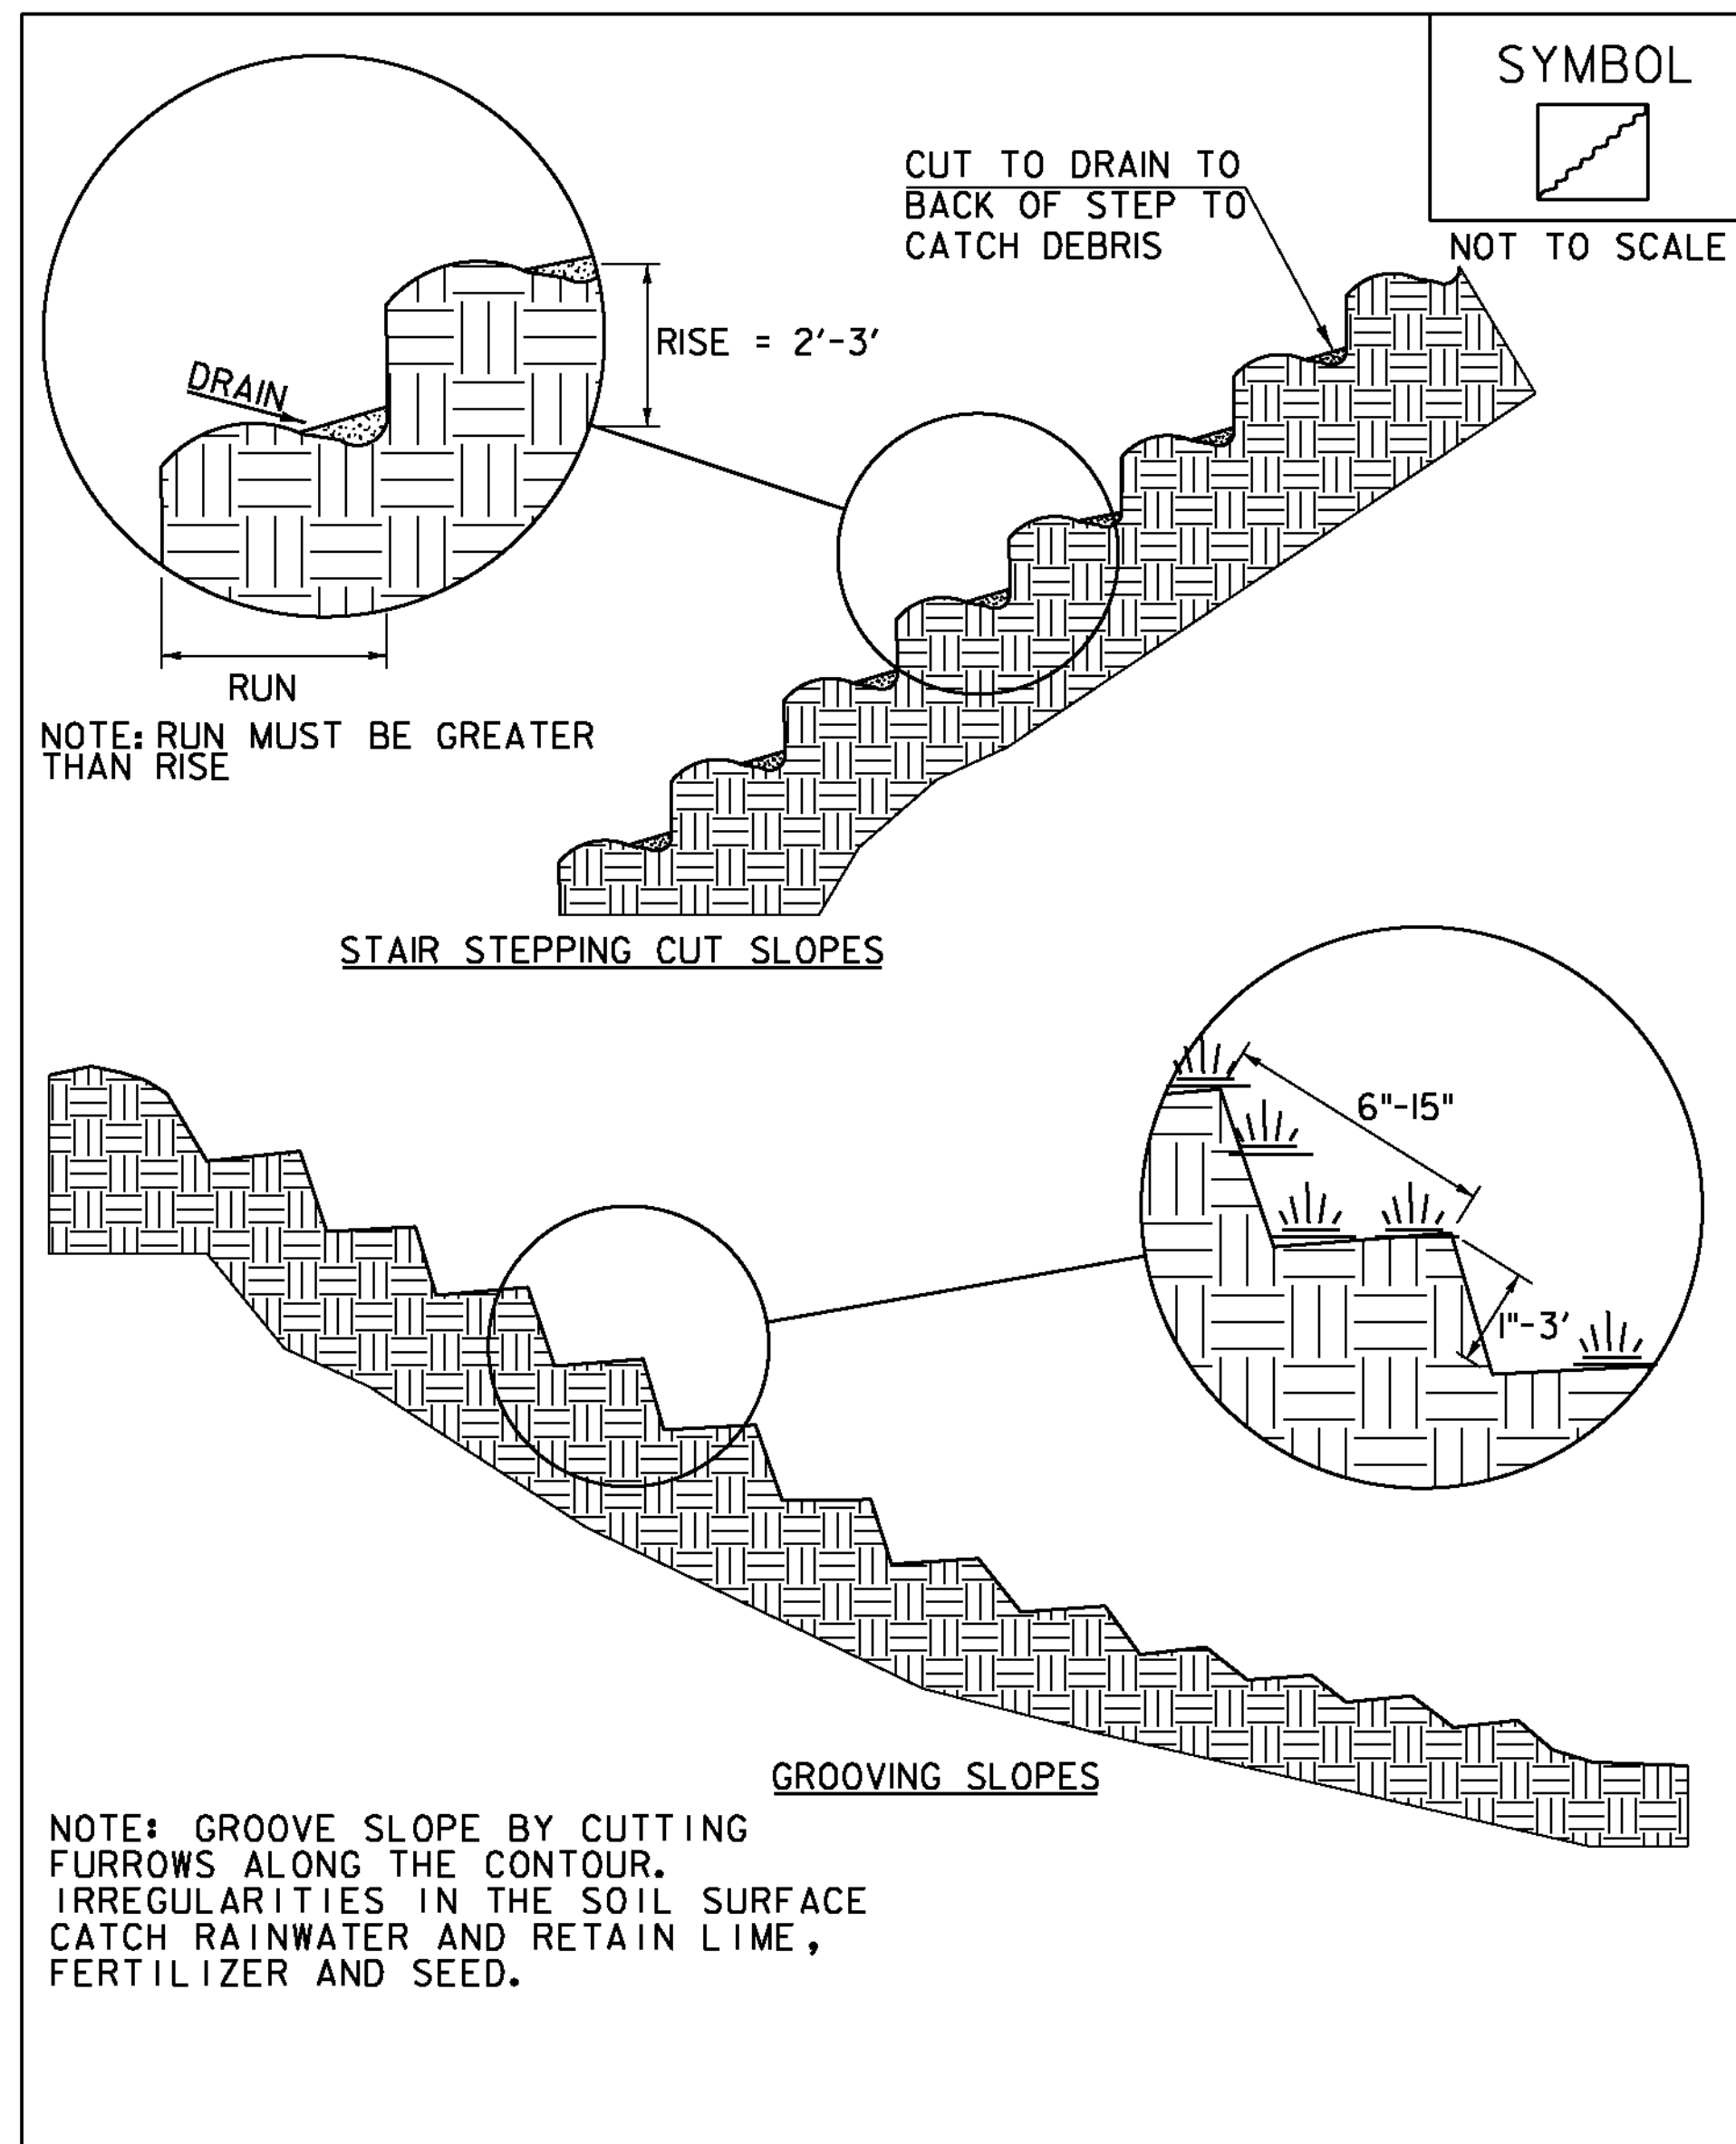

ADAPTED FROM DETAILS PROVIDED BY: NEW YORK STATE DEC
 ORIGINALLY DEVELOPED BY USDA-NRCS
 VERMONT DEPARTMENT OF ENVIRONMENTAL CONSERVATION

SURFACE ROUGHENING

NOTES:
 REFER TO "THE VERMONT STANDARDS & SPECIFICATIONS FOR
 EROSION PREVENTION & SEDIMENT CONTROL -2006- " FROM
 THE VT AGENCY OF NATURAL RESOURCES FOR ADDITIONAL
 GUIDANCE.
 THIS WORK SHALL BE CONSIDERED INCIDENTAL TO THE
 CONTRACT

REVISIONS	
APRIL 1, 2008	WHF
JANUARY 13, 2009	WHF

VAOT RURAL AREA MIX					
% WEIGHT	LBS/AC		NAME	GERM %	PURITY %
	BROADCAST	HYDROSEED			
37.5%	22.5	45	CREeping RED FESCUE	85%	98%
37.5%	22.5	45	TALL FESCUE	90%	95%
5.0%	3	6	RED TOP	90%	95%
15.0%	9	18	BIRDSFOOT TREFOIL	85%	98%
5.0%	3	6	ANNUAL RYE GRASS	85%	95%
100%	60	120			

VAOT URBAN AREA MIX					
% WEIGHT	LBS/AC		NAME	GERM %	PURITY %
	BROADCAST	HYDROSEED			
42.5%	34	68	CREeping RED FESCUE	85%	98%
10.0%	8	16	PERENNIAL RYE GRASS	90%	95%
42.5%	34	68	KENTUCKY BLUE GRASS	85%	85%
5.0%	4	8	ANNUAL RYE GRASS	85%	95%
100%	80	160			

SOIL AMENDMENT GUIDANCE			
FERTILIZER		LIME	
BROADCAST	HYDROSEED	BROADCAST	HYDROSEED
10-20-10	FOLLOW	PELLETIZED	FOLLOW
500 LBS/AC	MANUFACTURER	2 TONS/AC	MANUFACTURER

CONSTRUCTION GUIDANCE

1. RURAL SEED MIX: USE AS INDICATED IN THE PLANS AND/OR FOR ALL ESTABLISHED UPLAND (NON WETLAND) AREAS DISTURBED BY THE CONTRACTOR.
2. URBAN SEED MIX: USE AS INDICATED IN THE PLANS AND/OR FOR ALL ESTABLISHED LAWN AREAS DISTURBED BY THE CONTRACTOR.
3. ALL SEED MIXTURES: SHALL NOT HAVE A WEED CONTENT EXCEEDING 0.40% BY WEIGHT AND SHALL BE FREE OF ALL NOXIOUS SEED.
4. FERTILIZER AND LIMESTONE: SHALL FOLLOW RATES SHOWN ON PLAN OR AS DIRECTED BY THE ENGINEER
5. HAY MULCH: TO BE PLACED ON EARTH SLOPES AT THE RATE OF 2 TONS/ACRE, ACHIEVE 90% GROUND COVER OR AS DIRECTED BY THE ENGINEER.
6. TOPSOIL: TO BE USED WITH SEED AS INDICATED ON THE PLANS, OR AS DIRECTED BY THE ENGINEER.
7. HYDROSEEDING: ALTHOUGH GUIDANCE IS GIVEN ABOVE THE SITE CONDITIONS AND THE TYPE OF HYDROSEED WILL ULTIMATELY DICTATE THE AMOUNTS AND TYPES OF SOIL AMENDMENTS TO BE APPLIED
8. TURF ESTABLISHMENT: PLACING SEED, FERTILIZER, LIME AND MULCH PRIOR TO SEPTEMBER 15 AND AFTER APRIL 15 CAN BETTER ENSURE A VIGOROUS GROWTH OF GRASS.

ADAPTED FROM VTRANS TECHNICAL LANDSCAPE MANUAL FOR ROADWAYS AND TRANSPORTATION FACILITIES

TURF ESTABLISHMENT

REVISIONS	
JUNE 23, 2009	WHF
JANUARY 15, 2010	WHF
FEBRUARY 16, 2011	WHF

PROJECT NAME: ST. JOHNSBURY
 PROJECT NUMBER: BRF 028-4(25)S
 FILE NAME: s98b320epscDet.dgn PLOT DATE: 28-AUG-2012
 PROJECT LEADER: C. CARLSON DRAWN BY: C. MOONEY
 DESIGNED BY: H. SALLS CHECKED BY: C. CARLSON
 EPSC DETAILS 3 SHEET 58 OF 62

RIGHT - OF - WAY DETAIL SHEET

TABLE OF PROPERTY ACQUISITION

PARCEL NO.	PROPERTY OWNER	SHEET NO.	BEGINNING STATION	ENDING STATION	TAKE	REMAINDER	RIGHT			RECORDING DATA				REMARKS		
					AREA±	AREA±	TYPE	(T)/(P)	AREA ±	TITLE	DATE	TOWN / CITY	BOOK		PAGE	
1A	HUDSON, SPENCER K.	3, 4	375+90.38 LT	380+14.78 CL	0.31 A		ALL R. T. & I.								US RT 2 HIGHWAY EASE.; 13,406 SF±	
1B		3, 4	377+01.41 LT 378+19.83 LT 378+26.49 LT	379+70.64 LT 379+50.53 LT 378+68.00 LT			CONST.	(T)	2,534 SF						INCL. PDF & EC	
							SLOPE	(T)	208 SF							
							DITCH & DRAIN	(P)	94 SF							
2A	GINGUE, PAUL E. & ROSEMARY H.	4	378+69.10 RT 379+04.03 RT 379+11.13 RT 379+18.70 RT 379+43.78 RT 379+69.69 RT 379+84.12 RT	381+96.18 RT 379+65.41 RT 379+65.41 RT 379+25.47 RT 379+91.86 RT 379+91.86 RT 380+05.96 RT			DETOUR	(T)	0.11A						4,917 SF± INCL. PDF & EC	
							CONST.	(T)	512 SF							
							SLOPE	(T)	534 SF							
							INST. & MAINT.	(P)							GUARDRAIL	
							SLOPE	(T)	1,060 SF						FROM US RT 2 & DETOUR	
							ACCESS	(T)							INCL. PDF & EC	
							CONST.	(T)	278 SF							
2B		4	378+69.10 RT	380+18.54 RT	0.10 A		ALL R. T. & I.								US RT 2 HIGHWAY EASE.; 4,529 SF±	
3A	DARRAH, RALPH A. & NANCY J.	3, 4	376+70.21 RT 378+00.18 RT	378+66.63 RT 378+69.04 RT			CONST.	(T)	1,611 SF						INCL. PDF & EC	
							SLOPE	(T)	57 SF							
3B		3, 4	375+90.38 CL	378+69.16 CL	0.15 A		ALL R. T & I.								US RT 2 HIGHWAY EASEMENT; 6,542 SF±	
4	TOWN OF ST. JOHNSBURY	3, 4	379+02.86 CL	TH 59 30+00.00 CL			APPROACH	(T)							TH 59 4th CLASS ROAD, INCL. DETOUR	
5	SCHLUETER, SALLY E.	4, 5	380+10.71 LT	385+59.71 CL	0.47 A		ALL R. T. & I.			0.47 A	WDIF	07/02/12	ST. JOHNSBURY	361	393-394	US RT 2 HWY. EASE.; 20,490 SF±
6	CENTRAL VERMONT PUBLIC SERVICE CORPORATION	3, 4, 5	375+90.38 LT	386+30.65 RT											UTILITY EASEMENTS	
7	CHARTER ONE COMMUNICATIONS	3, 4, 5	375+90.38 LT	386+30.65 RT											UTILITY EASEMENTS	
8	TELEPHONE OPERATING COMPANY	3, 4, 5	375+90.38 LT	386+30.65 RT											UTILITY EASEMENTS	
9A	HUDSON, SPENCER K.	4	380+29.28 RT 380+52.13 RT 380+64.54 RT	381+96.18 RT 383+30.30 RT 383+37.01 RT			DETOUR	(T)	3,648 SF						INCL. PDF, EC & BF	
							SLOPE	(T)	3,038 SF							
							CONST.	(T)	2,846 SF							
9B		4, 5	380+14.78 CL	386+30.65 RT	0.48 A		ALL R. T. & I.								US RT 2 HIGHWAY EASE.; 20,820 SF±	

TABLE OF REVISIONS

REVISION NO.	SHEET NO.	DESCRIPTION	DATE
1	2, 4, 5	PARCEL 1 HUDSON - ELIMINATE PARCELS C & D COMPLETED BY: MT C.O. 9766 APPROVED BY: HP	05/01/12
2	2	PARCELS 6, 7 & 8 UTILITIES - REMOVE ALL R. T. & I. COMPLETED BY: MT C.O. 9767 APPROVED BY: HP	05/01/12
3	2, 4, 5	PARCEL 9 HUDSON - ADD NEW PARCELS 9A & 9B THAT WERE PREVIOUSLY 1C & 1D. COMPLETED BY: MT C.O. 9768 APPROVED BY: HP	05/01/12



PLAN LEGEND

	EXISTING RIGHT-OF-WAY		TOE OF SLOPE	EC	-EROSION CONTROL
	TAKING WITH ACCESS		TOP OF CUT	(P)	-PERMANENT
	TAKING WITHOUT ACCESS		SLOPE RIGHT	(T)	-TEMPORARY
	CLEAR ZONE		CONSTRUCTION RIGHT	DR.	-DRAINAGE RIGHT
	PROPERTY LINE		PROJECT DEMARCATION FENCE	DIT.	-DITCHING RIGHT
				CH.	-CHANNEL RIGHT
				DRIVE	-DRIVE RIGHT
				CUL.	-CULVERT RIGHT
				C&T	-CLEARING & TRIMMING RIGHT
				SR	-SLOPE RIGHT
				UE	-UTILITY EASEMENT

APPROVED: HARRY PETROVS DATE: 04-09-12
CHIEF, PLANS & TITLES

PROJECT NAME:	ST. JOHNSBURY	PLOT DATE:	28-AUG-2012
PROJECT NUMBER:	BRF 028-4(25)S	DRAWN BY:	M. TROTTIER
FILE NAME:	r98b320_DetailSheet.xls	CHECKED BY:	B. FERLAZO
PROJECT LEADER:	C. CARLSON	SHEET	59 OF 62
DESIGNED BY:	T. LACKEY		
R.O.W. DETAIL SHEET #1			

**BEGIN ROW PROJECT
BRF 028-4(25)
STA. 375+90.38 26.05' LT.**

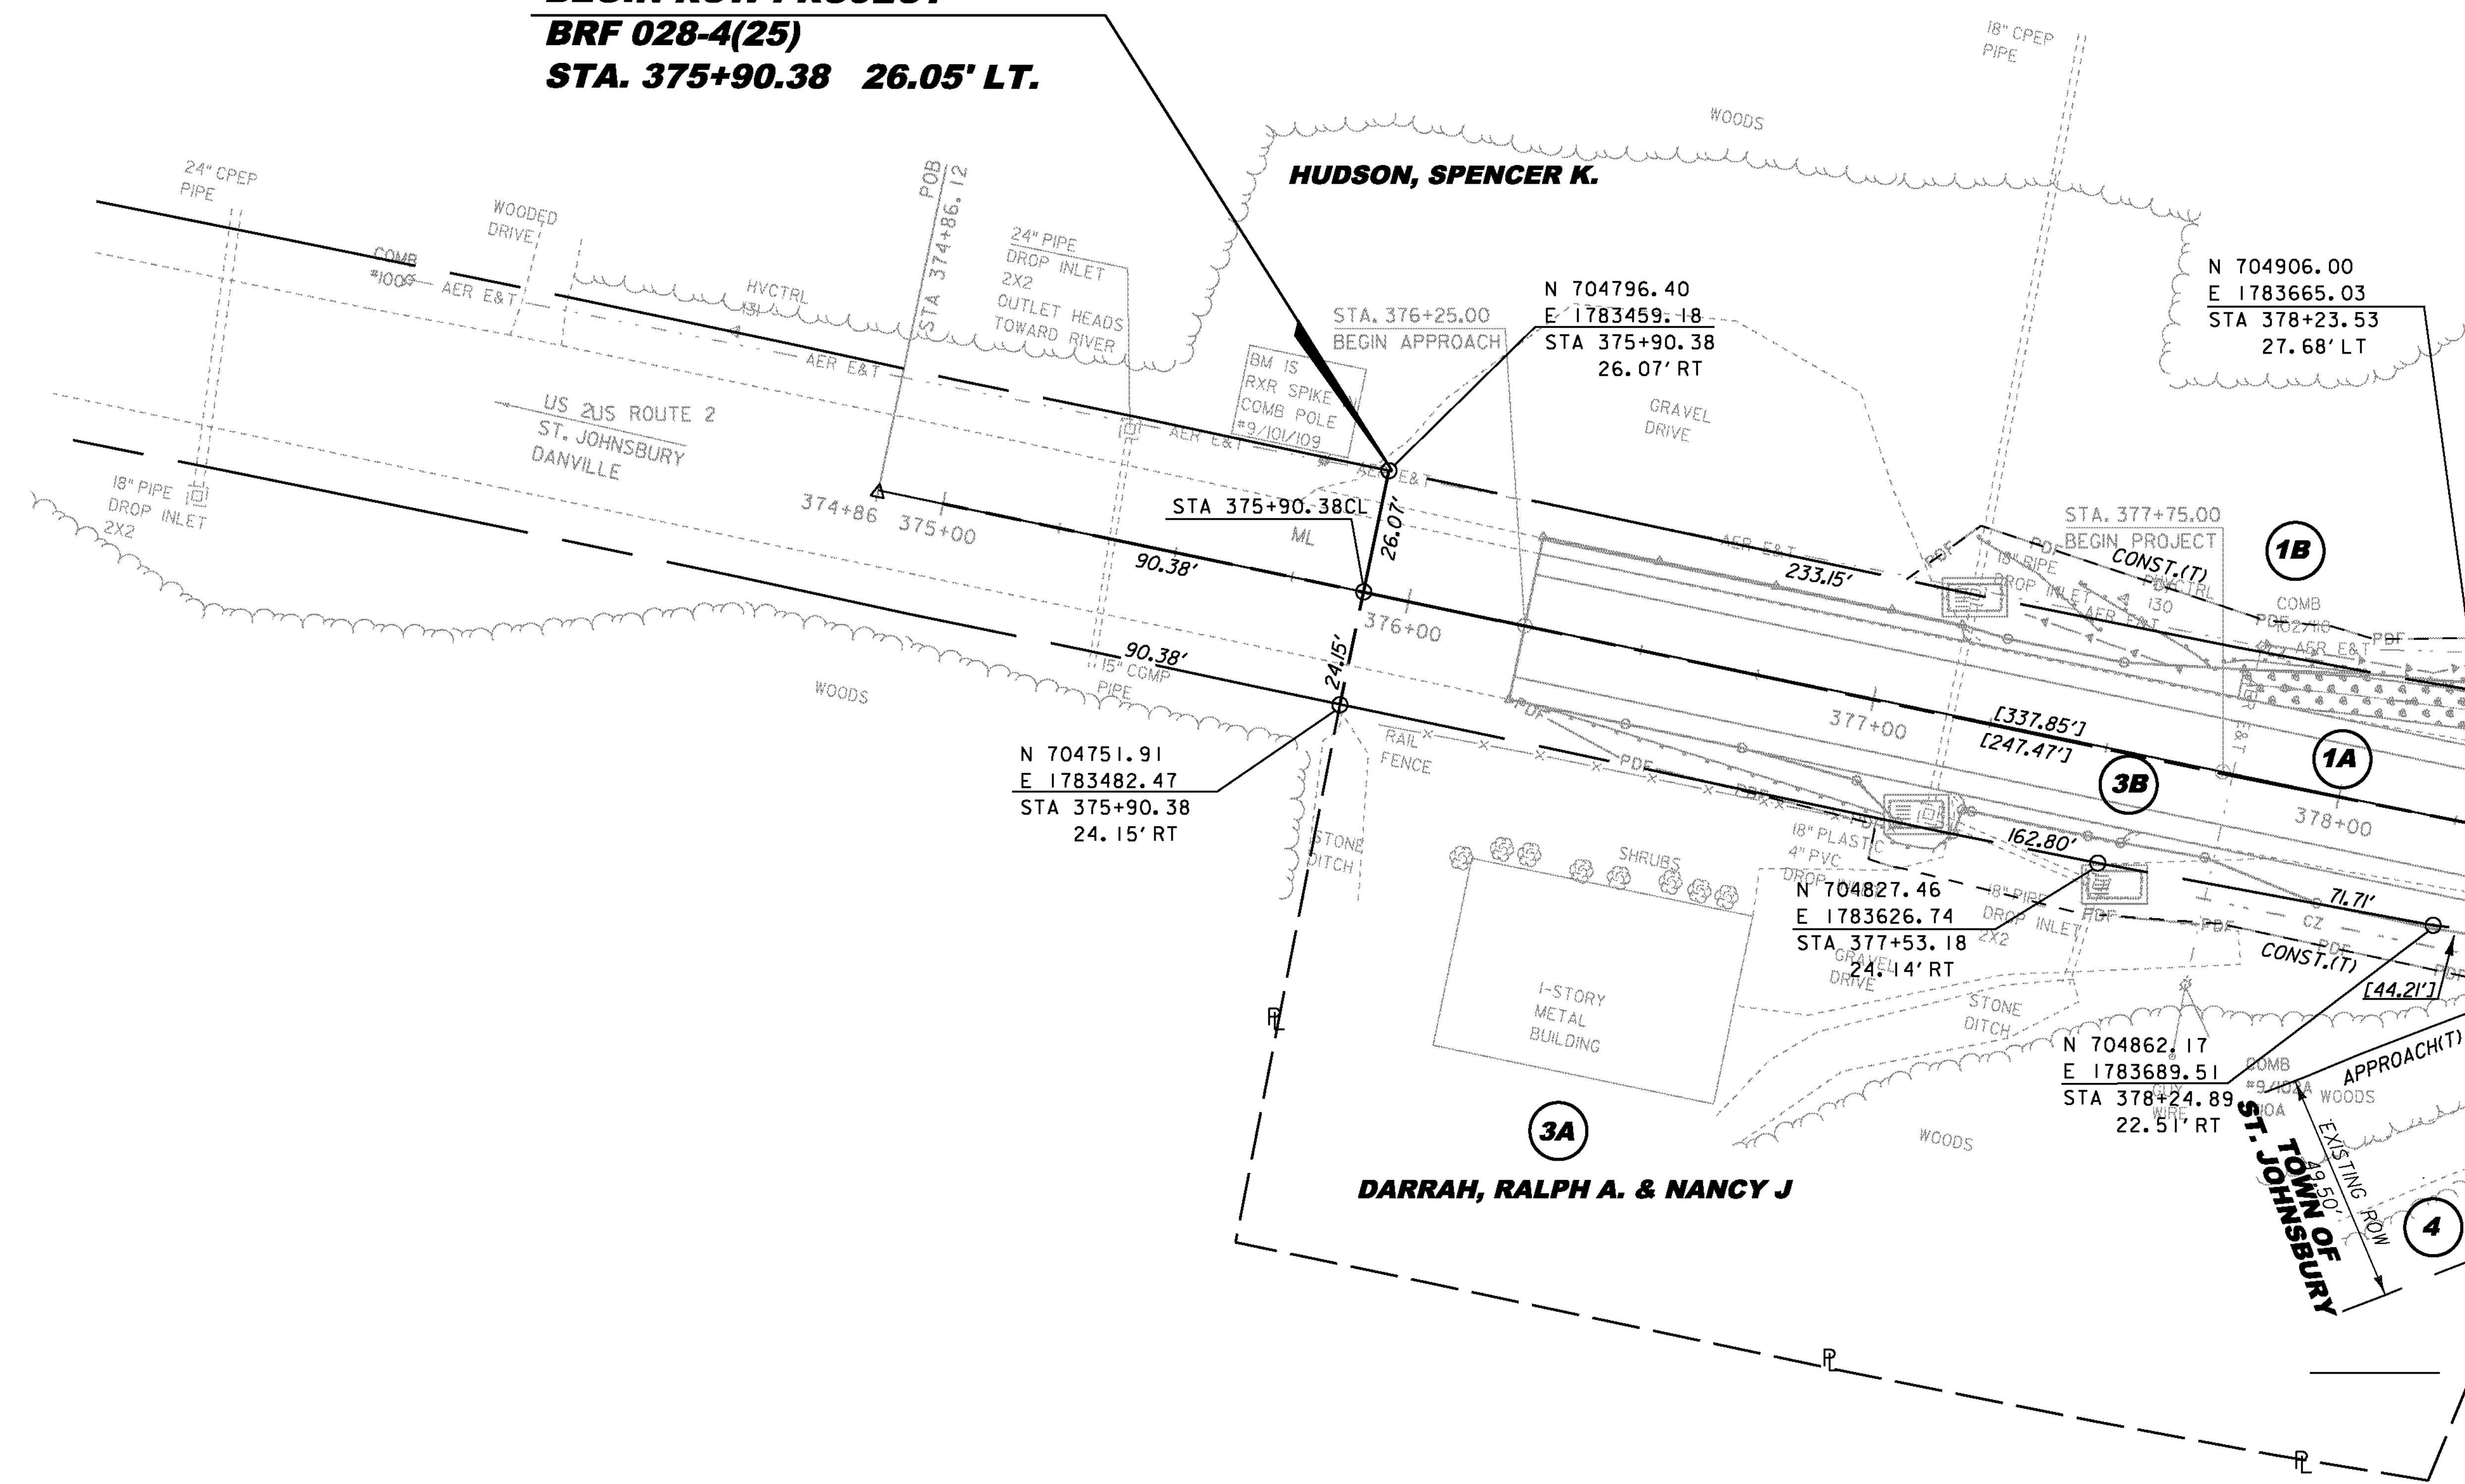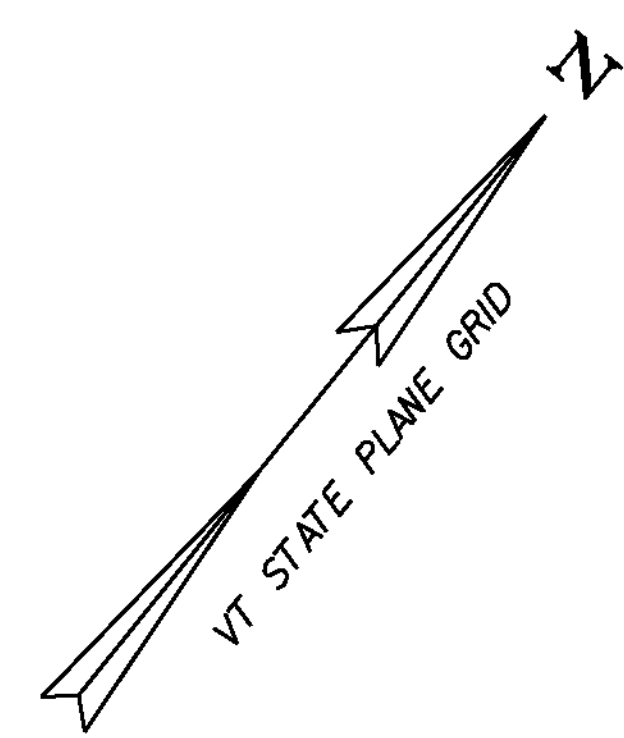


MATCH LINE - STA. 378+30.00

- CHANGING ELEVATION OF DROP INLET, CATCH BASIN OR MANHOLE
STA. 377+16.30 RT
- CONSTRUCT 3'-0" PAVED APRON
STA. 376+25 TO STA. 377+18 LT
STA. 377+20 TO STA. 377+60 RT
- CONSTRUCT STONE-LINED DITCH, TYPE I
STA. 377+75 TO STA. 378+30 LT

LINES SHOWN ON THIS PLAN AS EXISTING
PROPERTY LINES P/L ARE BELIEVED TO
BE ACCURATE BUT SHOULD NOT BE RELIED
UPON FOR PURPOSES UNRELATED TO THE
STATE OF VERMONT'S ACQUISITION OF LAND
AND RIGHTS FOR THIS PROJECT.


**FOR R.O.W.
USE ONLY**

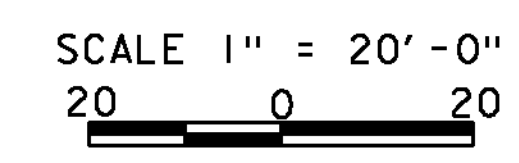

PROJECT NAME:	ST. JOHNSBURY	PLOT DATE:	28-AUG-2012
PROJECT NUMBER:	BRF 028-4(25)S	DRAWN BY:	B. FERLAZO
FILE NAME:	r98b320.lay1.dgn	CHECKED BY:	H. PETROVS
PROJECT LEADER:	C. CARLSON	ROW LAYOUT SHEET I	SHEET 60 OF 62
DESIGNED BY:	T. LACKEY		

US 2 - CURVE 1
 DELTA = 11°50'00" LT
 D = 9°32'57"
 R = 600.00'
 T = 62.18'
 L = 123.92'
 E = 3.21'
 BANKING = 0.060

US 2 - CURVE 2
 DELTA = 12°11'26" LT
 D = 4°59'54"
 R = 1146.30'
 T = 122.41'
 L = 243.90'
 E = 6.52'
 BANKING = MATCH EXISTING

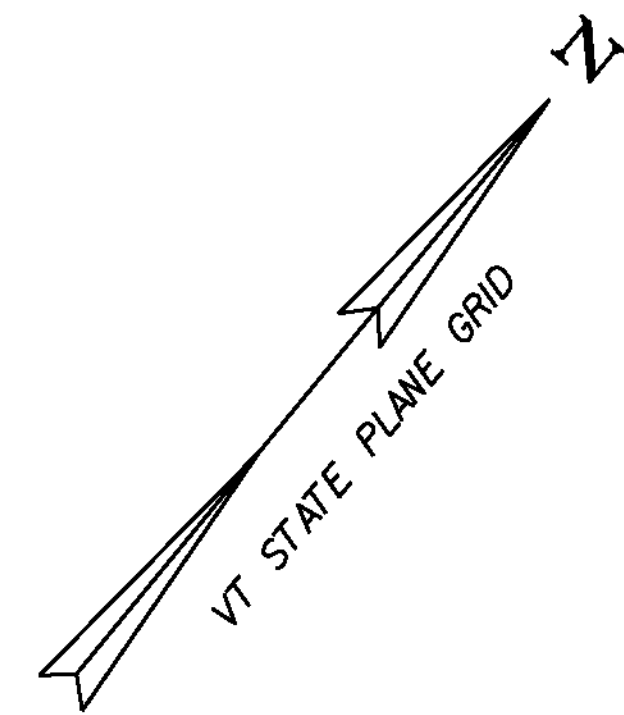

MATCH LINE - STA. 378+30.00

HUDSON, SPENCER K.

THIS PARCEL WDOE 5/23/1949
 FROM MERWIN, KATHERINE &
 FLORENCE SIMONS BK 95 PG 37


PLACE BARRIER FENCE ON ROW
 STA. 381+25LT TO STA. 383+25LT.
 PLACE SILT FENCE JUST INSIDE TO
 ALLOW FOR SLOPE CONSTRUCTION.

THIS PARCEL QCD 10/14/1934
 FROM BURKE BK 77/467

SCHLUETER, SALLY E.

THIS PARCEL WDOE 6/2/1949
 FROM WARK BK 95 PG 39

STA. 384+00.00
 END APPROACH

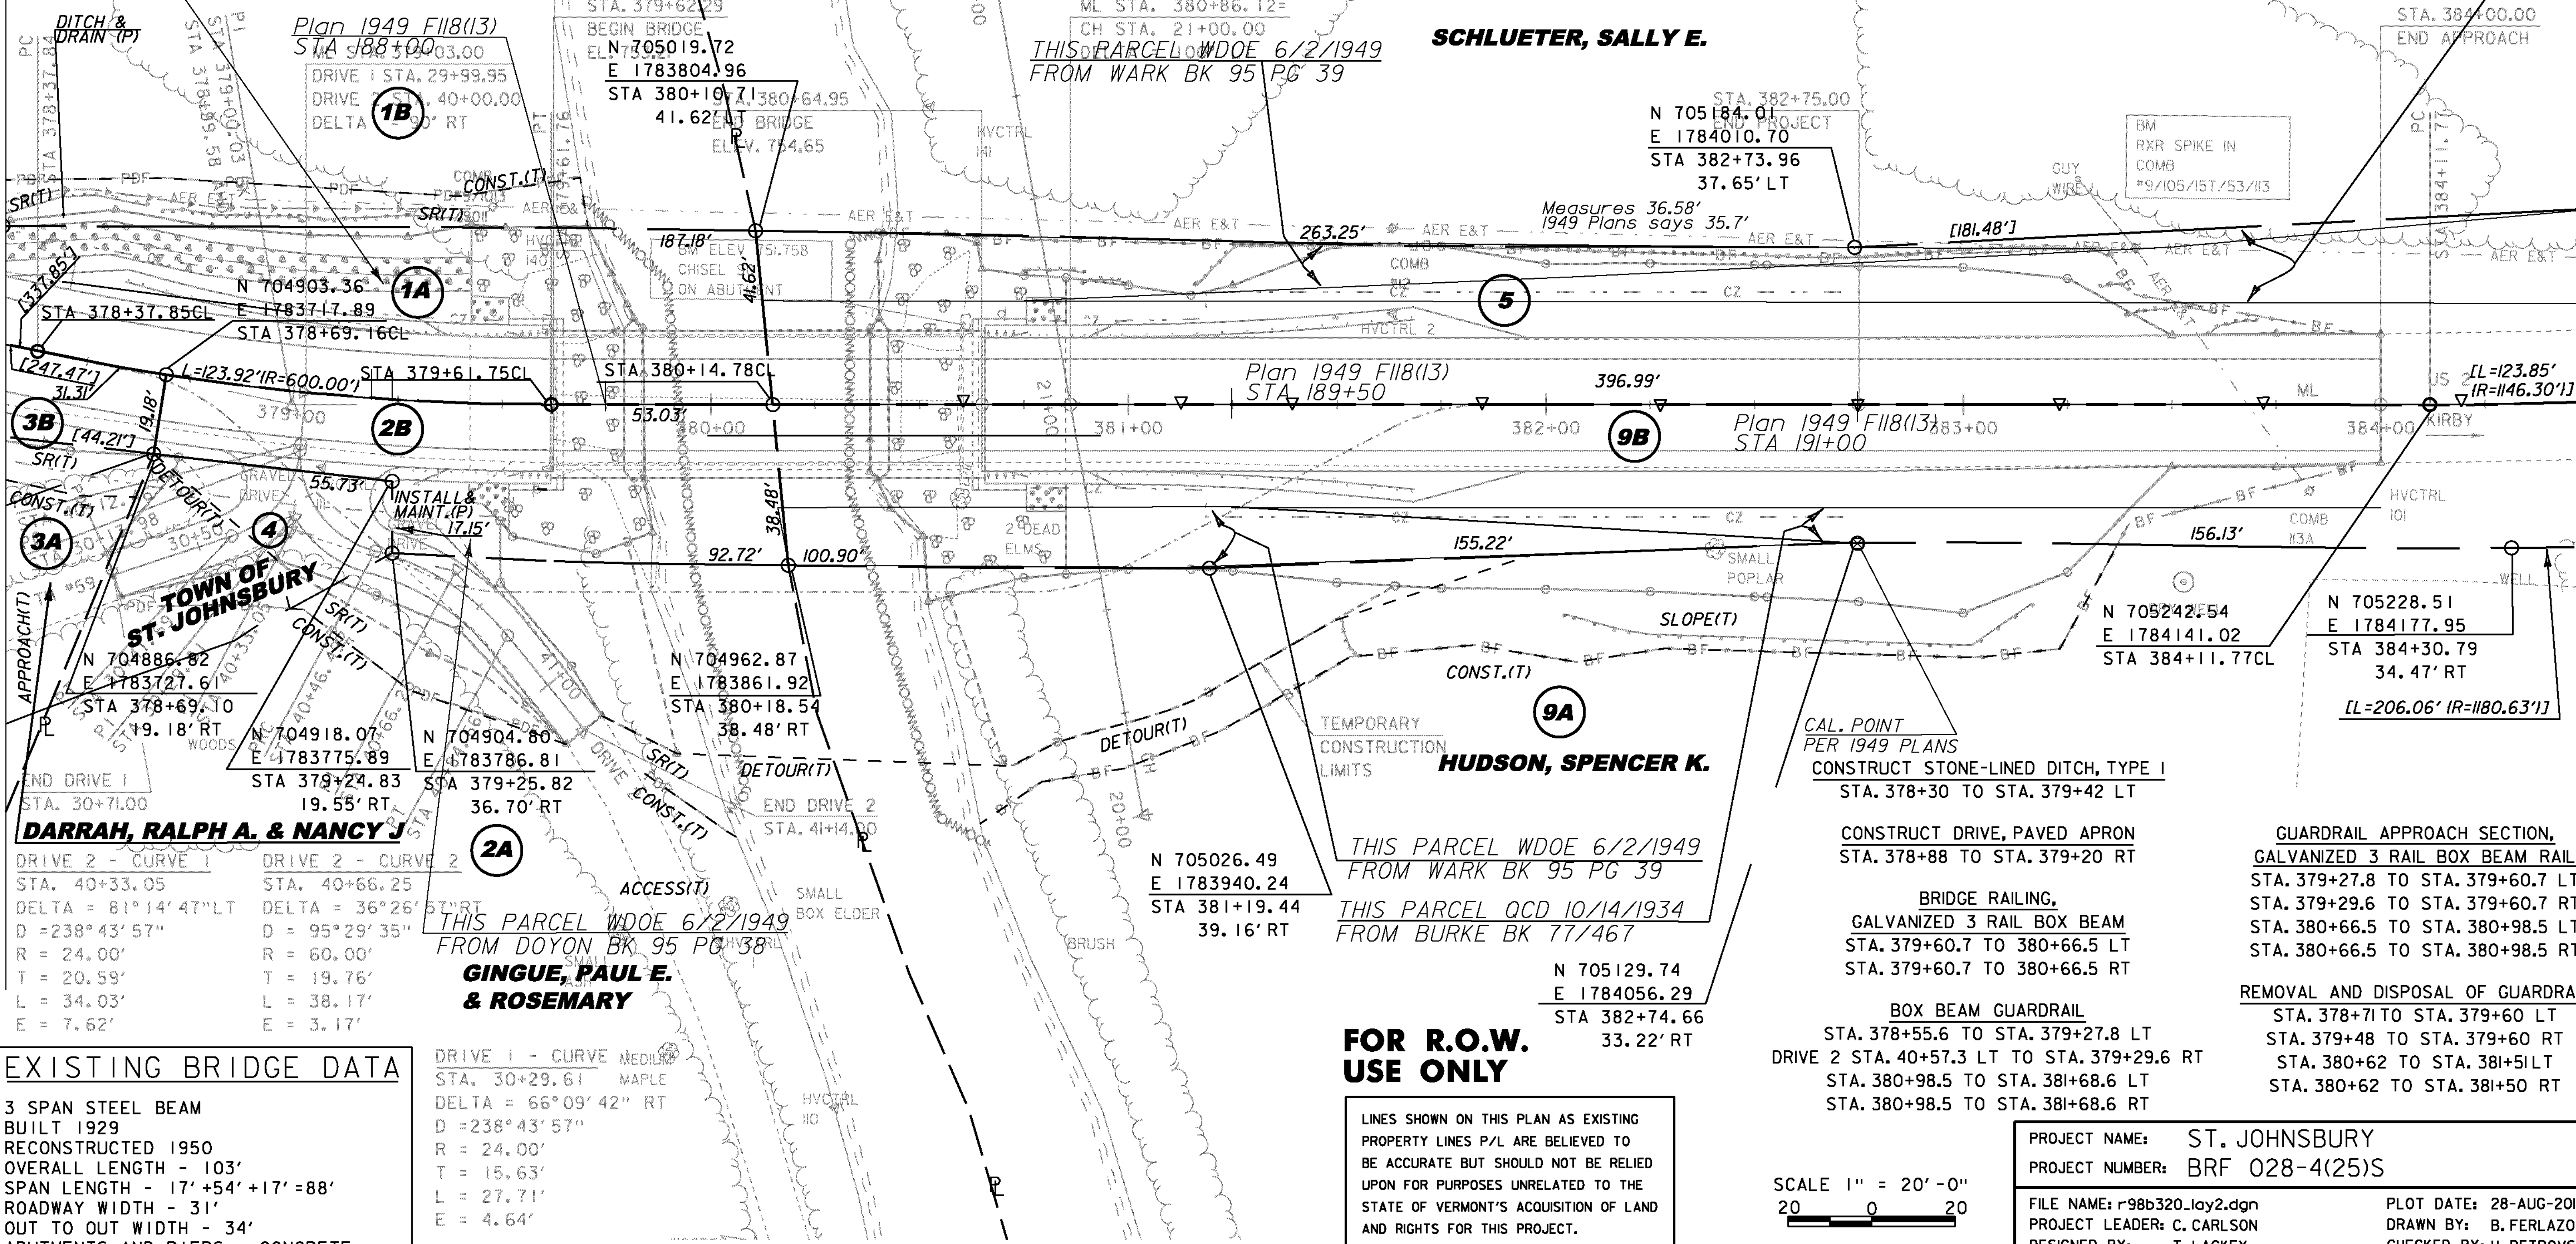

EXISTING BRIDGE DATA
 3 SPAN STEEL BEAM
 BUILT 1929
 RECONSTRUCTED 1950
 OVERALL LENGTH - 103'
 SPAN LENGTH - 17'+54'+17'=88'
 ROADWAY WIDTH - 31'
 OUT TO OUT WIDTH - 34'
 ABUTMENTS AND PIERS - CONCRETE

DRIVE 1 - CURVE 1
 STA. 30+29.61 MAPLE
 DELTA = 66°09'42" RT
 D = 238°43'57"
 R = 24.00'
 T = 15.63'
 L = 27.71'
 E = 4.64'

FOR R.O.W. USE ONLY
 LINES SHOWN ON THIS PLAN AS EXISTING PROPERTY LINES P/L ARE BELIEVED TO BE ACCURATE BUT SHOULD NOT BE RELIED UPON FOR PURPOSES UNRELATED TO THE STATE OF VERMONT'S ACQUISITION OF LAND AND RIGHTS FOR THIS PROJECT.

SCALE 1" = 20' - 0"
 20 0 20

CONSTRUCT DRIVE, PAVED APRON
 STA. 378+88 TO STA. 379+20 RT

BRIDGE RAILING,
 GALVANIZED 3 RAIL BOX BEAM
 STA. 379+60.7 TO 380+66.5 LT
 STA. 379+60.7 TO 380+66.5 RT

BOX BEAM GUARDRAIL
 STA. 378+55.6 TO STA. 379+27.8 LT
 DRIVE 2 STA. 40+57.3 LT TO STA. 379+29.6 RT
 STA. 380+98.5 TO STA. 381+68.6 LT
 STA. 380+98.5 TO STA. 381+68.6 RT


GUARDRAIL APPROACH SECTION,
 GALVANIZED 3 RAIL BOX BEAM RAIL
 STA. 379+27.8 TO STA. 379+60.7 LT
 STA. 379+29.6 TO STA. 379+60.7 RT
 STA. 380+66.5 TO STA. 380+98.5 LT
 STA. 380+66.5 TO STA. 380+98.5 RT

REMOVAL AND DISPOSAL OF GUARDRAIL
 STA. 378+71 TO STA. 379+60 LT
 STA. 379+48 TO STA. 379+60 RT
 STA. 380+62 TO STA. 381+51 LT
 STA. 380+62 TO STA. 381+50 RT

PROJECT NAME: ST. JOHNSBURY
 PROJECT NUMBER: BRF 028-4(25)S

FILE NAME: r98b320.lay2.dgn
 PROJECT LEADER: C. CARLSON
 DESIGNED BY: T. LACKEY
 ROW LAYOUT SHEET 2

PLOT DATE: 28-AUG-2012
 DRAWN BY: B. FERLAZO
 CHECKED BY: H. PETROVS
 SHEET 61 OF 62

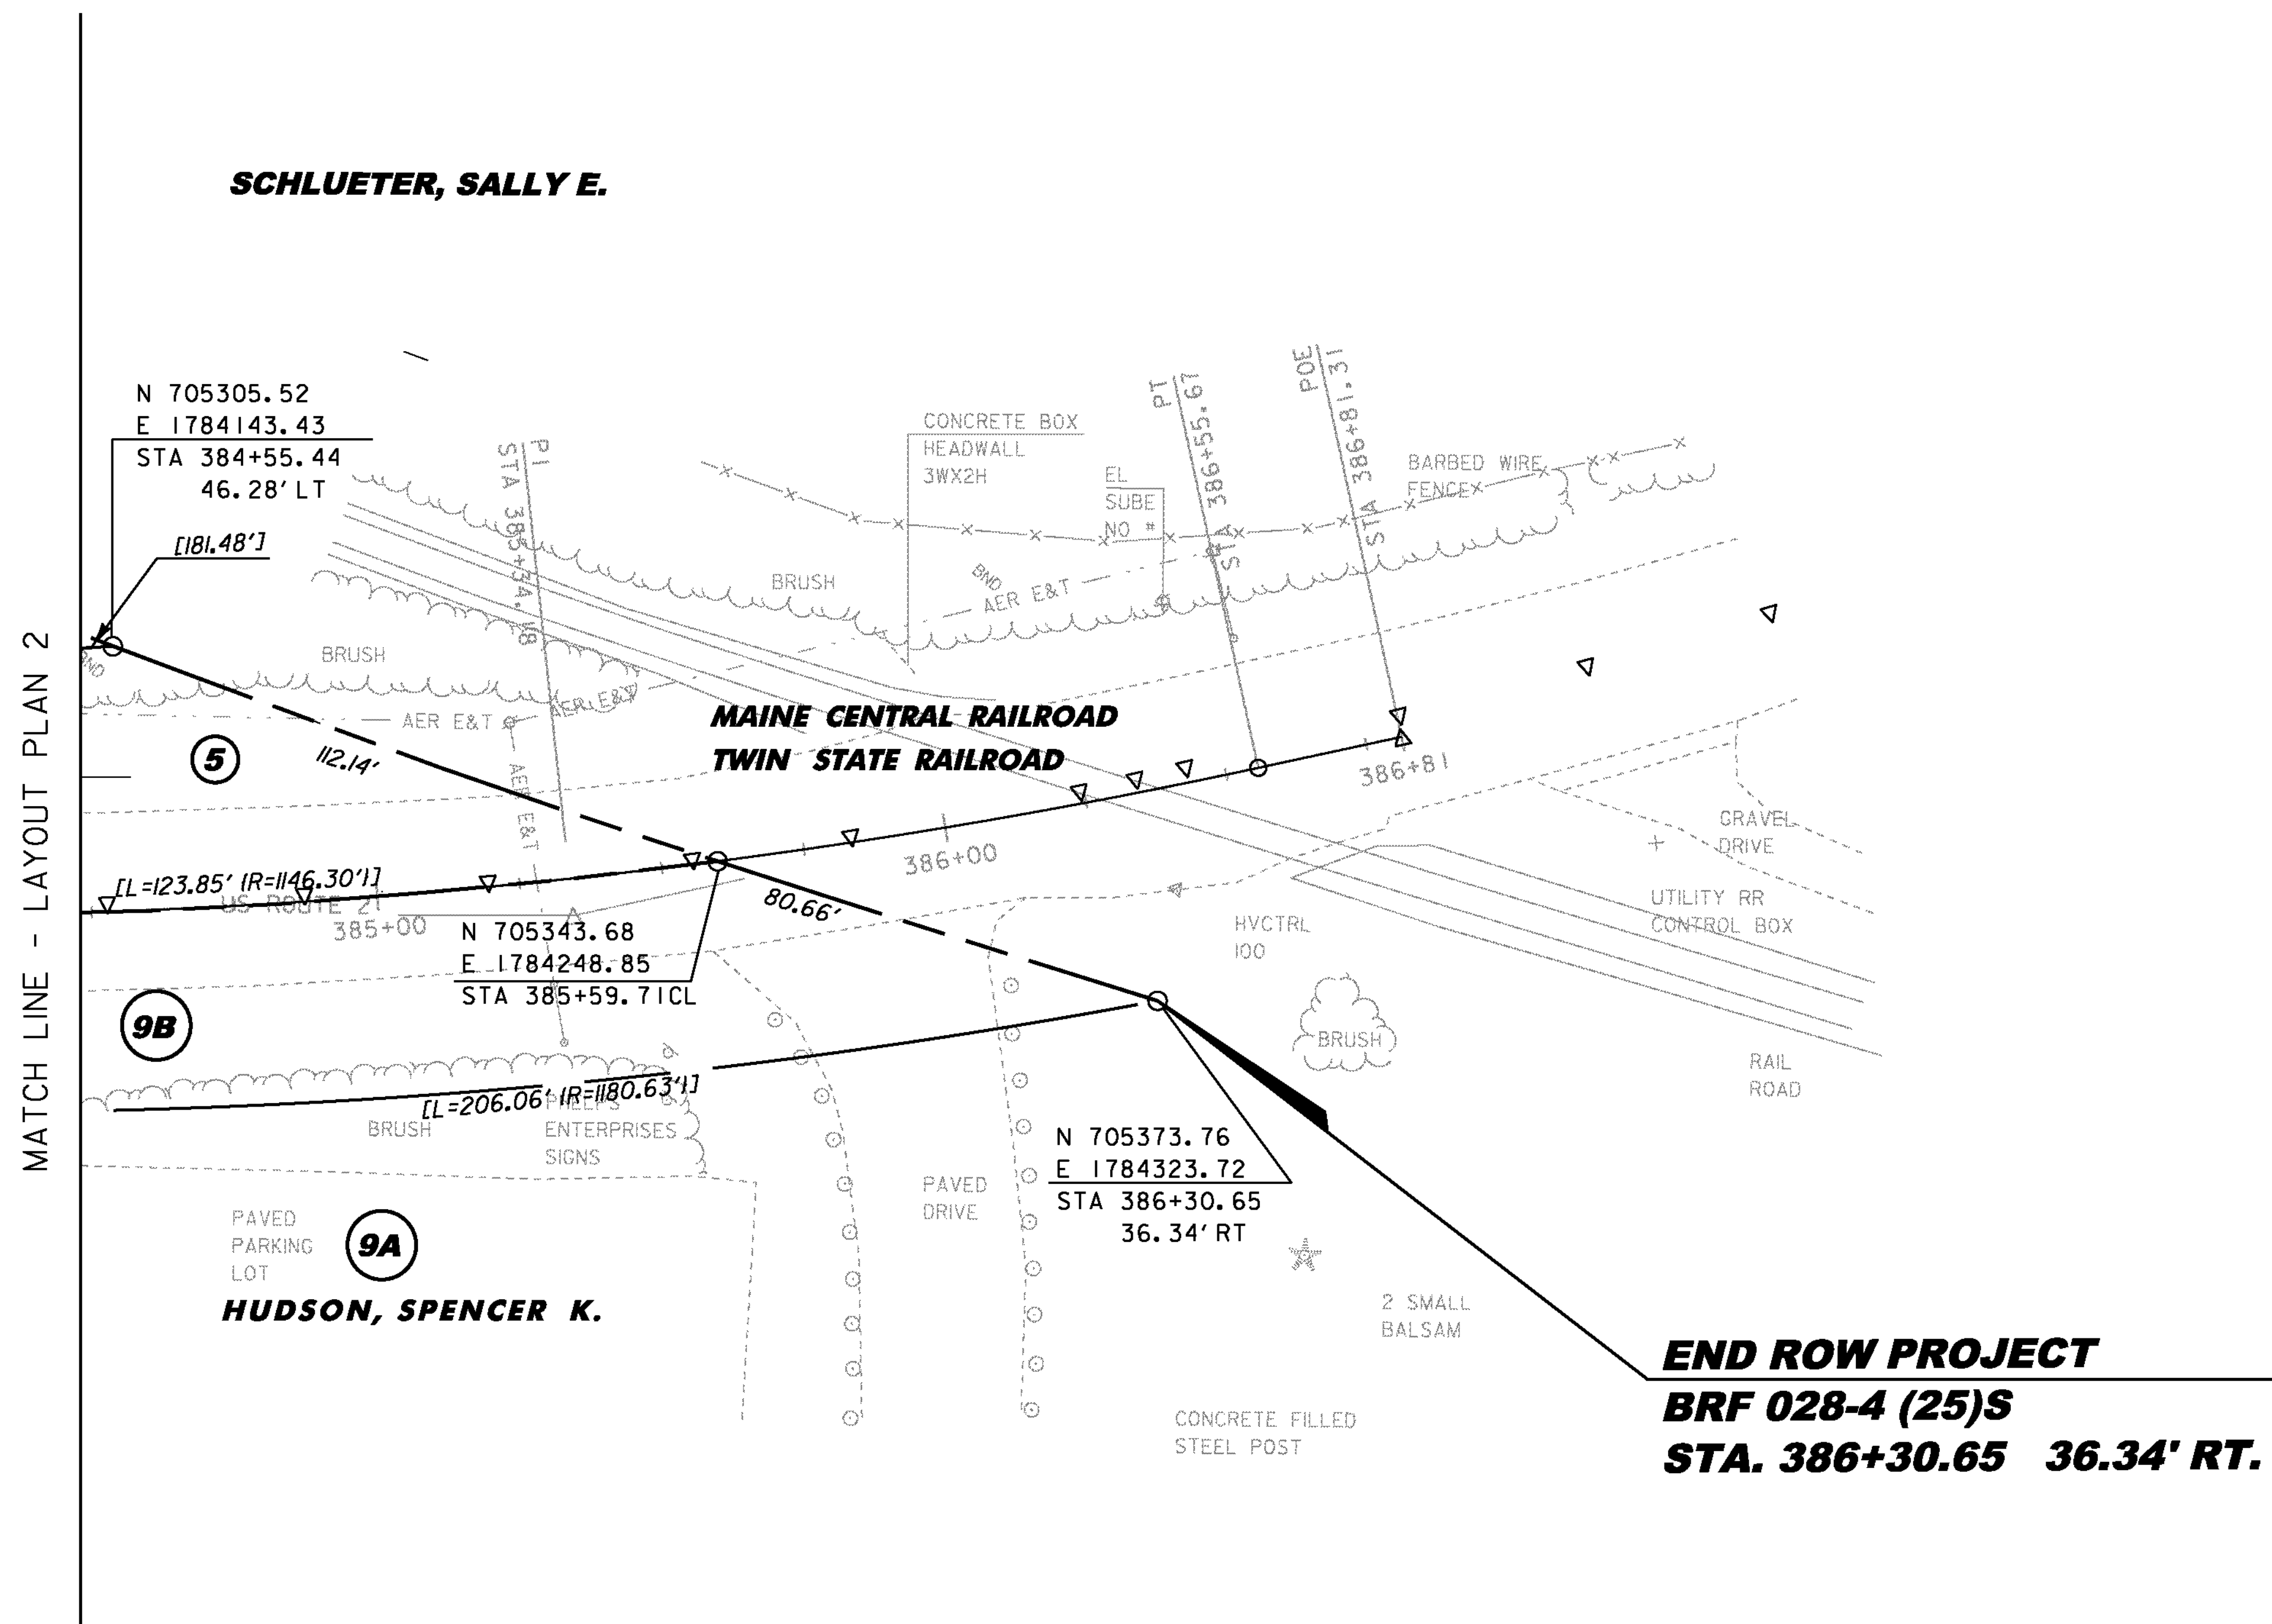

MATCH LINE - LAYOUT PLAN 2

SCHLUETER, SALLY E.

N 705305.52
E 1784143.43
STA 384+55.44
46.28' LT

[181.48']

5

BRUSH

AER E&T

385+00

9B

N 705343.68
E 1784248.85
STA 385+59.71CL

[L=206.06' | R=1180.63' |]

BRUSH

ENTERPRISES
SIGNS

PAVED
PARKING
LOT

9A

HUDSON, SPENCER K.

CONCRETE BOX
HEADWALL
3WX2H

EL
SUBE
NO #

PT

STA 386+55.61

POE

STA 386+81.31

BARBED WIRE
FENCE

**MAINE CENTRAL RAILROAD
TWIN STATE RAILROAD**

386+81

386+00

80.66'

HVCTRL
100

GRAVEL
DRIVE

UTILITY RR
CONTROL BOX

RAIL
ROAD

BRUSH

PAVED
DRIVE

N 705373.76
E 1784323.72
STA 386+30.65
36.34' RT

2 SMALL
BALSAM

CONCRETE FILLED
STEEL POST

**END ROW PROJECT
BRF 028-4 (25)S
STA. 386+30.65 36.34' RT.**

LINES SHOWN ON THIS PLAN AS EXISTING
PROPERTY LINES P/L ARE BELIEVED TO
BE ACCURATE BUT SHOULD NOT BE RELIED
UPON FOR PURPOSES UNRELATED TO THE
STATE OF VERMONT'S ACQUISITION OF LAND
AND RIGHTS FOR THIS PROJECT.

**FOR R.O.W.
USE ONLY**

SCALE 1" = 20'-0"
20 0 20

PROJECT NAME: ST. JOHNSBURY
PROJECT NUMBER: BRF 028-4(25)S

FILE NAME: r98b320.lay3.dgn
PROJECT LEADER: C. CARLSON
DESIGNED BY: T. LACKEY
ROW LAYOUT SHEET 3

PLOT DATE: 28-AUG-2012
DRAWN BY: B. FERLAZO
CHECKED BY: H. PETROVS
SHEET 62 OF 62


Highway Safety Corporation

Glastonbury, CT


Welding Procedure Specification

Material specification A572 gr 50, A709 Gr 50
 Welding process Gas Metal Arc Welding (GMAW) Spray Transfer
 Manual, semi-automatic, or automatic Semi-Automatic
 Position of welding Flat (1F) or Horizontal (2F)
 Filler metal specification AWS A5.18
 Filler metal classification ER70S-6
 Electrode and manufacturer Lincoln Electric Lincoln Weld L-56
 Flux and manufacturer N/A
 Shielding gas 86% Argon / 14% CO2 Flow rate 35-45 CFM
 Single or multiple pass Single or Multiple
 Single or multiple arc Single
 Welding current DCEP
 Polarity Reverse - electrode positive
 Welding progression Stringers
 Root treatment clean base metal
 Preheat and interpass temperature base metal up to 3/4" (50°F) ; over 3/4 thru 1-1/2" (150°F) ; over 1-1/2" thru 2-1/2" (225°F)
 Postheat treatment None
 Electrode extension 3/4" ± 1/4"

WELDING PROCEDURE

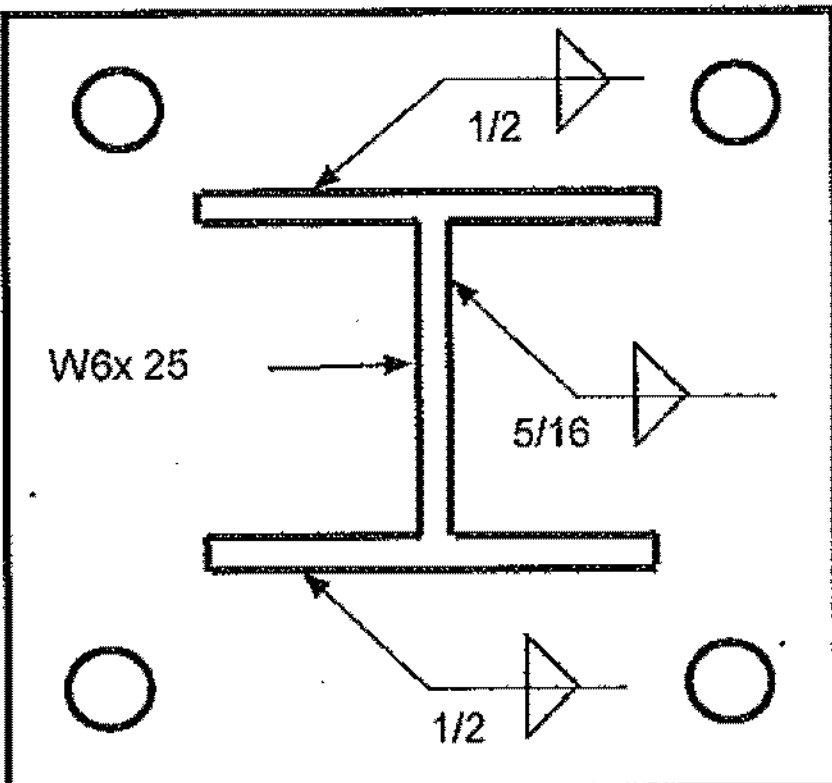Weld size	Pass no.	Electrode size	Welding parameters		Travel speed	Joint detail
			Amperes	Volts		
5/16"	1	0.062"	300 A ± 30	29 V ± 2	15 ipm ± 2	
1/2"	1 & 2	0.062"	↓	↓	15 ipm ± 2	
<p>Trans Received OK'd BY <u>JWC</u></p> <p style="font-size: 1.2em; font-weight: bold;">JUN 07 2013</p> <p>Resubmit APPROVED BY <u>[Signature]</u> DATE <u>6/11/13</u></p>						

This procedure may vary due to fabrication sequence, fit-up, pass size, etc. within the limitation of variables given in section 5 of latest edition AWS D1.5

WPS no. W-VTPEDPOST2 Fabricator Highway Safety Corporation
 Revision no. 0 Prepared By: Paul Radice  CWI 98070221
 Supporting PQR no. Pre-Qualified Date 06-04-13 QC1 EXP. 7/1/2013
 Project Name St. Johnsbury, VT Project Number BRF 028-4(25)S


Highway Safety Corporation

Glastonbury, CT

Welding Procedure Specification

Material specification ASTM A500 gr B
 Welding process Gas Metal Arc Welding (GMAW)
 Manual, semi-automatic, or automatic Semi-Automatic
 Position of welding Flat (1F) or Horizontal (2F)
 Filler metal specification AWS A5.18
 Filler metal classification ER70S-6
 Electrode and manufacturer Lincoln Electric Lincoln Weld L-56
 Flux and manufacturer N/A
 Shielding gas 86% Argon / 14% CO2 Flow rate 35-45 CFM
 Single or multiple pass Single
 Single or multiple arc Single
 Welding current DCEP
 Polarity Reverse - electrode positive
 Welding progression Stringers
 Root treatment clean base metal
 Preheat and interpass temperature base metal up to 3/4" (50°F)
 Postheat treatment None
 Electrode extension 3/4" ± 1/4"

WELDING PROCEDURE

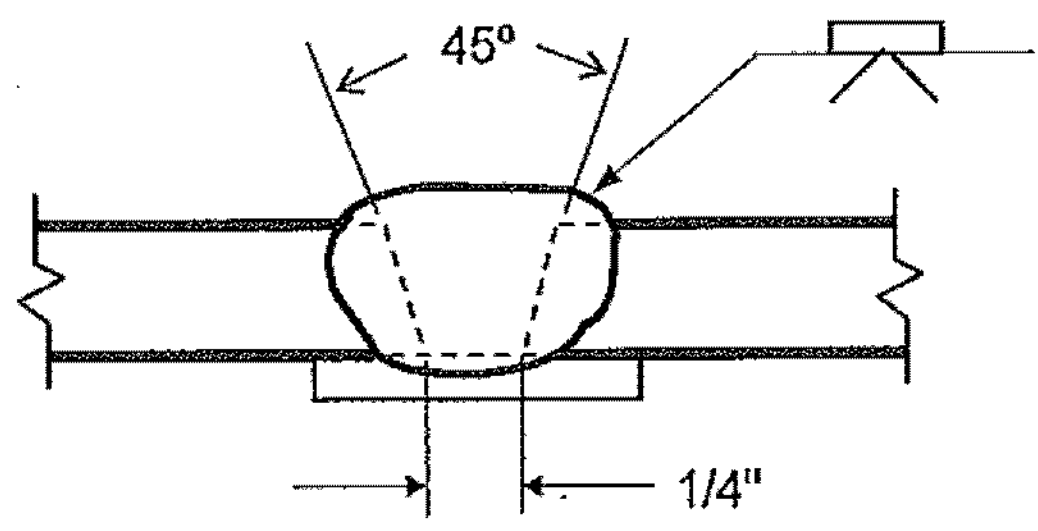Weld size	Pass no.	Electrode size	Welding parameters		Travel speed	Joint detail
			Amperes	Volts		
	1	0.063"	300 A ± 30	29 V ± 2	15 lpm ± 2	B-U2a-GF 
		CK'D	V Trans Received OK'd BY <u>JUC</u>			
			JUN 07 2013			
		Resubmit BY	APPROVED DATE <u>6/11/13</u>			

This procedure may vary due to fabrication sequence, fit-up, pass size, etc. within the limitation of variables given in section 5 of latest edition AWS D1.1

WPS no. W-VGWBCK Fabricator Highway Safety Corporation
 Revision no. 0 Prepared By: Paul Radice
 Supporting PQR no. Pre-Qualified Date 06-04-13
 Project Name St. Johnsbury, VT Project Number BRF 028-4(25)S

Paul A Radice
 CWI 98070221
 QC1 EXP. 7/1/2013


Highway Safety Corporation

Glastonbury, CT

Welding Procedure Specification


Material specification ASTM A36, A709 Gr 36, A500 gr B, A709 gr 50, A572 gr 50, A992
 Welding process Gas Metal Arc Welding (GMAW) Spray Transfer
 Manual, semi-automatic, or automatic Semi-Automatic
 Position of welding Flat (1F) or Horizontal (2F)
 Filler metal specification AWS A5.18
 Filler metal classification ER70S-6
 Electrode and manufacturer Lincoln Electric Lincoln Weld L-56
 Flux and manufacturer N/A
 Shielding gas 86% Argon / 14% CO2 Flow rate 35-45 CFM
 Single or multiple pass Single or Multiple
 Single or multiple arc Single
 Welding current DCEP
 Polarity Reverse - electrode positive
 Welding progression Stringers
 Root treatment clean base metal
 Preheat and interpass temperature base metal up to 3/4" (50°F) ; over 3/4 thru 1-1/2" (150°F) : over 1-1/2" thru 2-1/2" (225°F)
 Postheat treatment None
 Electrode extension 3/4" ± 1/4"


WELDING PROCEDURE

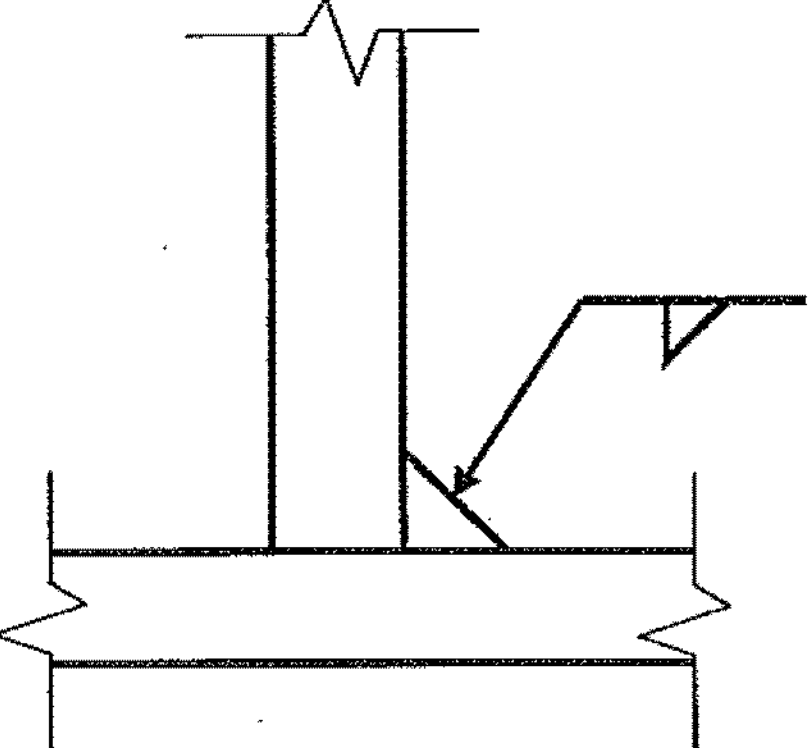Weld size	Pass no.	Electrode size	Welding parameters		Travel speed	Joint detail
			Amperes	Volts		
1/4"	1	0.062"	300 A ± 30	29 V ± 2	15 lpm ± 2	TYPICAL ALL FILLET WELDS 
CK'D _____ JUN 07 2013 resubmt _____ BY _____			Vtrans Received OK'D BY <i>JWC</i> APPROVED DATE <i>6/11/13</i>			

This procedure may vary due to fabrication sequence, fit-up, pass size, etc. within the limitation of variables given in section 5 of latest edition AWS D1.1 / D1.5

WPS no. W-1911A Fabricator Highway Safety Corporation
 Revision no. 0 Prepared By: Paul Radice
 Supporting PQR no. Pre-Qualified Date 06-04-13
 Project Name St. Johnsbury, VT Project Number BRF 028-4(25)S

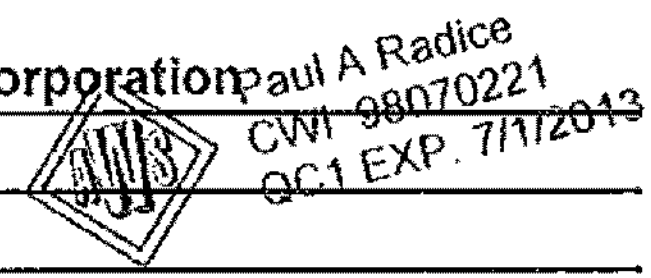

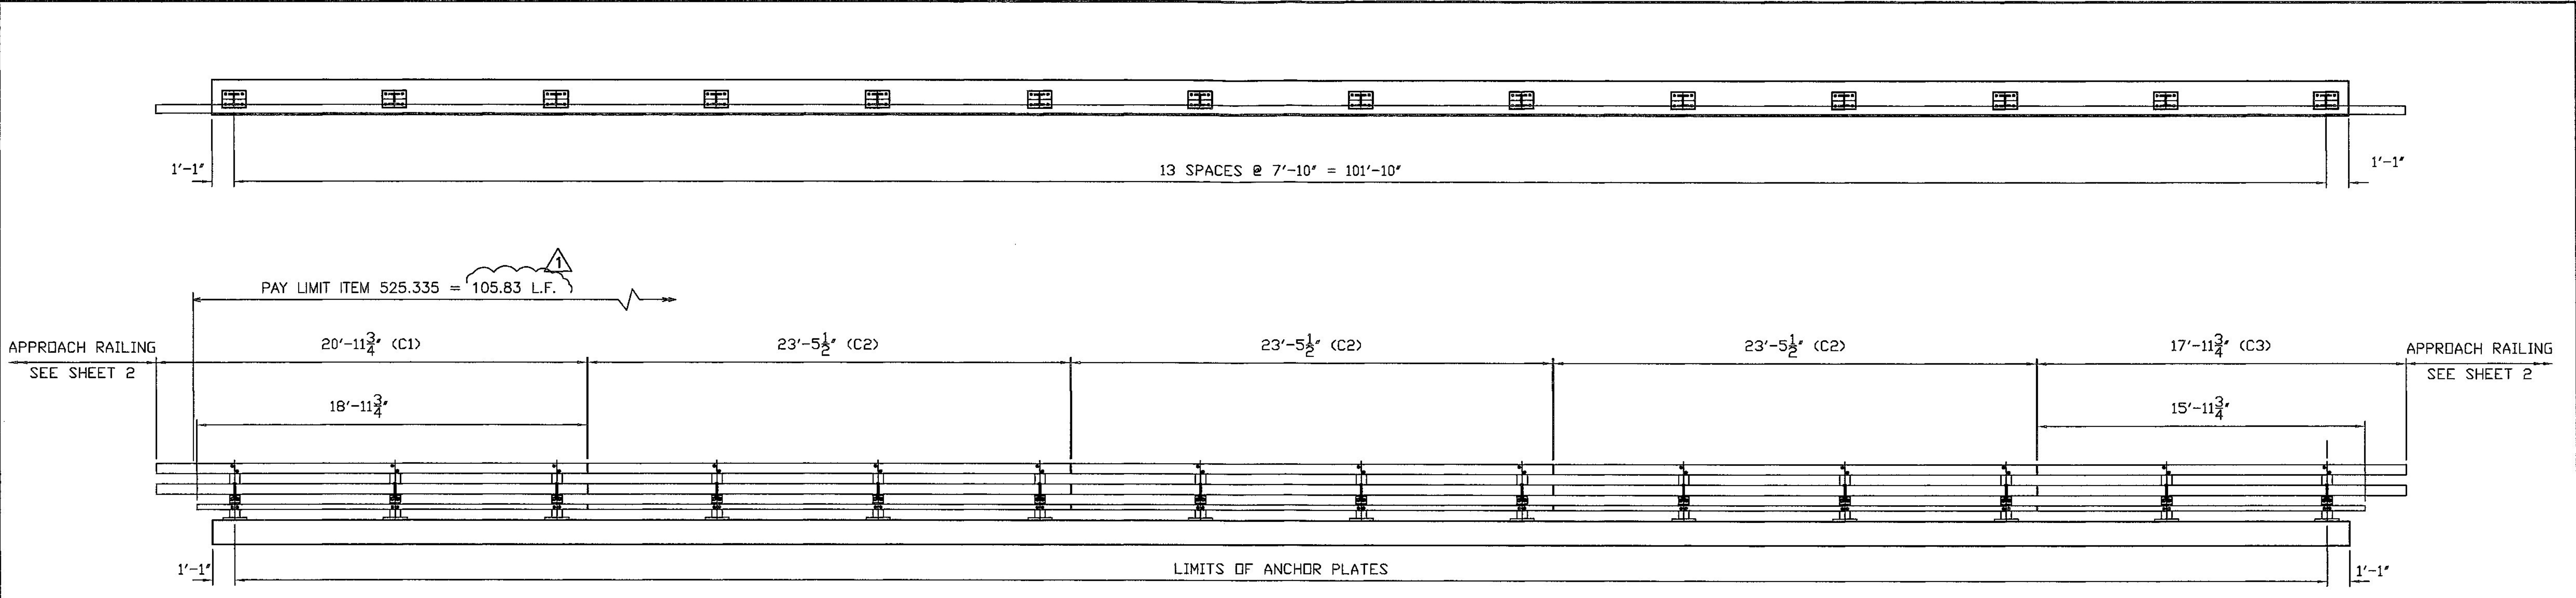

BRIDGE NO. 108
 NORTH RAIL ELEVATION
 looking at face of rail from center of road
 SOUTH ELEVATION SIMILAR

BILL OF MATERIAL - BRIDGE NO. 108 (NORTH & SOUTH SIDES)

Qty	mk	Description	Spec.
28		PED POST W6x25 2'-9.000" OAH (GALV) w/ 1.250" x 10" x 14" B.P	A572 gr 50
16		FIXED SPLICE TUBE (6x6) GALV TS 5x5x5/16 x 2'-3" OAL w/ (3) 1/4" fill plates	A500 gr B
8		FIXED SPLICE BAR (5x3) GALV 2.125 x 4.25 x 27.00"	A500 gr B
28		BRIDGE RAIL SHELF ANGLE (GALV) L 5 x 5 x 5/8 x 6" LONG	A572 gr 50
4	C1	TUBE 6 x 6 x 3/16 x 20 ft - 11.750 in LG (GALV) fixed splice 1 end, exp splice 1 end	A500 gr B
12	C2	TUBE 6 x 6 x 3/16 x 23 ft - 5.500 in LG (GALV) fixed splice both ends	A500 gr B
4	C3	TUBE 6 x 6 x 3/16 x 17 ft - 11.750 in LG (GALV) fixed splice 1 end, exp splice 1 end	A500 gr B
2	C1	TUBE 5 x 3 x 1/4 x 18 ft - 11.750 in LG (GALV) fixed splice 1 end, exp splice 1 end	A500 gr B
6	C2	TUBE 5 x 3 x 1/4 x 23 ft - 5.500 in LG (GALV) fixed splice both ends	A500 gr B
2	C3	TUBE 5 x 3 x 1/4 x 15 ft - 11.750 in LG (GALV) fixed splice 1 end, exp splice 1 end	A500 gr B
28		ANCHOR PLATE (GALV) PL 3/8" x 10.000" x 14.000"	A36
112		THREADED STUD (2 1/4" THREAD EACH SIDE) 1.000-08 x 13.000 HDG A449	A449
224		NUT HEX HEAVY (2) HI-STRENGTH 1.000-08 GALV	A563 DH
224		WASHER ROUND SMALL (2) F436 1.000 SAE GALV	F436
112		JAM NUT (1) 1.000-08 GALV	A563 DH
112		7/8 x 8 slotted head bolt w/ HN & LW SQW	A449
28		3/4 x 8 hex bolt w/ HN & LW (A325)	A325
56		3/4 x 2.5 hex bolt w/ HN & LW (A325)	A325
32		3/4 x 4.5 hex bolt w/ HN & 2 FW (A325)	A325
64		3/4 x 7.5 hex bolt w/ HN & 2 FW (A325)	A325

ITEM 525.335 3 RAIL BOX BEAM BRIDGE RAILING = 212 L.F.

No.	Remarks	Date
1	revised per approver	7/2/13
0	Initial submittal	6/21/13

REVISIONS


Vermont Agency of Transportation
RECEIVED
 CK'D BY M. Umberger OK'D BY C. Carlson
 July 2, 2013
 RESUBMIT Approved
 BY C. Carlson DATE 07/03/13

HIGHWAY SAFETY CORP
 GLASTONBURY, CT
 860-633-9445


ITEM 525.335 3-RAIL BOX BEAM
 TOWN OF ST. JOHNSBURY
 COUNTY OF CALEDONIA
 US ROUTE 2 - PRINCIPAL ARTERIAL
 BRIDGE NO. 108
 PROJECT NO. BRF 028-4(25)S

CERTIFIED FABRICATOR
 HSC JOB NO. 1911
 SHEET NO. 1 of 4

GENERAL CONTRACTOR
 SUB CONTRACTOR LAFAYETTE
 DRAWN BJB CHECKED [Signature] DATE 06-01-13 SCALE NONE SIZE D

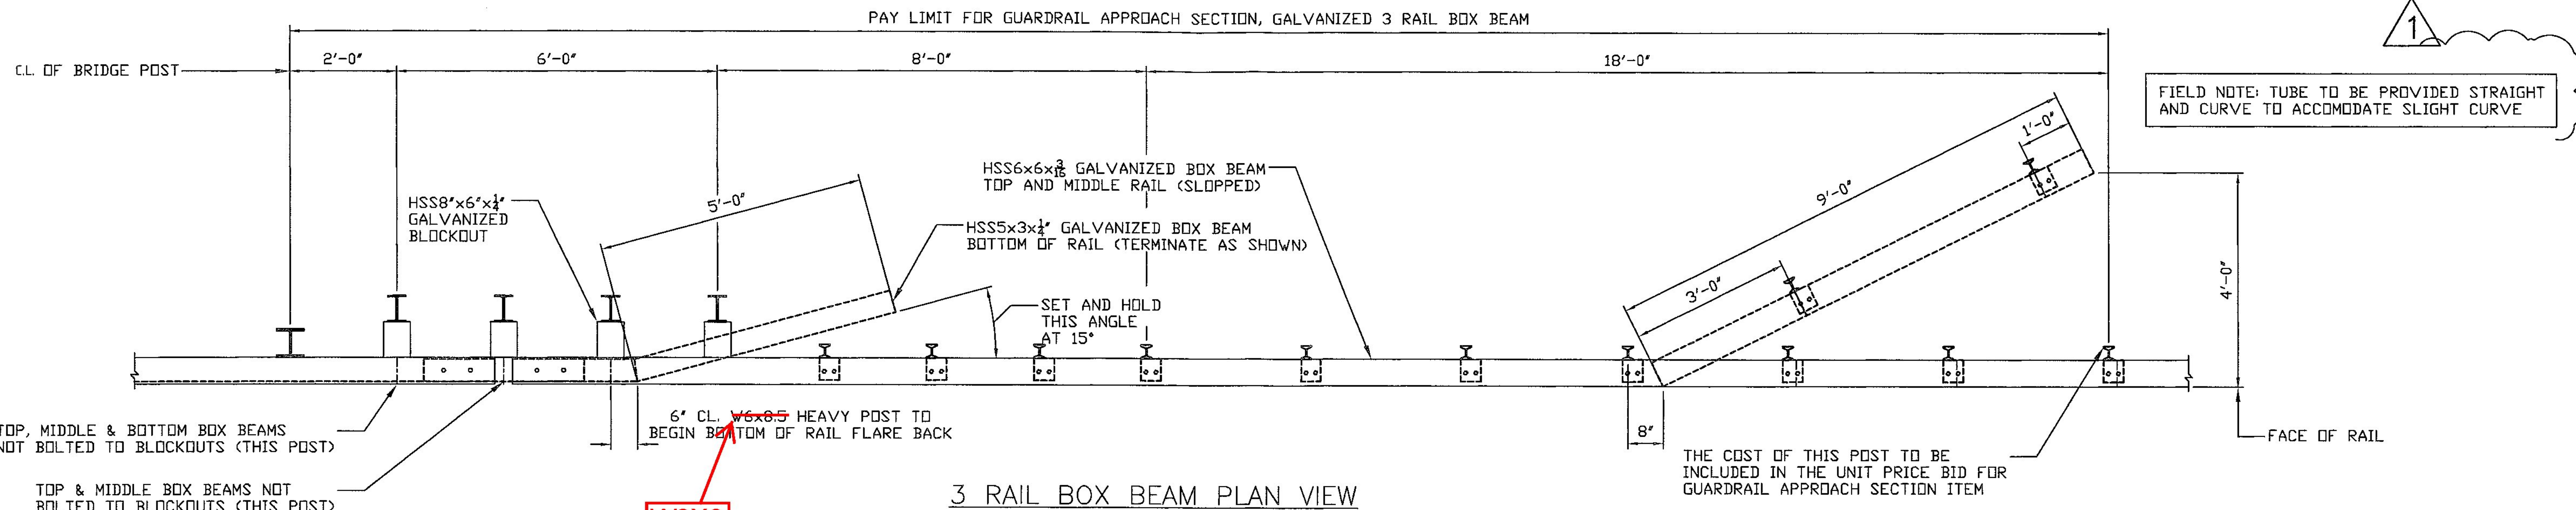

3 RAIL BOX BEAM PLAN VIEW

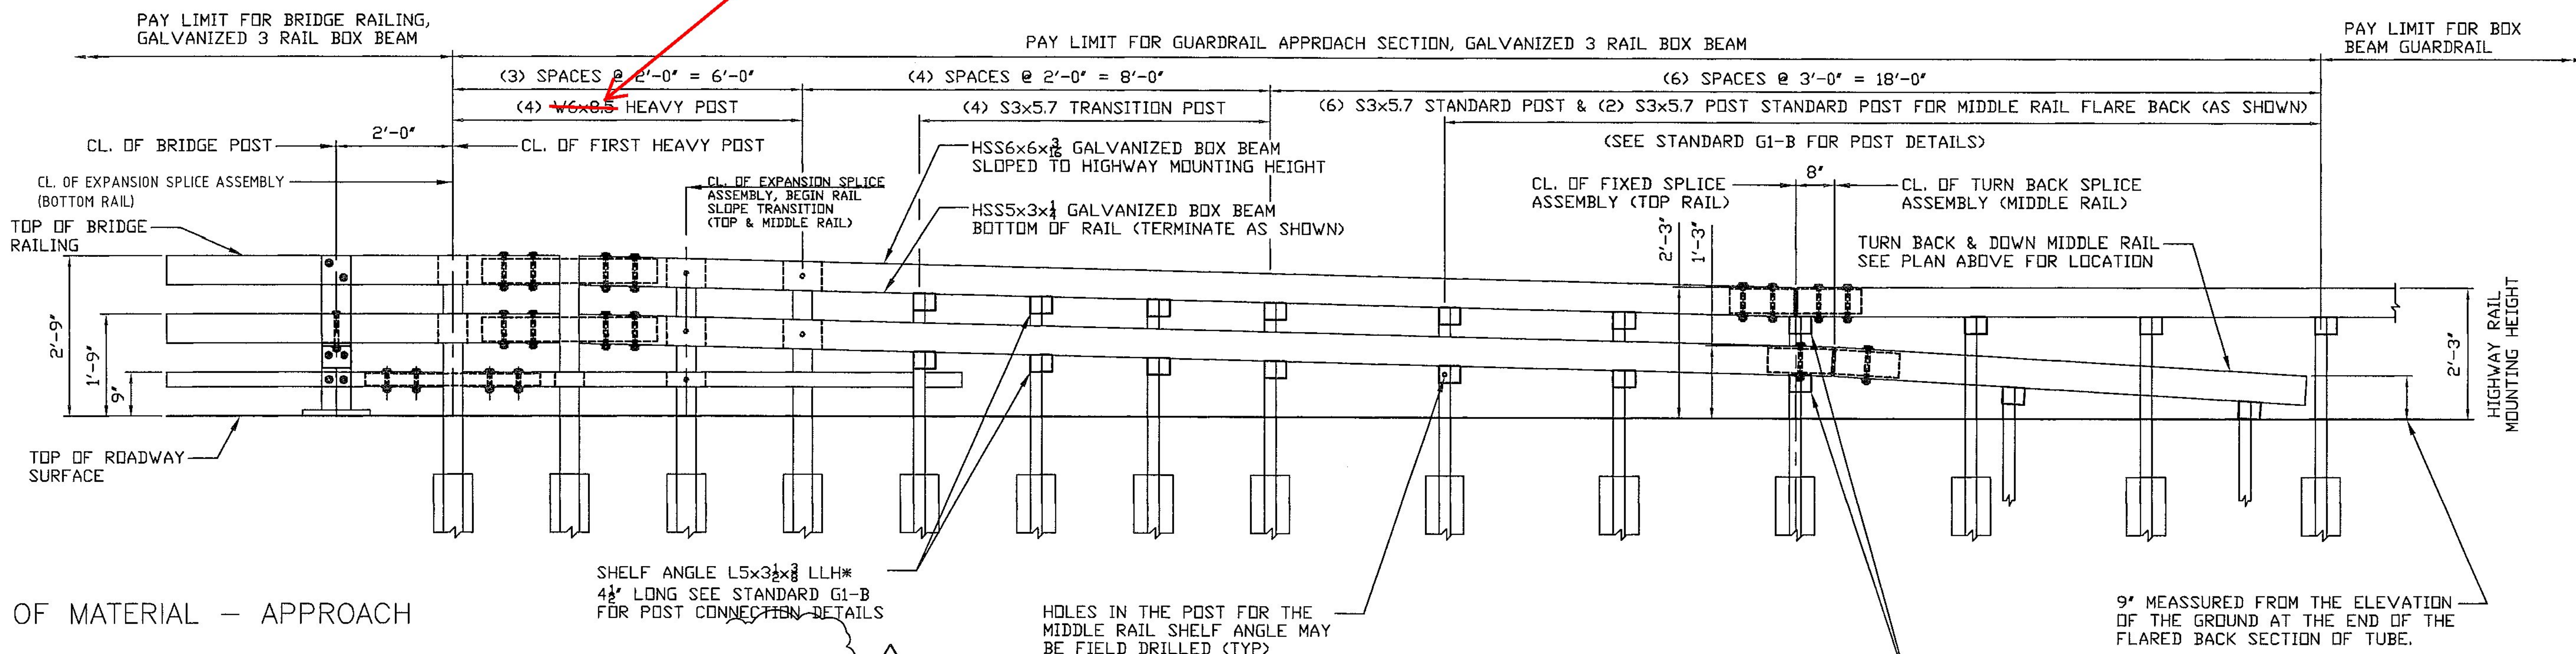

3 RAIL BOX BEAM ELEVATION

BILL OF MATERIAL - APPROACH

Qty	mk	Description	Spec.
4		6 X 6 BM BM TOP @ 20'-9.5" EXP	A500 gr B
4		6 X 6 BM BM BOTT @ 21'-5" EXP	A500 gr B
16		W6 X 8.5 POST @ 7'-0" W/SPADE	A36
12		3" I POST @ 7'-0" W/2'-8" SPADE	A36
24		3" I POST @ 5'-3" W/SPADE STD	A36
8		3" I POST @ 3'-11" W/SPADE	A36
32		TUBE BLOCKOUT 6" X 8'-6" LONG	A500 gr B
8		TUBE BLOCKOUT 6" X 8'-3" LONG	A500 gr B
4		9' BX BM TRANS FLAREBACK END	A500 gr B
4		5 X 5 DOUBLE BEND SPLICE TUBE	A500 gr B
4		5 X 5 FIXED TUBE SPLICE 27"	A500 gr B
8		5 X 5 EXP TUBE SPLICE 36"	A500 gr B
68		BOX BEAM CLIP ANGLE STD	A36
4		BOX BEAM END ANGLE STD	A36
32		3/4 X 8 CARR BOLT - N FW LW (2 per heavy post)	A307
4		3/4 X 8 HEX BOLT - N 2FW (1 per 9'-0" flareback)	A307
72		1/2 X 1 1/2 HEX BOLT - N FW (1 per shelf / end angle)	A307
80		1/2 X 1 1/2 HEX BOLT - N 2FW LW (2 per tube block)	A307
72		3/8 X 7 1/2 HEX BOLT - N 2FW (1 per shelf angle)	A307
48		3/4 x 7 1/2 HEX BOLT W/ HN & 2 FW (A325) (4 per 6x6 splice)	A325
8		3/4 x 7 1/2 HEX BOLT W/ HN & 2 FW & LW (A325) (2 per angled turnback splice)	A325

ITEM 621.725 GUARDRAIL APPR. SECTION 3 RAIL = 4 EA.

Vermont Agency of Transportation

RECEIVED

CK'D BY M. Umberger OK'D BY C. Carlson

July 2, 2013

RESUBMIT Approved AsNoted

BY C. Carlson DATE 07/03/13

HIGHWAY SAFETY CORP

GLASTONBURY, CT
860-633-9445

ITEM 621.725 APPROACH SECTION
TOWN OF ST. JOHNSBURY
COUNTY OF CALEDONIA
US ROUTE 2 - PRINCIPAL ARTERIAL
BRIDGE NO. 108
PROJECT NO. BRF 028-4(25)S

GENERAL CONTRACTOR

SUB CONTRACTOR










LAFAYETTE

CERTIFIED FABRICATOR






NSC JOB NO. 1911

SHEET NO. 2 of 4





DRAWN BJB CHECKED DATE 06-01-13 SCALE NONE SIZE D

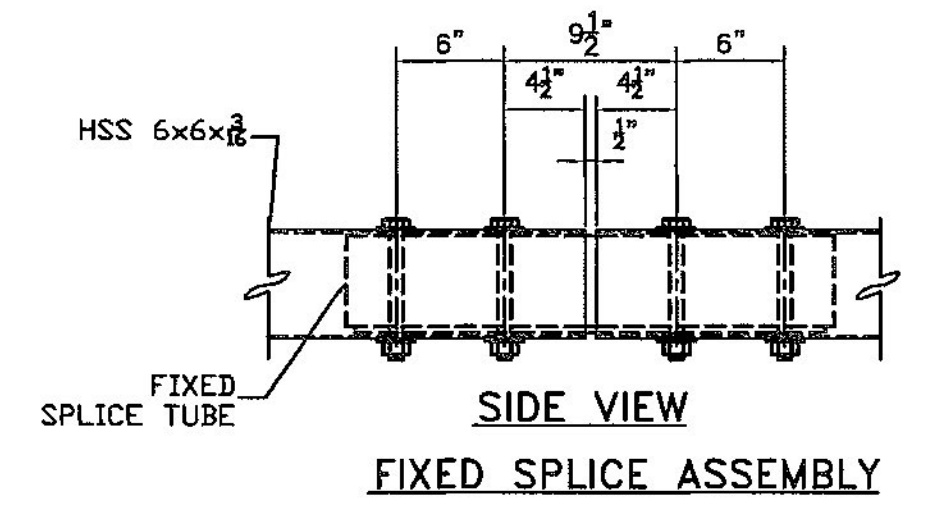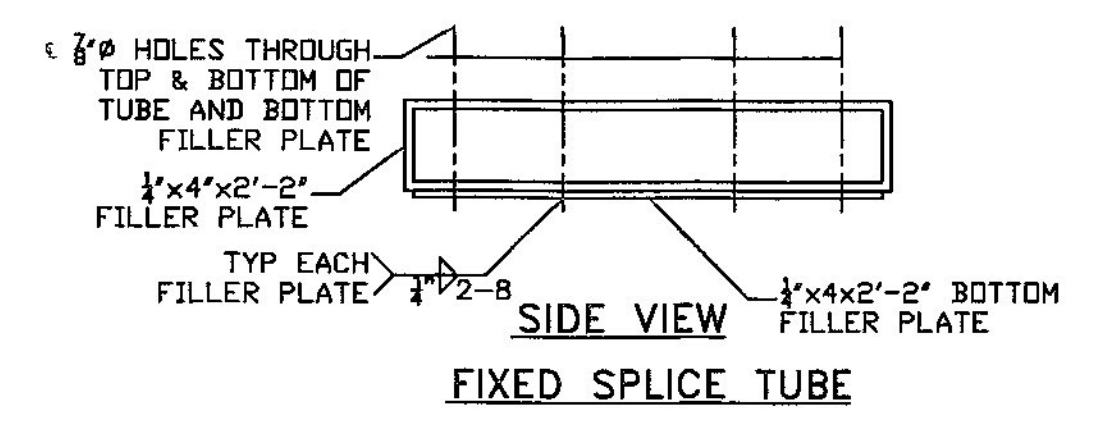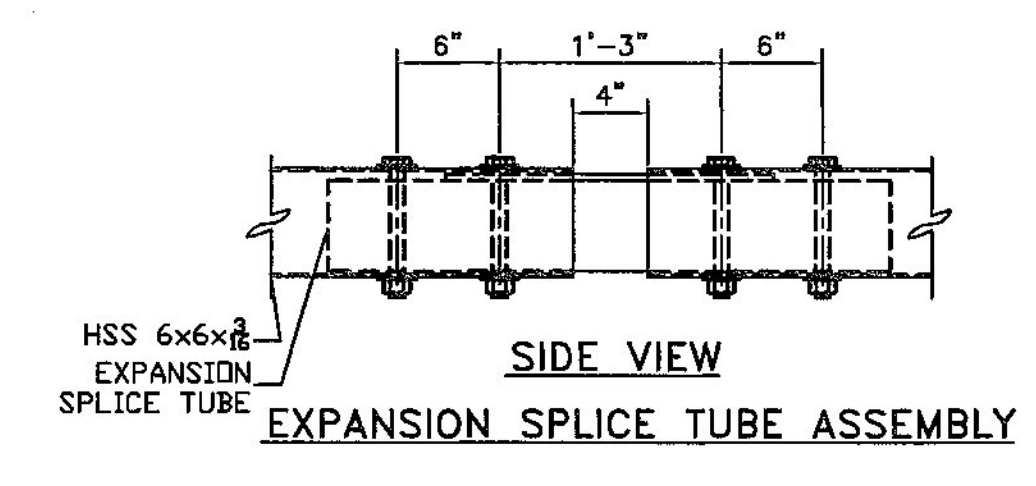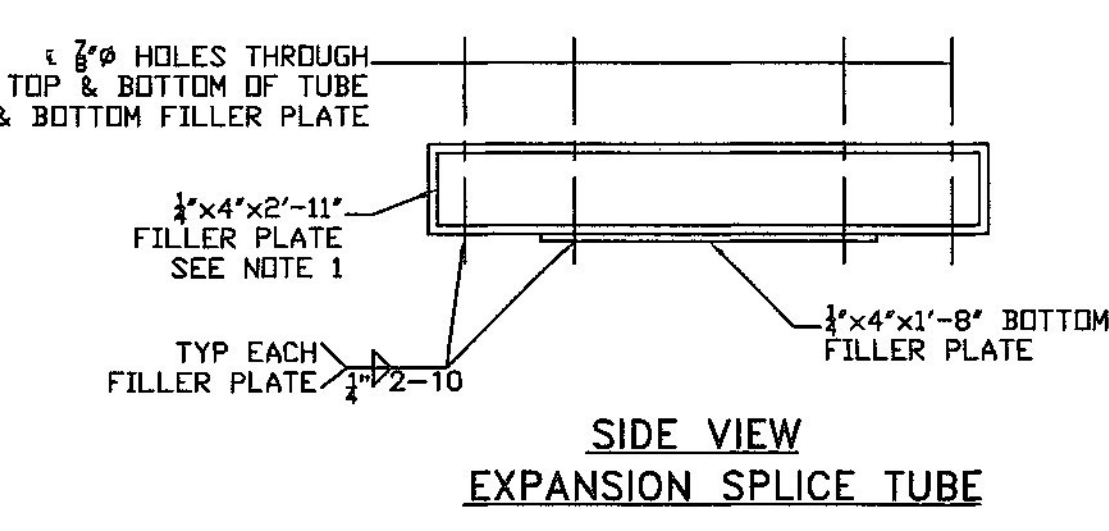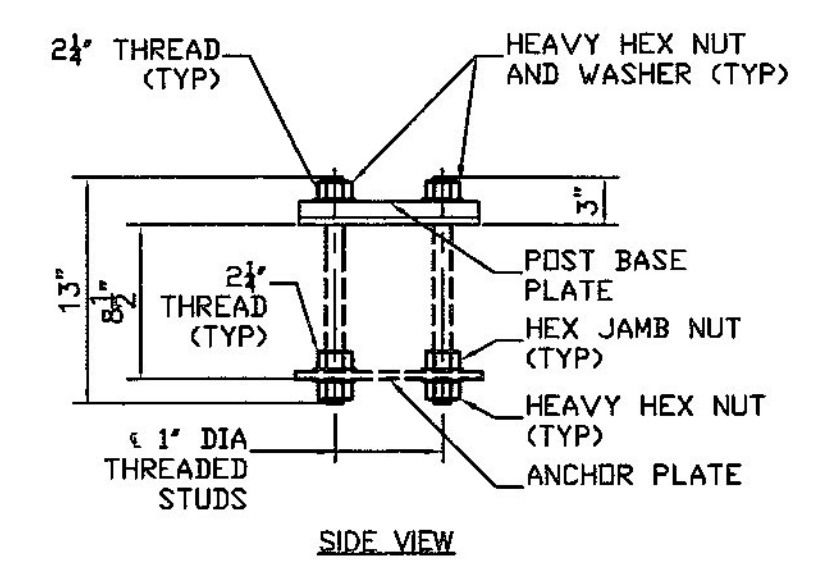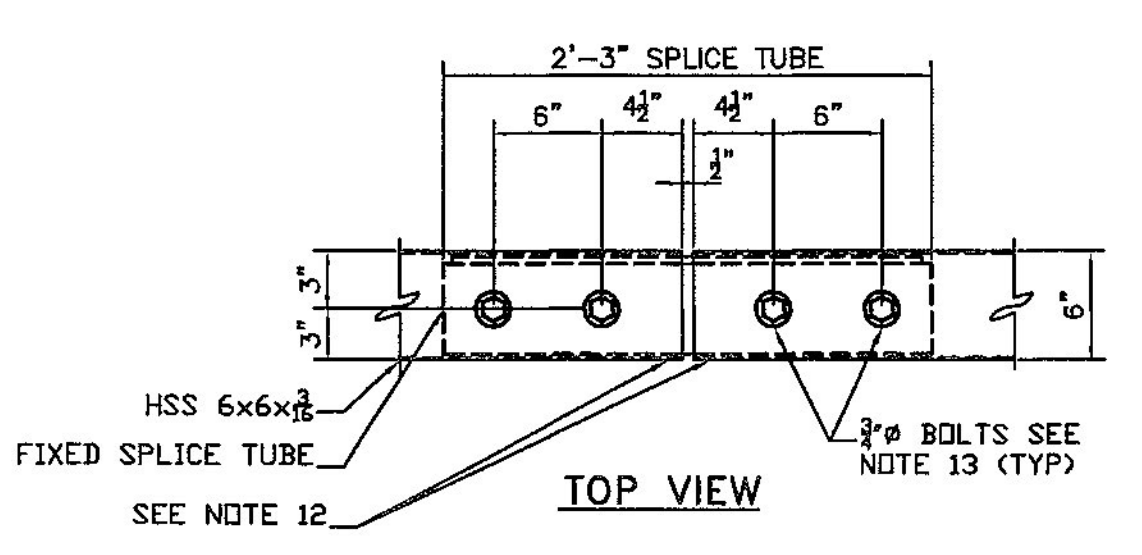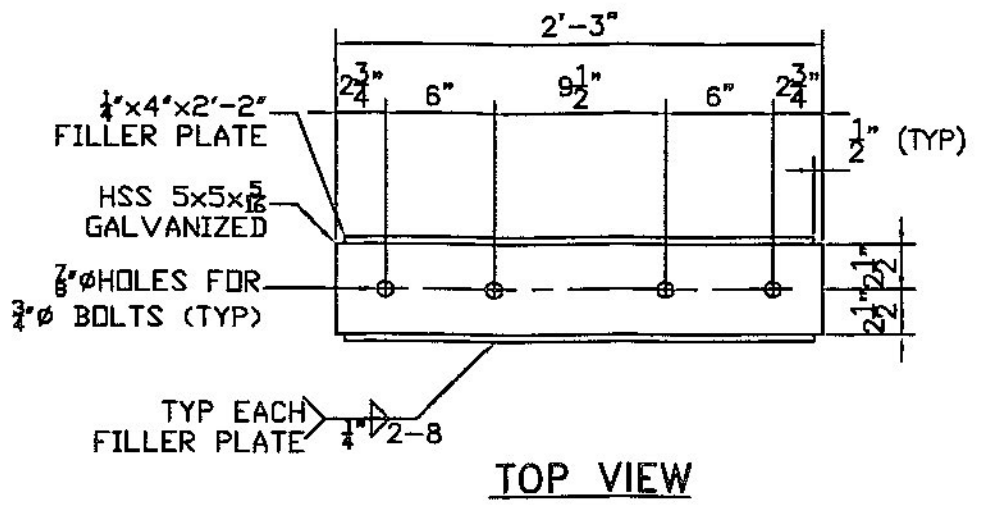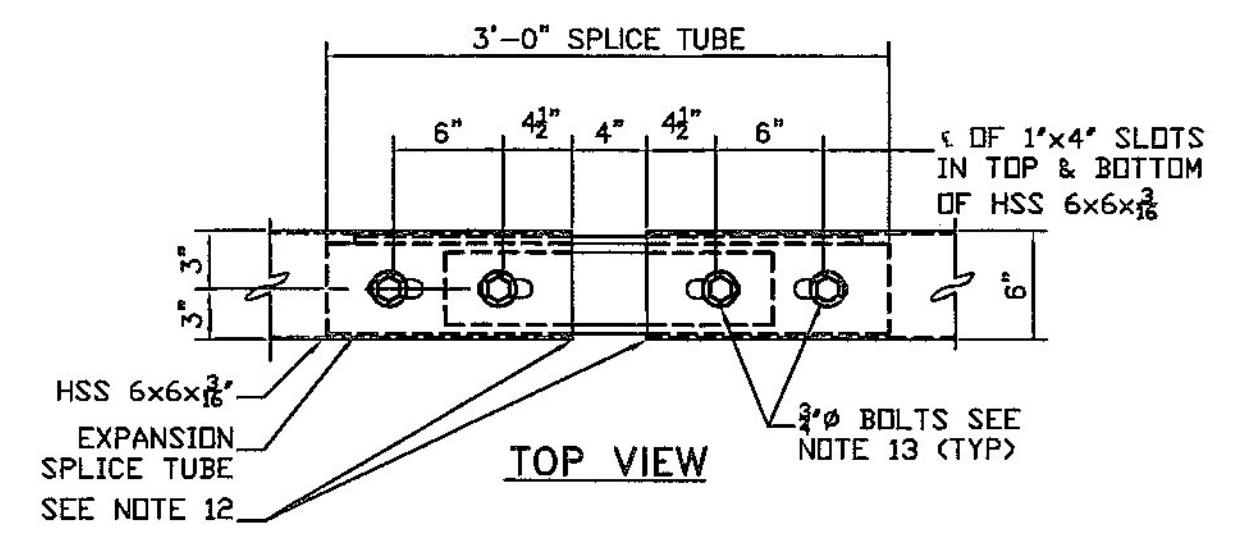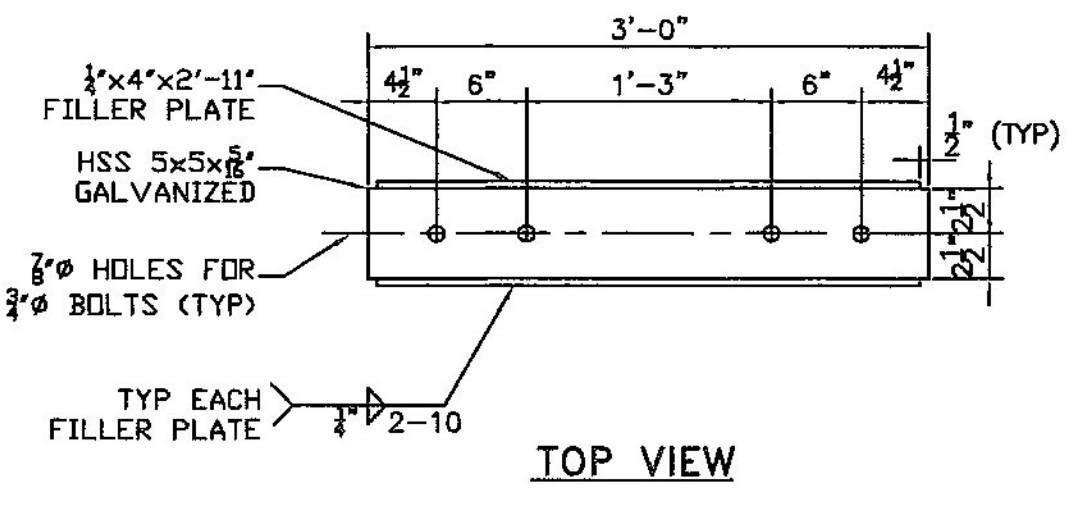


RAILING POST ANCHORAGE

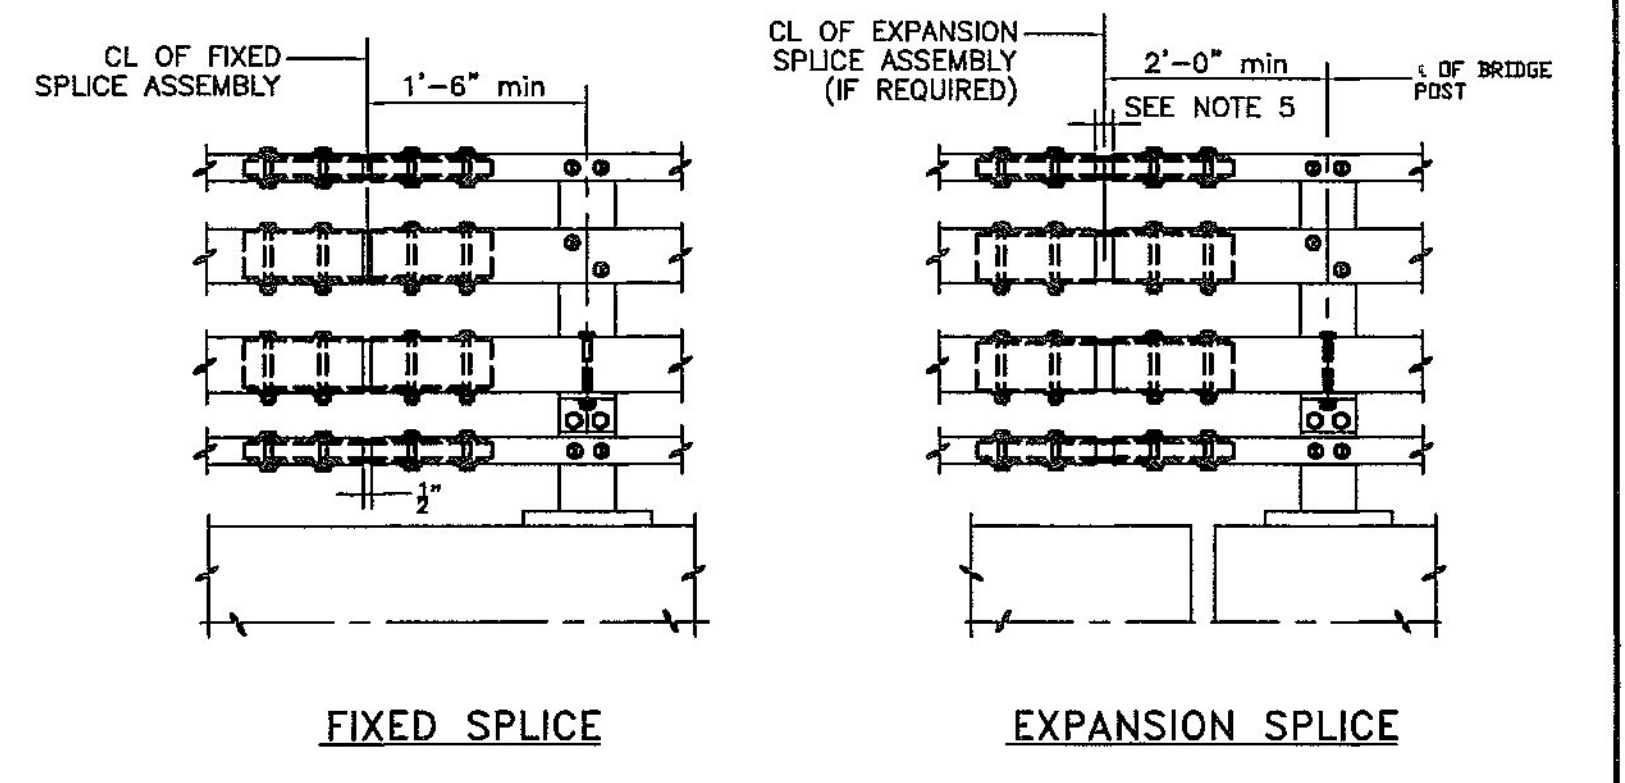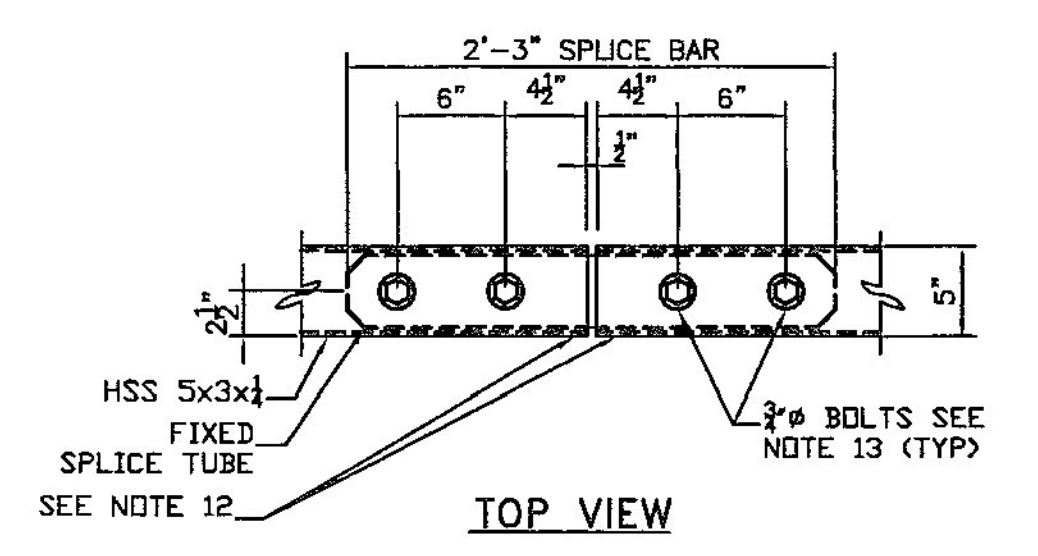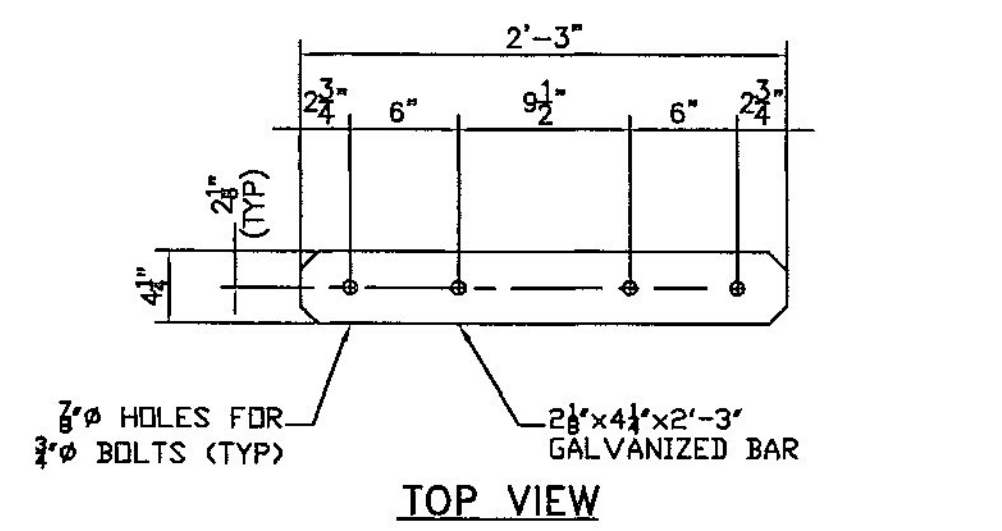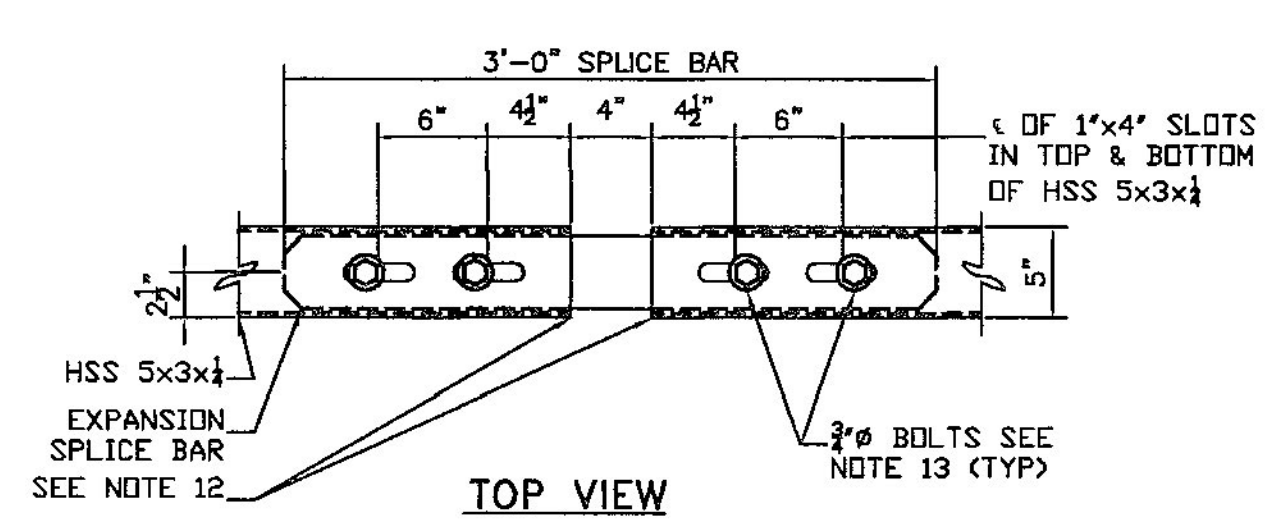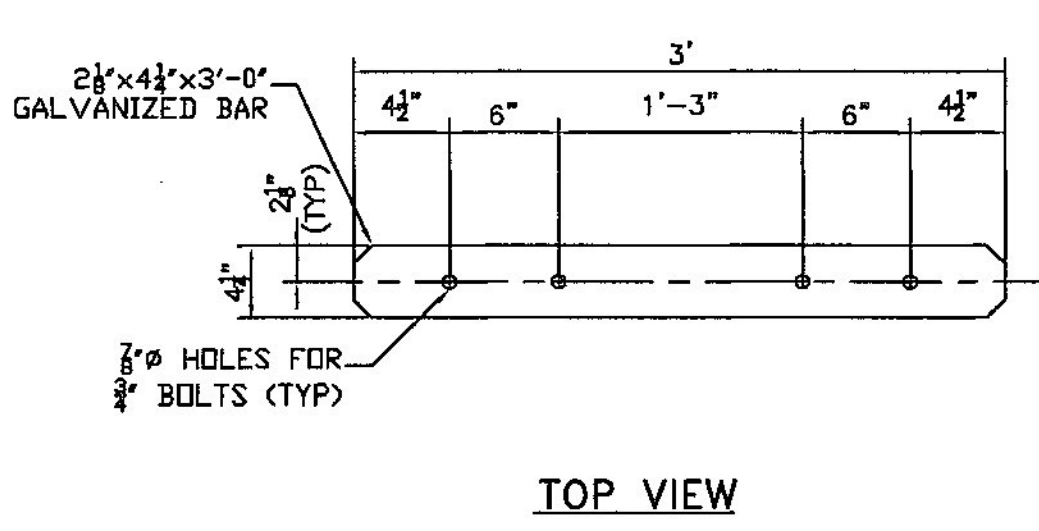

RAILING SPLICE DETAIL ELEVATION

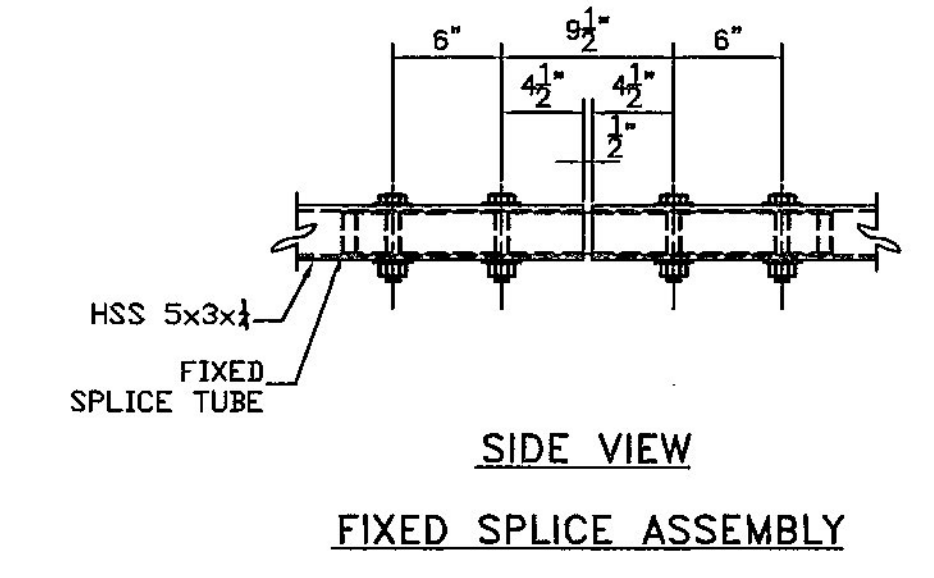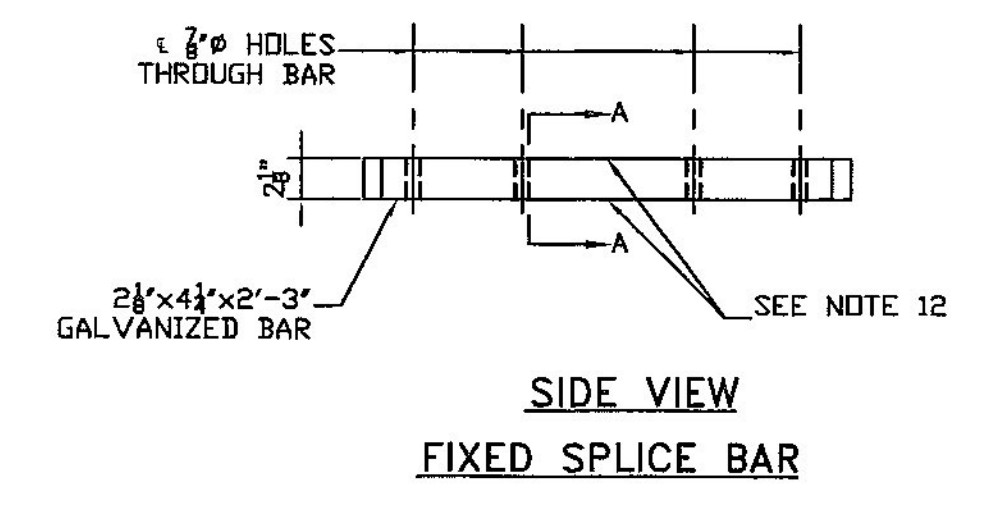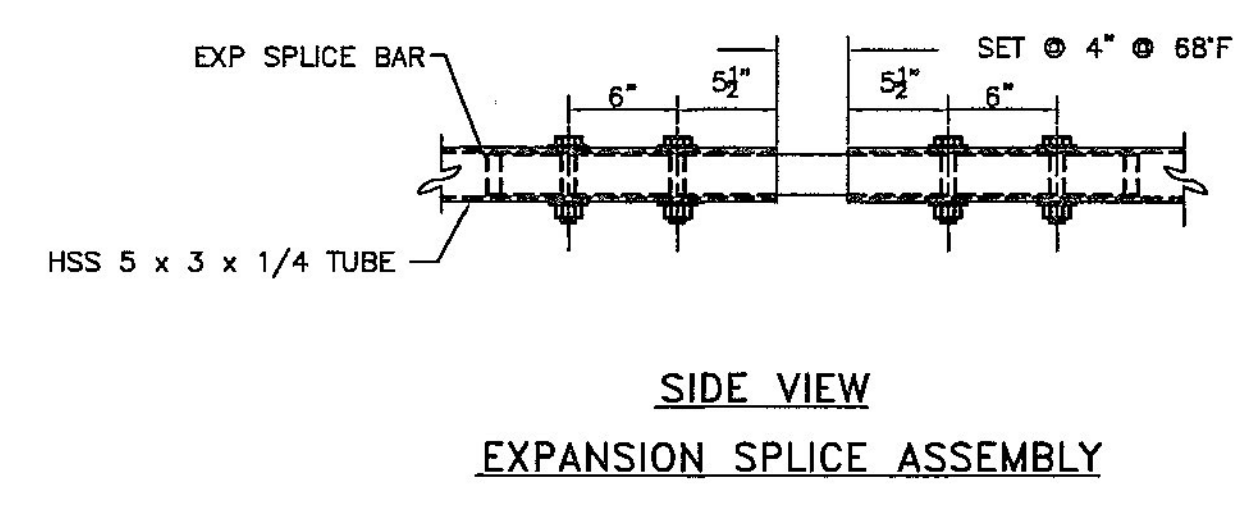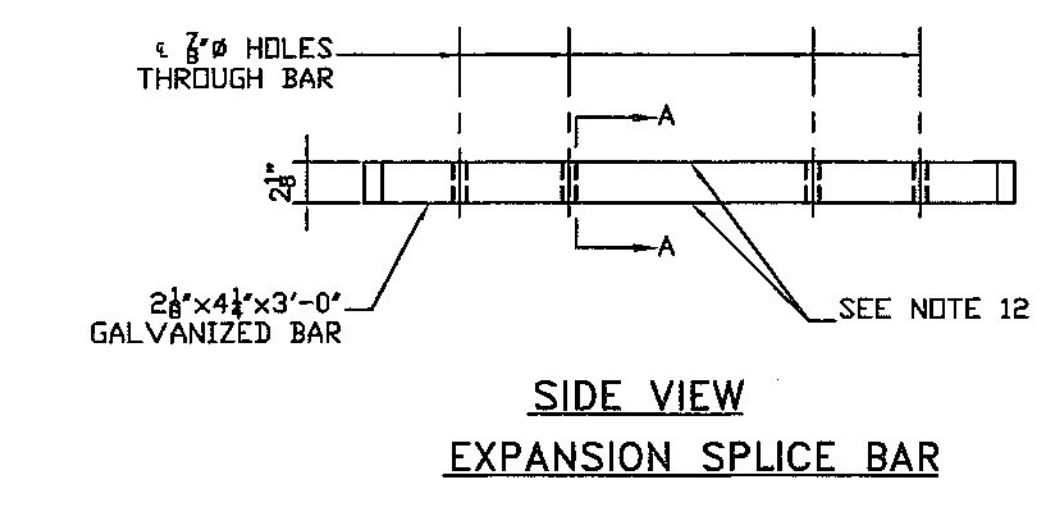

A RAILING EXPANSION SPLICE IS REQUIRED IN ANY POST SPACING THAT CONTAINS A SUPERSTRUCTURE EXPANSION JOINT.

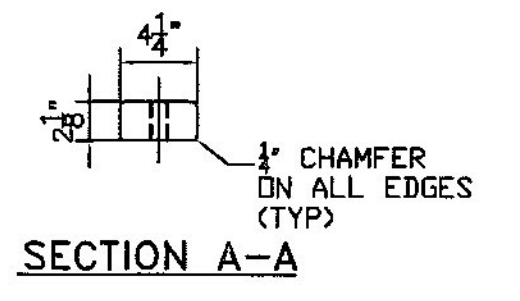

- NOTES:
1. ALL WORK AND MATERIALS SHALL CONFORM TO SECTION 525.
 2. PRIOR TO GALVANIZING THE ASSEMBLED POST, GRIND ALL EDGES TO A MINIMUM RADIUS OF 1/16".
 3. ALL POSTS SHALL BE SET NORMAL TO GRADE. THE MAXIMUM CENTER TO CENTER SPACING OF BRIDGE RAIL POSTS IS 8'-3".
 4. SECTIONS OF RAIL TUBE SHALL BE ATTACHED TO A MINIMUM OF TWO BRIDGE POST AND PREFERABLY TO AT LEAST 4 POSTS.
 5. RAIL TUBE EXPANSION JOINTS SHALL BE PROVIDED IN ANY RAIL BAY SPANNING THE END OF AN INTEGRAL ABUTMENT BRIDGE AND AT ALL SUPERSTRUCTURE EXPANSION JOINTS. EXPANSION JOINT WIDTH SHALL BE 4" @ 68°F AND WILL BE ADJUSTED IN THE FIELD BY THE ENGINEER FOR OTHER TEMPERATURES.
 6. HOLES IN RAILS FOR TUBE ATTACHMENT MAY BE FIELD-DRILLED. HOLES SHALL BE COATED WITH AN APPROVED ZINC-RICH PAINT PRIOR TO INSTALLATION.
 7. BOLTS SHALL BE TORQUED SNUG TIGHT (APPROXIMATELY 100 FT-LB).
 8. SEE STANDARD DRAWING G-1B FOR DETAILS OF DELINEATORS. A DELINEATOR SHALL BE INSTALLED AT 30 FOOT SPACING FOR THE NEAREST POST. WHITE IS TO BE INSTALLED ON THE DRIVER'S RIGHT. FOR ONE WAY BRIDGES, YELLOW IS TO BE INSTALLED ON THE DRIVER'S LEFT. PAYMENT SHALL BE INCIDENTAL TO OTHER ITEMS.
 9. ANY BENDING OF RAIL SHALL BE DONE AT THE FABRICATION PLANT ACCORDING TO A PROCEDURE PROVIDED BY THE FABRICATOR.
 10. THE MINIMUM DISTANCE FROM THE POST TO AN EXPANSION JOINT SHALL BE DETERMINED BY THE MINIMUM EDGE DISTANCE OF 5" FROM ANY ANCHORS STUD TO THE END OF THE SLAB, OR TO THE EXPANSION JOINT RECESS POUR, IF ONE IS USED.
 11. THIS RAILING MEETS THE REQUIREMENTS FOR A TL-4 SERVICE LEVEL.

- NOTES:
12. PROTRUSIONS CAUSED BY WELDING OR GALVANIZING ARE NOT PERMITTED ON THE ADJOINING SURFACES OF THE BOX BEAM RAILS, SPLICE TUBES AND FILL PLATES.
 13. FOUR (4) 3/8" DIAMETER BOLTS, 7 1/2" LONG WITH TWO (2) WASHERS AND HEAVY HEX NUT ON EACH BOLT. NUT TO BE FINGER TIGHT AND THE FIRST THREAD BELOW THE NUT TO BE BURRED TO PREVENT DISLODGING. FOUR (4) BOLTS AT EACH SPLICE.

Vermont Agency of Transportation
RECEIVED
CK'D BY M. Umberger OK'D BY C. Carlson
July 2, 2013
RESUBMIT Approved
BY C. Carlson DATE 07/03/13


HIGHWAY SAFETY CORP
GLASTONBURY, CT
860-633-9445

ITEM 525.335 3-RAIL BOX BEAM
TOWN OF ST. JOHNSBURY
COUNTY OF CALEDONIA
US ROUTE 2 - PRINCIPAL ARTERIAL
BRIDGE NO. 108
PROJECT NO. BRF 028-4(25)S


CERTIFIED FABRICATOR

HSD JOB NO. 1911
SHEET NO. 3 of 4


GENERAL CONTRACTOR
SUB CONTRACTOR LAFAYETTE
DATE 06-01-13 SCALE NONE SIZE D

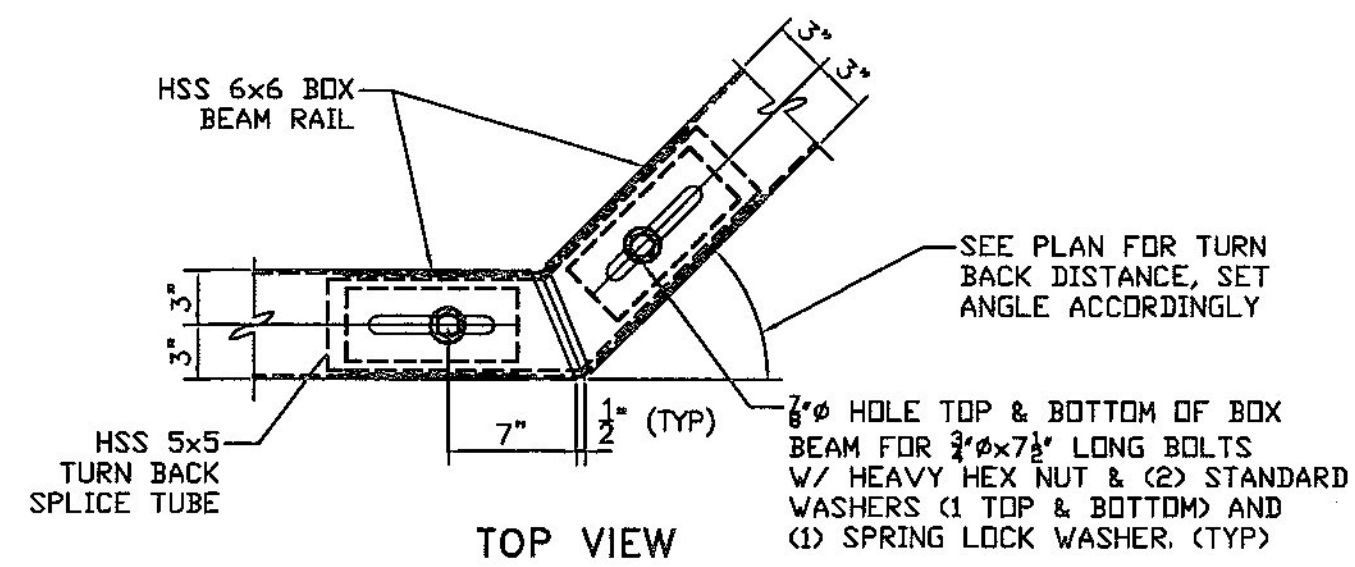

TURN BACK SPLICE TUBE ASSEMBLY

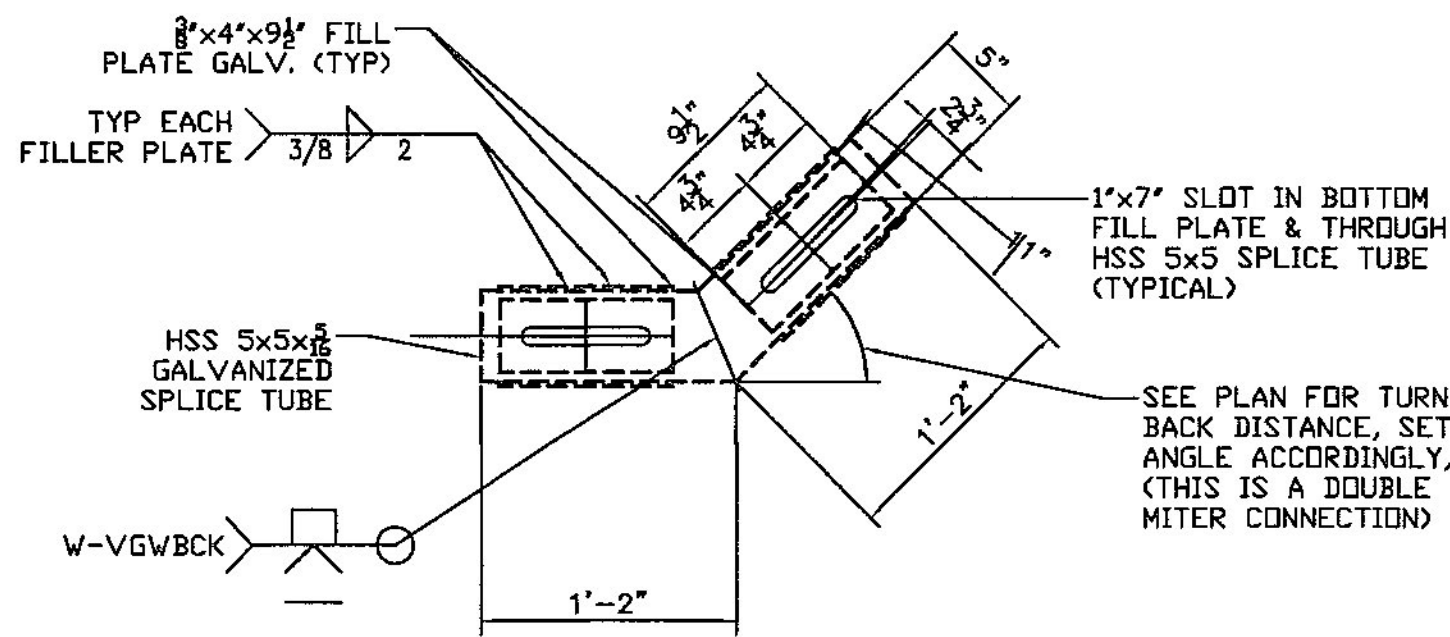


TOP VIEW

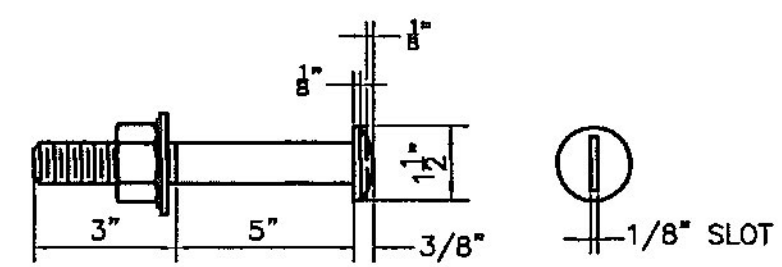


ROUND HEAD BOLT DETAIL


- NOTES:
1. ALL WORK AND MATERIALS SHALL CONFORM TO SECTION 525.
 2. PRIOR TO GALVANIZING THE ASSEMBLED POST, GRIND ALL EDGES TO A MINIMUM RADIUS OF $\frac{1}{8}$ ".
 3. ALL POSTS SHALL BE SET NORMAL TO GRADE. THE MAXIMUM CENTER TO CENTER SPACING OF BRIDGE RAIL POSTS IS 8'-3".
 4. SECTIONS OF RAIL TUBE SHALL BE ATTACHED TO A MINIMUM OF TWO BRIDGE POST AND PREFERABLY TO AT LEAST 4 POSTS.
 5. RAIL TUBE EXPANSION JOINTS SHALL BE PROVIDED IN ANY RAIL BAY SPANNING THE END OF AN INTEGRAL ABUTMENT BRIDGE AND AT ALL SUPERSTRUCTURE EXPANSION JOINTS. EXPANSION JOINT WIDTH SHALL BE 4" @ 68°F AND WILL BE ADJUSTED IN THE FIELD BY THE ENGINEER FOR OTHER TEMPERATURES.
 6. HOLES IN RAILS FOR TUBE ATTACHMENT MAY BE FIELD-DRILLED. HOLES SHALL BE COATED WITH AN APPROVED ZINC-RICH PAINT PRIOR TO INSTALLATION.
 7. BOLTS SHALL BE TORQUED SNUG TIGHT (APPROXIMATELY 100 FT-LB).
 8. SEE STANDARD DRAWING C-1B FOR DETAILS OF DELINEATORS. A DELINEATOR SHALL BE INSTALLED AT 30 FOOT SPACING FOR THE NEAREST POST. WHITE IS TO BE INSTALLED ON THE DRIVER'S RIGHT. FOR ONE WAY BRIDGES, YELLOW IS TO BE INSTALLED ON THE DRIVER'S LEFT. PAYMENT SHALL BE INCIDENTAL TO OTHER ITEMS.
 9. ANY BENDING OF RAIL SHALL BE DONE AT THE FABRICATION PLANT ACCORDING TO A PROCEDURE PROVIDED BY THE FABRICATOR.
 10. THE MINIMUM DISTANCE FROM THE POST TO AN EXPANSION JOINT SHALL BE DETERMINED BY THE MINIMUM EDGE DISTANCE OF 5" FROM ANY ANCHORS STUD TO THE END OF THE SLAB, OR TO THE EXPANSION JOINT RECESS POUR, IF ONE IS USED.
 11. THIS RAILING MEETS THE REQUIREMENTS FOR A TL-4 SERVICE LEVEL.
 12. PROTRUSIONS CAUSED BY WELDING OR GALVANIZING ARE NOT PERMITTED ON THE ADJOINING SURFACES OF THE BOX BEAM RAILS, SPLICE TUBES AND FILL PLATES.
 13. FOUR (4) $\frac{3}{8}$ " DIAMETER BOLTS, $\frac{1}{2}$ " LONG WITH TWO (2) WASHERS AND HEAVY HEX NUT ON EACH BOLT. NUT TO BE FINGER TIGHT AND THE FIRST THREAD BELOW THE NUT TO BE BURRED TO PREVENT DISLODGING. FOUR (4) BOLTS AT EACH SPLICE.

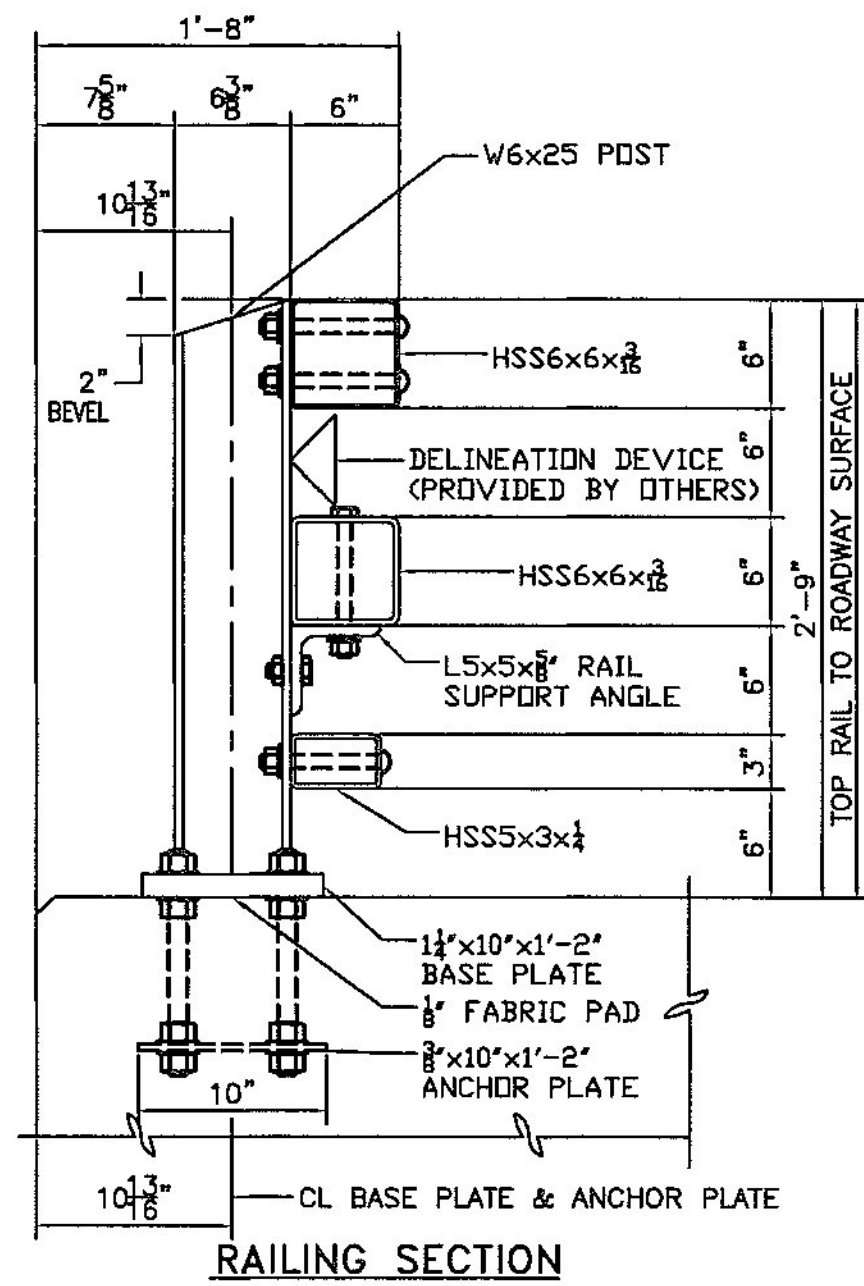


RAILING SECTION

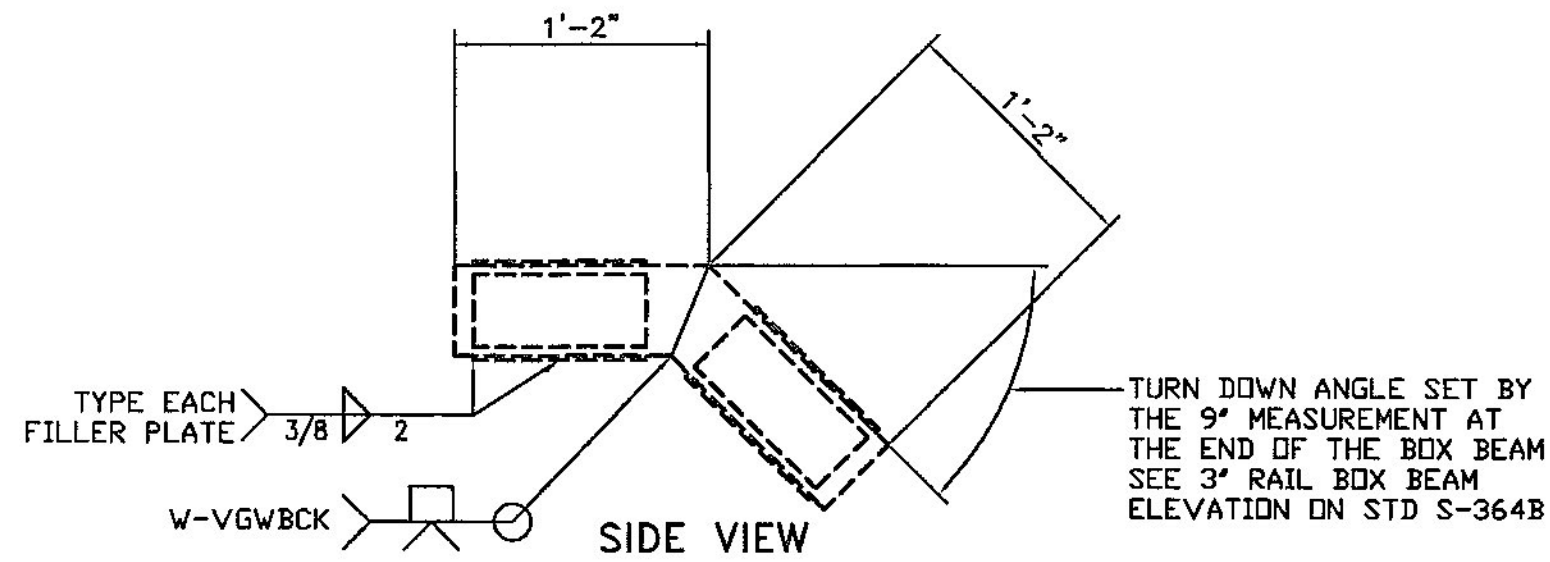


TURN BACK SPLICE TUBE DETAIL
TURN BACK & TURN TUBE JOINT

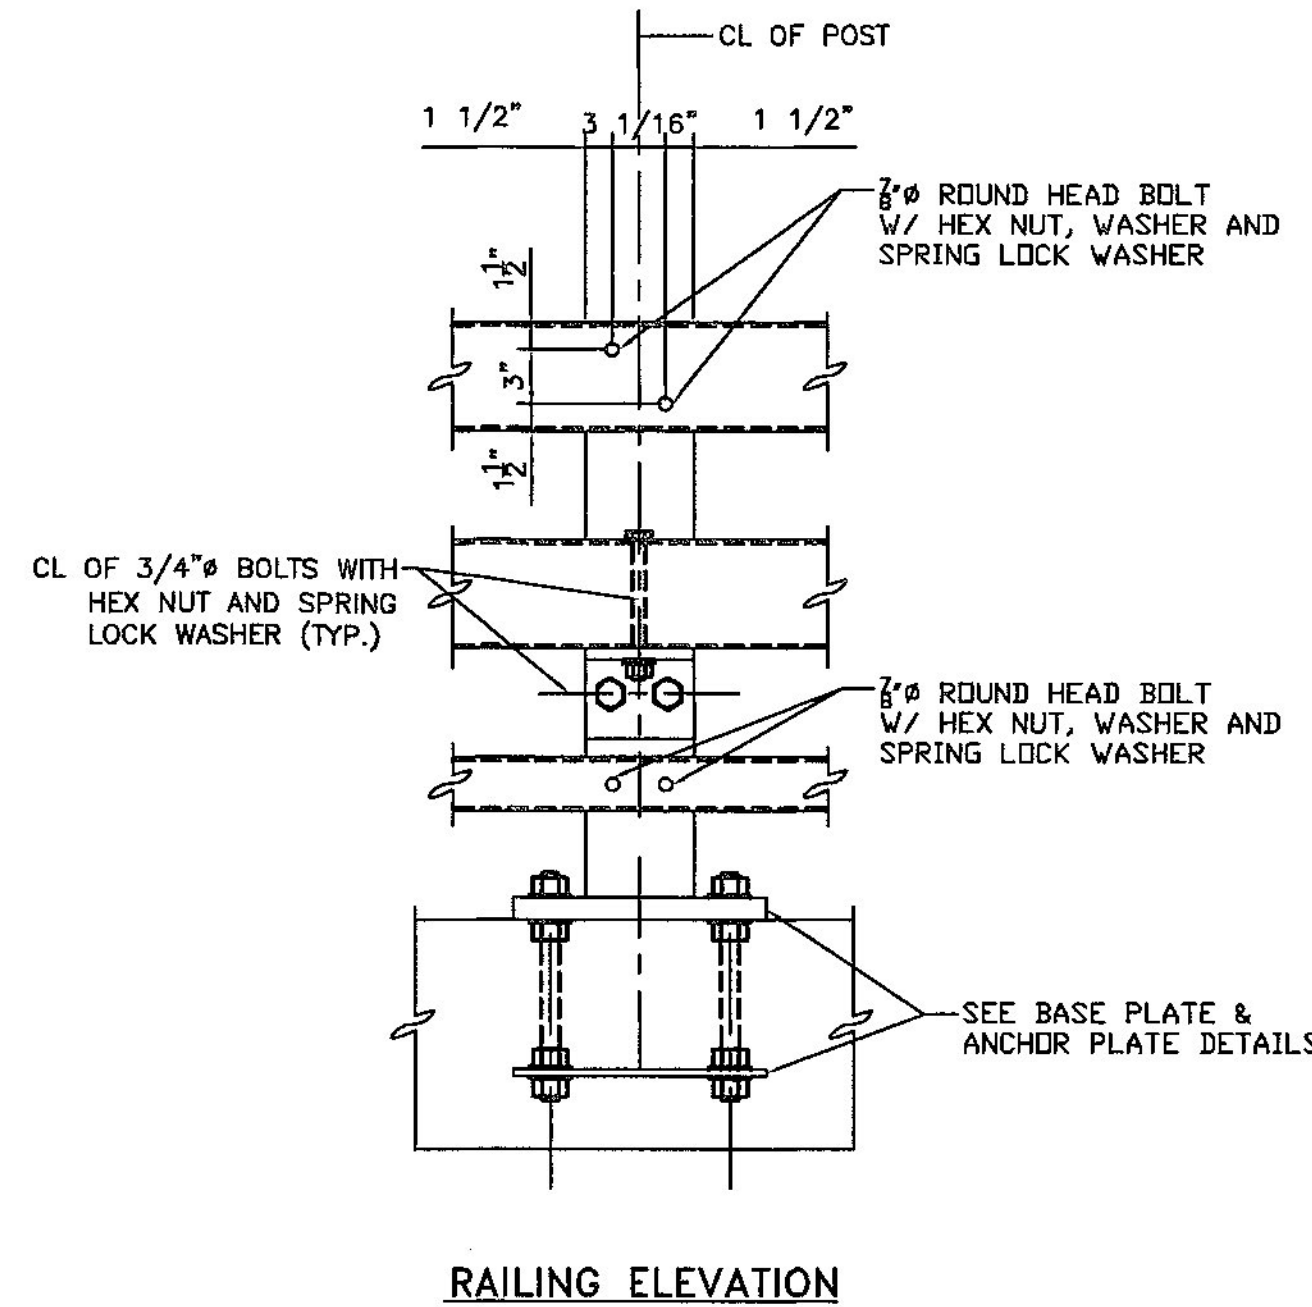


RAILING ELEVATION

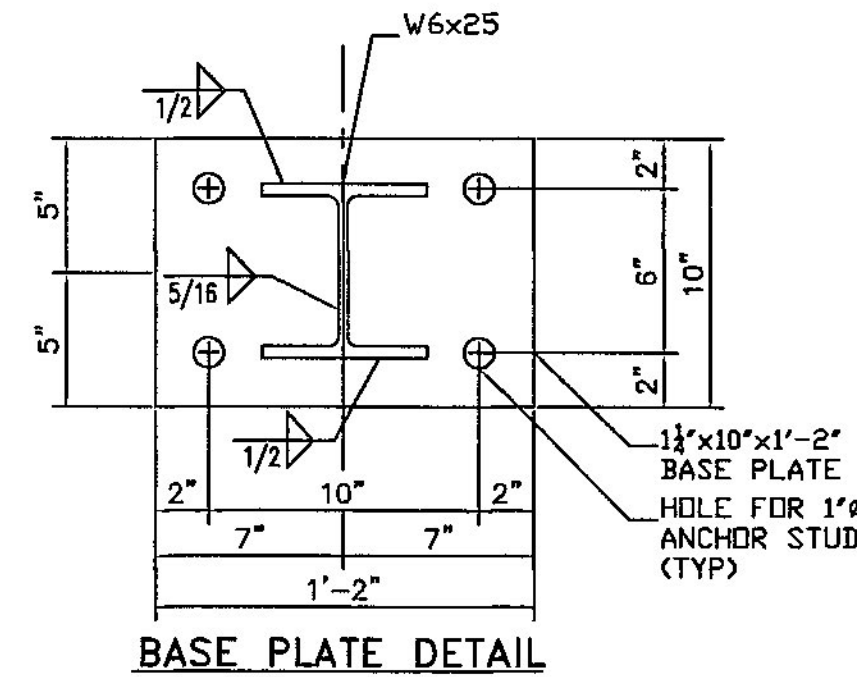



BASE PLATE DETAIL

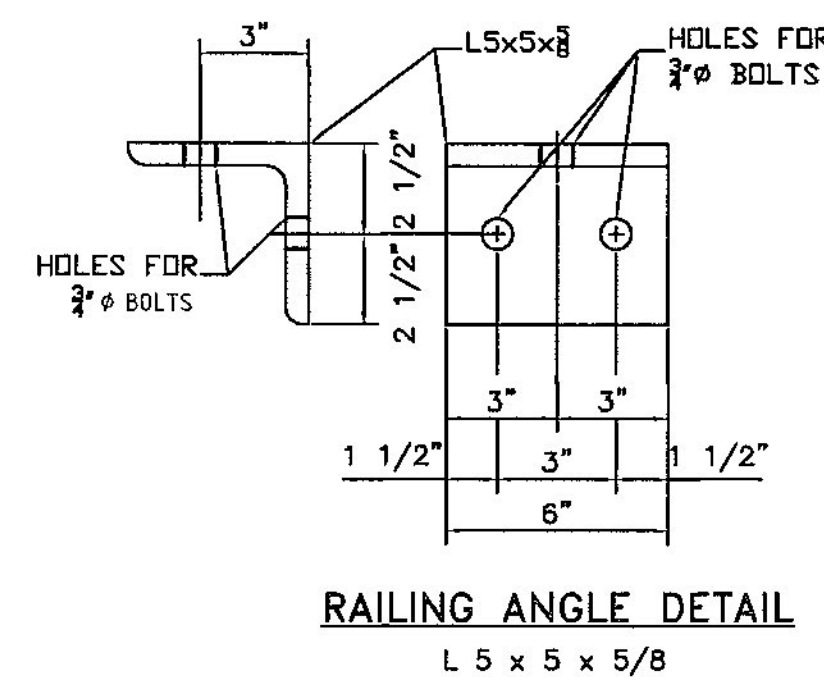



RAILING ANGLE DETAIL
L 5 x 5 x 5/8

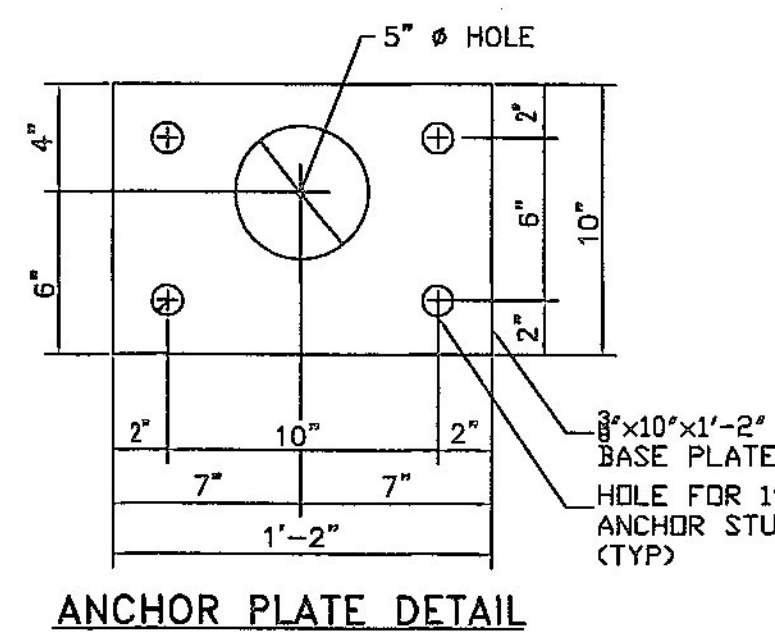

ANCHOR PLATE DETAIL

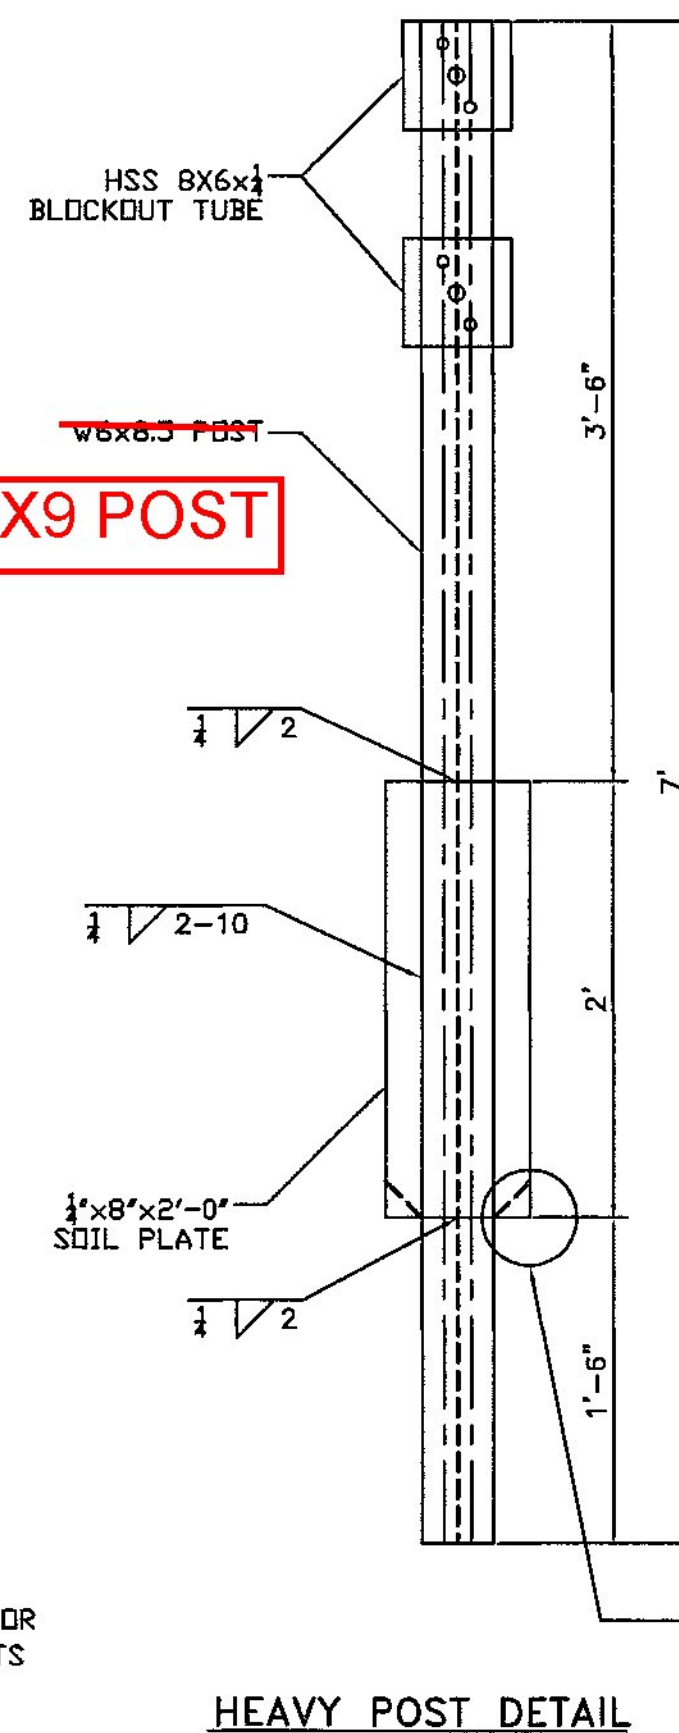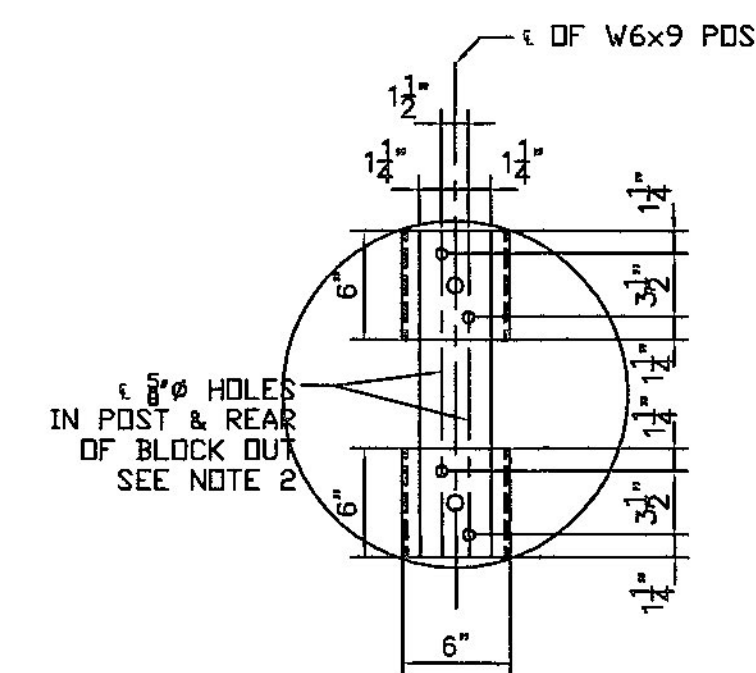

HEAVY POST DETAIL

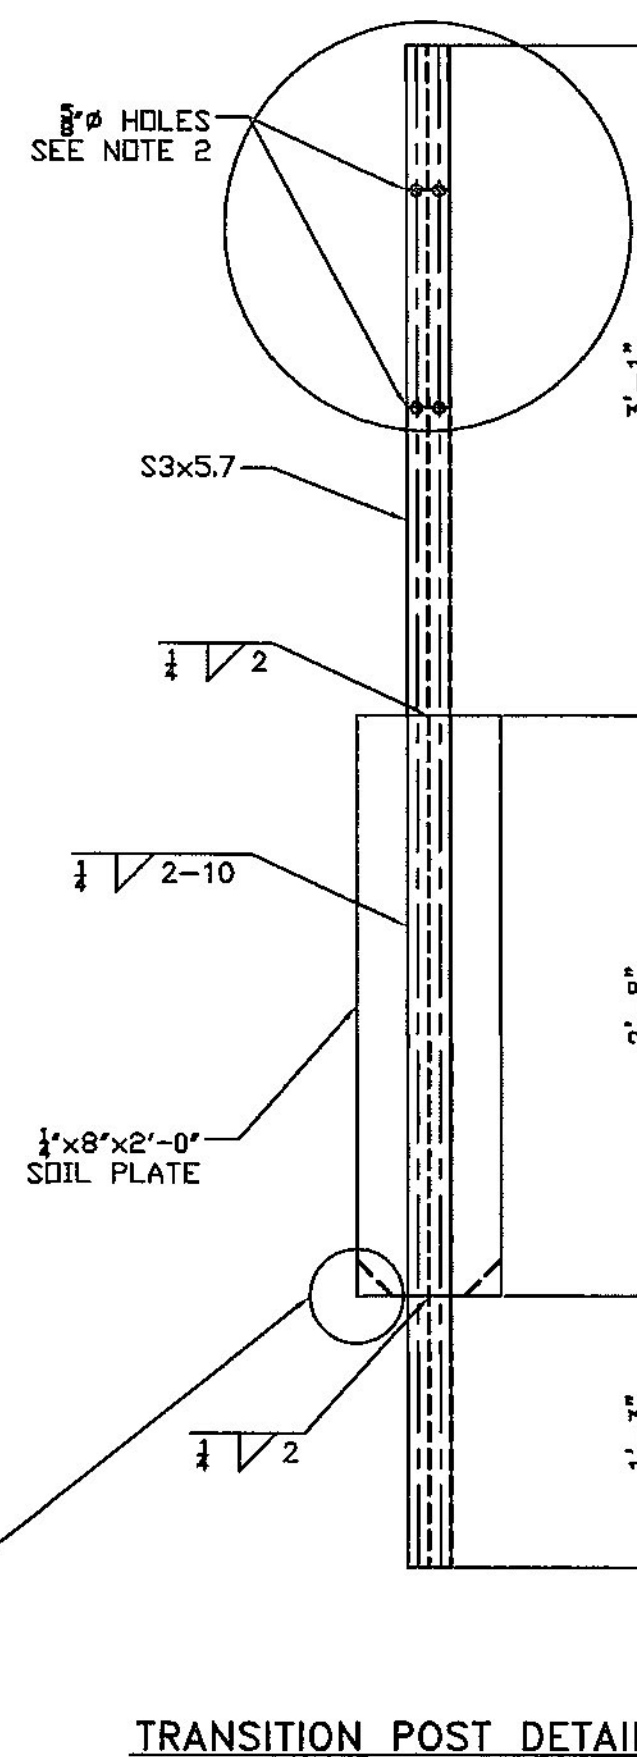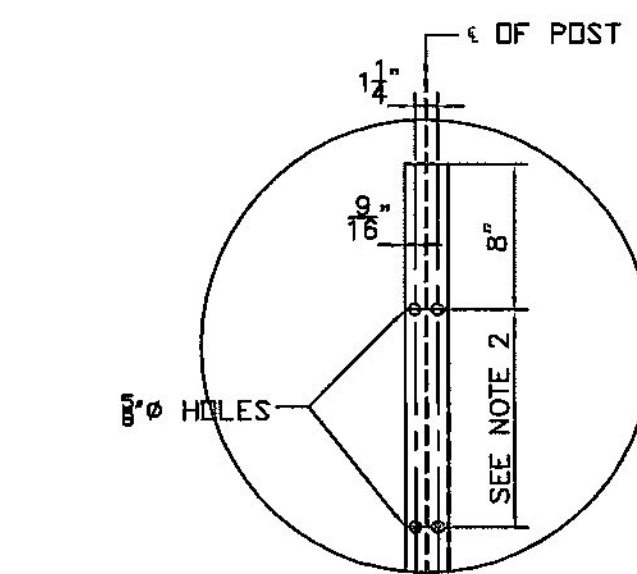

TRANSITION POST DETAIL

Vermont Agency of Transportation
RECEIVED
 CK'D BY M. Umberger OK'D BY C. Carlson
 July 2, 2013
 RESUBMIT Approved AsNoted
 BY C. Carlson DATE 07/03/13

HIGHWAY SAFETY CORP GLASTONBURY, CT 860-633-9445		CERTIFIED FABRICATOR
ITEM 525.335 3-RAIL BOX BEAM TOWN OF ST. JOHNSBURY COUNTY OF CALEDONIA US ROUTE 2 - PRINCIPAL ARTERIAL BRIDGE NO. 108 PROJECT NO. BRF 028-4(25)S		
GENERAL CONTRACTOR SUB CONTRACTOR LAFAYETTE	SHEET NO. 4 of 4	REC. JOB NO. 1911
DRAWN BJB	CHECKED DATE 06-01-13	SCALE NONE


Highway Safety Corporation

Glastonbury, CT


Welding Procedure Specification

Material specification A572 gr 50, A709 Gr 50
 Welding process Gas Metal Arc Welding (GMAW) Spray Transfer
 Manual, semi-automatic, or automatic Semi-Automatic
 Position of welding Flat (1F) or Horizontal (2F)
 Filler metal specification AWS A5.18
 Filler metal classification ER70S-6
 Electrode and manufacturer Lincoln Electric Lincoln Weld L-56
 Flux and manufacturer N/A
 Shielding gas 86% Argon / 14% CO2 Flow rate 35-45 CFM
 Single or multiple pass Single or Multiple
 Single or multiple arc Single
 Welding current DCEP
 Polarity Reverse - electrode positive
 Welding progression Stringers
 Root treatment clean base metal
 Preheat and interpass temperature base metal up to 3/4" (50°F) ; over 3/4 thru 1-1/2" (150°F) ; over 1-1/2" thru 2-1/2" (225°F)
 Postheat treatment None
 Electrode extension 3/4" ± 1/4"

WELDING PROCEDURE

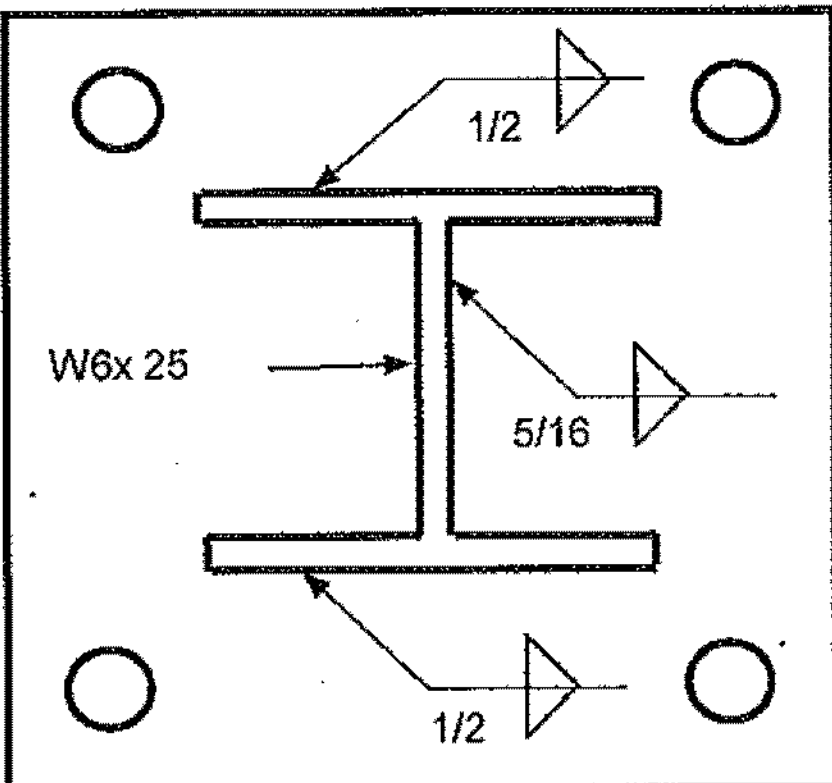Weld size	Pass no.	Electrode size	Welding parameters		Travel speed	Joint detail
			Amperes	Volts		
5/16"	1	0.062"	300 A ± 30	29 V ± 2	15 ipm ± 2	
1/2"	1 & 2	0.062"	↓	↓	15 ipm ± 2	
<p>Trans Received OK'd BY <u>JWC</u></p> <p style="font-size: 1.2em; font-weight: bold;">JUN 07 2013</p> <p>Resubmit APPROVED BY <u>[Signature]</u> DATE <u>6/11/13</u></p>						

This procedure may vary due to fabrication sequence, fit-up, pass size, etc. within the limitation of variables given in section 5 of latest edition AWS D1.5

WPS no. W-VTPEDPOST2 Fabricator Highway Safety Corporation
 Revision no. 0 Prepared By: Paul Radice  CWI 98070221
 Supporting PQR no. Pre-Qualified Date 06-04-13 QC1 EXP. 7/1/2013
 Project Name St. Johnsbury, VT Project Number BRF 028-4(25)S


Highway Safety Corporation

Glastonbury, CT

Welding Procedure Specification


Material specification ASTM A500 gr B
 Welding process Gas Metal Arc Welding (GMAW)
 Manual, semi-automatic, or automatic Semi-Automatic
 Position of welding Flat (1F) or Horizontal (2F)
 Filler metal specification AWS A5.18
 Filler metal classification ER70S-6
 Electrode and manufacturer Lincoln Electric Lincoln Weld L-56
 Flux and manufacturer N/A
 Shielding gas 86% Argon / 14% CO2 Flow rate 35-45 CFM
 Single or multiple pass Single
 Single or multiple arc Single
 Welding current DCEP
 Polarity Reverse - electrode positive
 Welding progression Stringers
 Root treatment clean base metal
 Preheat and interpass temperature base metal up to 3/4" (50°F)
 Postheat treatment None
 Electrode extension 3/4" ± 1/4"

WELDING PROCEDURE

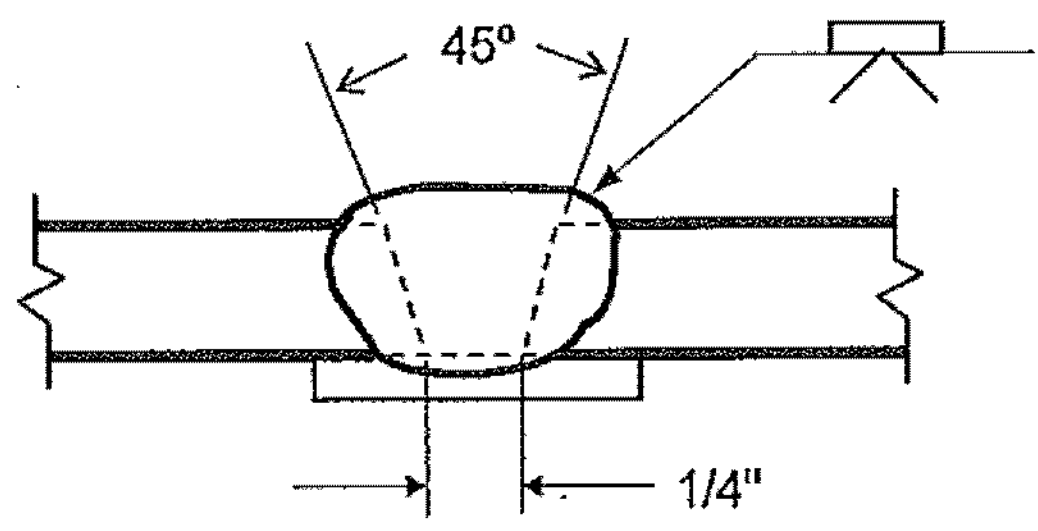Weld size	Pass no.	Electrode size	Welding parameters		Travel speed	Joint detail
			Amperes	Volts		
	1	0.063"	300 A ± 30	29 V ± 2	15 lpm ± 2	B-U2a-GF 
		CK'D	V Trans Received OK'd BY <i>Juc</i>			
			JUN 07 2013			
		Resubmit BY	APPROVED DATE <i>6/11/13</i>			

This procedure may vary due to fabrication sequence, fit-up, pass size, etc. within the limitation of variables given in section 5 of latest edition AWS D1.1

WPS no. W-VGWBCK Fabricator Highway Safety Corporation
 Revision no. 0 Prepared By: Paul Radice
 Supporting PQR no. Pre-Qualified Date 06-04-13
 Project Name St. Johnsbury, VT Project Number BRF 028-4(25)S

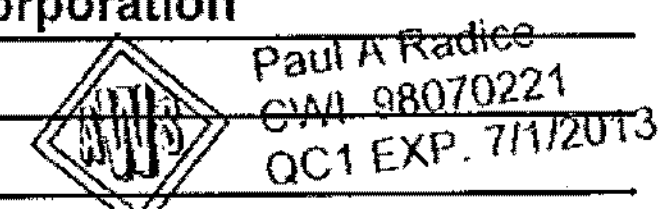


Highway Safety Corporation

Glastonbury, CT

Welding Procedure Specification


Material specification ASTM A36, A709 Gr 36, A500 gr B, A709 gr 50, A572 gr 50, A992
 Welding process Gas Metal Arc Welding (GMAW) Spray Transfer
 Manual, semi-automatic, or automatic Semi-Automatic
 Position of welding Flat (1F) or Horizontal (2F)
 Filler metal specification AWS A5.18
 Filler metal classification ER70S-6
 Electrode and manufacturer Lincoln Electric Lincoln Weld L-56
 Flux and manufacturer N/A
 Shielding gas 86% Argon / 14% CO2 Flow rate 35-45 CFM
 Single or multiple pass Single or Multiple
 Single or multiple arc Single
 Welding current DCEP
 Polarity Reverse - electrode positive
 Welding progression Stringers
 Root treatment clean base metal
 Preheat and interpass temperature base metal up to 3/4" (50°F) ; over 3/4 thru 1-1/2" (150°F) : over 1-1/2" thru 2-1/2" (225°F)
 Postheat treatment None
 Electrode extension 3/4" ± 1/4"


WELDING PROCEDURE

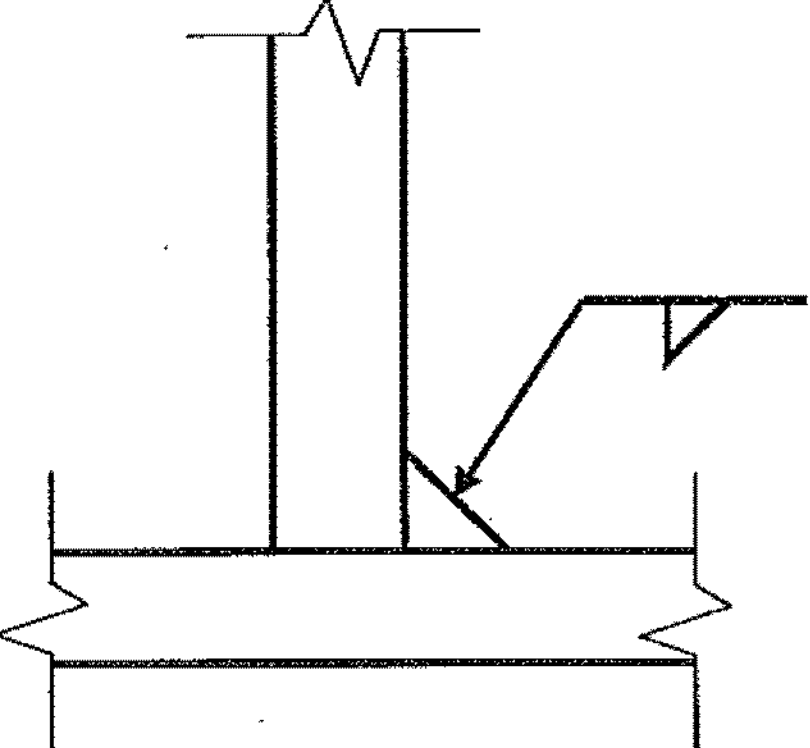Weld size	Pass no.	Electrode size	Welding parameters		Travel speed	Joint detail
			Amperes	Volts		
1/4"	1	0.062"	300 A ± 30	29 V ± 2	15 lpm ± 2	TYPICAL ALL FILLET WELDS 
CK'D _____ JUN 07 2013 resubmt _____ BY _____			Vtrans Received OK'D BY <i>JWC</i> APPROVED DATE <i>6/11/13</i>			

This procedure may vary due to fabrication sequence, fit-up, pass size, etc. within the limitation of variables given in section 5 of latest edition AWS D1.1 / D1.5

WPS no. W-1911A Fabricator Highway Safety Corporation
 Revision no. 0 Prepared By: Paul Radice *QC1*
 Supporting PQR no. Pre-Qualified Date 06-04-13
 Project Name St. Johnsbury, VT Project Number BRF 028-4(25)S

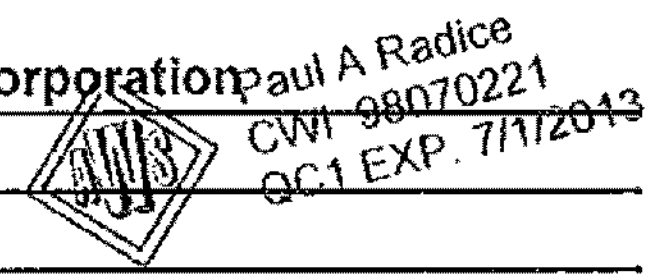

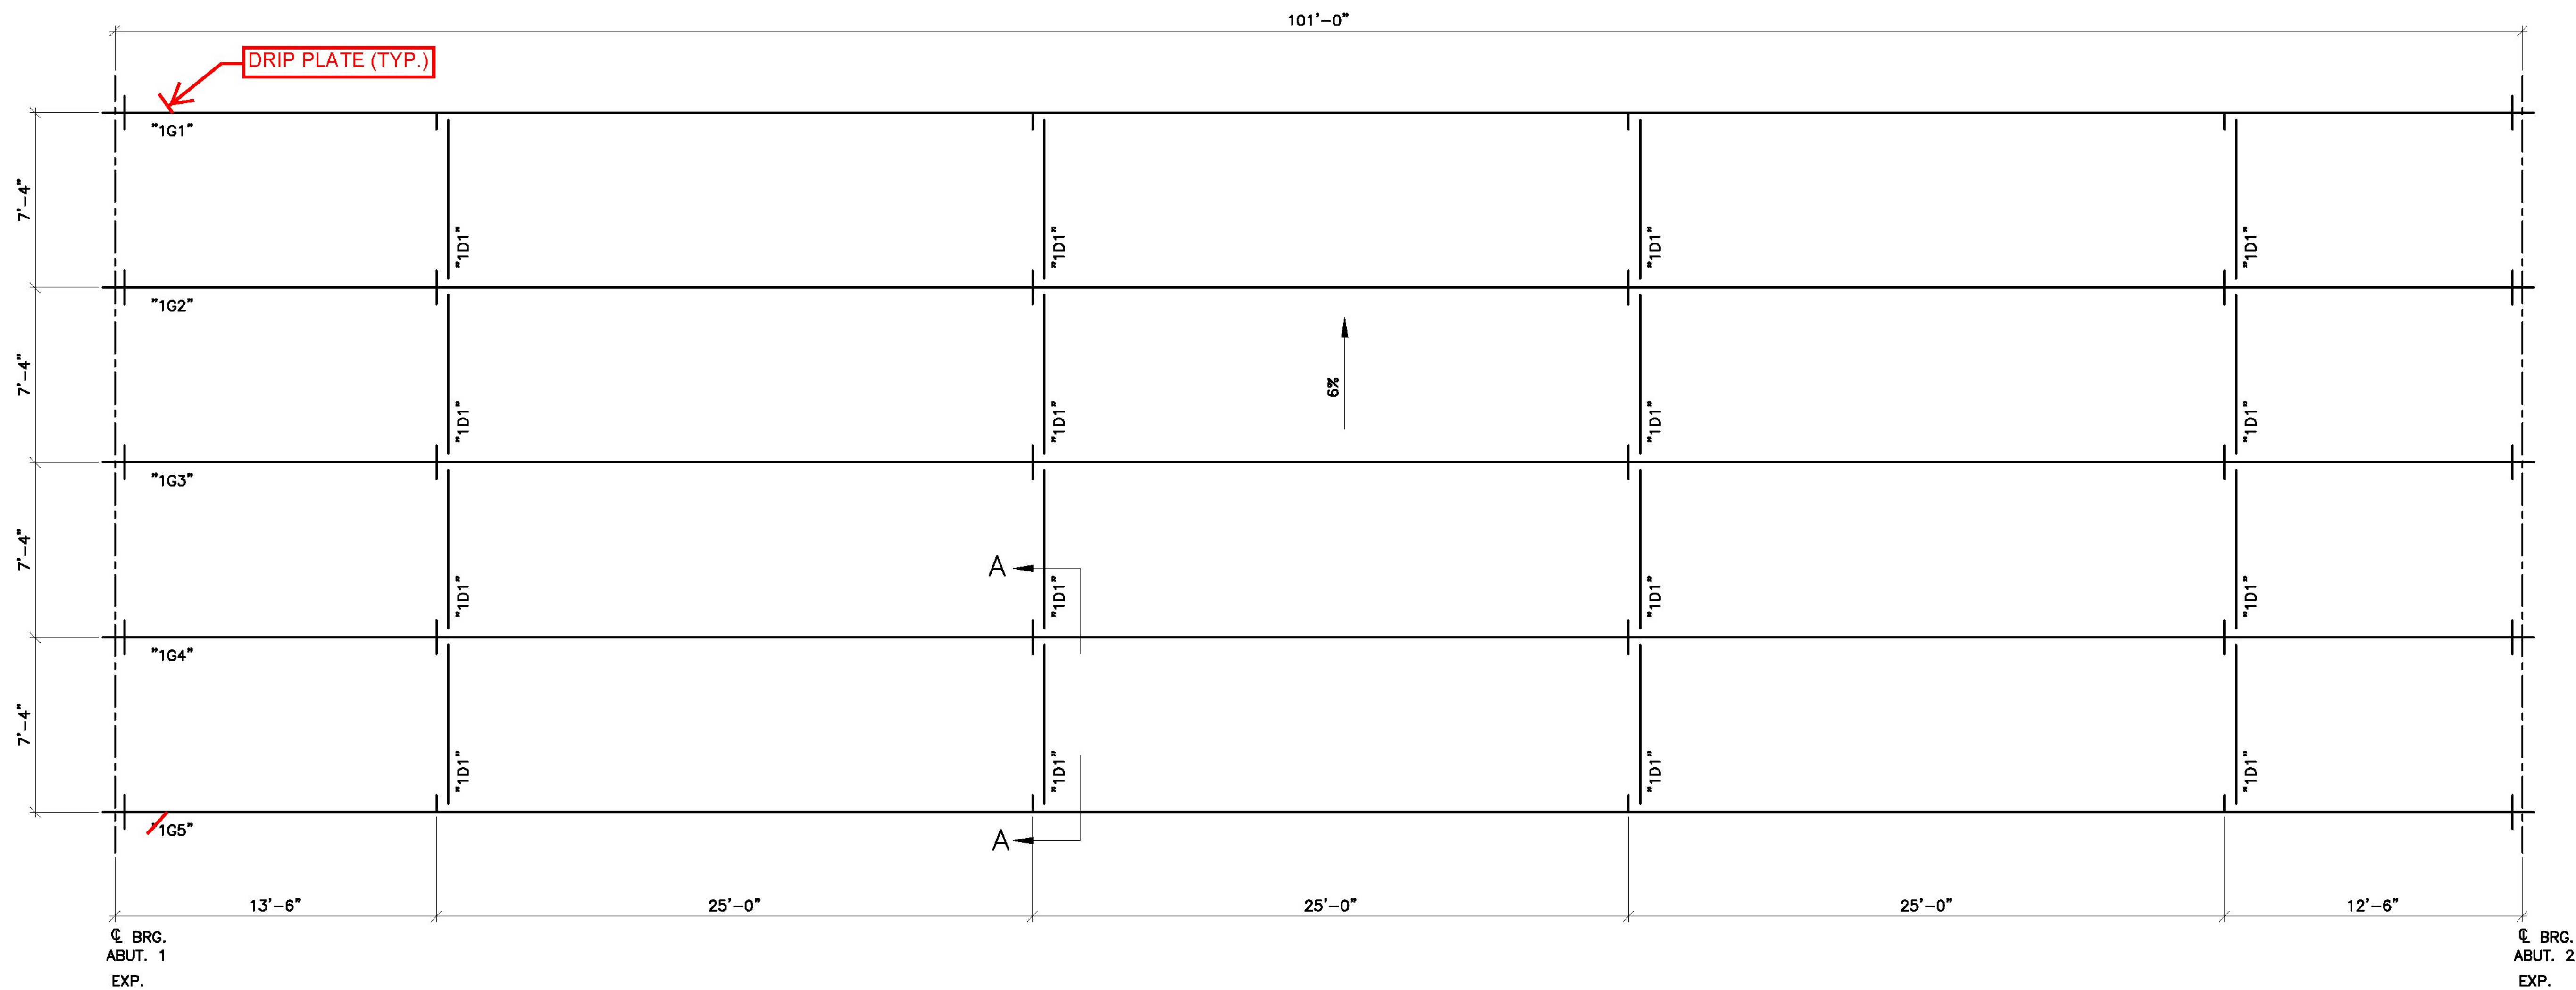

FRAMING PLAN

COATING SYSTEM: NEPCOAT LIST "A"

PRIMER - CARBOZINC 11HS INORGANIC ZINC PRIMER, 2-6 MILS DFT
 INTERMEDIATE - CARBOGUARD 893 EPOXY INTERMEDIATE, 3-6 MILS DFT
 TOP COAT - CARBOHANE 133 LH ALIPHATIC POLYURETHANE, 3-6 MILS DFT
 COLOR CHIP #20059 (BROWN)

GENERAL NOTES:


ALL MATERIALS AND CONSTRUCTION SHALL CONFORM TO STATE OF VERMONT AGENCY OF TRANSPORTATION'S STANDARD SPECIFICATIONS FOR CONSTRUCTION, DATED 2011, AND ITS LATEST REVISIONS, AND THE AASHTO LRFD BRIDGE DESIGN SPECIFICATIONS, 5TH EDITION AND ITS LATEST REVISIONS.

ALL MATERIAL SHALL CONFORM TO AASHTO M270 (ASTM A709) GRADE 50. ALL MATERIAL NOTED * SHALL MEET THE CHARPY V-NOTCH TESTING REQUIREMENTS OF ZONE 2, H FREQUENCY: 15 FT.-LB AT 40° F. NDT MUST BE ACCORDING TO ANSI/AASHTO/AWS D1.5, SECTION 6

ALL BOLTS SHALL BE ~~CONFORMING TO ASTM A325 WITH RO-CAP TESTING AND MECHANICALLY GALVANIZED.~~


7/8" Ø BOLTS IN 1 5/16" Ø HOLES.

TYPE 1

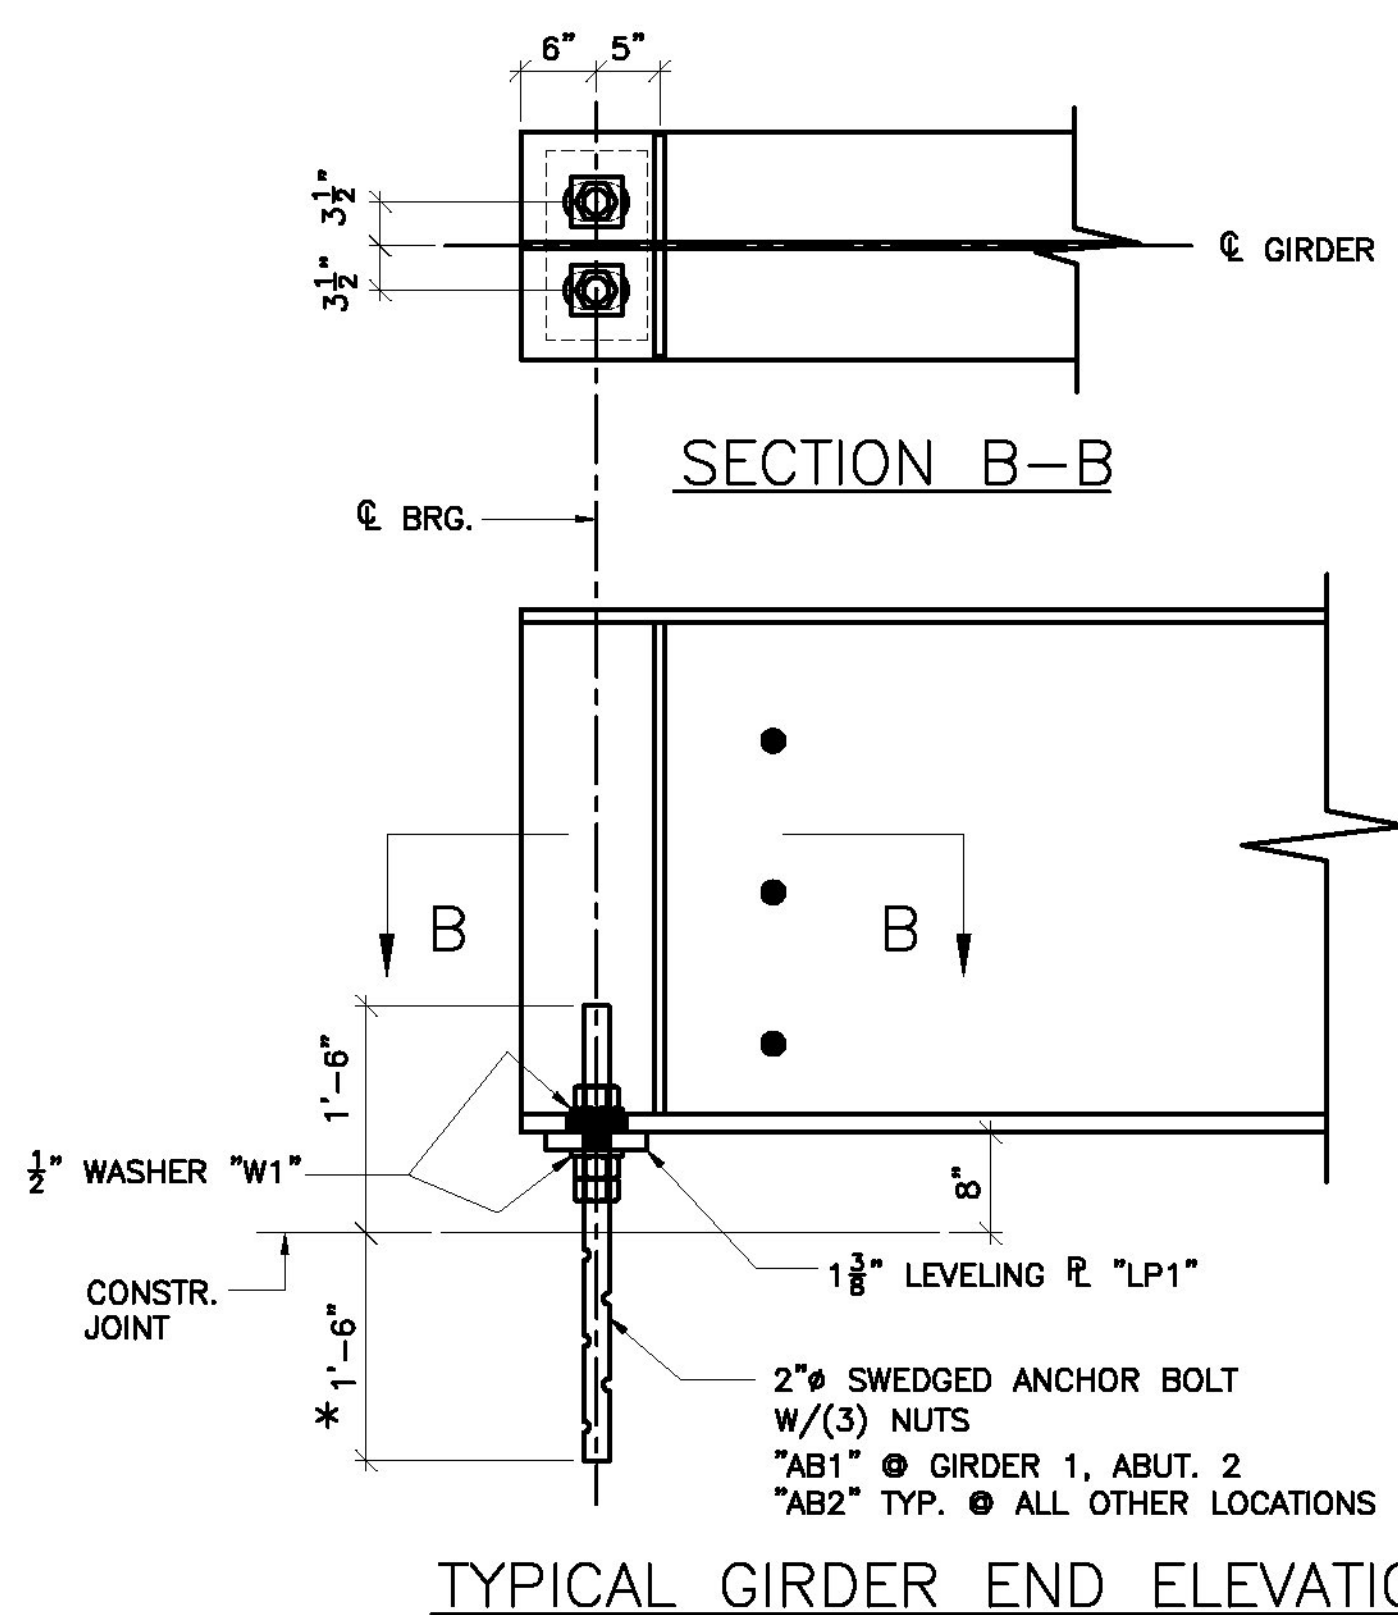

TYPICAL GIRDER END ELEVATION

* 15" ● GIRDER 1, ABUT. 2

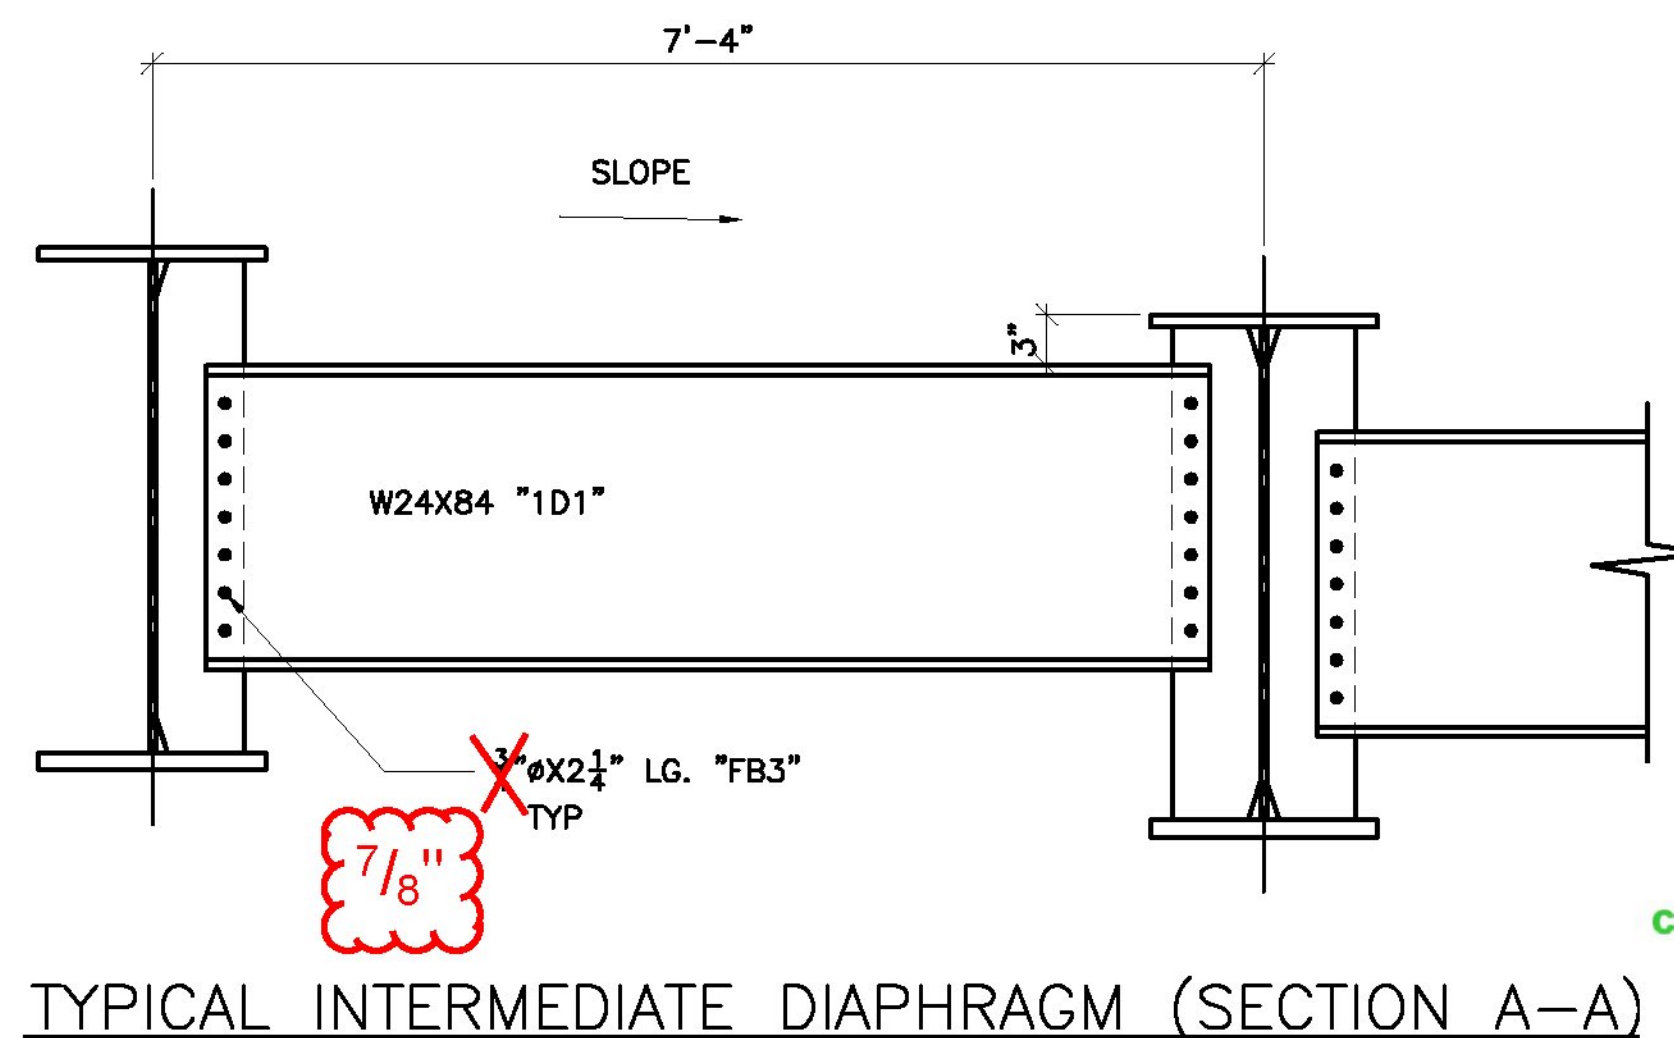

TYPICAL INTERMEDIATE DIAPHRAGM (SECTION A-A)




Vermont Agency of Transportation
RECEIVED

CK'D BY D. PETERSON OK'D BY C. CARLSON

08/20/2012

RESUBMIT APPROVED AS NOTED
 BY C. CARLSON DATE 12/14/2012


FINISH	MATERIAL	SEE DETAIL SHEETS			
HOLES					
ELECTRODES					
WELDS	PER WPS				
SURFACE PREP					
REVISIONS					
NO	DATE	DESCRIPTION	BY		
ADVANCED RESOURCES & CONST. ENTERPRISES, INCORPORATED P.O. BOX 120 KINGFIELD, ME. 04947 PHONE: (207) 265-2846 - FAX: (207) 265-4054					
DRAFTER	JAC	FRAMING PLAN		PROJECT NO.	
DATE	11/12/12	STATE OF VERMONT, TOWN OF JOHNSBURY, BRIDGE NO. 108		BRF 028-4(2)S	
CHECKED	MTD	COUNTY OF CALEDONIA, US ROUTE 2 - PRINCIPAL ARTERIAL		DWG. NO.	
JOB#	12-175	WINTERSSET, INC.		E1	

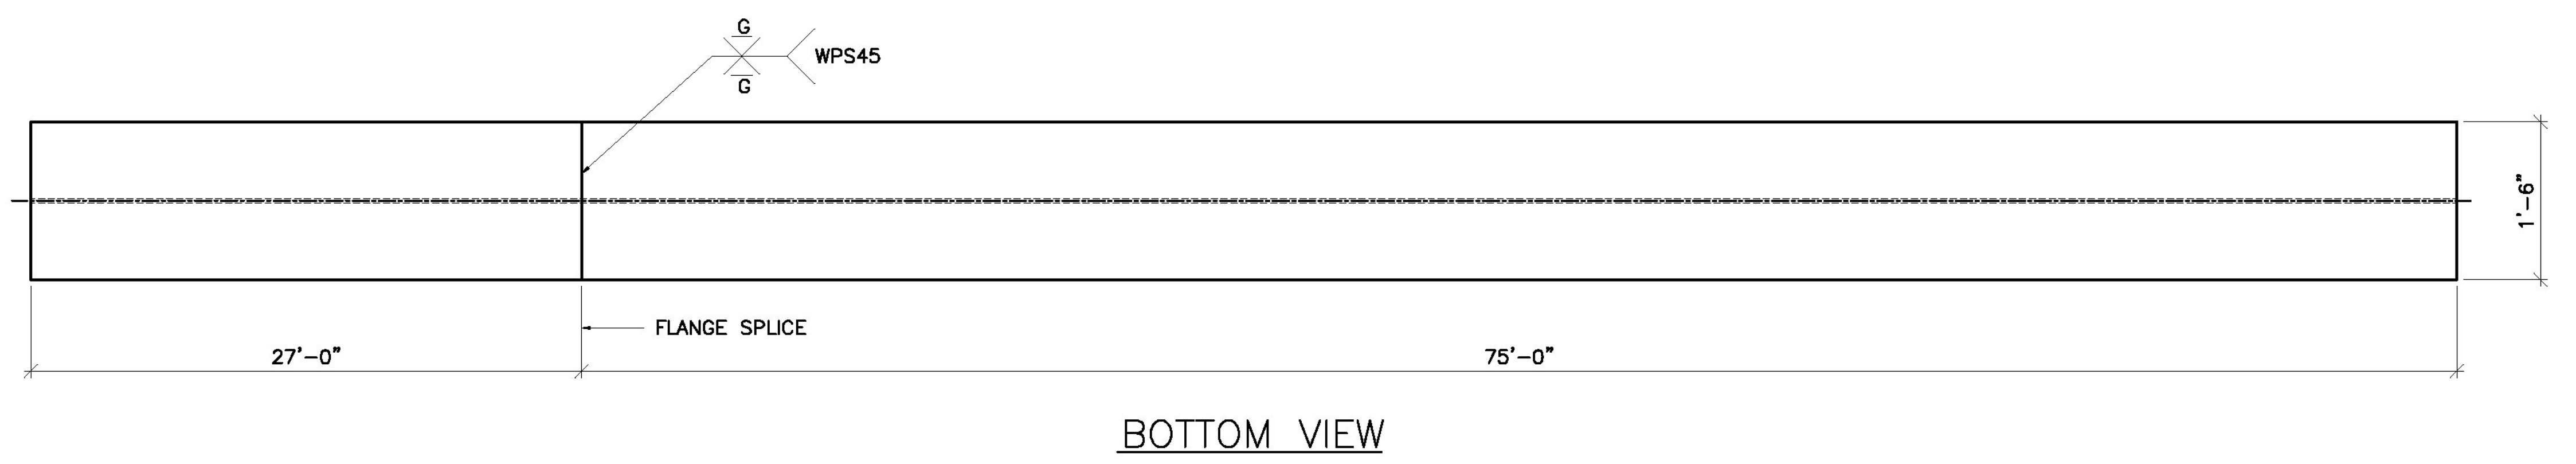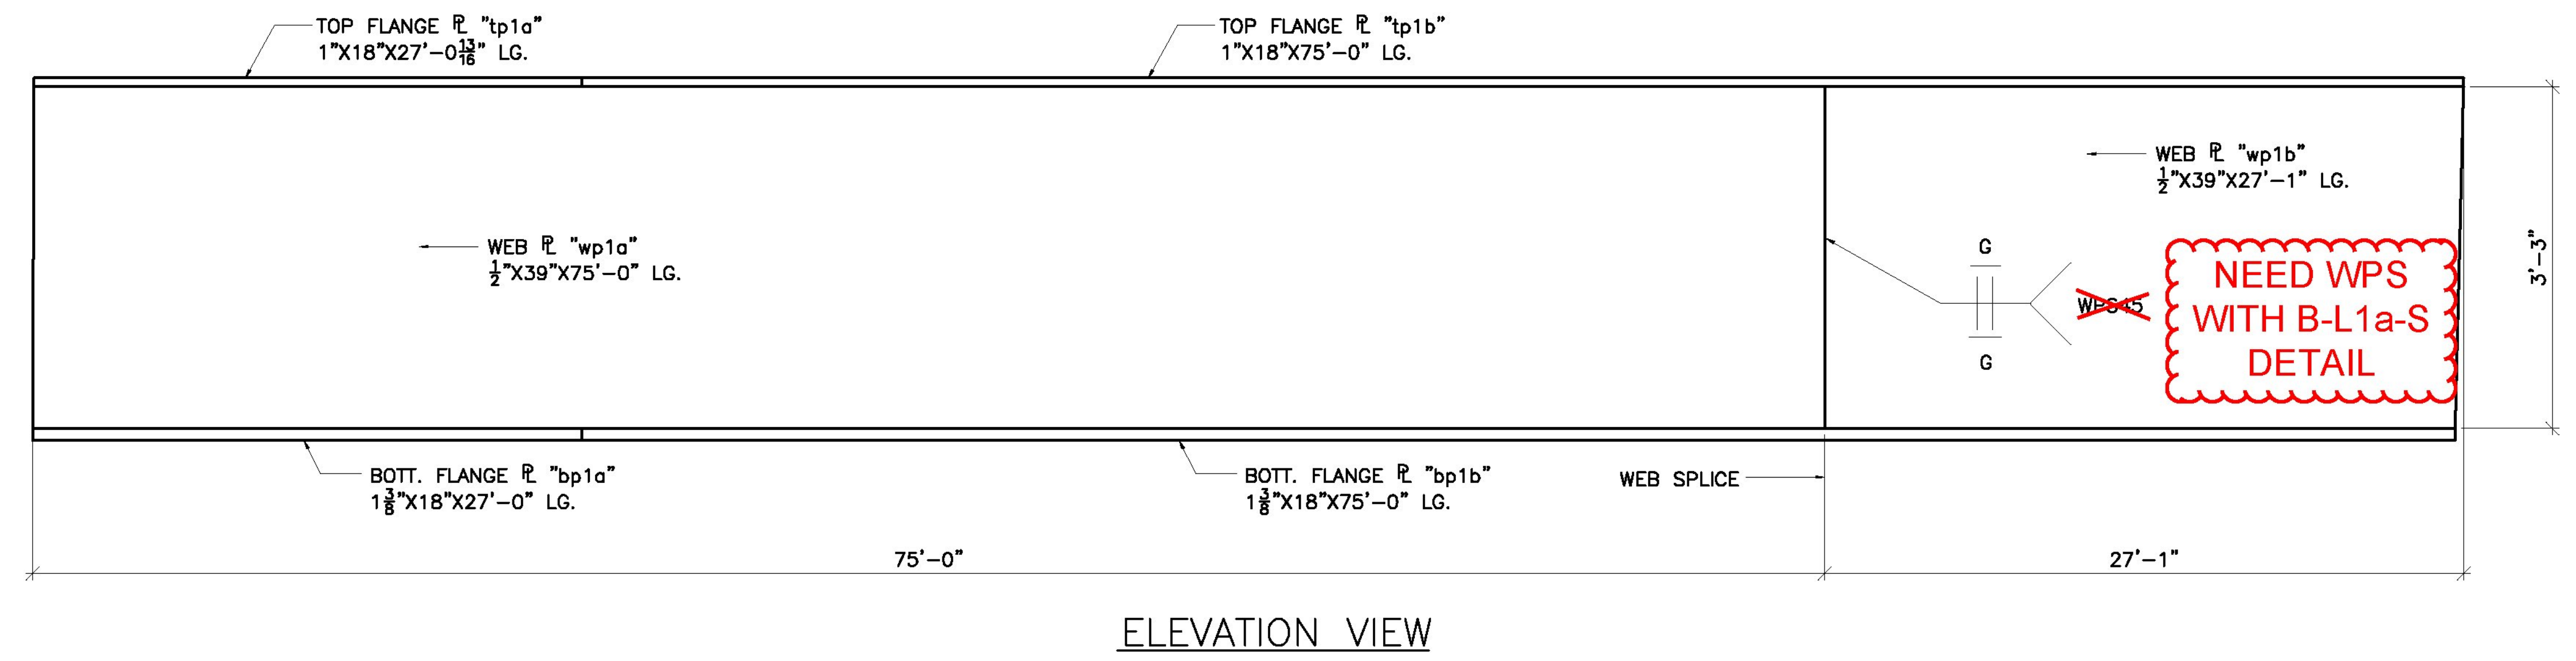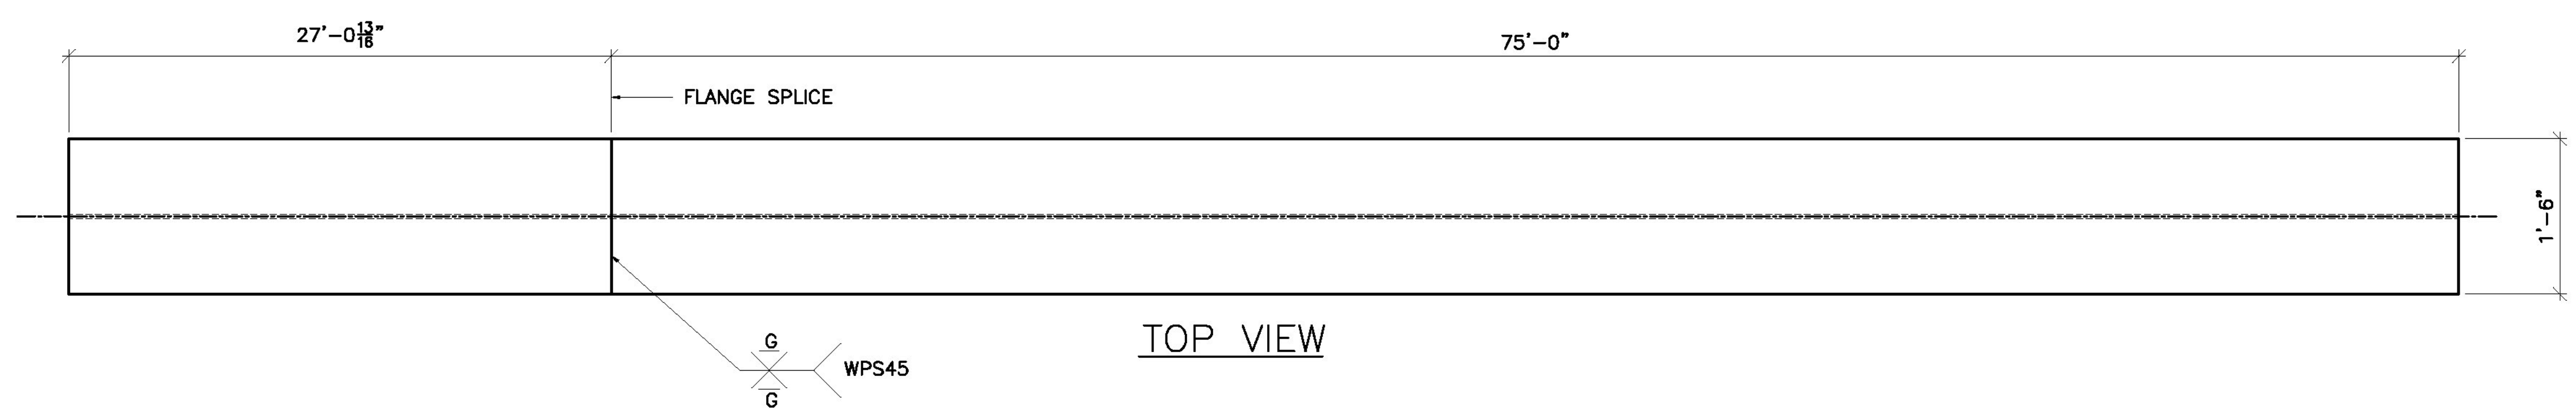


FINISH				
MATERIAL	ASHTO M270 (ASTM A709) GRADE 50			
HOLES	15/16" U.O.N.			
ELECTRODES				
WELDS	PER WPS			
SURFACE PREP				
		NO	DATE	DESCRIPTION
REVISIONS				
		ADVANCED RESOURCES & CONST. ENTERPRISES, INCORPORATED P.O. BOX 120 KINGFIELD, ME. 04947 PHONE: (207) 265-2646 - FAX: (207) 265-4054		
DRAFTER	JAC	FLANGE & WEB SHOP SPLICES		PROJECT NO.
DATE	11/12/12	STATE OF VERMONT, TOWN OF JOHNSBURY, BRIDGE NO. 106		BRF 028-4(25)S
CHECKED	JS	COUNTY OF CALEDONIA, US ROUTE 2 - PRINCIPAL ARTERIAL		DWG. NO.
JOB #	12-175	G.C. WINTERSET, INC.		S1

Vermont Agency of Transportation
RECEIVED
 CK'D BY D. PETERSON OK'D BY C. CARLSON
 08/20/2012
 RESUBMIT _____ APPROVED AS NOTED
 BY C. CARLSON DATE 12/14/2012


J.A.C. DRAFTING/S&B/12/12

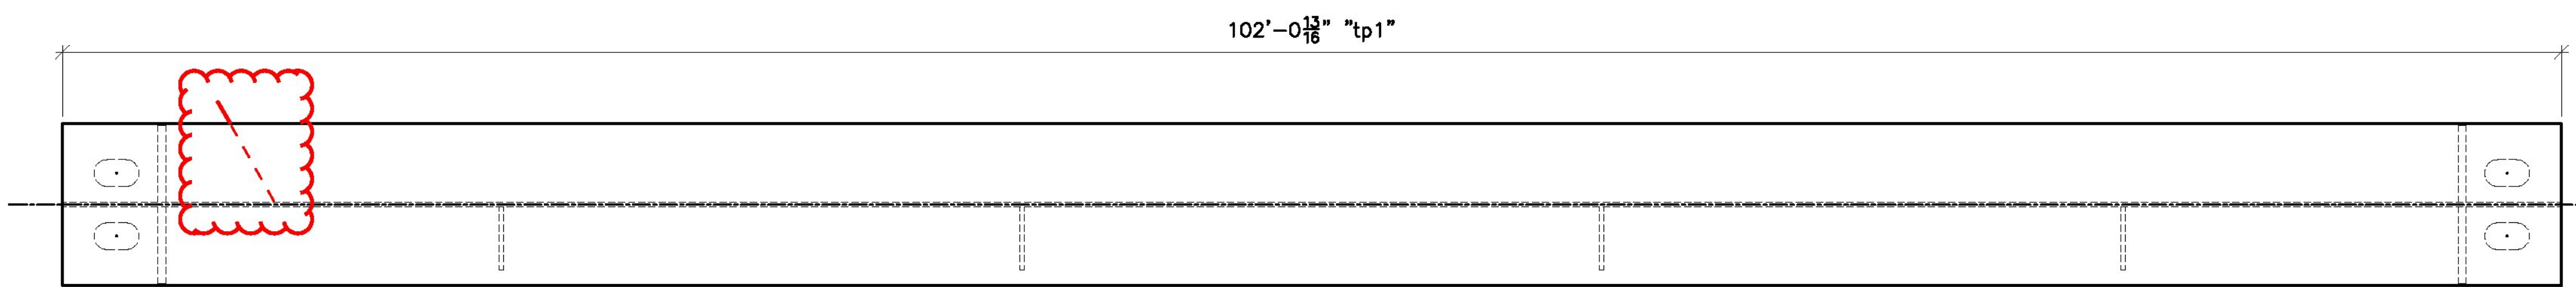



TOP VIEW

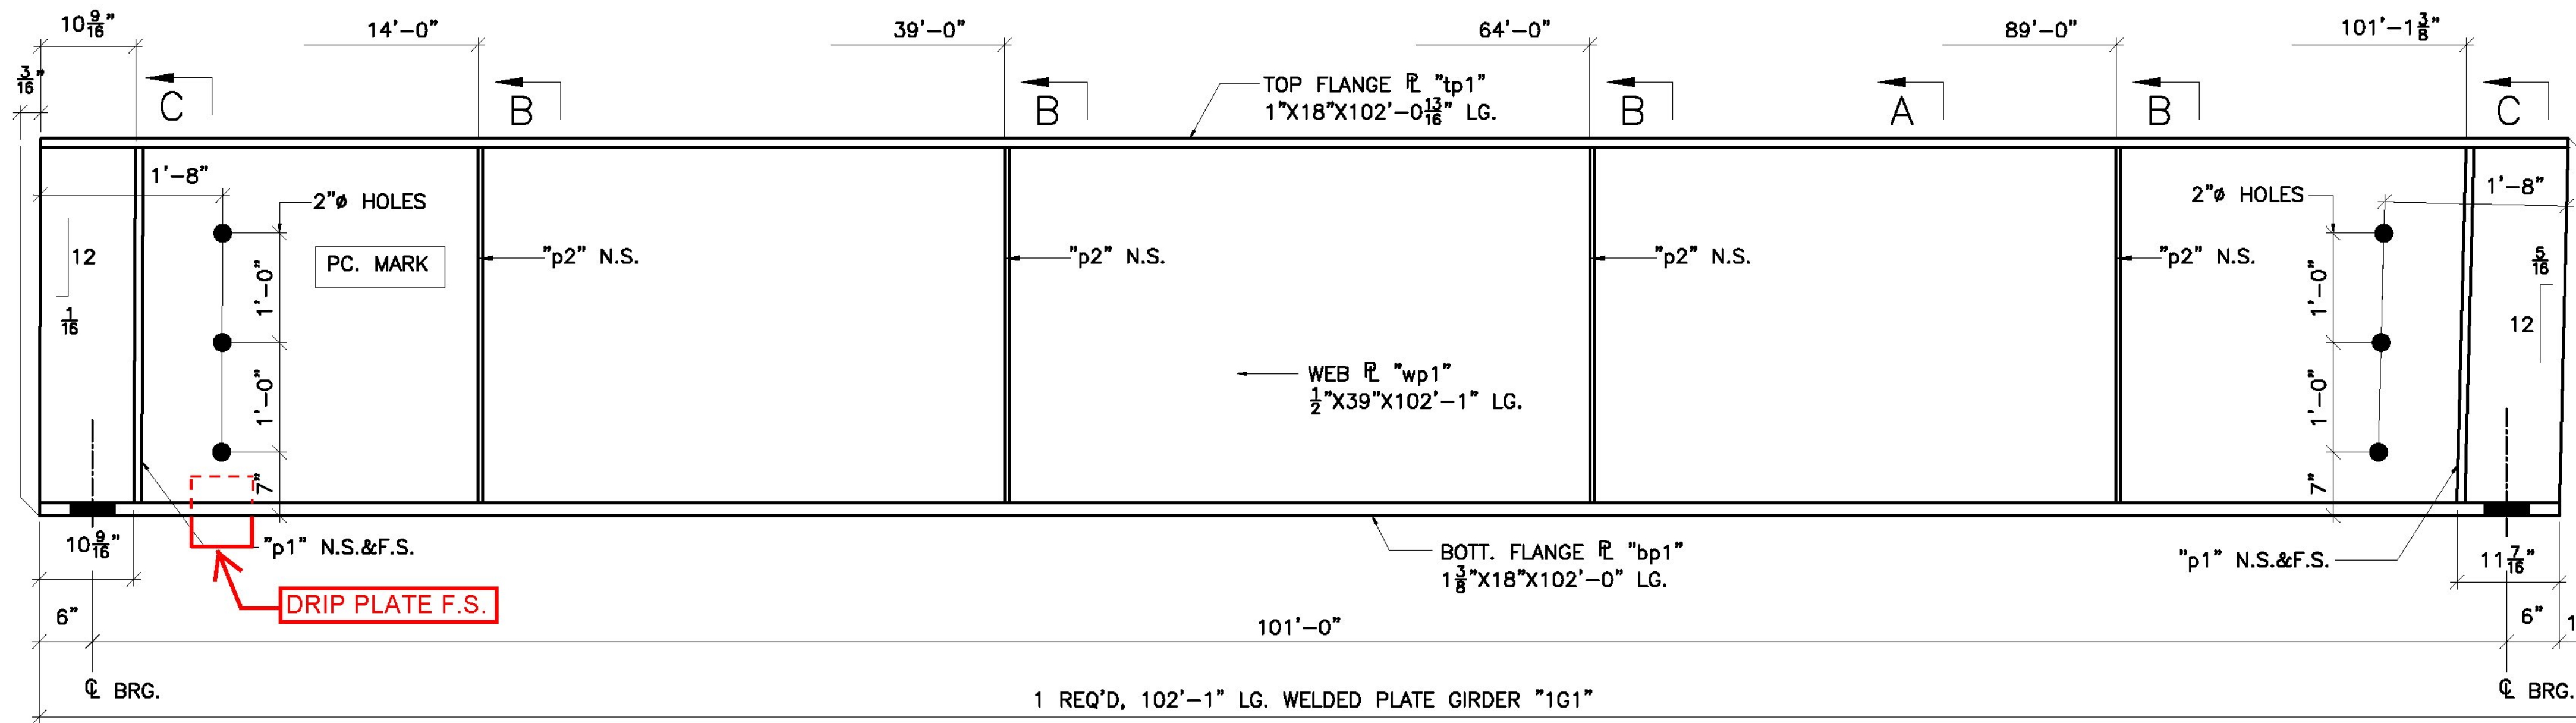

1 REQ'D, 102'-1" LG. WELDED PLATE GIRDER "1G1"

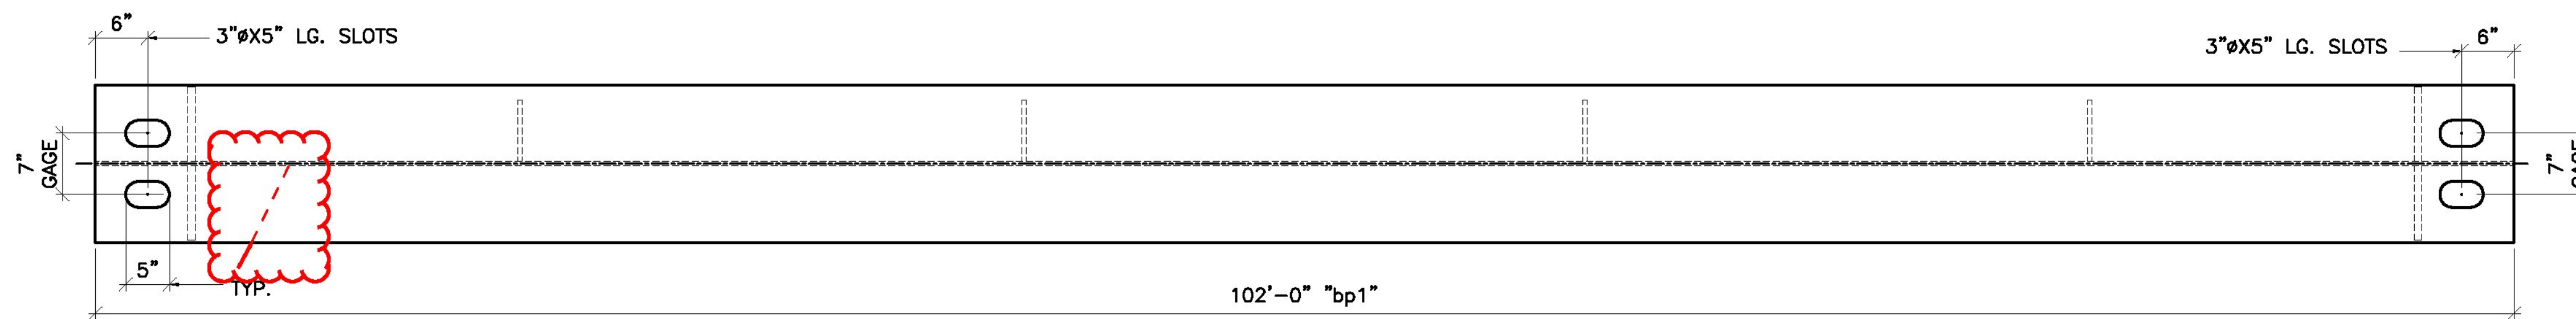

BOTTOM VIEW

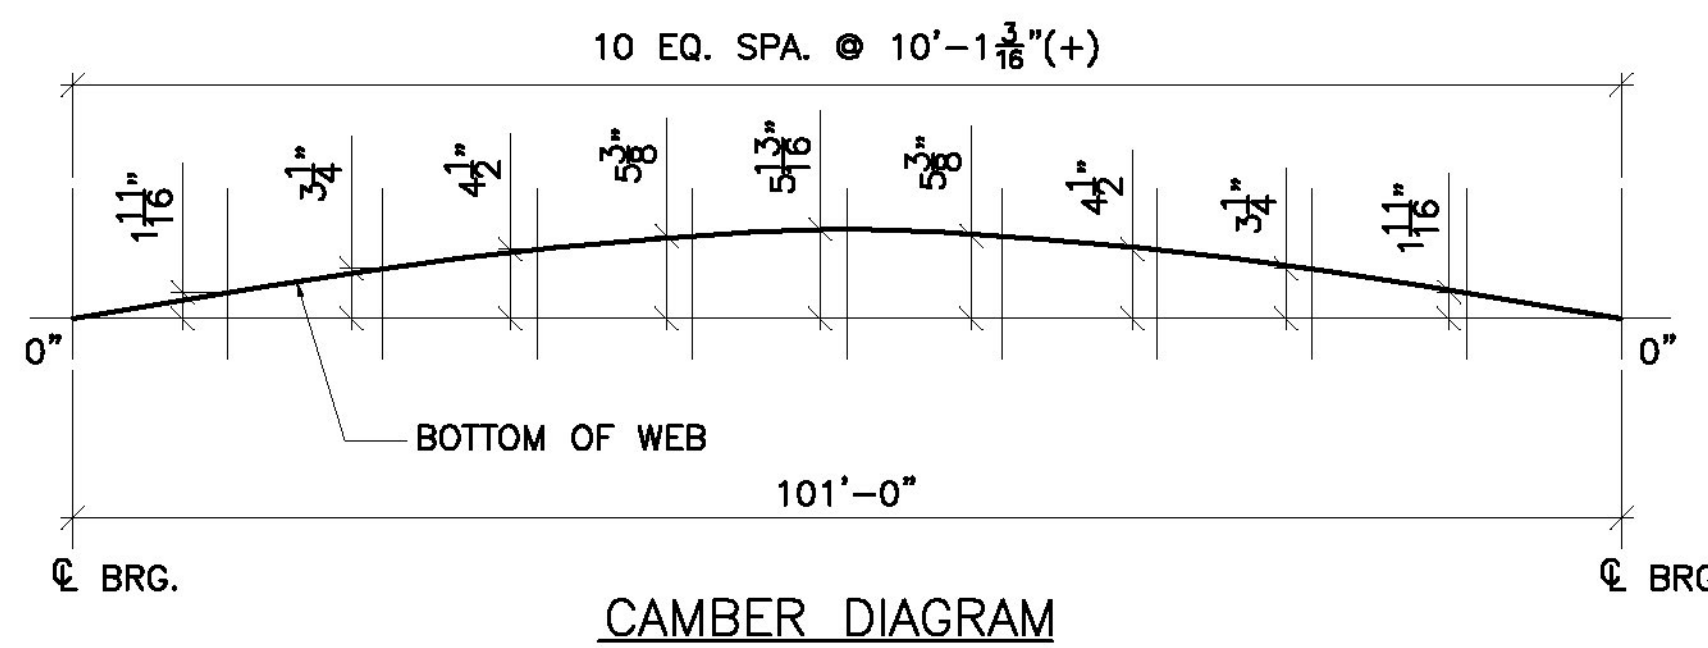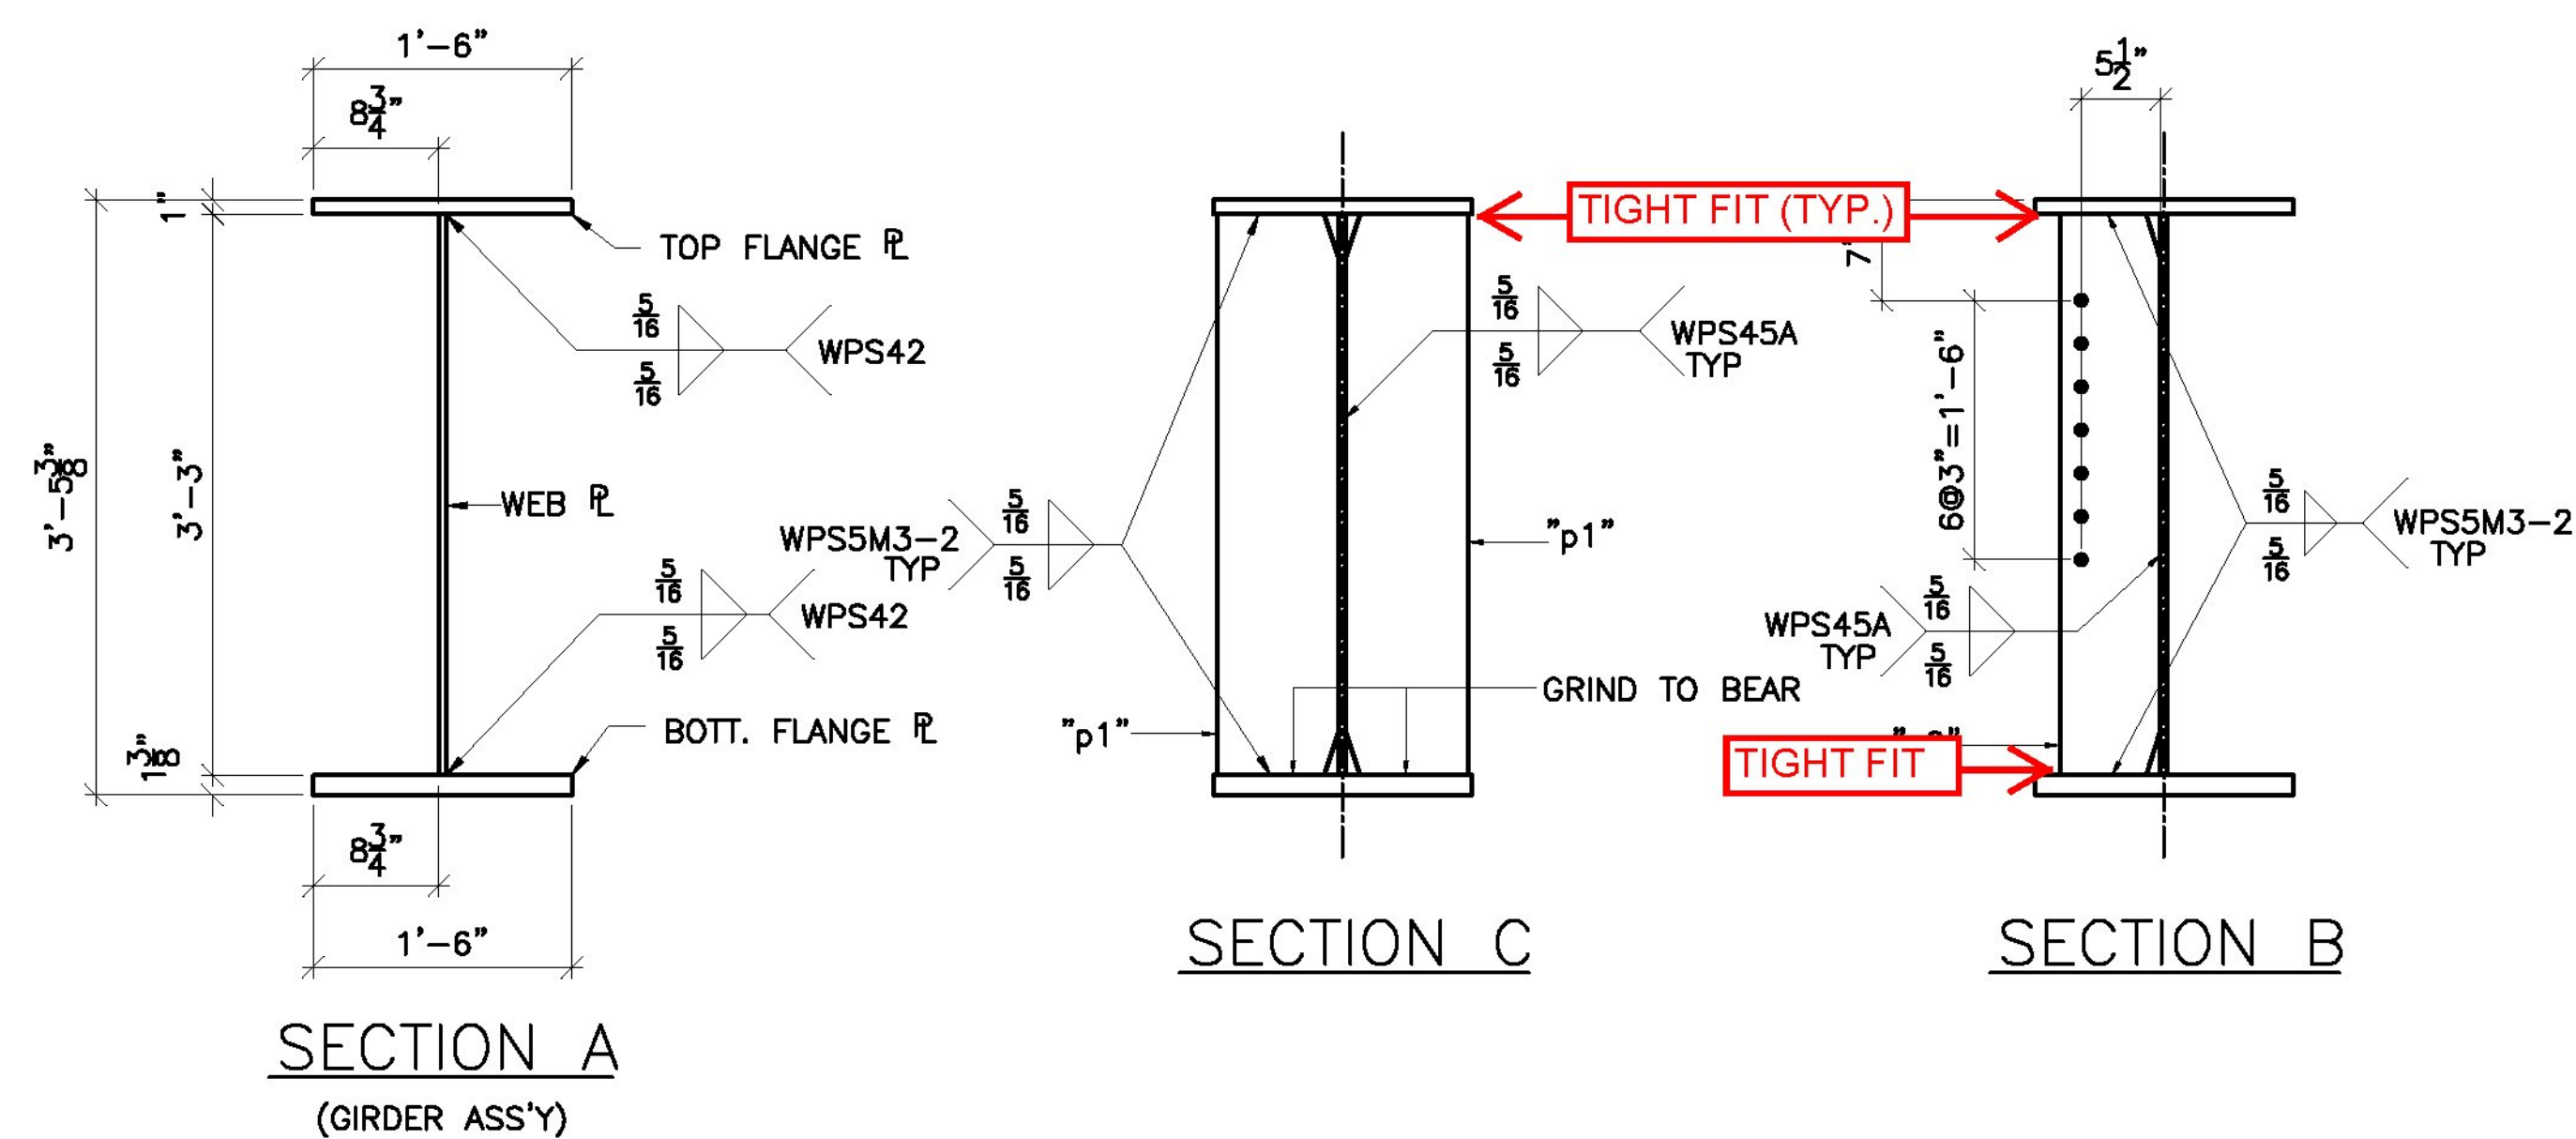

BILL OF MATERIAL

SHIP	SHIP MARK	NO. PCS.	PIECE MARK	DESCRIPTION	LENGTH	REMARKS	WT.
1	1G1			BRIDGE GIRDER			
		1	wp1	R 1/2X39	102'-1	*	6769
		1	tp1	R 1X18	102'-0 13/16	*	8252
		1	bp1	R 1 3/8X18	102'-0	*	8581
		4	p1	SEE SHT. 6			
		4	p2	SEE SHT. 6			

GIRDER WT: 22,091

* CVN (SEE NOTES ON DWG. NO. E1)

Vermont Agency of Transportation
RECEIVED

CK'D BY D. PETERSON OK'D BY C. CARLSON


08/20/2012

RESUBMIT APPROVED AS NOTED
BY C. CARLSON DATE 12/14/2012


SEE SHEET 6 FOR DETAILS NOT SHOWN

FINISH		REVISIONS	
MATERIAL	AASHTO M270 (ASTM A708) GRADE 50	NO.	DATE
HOLES	15/16" U.O.N.		
ELECTRODES			
WELDS	PER WPS		
SURFACE PREP			


	ADVANCED RESOURCES & CONST. ENTERPRISES, INCORPORATED P.O. BOX 120 KINGFIELD, ME. 04947 PHONE: (207) 285-2848 - FAX: (207) 285-4054	PROJECT NO. BR# 028-4(25)S
	DRAFTER JAC DATE 11/12/12 CHECKED JS JOB # 12-175	GIRDER DETAILS STATE OF VERMONT, TOWN OF JOHNSBURY, BRIDGE NO. 108 COUNTY OF CALEDONIA, US ROUTE 2 - PRINCIPAL ARTERIAL G.C. WINTERSET, INC.

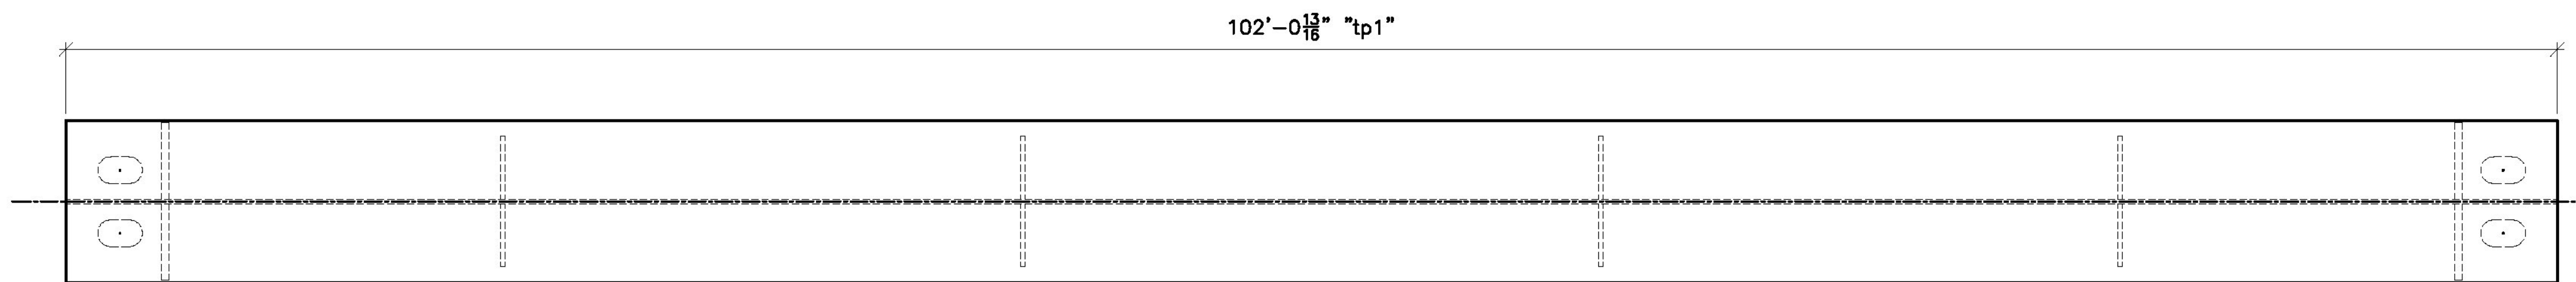


TOP VIEW

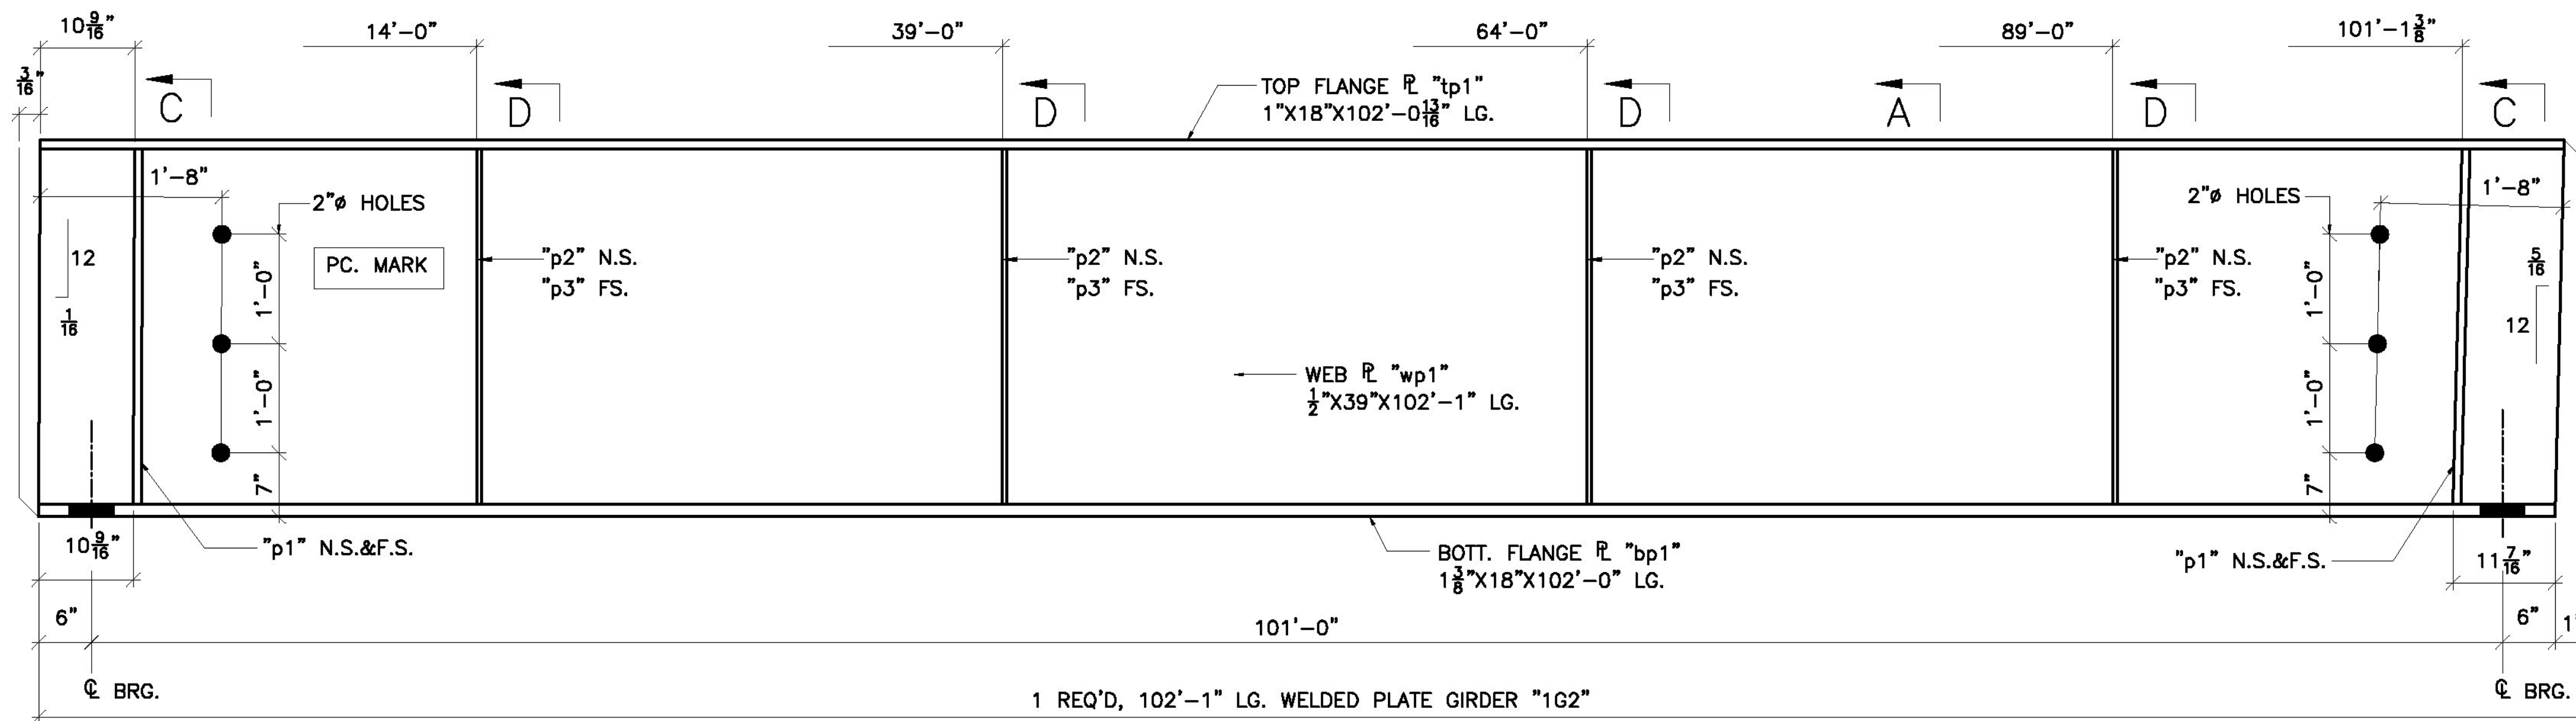


1 REQ'D, 102'-1" LG. WELDED PLATE GIRDER "1G2"

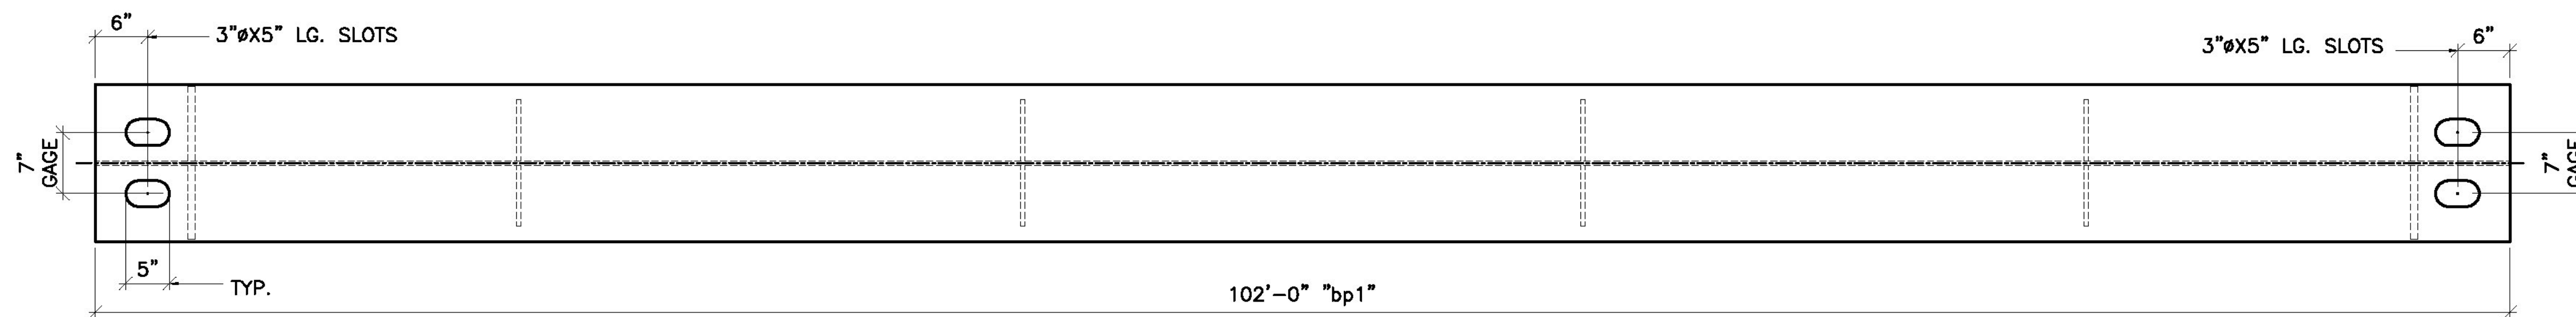

BOTTOM VIEW

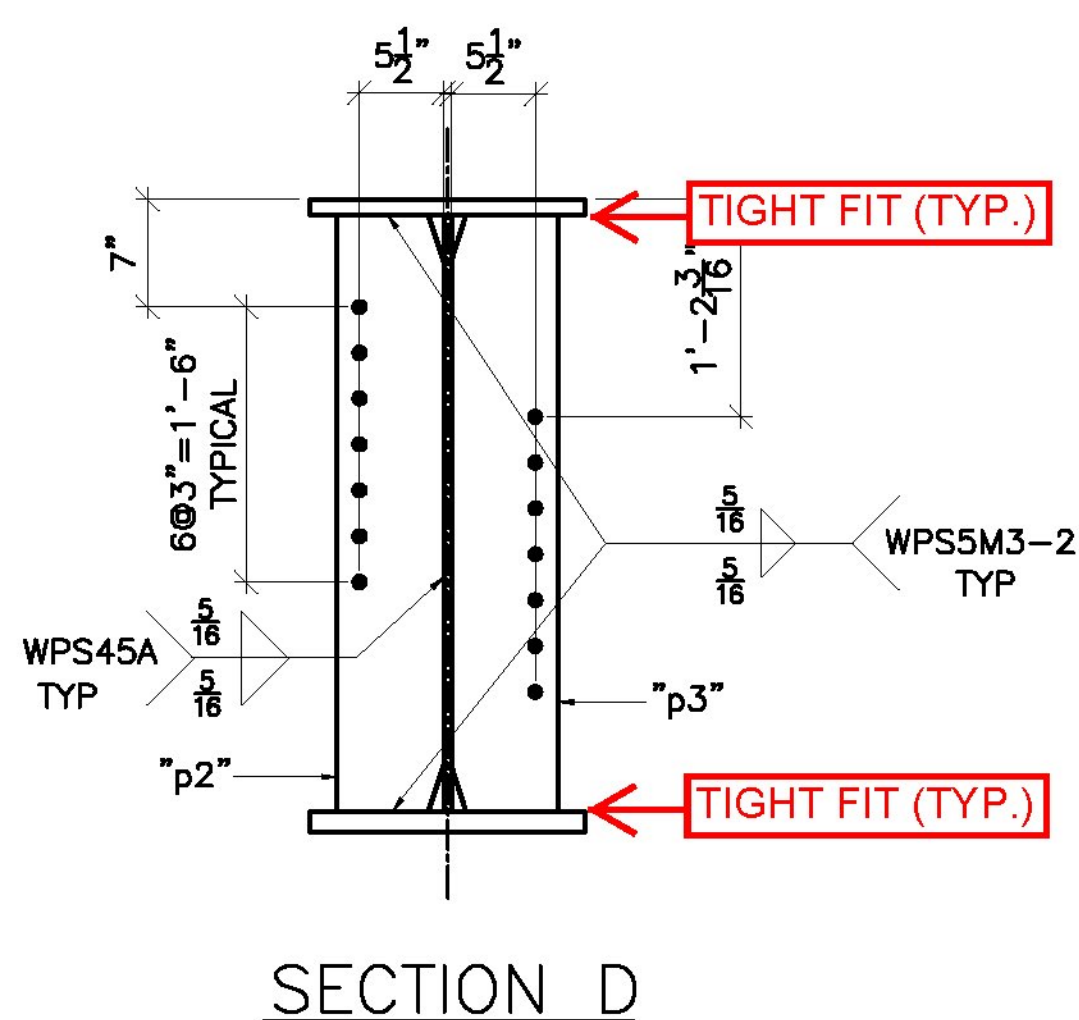

SECTION D

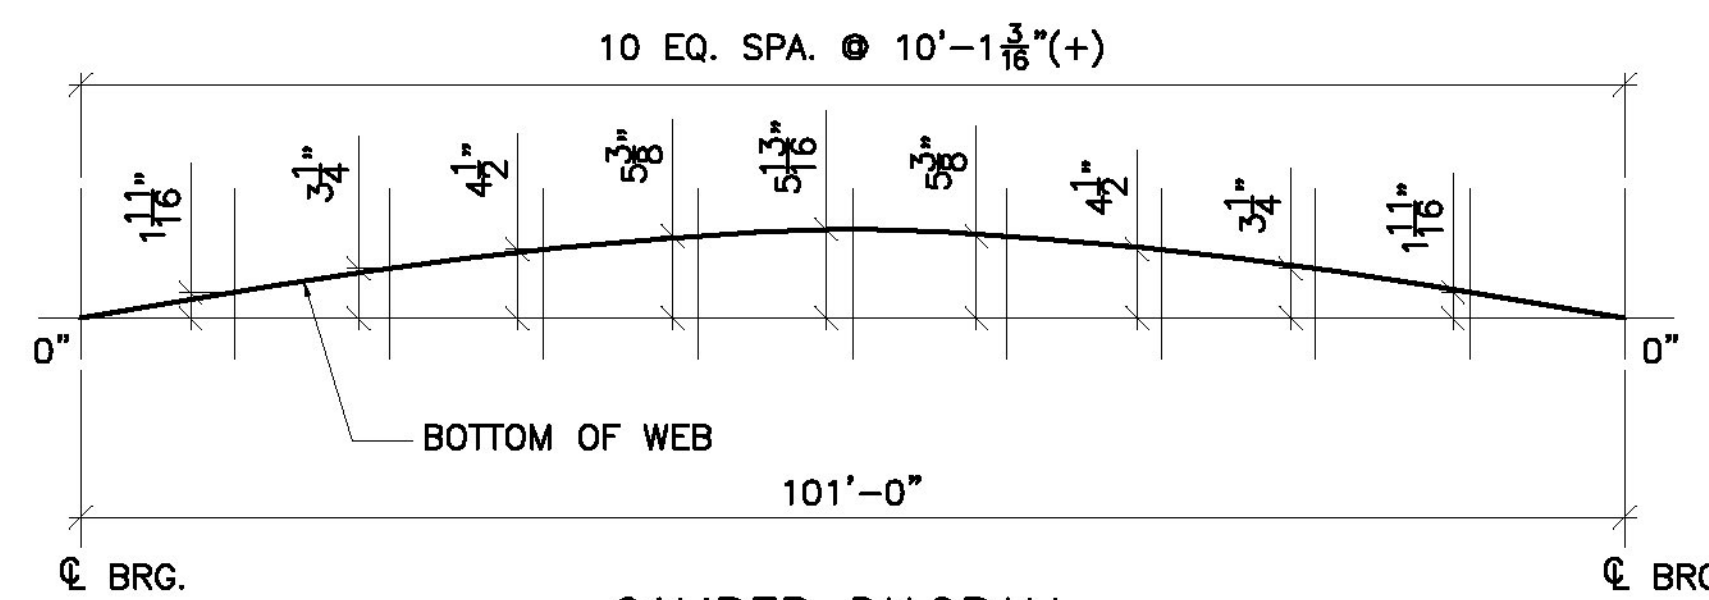

CAMBER DIAGRAM

BILL OF MATERIAL

SHIP	SHIP MARK	NO. PCS.	PIECE MARK	DESCRIPTION	LENGTH	REMARKS	WT.
1	1G2			BRIDGE GIRDER			
		1	wp1	R. 1/2 X 39	102'-1	*	6769
		1	tp1	R. 1 X 18	102'-0 1/8	*	6252
		1	bp1	R. 1 3/8 X 18	102'-0	*	8591
		4	p1	SEE SHT. 6			
		4	p2	SEE SHT. 6			
		4	p3	SEE SHT. 6			

GIRDER WT: 22,244

* CVN (SEE NOTES ON DWG. NO. E1)

Vermont Agency of Transportation
RECEIVED


CK'D BY D. PETERSON OK'D BY C. CARLSON

08/20/2012


RESUBMIT _____ APPROVED AS NOTED
BY C. CARLSON DATE 12/14/2012

SEE SHEET 1 FOR SECTION A & C
SEE SHEET 6 FOR DETAILS NOT SHOWN


FINISH		NO.		DATE		DESCRIPTION		BY	
MATERIAL		ASHTO M270 (ASTM A709) GRADE 50							
HOLES		15/16" U.O.N.							
ELECTRODES		PER WPS							
WELDS		PER WPS							
SURFACE PREP									
REVISIONS									
ADVANCED RESOURCES & CONST. ENTERPRISES, INCORPORATED P.O. BOX 120 KINGFIELD, ME. 04947 PHONE: (207) 265-2646 - FAX: (207) 265-4054									
DRAFTER		JAC		PROJECT NO.		BRF 028-4(25)S			
DATE		11/12/12		STATE OF VERMONT, TOWN OF JOHNSBURY, BRIDGE NO. 106		COUNTY OF CALEDONIA, US ROUTE 2 - PRINCIPAL ARTERIAL			
CHECKED		JS		G.C.		WINTERSSET, INC.		DWG. NO.	
JOB #		12-175						2	

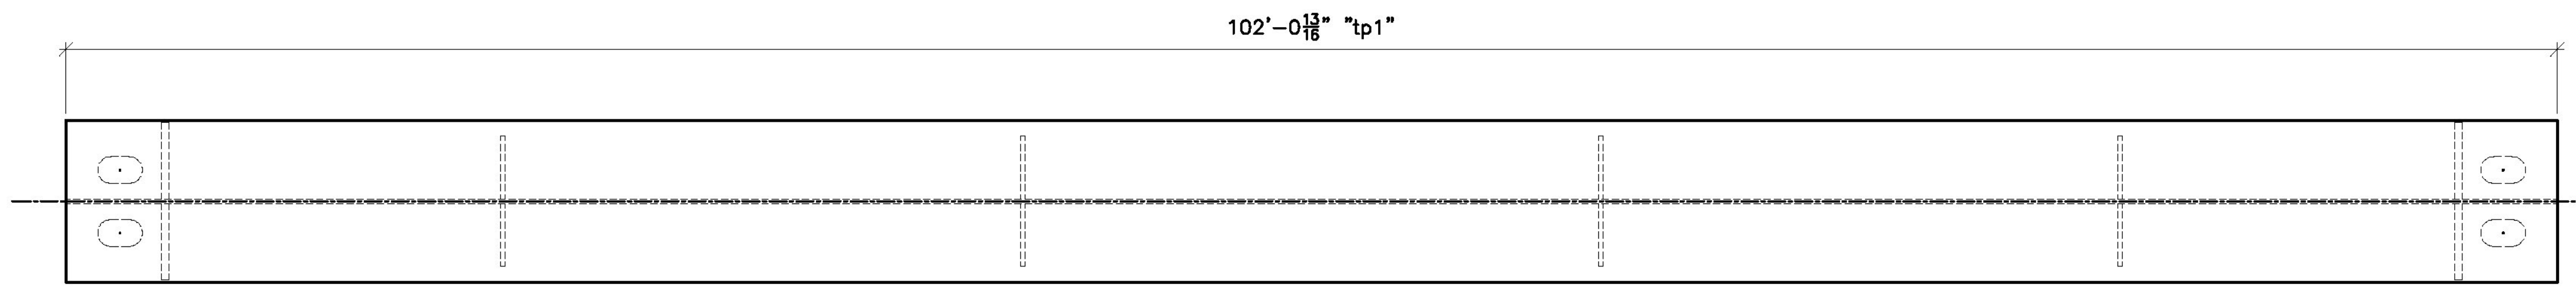


TOP VIEW

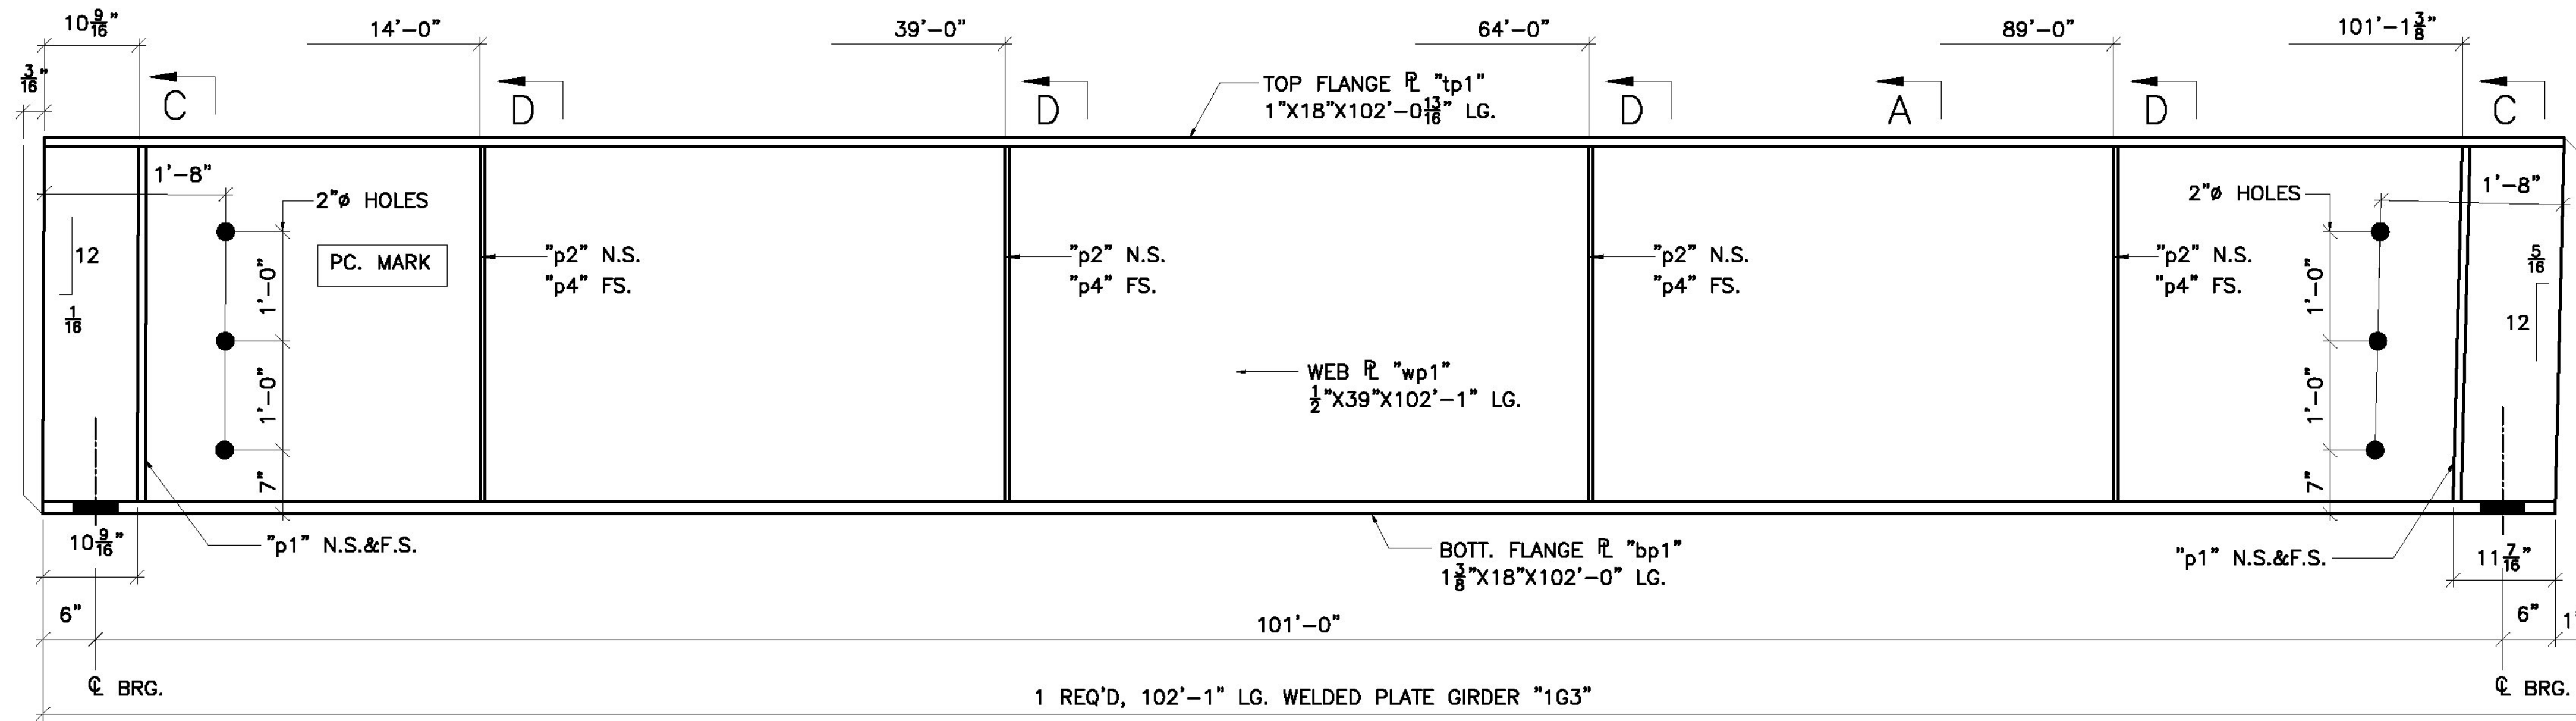


1 REQ'D, 102'-1" LG. WELDED PLATE GIRDER "1G3"

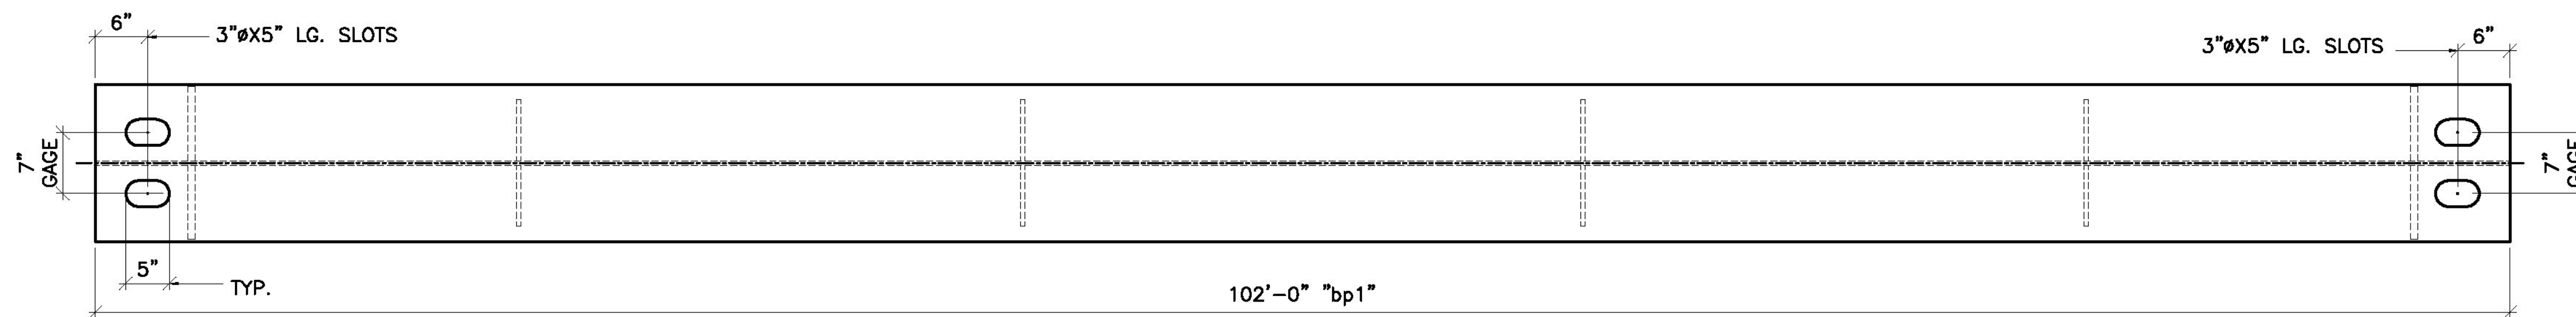

BOTTOM VIEW

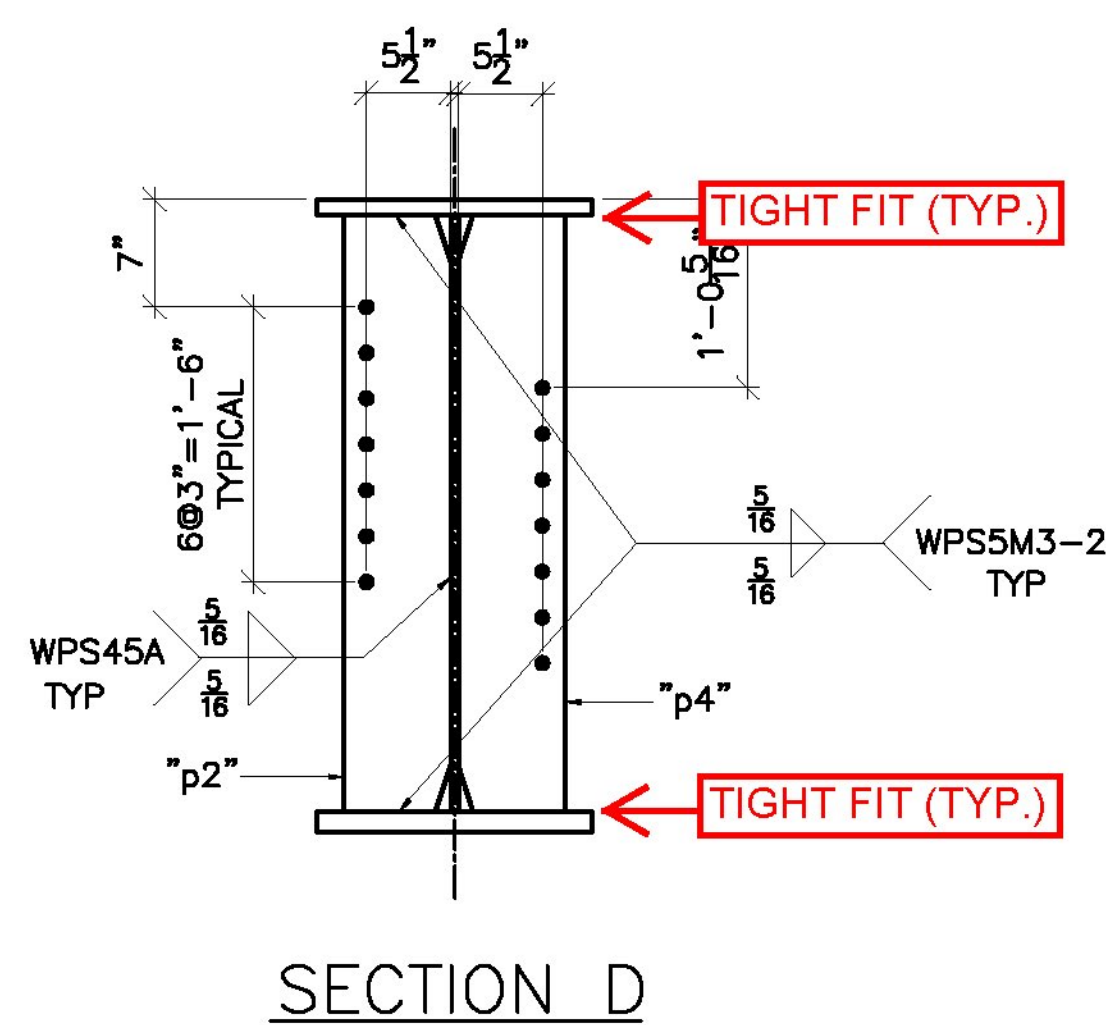

SECTION D

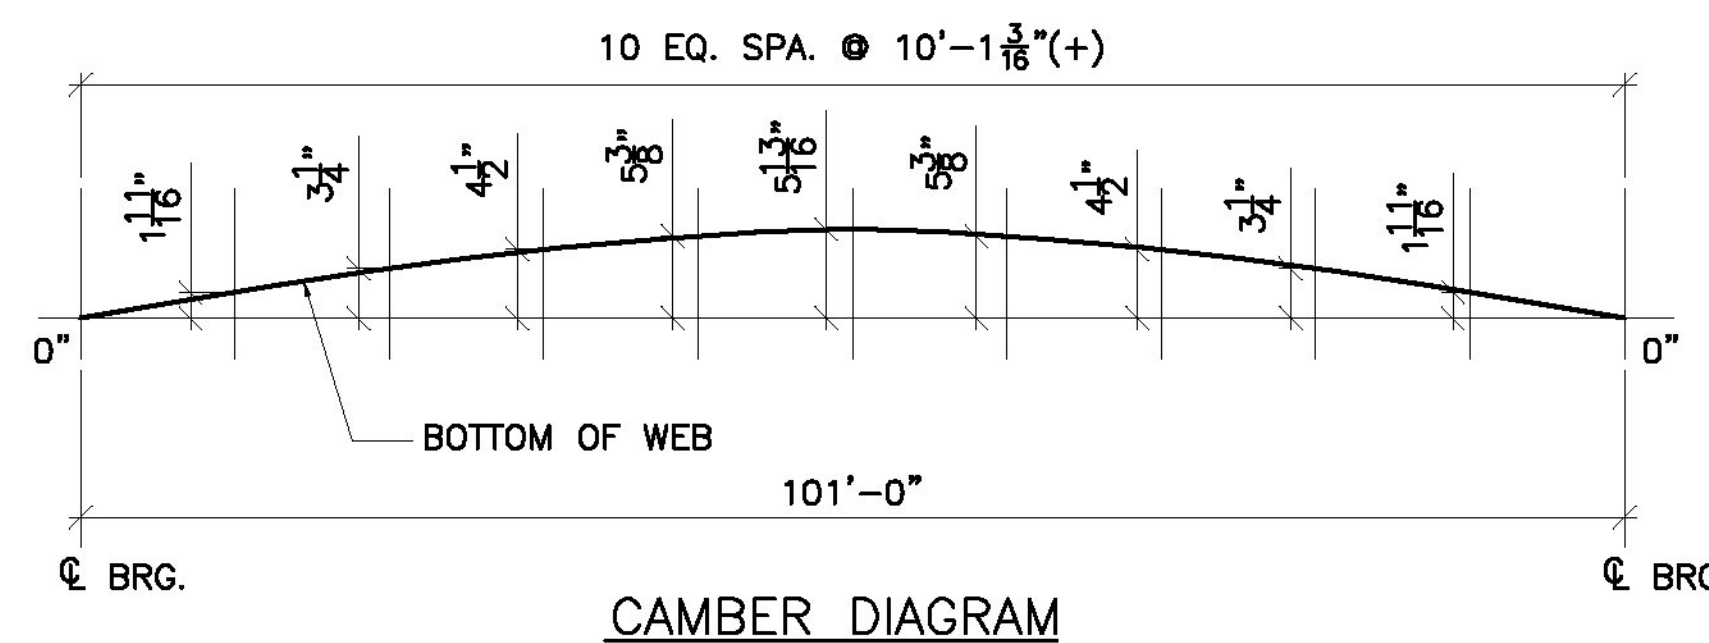

CAMBER DIAGRAM

BILL OF MATERIAL

SHIP	SHIP MARK	NO. PCS.	PIECE MARK	DESCRIPTION	LENGTH	REMARKS	WT.
1	1G3			BRIDGE GIRDER			
		1	wp1	PL 1/2 X 39	102'-1"	*	6769
		1	tp1	PL 1 X 18	102'-0 1/8"	*	6252
		1	bp1	PL 1 1/2 X 18	102'-0"	*	8591
		4	p1	SEE SHT. 6			
		4	p2	SEE SHT. 6			
		4	p4	SEE SHT. 6			

GIRDER WT: 22,244

* CVN (SEE NOTES ON DWG. NO. E1)

Vermont Agency of Transportation

RECEIVED

CK'D BY D. PETERSON OK'D BY C. CARLSON


08/20/2012

RESUBMIT APPROVED AS NOTED


BY C. CARLSON DATE 12/14/2012

SEE SHEET 1 FOR SECTION A & C
SEE SHEET 6 FOR DETAILS NOT SHOWN


FINISH		NO.		DATE		DESCRIPTION		BY	
MATERIAL		ASHTO M270 (ASTM A709) GRADE 50							
HOLES		15/16" U.D.N.							
ELECTRODES									
WELDS		PER WPS							
SURFACE PREP									
REVISIONS									
ADVANCED RESOURCES & CONST. ENTERPRISES, INCORPORATED P.O. BOX 120 KINGFIELD, ME. 04947 PHONE: (207) 265-2646 - FAX: (207) 265-4054									
DRAFTER		JAC		PROJECT NO.		GIRDER DETAILS		BRF 028-4(25)S	
DATE		11/12/12		STATE OF VERMONT, TOWN OF JOHNSBURY, BRIDGE NO. 106		COUNTY OF CALEDONIA, US ROUTE 2 - PRINCIPAL ARTERIAL		DWG. NO.	
CHECKED		JS		G.C.		WINTERSSET, INC.		3	
JOB #		12-175							

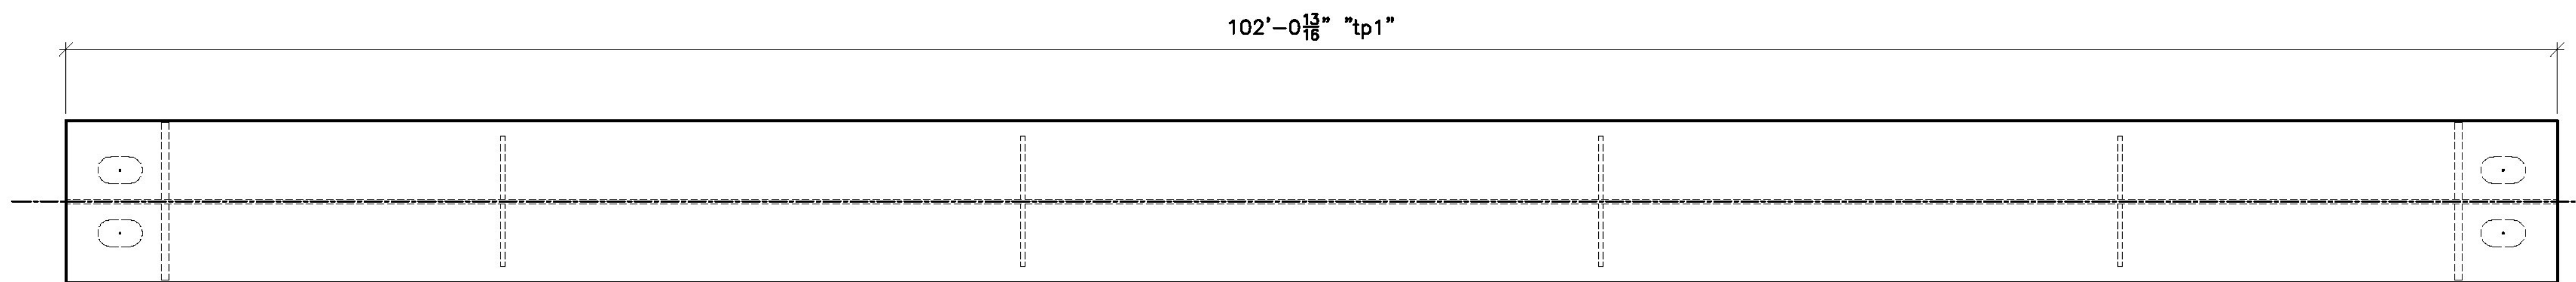


TOP VIEW

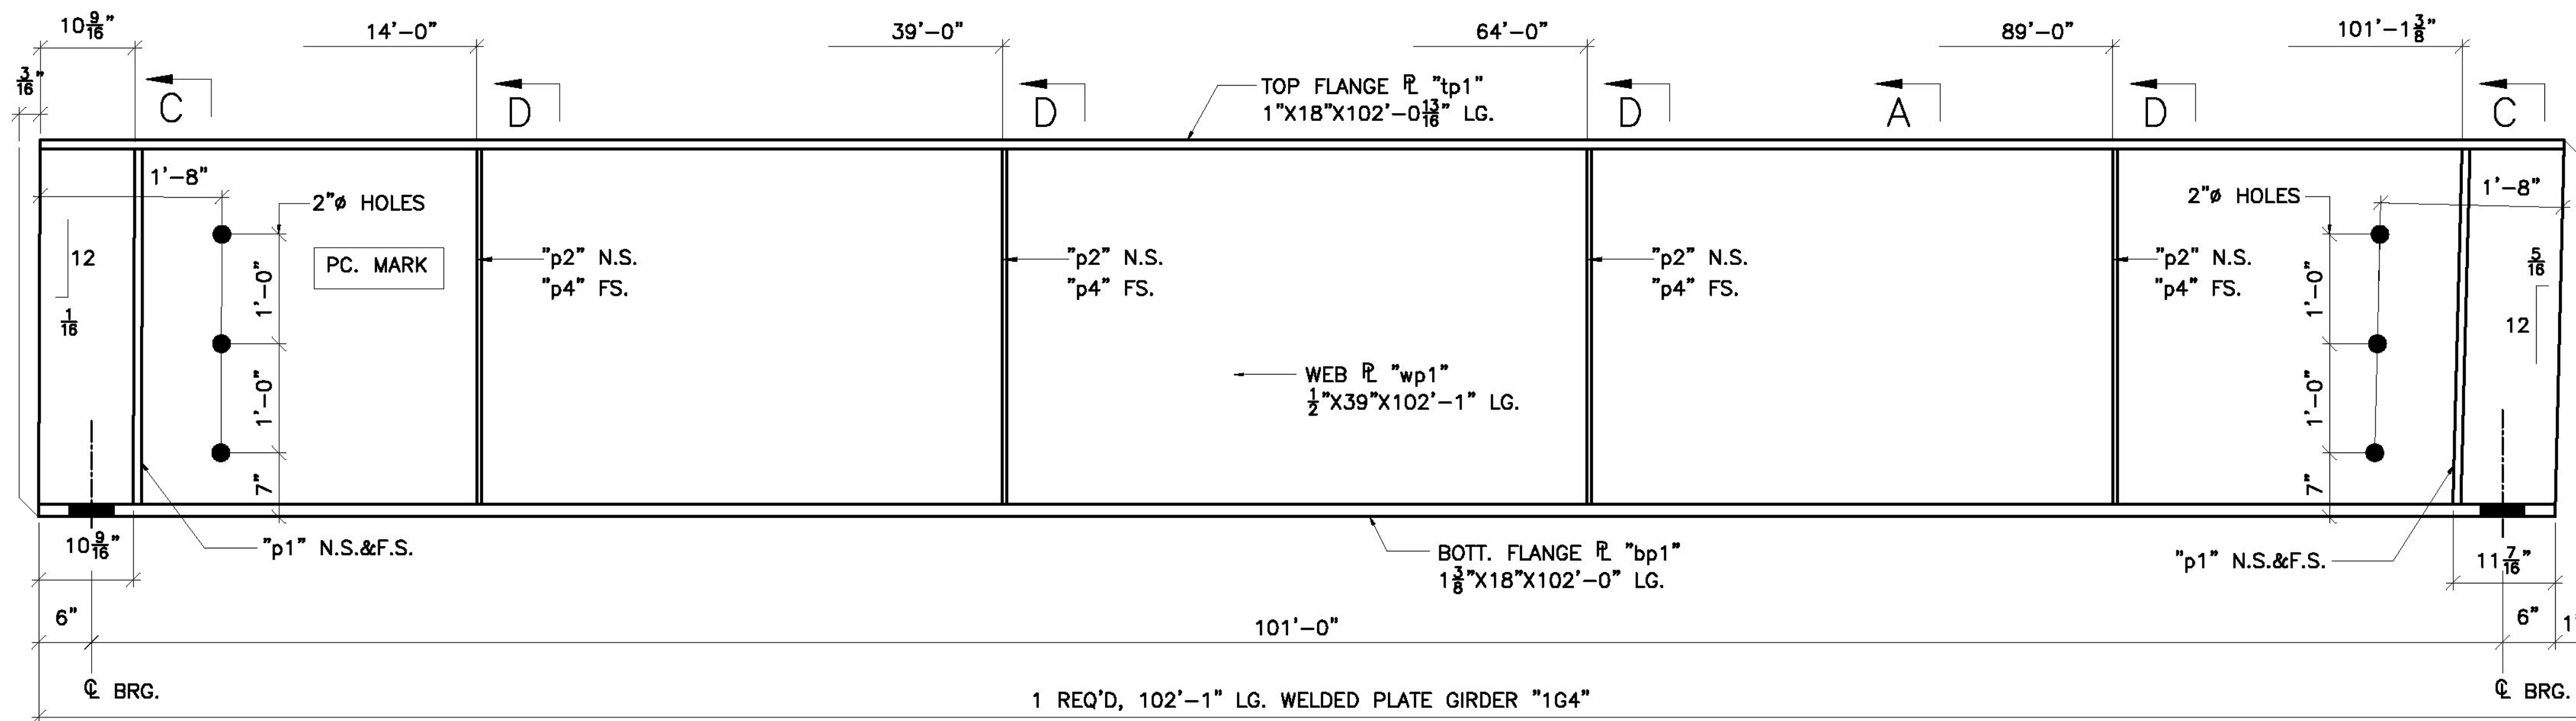


1 REQ'D, 102'-1" LG. WELDED PLATE GIRDER "1G4"

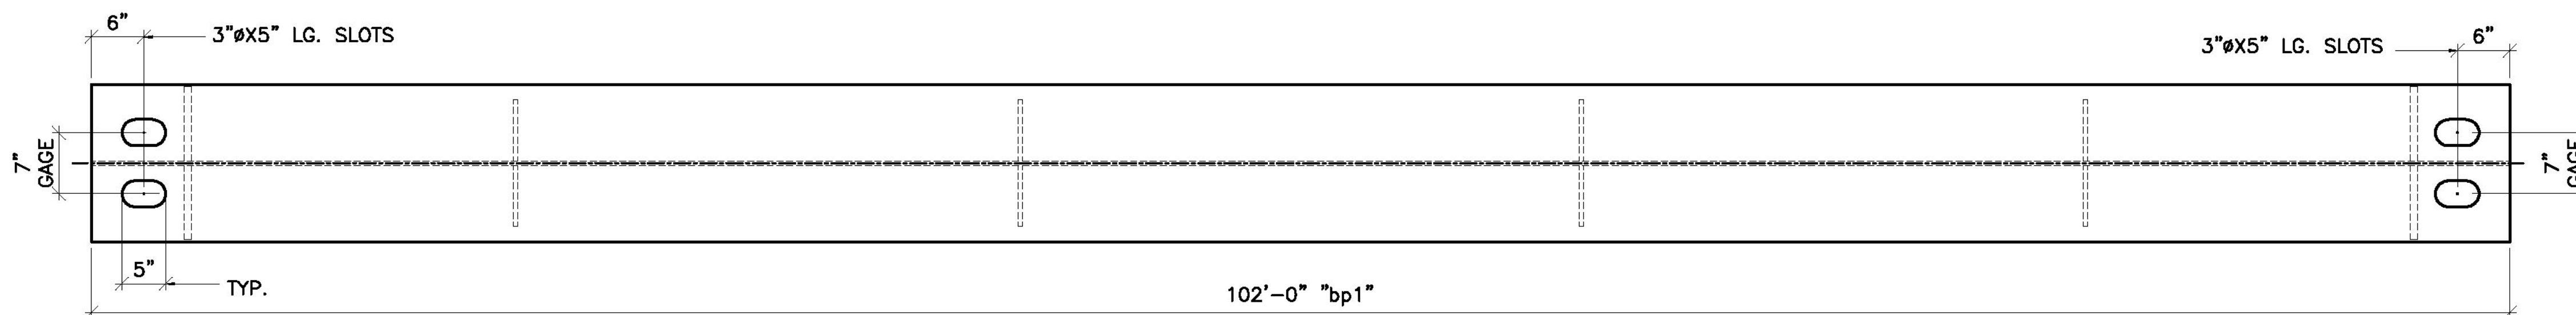

BOTTOM VIEW

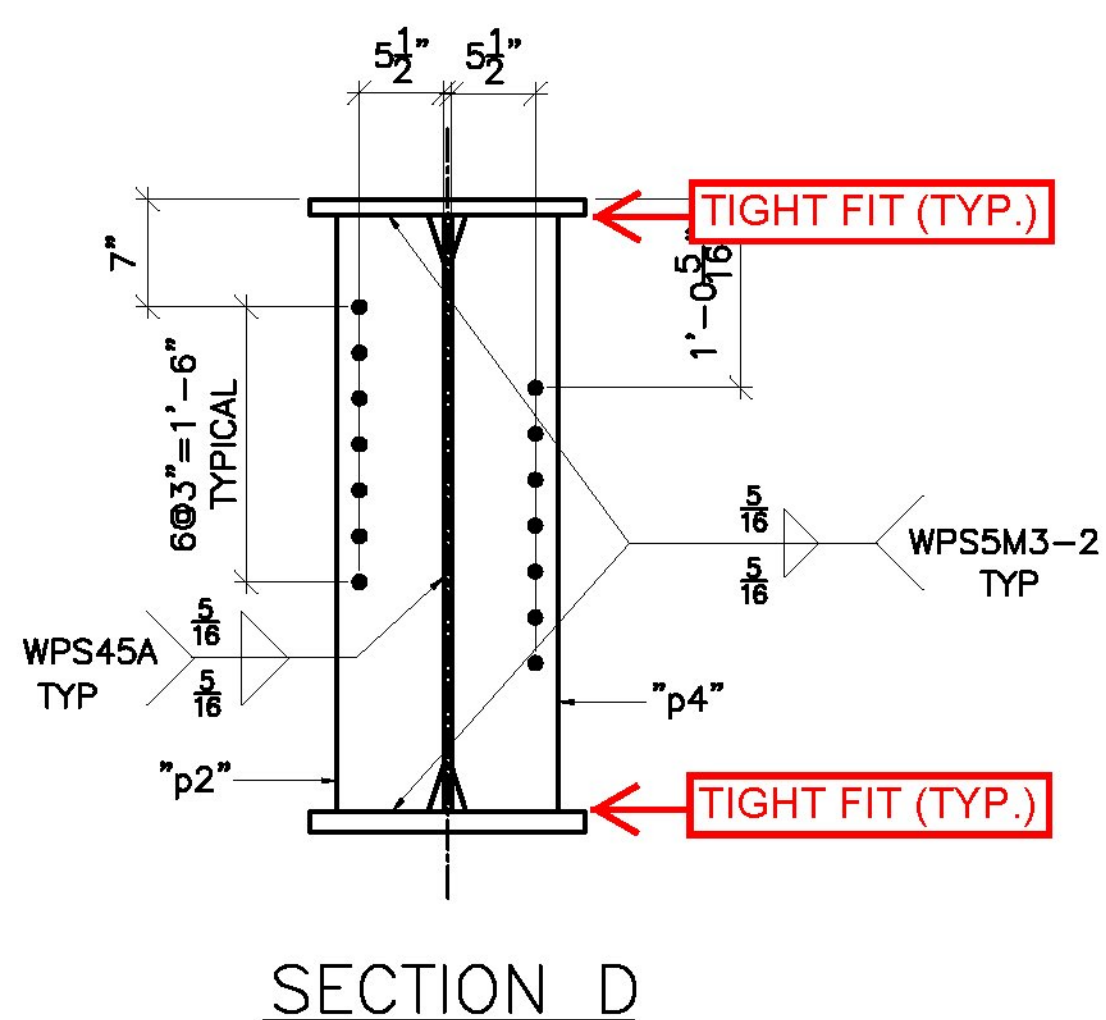

SECTION D

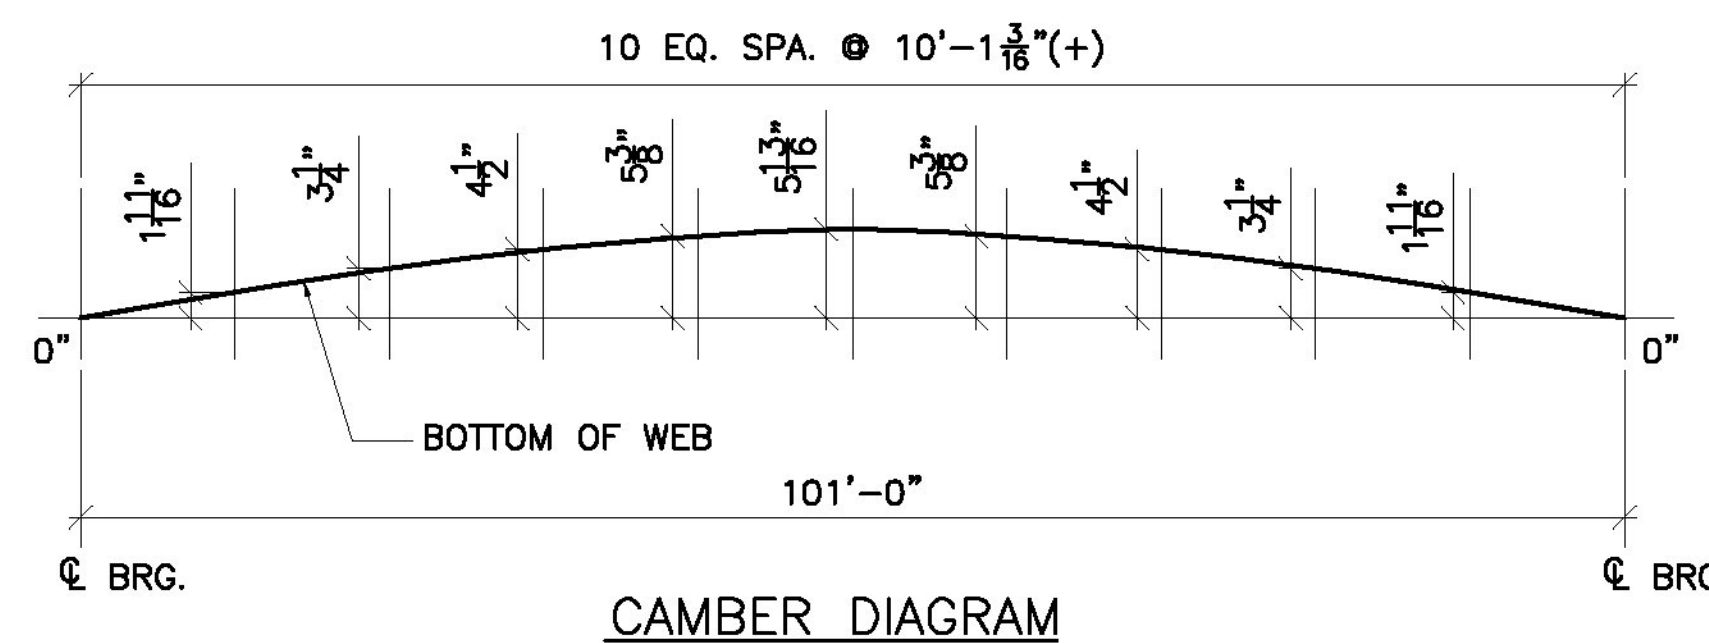

CAMBER DIAGRAM

BILL OF MATERIAL

SHIP	SHIP MARK	NO. PCS.	PIECE MARK	DESCRIPTION	LENGTH	REMARKS	WT.
1	1G4			BRIDGE GIRDER			
		1	wp1	R. 1/2 X 39	102'-1	*	6769
		1	tp1	R. 1 X 18	102'-0 1/8	*	6252
		1	bp1	R. 1 3/8 X 18	102'-0	*	8591
		4	p1	SEE SHT. 6			
		4	p2	SEE SHT. 6			
		4	p4	SEE SHT. 6			

GIRDER WT: 22,244

* CVN (SEE NOTES ON DWG. NO. E1)

Vermont Agency of Transportation

RECEIVED

CK'D BY D. PETERSON OK'D BY C. CARLSON


08/20/2012


RESUBMIT APPROVED AS NOTED

BY C. CARLSON DATE 12/14/2012


SEE SHEET 1 FOR SECTION A & C

SEE SHEET 6 FOR DETAILS NOT SHOWN


FINISH		NO.		DATE		DESCRIPTION		BY	
MATERIAL		ASHTO M270 (ASTM A709) GRADE 50							
HOLES		15/16" U.D.N.							
ELECTRODES		PER WPS							
WELDS		PER WPS							
SURFACE PREP									
REVISIONS									
 ARC ENTERPRISES, INC.									
ADVANCED RESOURCES & CONST. ENTERPRISES, INCORPORATED P.O. BOX 120 KINGFIELD, ME. 04947 PHONE: (207) 265-2646 - FAX: (207) 265-4054									
DRAFTER		JAC		PROJECT NO.		BRF 028-4(25)S			
DATE		11/12/12		STATE OF VERMONT, TOWN OF JOHNSBURY, BRIDGE NO. 106		DWG. NO.			
CHECKED		JS		COUNTY OF CALEDONIA, US ROUTE 2 - PRINCIPAL ARTERIAL		4			
JOB #		12-175		G.C. WINTERSSET, INC.					

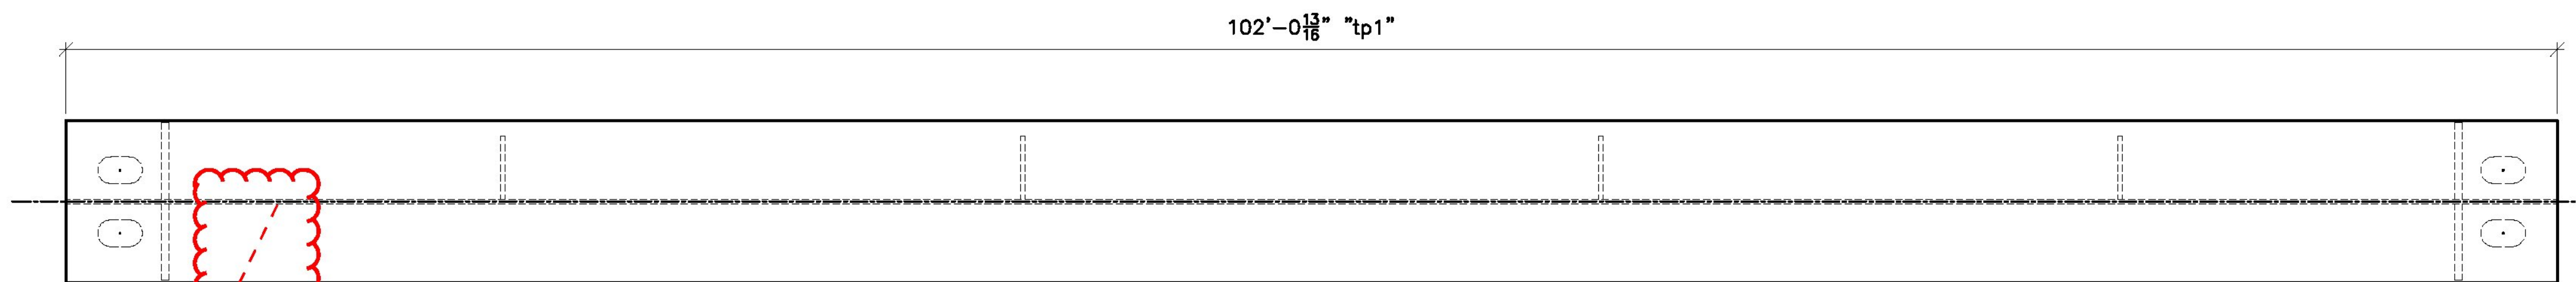


TOP VIEW

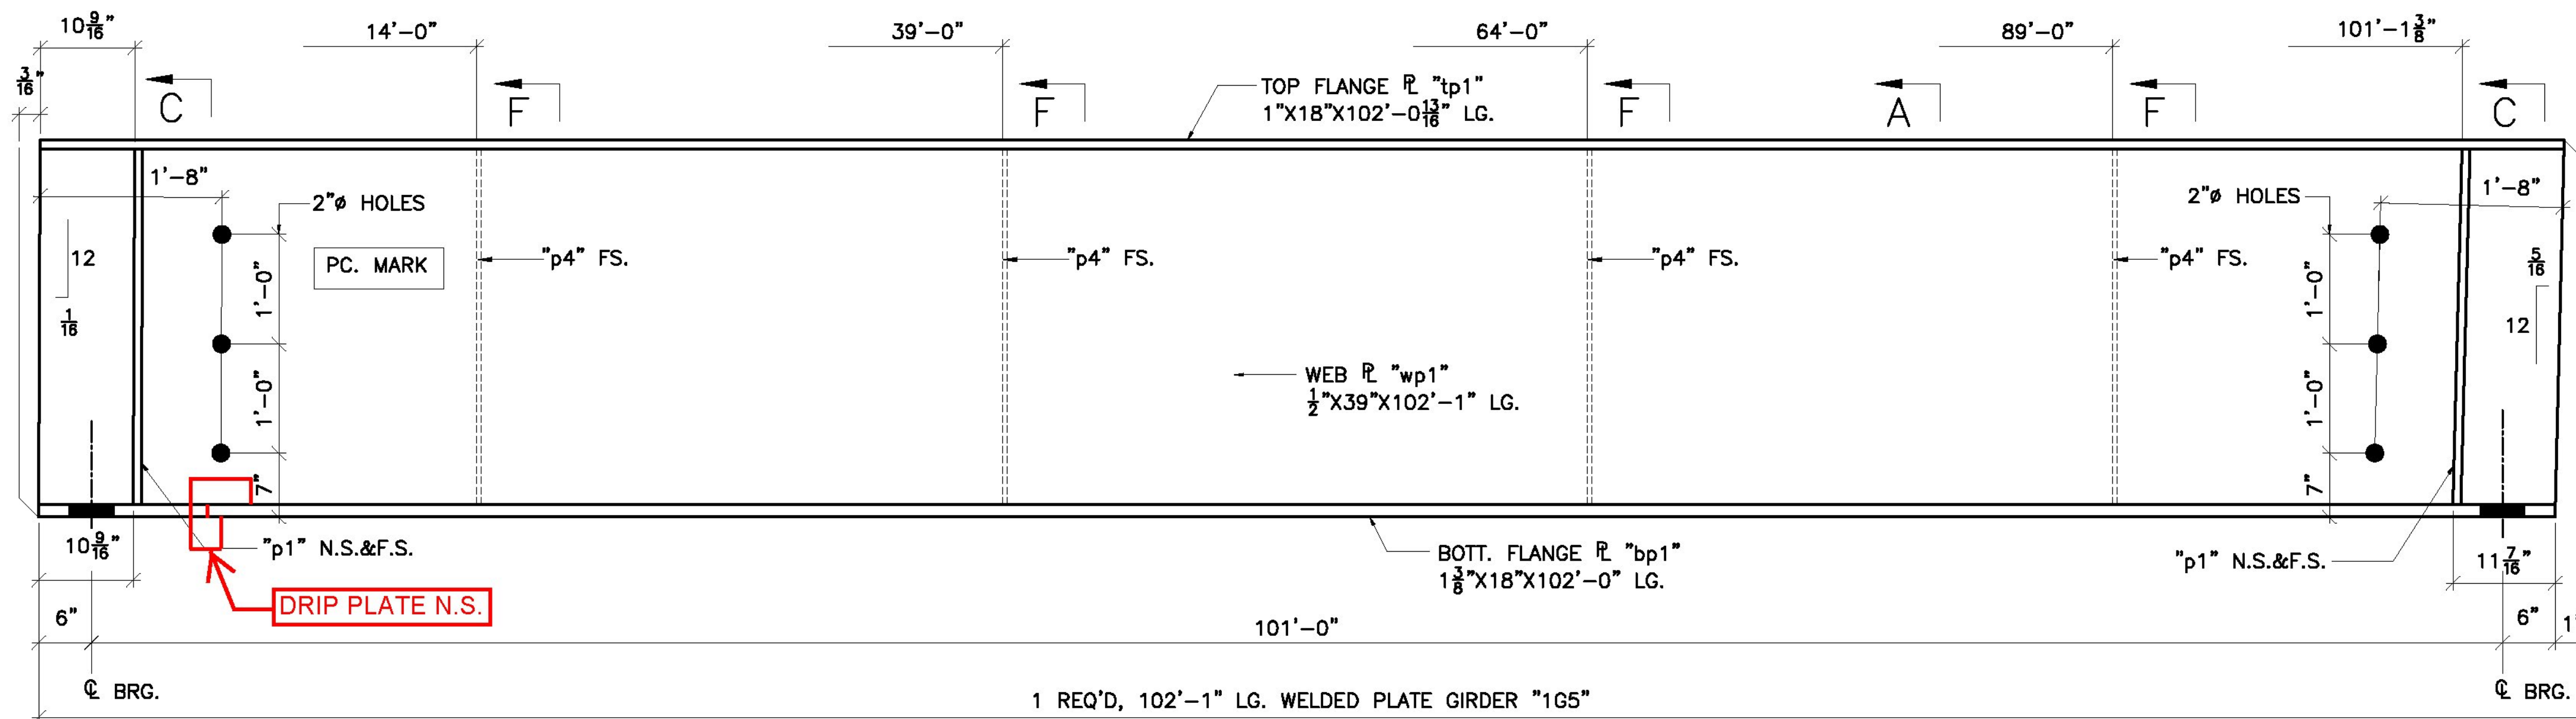


1 REQ'D, 102'-1" LG. WELDED PLATE GIRDER "1G5"

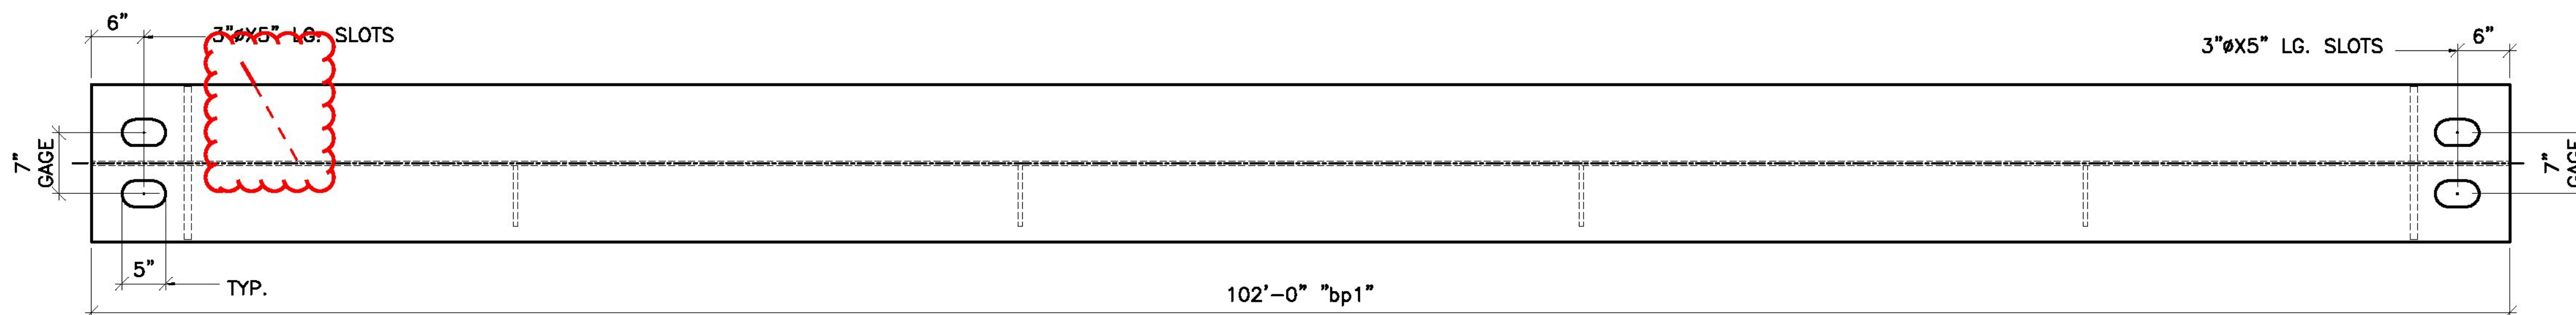

BOTTOM VIEW

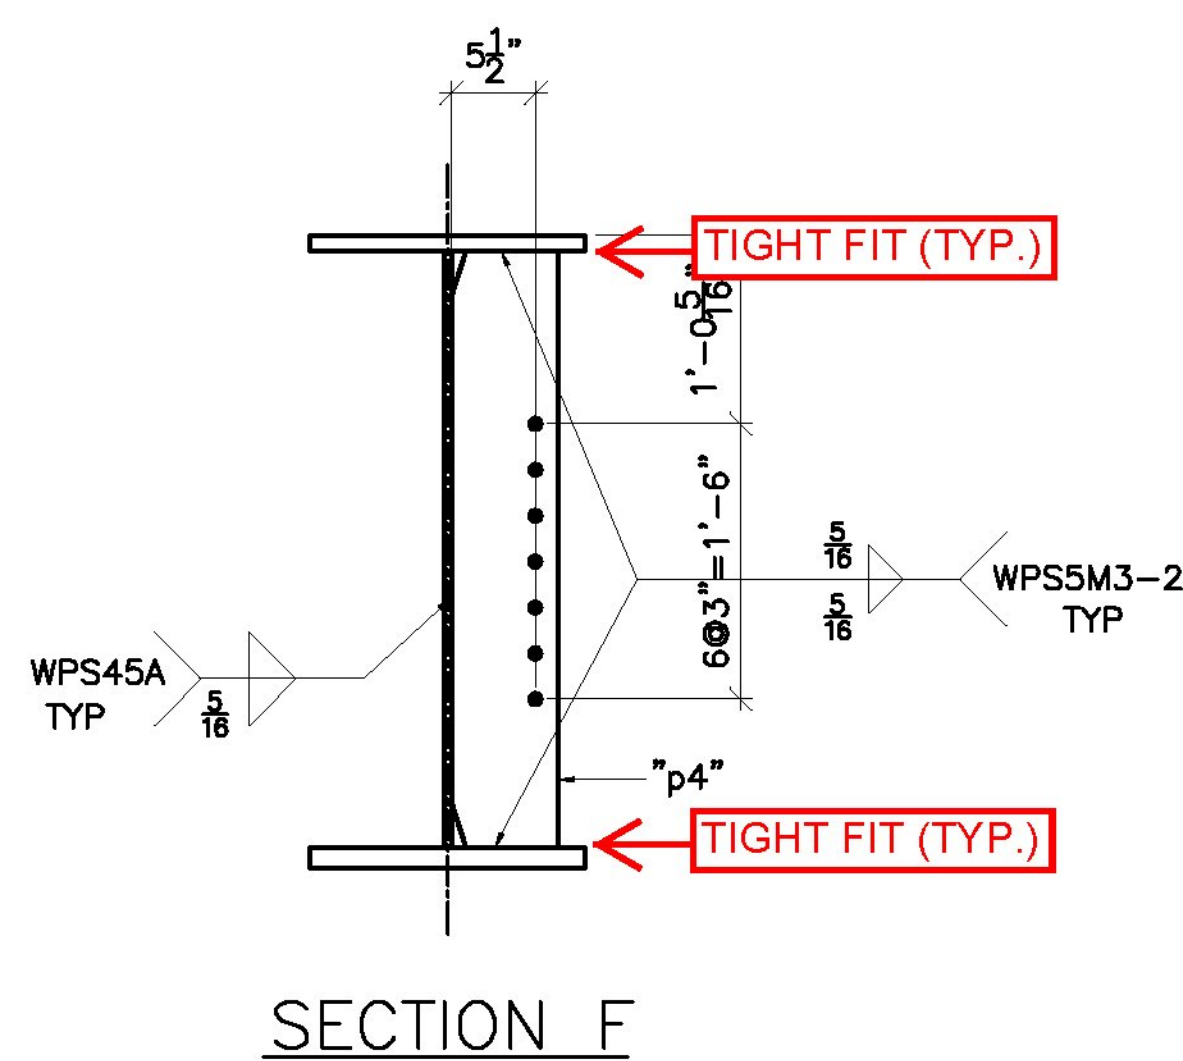

SECTION F

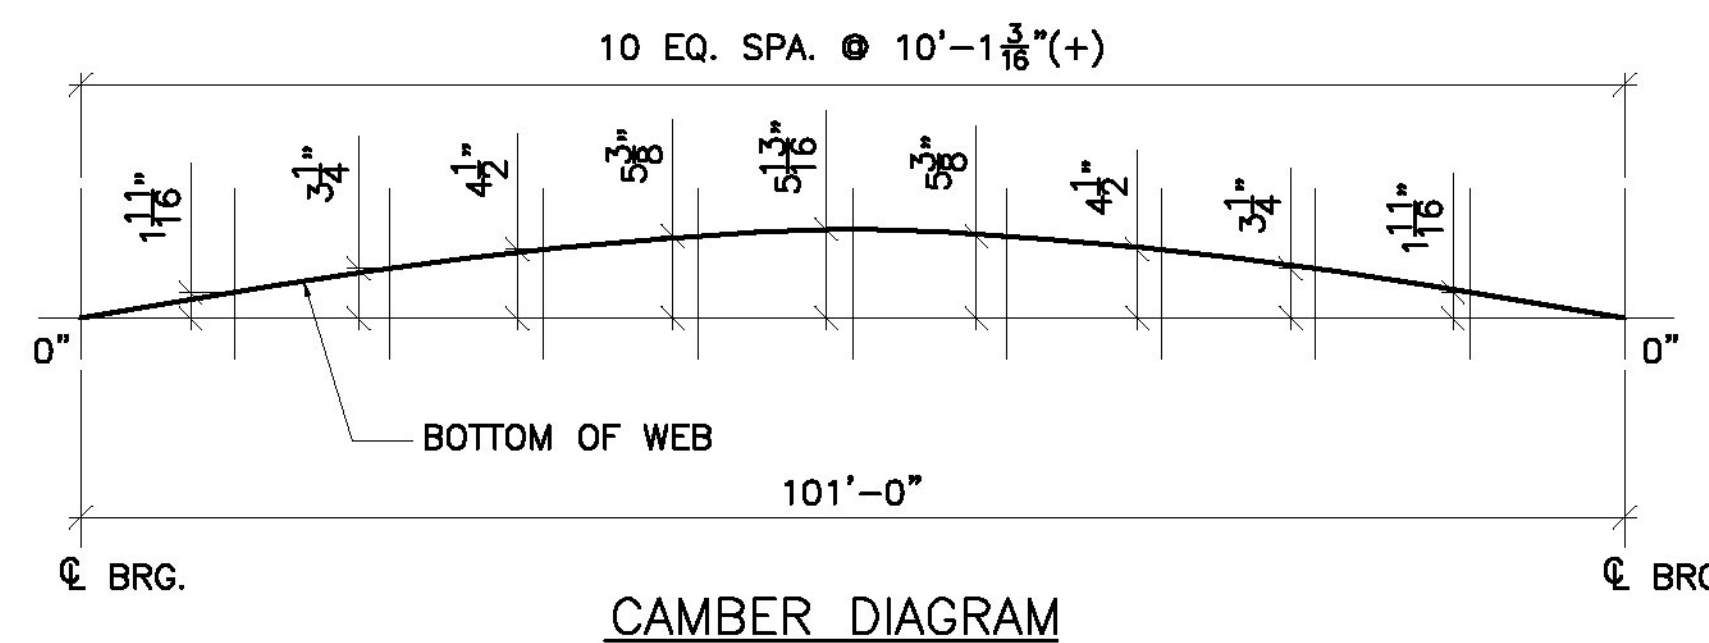

CAMBER DIAGRAM

BILL OF MATERIAL

SHIP	SHIP MARK	NO. PCS.	PIECE MARK	DESCRIPTION	LENGTH	REMARKS	WT.
1	1G5			BRIDGE GIRDER			
		1	wp1	R 1/2 X 39	102'-1	*	6769
		1	tp1	R 1 X 18	102'-0 1/8	*	6252
		1	bp1	R 1 1/2 X 18	102'-0	*	8591
		4	p1	SEE SHT. 6			
		4	p4	SEE SHT. 6			

GIRDER WT: 22.091

* CVN (SEE NOTES ON DWG. NO. E1)

Vermont Agency of Transportation
RECEIVED

CK'D BY D. PETERSON OK'D BY C. CARLSON

08/20/2012

RESUBMIT APPROVED AS NOTED
BY C. CARLSON DATE 12/14/2012

SEE SHEET 1 FOR SECTION A & C
SEE SHEET 6 FOR DETAILS NOT SHOWN

FINISH		NO		DATE		DESCRIPTION		BY	
MATERIAL		ASHTO M270 (ASTM A709) GRADE 50							
HOLES		15/16" U.O.N.							
ELECTRODES									
WELDS		PER WPS							
SURFACE PREP									
REVISIONS									
		ADVANCED RESOURCES & CONST. ENTERPRISES, INCORPORATED P.O. BOX 120 KINGFIELD, ME. 04947 PHONE: (207) 265-2646 - FAX: (207) 265-4054							
		DRAFTER JAC DATE 11/12/12 CHECKED JS JOB # 12-175		GIRDER DETAILS STATE OF VERMONT, TOWN OF JOHNSBURY, BRIDGE NO. 106 COUNTY OF CALEDONIA, US ROUTE 2 - PRINCIPAL ARTERIAL G.C. WINTERSSET, INC.				PROJECT NO. BRJ 028-4(25)S DWG. NO. 5	

Welding Procedure Specification (wps) Yes (X)
 PREQUALIFIED _____ QUALIFIED BY TESTING X
 or PROCEDURE QUALIFICATION RECORD (PQR) YES ()


Company Name A.R.C. Enterprises, Inc. Identification # ARC WPS #45 b
 Revision 5 Date 11/21/2012 By SVH
 Welding Process(es) SAW Authorized by STEVE HOWARD Date 11/21/2012
 Supporting PQR No.(s) ARC PQR # 45 Type - Manual () Semi - Automatic ()
 Machine () Automatic x

JOINT DESIGN USED Type <u>B-L1a-S</u> Single _____ Double Weld (X) Backing _____ () NO (X) Backing Material _____ Root Opening <u>0"</u> Root Face Dimension _____ Groove Angle <u>0</u> Radius (J-U) _____ Back Gouging (YES) _____ Method <u>open</u>		POSITION Position of Groove <u>1G</u> Fillet _____ Vertical Progression _____ ()	
BASE METALS Material Spec <u>A709</u> Type or Grade <u>50 50W</u> Thickness <u>Groove 5/8" max</u> Fillet _____ Diameter (Pipe) _____		ELECTRICAL CHARACTERISTICS Transfer Mode (FCAW) _____ Short Circuiting () Globular () Spray (X) Current : AC () DCEP (X) DCEN () Pulsed () OTHER : _____	
FILLER METALS <u>Lincoln LA-75</u> AWS Specification <u>A5.23</u> AWS Classification <u>ENi1K-Ni1-H8</u>		TECHNIQUE Stringer or Weave Bead <u>STRINGER</u> Multi-pass or Single Pass (per side) <u>MULTI</u> Number of Electrodes <u>ONE</u> Electrode Spacing <u>Longitudinal</u> Lateral _____ Angle _____	
SHIELDING Flux <u>960 Lincoln</u> Gas _____ Composition _____ Electrode - Flux (Class) <u>F8A2-ENi1K-Ni1-H8</u> Flow Rate _____ Gas Cup Size _____		Contact Tube to Work Distance <u>1"1/4 stickout +/-1/4"</u> Peening <u>none</u> Interpass Cleaning : <u>Hand or Power tools</u>	
Preheat <u>3/4" = 50 degrees 3/4" - 1 1/2" = 70 degrees.</u> <u>1 1/2" - 2 1/2" = 150 degrees Over 2 1/2" = 225 degrees F.</u>		POSTWELD HEAT TREATMENT Temp _____	

WELDING PROCEDURE Min. heat input=37.3 Kj/in. Max heat input=70.4 Kj/in.

Pass or Weld Layer(s)	S	Filler Metals		Current		Volts	Travel Speed	Joint Details	
		Class	Diameter	Type & Polarity	Amps or Wire Feed Speed			ROOT = 0	Tolerance + 1/16"
	SAW	ENi1K	3/32"	DCEP	360-440	28-32	14-16.2 ipm	ROOT = 0	Tolerance + 1/16"

Square-groove weld (1)
 Butt joint (B)

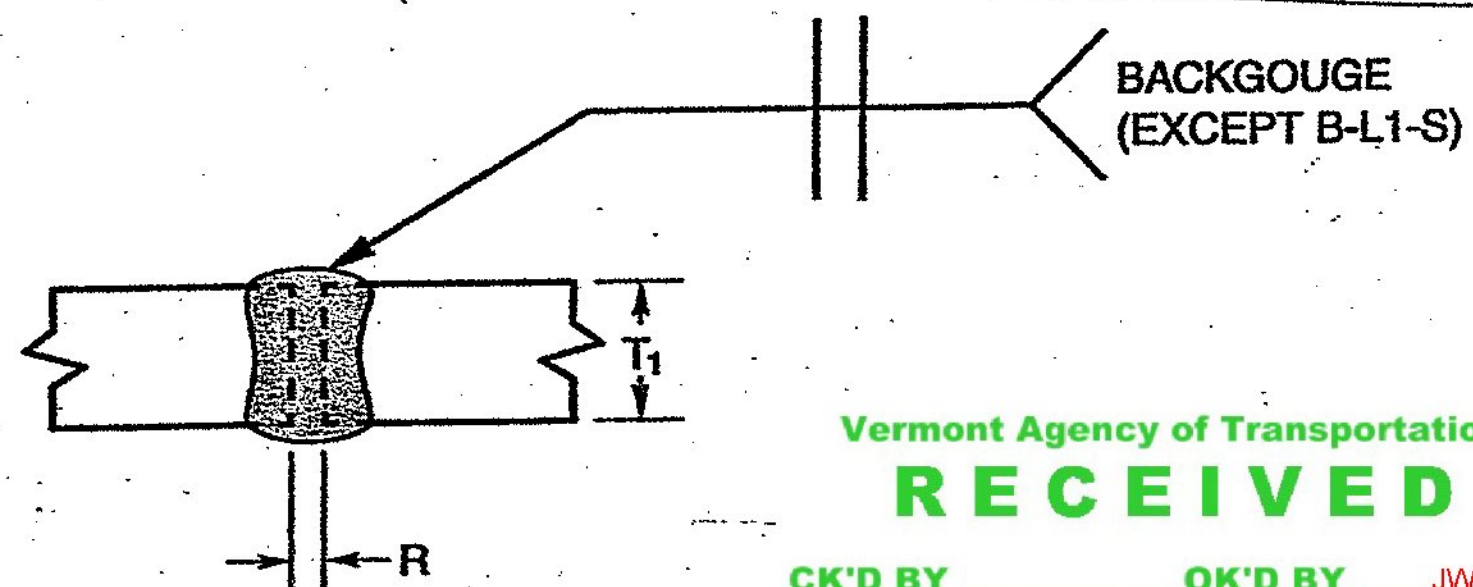

Vermont Agency of Transportation

RECEIVED

OK'D BY _____ OK'D BY JWC

01/15/2013

RESUBMIT _____ APPROVED X
 BY C. CARLSON DATE 01/16/2013