

### SEEDING FORMULA RURAL AREAS

% WT.	LBS./A.	NAME	PUR %	GERM %
37.5	22.5	CREEPING RED FESCUE	98	85
37.5	22.5	TALL FESCUE	95	90
5.0	3.0	RED TOP	95	90
15.0	9.0	BIRDSFOOT TREFOIL	98	85
5.0	3.0	ANNUAL RYEGRASS	95	85
100.0	60.0			


### GENERAL NOTES

- SEED MIXTURE: SHALL NOT HAVE A WEED CONTENT EXCEEDING 0.40% BY WEIGHT AND SHALL BE FREE OF ALL NOXIOUS SEED.
- SEED: TO BE APPLIED PER SEEDING FORMULAS OR AS DIRECTED BY THE ENGINEER.
- FERTILIZER: FORMULA 10-20-10, TO BE USED WITH SEED, APPLIED AT THE RATE OF 500 LBS./ACRE. (HYDRO SEEDERS MAY USE 19-19-19 FORMULA).
- AGRICULTURAL LIMESTONE: TO BE APPLIED AT THE RATE OF 2 TONS/ACRE, OR AS DIRECTED BY THE ENGINEER.
- HAY MULCH: TO BE PLACED ON EARTH SLOPES AT THE RATE OF 2 TONS/ACRE, OR AS DIRECTED BY THE ENGINEER.
- TOPSOIL: TO BE USED WITH SEED AS INDICATED ON THE PLANS, OR AS DIRECTED BY THE ENGINEER.

### NOTES

- SCOPE OF WORK: REMOVE AND REPLACE THE EXISTING CONCRETE BRIDGE DECK, CONSTRUCT NEW CURTAIN WALLS AND APPROACH SLABS, REMOVE AND RESET EXISTING GUARD RAIL AND PLACE NEW APPROACH PAVEMENT. PERFORM ADDITIONAL APPROACH AND SITE WORK AS SHOWN IN THE PLANS AND AS DIRECTED BY THE RESIDENT ENGINEER.
- ALL MATERIALS AND CONSTRUCTION SHALL CONFORM TO VERMONT AGENCY OF TRANSPORTATION STANDARD SPECIFICATIONS FOR CONSTRUCTION, DATED 1990, AND ITS LATEST REVISIONS AND THE AASHTO STANDARD SPECIFICATIONS FOR HIGHWAY BRIDGES, DATED 1996, AND ITS LATEST REVISIONS.


\*STAGE CONSTRUCTION - SEE SHEETS 9-10.

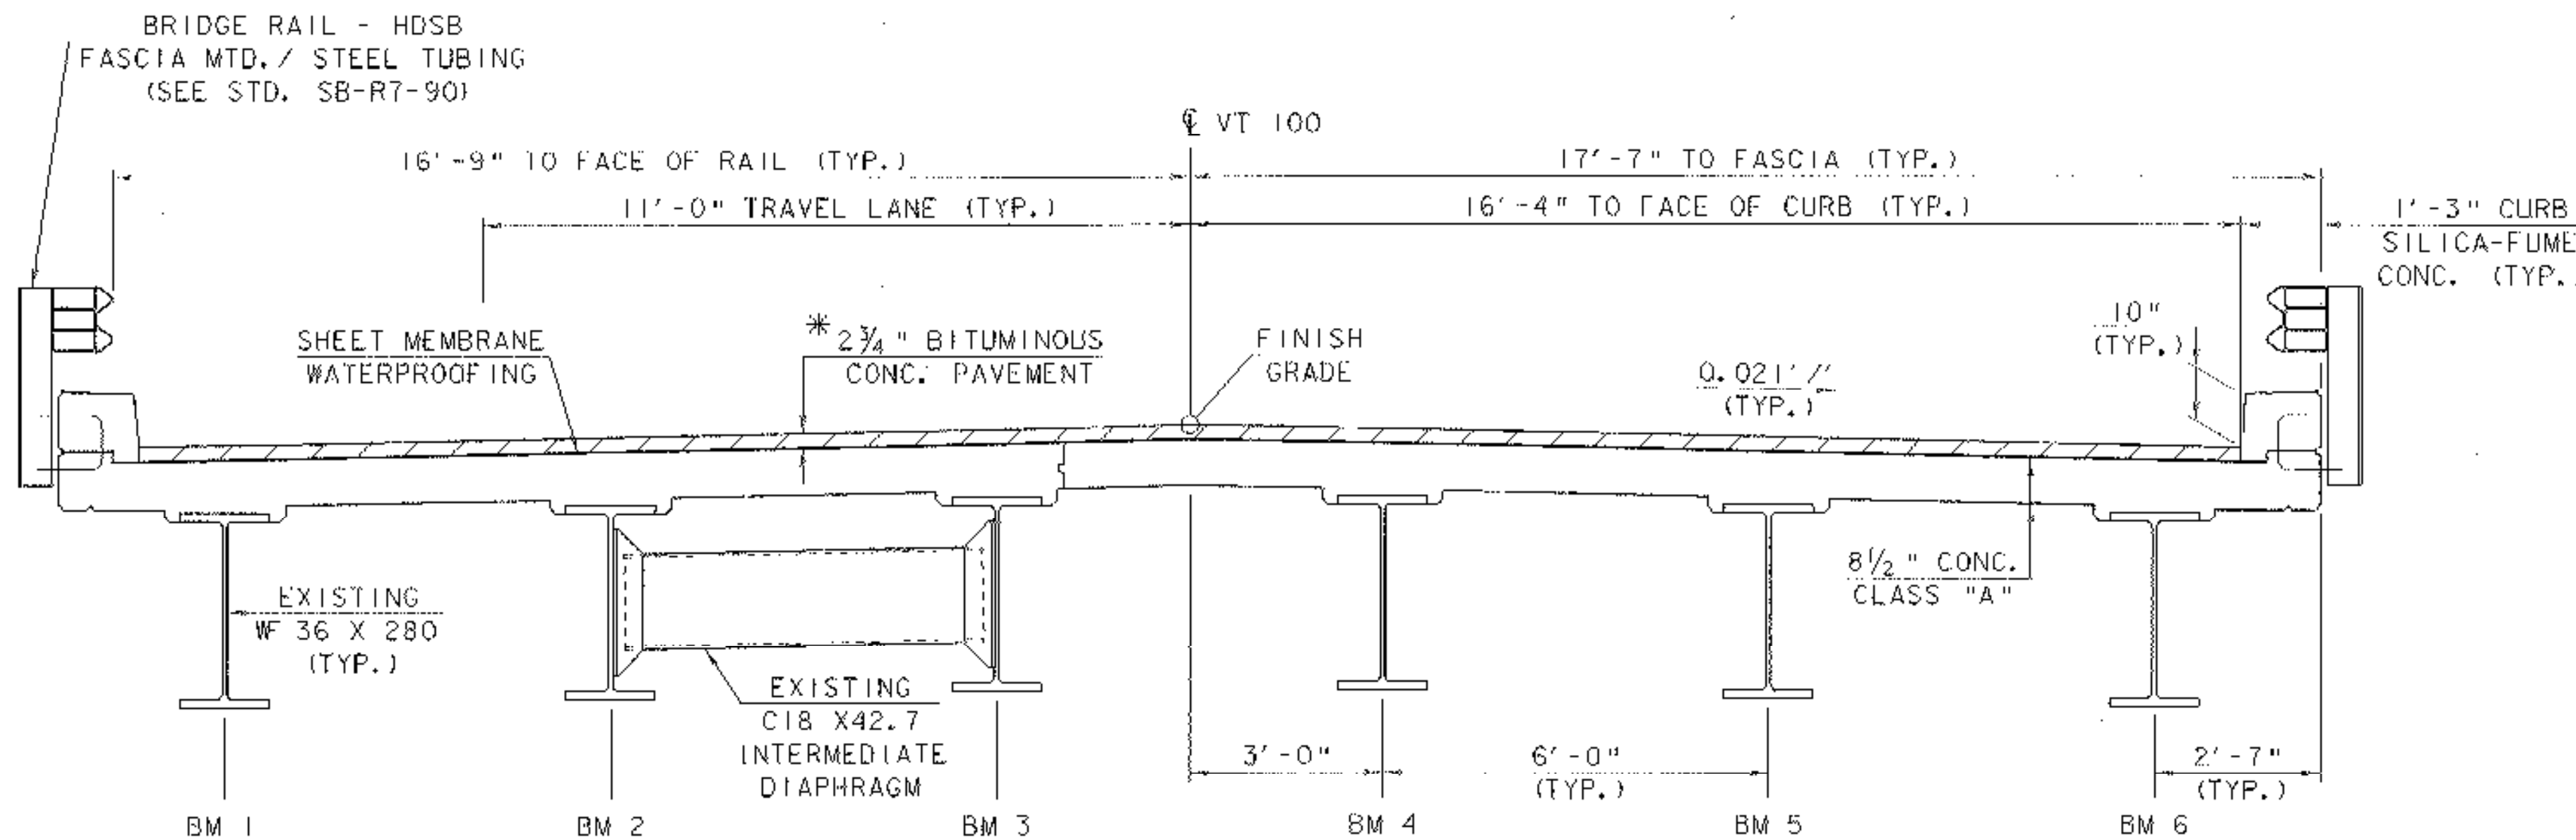

### BRIDGE TYPICAL SECTION

SCALE: 1/2" = 1'-0"

\* 1/2" TYPE III OVER  
1/4" TYPE IV

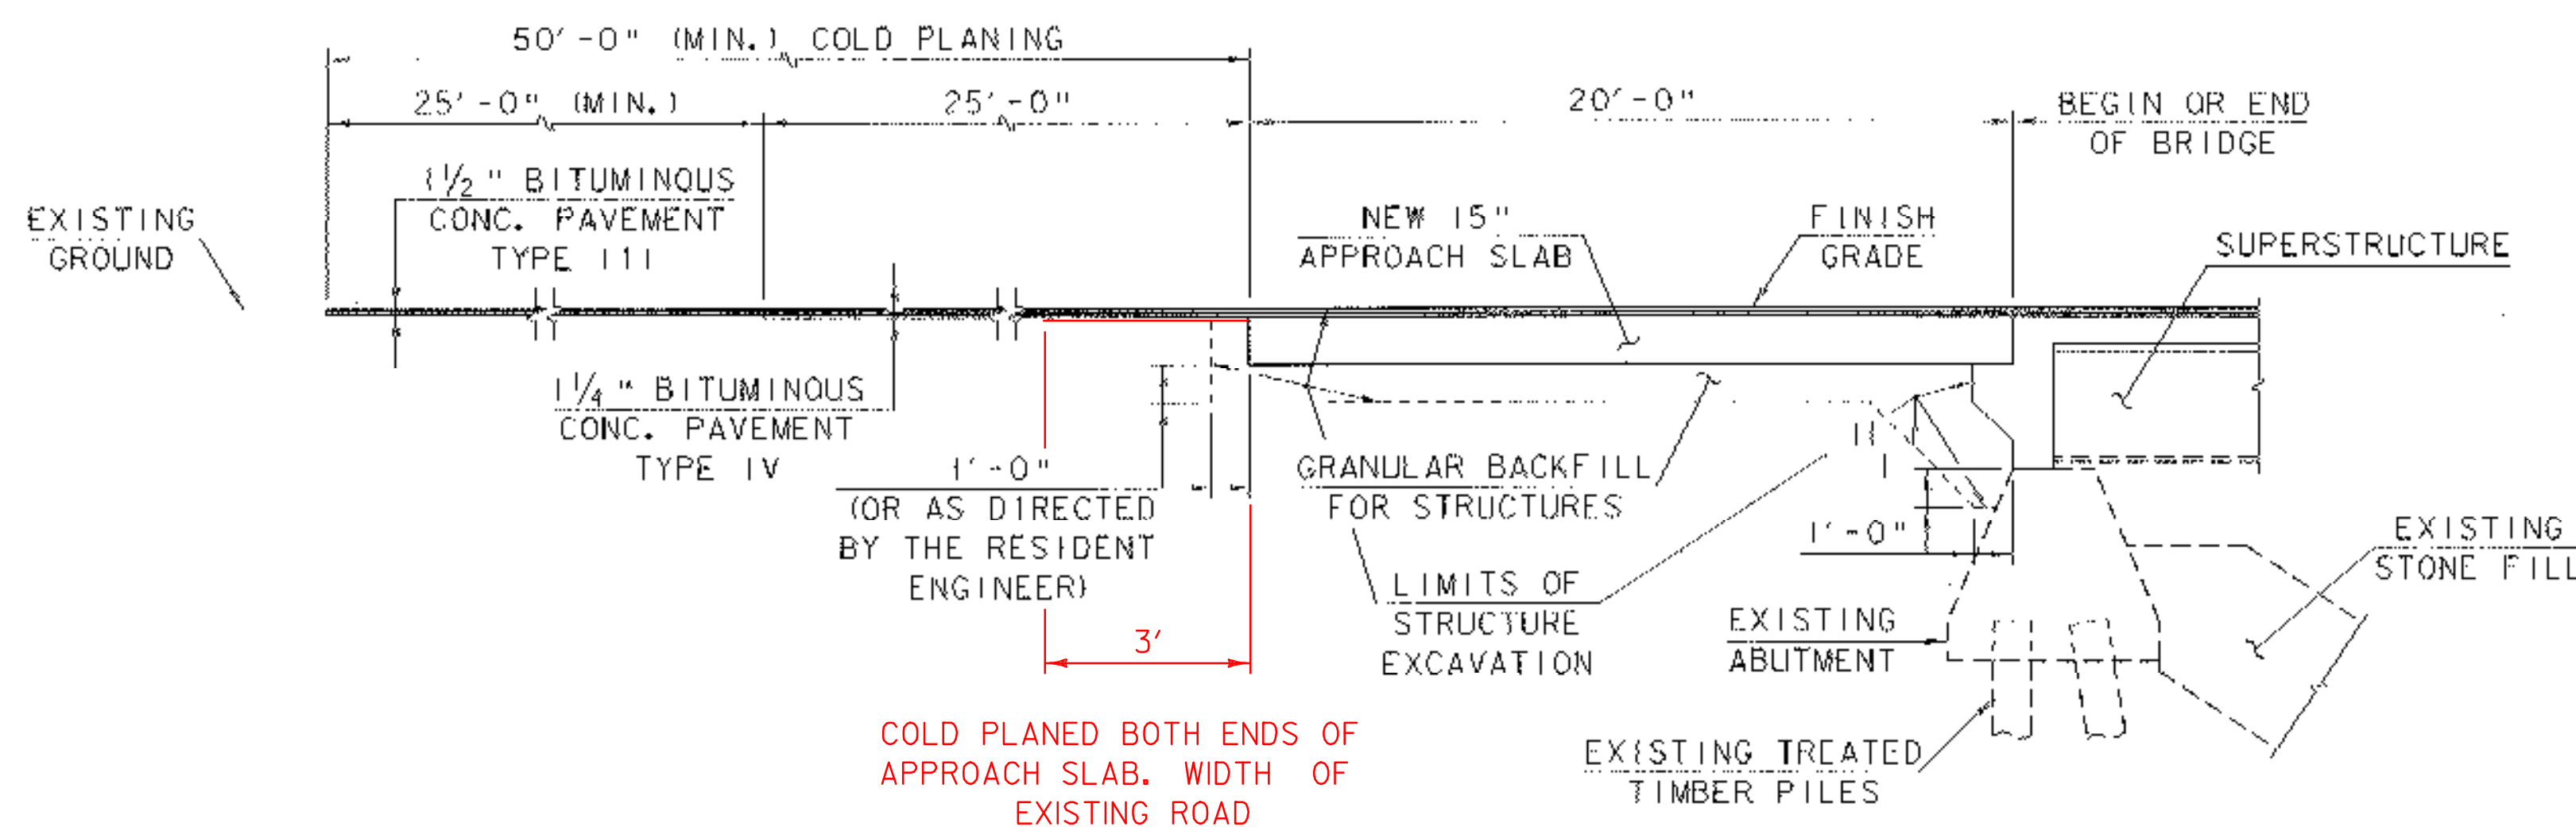

### COLD PLANING AND EARTHWORK DETAILS

SCALE: 1/4" = 1'-0"

MATERIAL ITEM	TOLERANCE
PAVEMENT	±1/4" TOTAL THICKNESS

### DESIGN CRITERIA:

- DESIGN LIVE LOAD AASHTO: HS20-44
  - DESIGN SPAN: 82.60'
  - ALLOWABLE LOAD FOR SPREAD FOOTINGS ON SOIL: N/A ON LEDGE: N/A
  - ALLOWABLE LOAD FOR PILING: N/A TYPE: N/A ESTIMATED LENGTH: N/A
  - ASSUMED STRUCTURAL STEEL AASHTO GRADE: 35 PAINTED (EXISTING)
  - REINFORCING STEEL GRADE: 60
  - CONCRETE CLASS A:  $f_c = 4000$  PSI  
CONCRETE CLASS B:  $f_c = 3500$  PSI  
SILICA-FUME CONCRETE:  $f_c = 5000$  PSI
  - ASSUMED UNIT WEIGHT OF SOIL: 140 PCF
  - ASSUMED STRENGTH OF EXISTING CONCRETE:  $f_c = 3000$  PSI
- TRAFFIC MAINTENANCE:
- IS TRAFFIC TO BE MAINTAINED? YES IF YES, ON EXISTING STRUCTURE \* OR ON TEMPORARY BRIDGE N/A
  - TEMPORARY BRIDGE REQUIREMENTS: ONE OR TWO WAY N/A TRAFFIC CONTROL SIGNALS REQUIRED YES

### LOAD FACTOR LOAD RATING (TONS)

LOADING LEVELS (LOAD FACTOR)	TRUCK					
	H	HS	352	6 AXLE	3A. STR.	4A. STR. 5A. SEMI
INVENTORY A=2.17; B=1.00	42	58				
POSTED A=1.55; B=1.40	59	81	96		74	76 88
OPERATING A=1.30; B=1.67		97	114	136	89	91

STRENGTH  $RF = \frac{0.75 M_n}{A \times M_{LL+1}} - 1.3 \frac{M_{SD1}}{M_{LL+1}}$  SERVICEABILITY  $RF = B \left[ 0.95 \frac{F_y S_{LL+1}}{M_{LL+1}} - \frac{M_{DL}}{M_{LL+1}} - \frac{M_{SD1}}{M_{LL+1}} - \frac{M_{SD2}}{M_{LL+1}} \right]$

### STATE OF VERMONT AGENCY OF TRANSPORTATION

Town Of **WARREN** Bridge No. **167**  
Highway No. **VT 100** Log Sta.   
Surv. Sta.

### VT 100 OVER THE MAD RIVER

### PRELIMINARY INFORMATION SHEET

Designed By **M. LOZIER** Drawn By **G. ROY**  
Checked By **M. LOZIER** Date **4/00** Bridge Design Supervisor **R. R. WHITCOMB** Date **4/00**  
PROJECT **WARREN** PROJECT NO. **BHF 013-4 (27)S**  
I.G.C. Info. **98b324 Structures\sh324pl.dgn** **sb324pl**  
Bridge Sheet No. **Sheet 2 of 23**

YEAR 2000 ADT (ASSUMED) = 1150 VPD  
DESIGN SPEED: 50 MPH