

REMOVING AND RESETTING GUARD RAIL

14+03.9 RT. - 15+36.1 RT.
 14+16.5 LT. - 15+48.6 LT.
 16+36.1 RT. - 17+54.3 RT.
 16+48.6 LT. - 17+33.9 LT.

**BRIDGE RAIL - HDSB
 FASCIA MTD./STEEL TUBING**



15+36.1 RT. - 16+36.1 RT.
 15+48.6 LT. - 16+48.6 LT.

DURABLE 4" WHITE LINE

14+70.0 - 17+25.0 LT. & RT.

DURABLE 4" YELLOW LINE

14+70.0 - 17+25.0 C.V.T. 100

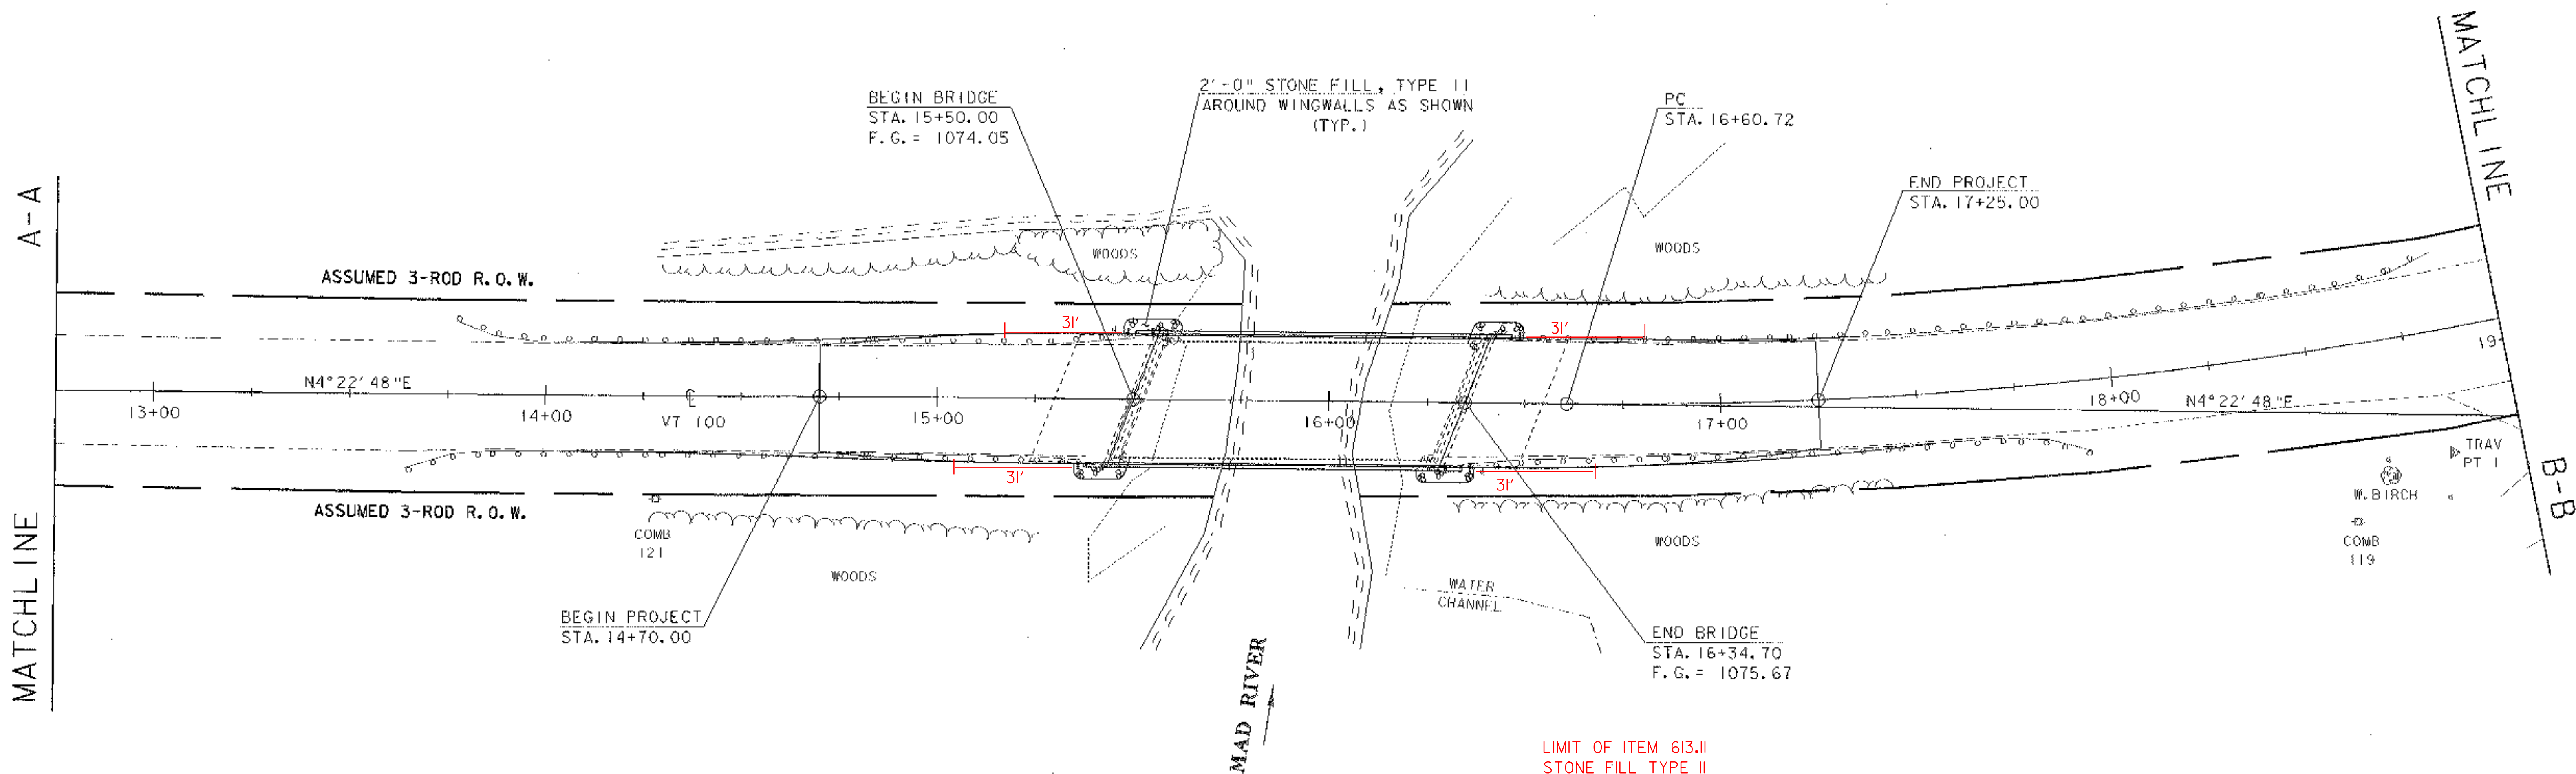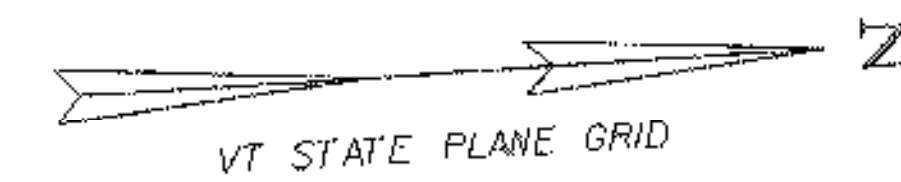

LIMIT OF ITEM 613.11
 STONE FILL TYPE II


L	W	D
WW#1	31 X 4 X 3	
WW#2	31 X 4 X 3	
WW#3	31 X 4 X 3	
WW#4	31 X 4 X 3	

15+45.52, 24.62 LT.
 END SHEET 4 FOR

EXISTING BRIDGE DATA

CONCRETE DECK W/ 6 - W 36 X 280 ROLLED BEAMS (NON-COMPOSITE)
 CONCRETE ABUTMENTS ON TIMBER PILES W/ CONCRETE WINGWALLS
 DECK WIDTH = 35.4'
 OVERALL SPAN = 84.75'
 CLEAR SPAN = 80.5' CLEAR HT. = 14.5'

LAYOUT SHEET TWO

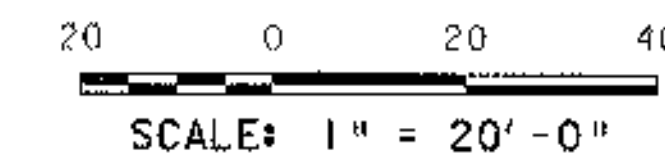

PROJECT NAME:	WARREN	FILE NAME:	98b324\Structures\sb324102.i	PLOT DATE:	07-JUN-2000
PROJECT NUMBER:	BHF 013-4 (27)S	PROJECT MANAGER:	R. R. WHITCOMB	DRAWN BY:	G. ROY
		DESIGNED BY:	G. ROY	CHECKED BY:	M. LOZIER
				SHEET	6 OF 23