




PLAN

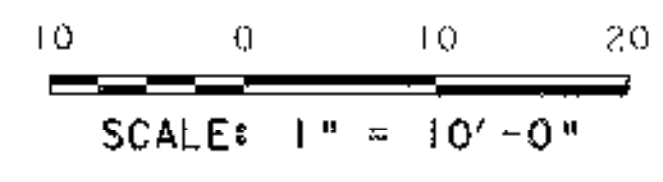

LIMITS OF ITEM 406.25
 BITUMINOUS CONCRETE PAVEMENT (PG 58-34)
 STA 15+27.00 ~ STA 16+57.70 TYPE III

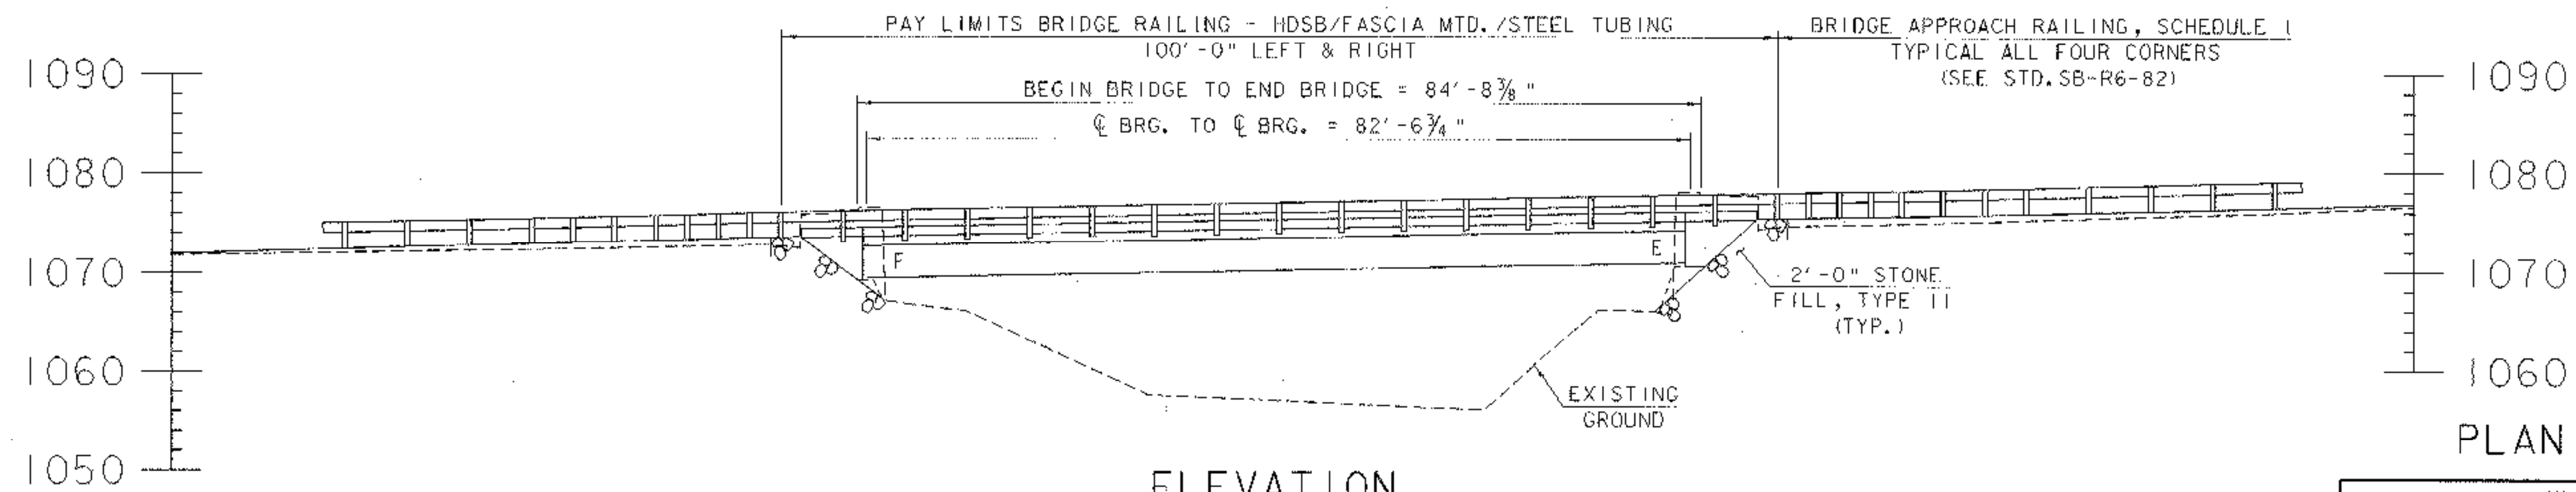

ELEVATION

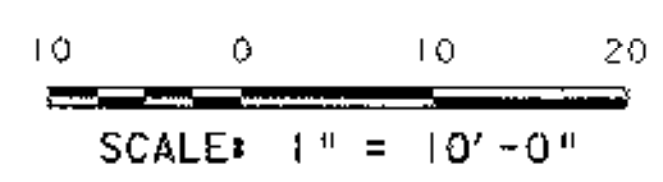

PLAN AND ELEVATION

PROJECT NAME:	WARREN	FILE NAME:	98b324\Structures\sb324pe.i	PLOT DATE:	07-JUN-2000
PROJECT NUMBER:	BHF 013-4 (27)S	PROJECT MANAGER:	R. R. WHITCOMB	DRAWN BY:	G. ROY
DESIGNED BY:	G. ROY	CHECKED BY:	M. LOZIER	SHEET	11 OF 23