


OVERLAY TYPICAL SECTION

U.S. RTE. 5 STA 16+866 ~ 0+523
VT. RTE. 58 STA 0+000 ~ 0+252

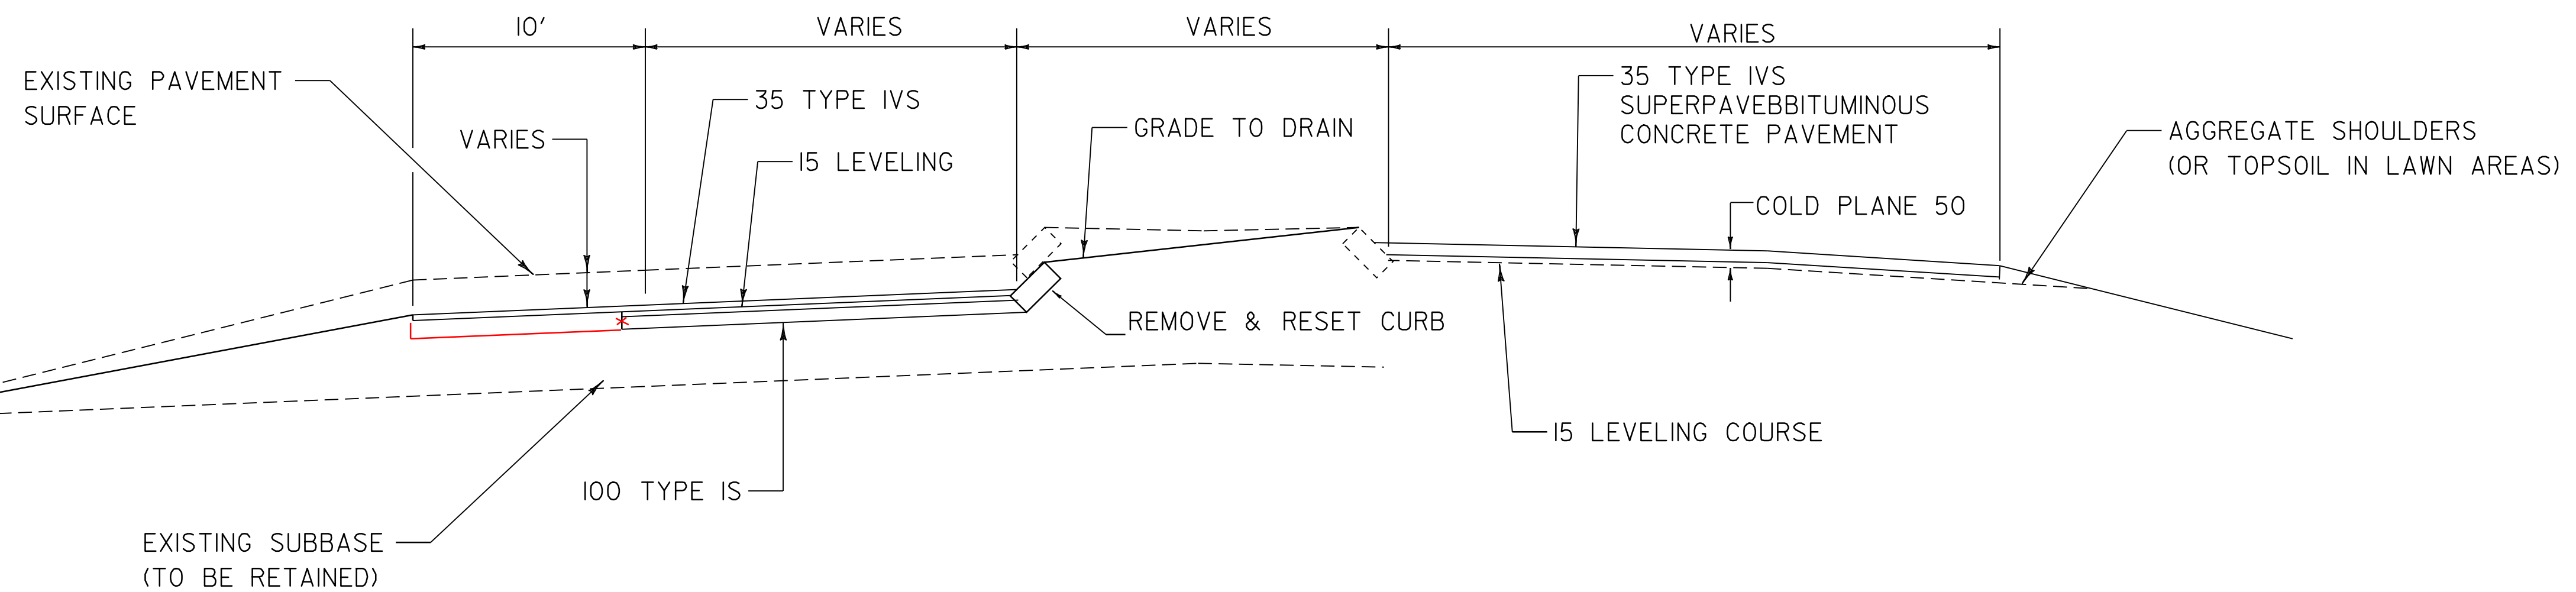

RECONSTRUCTION TYPICAL SECTION

U.S. RTE. 5 STA 16+973 LT ~ 0+81.52 LT
(SEE SHEETS 27 ~ 29 FOR GRADE LINE)

REFER TO LAYOUT SHEETS 27, 28, 29
AND PROFILE SHEETS 34 & 35 FOR
LIMITS AND DEPTHS OF GRADE CHANGE.

NOTE: FULL DEPTH PAVEMENT DESIGN REQUIRED THROUGHOUT
RECONSTRUCTION LOCATION.

**PROJECT
TYPICAL
SHEET #3**

PROJECT NAME: BARTON
PROJECT NUMBER: STP 2107(1)S

FILE NAME: /pave/98c096/pc096wrk.dgn PLOT DATE: 21-MAY-2007 13:11
PROJECT LEADER: WOOLAVER DRAWN BY: JLR
DESIGNED BY: JLR CHECKED BY:
pc096ty03.i SHEET 5 OF 49