

TEMPORARY AND DURABLE 100 mm YELLOW LINE
 STA 13+800 TO 14+004 SOLID LT & RT
 STA 14+010 DOUBLE SOLID LT (SA 6)
 STA 14+016 TO 14+150 SOLID LT & RT

TEMPORARY AND DURABLE 100 mm WHITE LINE
 STA 13+800 TO 13+998 SOLID LT
 STA 13+800 TO 14+150 SOLID RT
 STA 14+022 TO 14+150 SOLID LT

TEMPORARY AND DURABLE LETTER OR SYMBOL
 STA 14+010 LT "STOP" (SA 6)

TEMPORARY AND DURABLE 600 mm STOP BAR
 STA 14+010 LT (SA 6)

CHANGING ELEV. OF DI, CB OR MH
 REHABILITATION OF DI, CB OR MH CLASS I
 STA 14+105 LT

STEEL BEAM GUARDRAIL
~~STA 13+918 TO 13+937 LT~~
~~STA 13+920 TO 13+939 RT~~

~~ANCHOR FOR STEEL BEAM RAIL~~
~~STA 13+918 LT~~
~~STA 13+937 LT~~


STEEL BEAM GUARDRAIL
 (MOD - 2.4m POSTS)
 STA 13+924 TO 13+928 LT

MANUFACTURED TERMINAL SECTION (FLARED)
 I3+909 - STA 13+920 RT
 STA 13+939 RT - I3+950
 STA 14+091 RT - I4+102 RT
 STA I3+913 - I3+924 LT

REMOVING SIGNS
 AS SHOWN - 5- 4

ERECTING SALVAGED SIGNS
 AS SHOWN - 2- 1

REMOVE AND DISP GUARDRAIL
 STA 14+091 ~ 14+102 RT

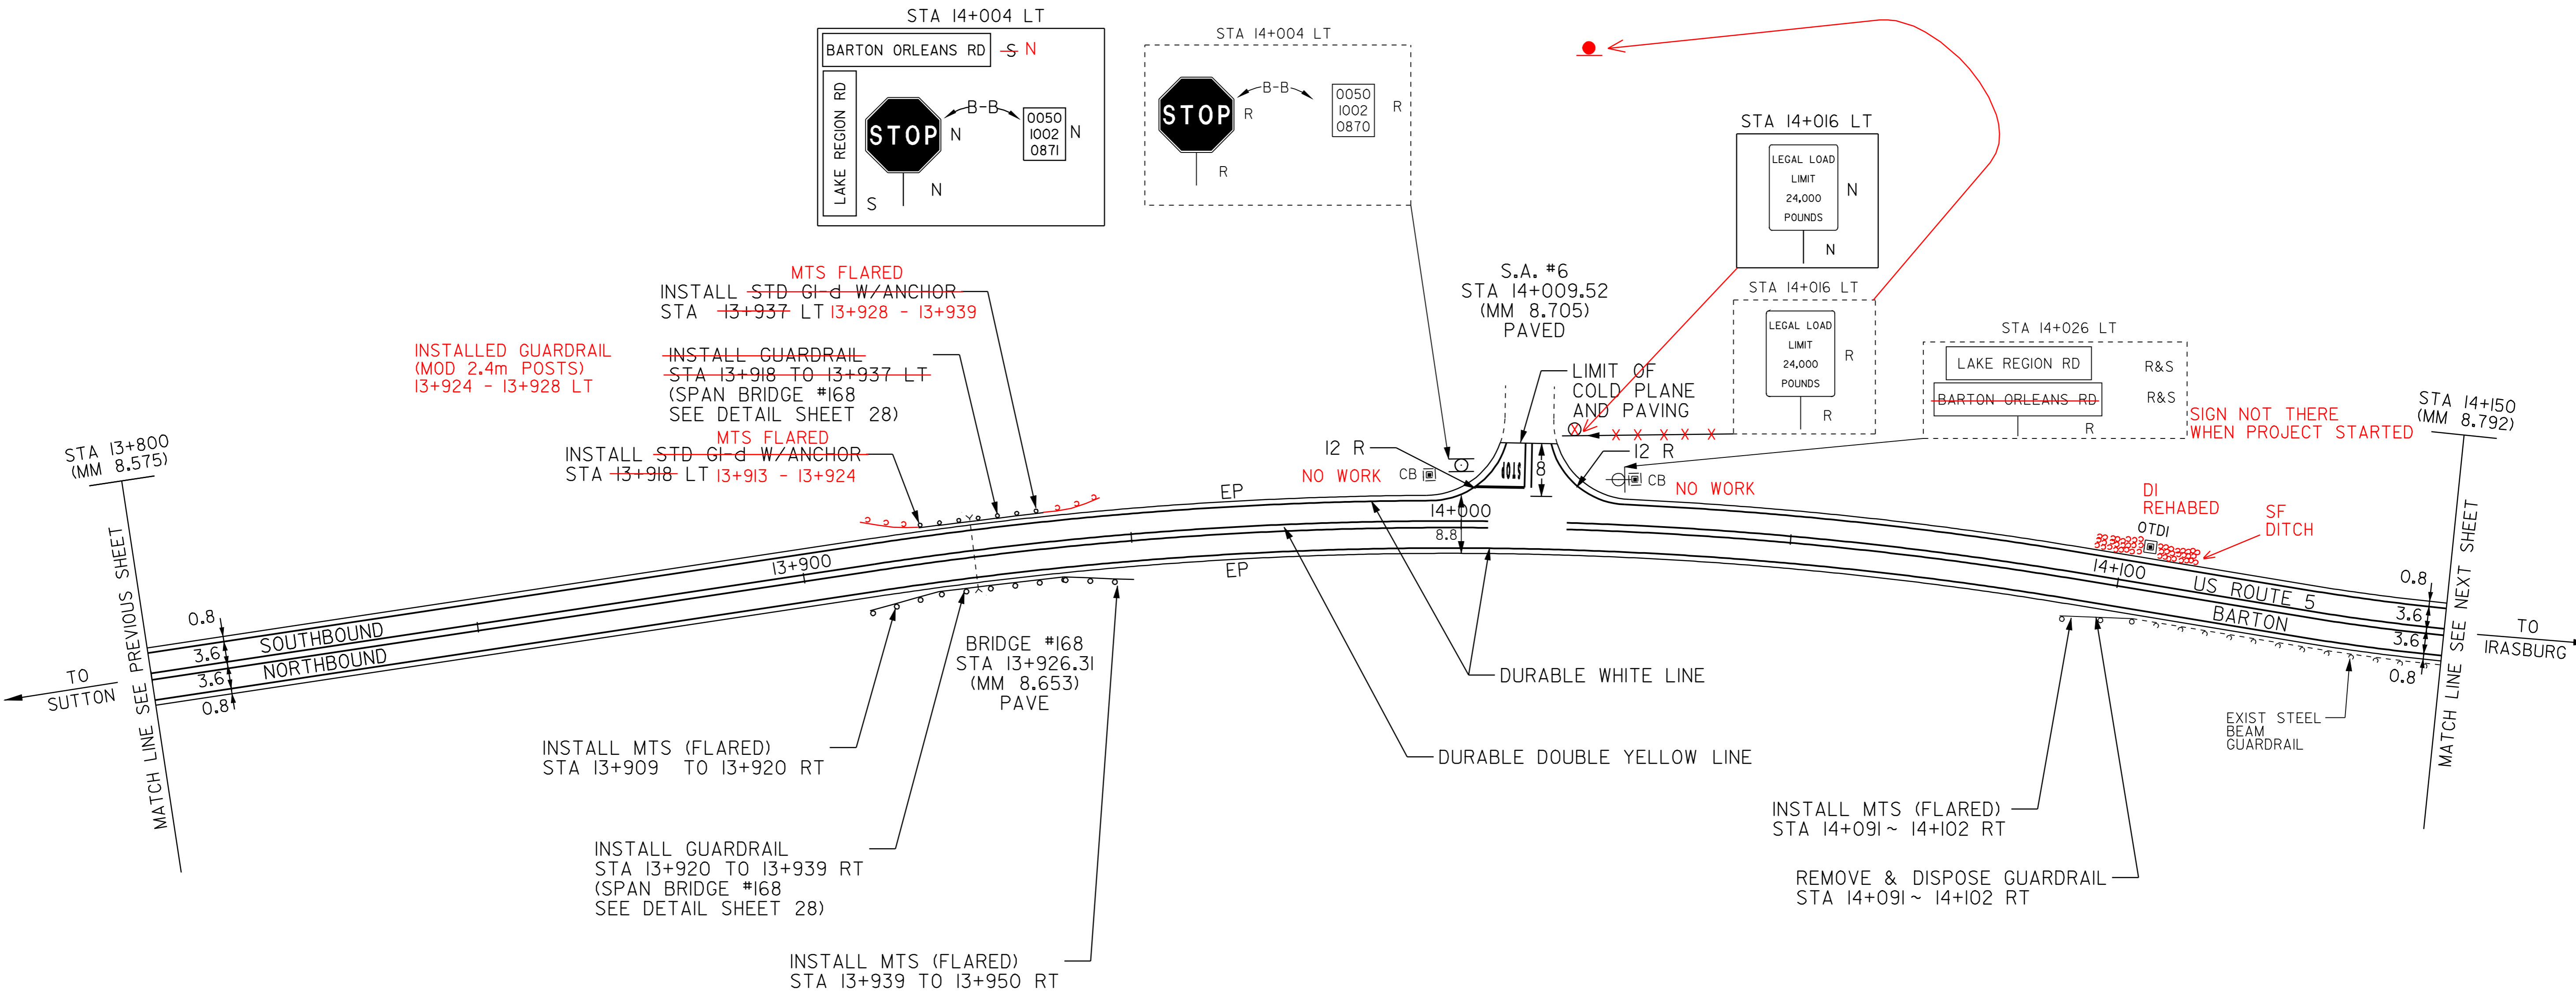

LEGEND

- R = REMOVE EXISTING
- S = SALVAGE
- R&S = REMOVE AND SALVAGE
- N = NEW
- RET = RETAIN
- B-B = BACK TO BACK
- = NEW RAIL
- = EXISTING RAIL
- ⊗ = BORING LOCATION

NOTE: ALL DIMENSIONS IN METERS EXCEPT AS INDICATED

DATUM	
VERTICAL	N/A
HORIZONTAL	N/A

NOT TO SCALE

PAVING PROJECT LAYOUT #9

PROJECT:	BARTON-IRASBURG	PROJECT NO.:	STP 2107(I)S
DESIGN FILE NAME:	pave/98c096/pc096.dgn	PLOT DATE:	21-MAY-2007
IPARM FILE NAME:	pc096i09.i	SURVEY DATE:	6/99
SURVEYED BY:	CLD ENGINEERS INC	DRAWN BY:	NLL
SQUAD LEADER:	WRH	SHEET:	20 OF 49