

DURABLE 4" WHITE LINE
 STA 17+200 ~ 0+041 LT (EDGE--SOLID)
 STA 17+230 ~ 0+004 RT (EDGE--SOLID)
 STA 0+011 ~ 0+041 RT (EDGE--SOLID)

DURABLE 4" YELLOW LINE
 STA 17+200 ~ 0+041 LT & RT (EDGE--SOLID)

REMOVING AND RESETTING CURB
 STA 17+200 LT ~ 0+041 LT
 0+020

REMOVING SIGNS
 AS SHOWN - 13


DURABLE 12" WHITE LINE
 STA 17+308 ~ 0+011 RT

CHANGING ELEV. OF DI, CB OR MH
 REHABILITATION OF DICB OR MH CL 1


STA 17+202 C.L.
 STA 17+290 LT

BIT. CONC. GUTTERS

17+202 CL
 17+290 CL

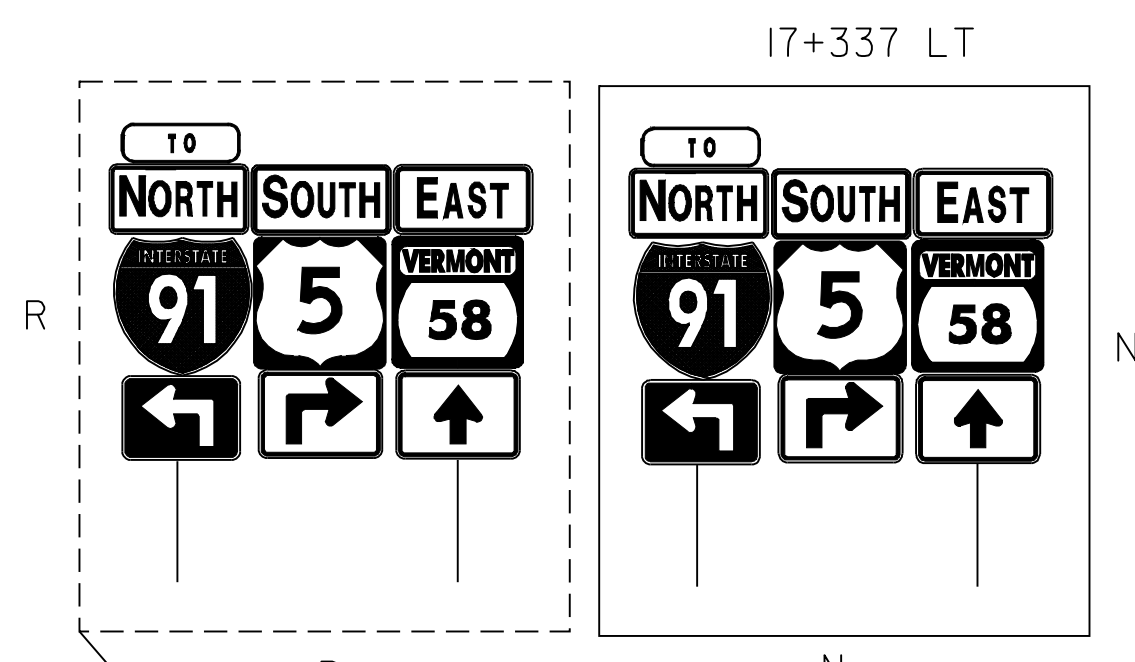

BARTON T/L
 STA 17+341 = STA 0+000
 MM 10.77 = MM 0.00

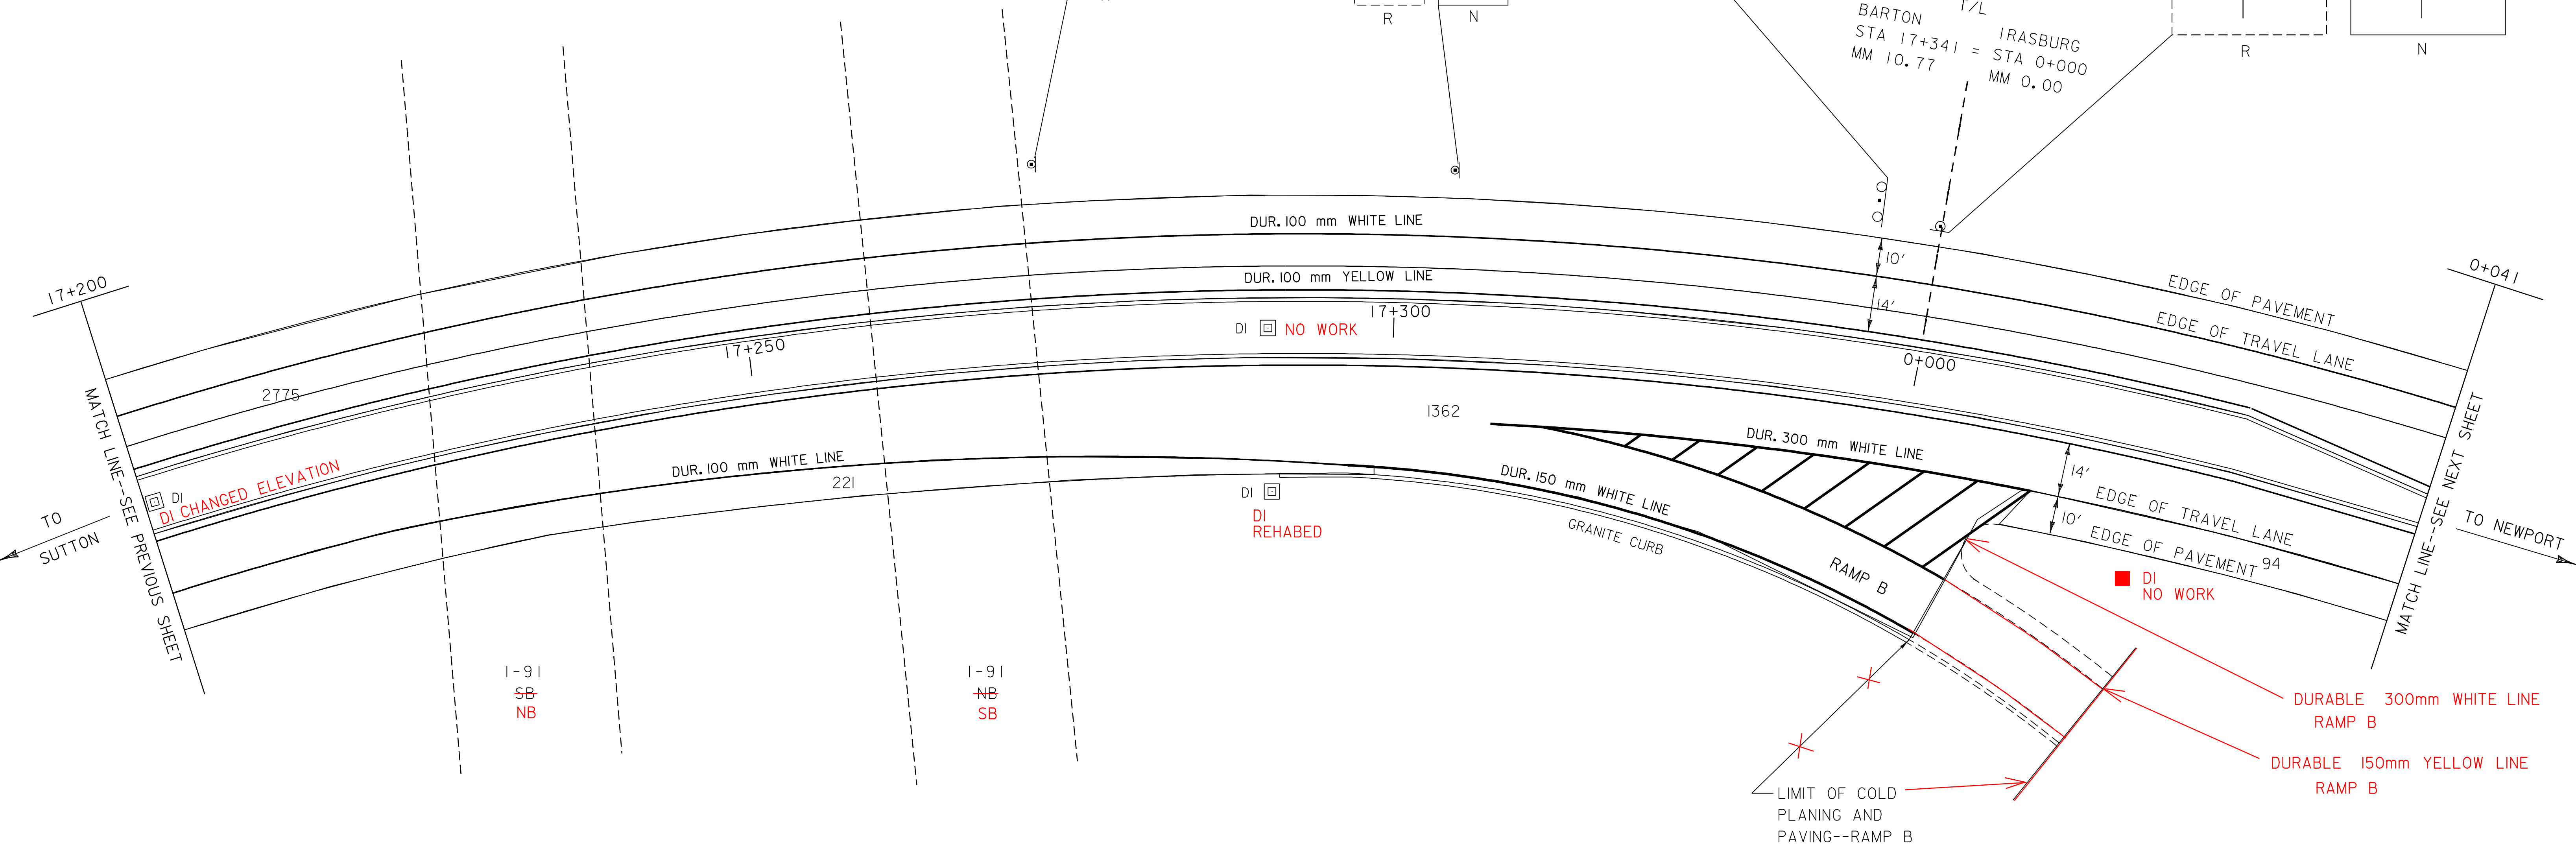

US RTE 5 LAYOUT # 17	PROJECT NAME: BARTON-IRASBURG	PLOT DATE: 21-MAY-2007 13:12
	PROJECT NUMBER: STP 2107(I)S	DRAWN BY: JLR
	FILE NAME: pave/98c096/pc096a.dgn	CHECKED BY:
	PROJECT LEADER: MW	SHEET 28 OF 49
	DESIGNED BY: JLR	
	pc096i17.i	