

DURABLE 4" WHITE LINE
 STA 0+41 ~ 0+058 RT (EDGE--SOLID)
 STA 0+041 ~ 0+224 LT (EDGE--SOLID)
 STA 0+068 ~ 0+163 LT (LANE LINE--SOLID)
 STA 0+085 ~ 0+224 RT (EDGE--SOLID)
 STA 0+163 ~ 0+193 LT (LANE LINE--DOTTED)

DURABLE 4" YELLOW LINE
 STA 0+041 ~ 0+054 LT & RT (EDGE--SOLID @ ISLAND)
 STA 0+078 ~ 0+224 LT & RT (EDGE--SOLID @ ISLAND)


DURABLE LETTER OR SYMBOL
 STA 0+079 LT (LT. ARROW)
 STA 0+160 LT (LT. ARROW)
RAMP A STOP

TEMPORARY LETTER OR SYMBOL
 STA 0+079 LT (LT. ARROW)
 STA 0+157 LT (LT. ARROW)

**CHANGING ELEV. OF DI, CB OR MH
 REHABILITATION OF DICB OR MH CL 1**
 STA 0+079 RT
 STA 0+132 RT

**REMOVING SIGNS
 AS SHOWN - -915**

TEMPORARY & DURABLE 600 mm STOP BAR
 STA 0+065 RT ~ 0+079 RT

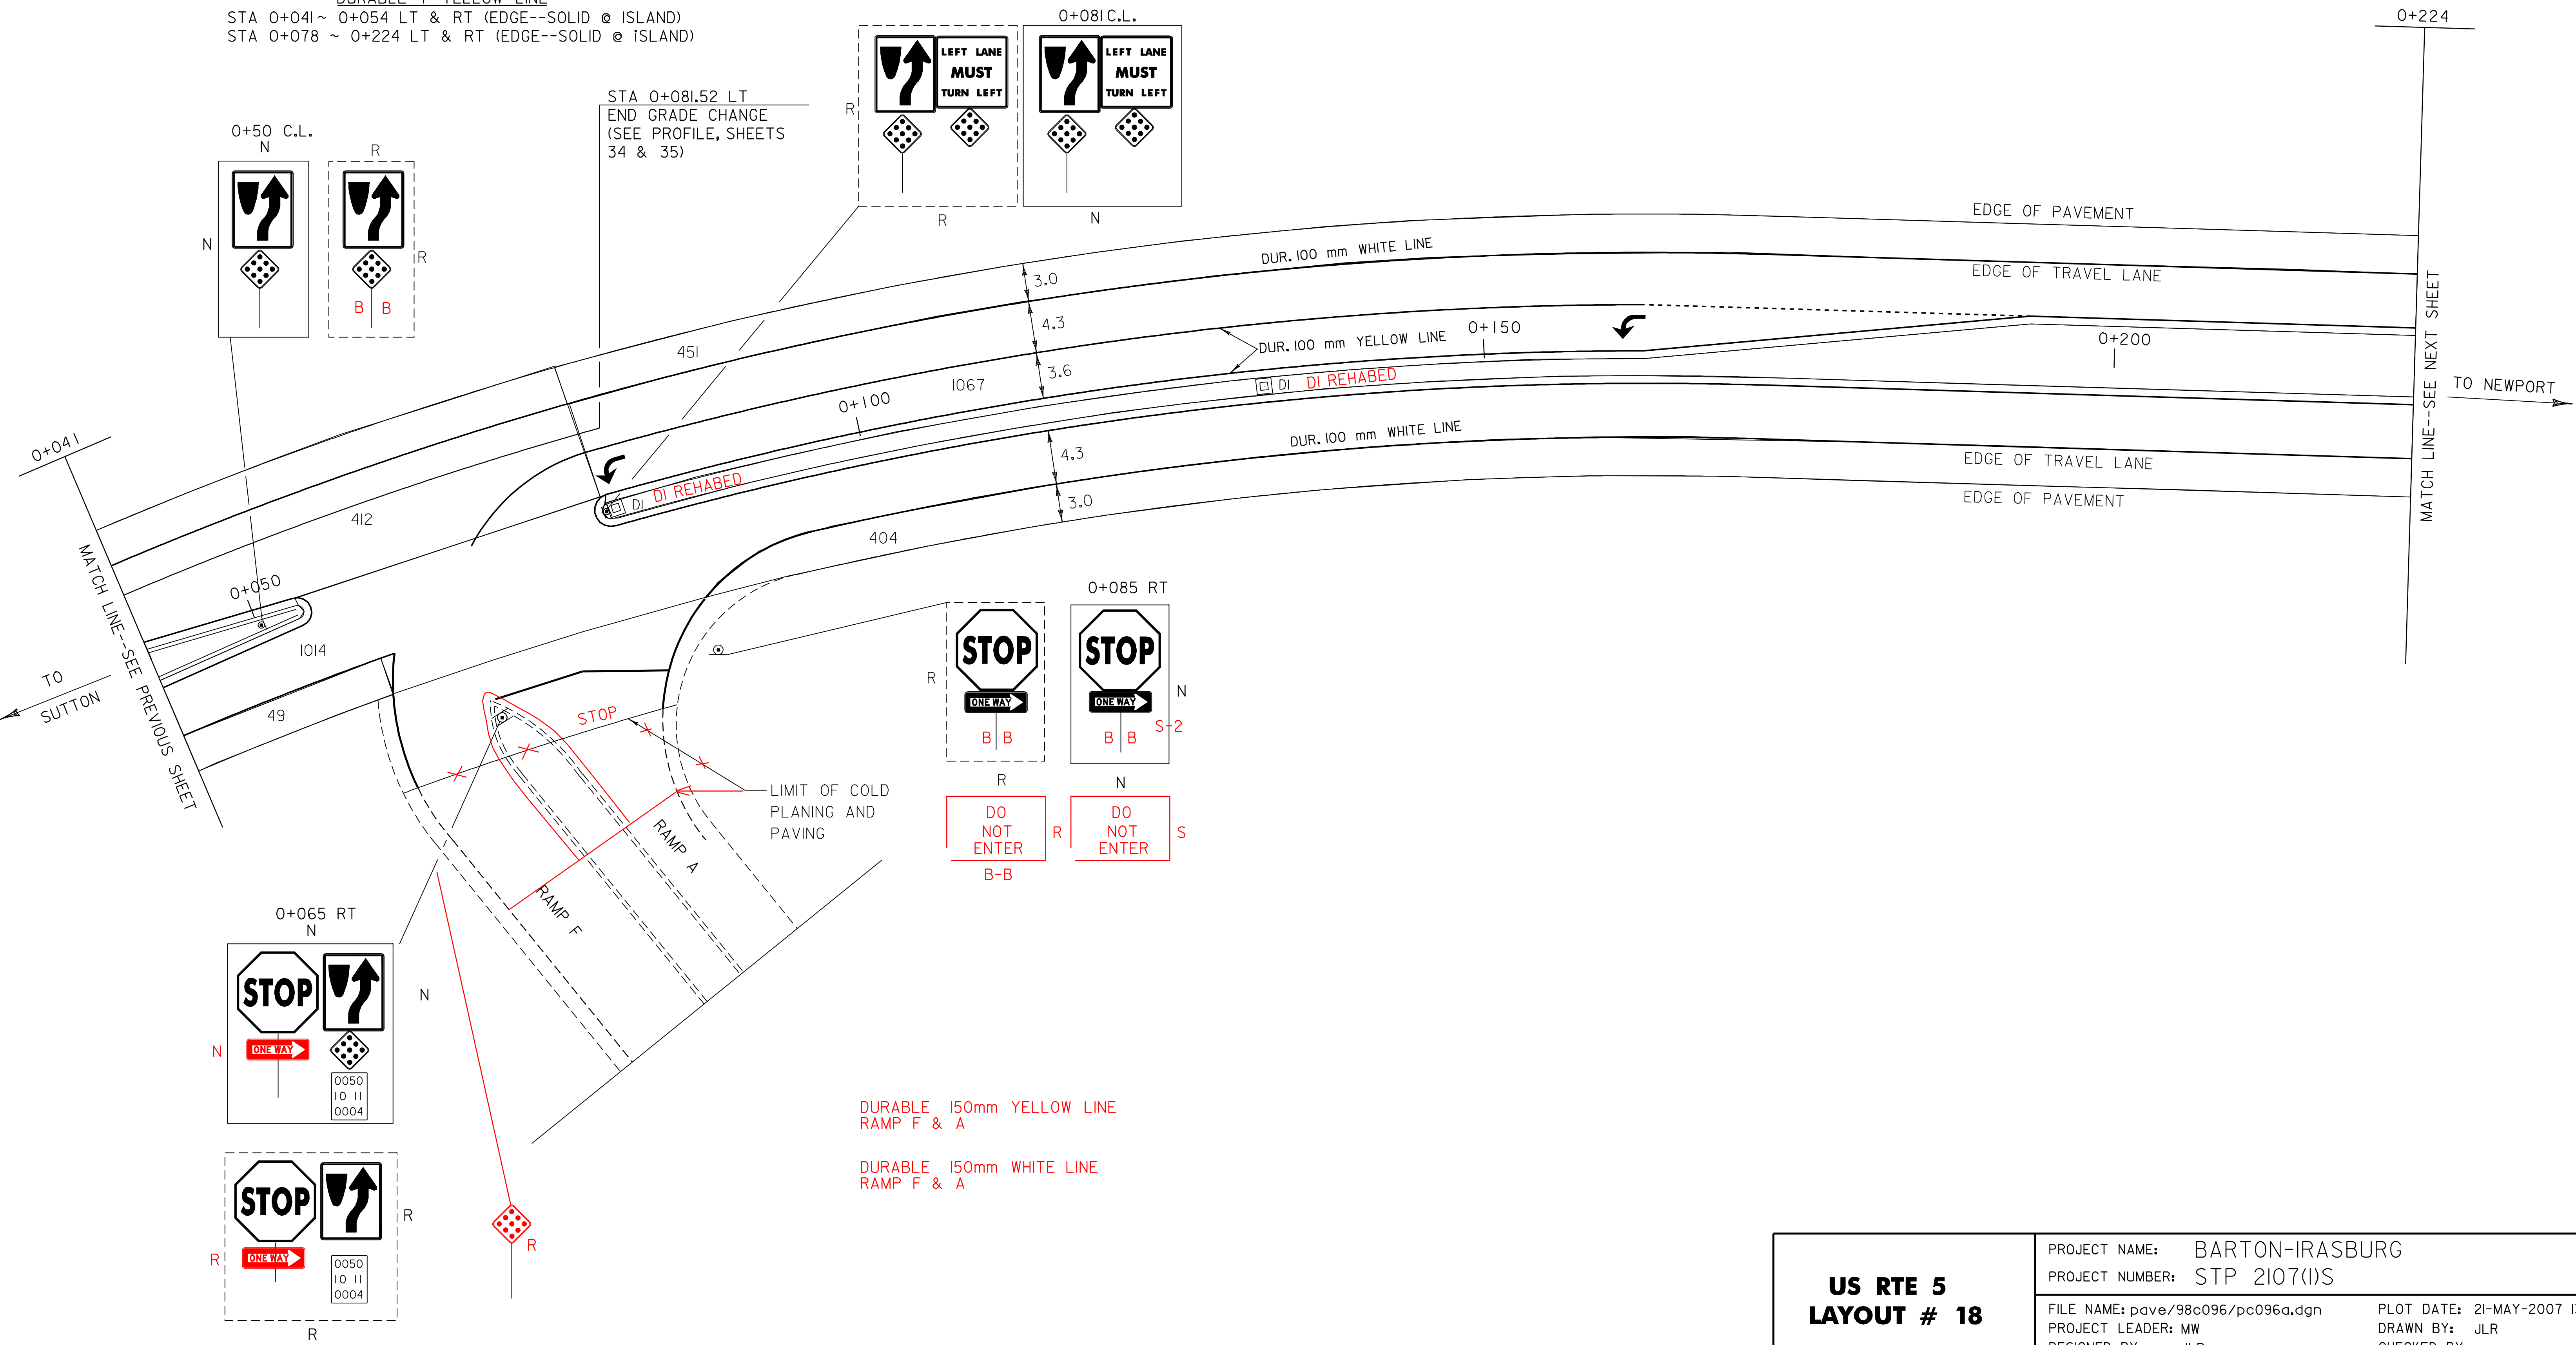

US RTE 5 LAYOUT # 18	PROJECT NAME: BARTON-IRASBURG	PLOT DATE: 21-MAY-2007 13:12
	PROJECT NUMBER: STP 2107(I)S	DRAWN BY: JLR
	FILE NAME: pave/98c096/pc096a.dgn	CHECKED BY:
	DESIGNED BY: JLR	SHEET 29 OF 49